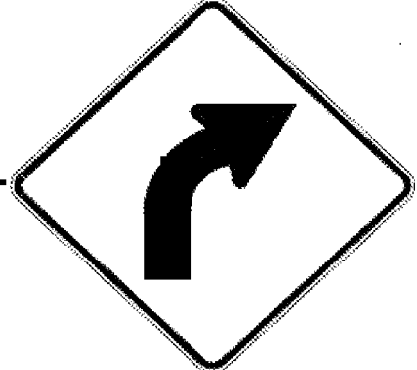
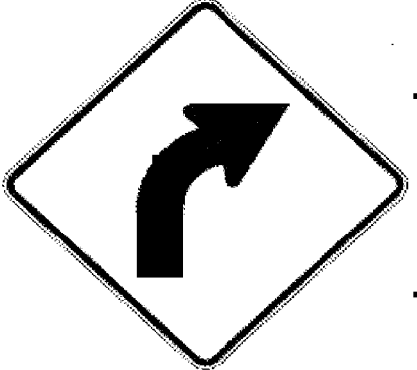



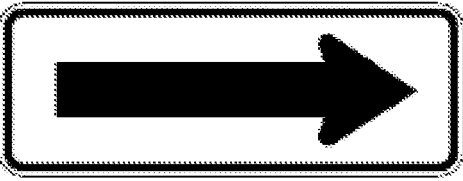


DIR	MILEPOINT	LOCATION CODE (SHEET 2)	MUTCD CODE	WIDTH (IN)	HEIGHT (IN)	SHEETING REMARKS	SIGN LEGEND	NEW SIGNS		EXISTING SIGNS				EXIST POST		NUMBER OF NEW POSTS	SQUARE STEEL (in)			TUBULAR STEEL Ø (IN)				SIGN FRAME REQUIRED	REMARKS	SIGN DETAIL			
								"A"	"B"	RETAIN	SALVAGE FROM	SALVAGE TO	REMOVE	RETAIN	REMOVE		1.75	2.00	2.50	FOUNDATION	3.00	3.50	4.00			5.00	DETAIL IN SHS	DETAIL ON SHEET NUMBER	DETAIL ON STD SHEET NUMBER
																	(LB / FT)				(LB / FT)								
FAIR HAVEN VT22A							"FY"-FLUORESCENT YELLOW "FYG"-FLUORESCENT YELLOW GREEN															"SHS"-STANDARD HIGHWAY SIGNS							
NB	3.570	A	W1-2R	30	30	FY		6.25							1		X							INSTALL 900' NORTH OF EXISTING SIGN	X				
NB	3.910	A	R2-1	24	30								1			X													
NB	3.975	A	W1-2R	30	30		RIGHT CURVE						1			X													
		A	W13-1	18	18		45 MPH PLAQUE						1																
NB	4.040	A	W1-2R	30	30	FY		6.25							1		X							INSTALL 340' NORTH OF EXISTING SIGN	X				
NB	4.210	A	S3-1	30	30		SCHOOL BUS STOP AHEAD						1			X													
SB	4.260	F	W1-6	48	24								1			X													
		F	OM1-1	18	18		CLUSTER						1																
		F	W1-6	48	24	FY		8.00							2		X								X				
SB	4.205	F	W1-6	48	24								2			X													
		F	W1-6	48	24	FY		8.00							2		X								X				
		E	W1-6	48	24	FY		8.00							2		X								X				
SB	4.150	E	W1-6	48	24								1			X													
		E	OM1-1	18	18		CLUSTER						1																
		E	W1-6	48	24	FY		8.00							2		X								X				
SIGN SUMMARY SHEET							SHEET TOTALS	44.50	0.00	0	0	0	10	0	0	10		150							PROJECT NAME: Fair Haven-Panton VT22A				
								SF	SF	EA	EA	EA	EA	EA	EA	EA		FT							PROJECT NUMBER: STPG SIGN(24)				
							TOWN TOTALS	601.5	0.0	9.0	5.0	5.0	137	0.0	0.0	95		1425.0								FILE NAME: Fair Haven.xls			
																									PLOT DATE: 4/29/2009				
																									DRAWN BY: I. Shea				
																									CHECKED BY: S. Menard				
																									FAIR HAVEN SHEET 13				
																									SHEET 20 OF 117				

FOR ALL POST LENGTHS SEE ORIGINAL RECORD PLANS

2+

10-9