





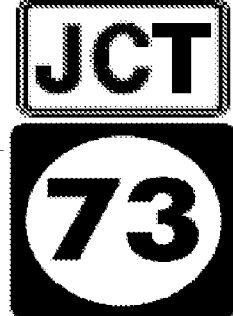



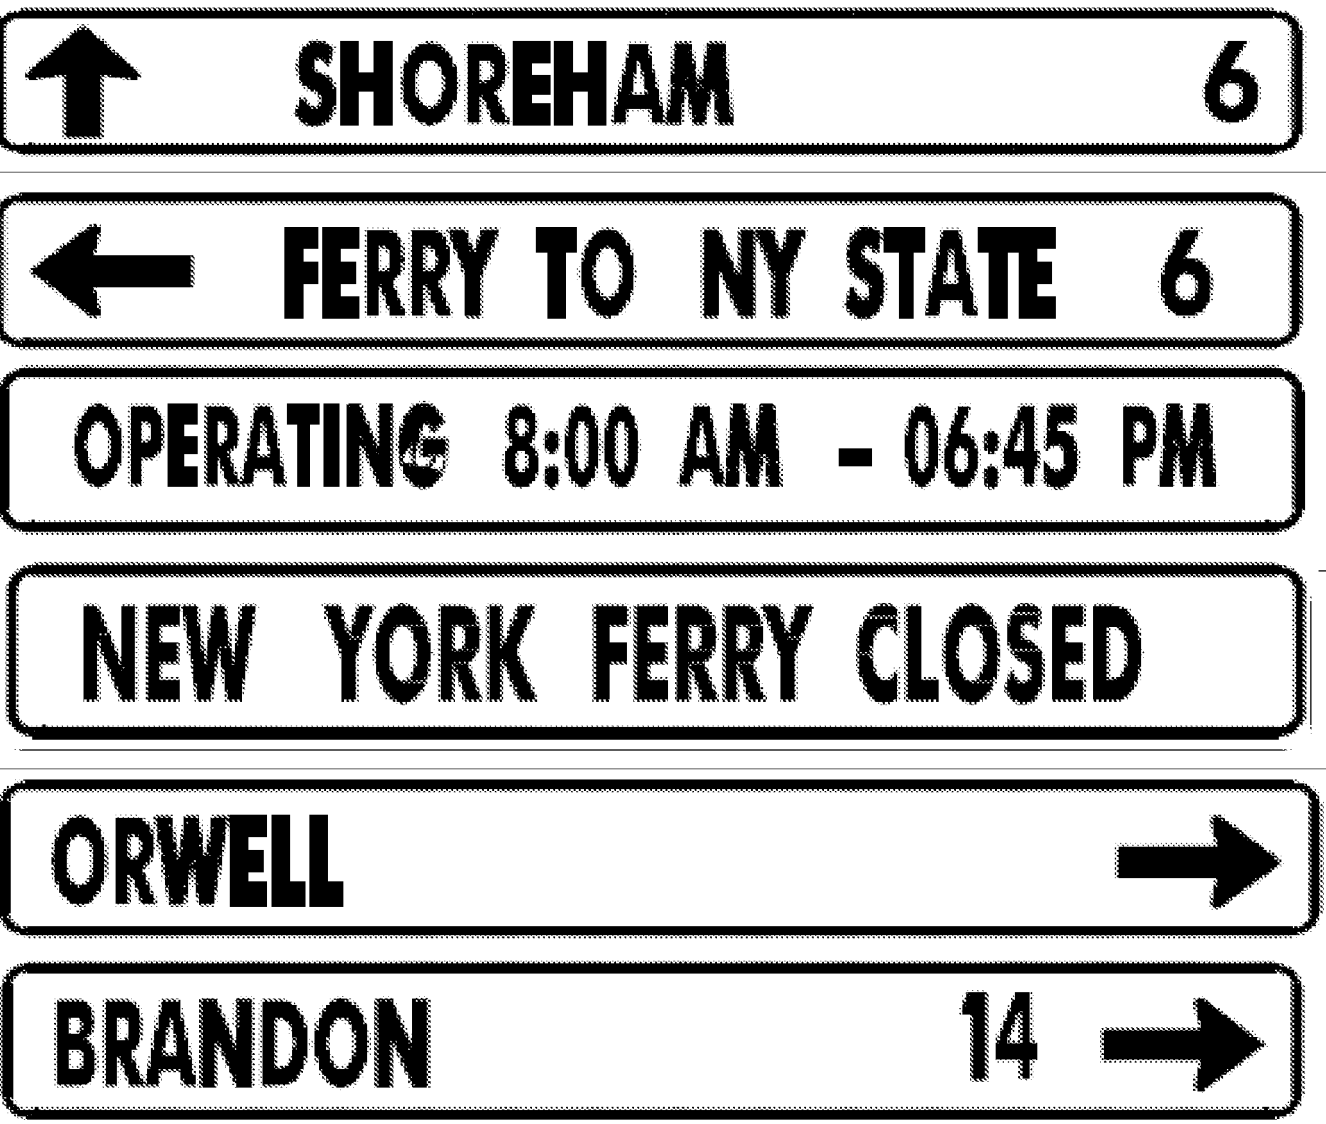


DIR	MILEPOINT	LOCATION CODE (SHEET 2)	MUTCD CODE	WIDTH (IN)	HEIGHT (IN)	SHEETING REMARKS	SIGN LEGEND	NEW SIGNS		EXISTING SIGNS				EXIST POST		NUMBER OF NEW POSTS	SQUARE STEEL (in)			TUBULAR STEEL Ø (IN)				SIGN FRAME REQUIRED	REMARKS	SIGN DETAIL				
								"A"	"B"	RETAIN	SALVAGE FROM	SALVAGE TO	REMOVE	RETAIN	REMOVE		1.75	2.00	2.50	FOUNDATION	3.00	3.50	4.00			5.00	DETAIL IN SHS	DETAIL ON SHEET NUMBER	DETAIL ON STD SHEET NUMBER	
																	(LB / FT)				(LB / FT)									
ORWELL VT22A							"FY"-FLUORESCENT YELLOW "FYG"-FLUORESCENT YELLOW GREEN															"SHS"-STANDARD HIGHWAY SIGNS								
			A				CHAMPLAIN BIKEWAY SIGNS																							
			A	M2-1	21	15		2.19															#1	BLACK ON WHITE SHEETING	X					
			A	M1-6	24	24		4.00																			E-136C			
			A	M2-1	21	15		2.19																GREEN ON WHITE SHEETING	X					
			A	M1-5	24	24		4.00																			E-136B			
NB	3.172		A	D1-1A	72	10																								
			A	D1-1M	72	10																								
			A	D1-1M	72	10																								
			A	D1-1	72	10																								
			A	D1-1A	72	10																								
			A	D1-1A	72	12		6.00																		5				
			A	D1-1M	72	12		6.00																		5				
			A	D1-1M	72	12		6.00																		5				
			A	D1-1M	72	12		6.00															Do not install sign. Supply to Colchester Traffic Shop for off-season installation. Black on orange sheeting			5				
			A	D1-1	72	12		6.00																		5				
SIGN SUMMARY SHEET							SHEET TOTALS	42.38	0.00	0	2	0	5	0	0	2	30						PROJECT NAME: Fair Haven-Panton VT22A							
VERMONT AGENCY OF TRANSPORTATION							TOWN TOTALS	339.7	0.0	9.0	3.0	3.0	67	0.0	2.0	38	570.0						PROJECT NUMBER: STPG SIGN(24)							
																							FILE NAME: Orwell.xls							
																								PLOT DATE: 4/29/2009						
																									DRAWN BY: I. Shea					
																										DESIGNED BY: J. Kelly				
																										CHECKED BY: S. Menard				
																										ORWELL SHEET 3				
																										SHEET 46 OF 117				

FOR ALL POST LENGTHS, SEE ORIGINAL RECORD PLANS

NOT ERECTED BY LAFAYETTE

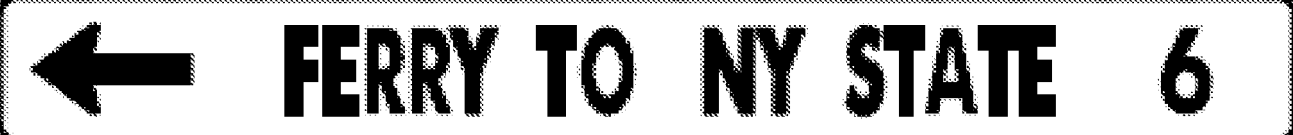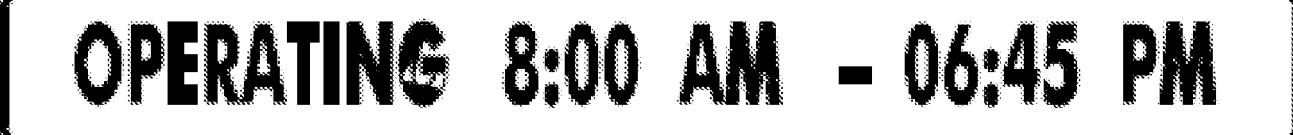

PROJECT NAME: **Fair Haven-Panton VT22A**
PROJECT NUMBER: **STPG SIGN(24)**
FILE NAME: **Orwell.xls**
PROJECT MANAGER: **N. Avery**
DESIGNED BY: **J. Kelly**
ORWELL SHEET 3
PLOT DATE: **4/29/2009**
DRAWN BY: **I. Shea**
CHECKED BY: **S. Menard**
SHEET **46** OF **117**