
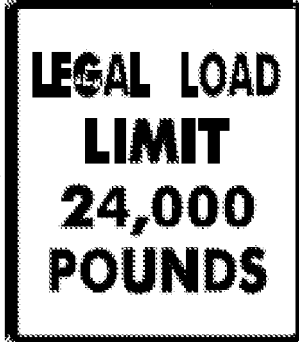




DIR	MILEPOINT	LOCATION CODE (SHEET 2)	MUTCD CODE	WIDTH (IN)	HEIGHT (IN)	SHEETING REMARKS	SIGN LEGEND	NEW SIGNS		EXISTING SIGNS				EXIST POST		NUMBER OF NEW POSTS	SQUARE STEEL (in)			TUBULAR STEEL Ø (IN)				SIGN FRAME REQUIRED	REMARKS	SIGN DETAIL			
								"A"	"B"	RETAIN	SALVAGE FROM	SALVAGE TO	REMOVE	RETAIN	REMOVE		1.75	2.00	2.50	FOUNDATION	3.00	3.50	4.00			5.00	DETAIL IN SHS	DETAIL ON SHEET NUMBER	DETAIL ON STD SHEET NUMBER
																	(LB / FT)				(LB / FT)								
ADDISON VT22A							"FY"-FLUORESCENT YELLOW "FYG"-FLUORESCENT YELLOW GREEN															"SHS"-STANDARD HIGHWAY SIGNS							
		F	M3-3	24	12			2.00							1		X							GREEN ON WHITE SHEETING	X				
		F	M1-5A	24	24			4.00																		E-136B			
SB	2.600	F	VD-062B	72	16		BUSINESS SIGN			1																			
SB	2.355	G	VR-017	24	30							1																	
		G	VR-017	24	30			5.00							1		X							TH-4, NORTONTOWN RD		E-141			
SB	2.347	H	R1-1	30	30							ERECT 1																	
		H	R1-1	30	30			6.25							1		X							TH-4, NORTONTOWN RD	X				
SB	2.295	F	R2-1	24	30							1																	
		F	R2-1	24	30			5.00							1		X							X					
SB	1.304	F	W11-7	30	30		EQUESTRIAN SYMBOL			1																			
		F	W7-3A	24	18		NEXT 1/2 MILE			1																			
SB	1.261	F	W2-2MR	30	30					1																			
		F	VW-092	24	18		UNSAFE TO PASS			1																			
SB	1.167	F	M3-3S	24	12		SOUTH			1																			
		F	M1-5	30	24		VT 22A			1																			
SIGN SUMMARY SHEET							SHEET TOTALS	22.25	0.00	7	0	6 2	3	0	0	4	60							PROJECT NAME: Fair Haven-Panton					
VERMONT AGENCY OF TRANSPORTATION							TOWN TOTALS	357.4	0.0	58.0	0.0	0.0	69	1.0	0.0	56	840.0							PROJECT NUMBER: STPG SIGN(24)					
								SF	SF	EA	EA	EA	EA	EA	EA	EA	FT							FILE NAME: Addison.xls					
																								PLOT DATE: 4/29/2009					
																								PROJECT MANAGER: N. Avery					
																								DRAWN BY: I. Shea					
																								DESIGNED BY: M. Miller					
																								CHECKED BY: S. Menard					
																								ADDISON SHEET 13					
																								SHEET 110 OF 117					