

STATE OF VERMONT AGENCY OF TRANSPORTATION




PROPOSED IMPROVEMENT TOWNS OF HALIFAX AND WHITINGHAM COUNTY OF WINDHAM VERMONT ROUTE 112

BEGINNING AT THE VERMONT-MASSACHUSETTS STATE LINE ON VT ROUTE 112 IN THE TOWN OF HALIFAX AT THE MILE MARKER 0.000 AND EXTENDING NORTHERLY ALONG VT ROUTE 112 FOR A DISTANCE OF 7.450 MILES TO THE INTERSECTION OF VT ROUTE 112 AND VT ROUTE 100 AT MILE MARKER 1.604 IN THE TOWN OF WHITINGHAM.


LENGTH OF ROADWAY = 7.450 MILES
LENGTH OF PROJECT = 7.450 MILES

WORK TO BE PERFORMED UNDER THIS PROJECT INCLUDES THE REMOVAL OF EXISTING SIGNS AND POSTS AND THE INSTALLATION OF NEW SIGNS AND SIGN POSTS AND INCIDENTAL ITEMS.

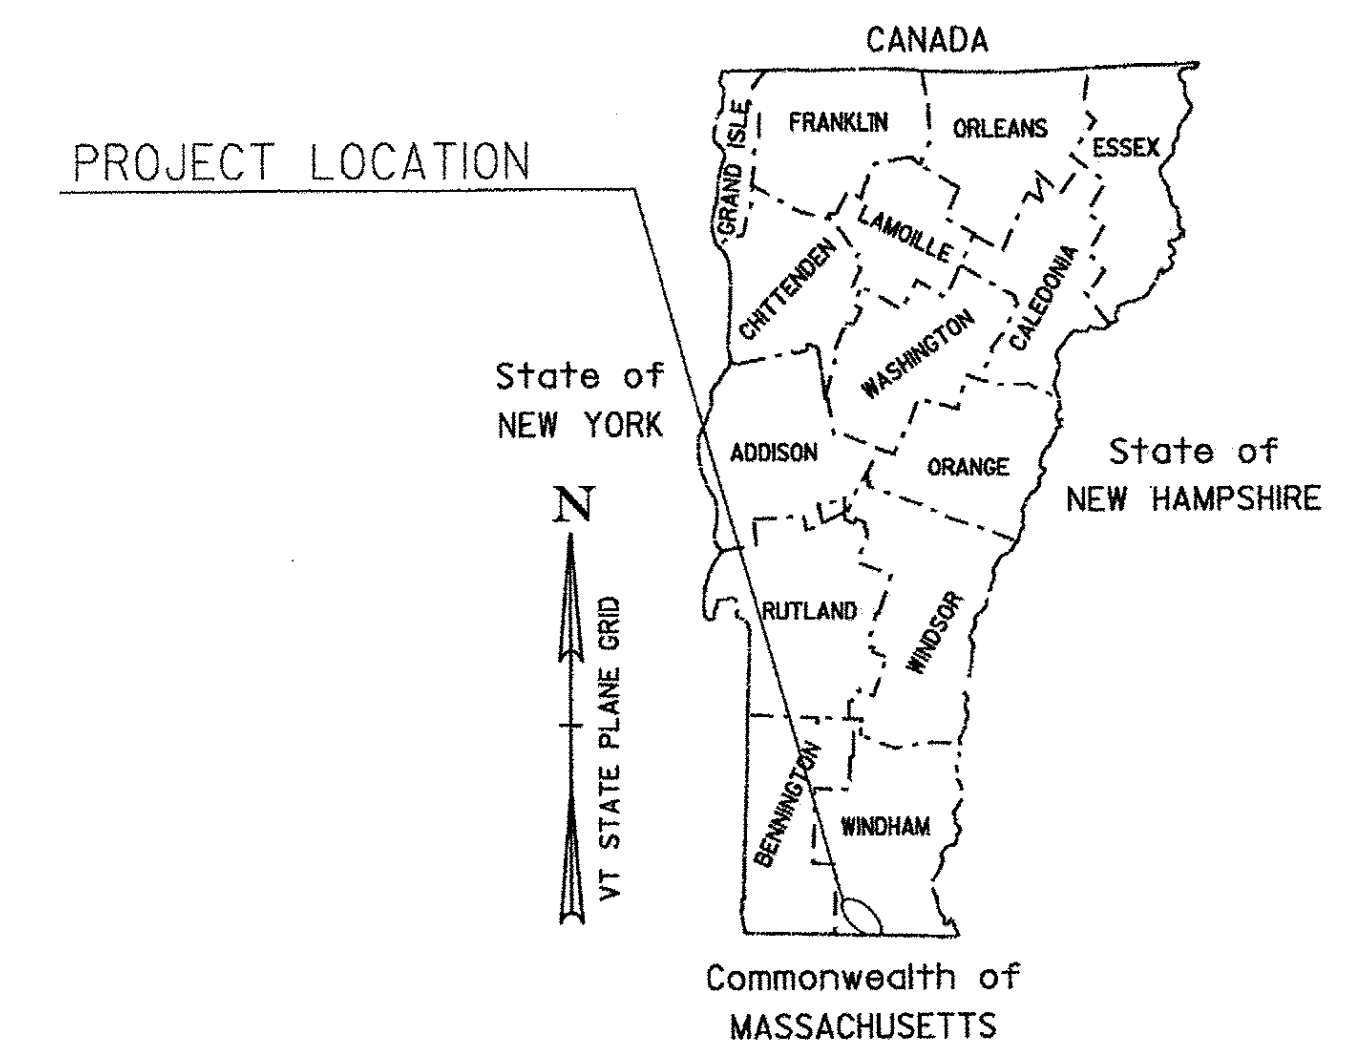

INDEX OF SHEETS
SEE SHEET 2

RECORD PLANS	
CONTRACTOR:	F. R. LAFAYETTE, INC. - ESSEX JUNCTION, VT
RESIDENT ENGINEER:	MARK HAUGHWOUT
CONSTRUCTION BEGAN:	NOVEMBER 9, 2009
CONSTRUCTION COMPLETE:	APRIL 26, 2011
RECORD PLANS BY:	MARK HAUGHWOUT & C. PIERCE
<p>I HEREBY CERTIFY THAT ALL THE CONSTRUCTION REQUIRED BY THIS SET OF DRAWINGS HAS BEEN ACCOMPLISHED AS INDICATED HEREIN.</p> <p>BY <i>Mark W. Haughwout</i> RESIDENT ENGINEER DATE <i>April 10, 2012</i></p>	
<p>NOTE: Any further information concerning final quantities, amounts or other details relative to this project may be found at Central Files in the electronic archives.</p>	

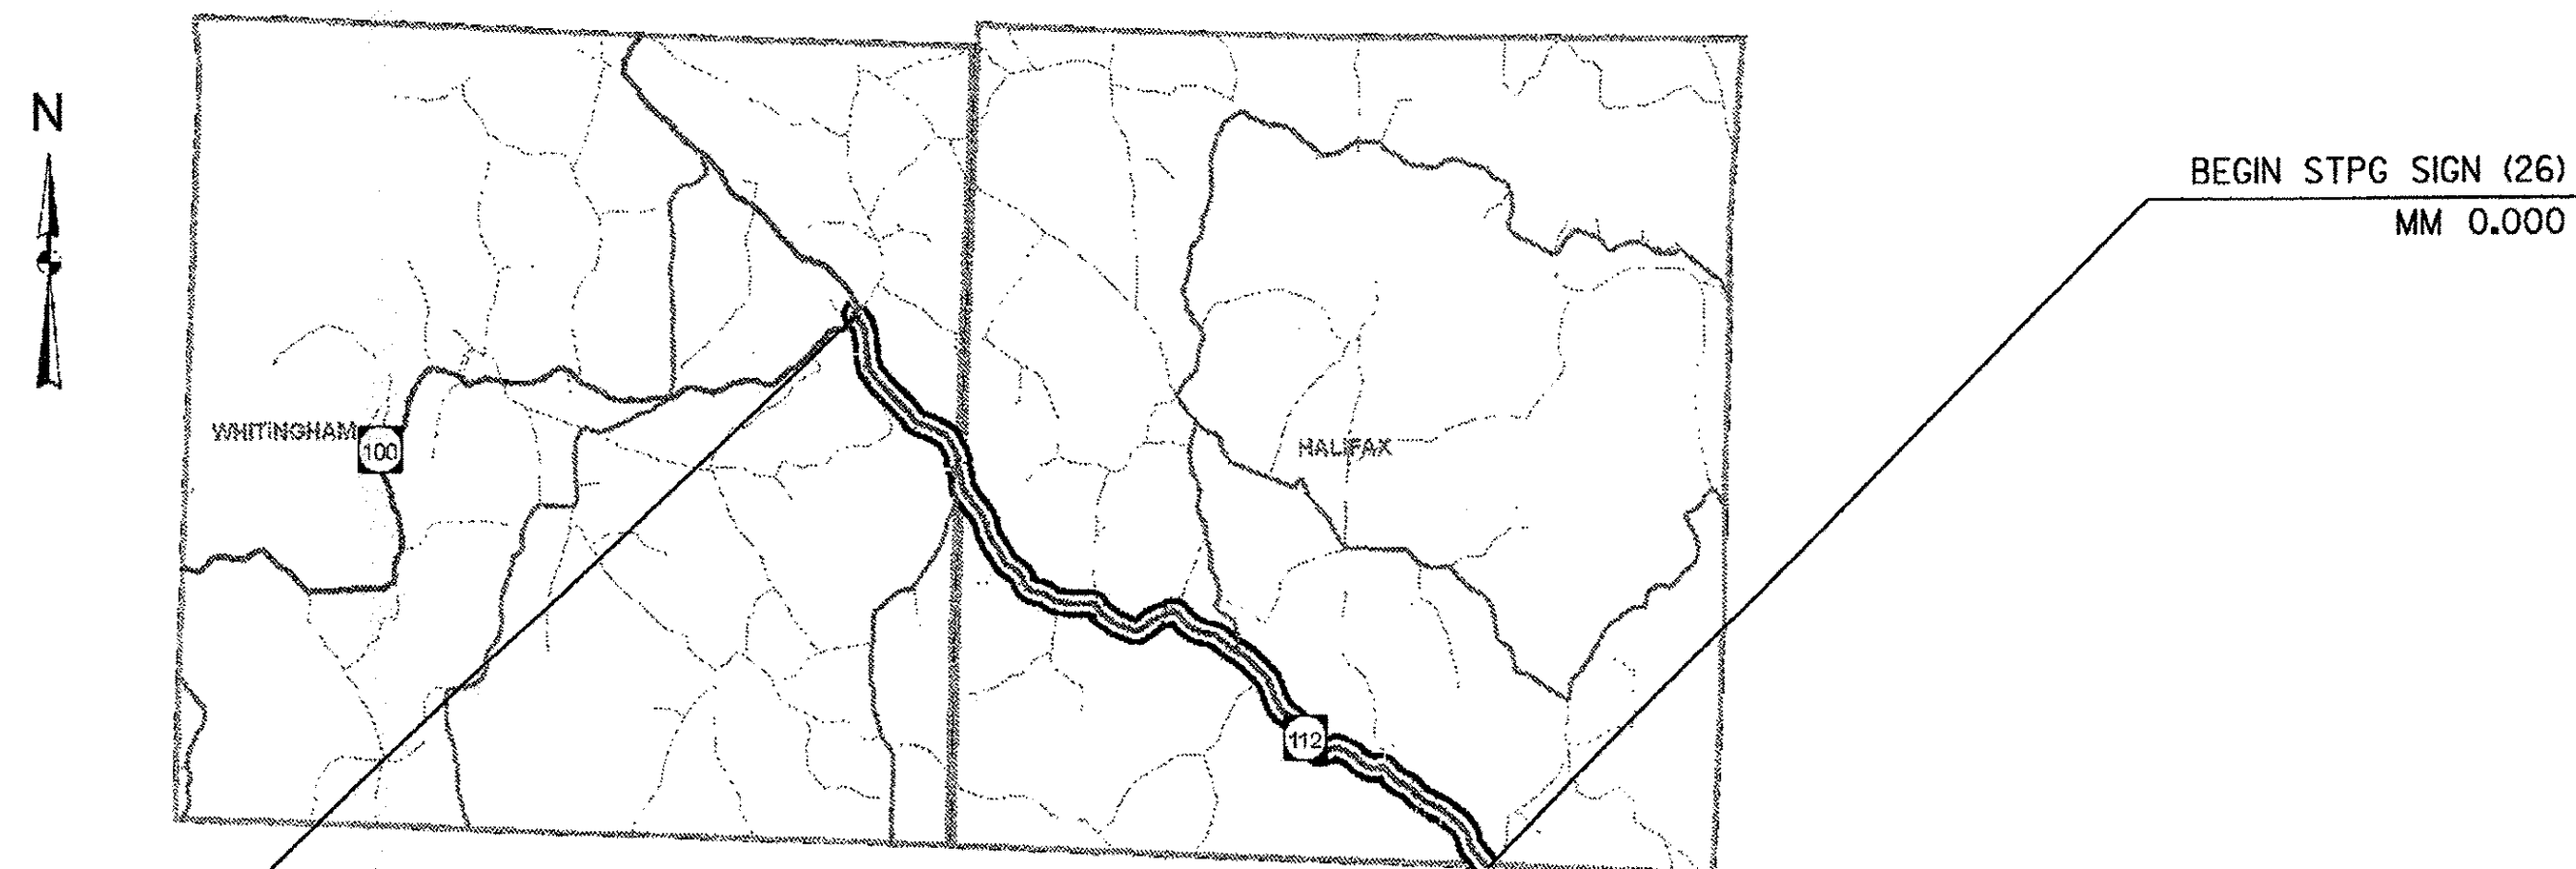

CONVENTIONAL SYMBOLS	
COUNTY LINE	
TOWN LINE	
LIMITS OF ACCESS	
POINT OF ACCESS	
FENCE LINE	
STONE WALL	
TRAVELED WAY	
GUARD RAIL	
RAILROAD	
SURVEY LINE	
CULVERT	
POWER POLE	
TELEPHONE POLE	
TREES	
CONTROL OF ACCESS	
PROPERTY LINE	
R.O.W. TAKING LINE	
SLOPE RIGHTS	
TOP OF CUT	
TOE OF SLOPE	

SURVEYED BY :	N/A
SURVEYED DATE :	N/A
DATUM	
VERTICAL	N/A
HORIZONTAL	N/A

THESE PLANS ARE SUBJECT TO SUCH ENGINEERING CHANGES AS MAY BE REQUIRED BY THE FEDERAL HIGHWAY ADMINISTRATION OR THE DIRECTOR OF PROGRAM DEVELOPMENT.

CONSTRUCTION IS TO BE CARRIED ON IN ACCORDANCE WITH THESE PLANS AND THE STANDARD SPECIFICATIONS FOR CONSTRUCTION DATED 2006, AS APPROVED BY THE FEDERAL HIGHWAY ADMINISTRATION ON JUNE 15, 2006 FOR USE ON THIS PROJECT, INCLUDING ALL SUBSEQUENT REVISIONS AND SUCH REVISED SPECIFICATIONS AND SPECIAL PROVISIONS AS ARE INCORPORATED IN THESE PLANS.

DIRECTOR OF PROGRAM DEVELOPMENT	
APPROVED <i>Richard J. Heavey</i>	DATE <i>6/24/09</i>
PROJECT MANAGER :	AMY GAMBLE
PROJECT NAME :	HALIFAX - WHITINGHAM
PROJECT NUMBER :	STPG SIGN (26)
SHEET 1 OF	SHEETS 46