


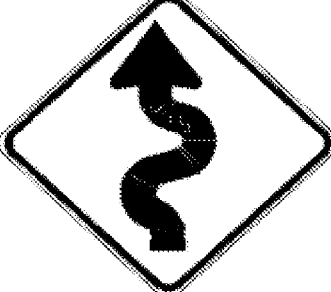



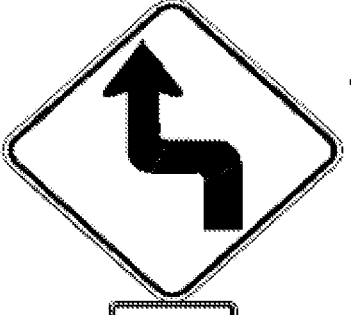



DIRECTION	MILEPOINT	LOCATION CODE (SHEET 2)	SIGN CODE	WIDTH (IN)	HEIGHT (IN)	SHEETING REMARKS	SIGN LEGEND	NEW SIGNS		EXISTING SIGNS				EXIST POST		NUMBER OF NEW POSTS	SQUARE STEEL (IN)			TUBULAR STEEL Ø (IN)				SIGN FRAME REQUIRED	REMARKS	SIGN DETAIL		
								"A"	"B"	RETAIN	SALVAGE FROM	SALVAGE TO	REMOVE	RETAIN	REMOVE		1.75	2.00	2.50	3.00	3.50	4.00	5.00			DETAIL IN SHS	DETAIL ON SHEET NUMBER	DETAIL ON STD SHEET NUMBER
																	(LB / FT)			(LB / FT)								
HALIFAX VT 112							FY-FLUORESCENT YELLOW FYG-FLUORESCENT YELLOW GREEN															"SHS"-STANDARD HIGHWAY SIGNS						
			A VR-654	24	24			4.00							1	14.5	X								E-143			
			A VR-655	24	18			3.00																	6			
NB	0.215		A VR-601A	24	30		BUCKLE UP IT'S THE LAW						1		X													
NB	0.265		A VR-048	24	30		STATE LAW STOP FOR SCHOOL BUS FLASHING RED LIGHTS						1		X													
			VR-023B	24	30		  	5.00							1	13.5	X								E-144			
NB	0.403		A W1-5L	30	30	FY		6.25							1	15.5	X							INSTALL 10 FT ± SOUTH OF POLE # VTEL / 6181 / 63 / NET / 224.	X			
			A W7-3A	24	18	FY		3.00																	X			
NB	0.690		C VR-017	24	30								1		X										STOWE MOUNTAIN RD (TH-30)			
			C VR-017	24	30			5.00							1	11.5	X								E-141			
NB	0.700		D R1-1	30	30								1		X										STOWE MOUNTAIN RD (TH-30)			
			D R1-1	30	30			6.25							1	13.5	X								X			
NB	0.810		A unknown	30	30		WATCH FOR FALLEN ROCK						1		X													
NB	1.105		A W1-3L	30	30	FY	 	6.25							1	15	X								INSTALL 80 FT ± SOUTH OF EXISTING SIGN JUST AHEAD.	X		
			A W13-1	18	18	FY		2.25 3.00																	X			
NB	1.120		A W1-3L	30	30		REVERSE TURN LEFT SYMBOL						1		X													
SIGN SUMMARY SHEET							SHEET TOTALS	41.00 41.75	0.00	0	0	0	6	0	0	6	-90	83.5							PROJECT NAME: Halifax-Whitingham VT112			
VERMONT AGENCY OF TRANSPORTATION							TOWN TOTALS	640.7	0.0	5.0	10.0	10.0	176	0.0	0.0	111	1665.0								PROJECT NUMBER: STPG SIGN(26)			
								SF	SF	EA	EA	EA	EA	EA	EA	EA	FT							FILE NAME: Halifax.xls	PLOT DATE: 6/22/2009			
																								PROJECT MANAGER: N. Avery	DRAWN BY: I. Shea			
																								DESIGNED BY: M. Miller	CHECKED BY: S. Menard			
																								HALIFAX SHEET 2	SHEET 9 OF 46			