
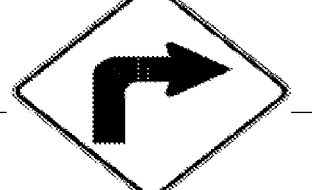



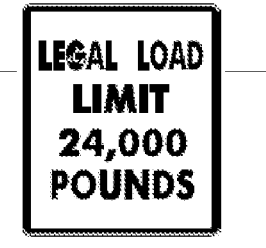

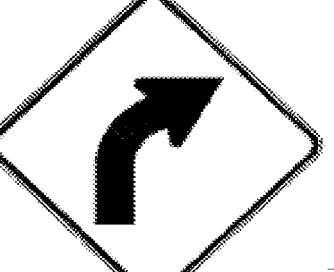



| DIRECTION                        | MILEPOINT | LOCATION CODE (SHEET 2) | SIGN CODE | WIDTH (IN) | HEIGHT (IN) | SHEETING REMARKS   | SIGN LEGEND   | NEW SIGNS |      | EXISTING SIGNS |              |            |        | EXIST POST |        | NUMBER OF NEW POSTS | SQUARE STEEL (IN) |      |        | TUBULAR STEEL Ø (IN) |           |      |                               | SIGN FRAME REQUIRED   | REMARKS                                       | SIGN DETAIL                  |               |                        |                            |
|----------------------------------|-----------|-------------------------|-----------|------------|-------------|--|---|-----------|------|----------------|--------------|------------|--------|------------|--------|---------------------|-------------------|------|--------|----------------------|-----------|------|-------------------------------|---|---|------------------------------|---------------|------------------------|----------------------------|
|                                  |           |                         |           |            |             |  |   | "A"       | "B"  | RETAIN         | SALVAGE FROM | SALVAGE TO | REMOVE | RETAIN     | REMOVE |                     | 1.75              | 2.00 | 2.50   | FOUNDATION           | 3.00      | 3.50 | 4.00                          |   |   | 5.00                         | DETAIL IN SHS | DETAIL ON SHEET NUMBER | DETAIL ON STD SHEET NUMBER |
|                                  |           |                         |           |            |             |  |   |           |      |                |              |            |        |            |        |                     | (LB / FT)         |      |        |                      | (LB / FT) |      |                               |   |   |                              |               |                        |                            |
| <b>HALIFAX VT 112</b>            |           |                         |           |            |             |  | FY-FLUORESCENT YELLOW<br>FYG-FLUORESCENT YELLOW GREEN |           |      |                |              |            |        |            |        |                     |                   |      |        |                      |           |      | "SHS"-STANDARD HIGHWAY SIGNS  |   |   |                              |               |                        |                            |
| SB                               | 3.545     | F W7-1B                 | 30        | 30         | FY          |   | 6.25  |           |      |                |              |            |        | 2          |        |                     | 17<br>17<br>X     |      |        |                      |           |      |                               | INSTALL ON TWO POSTS 80 FT ± SOUTH OF DESTINATIONS SIGNS THAT WERE JUST REMOVED.                      | X   |                              |               |                        |                            |
|                                  |           | F W1-1R                 | 30        | 30         | FY          |   | 6.25  |           |      |                |              |            |        |            |        |                     |                   |      |        |                      |           |      |                               | HILL SYMBOL ON TOP, RIGHT TURN SYMBOL BELOW THAT, ADVISORY PLAQUE ON LEFT-SIDE POST.                  | X   |                              |               |                        |                            |
|                                  |           | F W13-1                 | 18        | 18         | FY          |   | 2.25  |           |      |                |              |            |        |            |        |                     |                   |      |        |                      |           |      |                               | GRADE ON HILL SYMBOL IS 9%.   | X   |                              |               |                        |                            |
| SB                               | 3.165     | F W1-4R                 | 30        | 30         |             | RIGHT REVERSE CURVE SYMBOL   |   |           |      |                |              | 1          |        |            |        |                     |                   |      |        |                      |           |      |                               |   |   |                              |               |                        |                            |
| SB                               | 3.065     | F VW-619                | 30        | 30         |             | SHOULDER NARROWS   |   |           |      |                |              | 1          |        |            |        |                     |                   |      |        |                      |           |      |                               |   |   |                              |               |                        |                            |
| SB                               | 2.895     | F D1-1A                 | 72        | 12         |             |   | 6.00  |           |      |                |              |            |        | 2          |        |                     | 12<br>12.5<br>X   |      |        |                      |           |      |                               | INSTALL 125 FEET ± IN ADVANCE OF (NORTH OF) UTILITY POLE ON RIGHT / 340 FT ± NORTH OF DRIVE ON RIGHT. |   |                              | 5             |                        |                            |
| SB                               | 2.770     | F M3-3                  | 24        | 12         |             |  | 2.00  |           |      |                |              |            |        | 1          |        |                     | 15<br>X           |      |        |                      |           |      |                               | GREEN ON WHITE SHEETING. INSTALL 125 FEET SOUTH OF JCT WITH BRANCH RD (TH-1).                         | X   |                              |               |                        |                            |
|                                  |           | F M1-5                  | 30        | 24         |             |  | 5.00  |           |      |                |              |            |        |            |        |                     |                   |      |        |                      |           |      |                               |   |   |                              | E-136B        |                        |                            |
| SB                               | 2.580     | G VR-017                | 24        | 24         |             |  |   |           |      |                |              |            |        |            |        |                     |                   |      |        |                      |           |      |                               | PENNEL HILL ROAD (TH-37)  |   |                              |               |                        |                            |
|                                  |           | G VR-017                | 24        | 30         |             |  | 5.00  |           |      |                |              |            |        | 1          |        |                     | 11.5<br>X         |      |        |                      |           |      |                               | OLD SIGN MISSING - NO REMOVAL   |   |                              | E-141         |                        |                            |
| SB                               | 2.572     | F R1-1                  | 24        | 24         |             |  |   |           |      |                |              |            |        |            |        |                     |                   |      |        |                      |           |      |                               | PENNEL HILL ROAD (TH-37)  |   |                              |               |                        |                            |
|                                  |           | F R1-1                  | 30        | 30         |             |  | 6.25  |           |      |                |              |            |        | 1          |        |                     | 13.5<br>X         |      |        |                      |           |      |                               | OLD SIGN MISSING - NO REMOVAL   | X   |                              |               |                        |                            |
| SB                               | 2.150     | F W1-2R                 | 30        | 30         |             |  |   |           |      |                |              | 1          |        |            |        |                     |                   |      |        |                      |           |      |                               |   |   |                              |               |                        |                            |
|                                  |           | F W1-2R                 | 30        | 30         | FY          |  | 6.25  |           |      |                |              |            |        | 1          |        |                     | 15<br>X           |      |        |                      |           |      |                               |   |   |                              | X             |                        |                            |
|                                  |           | F W13-1                 | 18        | 18         | FY          |   | 2.25  |           |      |                |              |            |        |            |        |                     |                   |      |        |                      |           |      |                               |   |   |                              | X             |                        |                            |
| <b>SIGN SUMMARY SHEET</b>        |           |                         |           |            |             |  | SHEET TOTALS  | 47.50     | 0.00 | 0              | 0            | 0          | 3      | 0          | 0      | 8                   |                   |      | -120   | 113.5                |           |      |                               |   | PROJECT NAME: <b>Halifax-Whitingham VT112</b> |                              |               |                        |                            |
| VERMONT AGENCY OF TRANSPORTATION |           |                         |           |            |             |  | TOWN TOTALS   | 640.7     | 0.0  | 5.0            | 10.0         | 10.0       | 176    | 0.0        | 0.0    | 111                 |                   |      | 1665.0 |                      |           |      |                               | PROJECT NUMBER: <b>STPG SIGN(26)</b>  | FILE NAME: <b>Halifax.xls</b>                 | PLOT DATE: <b>6/22/2009</b>  |               |                        |                            |
|                                  |           |                         |           |            |             |  |   | SF        | SF   | EA             | EA           | EA         | EA     | EA         | EA     | EA                  | FT                |      |        |                      |           |      | DESIGNED BY: <b>M. Miller</b> | CHECKED BY: <b>S. Menard</b>  | DRAWN BY: <b>I. Shea</b>                      | SHEET <b>25</b> OF <b>46</b> |               |                        |                            |