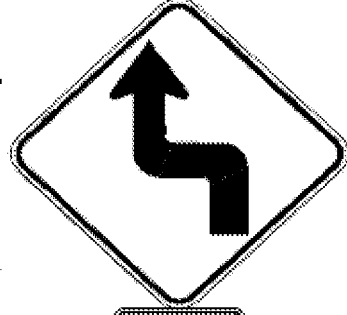




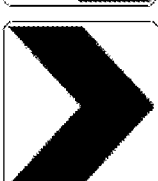
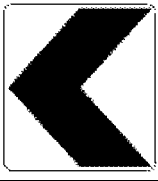


DIRECTION	MILEPOINT	LOCATION CODE (SHEET 2)	SIGN CODE	WIDTH (IN)	HEIGHT (IN)	SHEETING REMARKS	SIGN LEGEND	NEW SIGNS		EXISTING SIGNS				EXIST POST		NUMBER OF NEW POSTS	SQUARE STEEL (IN)			TUBULAR STEEL Ø (IN)				SIGN FRAME REQUIRED	REMARKS	SIGN DETAIL			
								"A"	"B"	RETAIN	SALVAGE FROM	SALVAGE TO	REMOVE	RETAIN	REMOVE		1.75	2.00	2.50	3.00	3.50	4.00	5.00			DETAIL IN SHS	DETAIL ON SHEET NUMBER	DETAIL ON STD SHEET NUMBER	
																	(LB / FT)			(LB / FT)									
<b>HALIFAX VT 112</b>							FY-FLUORESCENT YELLOW FYG-FLUORESCENT YELLOW GREEN															"SHS"-STANDARD HIGHWAY SIGNS							
SB	1.375	F W1-3L		30	30		REVERSE TURN LEFT																						
		F W13-1		18	18		30 MPH (PLAQUE)																						
																													
SB	1.335	F W1-3L		30	30	FY		6.25															INSTALL BEHIND RAIL 200 FT ± SOUTH OF PREVIOUS POSITON.	X					
		F W13-1		18	18	FY		2.25																X					
SB	1.295	F W1-8		18	24																								
		E W1-8		18	24																								
		F W1-8		18	24	FY		3.00																X					
		E W1-8		18	24	FY		3.00															BEHIND RAIL	X					
SB	1.280	F W1-8		18	24																								
		E W1-8		18	24																								
		F W1-8		18	24	FY		3.00																X					
		E W1-8		18	24	FY		3.00															BEHIND RAIL	X					
SB	1.265	F W1-8		18	24																								
		E W1-8		18	24																								
		F W1-8		18	24	FY		3.00																X					
<b>SIGN SUMMARY SHEET</b>							<b>SHEET TOTALS</b>	23.50	0.00	0	0	0	8	0	0	6									PROJECT NAME: <b>Halifax-Whitingham VT112</b>				
							SF	SF	EA	EA	EA	EA	EA	EA	EA	EA									PROJECT NUMBER: <b>STPG SIGN(26)</b>				
VERMONT AGENCY OF TRANSPORTATION							<b>TOWN TOTALS</b>	640.7	0.0	5.0	10.0	10.0	176	0.0	0.0	111										FILE NAME: <b>Halifax.xls</b>			
																										PLOT DATE: <b>6/22/2009</b>			
																											DRAWN BY: <b>I. Shea</b>		
																											DESIGNED BY: <b>M. Miller</b>		
																											CHECKED BY: <b>S. Menard</b>		
																											SHEET <b>30</b> OF <b>46</b>		