


STATE OF VERMONT
AGENCY OF TRANSPORTATION



PROPOSED IMPROVEMENT
TOWNS OF BARRE TOWN, ORANGE, GROTON & RYEGATE
COUNTIES OF WASHINGTON, ORANGE & CALEDONIA
US ROUTE 302

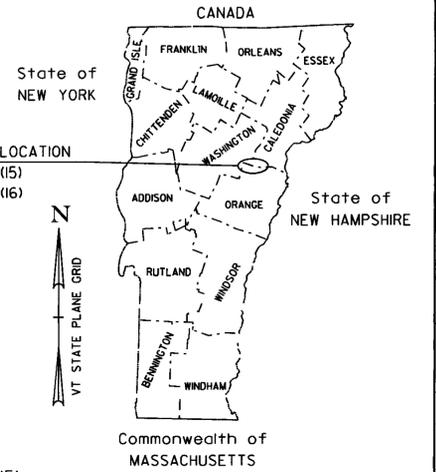


BEGIN STP SURF(15)
MM 0.000 (BARRE TOWN)

STOP STP SURF(15)
MM 2.494 (BARRE TOWN)

RESUME STP SURF(15)
MM 2.608 (BARRE TOWN)

END STP SURF(15)
MM 6.050 (ORANGE)

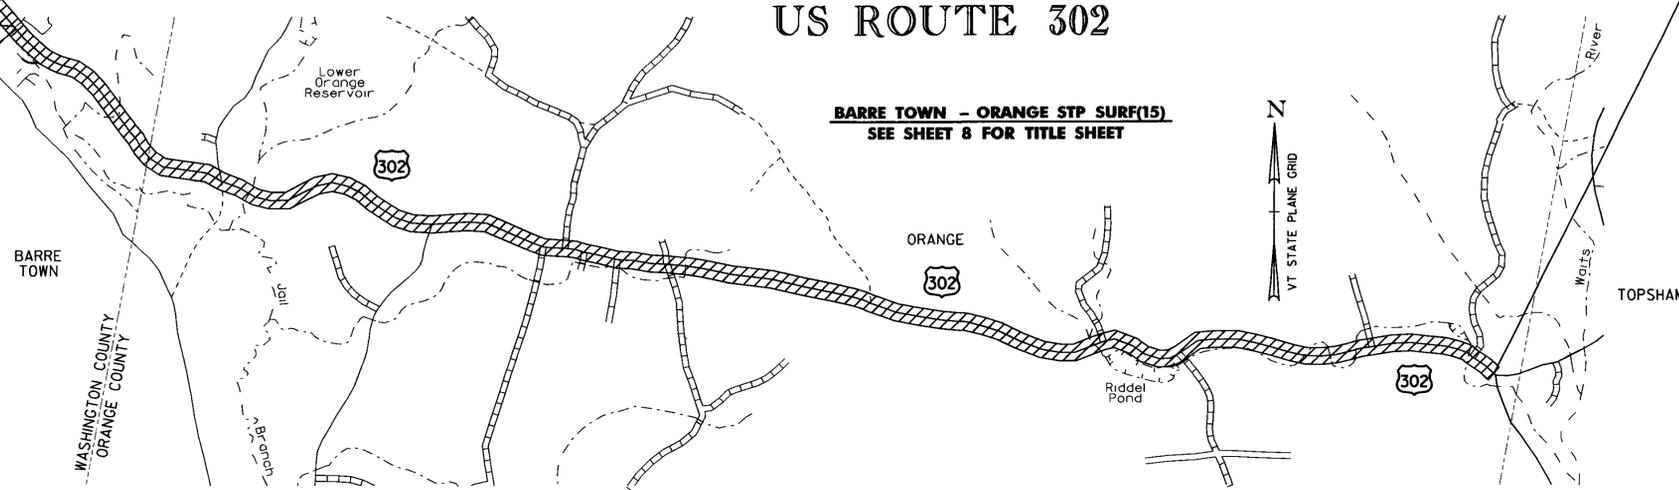

BARRE TOWN - ORANGE STP SURF(15)
SEE SHEET 8 FOR TITLE SHEET

END STP SURF(16)
MM 1.304 (RYEGATE)

BEGIN STP SURF(16)
MM 6.987 (GROTON)

GROTON - RYEGATE STP SURF(16)
SEE SHEET 18 FOR TITLE SHEET

CONVENTIONAL SYMBOLS

COUNTY LINE		COUNTY LINE
TOWN LINE		TOWN LINE
LIMITS OF ACCESS		
POINT OF ACCESS		
FENCE LINE		
STONE WALL		
TRAVELED WAY		
GUARD RAIL		
RAILROAD		
SURVEY LINE		
CULVERT		
POWER POLE		
TELEPHONE POLE		
TREES		
CONTROL OF ACCESS		
PROPERTY LINE		
R.O.W. TAKING LINE		
SLOPE RIGHTS		
TOP OF CUT		
TOE OF SLOPE		

RECORD PLANS

CONTRACTOR: ALL STATES ASPHALT, INC - SUNDERLAND, MA

RESIDENT ENGINEER: JOHN SLADYK

CONSTRUCTION BEGAN: JUNE 14, 2010

CONSTRUCTION COMPLETE: AUGUST 11, 2010

RECORD PLANS BY: JOHN SLADYK & CRAIG PIERCE

I HEREBY CERTIFY THAT ALL THE CONSTRUCTION REQUIRED BY THIS SET OF DRAWINGS HAS BEEN ACCOMPLISHED AS INDICATED HEREIN

BY: *John W. Sladyk* RESIDENT ENGINEER

DATE: 3-25-11

NOTE: Any further information concerning final quantities, amounts or other details relative to this project may be found at Central Files in the electronic archives

THESE PLANS ARE SUBJECT TO SUCH ENGINEERING CHANGES AS MAY BE REQUIRED BY THE FEDERAL HIGHWAY ADMINISTRATION OR THE DIRECTOR OF PROGRAM DEVELOPMENT.

CONSTRUCTION IS TO BE CARRIED ON IN ACCORDANCE WITH THESE PLANS AND THE STANDARD SPECIFICATIONS FOR CONSTRUCTION DATED 2006, AS APPROVED BY THE FEDERAL HIGHWAY ADMINISTRATION ON JUNE 15, 2006 FOR USE ON THIS PROJECT, INCLUDING ALL SUBSEQUENT REVISIONS AND SUCH REVISED SPECIFICATIONS AND SPECIAL PROVISIONS AS ARE INCORPORATED IN THESE PLANS.

DIRECTOR OF PROGRAM DEVELOPMENT	APPROVED: <i>Richard Johnson</i>	DATE: 12-7-09
PROJECT MANAGER:	KEVIN MARSHIA	
PROJECT NAME:	BARRE TOWN - ORANGE/GROTON - RYEGATE	
PROJECT NUMBER:	STP SURF (15) / STP SURF (16)	
SHEET 1 OF 24 SHEETS		