


NOTE:
 THIS SHEET TO BE USED FOR THE LAYOUT OF ALL CENTERLINE PAVEMENT MARKINGS.
 THE RESIDENT ENGINEER MAY CONTACT KEITH SWEET, PAVEMENT MARKING SUPERVISOR AT (802) 828-5573
 FOR ASSISTANCE LAYING OUT THE CENTERLINE DURING CONSTRUCTION.

ALL PAINT PAVEMENT MARKINGS SHALL BE WATERBORNE PAINT AND WILL BE APPLIED TWICE.
 THE PROJECT QUANTITIES HAVE BEEN ESTIMATED AND MULTIPLIED BY A FACTOR OF TWO TO ALLOW
 FOR THE DOUBLE APPLICATION.

N.T.S.

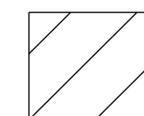

PROJECT AREA

PAVEMENT MARKING LAYOUT #3	PROJECT NAME: BARRE TOWN - ORANGE	
	PROJECT NUMBER: STP SURF(15)	
	FILE NAME: p09b038.dgn	PLOT DATE: 10-NOV-2011
PROJECT LEADER: MARSHIA	DRAWN BY: LOCKE	
DESIGNED BY: LOCKE	CHECKED BY: PAVT MGMT	
p09b038pm3.i	SHEET 14 OF 24	