


**BEGIN PROJECT
MM 1.304**

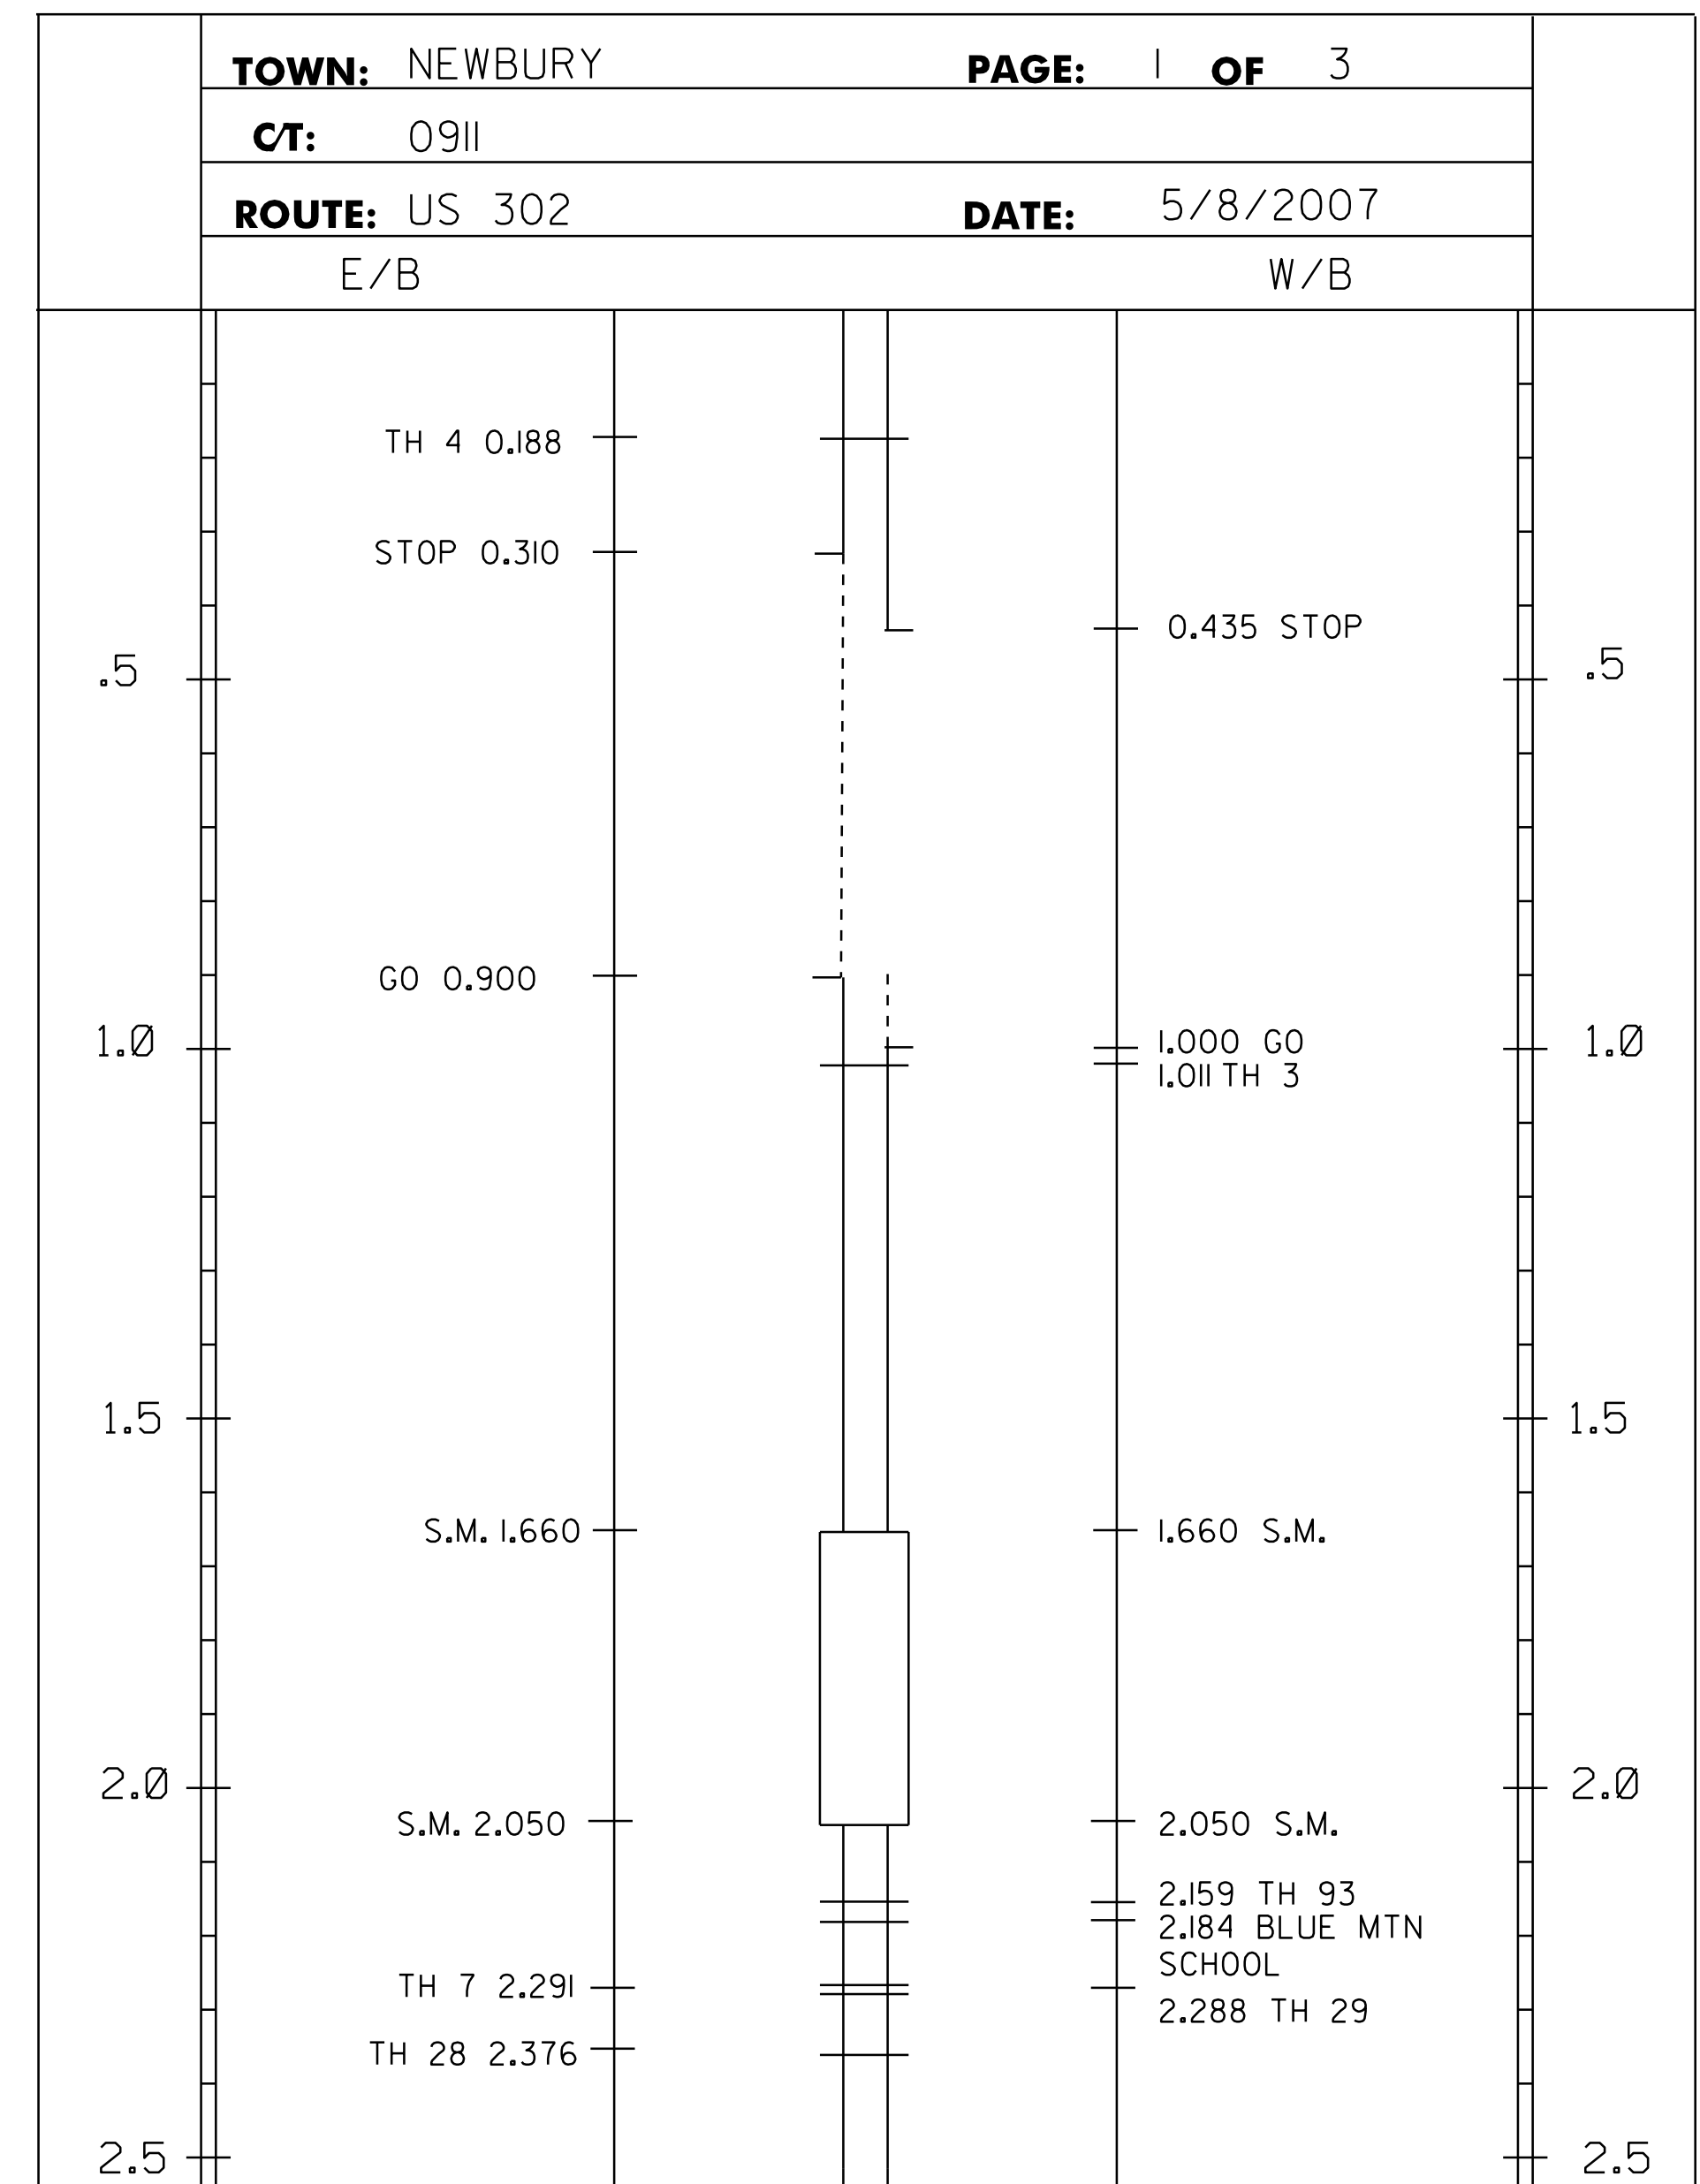

NOTE:

THIS SHEET TO BE USED FOR THE LAYOUT OF ALL CENTERLINE PAVEMENT MARKINGS.
 THE RESIDENT ENGINEER MAY CONTACT KEITH SWEET, PAVEMENT MARKING SUPERVISOR AT (802) 828-5573 FOR ASSISTANCE IN LAYING OUT THE CENTERLINE DURING CONSTRUCTION.
 ALL PAINT PAVEMENT MARKINGS SHALL BE WATERBORNE PAINT AND WILL BE APPLIED TWICE.
 THE PROJECT QUANTITIES HAVE BEEN ESTIMATED AND MULTIPLIED BY A FACTOR OF TWO TO ALLOW FOR THE DOUBLE APPLICATION. FINAL APPLICATION NO LATER THAN 17 SEPTEMBER 2010.

N.T.S.

**PAVEMENT
MARKING
LAYOUT 1**

PROJECT NAME: RYEGATE - NEWBURY
 PROJECT NUMBER: STP SURF(17)

FILE NAME: 09B042/09B042.dgn PLOT DATE: 01-AUG-2011 15:13
 PROJECT LEADER: K. MARSHIA DRAWN BY: PAVT MGMT
 DESIGNED BY: PAVT MGMT CHECKED BY: PAVT MGMT
 IPARM FILE NAME: 09B042_08.i SHEET 8 OF 10