


**BEGIN PROJECT
MM 1.304**

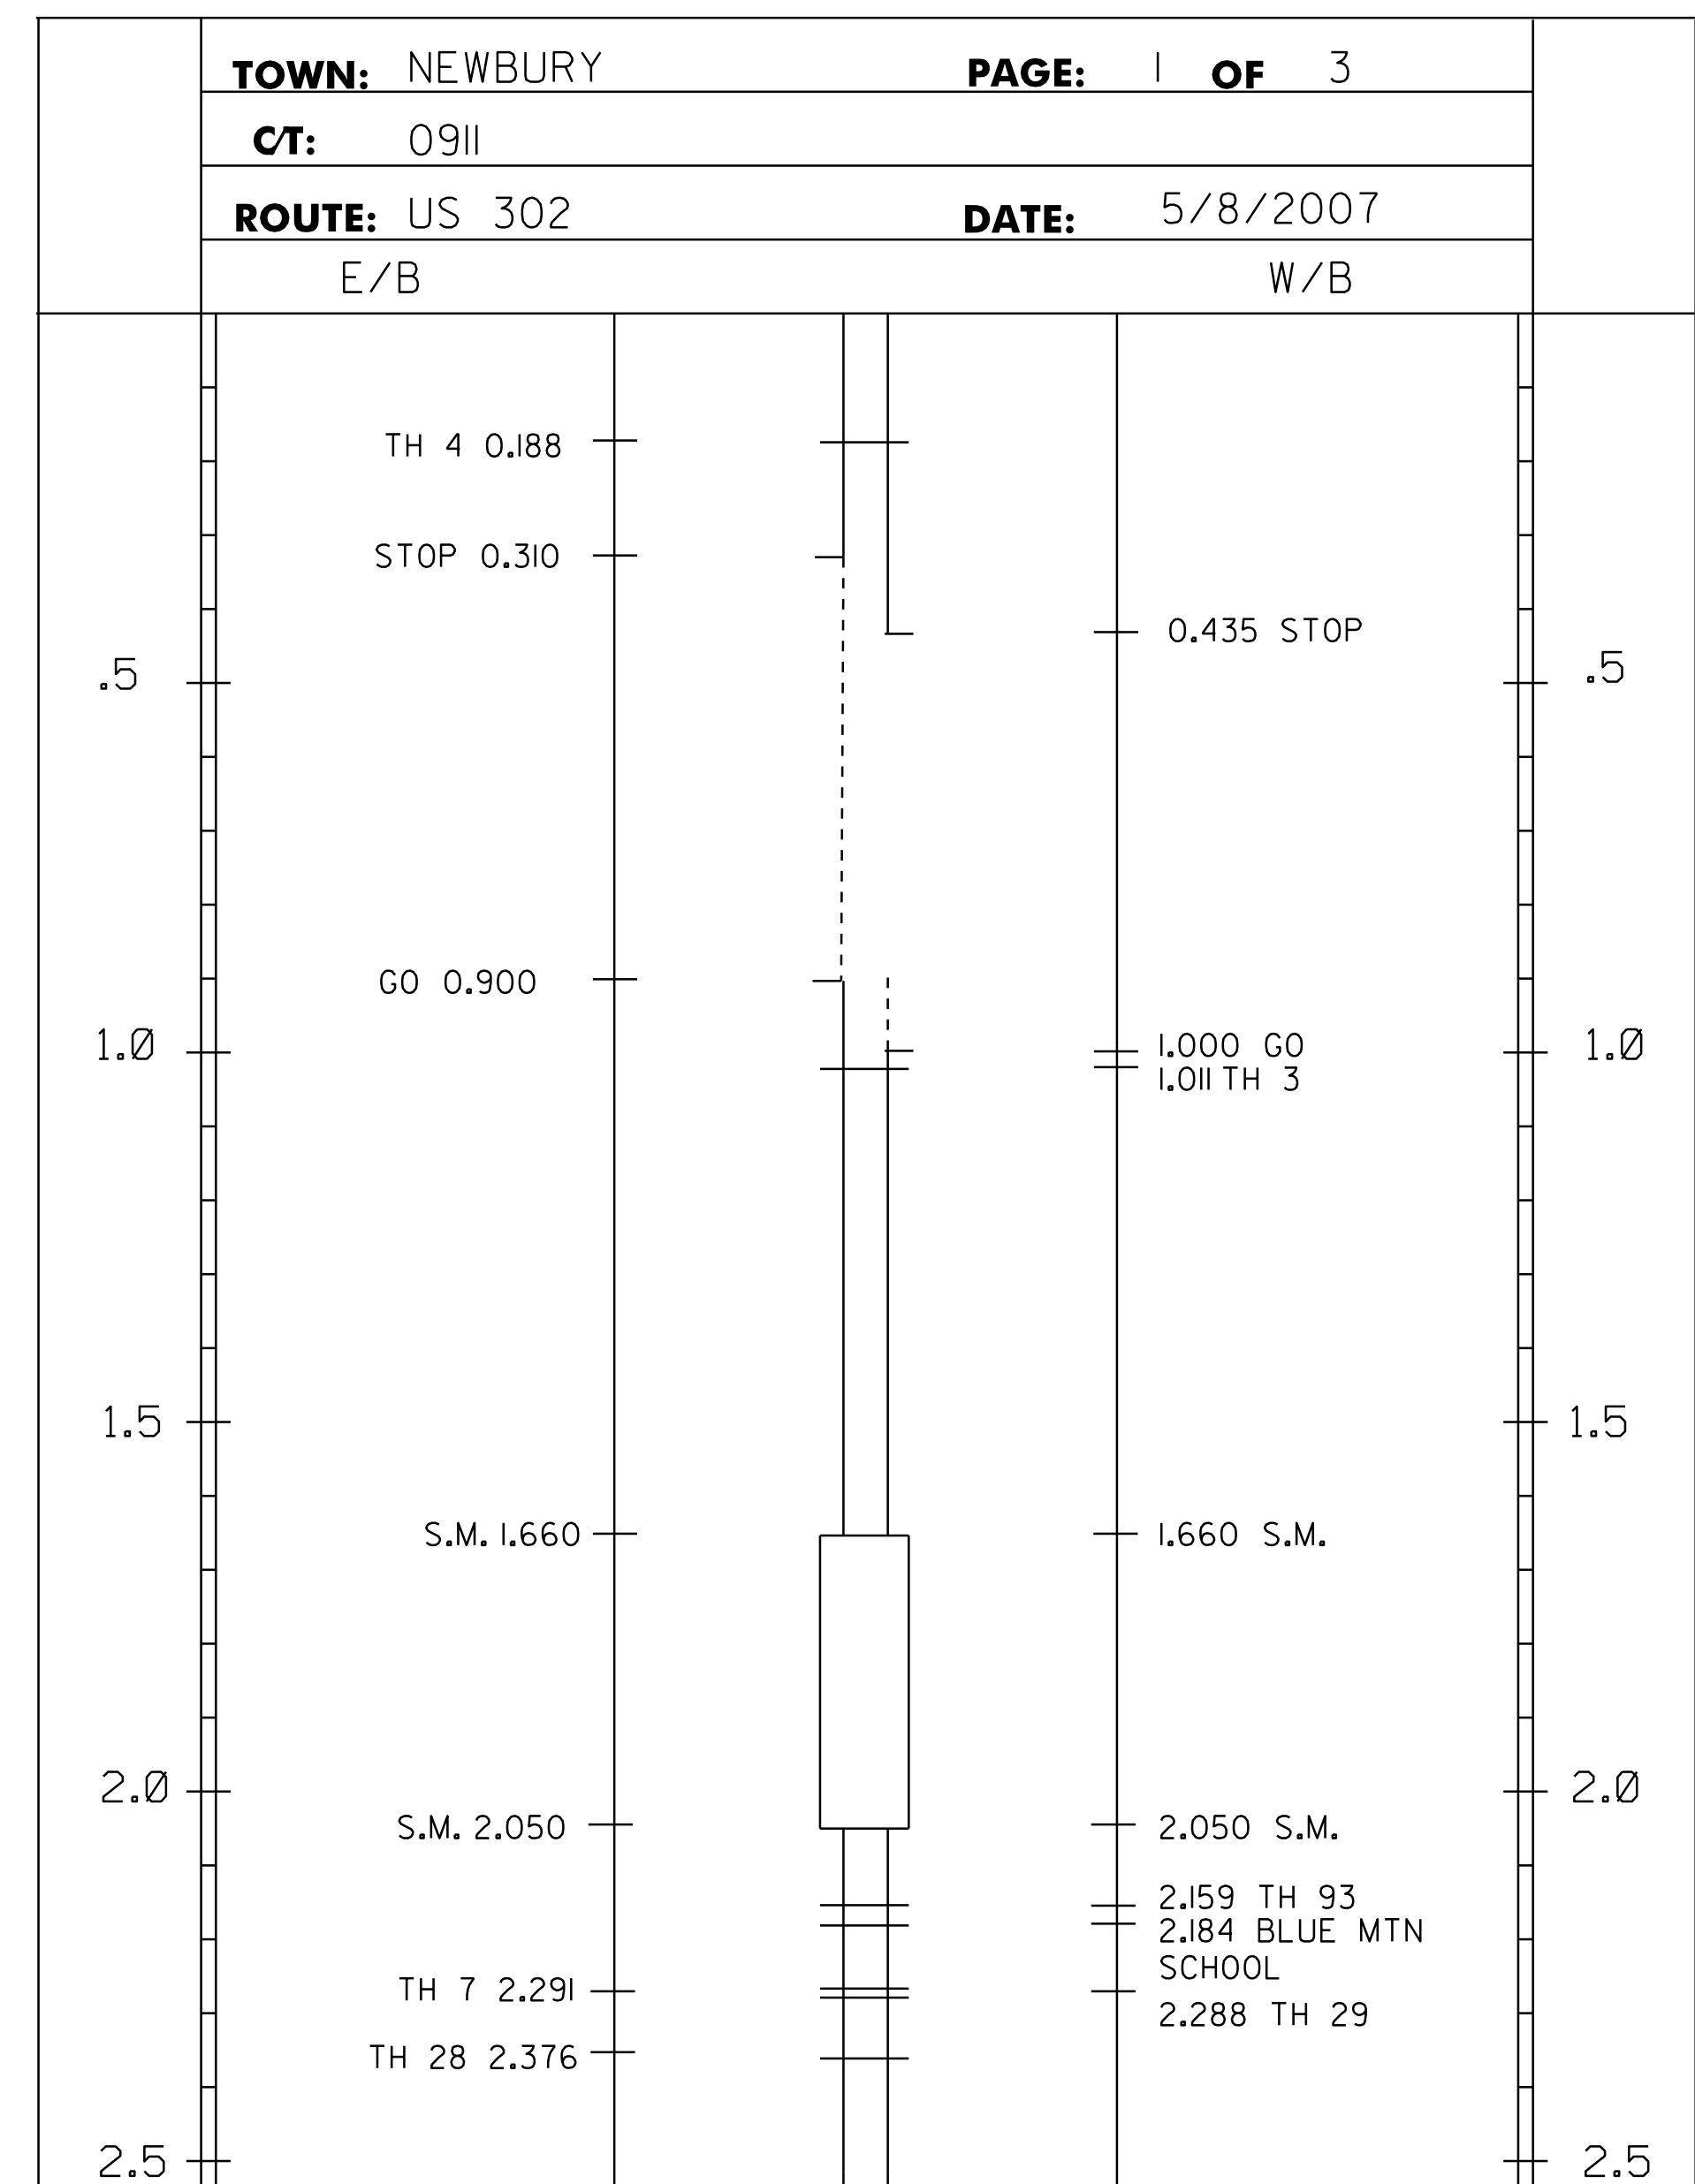

NOTE:

THIS SHEET TO BE USED FOR THE LAYOUT OF ALL CENTERLINE PAVEMENT MARKINGS.
 THE RESIDENT ENGINEER MAY CONTACT KEITH SWEET, PAVEMENT MARKING SUPERVISOR AT (802) 828-5573 FOR ASSISTANCE IN LAYING OUT THE CENTERLINE DURING CONSTRUCTION.
 ALL PAINT PAVEMENT MARKINGS SHALL BE WATERBORNE PAINT AND WILL BE APPLIED TWICE.
 THE PROJECT QUANTITIES HAVE BEEN ESTIMATED AND MULTIPLIED BY A FACTOR OF TWO TO ALLOW FOR THE DOUBLE APPLICATION. FINAL APPLICATION NO LATER THAN 17 SEPTEMBER 2010.

N.T.S.

PAVEMENT MARKING LAYOUT 1	PROJECT NAME: RYEGATE - NEWBURY
	PROJECT NUMBER: STP SURF(17)
	FILE NAME: 09B042/09B042.dgn
	PLOT DATE: 22-OCT-2012 13:11
PROJECT LEADER: K. MARSHIA	DRAWN BY: PAVT MGMT
DESIGNED BY: PAVT MGMT	CHECKED BY: PAVT MGMT
IPARM FILE NAME: 09B042_08.i	SHEET 8 OF 10