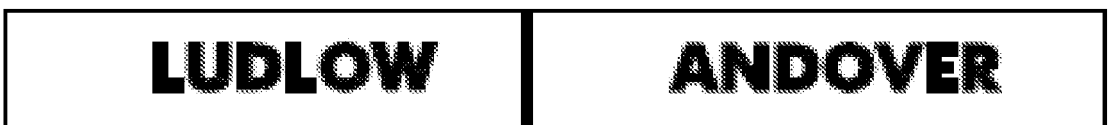
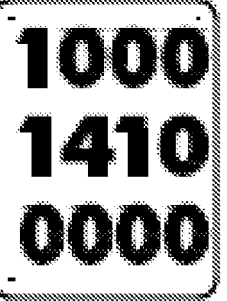
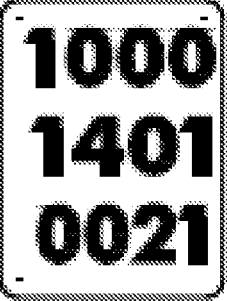
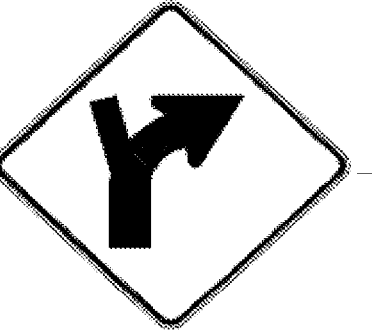
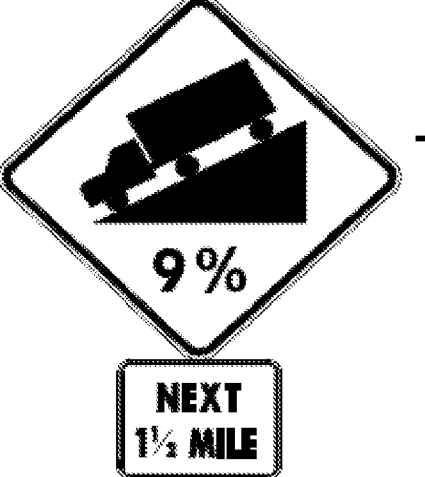


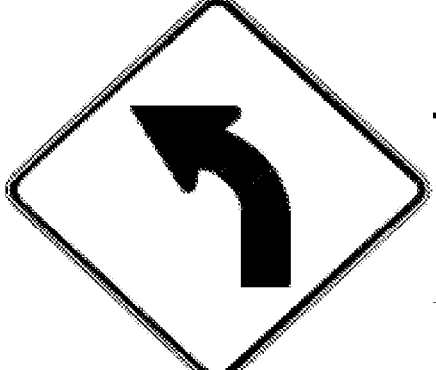



DIRECTION	MILEPOINT	LOCATION CODE (SHEET 2)	SIGN CODE	WIDTH (IN)	HEIGHT (IN)	SHEETING REMARKS	SIGN LEGEND	NEW SIGNS		EXISTING SIGNS				EXIST POST		NUMBER OF NEW POSTS	SQUARE STEEL (IN)			TUBULAR STEEL Ø (IN)				SIGN FRAME REQUIRED	REMARKS NOTE: POST LENGTHS, TOTALS AND INSTALLATION DATES ARE NOT SHOWN IN TRAFFIC SIGN SUMMARY SHEETS; THESE CAN BE FOUND IN ORIGINAL RECORD PLANS AND TOWN TOTAL SIGN SUMMARY SHEET, SHEET 202.	SIGN DETAIL			
								"A"	"B"	RETAIN	SALVAGE FROM	SALVAGE TO	REMOVE	RETAIN	REMOVE		1.75 (LB / FT)	2.00	2.50	FOUNDATION	3.00	3.50	4.00			5.00	DETAIL IN SHS	DETAIL ON SHEET NUMBER	DETAIL ON STD SHEET NUMBER
LUDLOW VT 100							FY-FLUORESCENT YELLOW FYG-FLUORESCENT YELLOW GREEN																"SHS"-STANDARD HIGHWAY SIGNS						
NB	0.000	C	VD-024	72	10			5.00																INSTALL DIRECTLY ACROSS FROM THE EXISTING TOWN LINE SIGN ON 2 NEW POSTS.		4			
		C	VD-700	6	10			0.42																LUDLOW MILE MARKER. INSTALL ON THE LEFT-SIDE POST UNDER LUDLOW.			E-138		
		C	VD-700	6	10			0.42																ANDOVER MILE MARKER. INSTALL ON THE RIGHT-SIDE POST UNDER ANDOVER.			E-138		
NB	0.135	A	W1-10R	30	30																								
		A	W1-2Mi R	30	30			6.25																		6			
NB	0.505	A	W7-1B	36	36	FY		9.00																INSTALL 240 FT± SOUTH OF THE EXISTING ASSEMBLY, WHICH WILL BE REMOVED.	X				
		A	W7-3A	30	18	FY		3.75																SPAN PLAQUE ACROSS BOTH POSTS.		6			
NB	0.550	A	W7-1B	36	36		HILL SYMBOL w/ 9% GRADE NUMBER																						
		A	W7-3A	30	18		NEXT 1-1/2 MILES (PLAQUE)																						
NB	1.266	A	W1-2L	30	30		CURVE LEFT																						
		A	W13-1	18	18		40 MPH (PLAQUE)																						
NB	1.300	A	W1-2L	30	30			6.25																INSTALL 180 FT± NORTH OF PREVIOUS POSITION	X				
		A	W13-1	18	18			2.25																	X				
NB	1.412	A	W1-6	48	24		<==== LARGE ARROW LEFT																						
SIGN SUMMARY SHEET							SHEET TOTALS	33.34	0.00	1	0	0	5	0	0	6	90							PROJECT NAME: Ludlow-Waitsfield VT100					
							SF	SF	EA	EA	EA	EA	EA	EA	EA	EA	EA	EA	EA	EA	EA	EA	EA	EA	EA	EA	EA	EA	EA
VERMONT AGENCY OF TRANSPORTATION							TOWN TOTALS	647.4	0.0	13.0	4.0	4.0	135	0.0	0.0	106	1590.0						PROJECT NUMBER: STPG SIGN(27)						
																						FILE NAME: Ludlow.xls	PLOT DATE: 9/4/2009						
																						PROJECT MANAGER: N. Avery	DRAWN BY: I. Shea						
																						DESIGNED BY: M. Miller	CHECKED BY: N. Avery						
																						LUDLOW SHEET 1	SHEET 9	OF 204					