

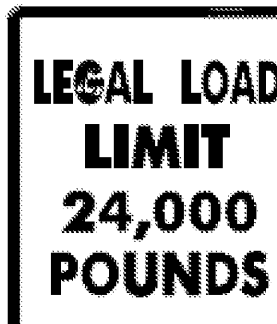

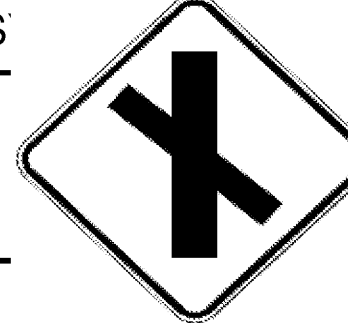
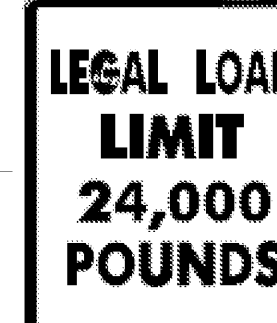


DIRECTION	MILEPOINT	LOCATION CODE (SHEET 2)	SIGN CODE	WIDTH (IN)	HEIGHT (IN)	SHEETING REMARKS	SIGN LEGEND	NEW SIGNS		EXISTING SIGNS				EXIST POST		NUMBER OF NEW POSTS	SQUARE STEEL (IN)			TUBULAR STEEL Ø (IN)				SIGN FRAME REQUIRED	REMARKS	SIGN DETAIL		
								"A"	"B"	RETAIN	SALVAGE FROM	SALVAGE TO	REMOVE	RETAIN	REMOVE		1.75	2.00	2.50	3.00	3.50	4.00	5.00			DETAIL IN SHS	DETAIL ON SHEET NUMBER	DETAIL ON STD SHEET NUMBER
																	(LB / FT)			(LB / FT)								
LUDLOW VT 100							FY-FLUORESCENT YELLOW FYG-FLUORESCENT YELLOW GREEN																"SHS"-STANDARD HIGHWAY SIGNS					
			H R1-1	30	30			6.25							1	X										X		
SB	3.150		F R2-1	24	30								1		X													
			F R2-1	24	30			5.00						1	X											X		
SB	2.430		G VR-017	24	24								1		X													
			G VR-017	24	30			5.00						1	X											E-141		
SB	2.422		H R1-1	24	24								1		X													
			H R1-1	30	30			6.25						1	X											X		
SB	2.388		F VM-607	24	30		43rd INF DIV MEMORIAL HWY			1																ADJACENT TO GRAVEL PULLOUT		
SB	2.175		F VD-062B	72	16		BUSINESS SIGN			1																		
			F VD-062B	72	16		BUSINESS SIGN			1																		
SB	1.937		F W1-10R	30	30		CURVE RIGHT w/ 2 MINOR SIDE ROADS (S)						1		X													
SB	1.890		F W2-1Mh	30	30			6.25						1	X											INSTALL 250 FT± SOUTH OF PREVIOUS REMOVAL		
SB	1.775		G VR-017	24	30								1		X											WRIGHT RD (TH-63)		
			G VR-017	24	30			5.00						1	X											E-141		
SB	1.775		H R1-1	30	30		STOP						1		X											REMOVE THE GATEPOSTED LEFT-SIDE STOP SIGN FOR WRIGHT RD (TH-63)		
SIGN SUMMARY SHEET							SHEET TOTALS	33.75	0.00	3	0	0	6	0	0	6	90								PROJECT NAME: Ludlow-Waitsfield VT100			
								SF	SF	EA	EA	EA	EA	EA	EA	EA	FT									PROJECT NUMBER: STPG SIGN(27)		
VERMONT AGENCY OF TRANSPORTATION							TOWN TOTALS	647.4	0.0	13.0	4.0	4.0	135	0.0	0.0	106	1590.0								FILE NAME: Ludlow.xls			
																									PLOT DATE: 9/4/2009			
																									DRAWN BY: N. Avery			
																									DESIGNED BY: M. Miller			
																									CHECKED BY: N. Avery			
																									SHEET 16 OF 204			