


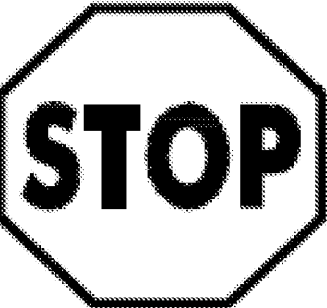
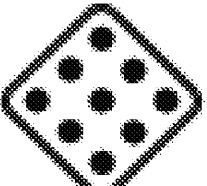


| DIRECTION | MILEPOINT | LOCATION CODE (SHEET 2) | SIGN CODE | WIDTH (IN) | HEIGHT (IN) | SHEETING REMARKS | SIGN LEGEND | NEW SIGNS | | EXISTING SIGNS | | | | EXIST POST | | NUMBER OF NEW POSTS | SQUARE STEEL (IN) | | | TUBULAR STEEL Ø (IN) | | | | SIGN FRAME REQUIRED | REMARKS | SIGN DETAIL | | | | |
|----------------------------------|-----------|-------------------------|-----------|------------|-------------|------------------|---|-----------|------|----------------|--------------|--|--------|------------|--------|---------------------|-------------------|-------------------------------|------|----------------------|------|------|------------------------------|-------------------------|---------|---------------|------------------------|----------------------------|--|--|
| | | | | | | | | "A" | "B" | RETAIN | SALVAGE FROM | SALVAGE TO | REMOVE | RETAIN | REMOVE | | 1.75 | 2.00 | 2.50 | 3.00 | 3.50 | 4.00 | 5.00 | | | DETAIL IN SHS | DETAIL ON SHEET NUMBER | DETAIL ON STD SHEET NUMBER | | |
| | | | | | | | | | | | | | | | | | (LB / FT) | | | (LB / FT) | | | | | | | | | | |
| KILLINGTON VT 100 | | | | | | | FY-FLUORESCENT YELLOW FYG-FLUORESCENT YELLOW GREEN | | | | | | | | | | | | | | | | "SHS"-STANDARD HIGHWAY SIGNS | | | | | | | |
| | | | F M6-3 | 21 | 15 | | | 2.19 | | | | | | | | | | | | | | | | BLACK ON WHITE SHEETING | X | | | | | |
| SB | 0.090 | | E W1-8 | 18 | 24 | | | | | | | | 1 | | X | | | | | | | | | | | | | | | |
| | | | E W1-8 | 24 | 30 | FY |  | 5.00 | | | | | | 1 | X | | | | | | | | | | | X | | | | |
| SB | 0.085 | | E W1-8 | 18 | 24 | | | | | | | | 1 | | X | | | | | | | | | | | | | | | |
| SB | 0.075 | | E W1-8 | 18 | 24 | | | | | | | | 1 | | X | | | | | | | | | | | | | | | |
| | | | E W1-8 | 24 | 30 | FY |  | 5.00 | | | | | | 1 | X | | | | | | | | | | | X | | | | |
| SB | 0.065 | | E W1-8 | 18 | 24 | | | | | | | | 1 | | X | | | | | | | | | | | | | | | |
| SB | 0.060 | | E W1-8 | 18 | 24 | | | | | | | | 1 | | X | | | | | | | | | | | | | | | |
| | | | E W1-8 | 24 | 30 | FY |  | 5.00 | | | | | | 1 | X | | | | | | | | | | | X | | | | |
| SB | 0.055 | | E W1-8 | 18 | 24 | | | | | | | | 1 | | X | | | | | | | | | | | | | | | |
| SB | 0.045 | | F R1-1 | 30 | 30 | |  | | | | | | 1 | | X | | | | | | | | | | | | | | | |
| | | | F R1-1 | 30 | 30 | | | 6.25 | | | | | | 1 | X | | | | | | | | | | | X | | | | |
| VT ROUTE 100 JOINS US ROUTE 4 | | | | | | | | | | | | | | | | | | | | | | | | | | | | | | |
| NB | 0.020 | | A OM1-1 | 18 | 18 | | | | | | | | 1 | | X | | | | | | | | | | | | | | | |
| | | | A OM1-1 | 18 | 18 | |  | 2.25 | | | | | | 1 | X | | | | | | | | | | | | | | | |
| SIGN SUMMARY SHEET | | | | | | | SHEET TOTALS | 25.69 | 0.00 | 0 | 0 | 0 | 8 | 0 | 0 | 5 | 75 | | | | | | | | | | | | | |
| VERMONT AGENCY OF TRANSPORTATION | | | | | | | | SF | SF | EA | EA | EA | EA | EA | EA | EA | EA | FT | | | | | | | | | | | | |
| | | | | | | | TOWN TOTALS | 567.0 | 0.0 | 28.0 | 0.0 | 0.0 | 114 | 0.0 | 0.0 | 88 | 1320.0 | | | | | | | | | | | | | |
| | | | | | | | | | | | | PROJECT NAME: Ludlow-Waitsfield VT100 | | | | | | | | | | | | | | | | | | |
| | | | | | | | | | | | | PROJECT NUMBER: STPG SIGN(27) | | | | | | | | | | | | | | | | | | |
| | | | | | | | | | | | | FILE NAME: Killington.xls | | | | | | PLOT DATE: 9/8/2009 | | | | | | | | | | | | |
| | | | | | | | | | | | | PROJECT MANAGER: N. Avery | | | | | | DRAWN BY: I. Shea | | | | | | | | | | | | |
| | | | | | | | | | | | | DESIGNED BY: J. Kelly | | | | | | CHECKED BY: N. Avery | | | | | | | | | | | | |
| | | | | | | | | | | | | KILLINGTON SHEET 15 | | | | | | SHEET 68 OF 204 | | | | | | | | | | | | |