

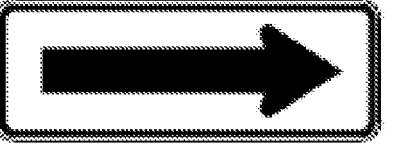
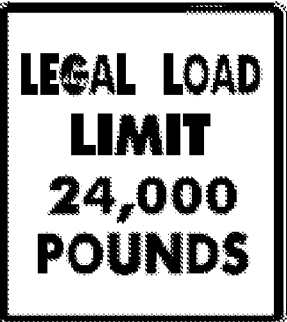


DIRECTION	MILEPOINT	LOCATION CODE (SHEET 2)	SIGN CODE	WIDTH (IN)	HEIGHT (IN)	SHEETING REMARKS	SIGN LEGEND	NEW SIGNS		EXISTING SIGNS				EXIST POST		NUMBER OF NEW POSTS	SQUARE STEEL (IN)			TUBULAR STEEL Ø (IN)				SIGN FRAME REQUIRED	REMARKS	SIGN DETAIL			
								"A"	"B"	RETAIN	SALVAGE FROM	SALVAGE TO	REMOVE	RETAIN	REMOVE		1.75	2.00	2.50	FOUNDATION	3.00	3.50	4.00			5.00	DETAIL IN SHS	DETAIL ON SHEET NUMBER	DETAIL ON STD SHEET NUMBER
																	(LB / FT)				(LB / FT)								
<b>PITTSFIELD VT 100</b>							FY-FLUORESCENT YELLOW FYG-FLUORESCENT YELLOW GREEN																"SHS"-STANDARD HIGHWAY SIGNS						
SB	4.345	F	VD-018	30	18																								
		F	VD-018	30	18			3.75																			8		
SB	4.298	F	R2-1	30	36		SPEED LIMIT 40			1																			
SB	4.210	F	VD-062B	72	16		BUSINESS SIGN			1																			
SB	4.145	F	D9-1	24	30		PHONE SYMBOL					1																	
SB	4.090	F	R2-1	30	36		SPEED LIMIT 35			1																			
SB	4.050	F	W1-2L	30	30		LEFT CURVE			1																			
SB	4.005	F	W1-6	48	24							1																	
		F	W1-6	48	24			8.00																			NEEDS TWO POSTS, NOT ONE	X	
SB	3.995	E	W1-6	48	24							1																	
		E	W1-6	48	24			8.00																				NEEDS TWO POSTS, NOT ONE	X
SB	3.989	G	VR-017	24	24																								
		G	VR-017	24	30			5.00																					E-141
		G		24	30																								REINSTALL TOWN'S SIGN BELOW NEW LEGAL LOAD
SB	3.982	H	R1-1	30	30		NO PARKING ANY TIME																					TH-1, UPPER MICHIGAN RD	
<b>SIGN SUMMARY SHEET</b>							SHEET TOTALS		24.75	0.00	4	1	1	6	0	0	4	60							PROJECT NAME: <b>Ludlow-Waitsfield VT100</b>				
							SF	SF	EA	EA	EA	EA	EA	EA	EA	EA	EA	EA	EA	EA	EA	EA	EA	EA	EA	EA	EA	PROJECT NUMBER: <b>STPG SIGN(27)</b>	
VERMONT AGENCY OF TRANSPORTATION							TOWN TOTALS		297.1	0.0	15.0	1.0	1.0	51	0.0	0.0	52	780.0							FILE NAME: <b>Pittsfield.xls</b>				
																						PLOT DATE: <b>9/9/2009</b>							
															PROJECT MANAGER: <b>N. Avery</b>														
															DESIGNED BY: <b>J. Kelly</b>														
															DRAWN BY: <b>I. Shea</b>														
															CHECKED BY: <b>N. Avery</b>														
															SHEET <b>77</b> OF <b>204</b>														