

STATE OF VERMONT AGENCY OF TRANSPORTATION




PROPOSED IMPROVEMENT TOWNS OF LUDLOW - WAITSFIELD COUNTIES OF WINDSOR, RUTLAND, ADDISON AND WASHINGTON VERMONT ROUTE 100

BEGINNING AT THE ANDOVER-LUDLOW TOWN LINE ON VT ROUTE 100 IN THE TOWN OF LUDLOW AT MILE MARKER 0.000 AND EXTENDING NORTHERLY ALONG VT ROUTE 100 FOR A DISTANCE OF 67.616 MILES TO THE WAITSFIELD-MORETOWN TOWN LINE AT MILE MARKER 7.580 IN THE TOWN OF WAITSFIELD; EXCLUDING CLASS I SECTIONS WITHIN THE PROJECT CORRIDOR.


LENGTH OF ROADWAY = 67.616 MILES
LENGTH OF PROJECT = 66.894 MILES

WORK TO BE PERFORMED UNDER THIS PROJECT INCLUDES THE REMOVAL OF EXISTING SIGNS & POSTS, INSTALLATION OF SIGNS & SIGN POSTS AND OTHER RELATED ITEMS.

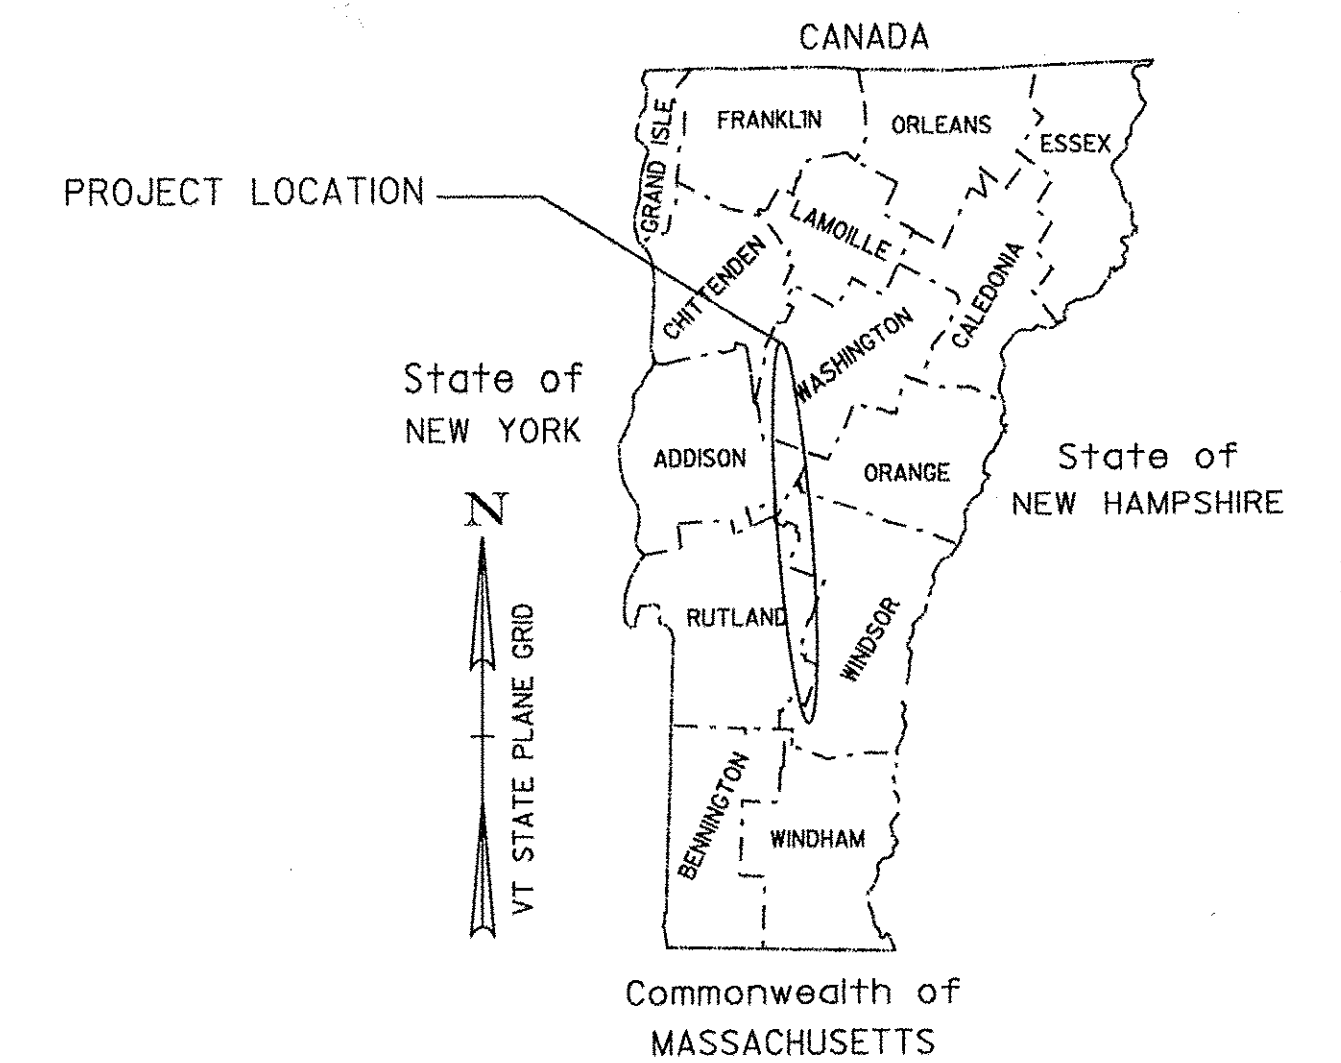

INDEX OF SHEETS
SEE SHEET 2

END PROJECT STPG SIGN (27)
WAITSFIELD MM 7.580

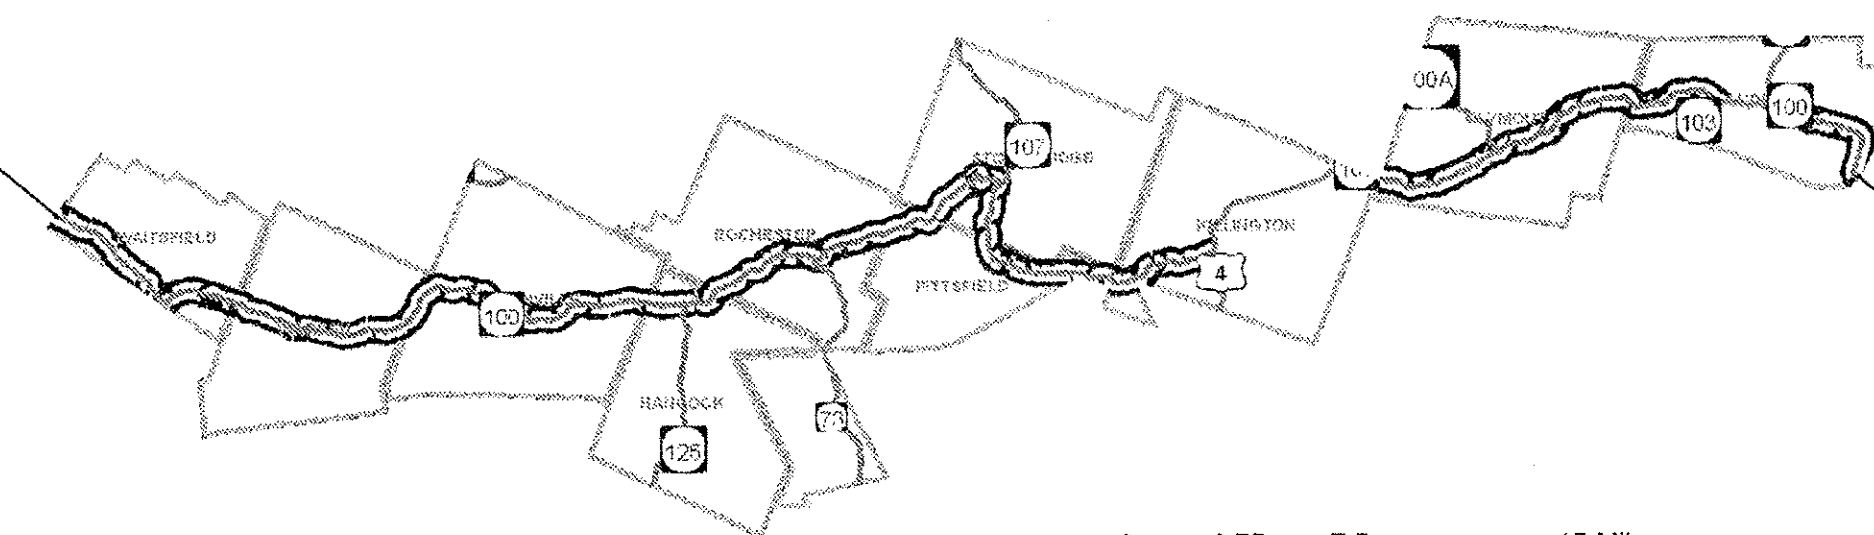

BEGIN PROJECT STPG SIGN (27)
LUDLOW MM 0.000

RECORD PLANS

CONTRACTOR: MIDDLEBURY FENCE COMPANY, LLC- NEW HAVEN, VT
RESIDENT ENGINEER: AL JONES
CONSTRUCTION BEGAN: APRIL 5, 2010
CONSTRUCTION COMPLETE: SEPTEMBER 1, 2010
RECORD PLANS BY: AL JONES & AMOS KEMPTON

I HEREBY CERTIFY THAT ALL THE CONSTRUCTION REQUIRED BY THIS SET OF DRAWINGS HAS BEEN ACCOMPLISHED AS INDICATED HEREIN.

BY Al Jones RESIDENT ENGINEER
DATE 8/22/11

NOTE: Any further information concerning final quantities, amounts or other details relative to this project may be found at Central Files in the electronic archives.

CONVENTIONAL SYMBOLS

COUNTY LINE	
TOWN LINE	
LIMITS OF ACCESS	
POINT OF ACCESS	
FENCE LINE	
STONE WALL	
TRAVELED WAY	
GUARD RAIL	
RAILROAD	
SURVEY LINE	
CULVERT	
POWER POLE	
TELEPHONE POLE	
TREES	
CONTROL OF ACCESS	
PROPERTY LINE	
R.O.W. TAKING LINE	
SLOPE RIGHTS	
TOP OF CUT	
TOE OF SLOPE	

SURVEYED BY : N/A
SURVEYED DATE : N/A

DATUM
VERTICAL N/A
HORIZONTAL N/A

THESE PLANS ARE SUBJECT TO SUCH ENGINEERING CHANGES AS MAY BE REQUIRED BY THE FEDERAL HIGHWAY ADMINISTRATION OR THE DIRECTOR OF PROGRAM DEVELOPMENT.

CONSTRUCTION IS TO BE CARRIED ON IN ACCORDANCE WITH THESE PLANS AND THE STANDARD SPECIFICATIONS FOR CONSTRUCTION DATED 2006, AS APPROVED BY THE FEDERAL HIGHWAY ADMINISTRATION ON JUNE 15, 2006 FOR USE ON THIS PROJECT, INCLUDING ALL SUBSEQUENT REVISIONS AND SUCH REVISED SPECIFICATIONS AND SPECIAL PROVISIONS AS ARE INCORPORATED IN THESE PLANS.

DIRECTOR OF PROGRAM DEVELOPMENT	
APPROVED <u>Richard Stewart</u>	DATE <u>9/17/09</u>
PROJECT MANAGER :	AMY GAMBLE
PROJECT NAME :	LUDLOW - WAITSFIELD
PROJECT NUMBER :	STPG SIGN (27)
SHEET 1 OF 204 SHEETS	

INDEX OF SHEETS

1	TITLE SHEET
2	GENERAL NOTES
3	QUANTITY SHEET
4	COUNTY / TOWN LINE DESIGN
5-6	SIGN DETAILS
7	GUIDE SIGN ASSEMBLY
8	WARNING STREET NAME PLAQUE DETAIL
9-27	LUDLOW TRAFFIC SIGN SUMMARY SHEETS 1-19
28-48	PLYMOUTH TRAFFIC SIGN SUMMARY SHEETS 1-21
49-53	BRIDGEWATER TRAFFIC SIGN SUMMARY SHEETS 1-5
54-71	KILLINGTON TRAFFIC SIGN SUMMARY SHEETS 1-18
72-79	PITTSFIELD TRAFFIC SIGN SUMMARY SHEETS 1-8
80-100	STOCKBRIDGE TRAFFIC SIGN SUMMARY SHEETS 1-21
101-121	ROCHESTER TRAFFIC SIGN SUMMARY SHEETS 1-21
122-135	HANCOCK TRAFFIC SIGN SUMMARY SHEETS 1-14
136-154	GRANVILLE TRAFFIC SIGN SUMMARY SHEETS 1-19
155-173	WARREN TRAFFIC SIGN SUMMARY SHEETS 1-19
174-201	WAITSFIELD TRAFFIC SIGN SUMMARY SHEETS 1-28
202	TOWN TOTAL SIGN SUMMARY SHEET
203-204	TRAFFIC CONTROL SHEETS

STANDARDS

E-120	STANDARD SIGN PLACEMENT EXPRESSWAY AND FREEWAY	08/08/1995
E-121	STANDARD SIGN PLACEMENT CONVENTIONAL ROAD	08/08/1995
E-123	GUIDE SIGN PLACEMENT	03/16/2004
E-127	ROUTE MARKINGS AT RURAL INTERSECTIONS	08/08/1995
E-128A	VILLAGE SIGNS A-M	08/08/1995
E-128B	VILLAGE SIGNS N-W	08/08/1995
E-132	GENERAL MOTORIST SERVICES SIGN DETAIL	08/18/1995
E-136B	STATE ROUTE MARKER SIGN DETAILS	08/08/1995
E-136C	STATE NUMBER TOWN HIGHWAY SIGN DETAILS	08/08/1995
E-138	MILEMARKER DETAILS STATE AND TOWN HIGHWAYS	05/30/2003
E-141	REGULATORY SIGN DETAILS	09/20/1995
E-144	REGULATORY SIGN DETAILS	05/29/1999
E-145A	REGULATORY SIGN DETAILS LANE USE CONTROL SIGNS	12/23/1994
E-145B	REGULATORY SIGN DETAILS LANE USE CONTROL SIGNS	12/23/1994
E-153	WARNING SIGN DETAILS	05/01/2004
E-154	WARNING SIGN DETAILS	05/01/2004
E-164	SQUARE STEEL POSTS	06/08/2009



CLASS I SECTIONS OF HIGHWAY TO BE EXCLUDED FROM THIS PROJECT

TOWN	BEGIN MM	END MM	DISTANCE
LUDLOW	4.318	5.040	0.722
TOTAL CLASS I MILEAGE			0.722

GENERAL NOTES

- ALL NEW SIGNS SHALL BE IN ACCORDANCE WITH THESE PLANS, THE LATEST EDITION OF THE 2003 MANUAL ON UNIFORM TRAFFIC CONTROL DEVICES, THE STANDARD HIGHWAY SIGN BOOK (SHS) PUBLISHED BY THE FEDERAL HIGHWAY ADMINISTRATION (FHWA), AND APPLICABLE VTRANS E-SERIES STANDARDS OR AS DIRECTED BY THE ENGINEER. SIGN LOCATIONS AS SHOWN ON THE PLANS ARE APPROXIMATE. EXACT LOCATIONS TO BE DETERMINED BY THE ENGINEER IN THE FIELD.
- ALL SIGNS WITHIN THE PROJECT LIMITS ARE TO BE REPLACED UNLESS OTHERWISE NOTED OR AS DIRECTED BY THE RESIDENT ENGINEER.
- THE CONTRACTOR SHALL BE RESPONSIBLE FOR REPAIRING ANY DAMAGE TO PRIVATE OR PUBLIC PROPERTY CAUSED BY THE CONTRACTOR, AT THEIR EXPENSE.
- ALL EXISTING MILE MARKER PLAQUES ATTACHED TO A DELINEATOR POST OR ATTACHED TO A RETAINED STAND ALONE SIGN POST ASSEMBLY SHALL BE RETAINED. IF AN EXISTING MILE MARKER PLAQUE IS ATTACHED TO A SIGN POST THAT IS TO BE REMOVED AND REPLACED IN THE SAME LOCATION, THE MILE MARKER PLAQUE SHALL BE REMOVED, SALVAGED AND INSTALLED TO THE NEW SIGN POST. IF AN EXISTING MILE MARKER PLAQUE IS ATTACHED TO A SIGN POST THAT IS TO BE RELOCATED TO A DIFFERENT LOCATION, THE MILE MARKER PLAQUE SHALL BE REMOVED, UNLESS OTHERWISE DIRECTED BY THE ENGINEER. PAYMENT FOR ANY OF THIS WORK SHALL BE INCIDENTAL TO ITEM 675.341 SQUARE TUBE POST AND ANCHOR. PAYMENT FOR NEW MILE MARKERS AS SHOWN ON THESE PLANS SHALL BE PAID FOR AS ITEM 675.20 TRAFFIC SIGN, TYPE A.
- SALVAGED SIGN TOTALS HAS BEEN ADDED TO THE TOTAL SIGN REMOVAL COLUMN ON THE TOWN TOTAL SIGN SUMMARY SHEET.
- EXISTING STREET NAME SIGNS ATTACHED TO SIGN POSTS THAT ARE TO BE REPLACED SHALL BE REMOVED AND INSTALLED ONTO NEW POST. ALL WORK AND MATERIALS NECESSARY TO REMOVE AND INSTALL THE STREET NAME PLAQUES SHALL BE PAID UNDER ITEM 675.60 ERECTING SALVAGED SIGNS. AN ESTIMATED QUANTITY HAS BEEN ADDED TO ITEM 675.60 TO PAY FOR THIS WORK.
- ALL EXISTING STREET NAME PLAQUES INSTALLED ON STAND ALONE SIGN POSTS SHALL BE RETAINED WITHIN THE PROJECT LIMITS.
- ALL SIGN PLACEMENT SHALL BE IN CONFORMANCE WITH STATE STANDARD E-120 STANDARD SIGN PLACEMENT CONVENTIONAL ROADS AND E-121 STANDARD SIGN PLACEMENT EXPRESSWAY AND FREEWAY.
- ALL SIGN LETTERING, DIGITS, ARROWS, AND DESIGN OF SYMBOLS FOR SIGNS DETAILED REFERENCED IN THESE PLANS SHALL CONFORM WITH THE "STANDARD ALPHABET FOR HIGHWAY SIGNS AND PAVEMENT MARKING" AS ADOPTED BY THE U.S. DEPARTMENT OF TRANSPORTATION AND THE FEDERAL HIGHWAY ADMINISTRATION (FHWA), UNLESS DETAILED WITHIN THESE PLANS.
- ALL COLORS SHALL CONFORM WITH THE STANDARD COLORS ADOPTED BY THE AMERICAN ASSOCIATION OF STATE HIGHWAY AND TRANSPORTATION OFFICIALS (AASHTO) AND APPROVED BY FHWA, UNLESS OTHERWISE NOTED.
- WITHIN THE TRAFFIC SIGN SUMMARY SHEETS FY= FLUORESCENT YELLOW SHEETING (ASTM VII, VIII, OR IX) AND FYG = FLUORESCENT YELLOW-GREEN SHEETING (ASTM TYPE VII, VIII, OR IX).
- SALVAGED SIGNS CALCULATED IN THE TRAFFIC SIGN SUMMARY SHEET HAVE BEEN INCLUDED INTO THE TOTAL FOR REMOVING SIGNS.
- UNLESS OTHERWISE DETAILED ON THE PLANS, ALL SIGN BASE MATERIAL SHALL BE FLAT SHEET ALUMINUM WITH THE FOLLOWING MINIMUM THICKNESSES:

SIZES	24" X 10"	24" X 12"	36" X 12"	
THICKNESS	0.060"	0.080"	0.100"	0.125"

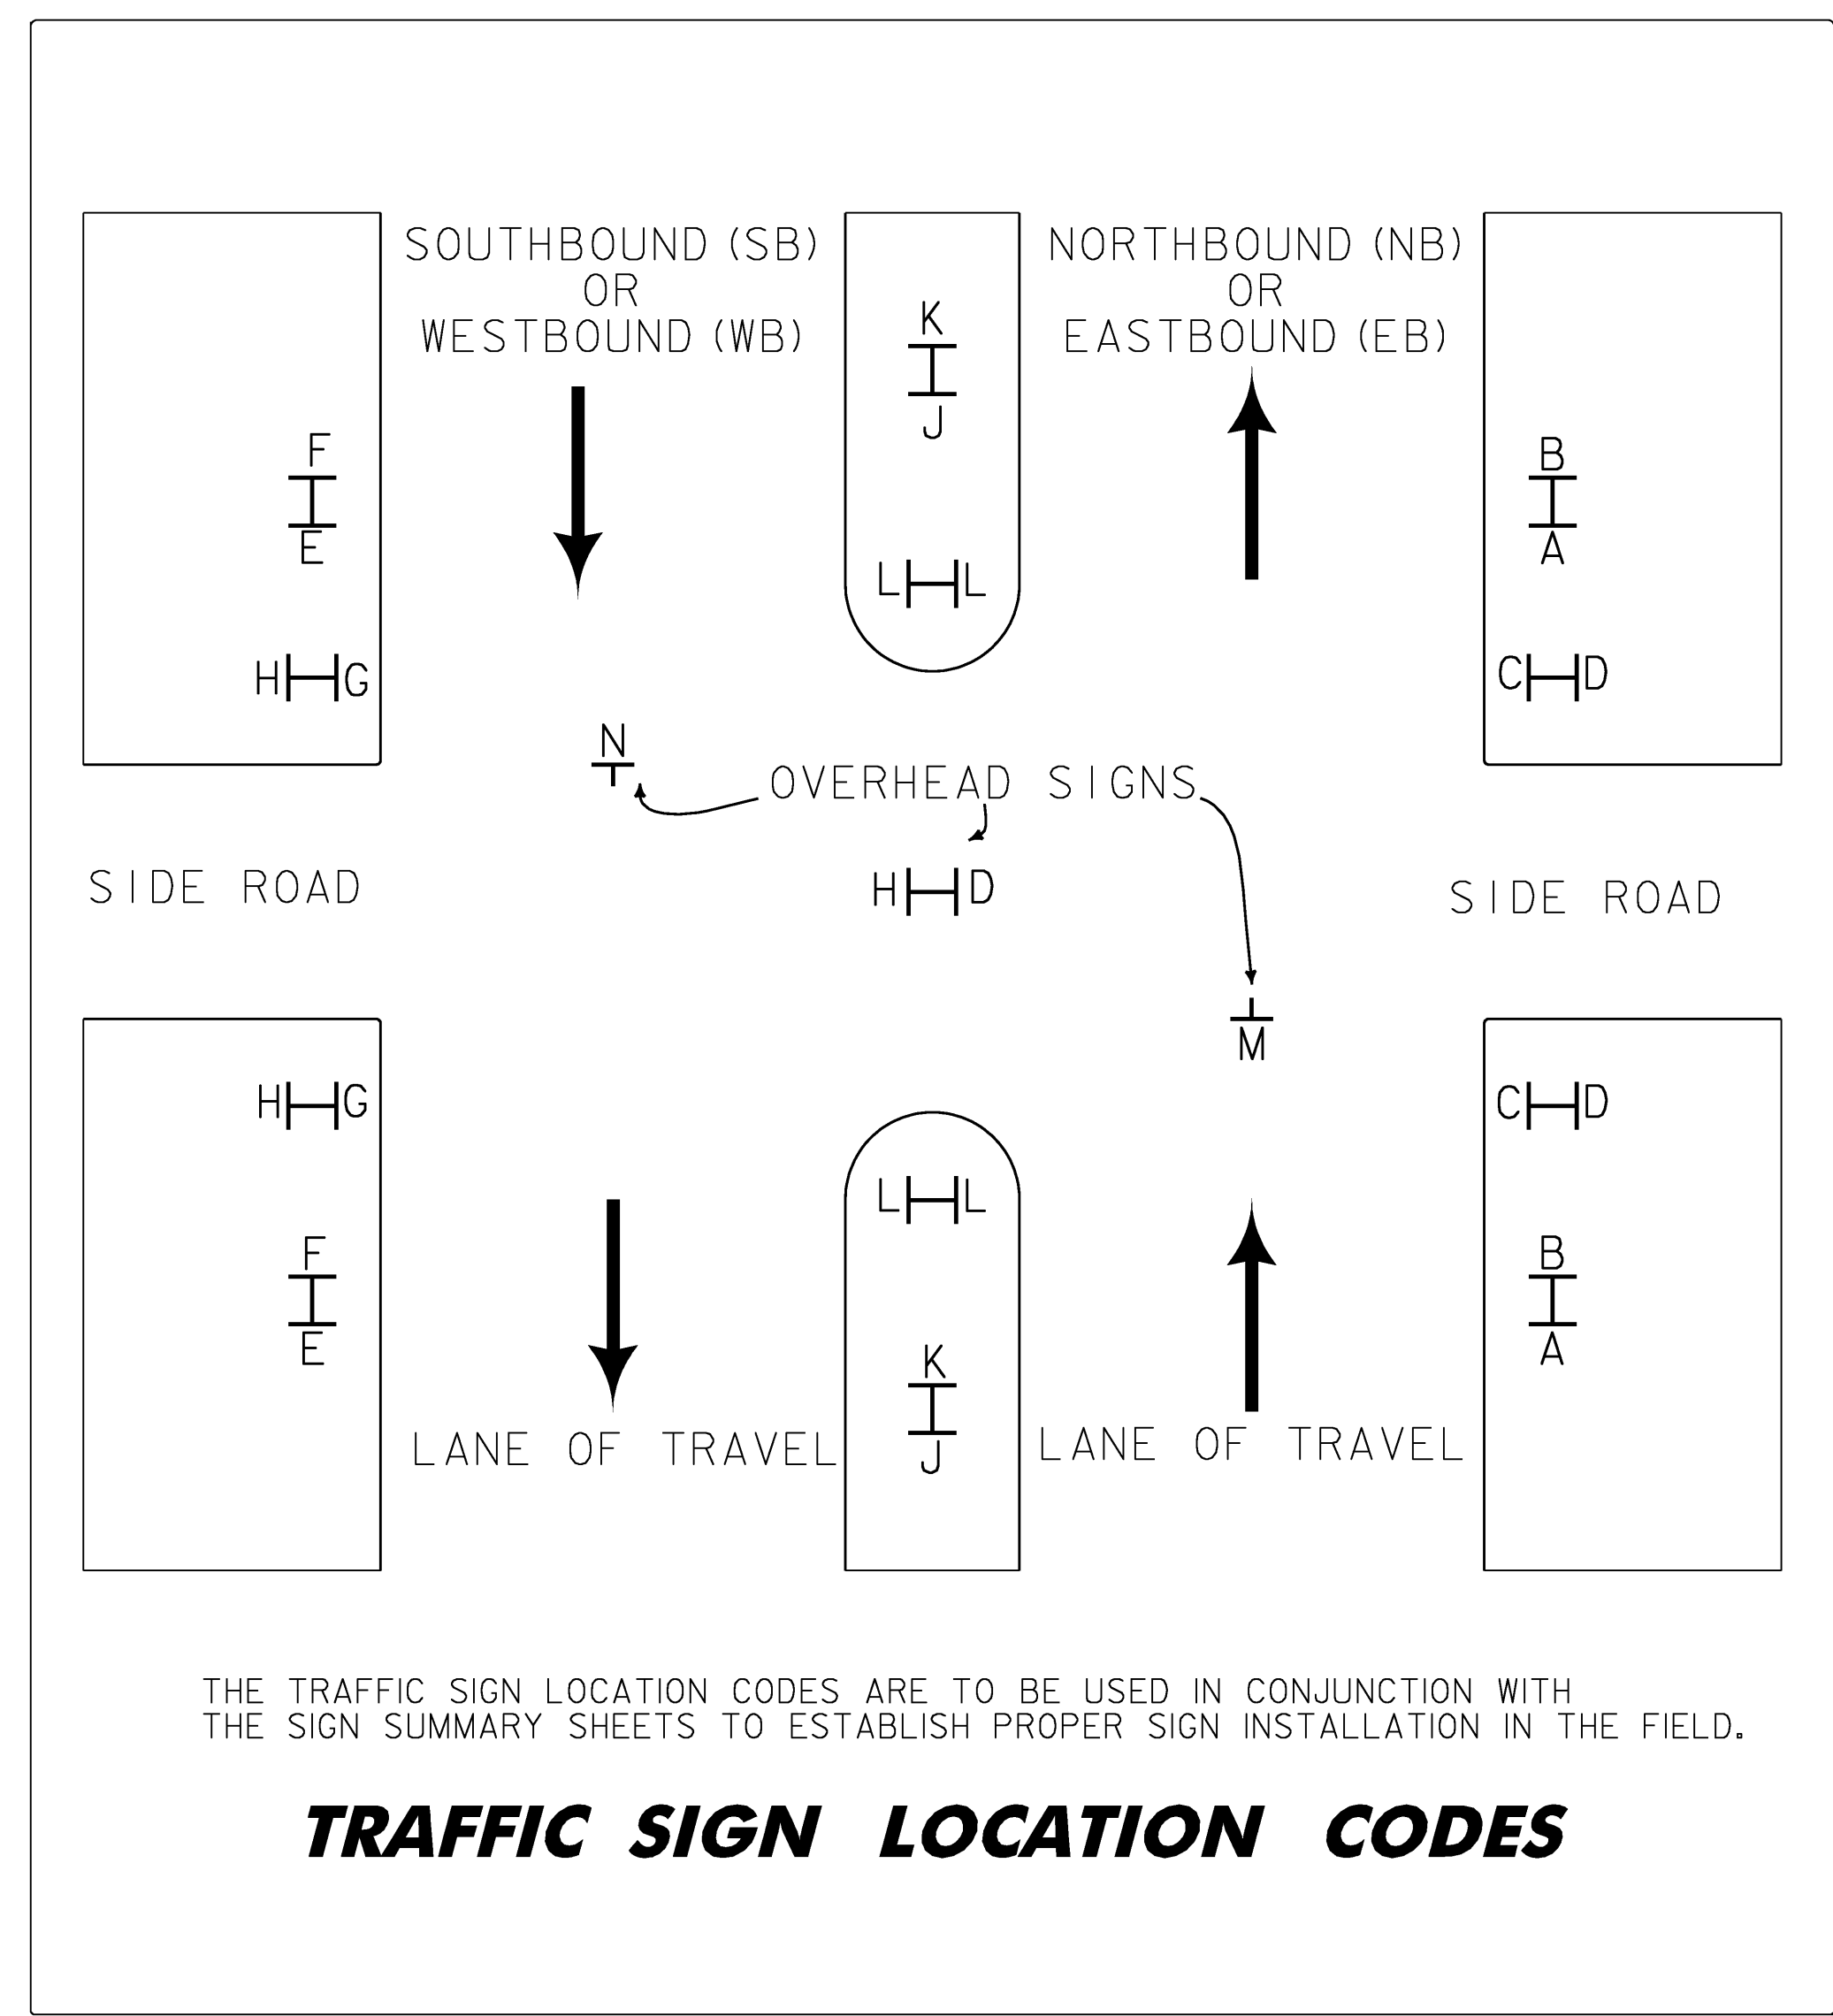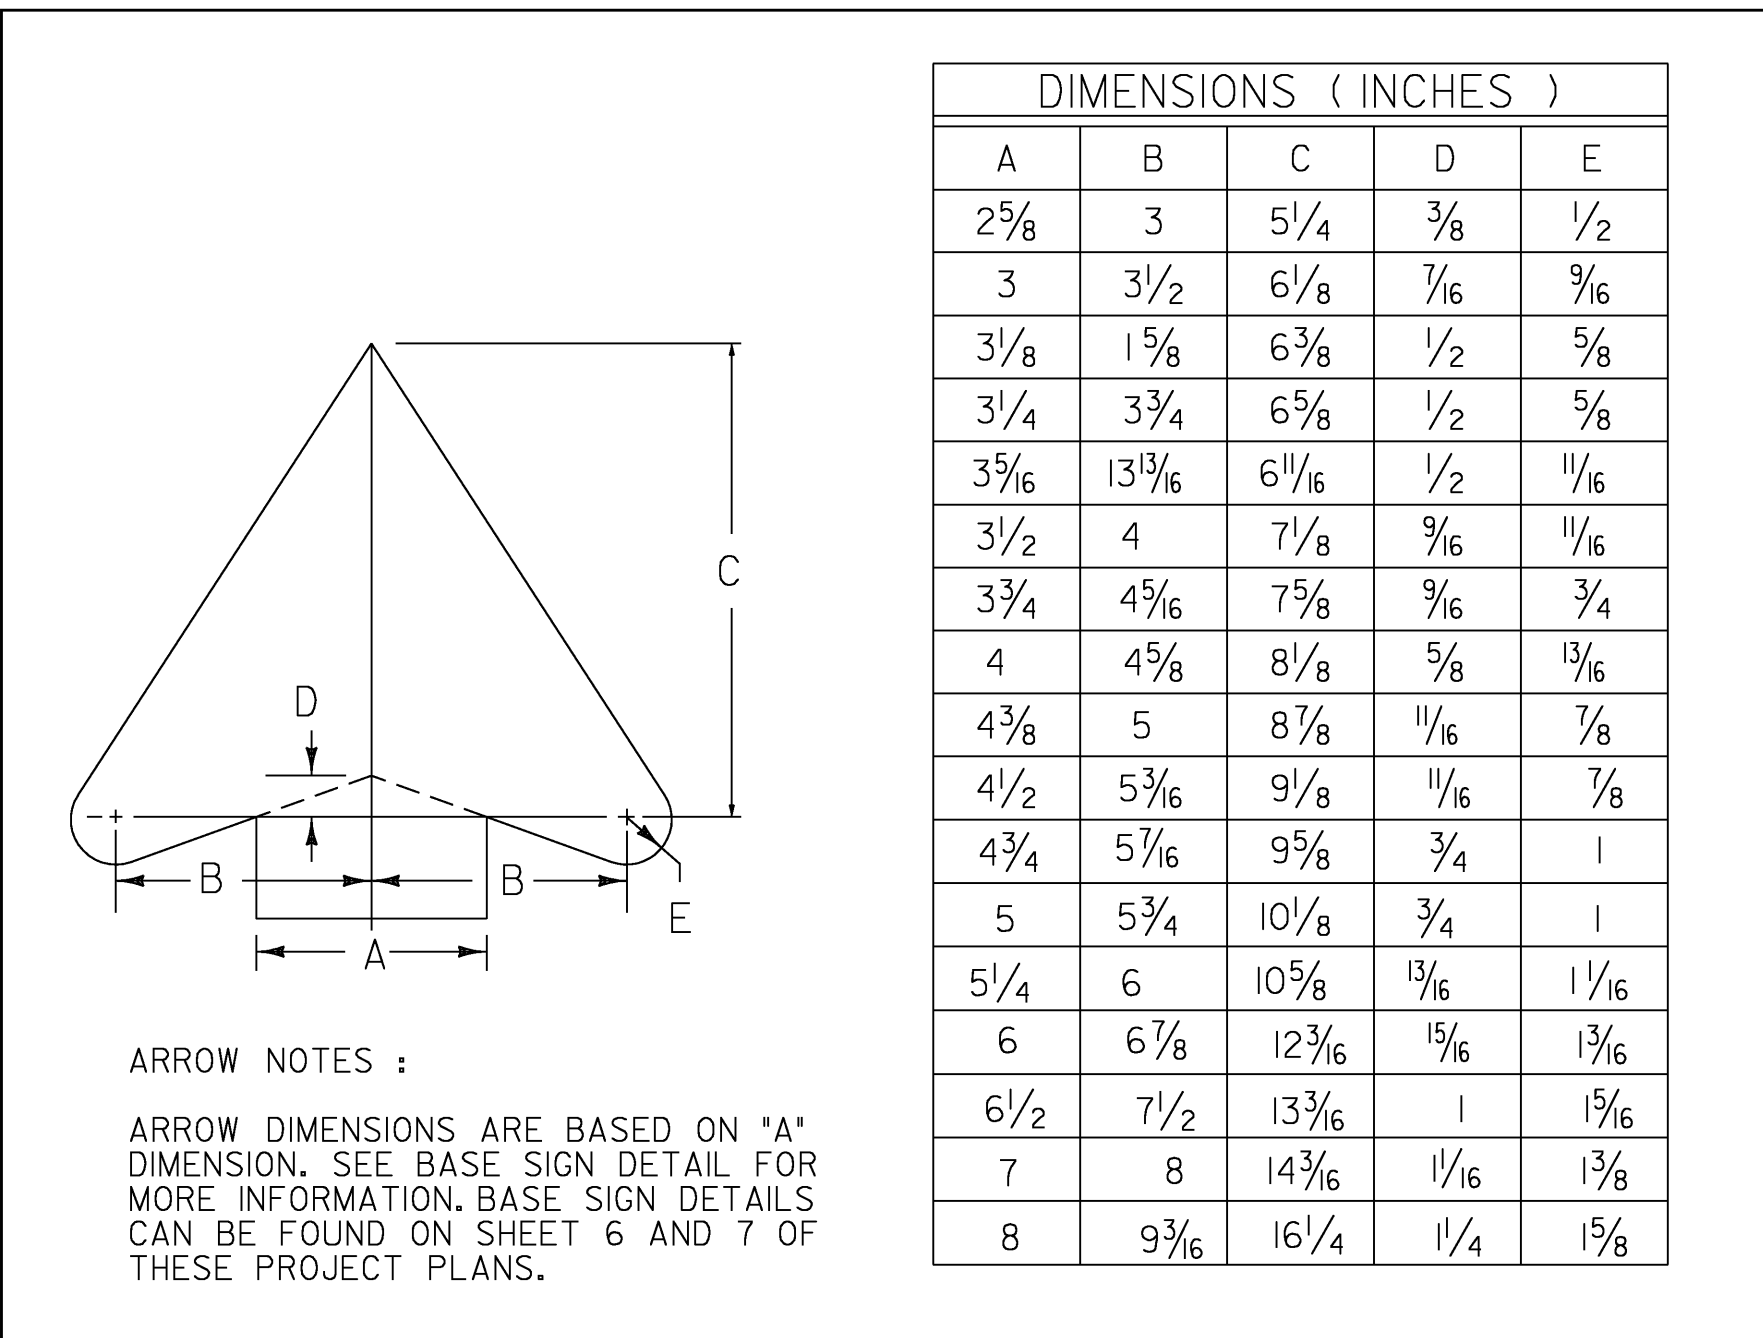

QUANTITY SHEET 1



SUMMARY OF ESTIMATED QUANTITIES										TOTALS		DESCRIPTIONS				DETAILED SUMMARY OF QUANTITIES			
										ROADWAY	GRAND TOTAL	FINAL	UNIT	ITEMS	ITEM NUMBER	ROUND	QUANTITIES	UNIT	ITEMS
										1	1		CY	TRENCH EXCAVATION OF EARTH, EXPLORATORY (N.A.B.I.)	204.22				
										56	56		HR	UNIFORMED TRAFFIC OFFICERS	630.10				
										948	948		HR	FLAGGERS	630.15				
										1	1		LS	MOBILIZATION/DEMOBILIZATION	635.11				
										1	1		LS	TRAFFIC CONTROL	641.10				
										5683	5683		SF	TRAFFIC SIGNS, TYPE A	675.20				
										14685	14685		LF	SQUARE TUBE SIGN POST AND ANCHOR	675.341				
										1213	1213		EACH	REMOVING SIGNS	675.50				
										83	83		EACH	ERECTING SALVAGED SIGNS	675.60				

TEXT	SERIES	DIMENSIONS
ADDISON	C	28.27
ALBANY	C	25.88
ALBURGH	C	29.99
ANDOVER	C	30.05
ARLINGTON	B	29.35
ATHENS	C	24.49
AVERILL	C	26.44
BAKERSFIELD	B	32.50
BARNARD	C	30.49
BARNET	C	24.83
BARRE CITY	B	32.50
BARRE TOWN	B	32.50
BARTON	C	25.38
BELVIDERE	C	32.50
BENNINGTON	B	32.50
BENSON	C	25.41
BERKSHIRE	B	29.04
BERLIN	C	22.50
BETHEL	C	23.80
BLOOMFIELD	B	24.83
BOLTON	C	24.39
BRADFORD	C	32.50
BRAINTREE	C	32.50
BRANDON	C	30.46
BRATTLEBORO	B	32.50
BRIDGEWATER	B	32.50
BRIDPORT	C	32.06
BRIGHTON	C	32.06
BRISTOL	C	27.24
BROOKFIELD	B	31.91
BROWNINGTON	B	31.22
BRUNSWICK	B	30.60
BURKE	C	20.93
BUELS GORE	B	32.50
BURLINGTON	B	32.50
CABOT	C	20.50
CALAIS	C	22.22
CAMBRIDGE	B	29.74
CANAAN	C	25.15
CASTLETON	B	29.32
CAVENDISH	C	32.50
CHARLESTON	B	32.50
CHARLOTTE	B	29.32
CHELSEA	C	28.84
CHESTER	C	28.46
CHITTENDEN	B	30.56
CLARENDON	B	30.32
COLCHESTER	B	32.50
CONCORD	C	30.42
CORINTH	C	27.27
CORNWALL	C	32.50
COVENTRY	C	32.50
CRAFTSBURY	B	32.50
DANBY	C	21.65
DANVILLE	C	31.16
DERBY	C	21.15
DORSET	C	24.55
DOVER	C	20.74
DUMMERSTON	B	32.50
DUXBURY	C	30.75
EDEN	C	15.85
ENOSBURG	C	32.50
EAST HAVEN	B	32.50
E. MONTPELIER	B (5'')	32.50
ELMORE	C	25.46
ESSEX	C	20.38
FAIRFAX	C	27.05
FAIRFIELD	C	32.50
FAIR HAVEN	B	32.50
FAIRLEE	C	26.12
FAYSTON	C	28.85
FERDINAND	B	29.17
FERRISBURGH	B	32.50
FLETCHER	C	31.85
FRANKLIN	C	31.31

TEXT	SERIES	DIMENSIONS
GEORGIA	C	27.74
GLOVER	C	25.00
GOSHEN	C	25.16
GLASTENBURY	B (5'')	31.32
GRAFTON	C	29.31
GRAND ISLE	B	32.50
GRANVILLE	C	32.50
GREENSBORO	B	32.50
GROTON	C	25.35
GUILDHALL	C	32.50
GUILFORD	C	31.78
HALIFAX	C	27.14
HANCOCK	C	29.96
HARDWICK	C	32.50
HARTFORD	C	32.50
HARTLAND	C	32.50
HIGHGATE	C	31.14
HINESBURG	B	29.23
HOLLAND	C	29.22
HUBBARDTON	B	31.42
HYDE PARK	B	32.50
IRA	C	10.15
IRASBURG	C	32.37
ISLE LA MOTTE	B (5'')	32.50
JAMAICA	C	28.26
JAY	C	11.85
JERICHO	C	27.24
JOHNSON	C	30.39
KILLINGTON	B	30.16
KIRBY	C	18.99
LANDGROVE	B	30.33
LEICESTER	C	32.50
LEMINGTON	B	28.79
LONDONDERRY	B (5'')	32.18
LOWELL	C	25.04
LUDLOW	C	26.10
LUNENBERG	B	30.01
LYNDON	C	24.96
MAIDSTONE	B	29.51
MANCHESTER	B	32.50
MARLBORO	C	32.50
MARSHFIELD	B	32.47
MENDON	C	26.02
MIDDLEBURY	B	32.50
MIDDLESEX	B	29.06
MIDDLETOWN SPR	B (5'')	32.50
MILTON	C	22.63
MONTGOMERY	B	32.50
MONTPELIER	B	31.94
MORETOWN	C	32.50
MORGAN	C	26.52
MORRISTOWN	B	32.50
MOUNT HOLLY	B (5'')	31.97
MOUNT TABOR	B	32.02
NEWARK	C	25.65
NEWBURY	C	30.87
NEWFANE	C	29.73
NEW HAVEN	B	32.50
NEWPORT CITY	B (5'')	32.50
NEWPORT TOWN	B (5'')	32.50
NORTH HERO	B	32.50
NORTHFIELD	B	31.57
NORTON	C	25.60
NORWICH	C	28.77
ORANGE	C	25.88
ORWELL	C	25.57
PANTON	C	25.38
PAWLET	C	24.59
PEACHAM	C	30.23
PERU	C	16.38
PITTSFIELD	C	32.50
PITTSFORD	C	32.50
PLAINFIELD	B	29.65
PLYMOUTH	C	32.50
POMFRET	C	29.42

TEXT	SERIES	DIMENSIONS
POULTNEY	C	32.50
POWNAI	C	26.35
PROCTOR	C	29.31
PUTNEY	C	24.83
RANDOLPH	C	32.50
READING	C	27.47
READSBORO	B	31.09
RICHFORD	C	32.06
RICHMOND	C	32.50
RIFTON	C	22.97
ROCHESTER	B	29.54
ROCKINGHAM	B	32.50
ROXBURY	C	30.44
ROYAL TON	C	32.50
RUPERT	C	24.94
RUTLAND CITY	B (5'')	32.50
RUTLAND TOWN	B (5'')	32.50
RYEGATE	C	28.47
ST. ALBANS CITY	B (5'')	32.50
ST. ALBANS TOWN	B (5'')	32.50
ST. GEORGE	B	32.50
ST. JOHNSBURY	B (5'')	32.50
SALISBURY	C	32.50
SEARSBURG	B	30.93
SHAFTSBURY	B	32.50
SHARON	C	25.91
SHEFFIELD	C	32.50
SHELDON	C	29.42
SHOREHAM	C	32.50
SHREWSBURY	B	32.50
S. BURLINGTON	B (5'')	32.50
SOUTH HERO	B	32.50
SPRINGFIELD	B	32.50
STAMFORD	C	32.50
STARKSBORO	B	32.50
STOCKBRIDGE	B	32.50
STOWE	C	21.30
STRAFFORD	B	30.42
STRATTON	C	32.06
SUDBURY	C	30.77
SUNDERLAND	B	32.50
SUTTON	C	24.21
SWANTON	C	30.22
THETFORD	C	32.50
TINMOUTH	C	32.14
TOPSHAM	C	30.53
TOWNSHEND	B	31.70
TROY	C	16.54
TUNBRIDGE	C	32.50
UNDERHILL	C	32.50
VERGENNES	B	30.03
VERNON	C	25.79
VERSHIRE	C	31.72
WAITSFIELD	B	30.44
WALDEN	C	25.46
WALLINGFORD	B	32.50
WALTHAM	C	29.91
WARDSBORO	B	32.29
WARREN	C	25.99
WARRENS GORE	B (5'')	32.50
WASHINGTON	B	32.50
WATERBURY	B	31.40
WATERFORD	B	30.65
WATERVILLE	B	31.35
WEATHERSFIELD	B (5'')	32.50
WELLS	C	20.83
WEST FAIRLEE	B (5'')	32.50
WESTFIELD	C	32.50
WEST HAVEN	B	32.50
WESTFORD	C	32.50
WESTMINSTER	B	32.50
WESTMORE	C	32.50
WESTON	C	25.85

TEXT	SERIES	DIMENSIONS
WEST RUTLAND	B (5'')	32.50
WEST WINDSOR	B (5'')	32.50
WEYBRIDGE	C	32.50
WHEELLOCK	C	32.50
WHITING	C	25.86
WHITINGHAM	B	32.50
WILLIAMSTOWN	B (5'')	32.50
WILLISTON	C	32.50
WILMINGTON	B	32.16
WINDHAM	C	29.66
WINDSOR	C	28.77
WINHALL	C	28.24
WINOOSKI	C	30.81
WOLCOTT	C	29.38
WOODBURY	C	32.50
WOODFORD	C	32.50
WOODSTOCK	B	31.79
WORCESTER	B	30.76

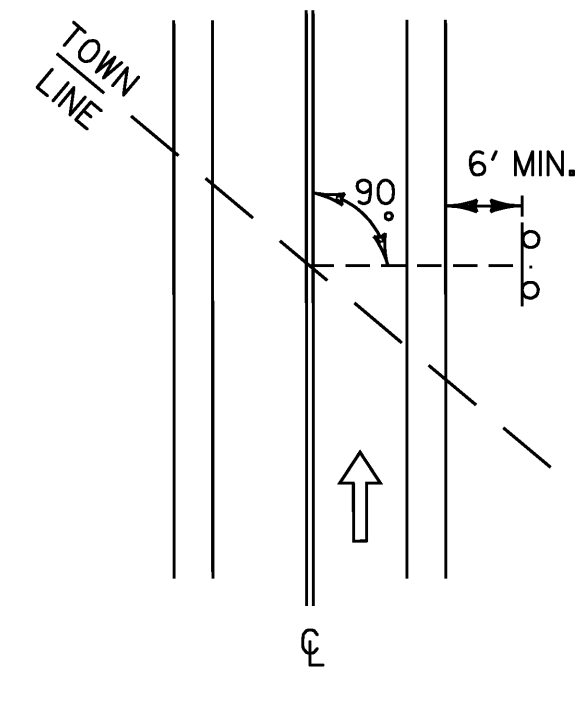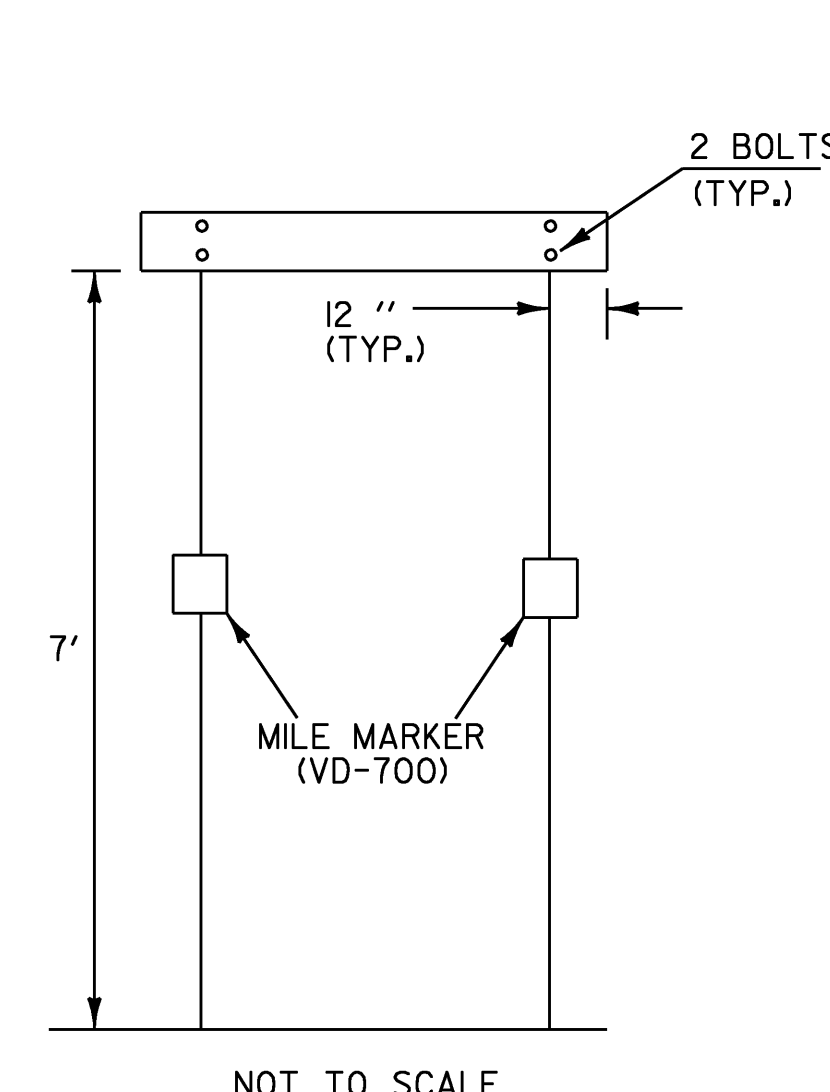


THE SIGN SHALL BE MOUNTED PARALLEL WITH THE ROADWAY, NORMALLY ON RIGHT SIDE TRAVELING WEST TO EAST OR SOUTH TO NORTH.

NOTES:

- WORD TO WORD SPACING FOR MULTIPLE TEXT TOWN NAMES IS ADJUSTABLE TO ACCOMMODATE DIMENSION REQUIREMENTS.
- DIMENSIONS SHOWN ARE APPROXIMATE AND MAY BE ADJUSTED SLIGHTLY TO ACCOMMODATE VARIOUS MANUFACTURER'S LETTER WIDTHS.
- ALL DIMENSIONS ARE IN INCHES UNLESS OTHERWISE NOTED

WHEN CROSSING COUNTY BOUNDARIES AN ADDITIONAL COUNTY LINE SIGN SHALL BE MOUNTED BELOW THE TOWN LINE SIGN MAINTAINING AN SEVEN FOOT CLEARANCE.

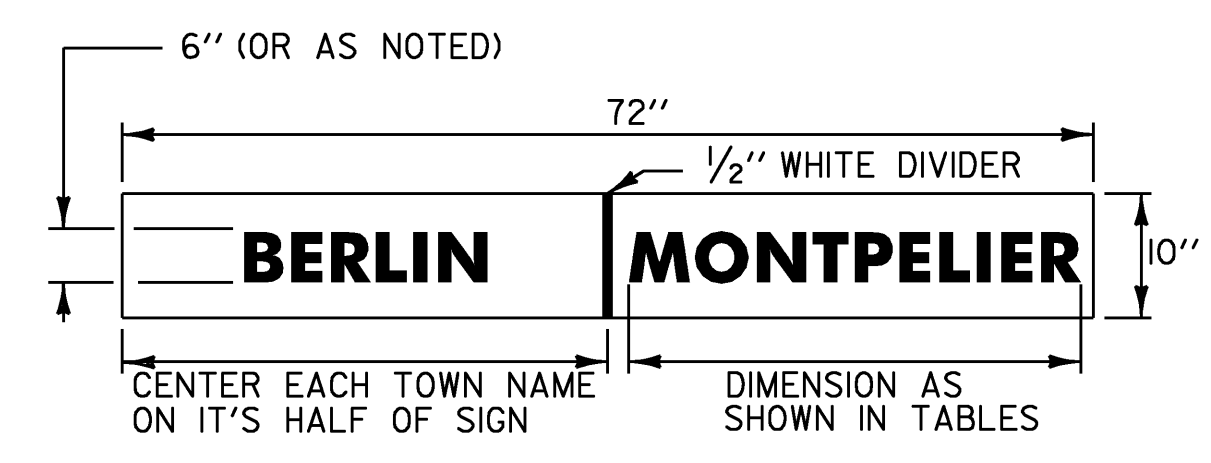

VD-024
VD-025 SIMILIAR

TEXT	SERIES	DIMENSIONS
ADDISON CO.	B	32.50
BENNINGTON CO.	B (5'')	32.50
CALEDONIA CO.	B (5'')	32.50
CHITTENDEN CO.	B (5'')	32.50
ESSEX CO.	C	32.50
FRANKLIN CO.	B (5'')	32.50
GRAND ISLE CO.	B (5'')	32.50
LAMOILLE CO.	B (5'')	32.50
ORANGE CO.	B	32.50
ORLEANS CO.	B	32.50
RUTLAND CO.	B	32.50
WASHINGTON CO.	B (5'')	32.50
WINDHAM CO.	B	32.50
WINDSOR CO.	B	32.50

VD-025


TOWN/COUNTY LINE SIGN NOTES:

- THE SIGN BASE MATERIAL SHALL BE HIGH DENSITY OVERLAIN PLYWOOD 5/8 INCH THICK OR ALUMINUM SHEETING 0.125" MINIMUM THICKNESS. THE RETROREFLECTIVE MATERIAL SHALL BE SHEETING APPLIED TO THE ENTIRE BACKGROUND OF THE SIGN. THE LEGEND SHALL BE CUT-OUT RETROREFLECTIVE LEGEND. ALL RETROREFLECTIVE MATERIAL SHALL BE EQUAL TO OR EXCEEDING THE "THE AMERICAN SOCIETY OF TESTING AND MATERIALS" (ASTM 4956-01) TYPE III SHEETING.
- SIGNS SHALL HAVE A MINIMUM ASTM TYP III SHEETING WITH A WHITE LEGEND ON A GREEN BACKGROUND.
- LEGEND SHALL CONFORM WITH THE STANDARD ALPHABETS FOR HIGHWAY SIGNS APPROVED BY THE NATIONAL JOINT COMMITTEE ON UNIFORM TRAFFIC CONTROL DEVICES.
- ALL SIGNS SHALL BE IN ACCORDANCE WITH "THE MANUAL ON UNIFORM TRAFFIC CONTROL DEVICES" (2003 MUTCD) AND THE "STANDARD HIGHWAY SIGNS" BOOK (SHS) PUBLISHED BY THE FEDERAL HIGHWAY ADMINISTRATION (FHWA).


PROJECT NAME:	LUDLOW - WAITSFIELD
PROJECT NUMBER:	STPG SIGN (27)
FILE NAME:	09B058_TS.DGN
PLOT DATE:	16-SEP-2009
PROJECT LEADER:	N. AVERY
DRAWN BY:	N. AVERY
DESIGNED BY:	N. AVERY
CHECKED BY:	A. GAMBLE
COUNTY / TOWN LINE DESIGN	SHEET 4 OF 204




D1-1

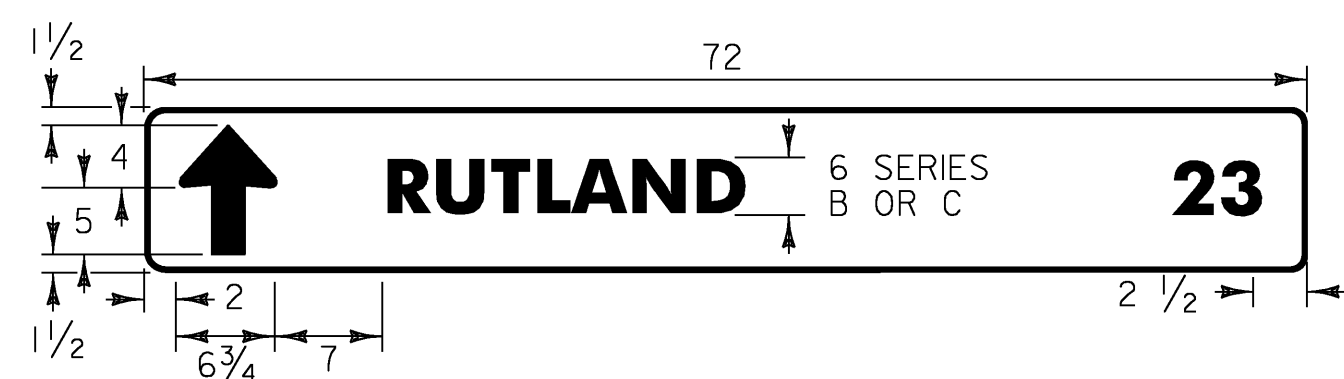


D1-1A

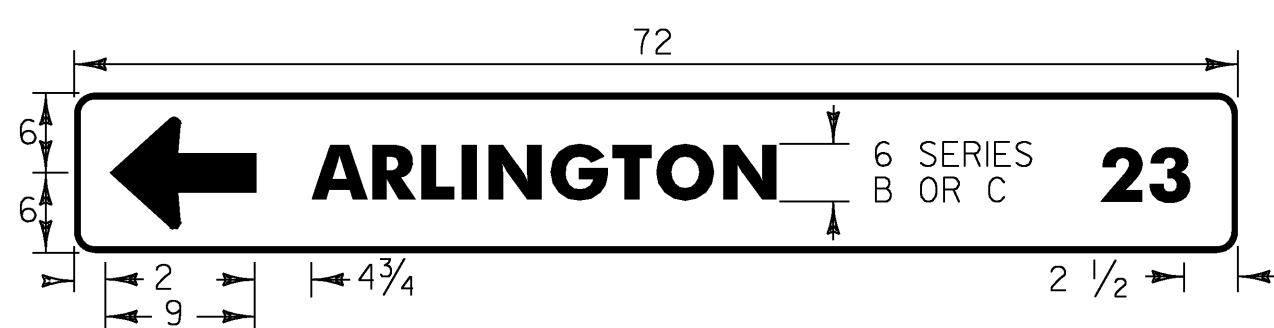


D1-1A

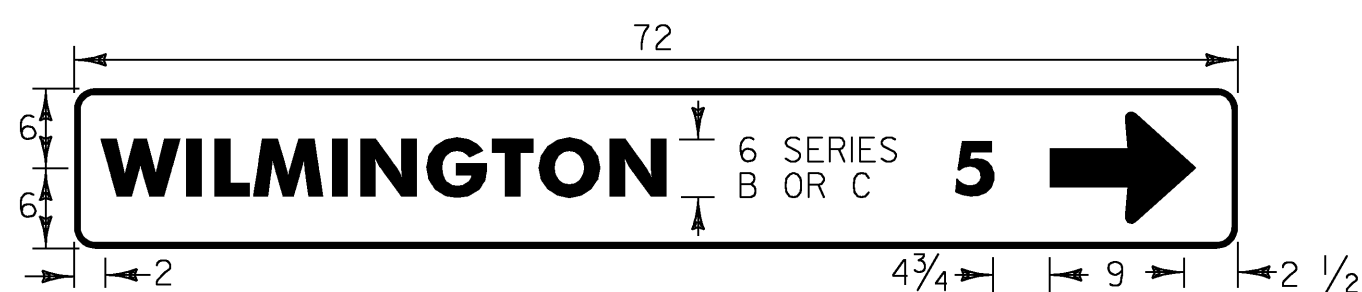


D1-1A

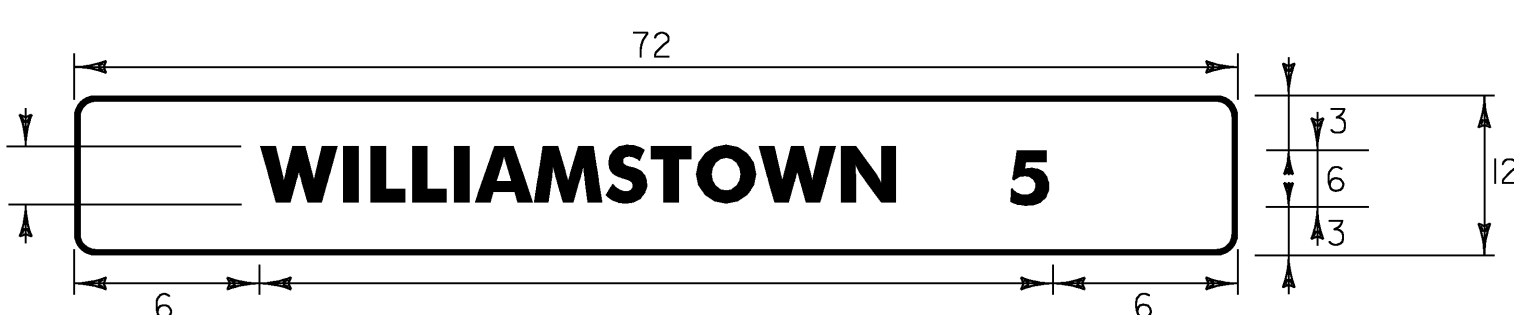

D2-1

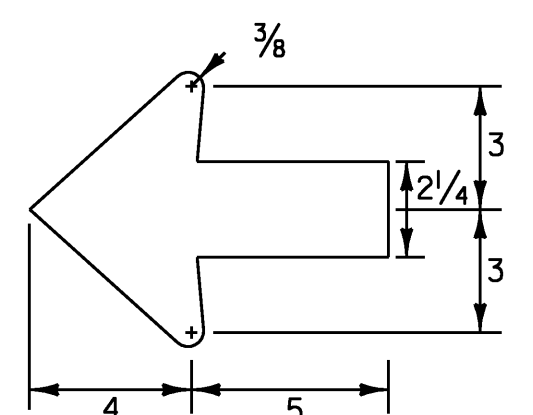


STANDARD ARROW

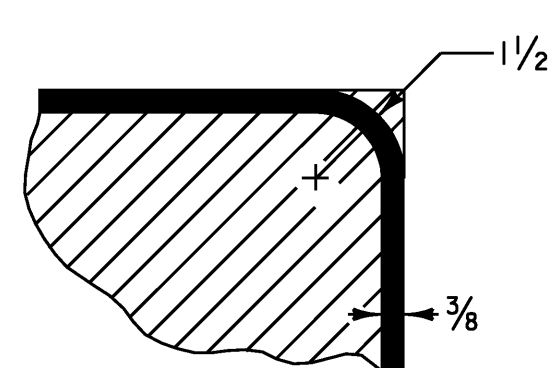

BORDER DETAIL


**STANDARD DESTINATION SIGN NOTES
D1-1, D1-1A, D1-2, D2-1**

1. THE SIGN BASE MATERIAL FOR STANDARD DESTINATION SIGNS SHALL BE HIGH DENSITY OVERLAYED PLYWOOD 3/8" THICK OR FLAT SHEET ALUMINUM 1/8" THICK.
2. THE DESTINATION SIGNS SHOWN ON THIS SHEET SHALL HAVE WHITE RETROREFLECTIVE ASTM TYPE III TEXT, ARROWS AND BORDERS ON A GREEN RETROREFLECTIVE ASTM TYPE III BACKGROUND. THE COLORS SHALL CONFORM WITH THE COLORS ADOPTED BY AASHTO AND APPROVED BY THE FHWA.
3. MULTIPLE ASSEMBLIES SHALL USE THE SAME SIZE THROUGHOUT. DO NOT MIX AND MATCH OLDER SIGN SIZES WITH NEW SIGN HEIGHTS AND WIDTHS.
4. ALL DIMENSIONS SHOWN IN INCHES UNLESS OTHERWISE NOTED.

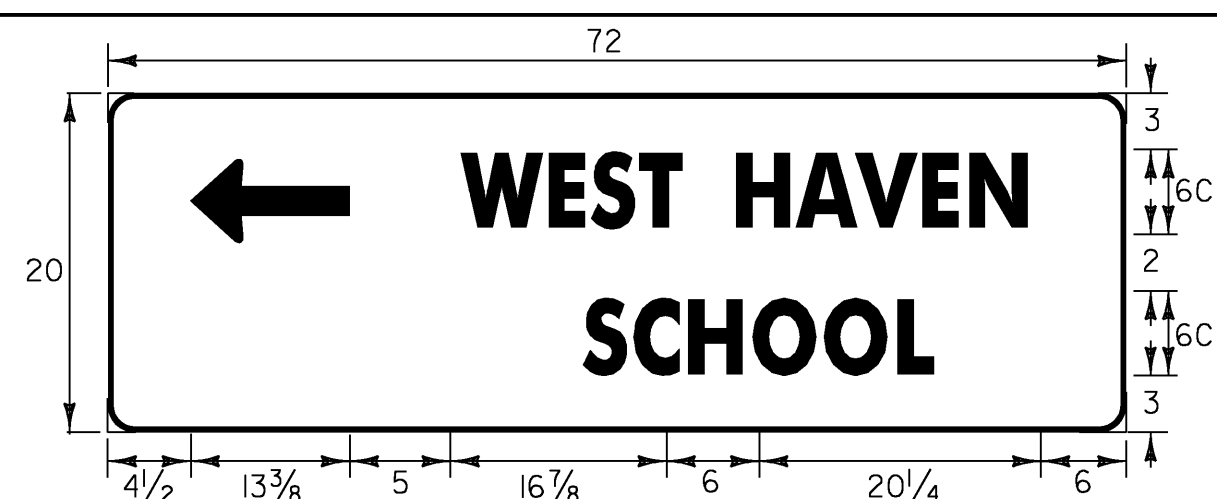


D1-2 (L)

LATERAL SPACING OF "SCHOOL" TEXT SHALL BE CENTERED TO TOP LINE TEXT.

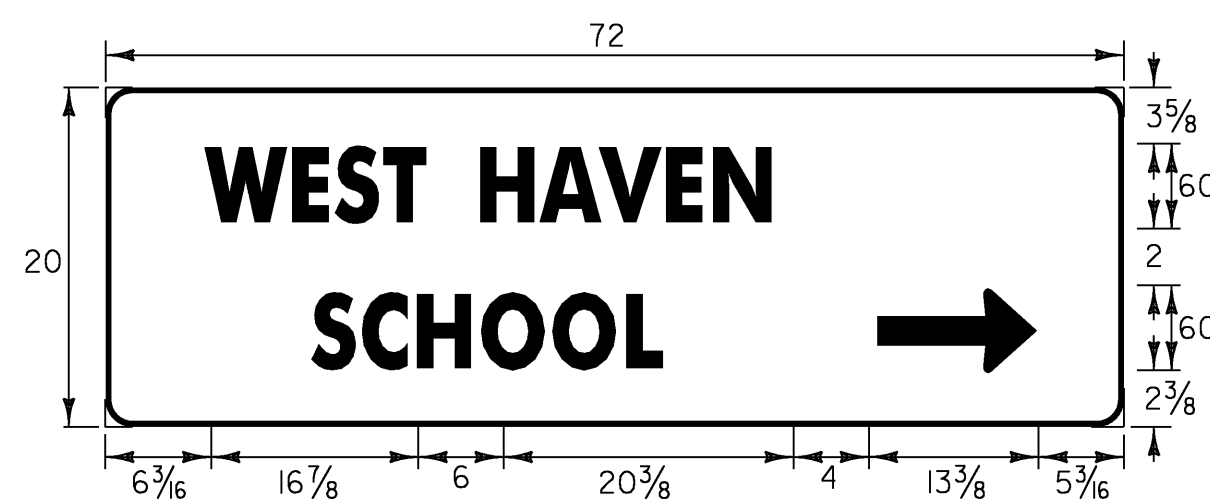

D1-2 (R)

LATERAL SPACING OF "SCHOOL" TEXT SHALL BE CENTERED TO TOP LINE TEXT.

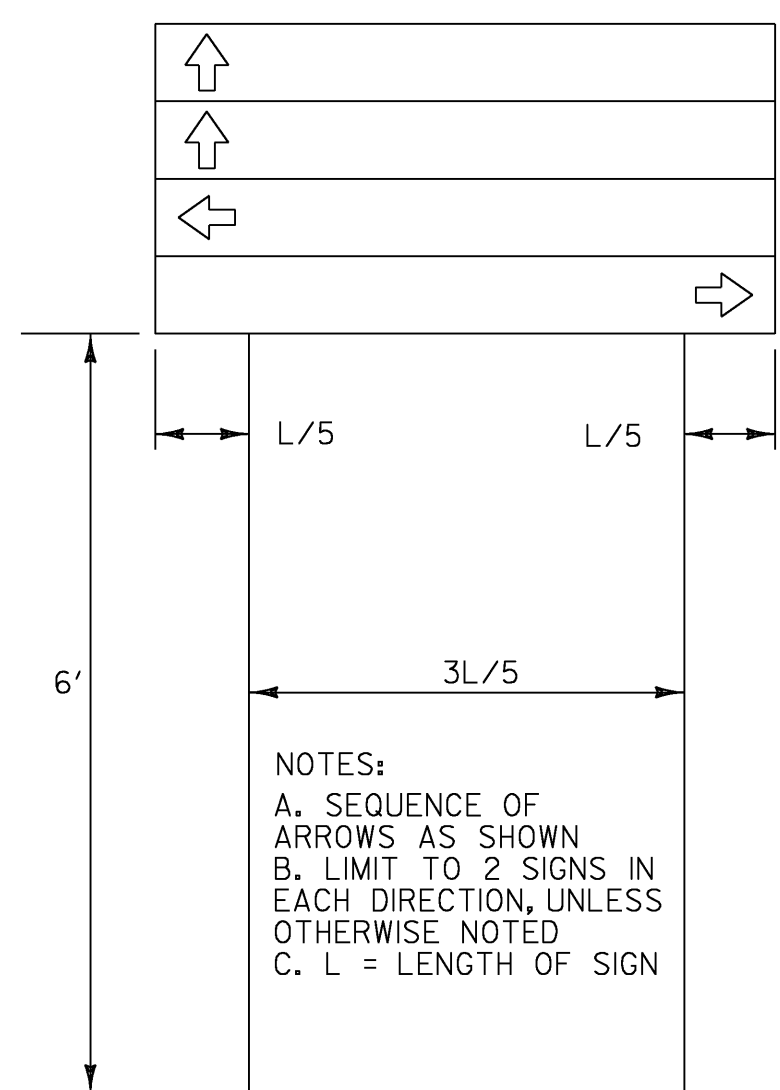

DESTINATION ASSEMBLY

NOTES:
A. SEQUENCE OF ARROWS AS SHOWN
B. LIMIT TO 2 SIGNS IN EACH DIRECTION, UNLESS OTHERWISE NOTED
C. L = LENGTH OF SIGN



VR-105

1.5" RADIUS, 0.625" BORDER, 0.375" INDENT
COLORS: LEGEND - BLACK
BACKGROUND - WHITE
TEXT STYLE: "NO" C; "OVERNIGHT" C;
"CAMPING" C



1.5" Radius, 0.4" Border, White on Green;
Standard Arrow Custom 9.0" X 6.8" 180°; "STRATTON MTN" B specified length;
"SKI" C; "AREA" C; "10" B specified length;




1.5" Radius, 0.4" Border, White on Green;
Standard Arrow Custom 9.0" X 6.8" 180°; "HAYSTACK" B; "SKI" C; "AREA" C; "3" C;

D1-1A




1.5" Radius, 0.4" Border, White on Green;
Standard Arrow Custom 9.0" X 6.8" 90°; "MOUNT SNOW" B 90% spacing; "SKI" C;
"AREA" C; "7" C;

D1-1A

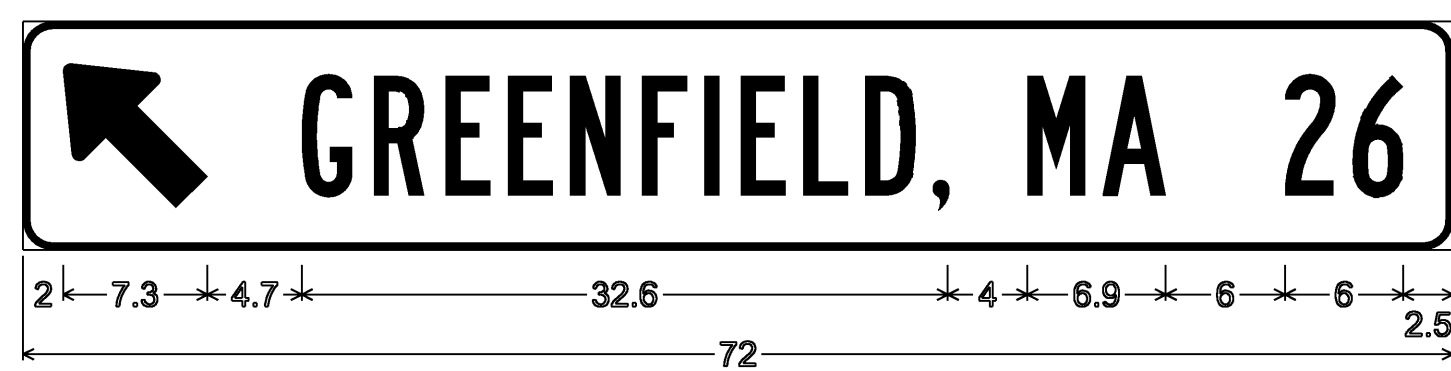


1.5" Radius, 0.4" Border, White on Green;
Arrow Custom - 9.0" 135°;
"GREENFIELD," B " C "MA" B " " C "26" B specified length;

D1-1A

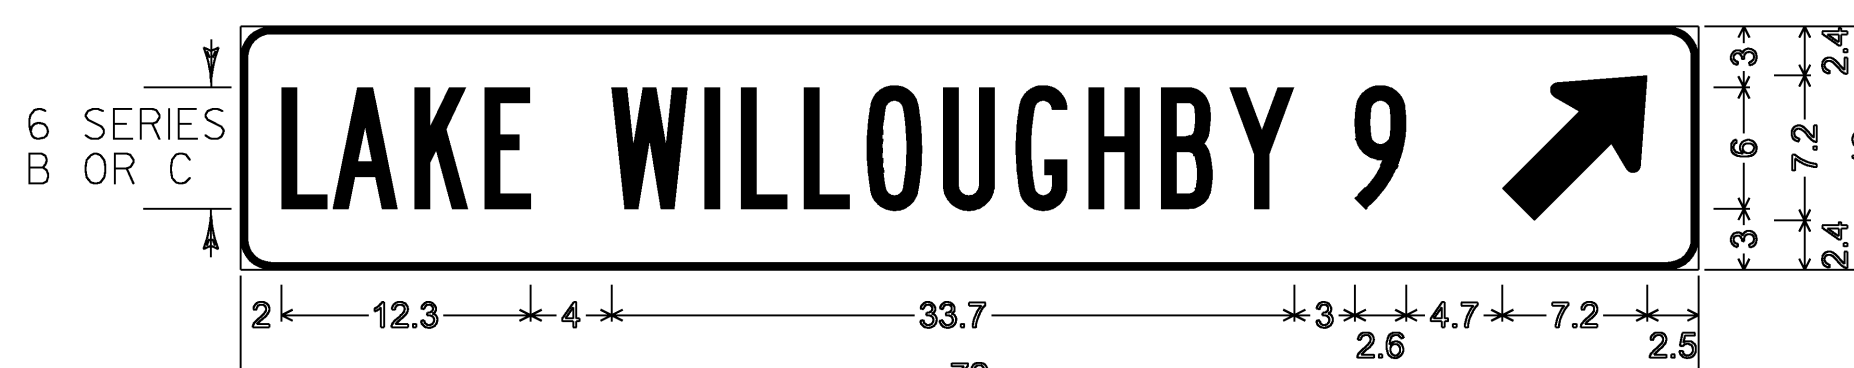




1.5" Radius, 0.4" Border, White on Green;
"LAKE WILLOUGHBY" B specified length; "9" B;
Standard Arrow Custom 9.0" X 6.0" 45°;

D1-1A

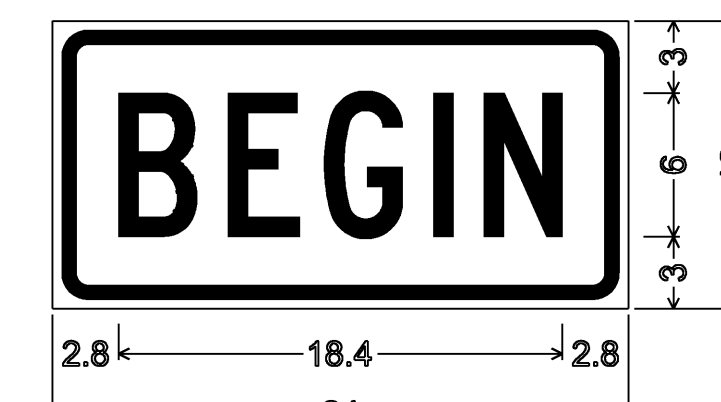

1.5" RADIUS, 0.625" BORDER, 0.375" INDENT
COLORS: LEGEND - RED
BACKGROUND - WHITE
TEXT STYLE: "BEGIN" C


VR-644p

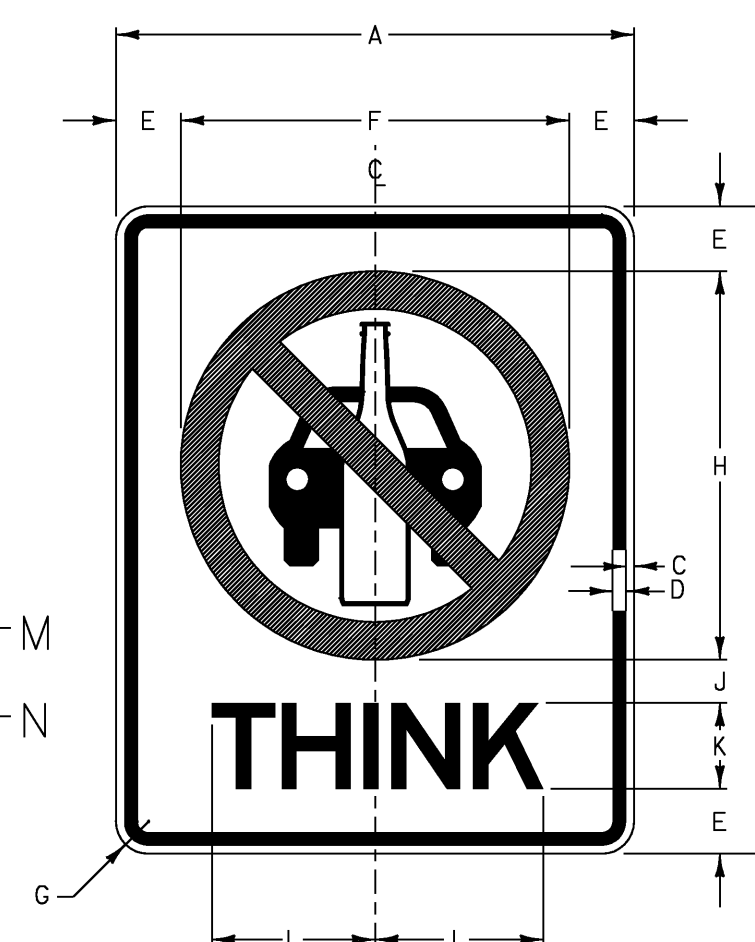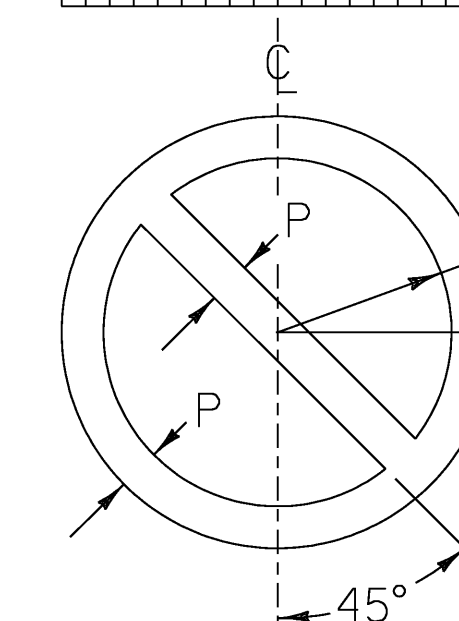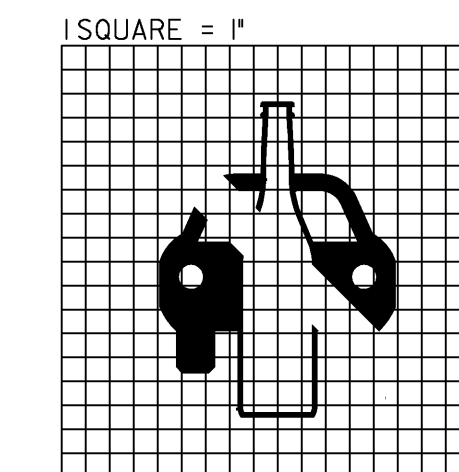

VR-072


COLORS
TEXT - BLACK (NON-REFL.)
CAR & BOTTLE SYMBOL - BLACK (NON-REFL.)
PROHIBITED SYMBOL - RED (NON-REFL.)
BACKGROUND - WHITE (REFL.)

SIGN	DIMENSIONS (INCHES)													
	A	B	C	D	E	F	G	H	J	K	L	M	N	P
STD.	24	30	3/8	5/8	3	18	1 1/2	18	2	4E	7 1/16	7 1/4	9	1 3/4

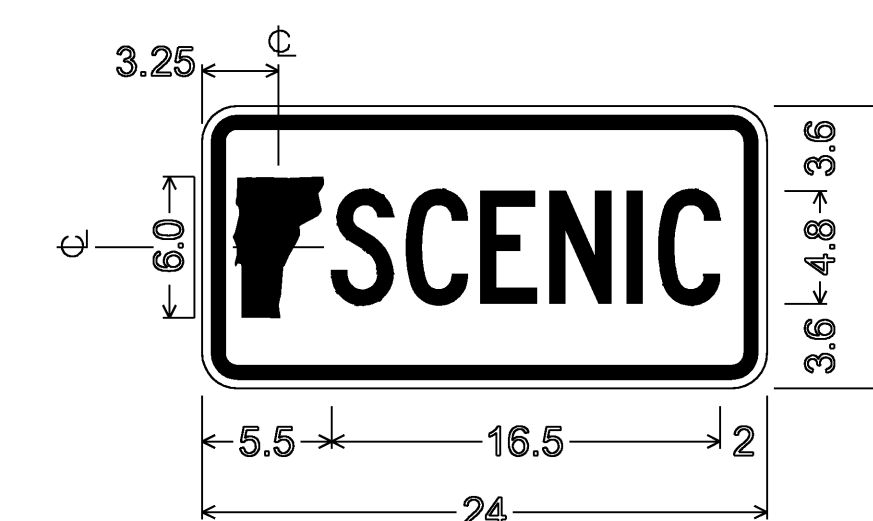

1.5" RADIUS, 0.625" BORDER, 0.375" INDENT
COLORS: LEGEND - GREEN
BACKGROUND - WHITE
TEXT STYLE: "SCENIC" C; SPECIFIED LENGTH







VM-064

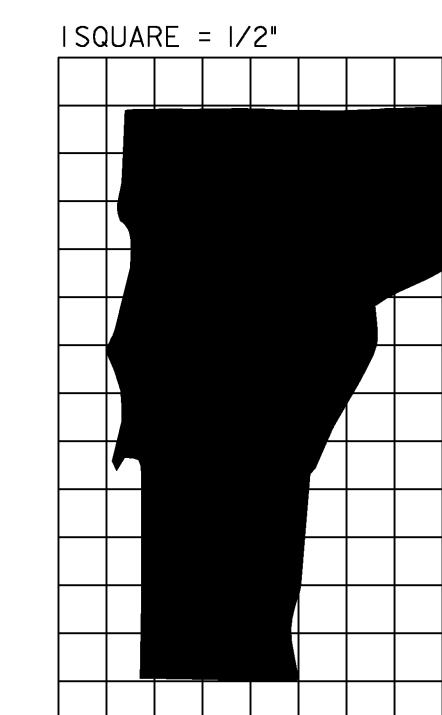

PROJECT NAME: LUDLOW - WAITSFIELD
PROJECT NUMBER: STPG SIGN (27)

FILE NAME: 09B058_TS.DGN
PROJECT LEADER: N. AVERY
DESIGNED BY: N. AVERY
SIGN DETAILS I

PLOT DATE: 16-SEP-2009
DRAWN BY: N. AVERY
CHECKED BY: A. GAMBLE
SHEET 5 OF 204

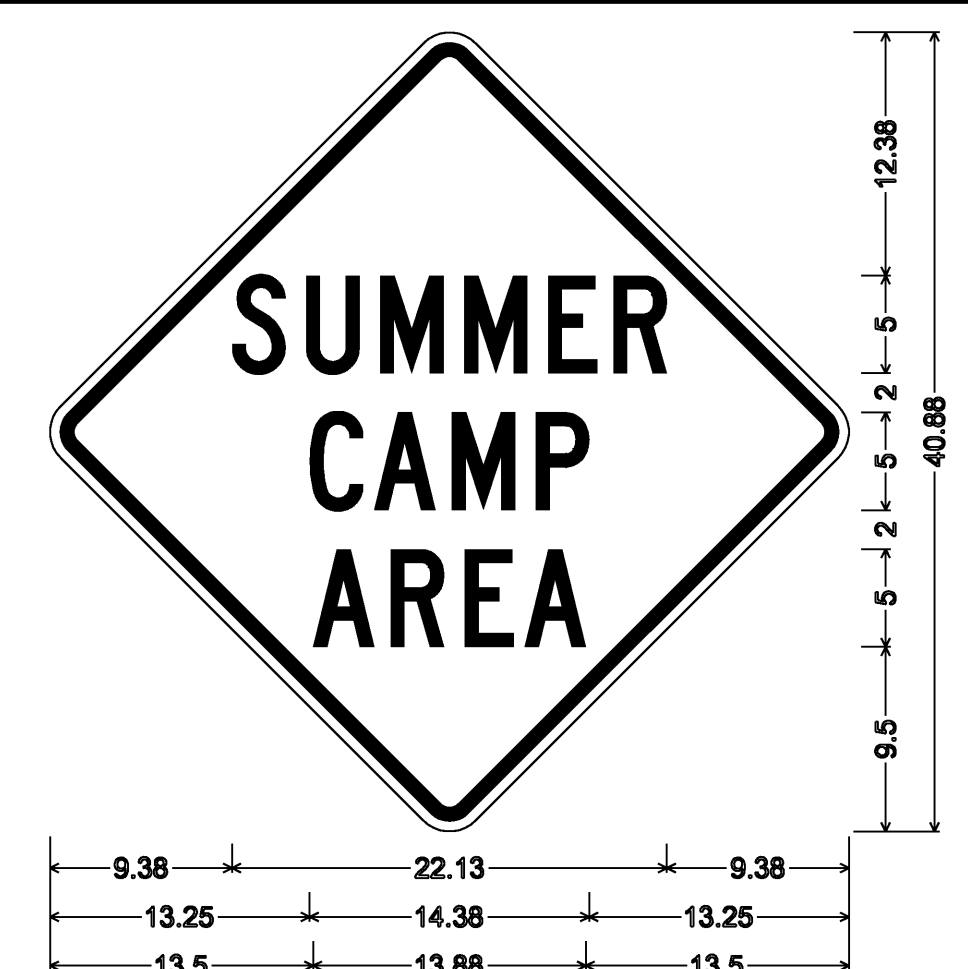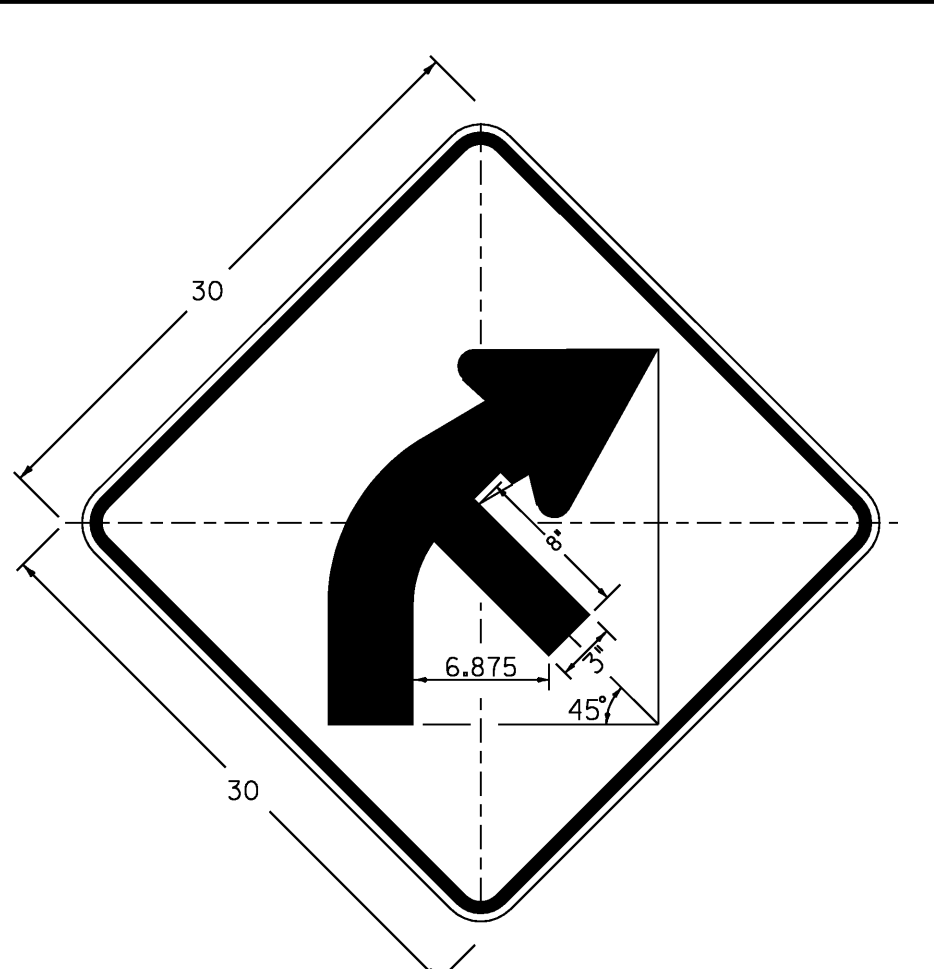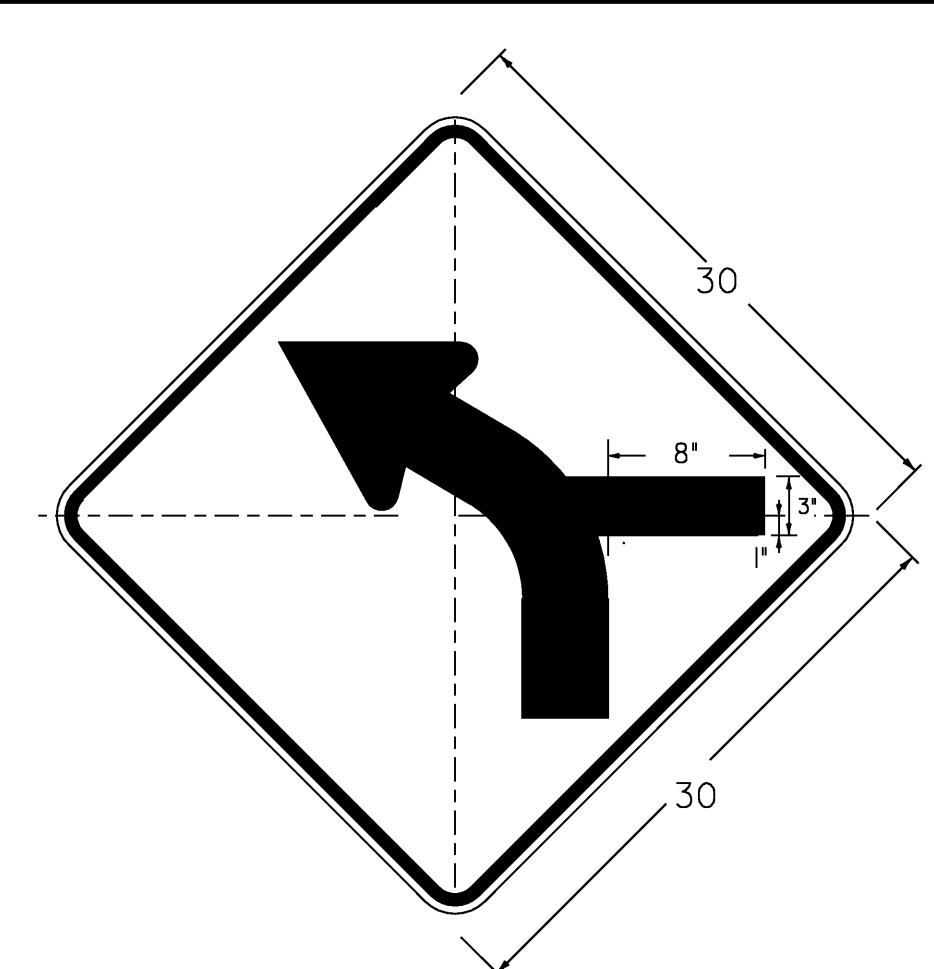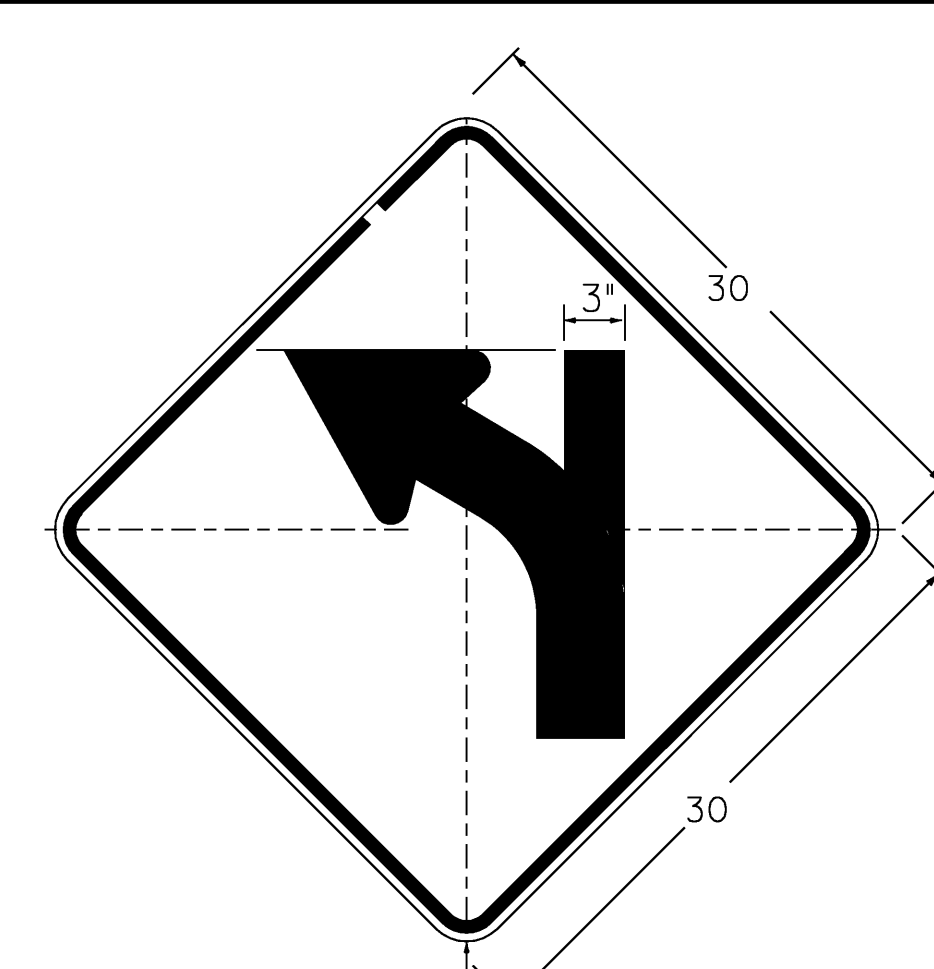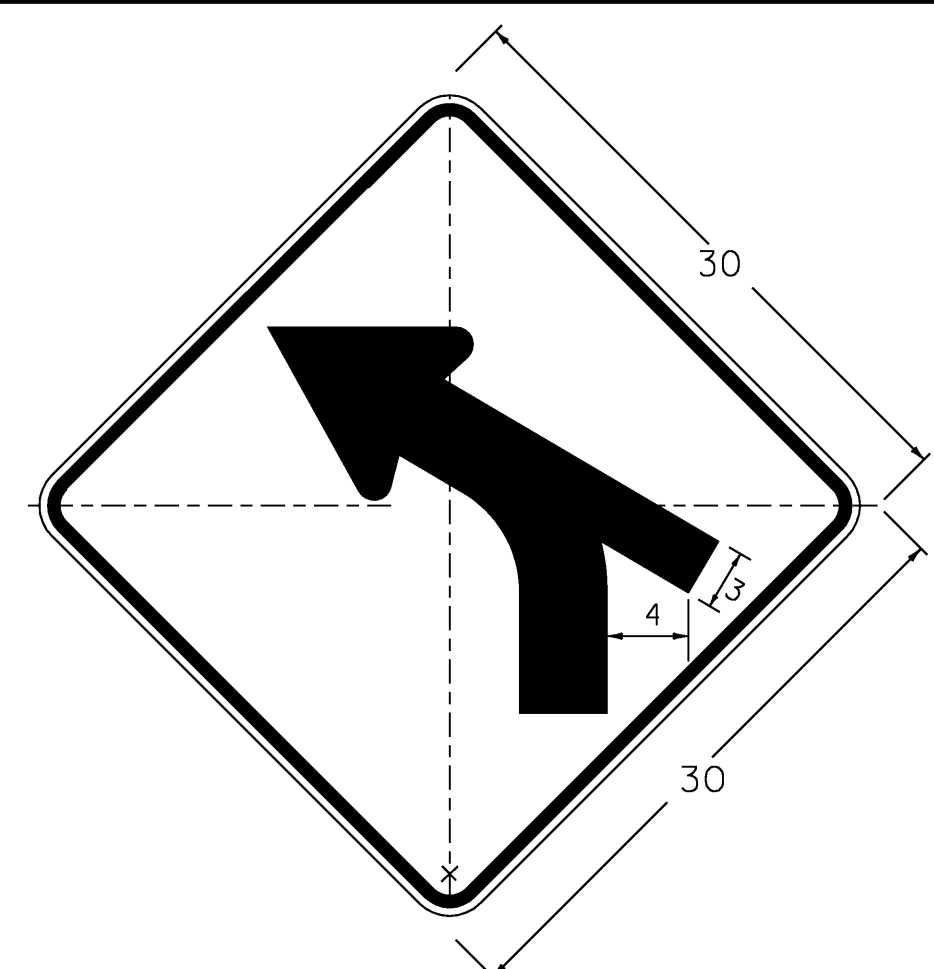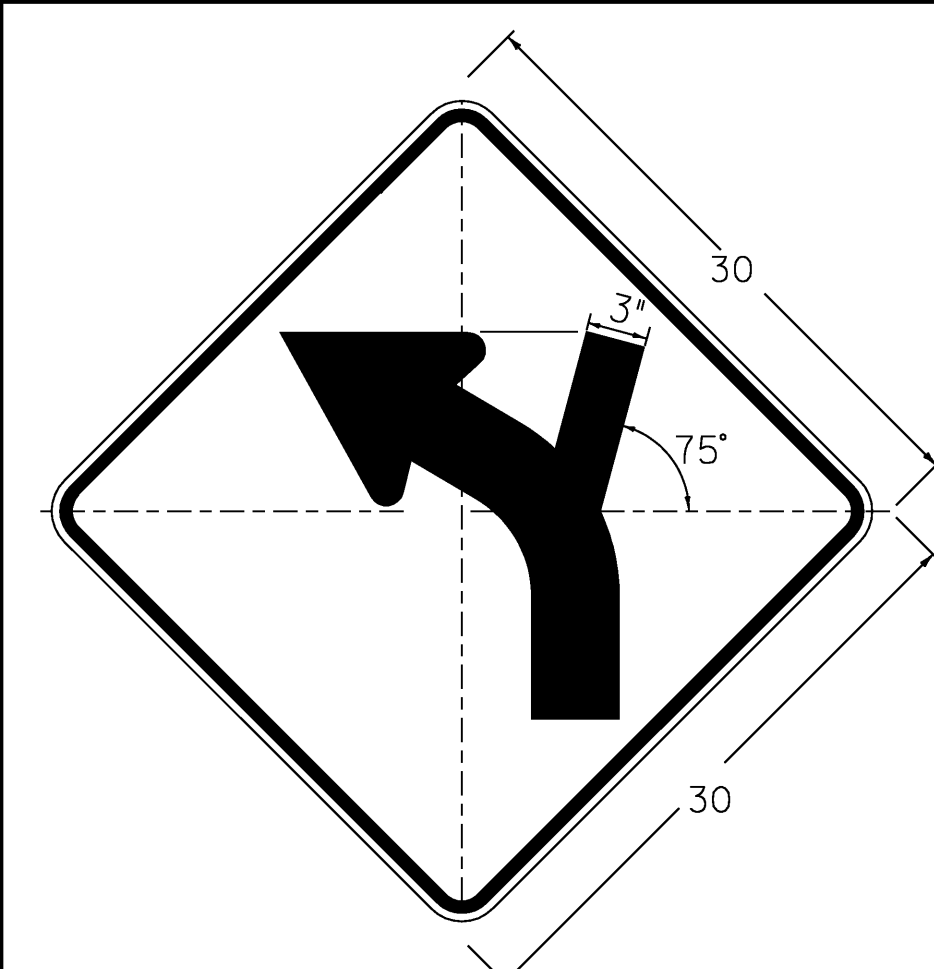

W1-2Mi L(R)
DIMENSIONS NOT SHOWN
FOR THIS DETAIL SHALL CONFORM
TO THE LATEST EDITION OF THE 2003 MUTCD
FOR SIGN DETAIL W1-2.
UNLESS OTHERWISE NOTED FOR THIS DETAIL







W1-2Mh L(R)
DIMENSIONS NOT SHOWN
FOR THIS DETAIL SHALL CONFORM
TO THE LATEST EDITION OF THE 2003 MUTCD
FOR SIGN DETAIL W1-2.
UNLESS OTHERWISE NOTED FOR THIS DETAIL

W1-2Mg L
DIMENSIONS NOT SHOWN
FOR THIS DETAIL SHALL CONFORM
TO THE LATEST EDITION OF THE 2003 MUTCD
FOR SIGN DETAIL W1-2.
UNLESS OTHERWISE NOTED FOR THIS DETAIL

W1-2Mc L
DIMENSIONS NOT SHOWN
FOR THIS DETAIL SHALL CONFORM
TO THE LATEST EDITION OF THE 2003 MUTCD
FOR SIGN DETAIL W1-2.
UNLESS OTHERWISE NOTED FOR THIS DETAIL

W1-2Mb R(L)
DIMENSIONS NOT SHOWN
FOR THIS DETAIL SHALL CONFORM
TO THE LATEST EDITION OF THE 2003 MUTCD
FOR SIGN DETAIL W1-2.
UNLESS OTHERWISE NOTED FOR THIS DETAIL

1.875" RADIUS, 0.75" BORDER, 0.5" INDENT
COLORS: LEGEND - BLACK
BACKGROUND - YELLOW
TEXT STYLE: "SUMMER" C; "CAMP" C; "AHEAD" C
VW-219

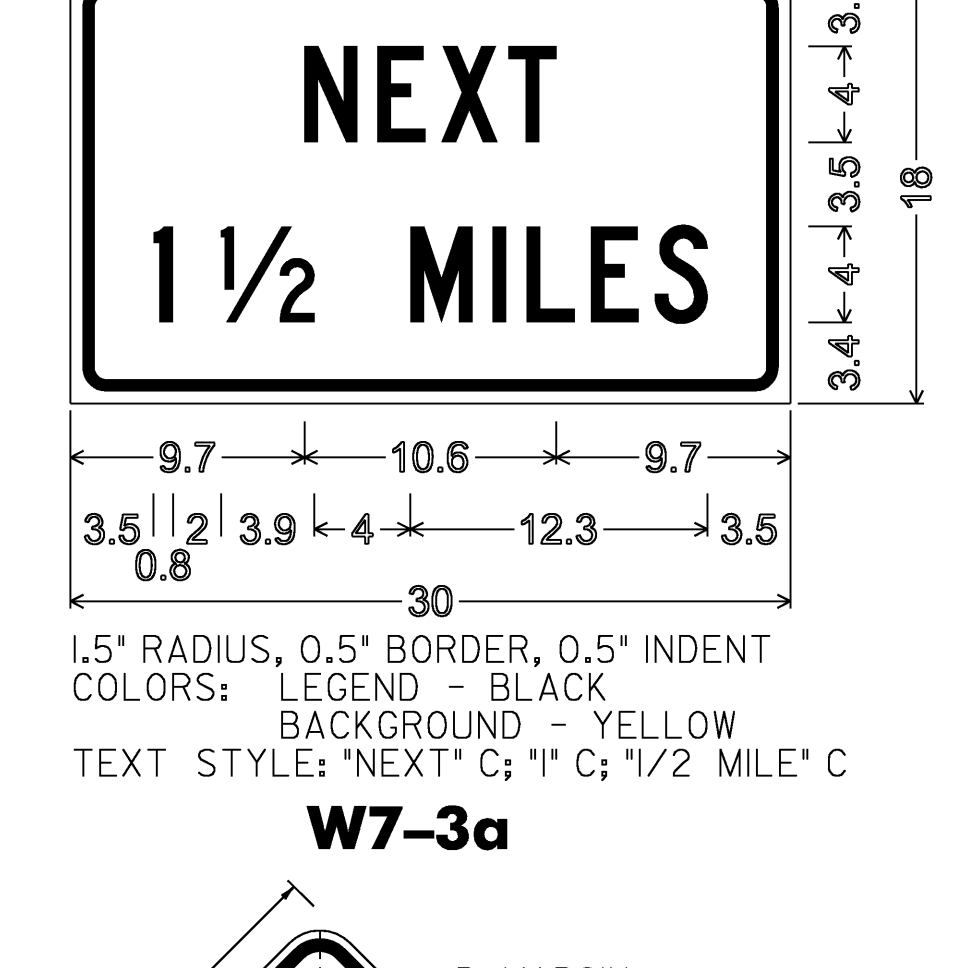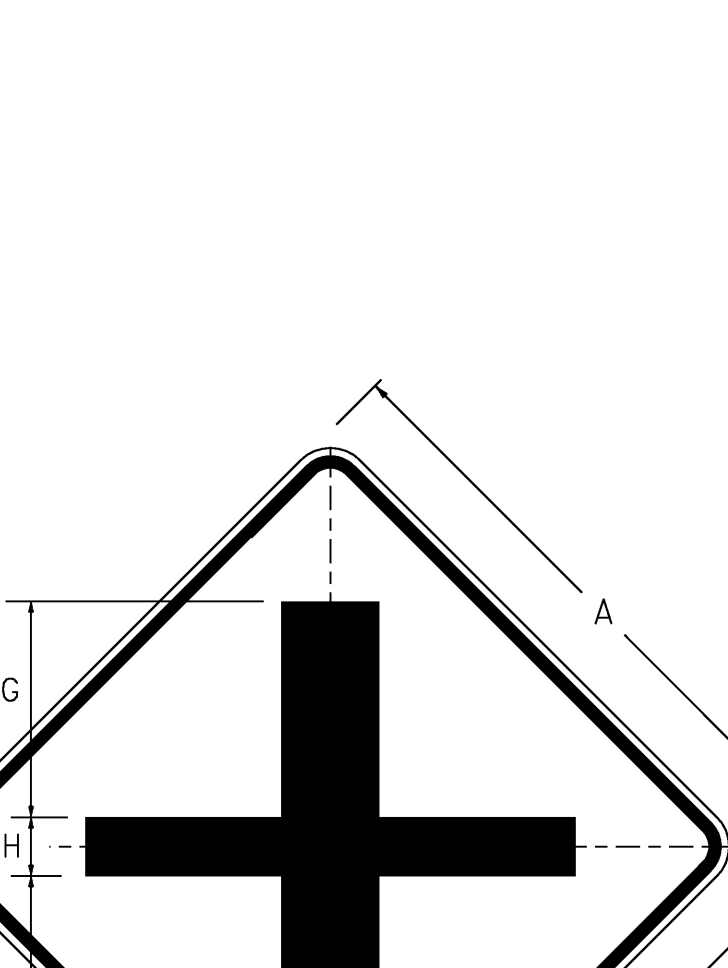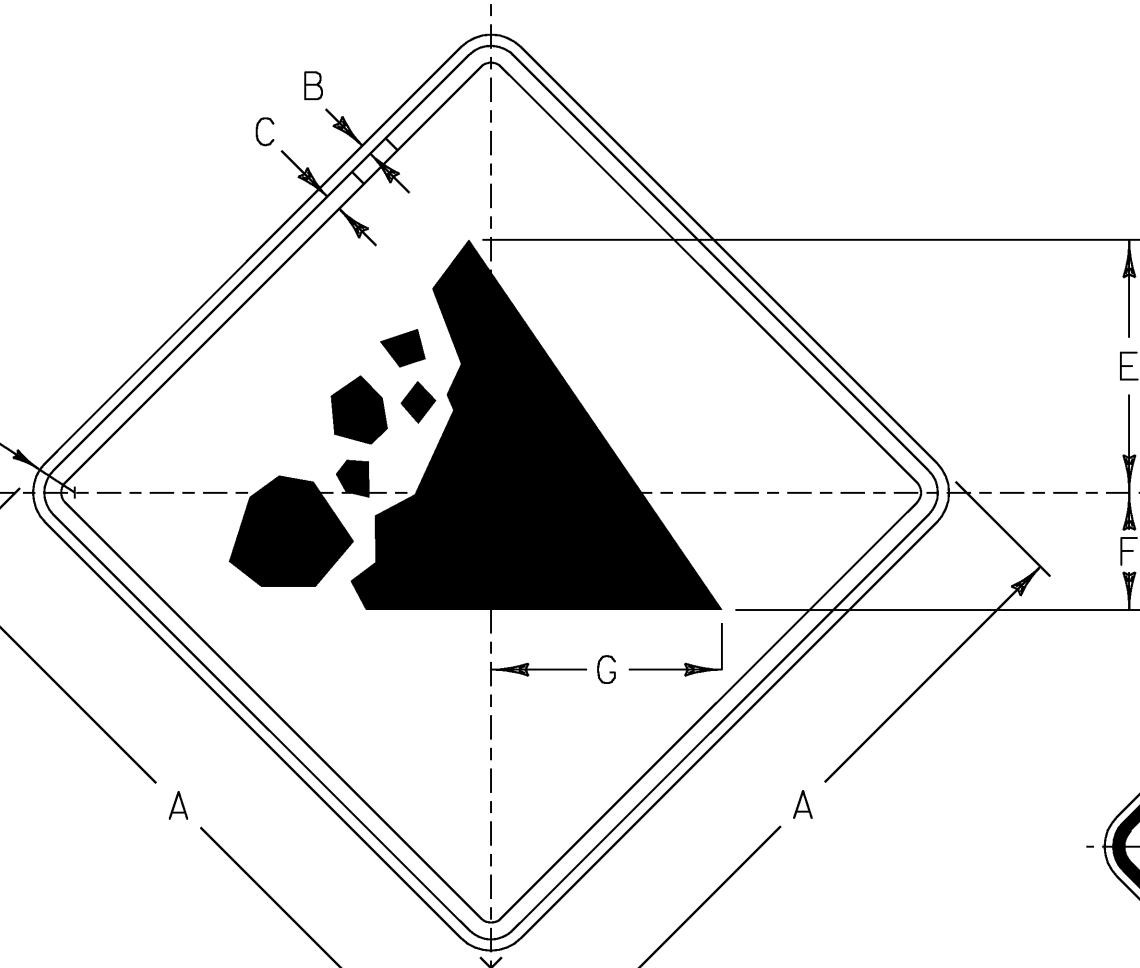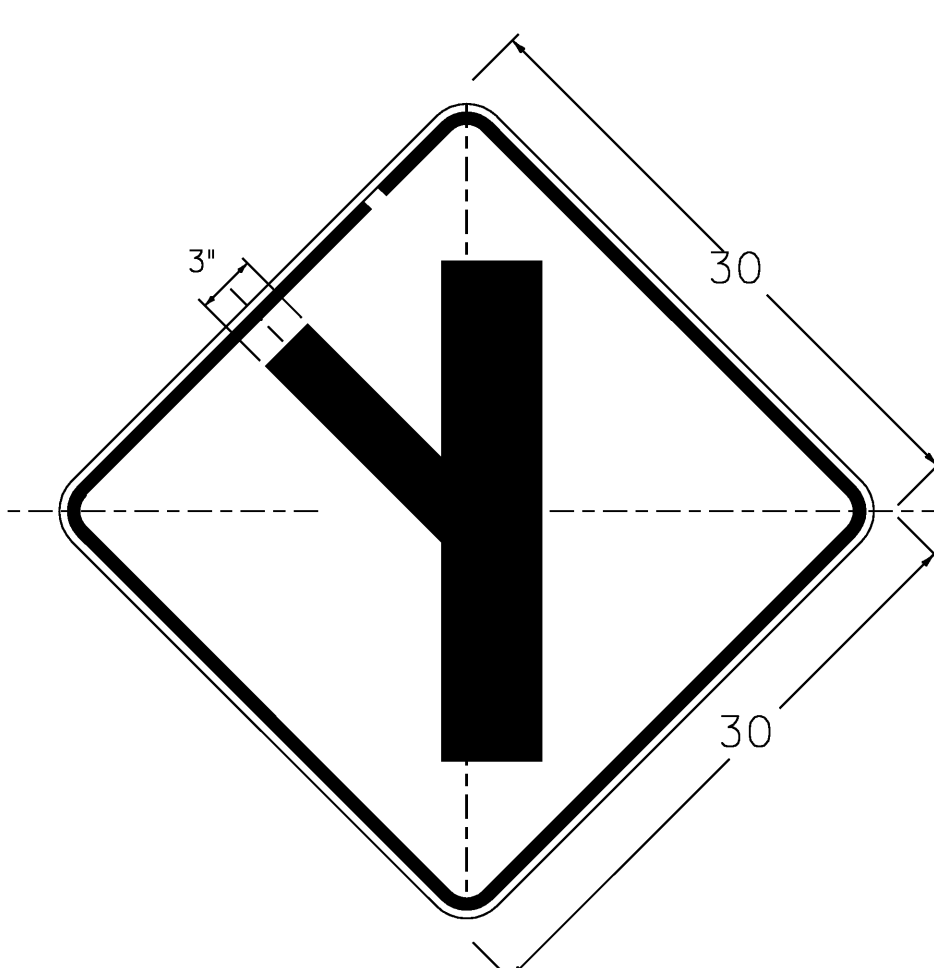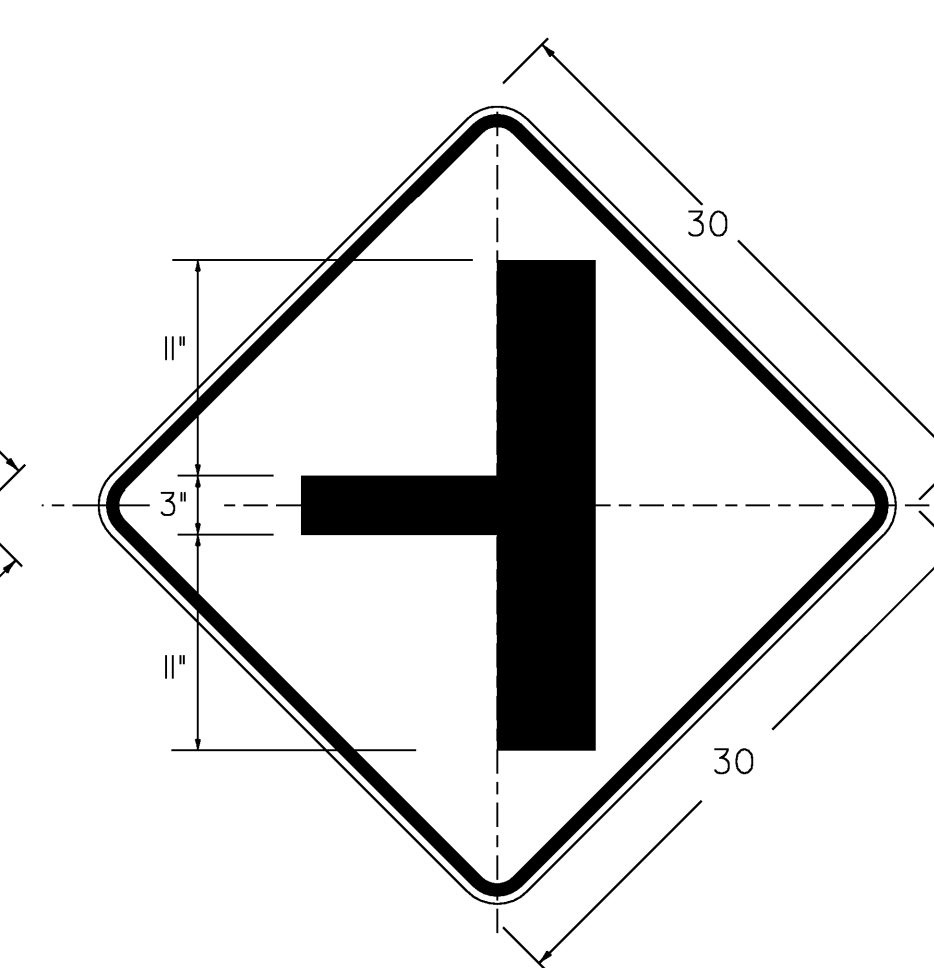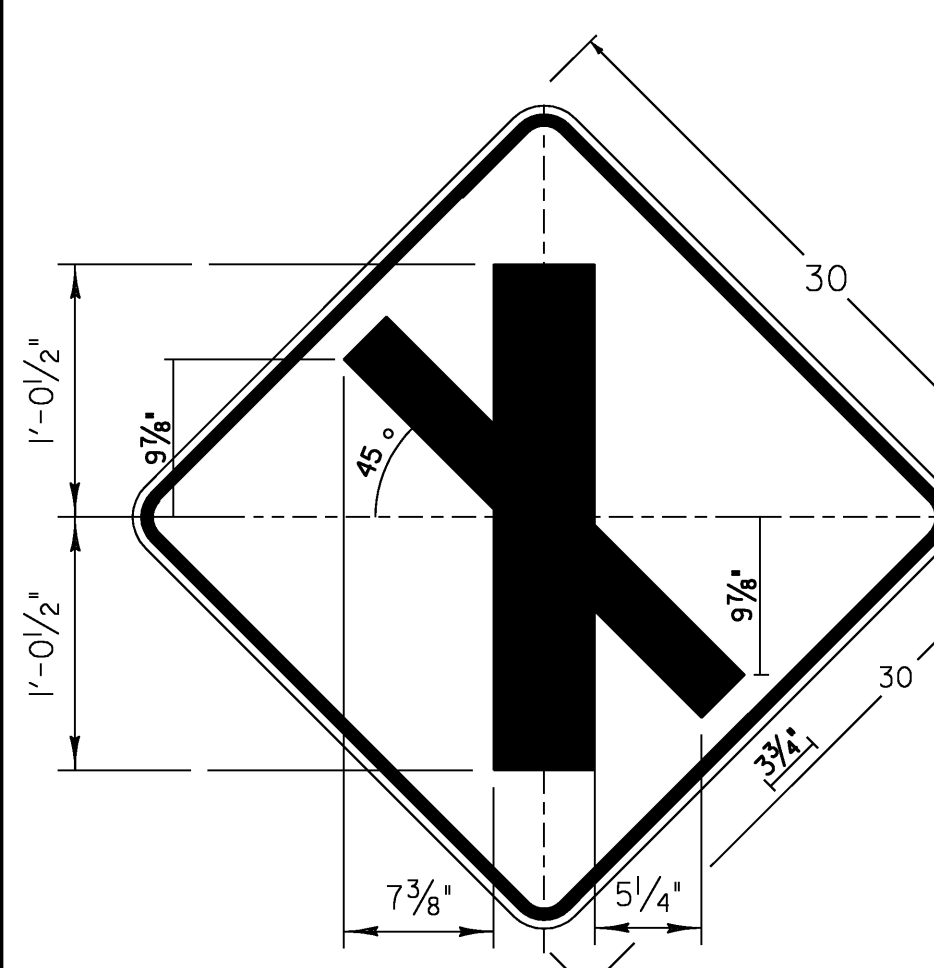

W2-1Mh
DIMENSIONS NOT SHOWN
FOR THIS DETAIL SHALL CONFORM
TO THE LATEST EDITION OF THE 2003 MUTCD
FOR SIGN DETAIL W2-1.
UNLESS OTHERWISE NOTED FOR THIS DETAIL





W2-2Ma L(R)
DIMENSIONS NOT SHOWN
FOR THIS DETAIL SHALL CONFORM
TO THE LATEST EDITION OF THE 2003 MUTCD
FOR SIGN DETAIL W2-2.
UNLESS OTHERWISE NOTED FOR THIS DETAIL

W2-3Ma L(R)
DIMENSIONS NOT SHOWN
FOR THIS DETAIL SHALL CONFORM
TO THE LATEST EDITION OF THE 2003 MUTCD
FOR SIGN DETAIL W2-3.
UNLESS OTHERWISE NOTED FOR THIS DETAIL

VW-285
COLORS: LEGEND - BLACK
BACKGROUND - YELLOW

W2-1Mb
DIMENSIONS NOT SHOWN
FOR THIS DETAIL SHALL CONFORM
TO THE LATEST EDITION OF THE 2003 MUTCD
FOR SIGN DETAIL W2-1.
UNLESS OTHERWISE NOTED FOR THIS DETAIL

1.5" RADIUS, 0.5" BORDER, 0.5" INDENT
COLORS: LEGEND - BLACK
BACKGROUND - YELLOW
TEXT STYLE: "NEXT" C; "1" C; "1/2 MILE" C
W7-3a

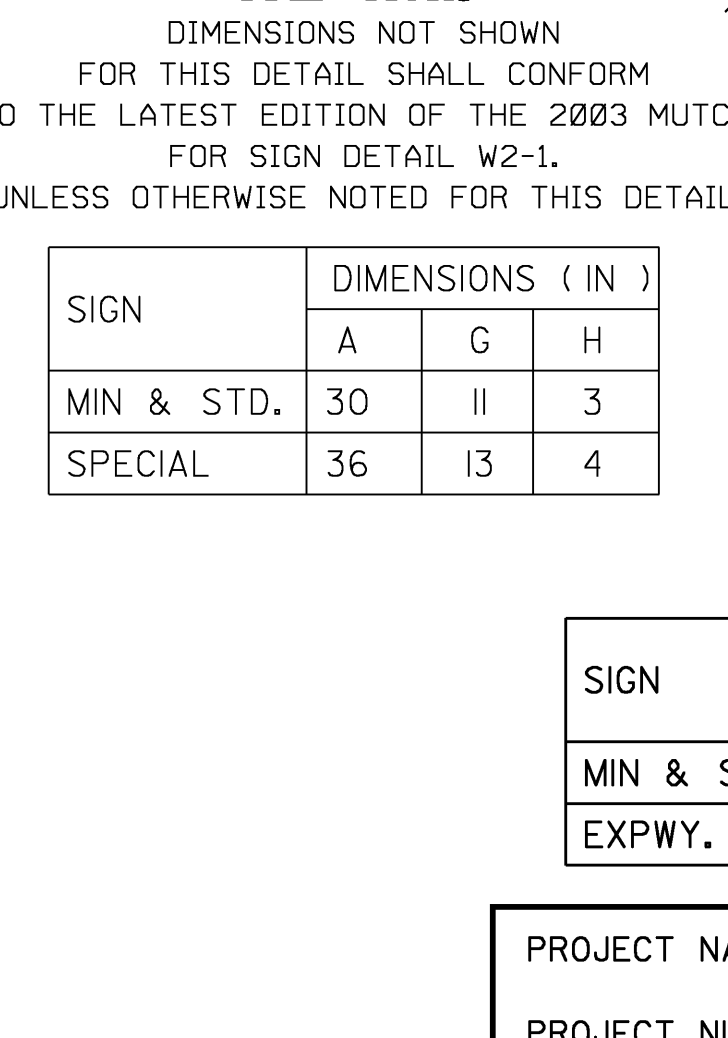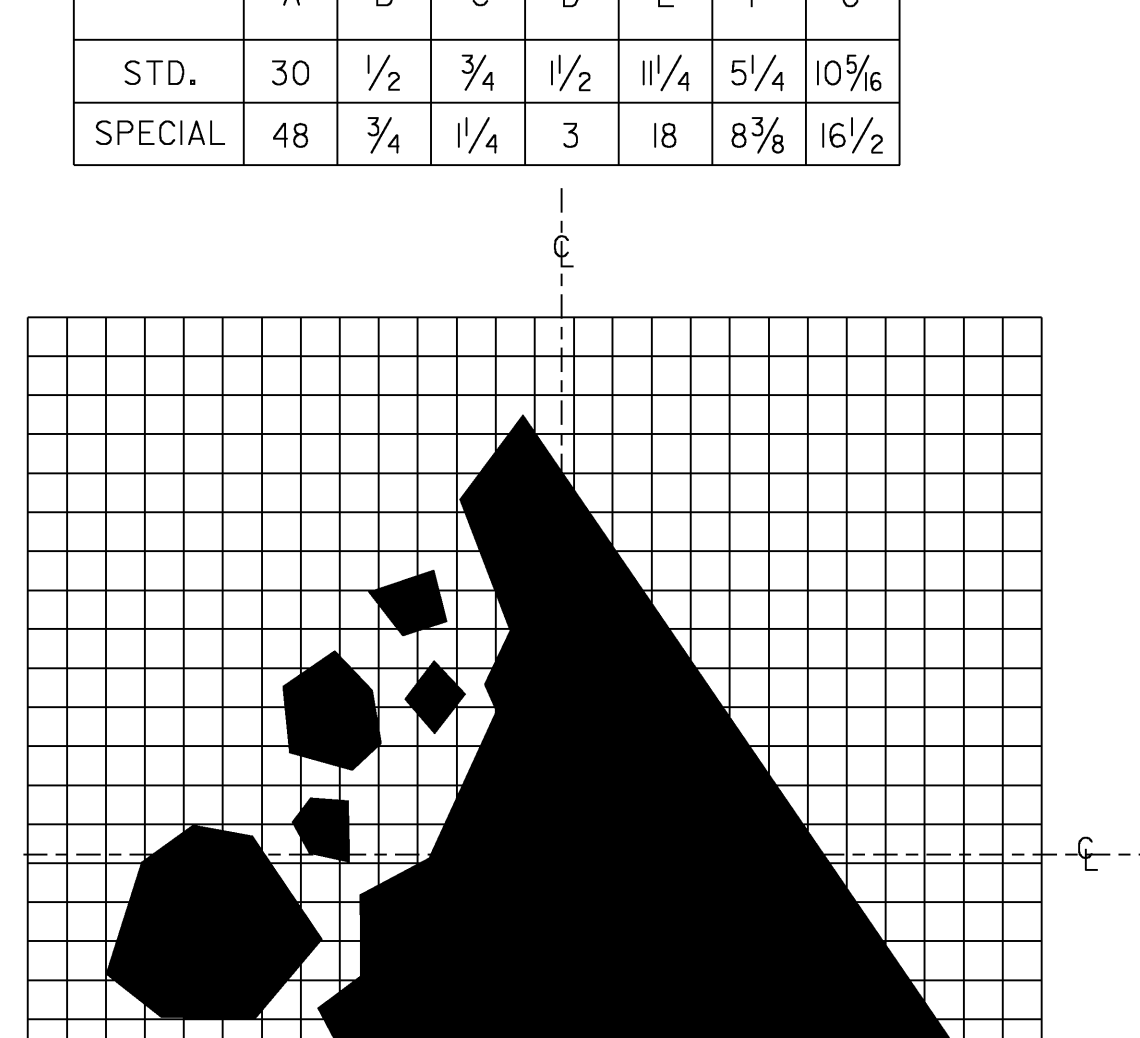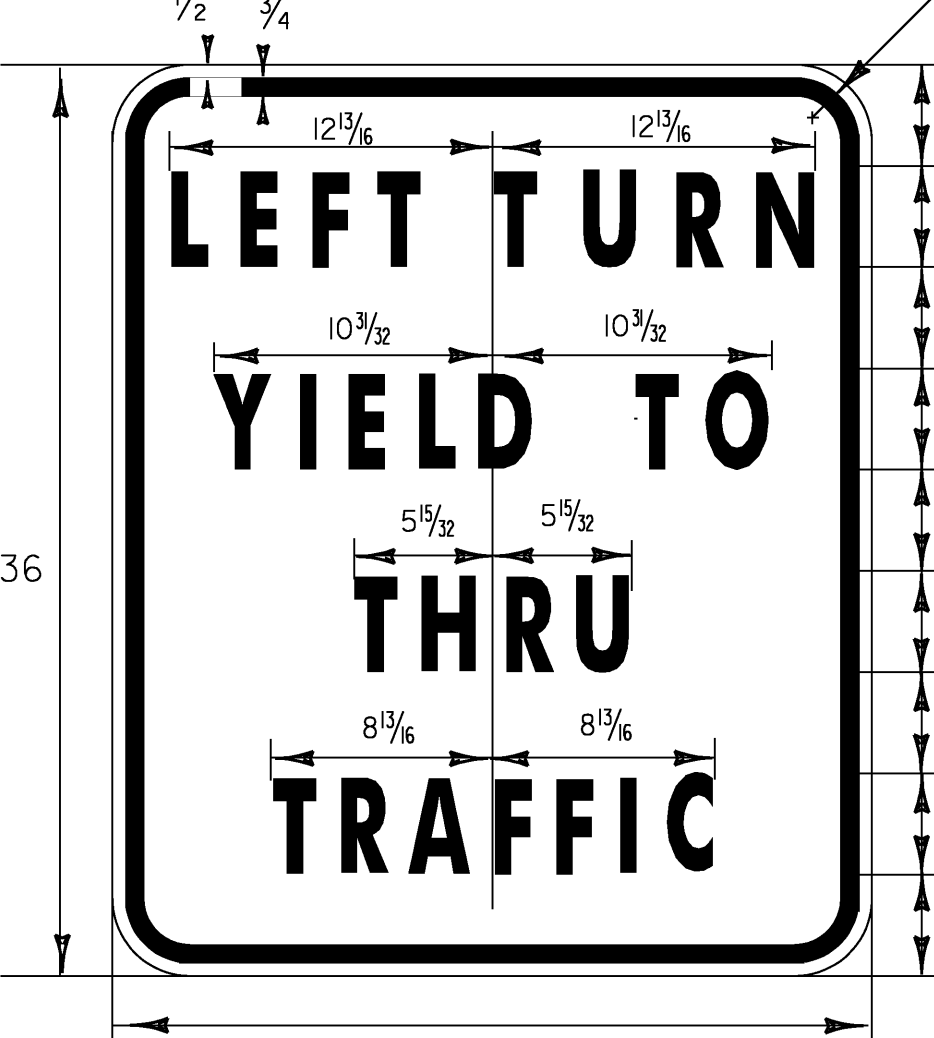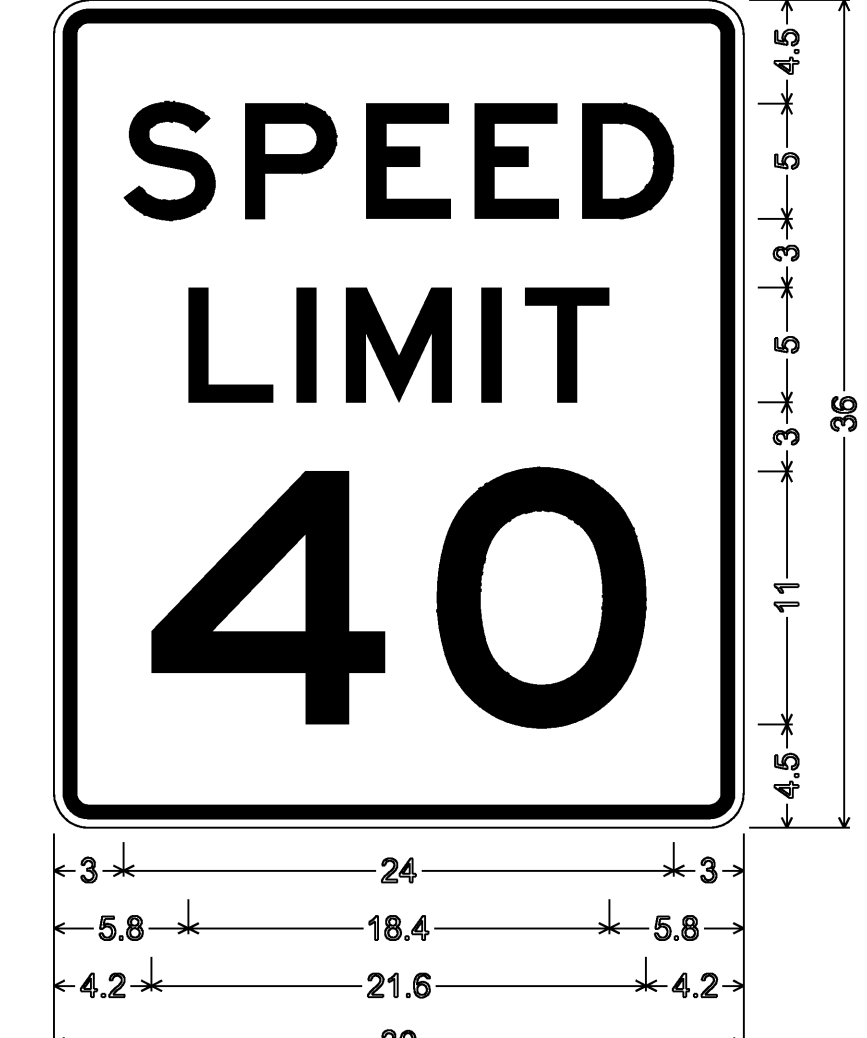

1.5" RADIUS, 0.625" BORDER, 0.375" INDENT
COLORS: LEGEND - BLACK
BACKGROUND - WHITE
TEXT STYLE: "SPEED" E; "LIMIT" E; "40" E
R2-1

COLORS: LEGEND - BLACK
BACKGROUND - WHITE
VR-615

COLORS: LEGEND - RED
BACKGROUND - WHITE
VR - 020

1 SQUARE = 1"
VW-619
COLORS: LEGEND - BLACK
BACKGROUND - YELLOW

1.5" RADIUS, 0.5" BORDER, 0.5" INDENT
COLORS: LEGEND - BLACK
BACKGROUND - YELLOW
TEXT STYLE: "NEXT" C; "1" C; "1/2 MILE" C
W7-3a


SIGN	DIMENSIONS (INCHES)						
	A	B	C	D	E	F	G
STD.	30	1/2	3/4	1 1/2	1 1/4	5/4	10 5/16
SPECIAL	48	3/4	1 1/4	3	18	8 3/8	16 1/2

SIGN	DIMENSIONS (IN)		
	A	G	H
MIN & STD.	30	11	3
SPECIAL	36	13	4

SIGN	DIMENSIONS (INCHES)												
	A	B	C	D	E	F	G	H	J	K	L	M	
MIN & STD.	36	5/8	7/8	5C	3	6D	1	13 1/16	13 1/16	17 3/8	18 1/4	2 1/4	
EXPWY.	48	3/4	1 1/4	7D	3 1/2	7D	1	23 3/8	23 3/8	21 1/2	2 1/8	3	

PROJECT NAME: LUDLOW - WAITSFIELD
PROJECT NUMBER: STPG SIGN (27)
FILE NAME: 09B058_TS.DGN
PROJECT LEADER: N. AVERY
DESIGNED BY: N. AVERY
SIGN DETAILS 2
PLOT DATE: 16-SEP-2009
DRAWN BY: N. AVERY
CHECKED BY: A. GAMBLE
SHEET 6 OF 204


ROUTE MARKER ASSEMBLY FRAMES

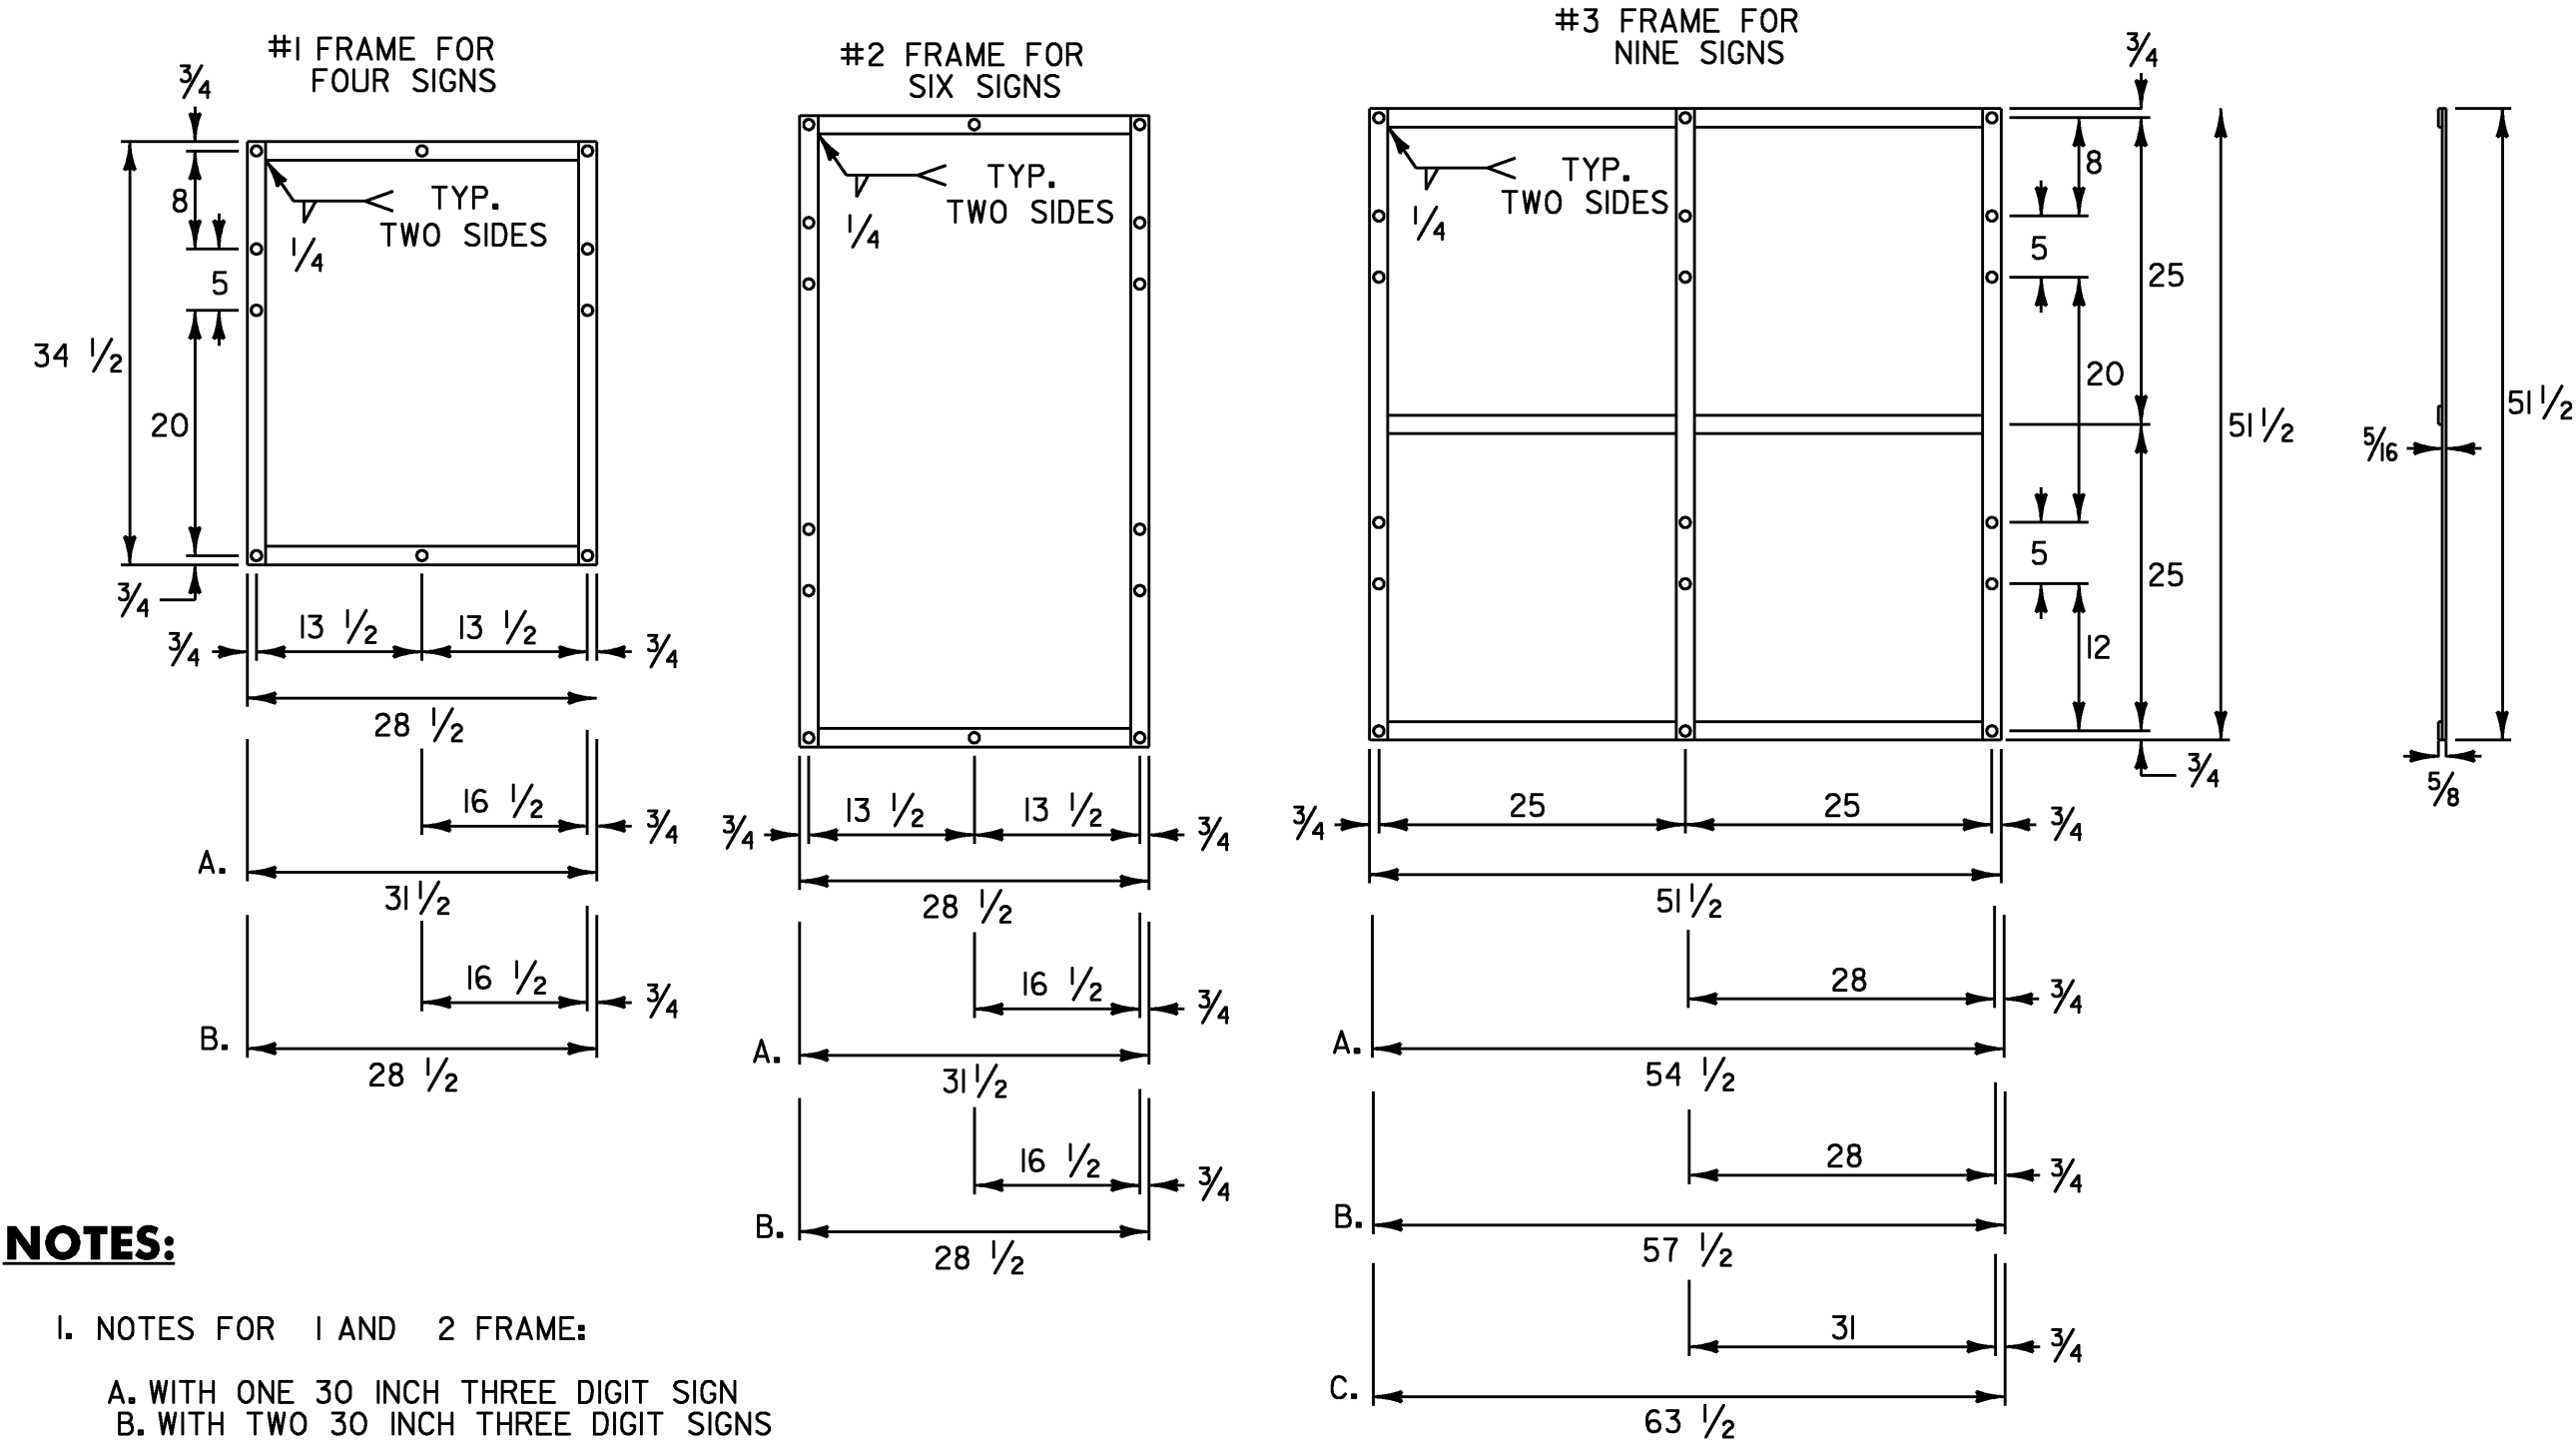

NOTES:

- NOTES FOR 1 AND 2 FRAME:
 - WITH ONE 30 INCH THREE DIGIT SIGN
 - WITH TWO 30 INCH THREE DIGIT SIGNS
- NOTES FOR 3 FRAME:
 - WITH ONE 30 INCH THREE DIGIT SIGN IN AN OUTSIDE POSITION.
 - WITH ONE 30 INCH THREE DIGIT SIGN IN THE CENTER POSITION OR TWO SUCH SIGNS IN THE OUTSIDE POSITIONS.
 - WITH THREE 30 INCH THREE DIGIT SIGNS.
- ALL HOLES SHALL BE 1/8 INCH DIAMETER. FOR OTHER SIGN COMBINATIONS THAN ABOVE, THE FRAME DIMENSIONS AND HOLE SPACING SHALL BE MODIFIED AS NECESSARY. THE FRAME SHALL BE PAINTED WITH ONE COAT OF PRIMER AND A SECOND COAT OF BLACK PAINT. THE PAINT SHALL BE OF THE TYPE USED ON EXTERIOR METAL SURFACES TO PREVENT METAL CORROSION.
- STANDARD FRAMES SHALL BE 5/16 INCH x 1 1/2 INCH WELDED A-36 STEEL.
- ALL DIMENSIONS SHOWN IN INCHES UNLESS OTHERWISE NOTED.

STANDARD MOUNTING OF ROUTE MARKER ASSEMBLIES

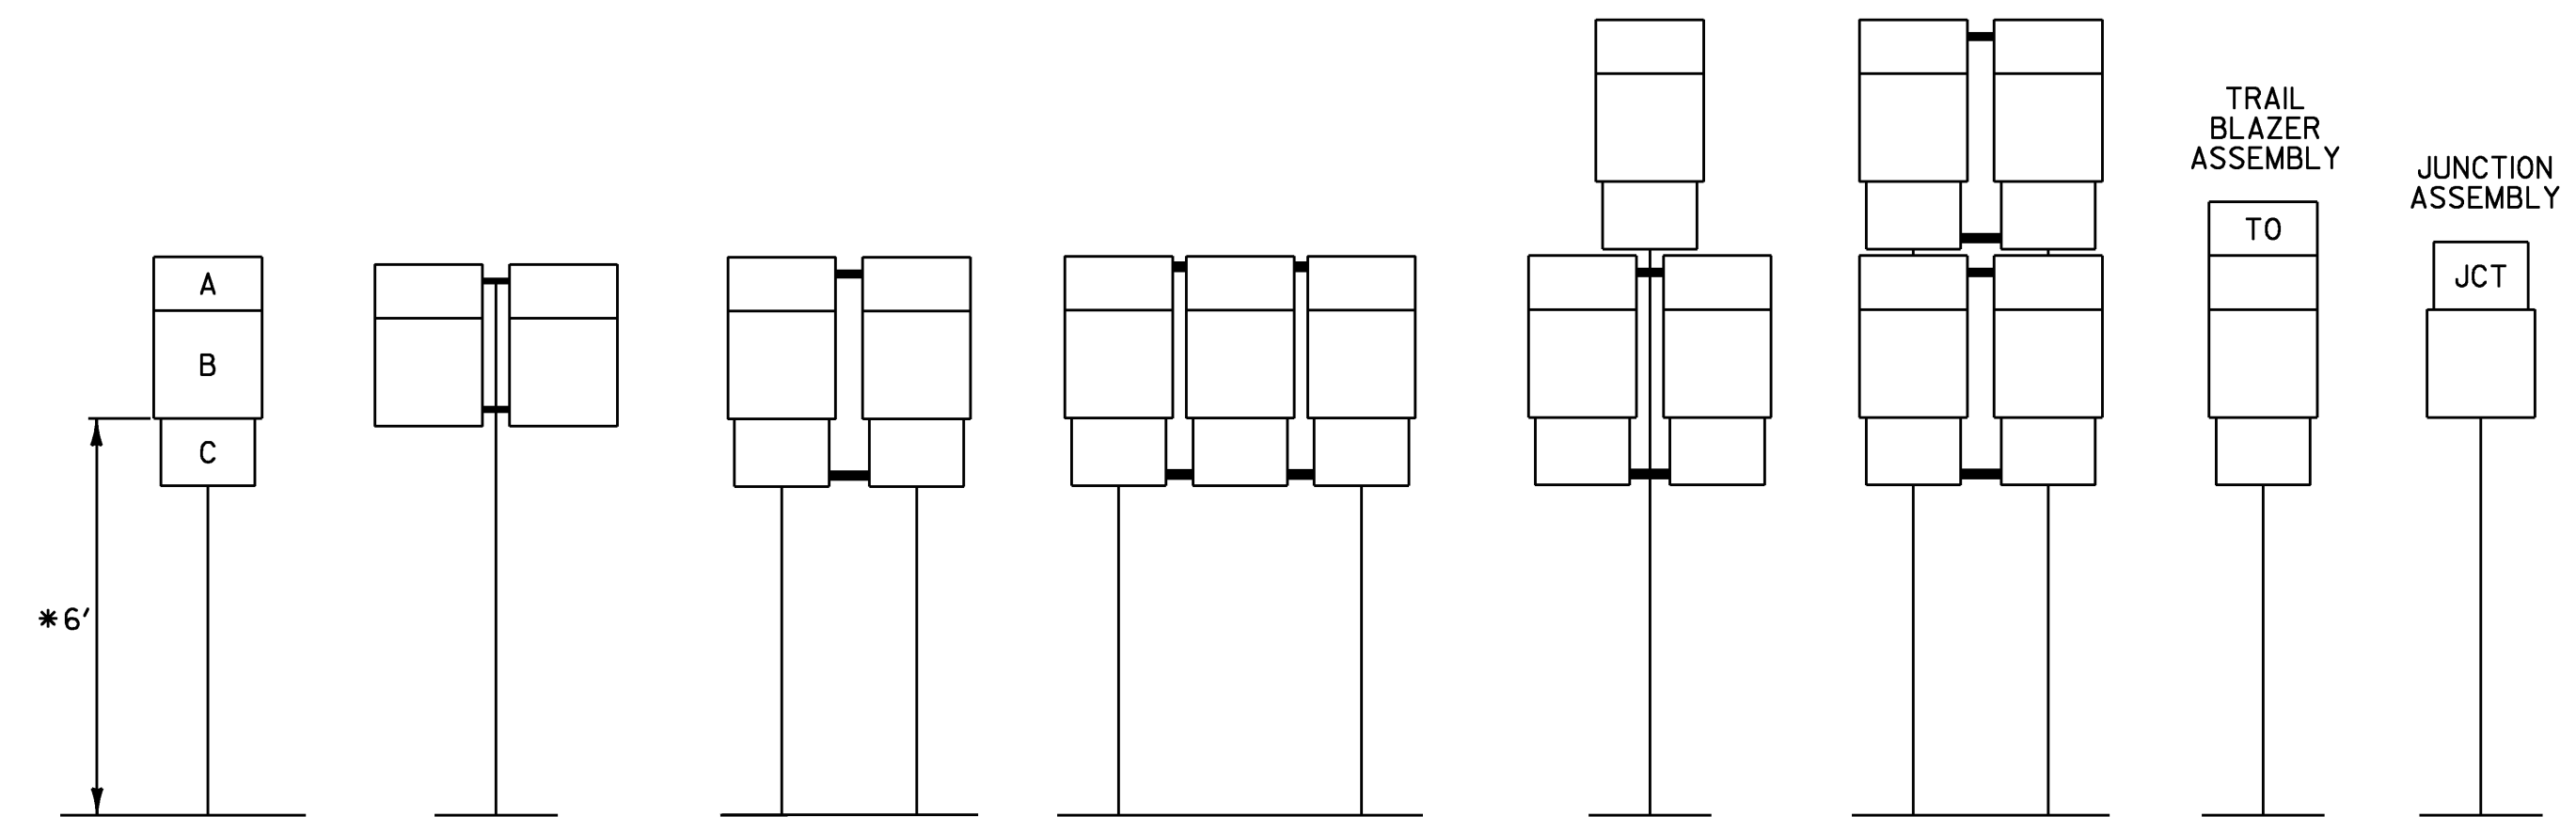


- A - CARDINAL DIRECTION MARKER
 B - ROUTE NUMBER
 C - ADVANCE TURN ARROW OR DIRECTIONAL ARROW
- * WHERE PARKING OR PEDESTRIAN TRAFFIC WILL OCCUR IN THE IMMEDIATE VICINITY OF THESE SIGNS, MINIMUM VERTICAL CLEARANCE SHALL BE INCREASED TO SEVEN FEET

INSTALLATION SEQUENCE:

IN MULTIPLE HORIZONTAL MOUNTINGS PLACE A ROUTE MARKER ASSEMBLY INDICATING A LEFT TURN ON THE LEFT SIDE OF THE ASSEMBLY; RIGHT TURN ON THE RIGHT SIDE. FOR VERTICALLY STACKED MOUNTINGS PLACE THE STRAIGHT THROUGH MOVE INDICATION ON TOP, THE LEFT OR RIGHT TURNS AS APPROPRIATE BENEATH.


NOTES:

- ALL DIMENSIONS SHOWN IN INCHES UNLESS OTHERWISE NOTED.
- VERTICAL FRAME MEMBERS SHALL LINE UP WITH SIGN POST ON WHICH THEY ARE MOUNTED.

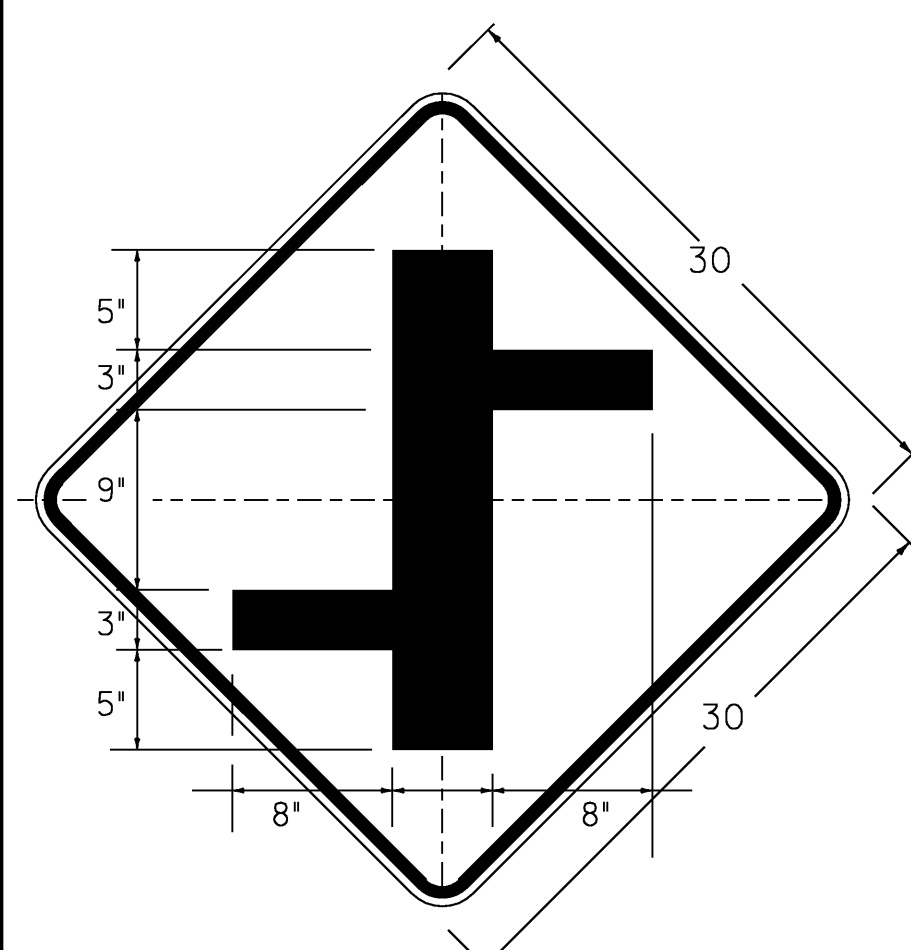


W2-1Me

DIMENSIONS NOT SHOWN FOR THIS DETAIL SHALL CONFORM TO THE LATEST EDITION OF THE 2003 MUTCD FOR SIGN DETAIL W2-1. UNLESS OTHERWISE NOTED FOR THIS DETAIL.

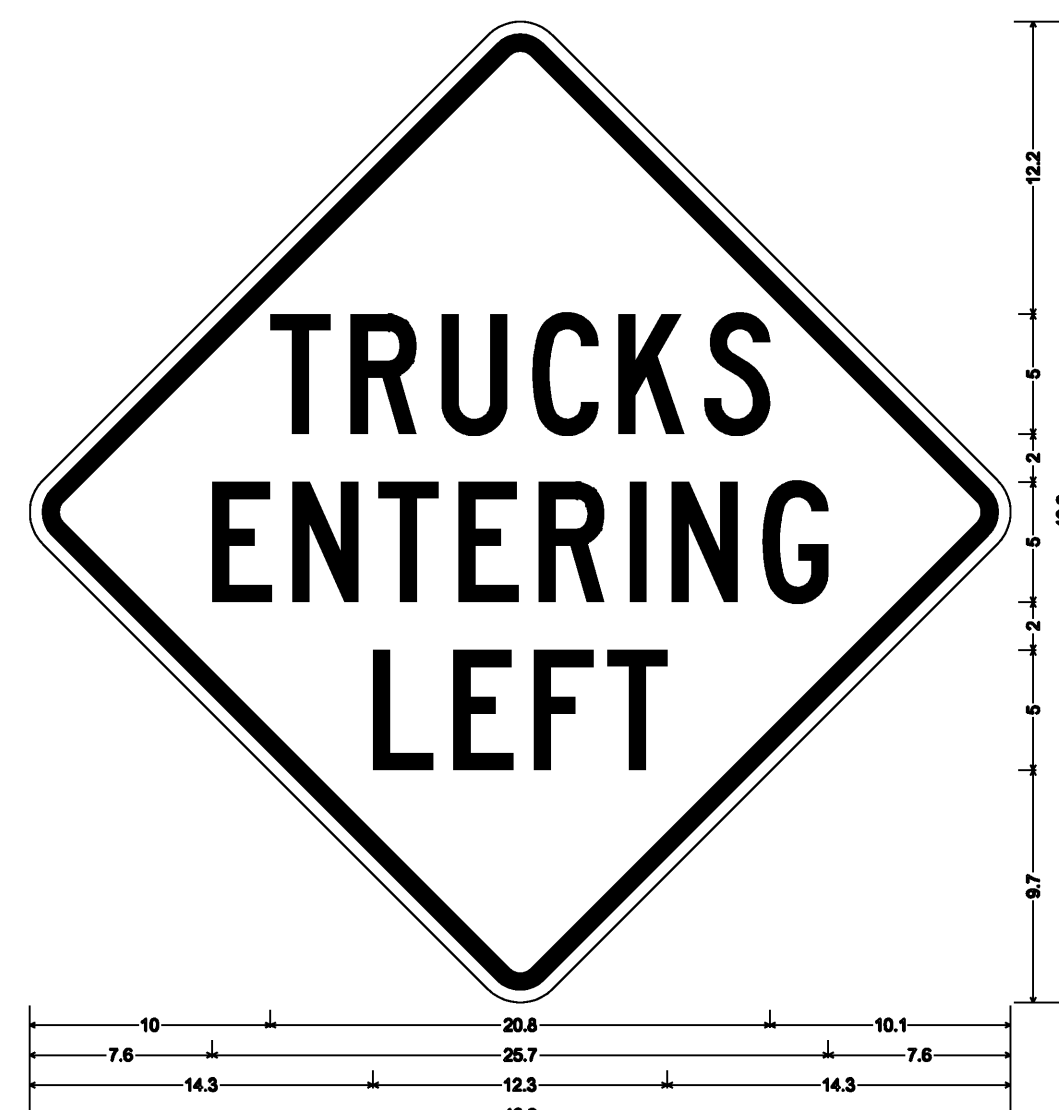


VW-084

30" SQUARE SIGN FACE
 1.875" RADIUS, 0.75" BORDER, 0.50" INDENT
 COLORS: LEGEND - BLACK
 BACKGROUND - YELLOW
 TEXT STYLE: C

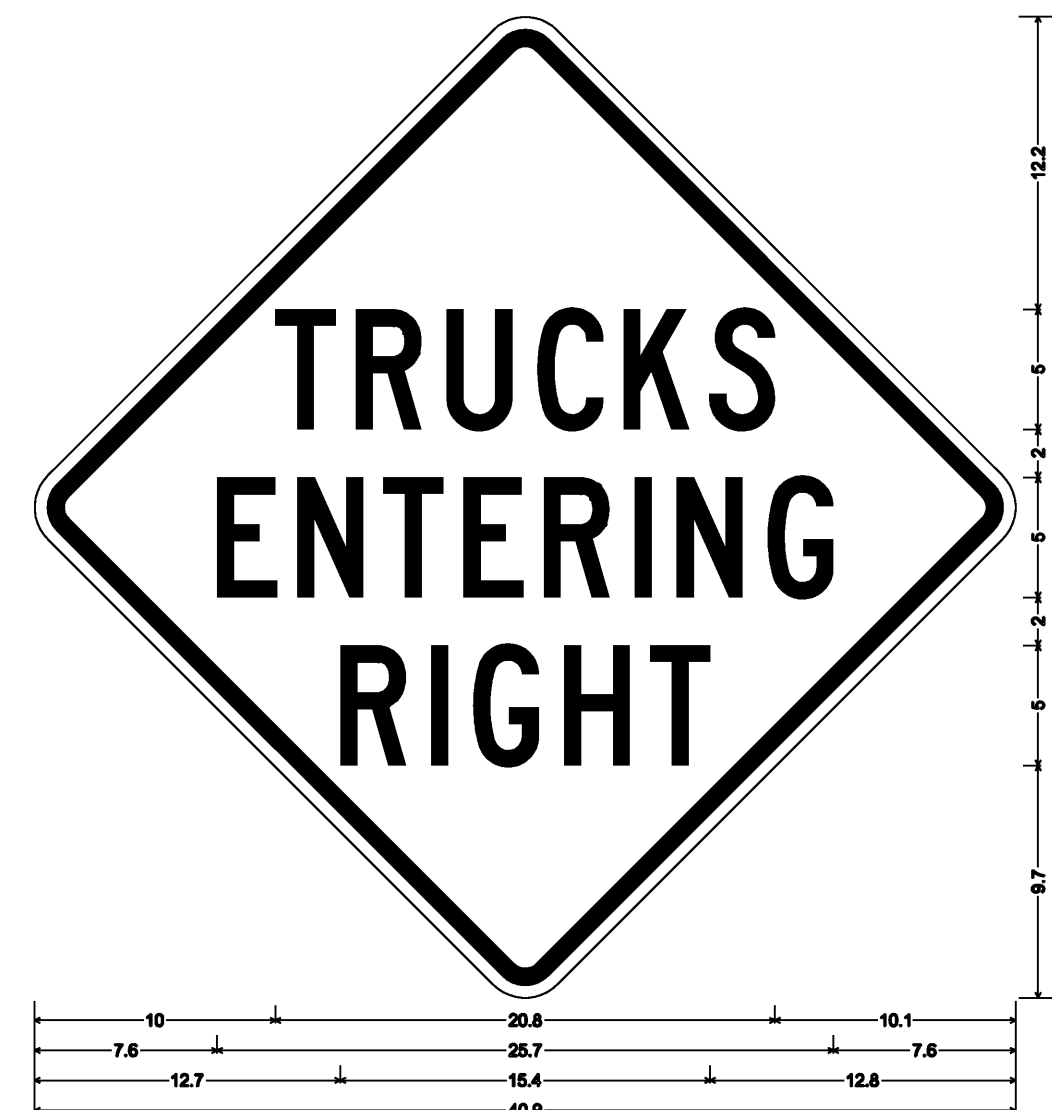


VW-081

30" SQUARE SIGN FACE
 1.875" RADIUS, 0.75" BORDER, 0.50" INDENT
 COLORS: LEGEND - BLACK
 BACKGROUND - YELLOW
 TEXT STYLE: C

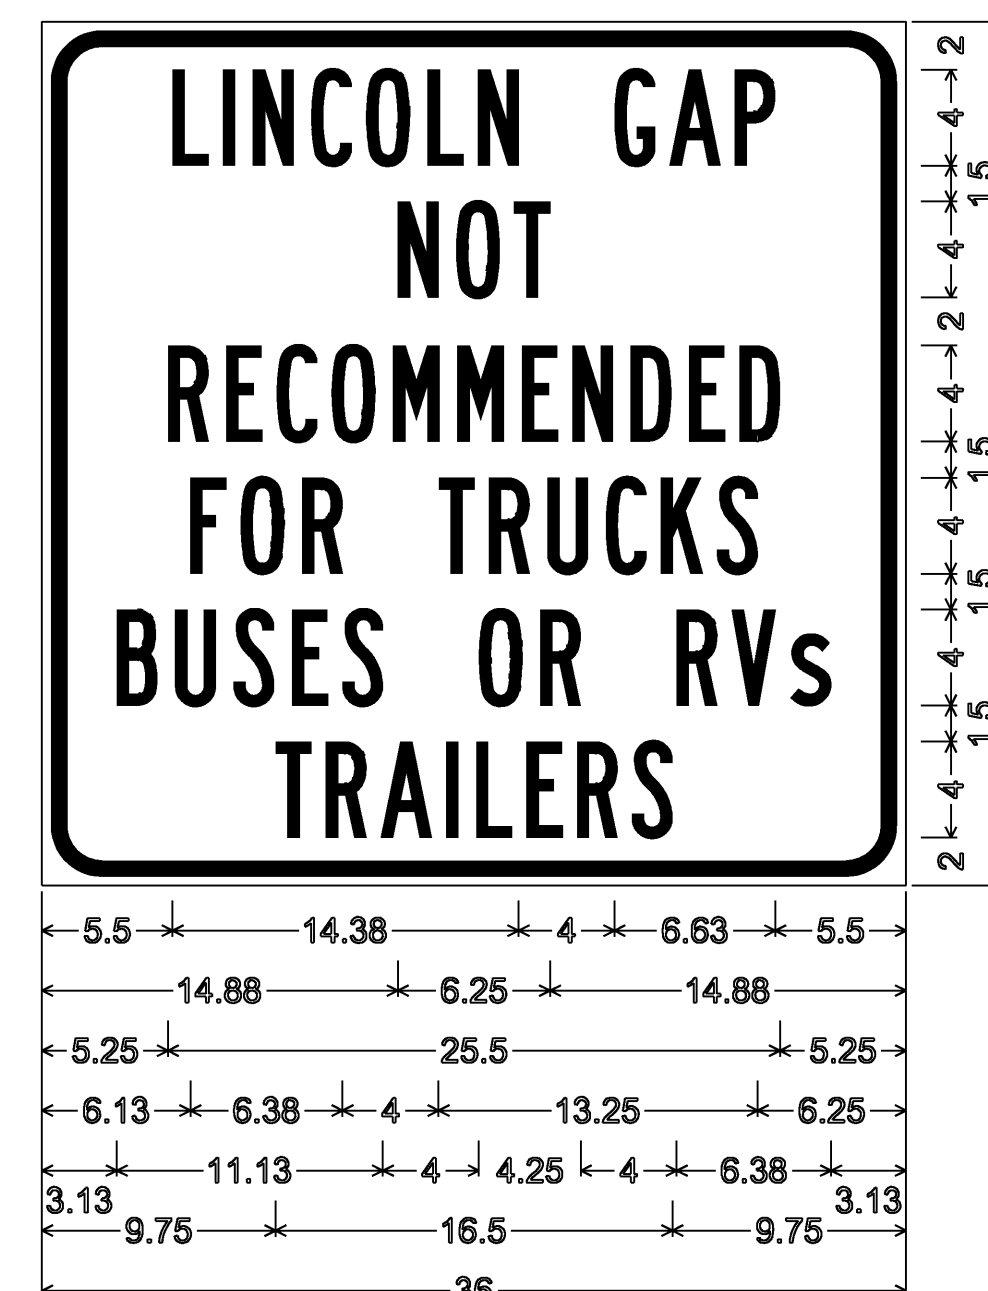

VW-399p

2.5" RADIUS, 0.625" BORDER, 0.375" INDENT
 COLORS: LEGEND - BLACK
 BACKGROUND - YELLOW
 TEXT STYLE: B

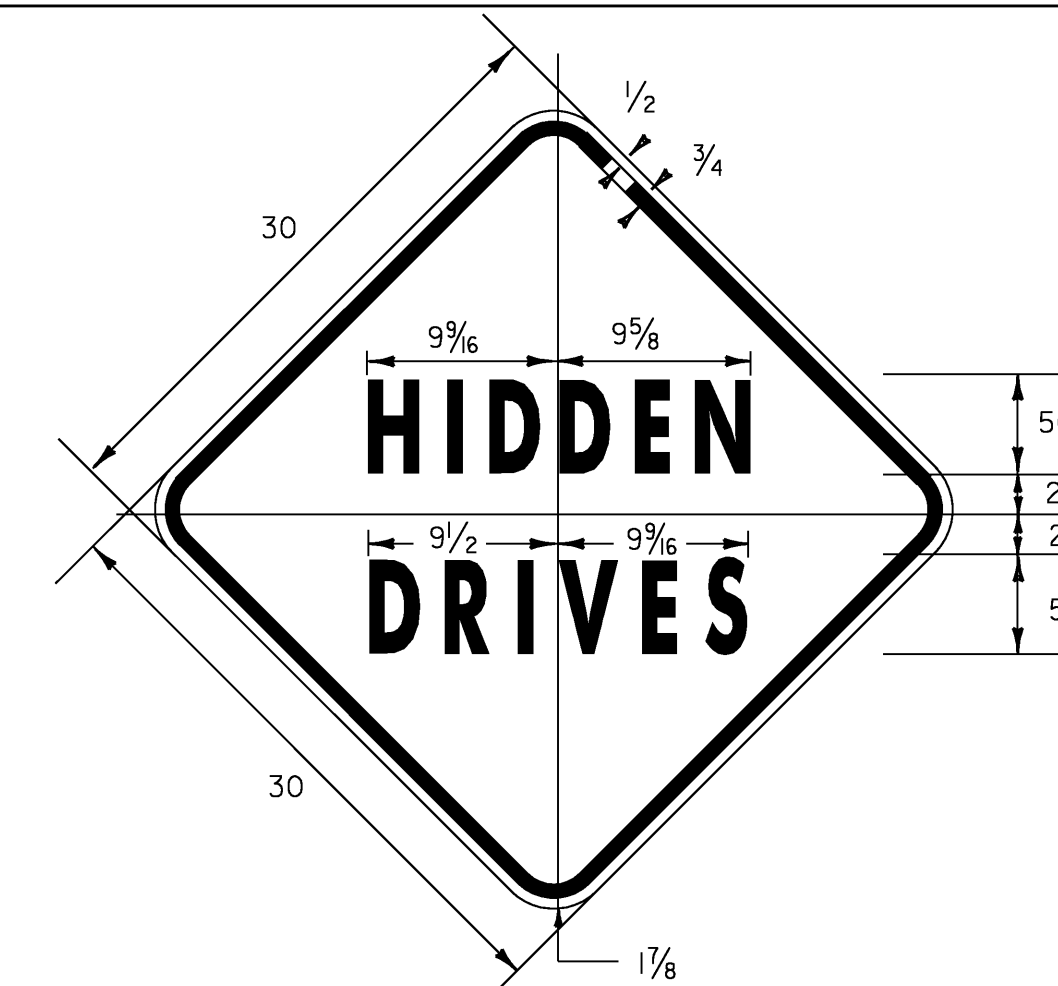

VW-060

COLORS: LEGEND - BLACK
 BACKGROUND - YELLOW

PROJECT NAME: LUDLOW - WAITSFIELD

PROJECT NUMBER: STPG SIGN (27)

FILE NAME: 09B058_TS.DGN
 PROJECT LEADER: N. AVERY
 DESIGNED BY: N. AVERY
 GUIDE SIGN ASSEMBLY


PLOT DATE: 16-SEP-2009
 DRAWN BY: N. AVERY
 CHECKED BY: A. GAMBLE
 SHEET 7 OF 204



1.5" RADIUS, 0.375" BORDER, 0.375" INDENT
 COLORS: LEGEND - BLACK
 BACKGROUND - YELLOW
 TEXT STYLE: B

* LATERAL SPACING TO OUTSIDE OF PANEL
 SHALL BE A MINIMUM OF 1.5"


W16-8

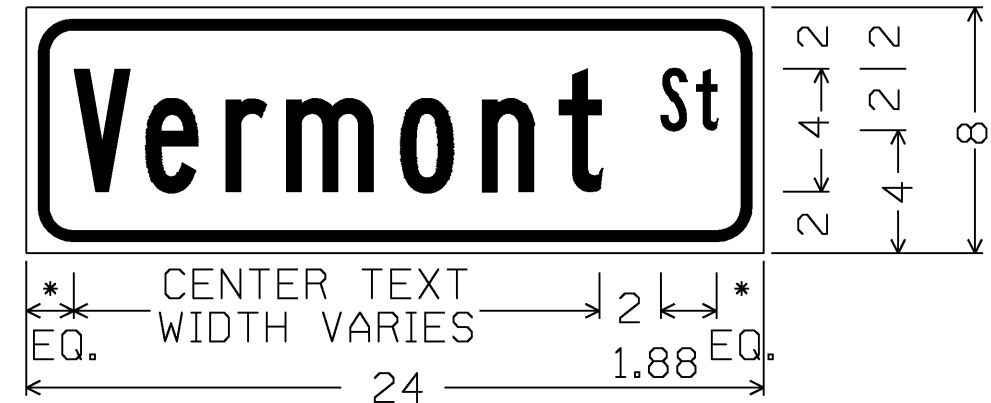

1.5" RADIUS, 0.375" BORDER, 0.375" INDENT
 COLORS: LEGEND - BLACK
 BACKGROUND - YELLOW
 TEXT STYLE: B

* LATERAL SPACING TO OUTSIDE OF PANEL
 SHALL BE A MINIMUM OF 1.5"

W16-8

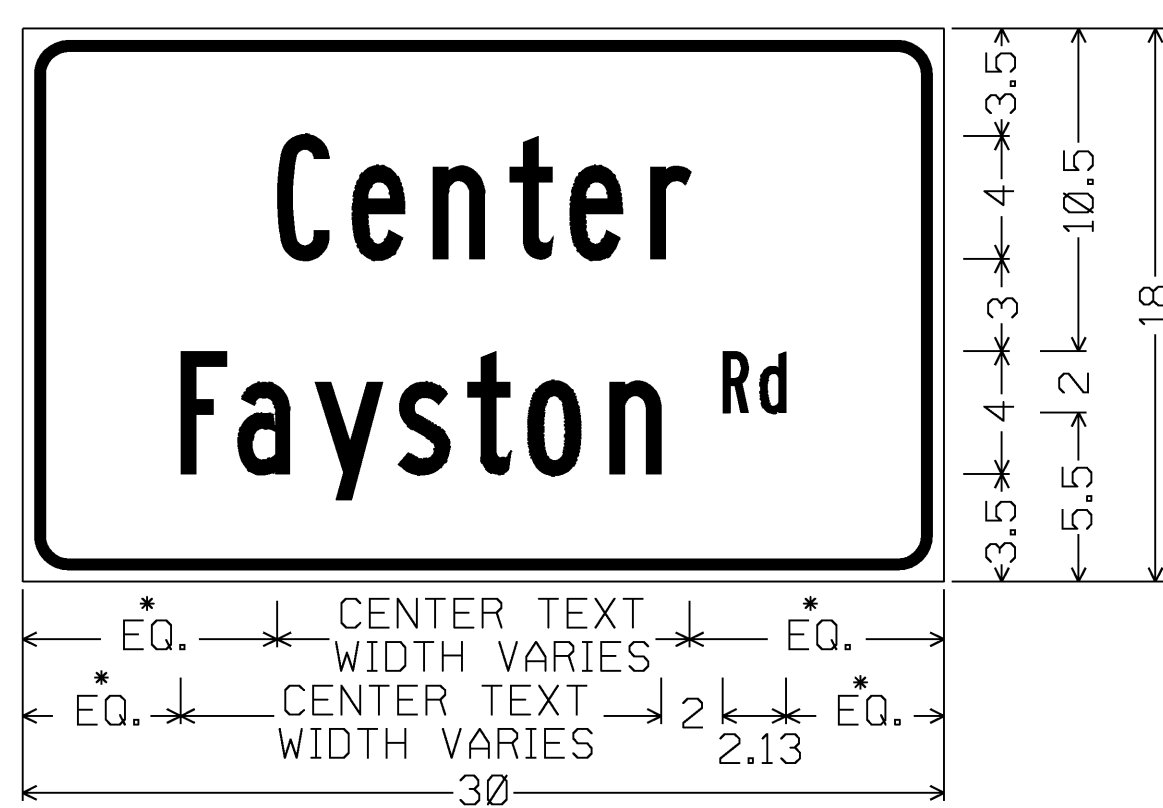

1.5" RADIUS, 0.375" BORDER, 0.375" INDENT
 COLORS: LEGEND - BLACK
 BACKGROUND - YELLOW
 TEXT STYLE: B

* LATERAL SPACING TO OUTSIDE OF PANEL
 SHALL BE A MINIMUM OF 1.5"

W16-8




3" RADIUS, 0.75" BORDER, 0.50" INDENT
 COLORS: LEGEND - BLACK
 BACKGROUND - YELLOW
 TEXT STYLE: D STANDARD ARROW CUSTOM 6" WIDE X 4" HIGH

* LATERAL SPACING TO OUTSIDE OF PANEL
 SHALL BE A MINIMUM OF 3"

W16-8a


ADVANCE WARNING SIGN PLAQUE NOTES:

- I. ALL ADVANCE STREET NAME PLAQUE SIGNS (W16-8 AND W16-8a) USED TO IDENTIFY THE NAME OF THE INTERSECTING STREETS SHALL HAVE INITIAL UPPER CASE LETTERS AND USED IN CONJUNCTION WITH LOWERCASE LETTERS (I.E. Main St, Foster Rd, East Ave, West Ln).

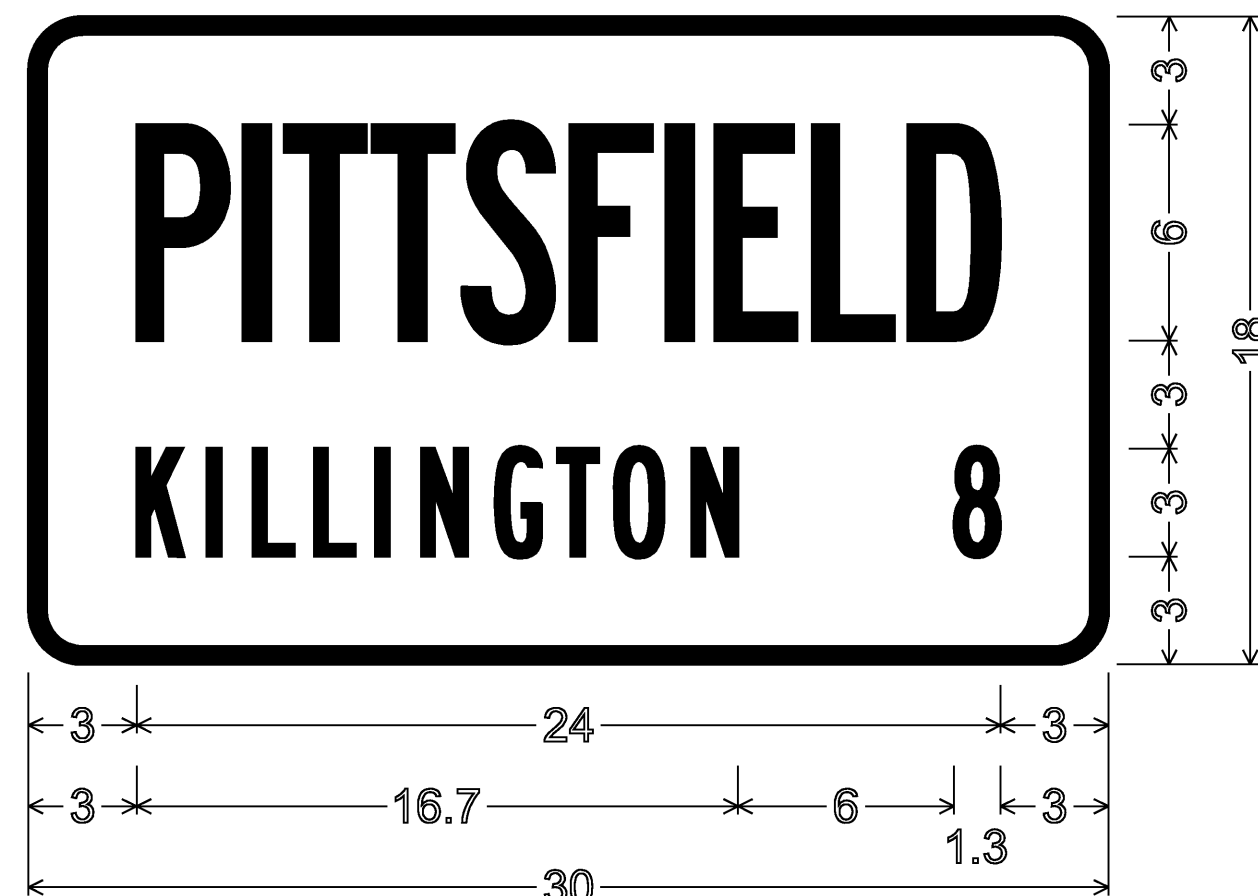

1.5" Radius, 0.5" Border, White on Green;
 "PITTSFIELD" B 2K specified length;
 "KILLINGTON 8" B 2K specified length;

VD-018

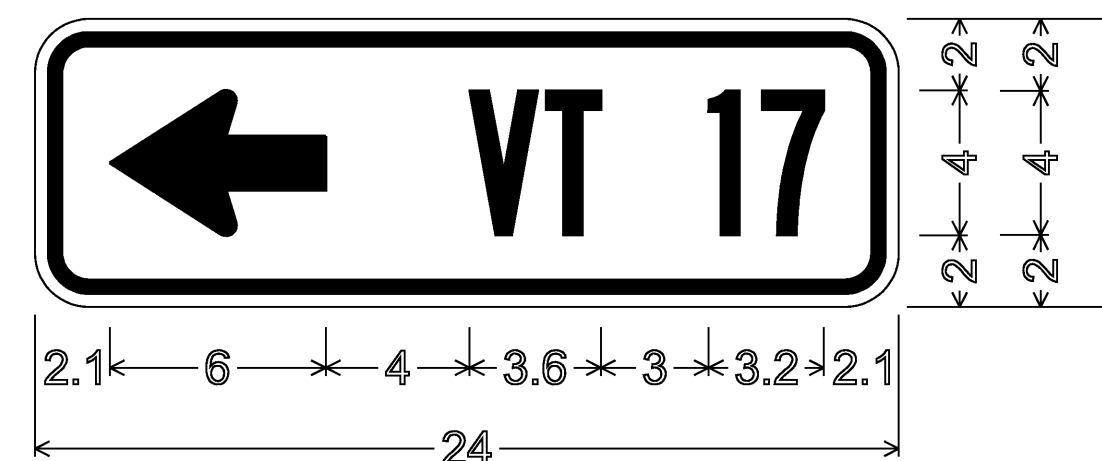

1.5" Radius, 0.4" Border, 0.4" Indent, Black on Yellow;
 Standard Arrow Custom 6.0" X 4.0" 180°;
 "VT 17" B 2K;


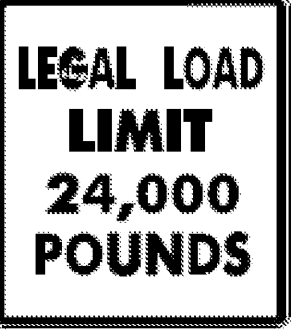




W16-8a




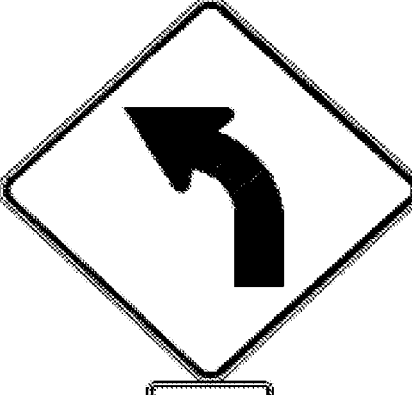


ADVANCE WARNING SIGN PLAQUE NOTES:



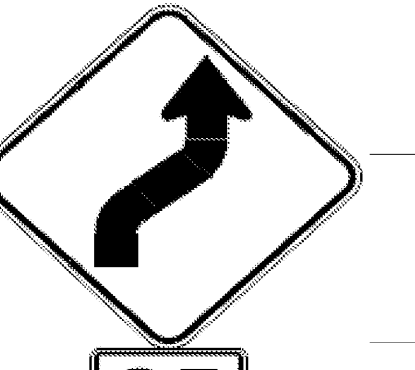


- I. ALL ADVANCE STREET NAME PLAQUE SIGNS (W16-8 AND W16-8a) USED TO IDENTIFY THE NAME OF THE INTERSECTING STREETS SHALL HAVE INITIAL UPPER CASE LETTERS AND USED IN CONJUNCTION WITH LOWERCASE LETTERS (I.E. Main St, Foster Rd, East Ave, West Ln).


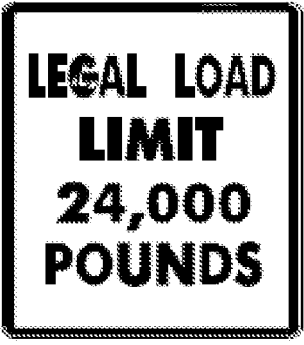



PROJECT NAME: LUDLOW - WAITSFIELD	
PROJECT NUMBER: STPG SIGN (27)	
FILE NAME: 09b058_TS.DGN	PLOT DATE: 16-SEP-2009
PROJECT LEADER: N. AVERY	DRAWN BY: N. AVERY
DESIGNED BY: N. AVERY	CHECKED BY: A. GAMBLE
WARNING STREET NAME PLAQUES DETAIL	SHEET 8 OF 204


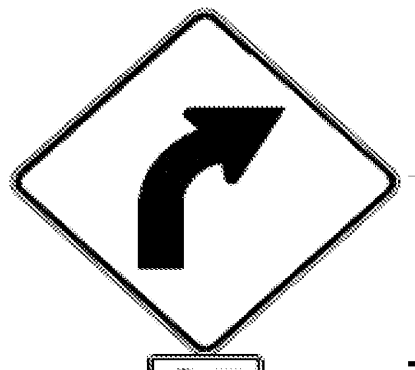



DIRECTION	MILEPOINT	LOCATION CODE (SHEET 2)	SIGN CODE	WIDTH (IN)	HEIGHT (IN)	SHEETING REMARKS	SIGN LEGEND	NEW SIGNS		EXISTING SIGNS				EXIST POST		NUMBER OF NEW POSTS	SQUARE STEEL (IN)			TUBULAR STEEL Ø (IN)				SIGN FRAME REQUIRED	REMARKS NOTE: POST LENGTHS, TOTALS AND INSTALLATION DATES ARE NOT SHOWN IN TRAFFIC SIGN SUMMARY SHEETS; THESE CAN BE FOUND IN ORIGINAL RECORD PLANS AND TOWN TOTAL SIGN SUMMARY SHEET, SHEET 202.	SIGN DETAIL			
								"A"	"B"	RETAIN	SALVAGE FROM	SALVAGE TO	REMOVE	RETAIN	REMOVE		1.75 (LB / FT)	2.00	2.50	FOUNDATION	3.00	3.50	4.00			5.00	DETAIL IN SHS	DETAIL ON SHEET NUMBER	DETAIL ON STD SHEET NUMBER
LUDLOW VT 100							FY-FLUORESCENT YELLOW FYG-FLUORESCENT YELLOW GREEN																"SHS"-STANDARD HIGHWAY SIGNS						
NB	0.000	C	VD-024	72	10			5.00							2	X								INSTALL DIRECTLY ACROSS FROM THE EXISTING TOWN LINE SIGN ON 2 NEW POSTS.		4			
		C	VD-700	6	10			0.42																LUDLOW MILE MARKER. INSTALL ON THE LEFT-SIDE POST UNDER LUDLOW.			E-138		
		C	VD-700	6	10			0.42																ANDOVER MILE MARKER. INSTALL ON THE RIGHT-SIDE POST UNDER ANDOVER.			E-138		
NB	0.135	A	W1-10R	30	30									1		X													
		A	W1-2Mi R	30	30			6.25							1	X										6			
NB	0.505	A	W7-1B	36	36	FY		9.00							2	X								INSTALL 240 FT± SOUTH OF THE EXISTING ASSEMBLY, WHICH WILL BE REMOVED.	X				
		A	W7-3A	30	18	FY		3.75																SPAN PLAQUE ACROSS BOTH POSTS.		6			
NB	0.550	A	W7-1B	36	36		HILL SYMBOL w/ 9% GRADE NUMBER							1		X													
		A	W7-3A	30	18		NEXT 1-1/2 MILES (PLAQUE)							1															
NB	1.266	A	W1-2L	30	30		CURVE LEFT							1		X													
		A	W13-1	18	18		40 MPH (PLAQUE)							1															
NB	1.300	A	W1-2L	30	30			6.25							1	X								INSTALL 180 FT± NORTH OF PREVIOUS POSITION	X				
		A	W13-1	18	18			2.25																	X				
NB	1.412	A	W1-6	48	24		<==== LARGE ARROW LEFT							1		X													
SIGN SUMMARY SHEET							SHEET TOTALS	33.34	0.00	1	0	0	5	0	0	6	90						PROJECT NAME: Ludlow-Waitsfield VT100						
							SF	SF	EA	EA	EA	EA	EA	EA	EA	EA	EA	EA	EA	EA	EA	EA	EA	EA	EA	EA	EA	EA	EA
VERMONT AGENCY OF TRANSPORTATION							TOWN TOTALS	647.4	0.0	13.0	4.0	4.0	135	0.0	0.0	106	1590.0						PROJECT NUMBER: STPG SIGN(27)						
																					FILE NAME: Ludlow.xls	PLOT DATE: 9/4/2009							
																					PROJECT MANAGER: N. Avery	DRAWN BY: I. Shea							
																					DESIGNED BY: M. Miller	CHECKED BY: N. Avery							
																					LUDLOW SHEET 1	SHEET 9	OF 204						







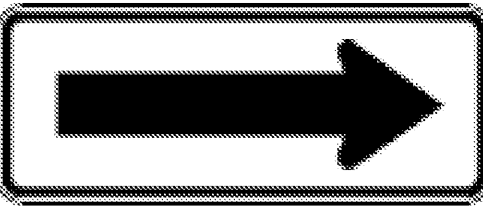
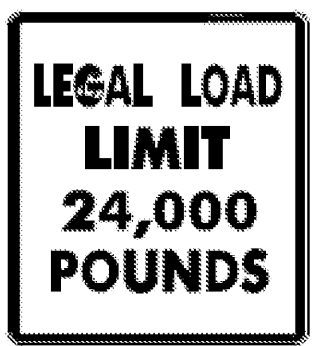
DIRECTION	MILEPOINT	LOCATION CODE (SHEET 2)	SIGN CODE	WIDTH (IN)	HEIGHT (IN)	SHEETING REMARKS	SIGN LEGEND	NEW SIGNS		EXISTING SIGNS				EXIST POST		NUMBER OF NEW POSTS	SQUARE STEEL (IN)			TUBULAR STEEL Ø (IN)				SIGN FRAME REQUIRED	REMARKS	SIGN DETAIL						
								"A"	"B"	RETAIN	SALVAGE FROM	SALVAGE TO	REMOVE	RETAIN	REMOVE		1.75	2.00	2.50	3.00	3.50	4.00	5.00			DETAIL IN SHS	DETAIL ON SHEET NUMBER	DETAIL ON STD SHEET NUMBER				
																	(LB / FT)			(LB / FT)												
																	1.88	2.42	3.35	FOUNDATION	7.60	9.00	10.80						14.60			
LUDLOW VT 100							FY-FLUORESCENT YELLOW FYG-FLUORESCENT YELLOW GREEN															"SHS"-STANDARD HIGHWAY SIGNS										
NB	1.455	A	VW-619	30	30		SHOULDER NARROWS								1																	
NB	1.558	A	W1-10L	30	30		CURVE LEFT w/ INTERSECTING SIDE ROADS BOTH SIDES								1																	
NB	1.612	A	W2-1Mh	30	30			6.25							1			X							INSTALL BEHIND RAIL 225 FT± SOUTH OF THE "ST. JOSEPH'S" BUSINESS SIGN (NEXT ENTRY)				6			
NB	1.655	A	VD-062B	72	16		BUSINESS SIGN			1					X																	
NB	1.710	C	VR-017	24	24										1										ANDOVER RD (TH-1); SOUTHERLY APPROACH							
		C	VR-017	24	30			5.00							1			X							INSTALL AT A POINT JUST BEYOND THE CONVERGENCE OF THE TWO APPROACHES						E-141	
NB	1.718	D	R1-1	24	24										1										ANDOVER RD (TH-1); SOUTHERLY APPROACH							
		D	R1-1	30	30			6.25							1			X													X	
NB	1.754	D	R1-1	24	24										1										ANDOVER RD (TH-1) NORTHERLY APPROACH							
		D	R1-1	30	30			6.25							1			X													X	
NB	1.773	A	M3-1	24	12			2.00							1			X							GREEN ON WHITE SHEETING			X				
		A	M1-5	30	24			5.00																	INSTALL 100 FT± NORTH OF THE NORTHERLY APPROACH TO ANDOVER RD (TH-1)						E-136B	
NB	1.837	A	VD-123	36	36		511 TRAVEL INFO			1					X																	
NB	2.126	C	VR-017	24	24										1										EVERGREEN ACRES RD (TH-71)							
		C	VR-017	24	30			5.00							1			X													E-141	
SIGN SUMMARY SHEET							SHEET TOTALS			35.75	0.00	2	0	0	6	0	0	6	90				PROJECT NAME: Ludlow-Waitsfield VT100									
										SF	SF	EA	EA	EA	EA	EA	EA	EA	FT				PROJECT NUMBER: STPG SIGN(27)									
																						FILE NAME: Ludlow.xls										
																						PLOT DATE: 9/4/2009										
																						DRAWN BY: I. Shea										
																						DESIGNED BY: M. Miller										
																						CHECKED BY: N. Avery										
																						SHEET 10 OF 204										
VERMONT AGENCY OF TRANSPORTATION							TOWN TOTALS			647.4	0.0	13.0	4.0	4.0	135	0.0	0.0	106	1590.0													

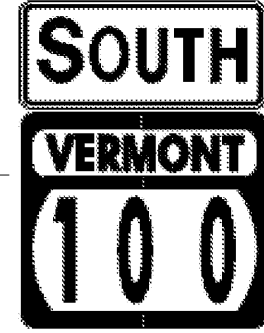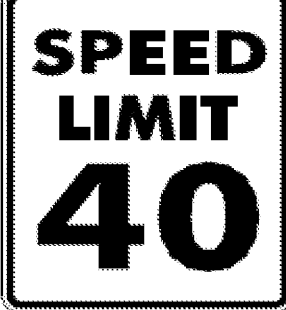



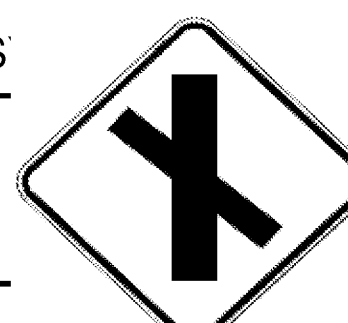
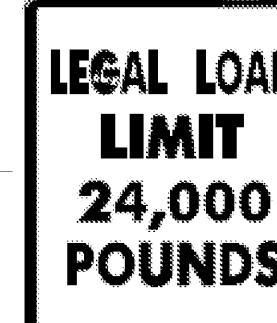
DIRECTION	MILEPOINT	LOCATION CODE (SHEET 2)	SIGN CODE	WIDTH (IN)	HEIGHT (IN)	SHEETING REMARKS	SIGN LEGEND	NEW SIGNS		EXISTING SIGNS				EXIST POST		NUMBER OF NEW POSTS	SQUARE STEEL (IN)			TUBULAR STEEL Ø (IN)				SIGN FRAME REQUIRED	REMARKS	SIGN DETAIL			
								"A"	"B"	RETAIN	SALVAGE FROM	SALVAGE TO	REMOVE	RETAIN	REMOVE		1.75	2.00	2.50	FOUNDATION	3.00	3.50	4.00			5.00	DETAIL IN SHS	DETAIL ON SHEET NUMBER	DETAIL ON STD SHEET NUMBER
																	(LB / FT)				(LB / FT)								
LUDLOW VT 100							FY-FLUORESCENT YELLOW FYG-FLUORESCENT YELLOW GREEN																"SHS"-STANDARD HIGHWAY SIGNS						
NB	2.134	D	R1-1	24	24																								
		D	R1-1	30	30			6.25																	X				
NB	2.600	A	W7-1B	36	36	FY																							
		A	W7-3A	30	24	FY																							
		A	W7-1B	36	36	FY		9.00																	X				
		A	W7-3A	24	18	FY		3.00																	X				
NB	2.908	A	W1-2L	30	30																								
		A	W1-2L	30	30			6.25																	X				
		A	W13-1	18	18			2.25																	X				
NB	2.981	A	W3-5	36	36		SPEED REDUCTION 40 MPH AHEAD																						
																													
		A	R2-1	24	30																								
		A	R2-1	30	36			7.50																		6			
NB	3.177	A	VW-619	30	30		SHOULDER NARROWS																						
NB	3.230	A	W1-2R	30	30																								
		A	W13-1	18	18																								
SIGN SUMMARY SHEET							SHEET TOTALS	34.25	0.00	0	1	1	8	0	0	7	105							PROJECT NAME: Ludlow-Waitsfield VT100					
								SF	SF	EA	EA	EA	EA	EA	EA	EA	FT							PROJECT NUMBER: STPG SIGN(27)					
VERMONT AGENCY OF TRANSPORTATION							TOWN TOTALS	647.4	0.0	13.0	4.0	4.0	135	0.0	0.0	106	1590.0							FILE NAME: Ludlow.xls	PLOT DATE: 9/4/2009				
																								PROJECT MANAGER: N. Avery	DRAWN BY: I. Shea				
																								DESIGNED BY: M. Miller	CHECKED BY: N. Avery				
																								LUDLOW SHEET 3	SHEET 11 OF 204				





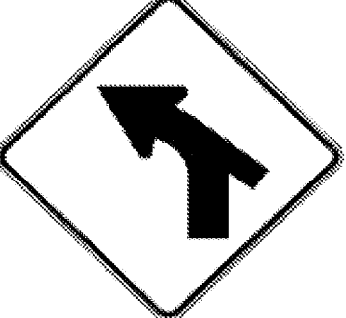
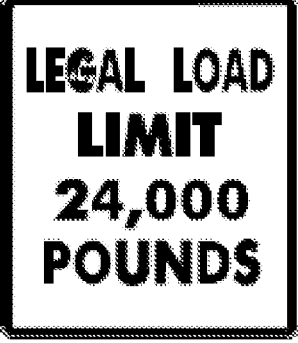

DIRECTION	MILEPOINT	LOCATION CODE (SHEET 2)	SIGN CODE	WIDTH (IN)	HEIGHT (IN)	SHEETING REMARKS	SIGN LEGEND	NEW SIGNS		EXISTING SIGNS				EXIST POST		NUMBER OF NEW POSTS	SQUARE STEEL (IN)			TUBULAR STEEL Ø (IN)				SIGN FRAME REQUIRED	REMARKS	SIGN DETAIL				
								"A"	"B"	RETAIN	SALVAGE FROM	SALVAGE TO	REMOVE	RETAIN	REMOVE		1.75	2.00	2.50	3.00	3.50	4.00	5.00			DETAIL IN SHS	DETAIL ON SHEET NUMBER	DETAIL ON STD SHEET NUMBER		
																	(LB / FT)			(LB / FT)										
LUDLOW VT 100							FY-FLUORESCENT YELLOW FYG-FLUORESCENT YELLOW GREEN															"SHS"-STANDARD HIGHWAY SIGNS								
		A	W1-2R	30	30			6.25							1	X								BEHIND RAIL	X					
		A	W13-1	18	18			2.25																	X					
NB	3.270	A	VD-062BC	74.75	16		BUSINESS SIGN			1																				
		A	VD-062C	74.75	16			BUSINESS SIGN			1																			
NB	3.429	A	R2-1	24	30							1																		
		A	R2-1	24	30			5.00							1	X										X				
NB	3.487	A	W1-4R	30	30																									
		A	W13-1	18	18																									
		A	W1-4R	30	30			6.25							1	X										X				
		A	W13-1	18	18			2.25																		X				
NB	3.535	A	VW-060	30	30								1																	
		A	VW-060	30	30			6.25							1	X											ASSURE 10 FT MINIMUM TO UTILITY POLE			7
NB	3.665	A	VD-062B	72	16		BUSINESS SIGN			1																				
NB	3.780	A	R2-1	24	30							1																		
		A	R2-1	24	30			5.00							1	X										X				
SIGN SUMMARY SHEET							SHEET TOTALS	33.25	0.00	3	0	0	5	0	0	5	75													
								SF	SF	EA	EA	EA	EA	EA	EA	EA	FT													
VERMONT AGENCY OF TRANSPORTATION							TOWN TOTALS	647.4	0.0	13.0	4.0	4.0	135	0.0	0.0	106	1590.0													
															PROJECT NAME:	Ludlow-Waitsfield VT100														
															PROJECT NUMBER:	STPG SIGN(27)														
															FILE NAME:	Ludlow.xls				PLOT DATE:	9/4/2009									
															PROJECT MANAGER:	N. Avery				DRAWN BY:	I. Shea									
															DESIGNED BY:	M. Miller				CHECKED BY:	N. Avery									
															LUDLOW SHEET 4					SHEET	12		OF	204						

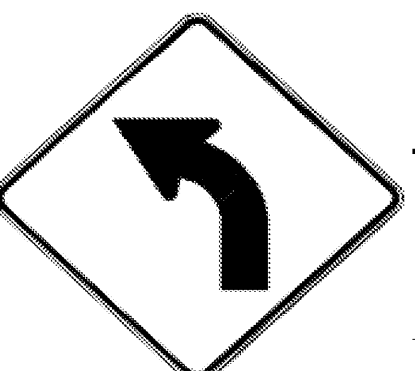
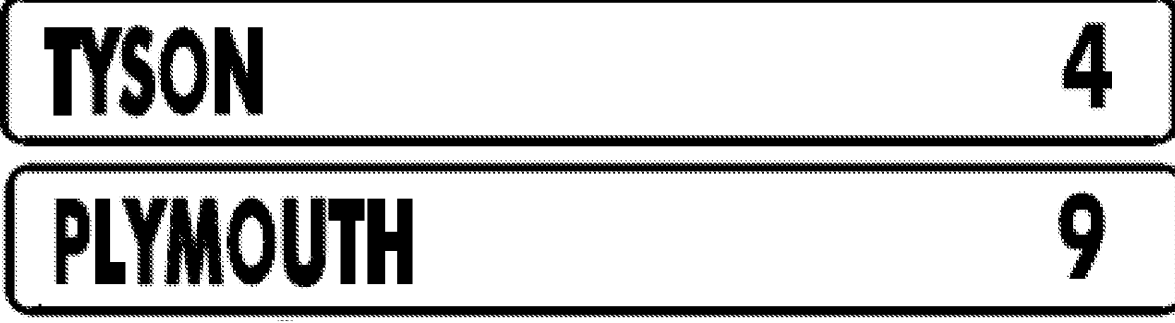

DIRECTION	MILEPOINT	LOCATION CODE (SHEET 2)	SIGN CODE	WIDTH (IN)	HEIGHT (IN)	SHEETING REMARKS	SIGN LEGEND	NEW SIGNS		EXISTING SIGNS				EXIST POST		NUMBER OF NEW POSTS	SQUARE STEEL (IN)			TUBULAR STEEL Ø (IN)				SIGN FRAME REQUIRED	REMARKS	SIGN DETAIL			
								"A"	"B"	RETAIN	SALVAGE FROM	SALVAGE TO	REMOVE	RETAIN	REMOVE		1.75	2.00	2.50	FOUNDATION	3.00	3.50	4.00			5.00	DETAIL IN SHS	DETAIL ON SHEET NUMBER	DETAIL ON STD SHEET NUMBER
																	(LB / FT)				(LB / FT)								
LUDLOW VT 100							FY-FLUORESCENT YELLOW FYG-FLUORESCENT YELLOW GREEN																"SHS"-STANDARD HIGHWAY SIGNS						
NB	4.007	A	R2-1	24	30								1		X														
		A	R2-1	24	30			5.00																	X				
NB	4.102	C	VR-017	24	24								1		X														
		C	VR-017	24	30			5.00																			E-141		
NB	4.110	D	R1-1	24	24																								
		D	R1-1	30	30			6.25																	X				
NB	4.160	A	W3-5	36	36		SPEED REDUCTION 25 MPH (SYMBOL)			1					X														
NB	4.300	A	VR-038	24	18		STATE HIGHWAY ENDS				1	1			X														
		A	R2-1	24	30		SPEED LIMIT 25				1	1																	
CLASS 1 PORTION OF HIGHWAY BEGINS																													
SB	4.322	F	VR-039	24	18								1		X														
		F	R2-1	24	30								1																
		F	VR-039	24	18			3.00																			E-141		
		F	R2-1	24	30			5.00																	X				
SB	4.072	F	M3-3S	24	12								1		X														
SIGN SUMMARY SHEET							SHEET TOTALS		24.25	0.00	1	2	2	6	0	0	5	75									PROJECT NAME: Ludlow-Waitsfield VT100		
							SF	SF	EA	EA	EA	EA	EA	EA	EA	EA	EA	EA	EA	EA	EA	EA	EA	EA	EA	EA	EA	EA	EA
VERMONT AGENCY OF TRANSPORTATION							TOWN TOTALS		647.4	0.0	13.0	4.0	4.0	135	0.0	0.0	106	1590.0								FILE NAME: Ludlow.xls			
																									PLOT DATE: 9/4/2009				
																									DRAWN BY: I. Shea				
																								DESIGNED BY: M. Miller					
																								CHECKED BY: N. Avery					
																								SHEET 13 OF 204					

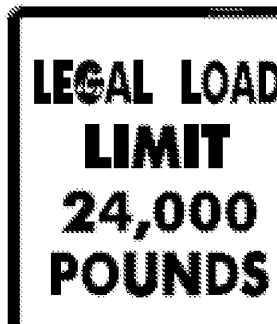



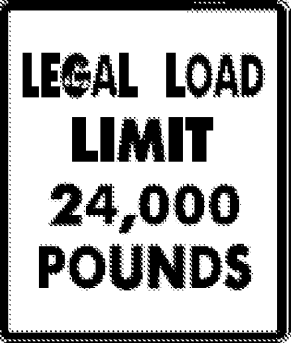
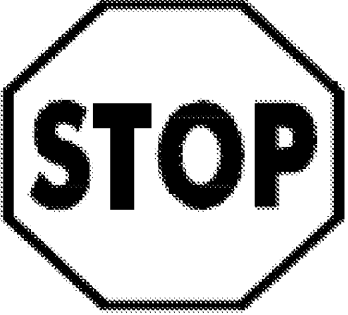

DIRECTION	MILEPOINT	LOCATION CODE (SHEET 2)	SIGN CODE	WIDTH (IN)	HEIGHT (IN)	SHEETING REMARKS	SIGN LEGEND	NEW SIGNS		EXISTING SIGNS				EXIST POST		NUMBER OF NEW POSTS	SQUARE STEEL (IN)			TUBULAR STEEL Ø (IN)				SIGN FRAME REQUIRED	REMARKS	SIGN DETAIL		
								"A"	"B"	RETAIN	SALVAGE FROM	SALVAGE TO	REMOVE	RETAIN	REMOVE		(LB / FT)			(LB / FT)						DETAIL IN SHS	DETAIL ON SHEET NUMBER	DETAIL ON STD SHEET NUMBER
																	1.75	2.00	2.50	3.00	3.50	4.00	5.00					
LUDLOW VT 100							FY-FLUORESCENT YELLOW FYG-FLUORESCENT YELLOW GREEN															"SHS"-STANDARD HIGHWAY SIGNS						
			F M1-5	30	24																							
			F M3-3	24	12			2.00																	X			
			F M1-5	30	24			5.00																	E-136B			
SB	4.035		F R2-1	24	30																							
			F R2-1	24	30			5.00																	X			
SB	3.860		F W1-2R	30	30		CURVE RIGHT																					
			F W13-1	18	18		35 MPH (PLAQUE)																					
SB	3.813		F VW-202	30	30		TRUCKS ENTERING																					
			F R2-1	24	30			5.00																	X			
SB	3.875		F R2-1	24	30		SPEED LIMIT 40																					
			F VW-202	30	30			6.25																	E-154			
SB	3.682		F W1-4R	30	30		REVERSE CURVE RIGHT																					
			F W13-1	18	18		35 MPH (PLAQUE)																					
			F W11-6	30	30		SNOWMOBILE (HINGED)																					
			F W1-4R	30	30			6.25																	X			
SIGN SUMMARY SHEET							SHEET TOTALS	29.50	0.00	0	0	0	9	0	0	5	75						PROJECT NAME: Ludlow-Waitsfield VT100					
VERMONT AGENCY OF TRANSPORTATION								SF	SF	EA	EA	EA	EA	EA	EA	EA	FT						PROJECT NUMBER: STPG SIGN(27)					
TOWN TOTALS							647.4	0.0	13.0	4.0	4.0	135	0.0	0.0	106	1590.0						FILE NAME: Ludlow.xls	PLOT DATE: 9/4/2009					
																					PROJECT MANAGER: N. Avery	DRAWN BY: I. Shea						
																					DESIGNED BY: M. Miller	CHECKED BY: N. Avery						
																					LUDLOW SHEET 6	SHEET 14 OF 204						


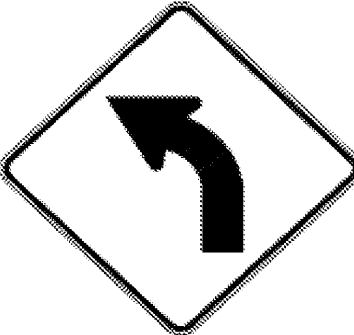


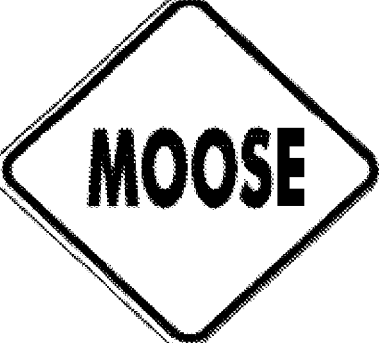
DIRECTION	MILEPOINT	LOCATION CODE (SHEET 2)	SIGN CODE	WIDTH (IN)	HEIGHT (IN)	SHEETING REMARKS	SIGN LEGEND	NEW SIGNS		EXISTING SIGNS				EXIST POST		NUMBER OF NEW POSTS	SQUARE STEEL (IN)			TUBULAR STEEL Ø (IN)				SIGN FRAME REQUIRED	REMARKS	SIGN DETAIL			
								"A"	"B"	RETAIN	SALVAGE FROM	SALVAGE TO	REMOVE	RETAIN	REMOVE		(LB / FT)			(LB / FT)						DETAIL IN SHS	DETAIL ON SHEET NUMBER	DETAIL ON STD SHEET NUMBER	
																	1.75	2.00	2.50	3.00	3.50	4.00	5.00						
LUDLOW VT 100							FY-FLUORESCENT YELLOW FYG-FLUORESCENT YELLOW GREEN																"SHS"-STANDARD HIGHWAY SIGNS						
			F W13-1	18	18			2.25																X					
SB	3.845		F VW-133R	30	30			6.25							2		X								INSTALL ASSEMBLY 160 FT± SOUTH OF PREVIOUS ASSEMBLY, ON 2 POSTS, w/ HIDDEN DRIVES RIGHT ON TOP.				
			F W11-6H	30	30			6.25																	INSTALL BELOW HIDDEN DRIVES SIGN, IN CLOSED POSITION (HINGED SIGN)			E-153	
SB	3.521		F R2-1	24	30								1				X												
			F R2-1	24	30			5.00							1		X							X					
SB	3.500		F W1-2L	30	30		CURVE LEFT						1				X												
			F W13-1	18	18		35 MPH (PLAQUE)						1																
SB	3.445		F W1-2L	30	30			6.25							1		X								INSTALL 290 FT± SOUTH OF PREVIOUS POSITION, JUST SOUTH OF MAILBOXES / DRIVEWAY TO #474.	X			
			F W13-1	18	18			2.25																	X				
SB	3.377		E W1-6	48	24								1				X												
			E W1-6	48	24			8.00							2		X							X	IN THE SB LANE, FACING NB TRAFFIC				
SB	3.180		G VR-017	24	24								1				X												
			G VR-017	24	30			5.00							1		X									E-141			
SB	3.178		H R1-1	30	30		STOP						1				X								BROOKS RD (TH-41); REMOVE THE LEFT-SIDE STOP SIGN FOR BROOKS RD.				
SB	3.170		H R1-1	30	30								1				X								BROOKS RD (TH-41)				
SIGN SUMMARY SHEET							SHEET TOTALS	41.25	0.00	0	0	0	7	0	0	7		105								PROJECT NAME: Ludlow-Waitsfield VT100			
								SF	SF	EA	EA	EA	EA	EA	EA	EA		FT								PROJECT NUMBER: STPG SIGN(27)			
VERMONT AGENCY OF TRANSPORTATION							TOWN TOTALS	647.4	0.0	13.0	4.0	4.0	135	0.0	0.0	106		1590.0								FILE NAME: Ludlow.xls			
																									PLOT DATE: 9/4/2009				
																										PROJECT MANAGER: N. Avery			
																										DRAWN BY: I. Shea			
																										DESIGNED BY: M. Miller			
																										CHECKED BY: N. Avery			
																										LUDLOW SHEET 7			
																										SHEET 15 OF 204			


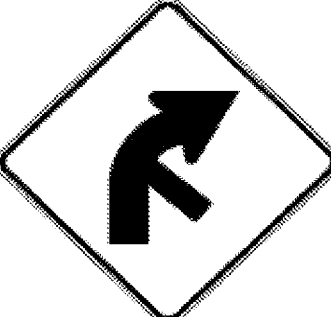
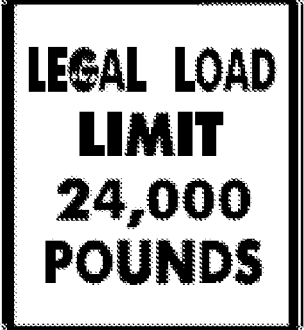


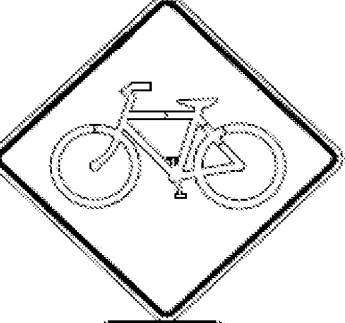

DIRECTION	MILEPOINT	LOCATION CODE (SHEET 2)	SIGN CODE	WIDTH (IN)	HEIGHT (IN)	SHEETING REMARKS	SIGN LEGEND	NEW SIGNS		EXISTING SIGNS				EXIST POST		NUMBER OF NEW POSTS	SQUARE STEEL (IN)			TUBULAR STEEL Ø (IN)				SIGN FRAME REQUIRED	REMARKS	SIGN DETAIL		
								"A"	"B"	RETAIN	SALVAGE FROM	SALVAGE TO	REMOVE	RETAIN	REMOVE		1.75	2.00	2.50	3.00	3.50	4.00	5.00			DETAIL IN SHS	DETAIL ON SHEET NUMBER	DETAIL ON STD SHEET NUMBER
																	(LB / FT)			(LB / FT)								
LUDLOW VT 100							FY-FLUORESCENT YELLOW FYG-FLUORESCENT YELLOW GREEN																"SHS"-STANDARD HIGHWAY SIGNS					
			H R1-1	30	30			6.25								1		X							BEHIND RAIL. RIGHT-SIDE STOP SIGN FOR BROOKS RD.	X		
SB	3.150		F R2-1	24	30								1				X							BEHIND RAIL				
			F R2-1	24	30			5.00							1		X							15 FT± SOUTH OF AND ACROSS FROM THE NB-FACING SPEED LIMIT 40 SIGN	X			
SB	2.430		G VR-017	24	24								1				X							SITE 1 RD (TH-64)				
			G VR-017	24	30			5.00							1		X										E-141	
SB	2.422		H R1-1	24	24								1				X							SITE 1 RD (TH-64)				
			H R1-1	30	30			6.25							1		X								X			
SB	2.388		F VM-607	24	30		43rd INF DIV MEMORIAL HWY				1						X							ADJACENT TO GRAVEL PULLOUT				
SB	2.175		F VD-062B	72	16		BUSINESS SIGN				1						X											
			F VD-062B	72	16		BUSINESS SIGN				1																	
SB	1.937		F W1-10R	30	30		CURVE RIGHT w/ 2 MINOR SIDE ROADS (S)						1				X											
SB	1.890		F W2-1Mh	30	30			6.25							1		X							INSTALL 250 FT± SOUTH OF PREVIOUS REMOVAL			6	
SB	1.775		G VR-017	24	30								1				X							WRIGHT RD (TH-63)				
			G VR-017	24	30			5.00							1		X										E-141	
SB	1.775		H R1-1	30	30		STOP						1				X						REMOVE THE GATEPOSTED LEFT-SIDE STOP SIGN FOR WRIGHT RD (TH-63)					
SIGN SUMMARY SHEET							SHEET TOTALS	33.75	0.00	3	0	0	6	0	0	6		90							PROJECT NAME: Ludlow-Waitsfield VT100			
								SF	SF	EA	EA	EA	EA	EA	EA	EA		FT							PROJECT NUMBER: STPG SIGN(27)			
VERMONT AGENCY OF TRANSPORTATION							TOWN TOTALS	647.4	0.0	13.0	4.0	4.0	135	0.0	0.0	106		1590.0							FILE NAME: Ludlow.xls			
																								PLOT DATE: 9/4/2009				
																									PROJECT MANAGER: N. Avery			
																									DRAWN BY: I. Shea			
																									DESIGNED BY: M. Miller			
																									CHECKED BY: N. Avery			
																									LUDLOW SHEET 8			
																									SHEET 16 OF 204			


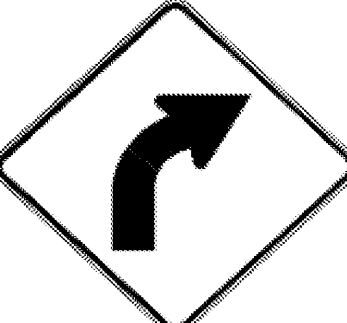


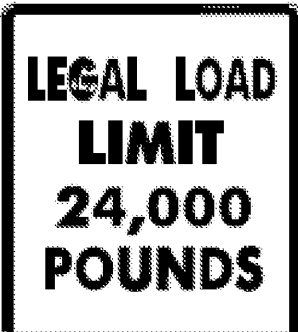


DIRECTION	MILEPOINT	LOCATION CODE (SHEET 2)	SIGN CODE	WIDTH (IN)	HEIGHT (IN)	SHEETING REMARKS	SIGN LEGEND	NEW SIGNS		EXISTING SIGNS				EXIST POST		NUMBER OF NEW POSTS	SQUARE STEEL (IN)			TUBULAR STEEL Ø (IN)				SIGN FRAME REQUIRED	REMARKS	SIGN DETAIL			
								"A"	"B"	RETAIN	SALVAGE FROM	SALVAGE TO	REMOVE	RETAIN	REMOVE		1.75	2.00	2.50	FOUNDATION	3.00	3.50	4.00			5.00	DETAIL IN SHS	DETAIL ON SHEET NUMBER	DETAIL ON STD SHEET NUMBER
																	(LB / FT)				(LB / FT)								
																	1.88	2.42	3.35		7.60	9.00	10.80			14.60			
LUDLOW VT 100							FY-FLUORESCENT YELLOW FYG-FLUORESCENT YELLOW GREEN															"SHS"-STANDARD HIGHWAY SIGNS							
SB	1.765	H	R1-1	30	30																								
		H	R1-1	30	30			6.25																X					
SB	1.705	F	M3-3	24	12																								
		F	M1-5	30	24			5.00																X	E-136B				
SB	1.630	F	VW-000	30	30																								
		F	W7-3A	24	18																								
		F	VW-001	36	36	FY		9.00																	E-153				
		F	W7-3A	24	18	FY		3.00																X					
SB	0.336	F	W1-10L	30	30																								
		F	W1-2Mh L	30	30			6.25																	6				
SB	0.230	G	VR-017	24	30																								
		G	VR-017	24	30			5.00																	E-141				
SB	0.222	H	R1-1	30	30																								
		H	R1-1	30	30			6.25																X					
SB	0.192	F	W7-1B	36	36																								
							HILL SYMBOL w/ 10% GRADE																						
SIGN SUMMARY SHEET							SHEET TOTALS	42.75	0.00	1	0	0	6	0	0	7	105					PROJECT NAME: Ludlow-Waitsfield VT100							
								SF	SF	EA	EA	EA	EA	EA	EA	EA	FT					PROJECT NUMBER: STPG SIGN(27)							
VERMONT AGENCY OF TRANSPORTATION							TOWN TOTALS	647.4	0.0	13.0	4.0	4.0	135	0.0	0.0	106	1590.0					FILE NAME: Ludlow.xls	PLOT DATE: 9/4/2009						
																					PROJECT MANAGER: N. Avery	DRAWN BY: I. Shea							
																					DESIGNED BY: M. Miller	CHECKED BY: N. Avery							
																					LUDLOW SHEET 9	SHEET 17 OF 204							

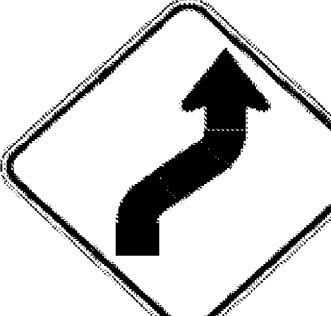




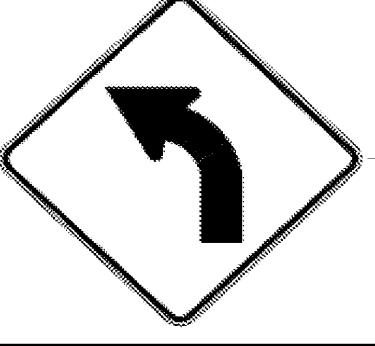
DIRECTION	MILEPOINT	LOCATION CODE (SHEET 2)	SIGN CODE	WIDTH (IN)	HEIGHT (IN)	SHEETING REMARKS	SIGN LEGEND	NEW SIGNS		EXISTING SIGNS				EXIST POST		NUMBER OF NEW POSTS	SQUARE STEEL (IN)			TUBULAR STEEL Ø (IN)				SIGN FRAME REQUIRED	REMARKS	SIGN DETAIL				
								"A"	"B"	RETAIN	SALVAGE FROM	SALVAGE TO	REMOVE	RETAIN	REMOVE		1.75	2.00	2.50	3.00	3.50	4.00	5.00			DETAIL IN SHS	DETAIL ON SHEET NUMBER	DETAIL ON STD SHEET NUMBER		
																	(LB / FT)			(LB / FT)										
LUDLOW VT 100							FY-FLUORESCENT YELLOW FYG-FLUORESCENT YELLOW GREEN																"SHS"-STANDARD HIGHWAY SIGNS							
			F W7-3A	30	24		NEXT 2 MILES (PLAQUE)			1																				
SB	0.000	G	VD-024	60	7.5		ANDOVER I LUDLOW									X		X										(REMOVE ONLY AFTER THE NEW SIGN IS INSTALLED ACROSS IN THE NB LANE)		
CLASS 1 PORTION OF HIGHWAY ENDS																														
NB	5.080	A	M3-1	24	12							1		X																
		A	M1-5	30	24								1																	
		A	M3-1	24	12			2.00							1		X									X			GREEN ON WHITE SHEETING	
		A	M1-5	30	24			5.00																					ASSEMBLY BEHIND RAIL	
NB	5.118	A	D2-1	72	10							1		X																
		A	D2-1	72	10								1																	
		A	D2-1	72	12			6.00							2		X												5	
		A	D2-1	72	12			6.00																					5	
NB	5.148	A	VW-619	36	36		SHOULDER NARROWS							1		X														
NB	5.178	A	R2-1	24	30																									
		A	R2-1	24	30			5.00							1		X									X				
NB	5.223	A	W11-1	30	30		BICYCLE SYMBOL							1		X														
SIGN SUMMARY SHEET							SHEET TOTALS	24.00	0.00	1	0	0	7	0	0	4	60													
								SF	SF	EA	EA	EA	EA	EA	EA	EA	EA	EA	EA	EA	EA	EA	EA	EA	EA	EA	EA	EA	EA	EA
VERMONT AGENCY OF TRANSPORTATION							TOWN TOTALS	647.4	0.0	13.0	4.0	4.0	135	0.0	0.0	106	1590.0													
																				PROJECT NAME:	Ludlow-Waitsfield VT100									
																				PROJECT NUMBER:	STPG SIGN(27)									
										FILE NAME:	Ludlow.xls				PLOT DATE:	9/4/2009														
										PROJECT MANAGER:	N. Avery				DRAWN BY:	I. Shea														
										DESIGNED BY:	M. Miller				CHECKED BY:	N. Avery														
										LUDLOW SHEET 10									SHEET	18	OF	204								







DIRECTION	MILEPOINT	LOCATION CODE (SHEET 2)	SIGN CODE	WIDTH (IN)	HEIGHT (IN)	SHEETING REMARKS	SIGN LEGEND	NEW SIGNS		EXISTING SIGNS				EXIST POST		NUMBER OF NEW POSTS	SQUARE STEEL (IN)			TUBULAR STEEL Ø (IN)				SIGN FRAME REQUIRED	REMARKS	SIGN DETAIL			
								"A"	"B"	RETAIN	SALVAGE FROM	SALVAGE TO	REMOVE	RETAIN	REMOVE		1.75	2.00	2.50	3.00	3.50	4.00	5.00			DETAIL IN SHS	DETAIL ON SHEET NUMBER	DETAIL ON STD SHEET NUMBER	
																	(LB / FT)			(LB / FT)									
LUDLOW VT 100							FY-FLUORESCENT YELLOW FYG-FLUORESCENT YELLOW GREEN															"SHS"-STANDARD HIGHWAY SIGNS							
			A W16-1	18	24		SHARE THE ROAD (PLAQUE) 						1																
NB	5.225		A W11-1	30	30			6.25							1		X							INSTALL 10 FT± NORTH OF PREVIOUS LOCATION	X				
			A W16-1	18	24			3.00																	X				
NB	5.301		A VR-023B	24	30		\$500 FINE FOR THROWING TRASH ON HIGHWAYS AND STREAMS			1	1				1		X												
NB	5.360		A VW-054L	30	30								1				X												
			A VW-054L	30	30			6.25						1		X											E-154		
NB	5.600		A W1-10L	30	30		CURVE LEFT w/ MINOR SIDE ROAD LEFT						1				X												
NB	5.715		A W1-2L	30	30		CURVE LEFT w/ MINOR SIDE ROAD RIGHT 						1				X							BEHIND RAIL					
			A W1-2McL	30	30			6.25						1		X											6		
NB	5.765		A VD-062AS	72	16		BUSINESS SIGN			1							X							BEHIND RAIL					
NB	5.813		C VR-017	24	30								1				X							EAST LAKE RD (TH-4)					
			C VR-017	24	30			5.00						1		X											E-141		
NB	5.821		D R1-1	30	30								1				X							EAST LAKE RD (TH-4)					
			D R1-1	30	30			6.25							1		X								X				
NB	5.865		A R2-1	24	30			5.00							1		X							INSTALL 25 FT± SOUTH OF THE EXISTING SPEED LIMIT 45 SIGN (TO BE REMOVED)	X				
SIGN SUMMARY SHEET							SHEET TOTALS	38.00	0.00	1	1	1	6	0	0	7		105							PROJECT NAME: Ludlow-Waitsfield VT100				
								SF	SF	EA	EA	EA	EA	EA	EA	EA		FT								PROJECT NUMBER: STPG SIGN(27)			
VERMONT AGENCY OF TRANSPORTATION							TOWN TOTALS	647.4	0.0	13.0	4.0	4.0	135	0.0	0.0	106		1590.0								FILE NAME: Ludlow.xls			
																									PROJECT MANAGER: N. Avery				
																									DESIGNED BY: M. Miller				
																									LUDLOW SHEET 11				
																									PLOT DATE: 9/4/2009				
																									DRAWN BY: I. Shea				
																									CHECKED BY: N. Avery				
																									SHEET 19 OF 204				

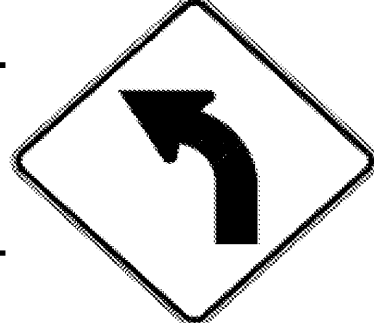

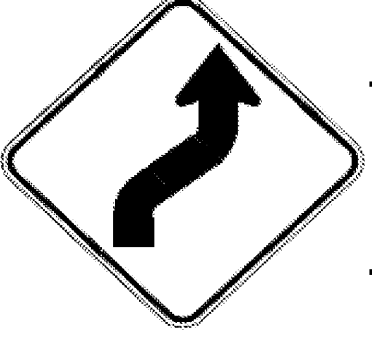
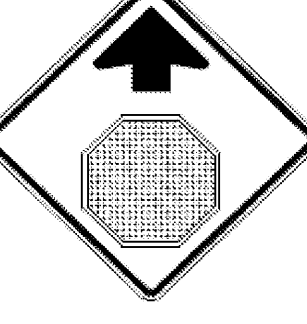

DIRECTION	MILEPOINT	LOCATION CODE (SHEET 2)	SIGN CODE	WIDTH (IN)	HEIGHT (IN)	SHEETING REMARKS	SIGN LEGEND	NEW SIGNS		EXISTING SIGNS				EXIST POST		NUMBER OF NEW POSTS	SQUARE STEEL (IN)			TUBULAR STEEL Ø (IN)				SIGN FRAME REQUIRED	REMARKS	SIGN DETAIL		
								"A"	"B"	RETAIN	SALVAGE FROM	SALVAGE TO	REMOVE	RETAIN	REMOVE		1.75	2.00	2.50	3.00	3.50	4.00	5.00			DETAIL IN SHS	DETAIL ON SHEET NUMBER	DETAIL ON STD SHEET NUMBER
																	(LB / FT)			(LB / FT)								
								1.88	2.42	3.35	FOUNDATION	7.60	9.00	10.80	14.60													
LUDLOW VT 100							FY-FLUORESCENT YELLOW FYG-FLUORESCENT YELLOW GREEN															"SHS"-STANDARD HIGHWAY SIGNS						
NB	5.870	A	R2-1	24	30		SPEED LIMIT 45					1		X														
NB	5.900	A	M3-1	24	12										1													
		A	M1-5	30	24																							
		A	M3-1	24	12			2.00							1	X								X				
		A	M1-5	30	24			5.00																		E-136B		
NB	6.570	A	W1-2L	30	30		CURVE LEFT					1		X												BEHIND RAIL		
NB	6.572	A	W1-2L	30	30			6.25							1	X								X		INSTALL 10 FT± NORTH OF EXISTING POSITION		
NB	6.735	A	VW-219	30	30							1		X														
		A	VW-219	30	30			6.25							1	X									6	INSTALL 285 FT± SOUTH OF THE CURVE LEFT w/ MINOR SIDE ROAD RIGHT SYMBOL AHEAD		
NB	6.789	A	W1-2McL	30	30							1		X														
		A	W1-2McL	30	30			6.25							1	X										6		
NB	6.896	C	n/a	24	30		SPEED ZONE AHEAD								1		X									RED BRIDGE RD (TH-8); REMOVE THE TOWN-INSTALLED SIGN, NOT TO BE RE-INSTALLED. RETURN TO TOWN		
		C	VR-017	24	30										1													
		C	VR-017	24	30			5.00							1	X										E-141		
NB	6.904	D	R1-1	30	30										1		X									RED BRIDGE RD (TH-8)		
SIGN SUMMARY SHEET							SHEET TOTALS	30.75	0.00	0	0	0	9	0	0	5	75					PROJECT NAME: Ludlow-Waitsfield VT100						
VERMONT AGENCY OF TRANSPORTATION								SF	SF	EA	EA	EA	EA	EA	EA	EA	FT					PROJECT NUMBER: STPG SIGN(27)						
							TOWN TOTALS	647.4	0.0	13.0	4.0	4.0	135	0.0	0.0	106	1590.0					FILE NAME: Ludlow.xls	PLOT DATE: 9/4/2009					
																							PROJECT MANAGER: N. Avery	DRAWN BY: I. Shea				
																							DESIGNED BY: M. Miller	CHECKED BY: N. Avery				
																							LUDLOW SHEET 12	SHEET 20 OF 204				

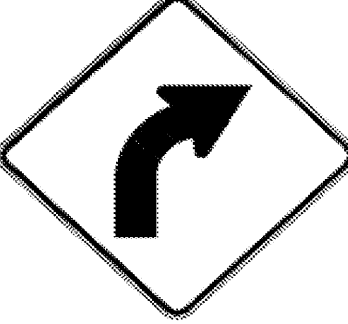


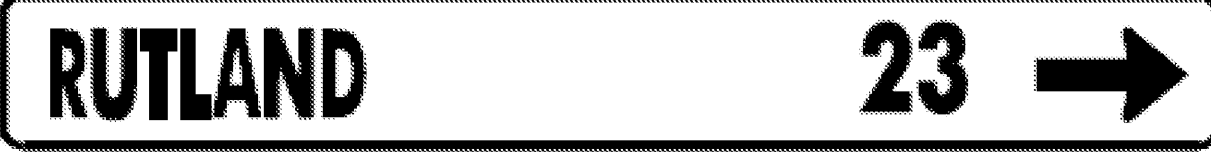
DIRECTION	MILEPOINT	LOCATION CODE (SHEET 2)	SIGN CODE	WIDTH (IN)	HEIGHT (IN)	SHEETING REMARKS	SIGN LEGEND	NEW SIGNS		EXISTING SIGNS				EXIST POST		NUMBER OF NEW POSTS	SQUARE STEEL (IN)			TUBULAR STEEL Ø (IN)				SIGN FRAME REQUIRED	REMARKS	SIGN DETAIL			
								"A"	"B"	RETAIN	SALVAGE FROM	SALVAGE TO	REMOVE	RETAIN	REMOVE		1.75	2.00	2.50	FOUNDATION	3.00	3.50	4.00			5.00	DETAIL IN SHS	DETAIL ON SHEET NUMBER	DETAIL ON STD SHEET NUMBER
																	(LB / FT)				(LB / FT)								
LUDLOW VT 100							FY-FLUORESCENT YELLOW FYG-FLUORESCENT YELLOW GREEN																"SHS"-STANDARD HIGHWAY SIGNS						
			D R1-1	30	30			6.25							1		X									X			
NB	7.025		A W1-2R	30	30		CURVE RIGHT							1		X													
			A W13-1	18	18		40 MPH (PLAQUE)																						
NB	7.090		A W1-2MbR	30	30			6.25							1		X										6		
NB	7.167		C VR-017	24	30									1		X													
			C VR-017	24	30			5.00							1		X										E-141		
NB	7.175		D R1-1	30	30									1		X													
			D R1-1	30	30			6.25							1		X								X				
NB	7.230		A R2-1	24	30									1		X													
			A R2-1	24	30			5.00							1		X								X				
NB	7.320		A W1-4R	30	30									1		X													
			A W13-1	18	18									1															
			A W1-4R	30	30			6.25							1		X									X			
			A W13-1	18	18			2.25																	X				
NB	7.382		A VW-054	30	30									1		X													
SIGN SUMMARY SHEET							SHEET TOTALS	37.25	0.00	0	0	0	8	0	0	6	90												
								SF	SF	EA	EA	EA	EA	EA	EA	EA	EA	EA	EA	EA	EA	EA	EA	EA	EA	EA	EA	EA	EA
VERMONT AGENCY OF TRANSPORTATION							TOWN TOTALS	647.4	0.0	13.0	4.0	4.0	135	0.0	0.0	106	1590.0												
							PROJECT NAME:	Ludlow-Waitsfield VT100																					
							PROJECT NUMBER:	STPG SIGN(27)																					
							FILE NAME:	Ludlow.xls											PLOT DATE:	9/4/2009									
							PROJECT MANAGER:	N. Avery											DRAWN BY:	I. Shea									
							DESIGNED BY:	M. Miller											CHECKED BY:	N. Avery									
							LUDLOW SHEET	13											SHEET	21 OF 204									

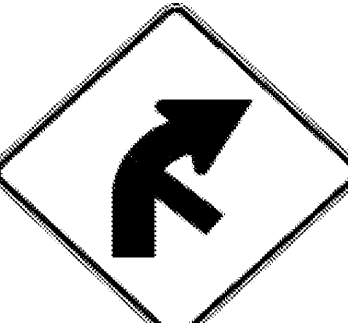DIRECTION	MILEPOINT	LOCATION CODE (SHEET 2)	SIGN CODE	WIDTH (IN)	HEIGHT (IN)	SHEETING REMARKS	SIGN LEGEND	NEW SIGNS		EXISTING SIGNS				EXIST POST		NUMBER OF NEW POSTS	SQUARE STEEL (IN)			TUBULAR STEEL Ø (IN)				SIGN FRAME REQUIRED	REMARKS	SIGN DETAIL			
								"A"	"B"	RETAIN	SALVAGE FROM	SALVAGE TO	REMOVE	RETAIN	REMOVE		(LB / FT)			(LB / FT)						DETAIL IN SHS	DETAIL ON SHEET NUMBER	DETAIL ON STD SHEET NUMBER	
																	1.75	2.00	2.50	3.00	3.50	4.00	5.00						
LUDLOW VT 100							FY-FLUORESCENT YELLOW FYG-FLUORESCENT YELLOW GREEN																"SHS"-STANDARD HIGHWAY SIGNS						
		A	VW-054R	30	30			6.25							1	X										E-154			
NB	8.081	A	W1-2R	30	30									1		X													
NB	8.098	A	W1-2R	30	30			6.25							1		X							INSTALL 90 FT± NORTH OF PREVIOUS POSITION	X				
NB	8.125	A	R2-5A	24	30									1		X													
NB	8.135	A	W3-5	36	36			9.00							2		X							INSTALL THIS NEW SIGN ON 2 POSTS 50 FT± NORTH OF REMOVED PREVIOUS SIGN; MAINTAIN 10 FT MIN TO POLE	X				
NB	8.161	A	VD-018	30	18									1		X													
		A	VD-018	30	18			3.75							1		X								E-128B				
NB	8.215	A	R2-1	24	30									1		X													
		A	R2-1	30	36			7.50							1		X								6				
NB	8.313	A	VW-054	30	30									1		X													
		A	VW-133R	30	30			6.25							1		X									E-154			
SB	8.440	F	VW-219	30	30									1		X													
SB	8.368	F	VW-219	30	30			6.25							1		X							INSTALL 380 FT± SOUTH OF PREVIOUS POSITION; MAINTAIN 10 FT MIN TO POLE.		6			
SB	8.283	F	W1-2L	30	30									1		X													
		F	W13-1	18	18									1		X													
SIGN SUMMARY SHEET							SHEET TOTALS	45.25	0.00	0	0	0	8	0	0	8		120											
VERMONT AGENCY OF TRANSPORTATION								SF	SF	EA	EA	EA	EA	EA	EA	EA		FT											
							TOWN TOTALS	647.4	0.0	13.0	4.0	4.0	135	0.0	0.0	106		1590.0											
																		PROJECT NAME:	Ludlow-Waitsfield VT100										
																		PROJECT NUMBER:	STPG SIGN(27)										
																		FILE NAME:	Ludlow.xls					PLOT DATE:	9/4/2009				
																		PROJECT MANAGER:	N. Avery					DRAWN BY:	I. Shea				
																		DESIGNED BY:	M. Miller					CHECKED BY:	N. Avery				
																		LUDLOW SHEET 14						SHEET	22		OF	204	


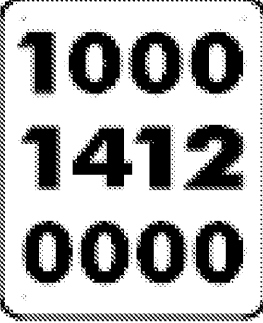
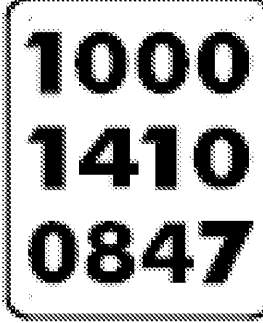



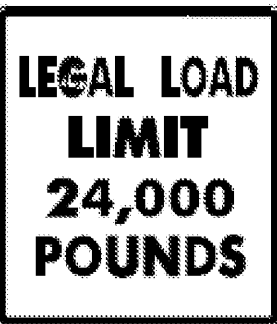
DIRECTION	MILEPOINT	LOCATION CODE (SHEET 2)	SIGN CODE	WIDTH (IN)	HEIGHT (IN)	SHEETING REMARKS	SIGN LEGEND	NEW SIGNS		EXISTING SIGNS				EXIST POST		NUMBER OF NEW POSTS	SQUARE STEEL (IN)			TUBULAR STEEL Ø (IN)				SIGN FRAME REQUIRED	REMARKS	SIGN DETAIL			
								"A"	"B"	RETAIN	SALVAGE FROM	SALVAGE TO	REMOVE	RETAIN	REMOVE		(LB / FT)			(LB / FT)						DETAIL IN SHS	DETAIL ON SHEET NUMBER	DETAIL ON STD SHEET NUMBER	
																	1.75	2.00	2.50	3.00	3.50	4.00	5.00						
LUDLOW VT 100							FY-FLUORESCENT YELLOW FYG-FLUORESCENT YELLOW GREEN																"SHS"-STANDARD HIGHWAY SIGNS						
			F W1-2L	30	30			6.25							1	X								X					
SB	8.230		F R2-1	24	30								1		X														
			F R2-1	24	30			5.00						1	X									X	(ACROSS FROM THE NB SPEED LIMIT 35 SIGN)				
SB	8.064		F n/a	n/a	n/a		REMOVE EMPTY POST																		REMOVE EMPTY POST				
SB	7.930		F VW-054L	30	30			6.25						1	X											INSTALL 185 FT± NORTH OF THE EXISTING SIGN, WHICH WILL BE REMOVED			E-154
SB	7.895		F VW-133A	30	30		HIDDEN DRIVE LEFT						1		X														
SB	7.705		F W1-4R	30	30		REVERSE CURVE RIGHT						1		X														
			F W13-1	18	18		35 MPH (PLAQUE)						1		X														
SB	7.655		F W1-4R	30	30			6.25						1	X									X	INSTALL 265 FT± SOUTH OF PREVIOUS POSITION				
SB	7.530		F VW-133A	30	30		HIDDEN DRIVE LEFT						1		X														
SB	7.455		F VW-054L	30	30			6.25						1	X											INSTALL 400 FT± SOUTH OF PREVIOUS POSITION; MAINTAIN 10 FT MIN TO POLE			E-154
SB	7.255		F W1-2L	30	30		CURVE LEFT						1		X														
SB	7.220		F VW-219	30	30		SUMMER CAMP AREA						1		X														
			F W1-2L	30	30			6.25						1	X									X					
SB	7.105		F R2-1	24	30		SPEED LIMIT 45						1		X														
SIGN SUMMARY SHEET							SHEET TOTALS	36.25	0.00	0	0	0	8	0	0	6	90												
VERMONT AGENCY OF TRANSPORTATION								SF	SF	EA	EA	EA	EA	EA	EA	EA	FT												
							TOWN TOTALS	647.4	0.0	13.0	4.0	4.0	135	0.0	0.0	106	1590.0												
PROJECT NAME: Ludlow-Waitsfield VT100																					PROJECT NUMBER: STPG SIGN(27)								
FILE NAME: Ludlow.xls												PLOT DATE: 9/4/2009																	
PROJECT MANAGER: N. Avery												DRAWN BY: I. Shea																	
DESIGNED BY: M. Miller												CHECKED BY: N. Avery																	
LUDLOW SHEET 15																					SHEET 23 OF 204								




DIRECTION	MILEPOINT	LOCATION CODE (SHEET 2)	SIGN CODE	WIDTH (IN)	HEIGHT (IN)	SHEETING REMARKS	SIGN LEGEND	NEW SIGNS		EXISTING SIGNS				EXIST POST		NUMBER OF NEW POSTS	SQUARE STEEL (IN)			TUBULAR STEEL Ø (IN)				SIGN FRAME REQUIRED	REMARKS	SIGN DETAIL		
								"A"	"B"	RETAIN	SALVAGE FROM	SALVAGE TO	REMOVE	RETAIN	REMOVE		1.75	2.00	2.50	3.00	3.50	4.00	5.00			DETAIL IN SHS	DETAIL ON SHEET NUMBER	DETAIL ON STD SHEET NUMBER
																	(LB / FT)			(LB / FT)								
LUDLOW VT 100							FY-FLUORESCENT YELLOW FYG-FLUORESCENT YELLOW GREEN															"SHS"-STANDARD HIGHWAY SIGNS						
SB	7.070	F	R2-1	24	30			5.00															INSTALL 185 FT± SOUTH OF PREVIOUS POSITION	X				
SB	7.010	F	W1-2R	30	30		CURVE RIGHT w/ MINOR SIDE ROAD LEFT																					
SB	6.950	F	VW-133R	30	30			6.25																INSTALL 315 FT± SOUTH OF PREVIOUS CURVE RIGHT SIGN REMOVAL; MAINTAIN 10 FT MIN TO POLE.			E-154	
SB	6.775	F	W1-2R	30	30		CURVE RIGHT																					
SB	6.766	F	W1-2R	30	30			6.25																INSTALL 50 FT± SOUTH OF PREVIOUS LOCATION	X			
SB	6.730	F	VW-205	30	30																							
		F	VW-205	30	30			6.25																			E-154	
SB	5.975	F	R2-5A	24	30		REDUCED SPEED AHEAD																					
SB	5.920	F	W1-10R	30	30		CURVE RIGHT w/ MINOR SIDE ROAD LEFT																					
SB	5.885	F	R2-1	24	30																							
		F	R2-1	30	36			7.50																	INSTALL ACROSS FROM± THE NB SPEED LIMIT 45 SIGN		6	
SB	5.825	F	W1-2MbR	30	30		CURVE RIGHT w/ MINOR SIDE ROAD RIGHT																					
SB	5.790	F	n/a	n/a	n/a		(REMOVE THE TWO EMPTY POSTS)																					
		F	W1-2MbR	30	30			6.25																			6	
SB	5.755	F	R2-1	24	30		SPEED LIMIT 40																					
SIGN SUMMARY SHEET							SHEET TOTALS	37.50	0.00	0	0	0	8	0	0	6	90							PROJECT NAME: Ludlow-Waitsfield VT100				
								SF	SF	EA	EA	EA	EA	EA	EA	EA	FT						PROJECT NUMBER: STPG SIGN(27)					
VERMONT AGENCY OF TRANSPORTATION							TOWN TOTALS	647.4	0.0	13.0	4.0	4.0	135	0.0	0.0	106	1590.0						FILE NAME: Ludlow.xls	PLOT DATE: 9/4/2009				
																						PROJECT MANAGER: N. Avery	DRAWN BY: I. Shea					
																						DESIGNED BY: M. Miller	CHECKED BY: N. Avery					
																						LUDLOW SHEET 16	SHEET 24 OF 204					




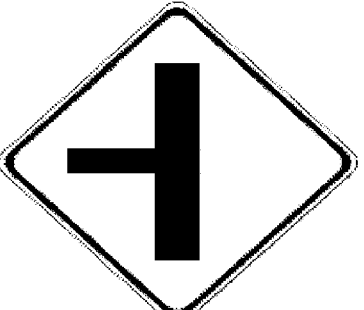
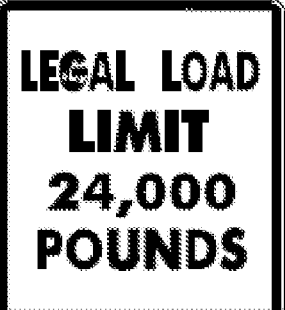
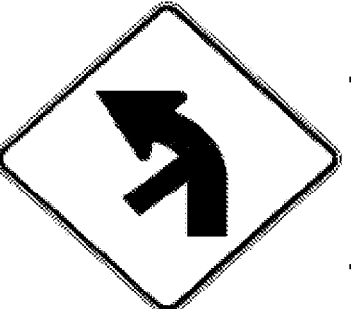
DIRECTION	MILEPOINT	LOCATION CODE (SHEET 2)	SIGN CODE	WIDTH (IN)	HEIGHT (IN)	SHEETING REMARKS	SIGN LEGEND	NEW SIGNS		EXISTING SIGNS				EXIST POST		NUMBER OF NEW POSTS	SQUARE STEEL (IN)			TUBULAR STEEL Ø (IN)				SIGN FRAME REQUIRED	REMARKS	SIGN DETAIL		
								"A"	"B"	RETAIN	SALVAGE FROM	SALVAGE TO	REMOVE	RETAIN	REMOVE		(LB / FT)			(LB / FT)						DETAIL IN SHS	DETAIL ON SHEET NUMBER	DETAIL ON STD SHEET NUMBER
																	1.75	2.00	2.50	3.00	3.50	4.00	5.00					
LUDLOW VT 100							FY-FLUORESCENT YELLOW FYG-FLUORESCENT YELLOW GREEN															"SHS"-STANDARD HIGHWAY SIGNS						
SB	5.726	G	VR-017	24	30							1		X														
		G	VR-017	24	30			5.00								1		X								E-141		
SB	5.720	H	R1-1	30	30							1		X														
		H	R1-1	30	30			6.25								1		X					X					
SB	5.650	F	M3-3	24	12		SOUTH					1		X														
		F	M1-5	30	24		VERMONT 100						1															
		F	R2-1	24	30			5.00								1		X					X					
SB	5.240	F	W3-1	36	36							1		X														
		F	W3-1	36	36			9.00								2		X					X					
SB	5.190	F	M2-1	21	15							1		X														
		F	M1-5	24	24							1																
		F	M2-1	21	15			2.19								1		X					X					
		F	M1-5	24	24			5.00																		E-136B		
SB	5.160	F	D1-1S	72	10							1		X														
		F	D1-1A	72	10							1																
SIGN SUMMARY SHEET							SHEET TOTALS		32.44	0.00	0	0	0	9	0	0	6	90	PROJECT NAME: Ludlow-Waitsfield VT100									
							SF	SF	EA	EA	EA	EA	EA	EA	EA	EA	EA	EA	FT	PROJECT NUMBER: STPG SIGN(27)								
							TOWN TOTALS							647.4	0.0	13.0	4.0	4.0	135	0.0	0.0	106	1590.0	FILE NAME: Ludlow.xls PLOT DATE: 9/4/2009				
VERMONT AGENCY OF TRANSPORTATION														PROJECT MANAGER: N. Avery DRAWN BY: I. Shea														
														DESIGNED BY: M. Miller CHECKED BY: N. Avery														
														LUDLOW SHEET 17 SHEET 25 OF 204														

DIRECTION	MILEPOINT	LOCATION CODE (SHEET 2)	SIGN CODE	WIDTH (IN)	HEIGHT (IN)	SHEETING REMARKS	SIGN LEGEND	NEW SIGNS		EXISTING SIGNS				EXIST POST		NUMBER OF NEW POSTS	SQUARE STEEL (IN)			TUBULAR STEEL Ø (IN)				SIGN FRAME REQUIRED	REMARKS	SIGN DETAIL			
								"A"	"B"	RETAIN	SALVAGE FROM	SALVAGE TO	REMOVE	RETAIN	REMOVE		(LB / FT)			(LB / FT)						DETAIL IN SHS	DETAIL ON SHEET NUMBER	DETAIL ON STD SHEET NUMBER	
																	1.75	2.00	2.50	3.00	3.50	4.00	5.00						
LUDLOW VT 100							FY-FLUORESCENT YELLOW FYG-FLUORESCENT YELLOW GREEN																"SHS"-STANDARD HIGHWAY SIGNS						
			F D1-1A	72	10																								
			F D1-1A	72	10																								
			F D1-1A	72	12			6.00							2			X							5				
			F D1-1S	72	12			6.00																		5			
			F D1-1A	72	12			6.00																		5			
			F D1-1A	72	12			6.00																		5			
SB	5.130		F M3-3	24	12																								
			F M1-5	24	24																								
			F M6-1	21	15																								
			F M3-3	24	12																								
			F M1-5	24	24																								
			F M6-1	21	15																								
			F M3-1	24	12																								
			F M1-5	24	24																								
			F M6-1	21	15																								
SIGN SUMMARY SHEET							SHEET TOTALS	24.00	0.00	0	0	0	11	0	0	2	30												
							SF	SF	EA	EA	EA	EA	EA	EA	EA	EA	FT												
							TOWN TOTALS	647.4	0.0	13.0	4.0	4.0	135	0.0	0.0	106	1590.0												
VERMONT AGENCY OF TRANSPORTATION																	PROJECT NAME: Ludlow-Waitsfield VT100 PROJECT NUMBER: STPG SIGN(27) FILE NAME: Ludlow.xls PLOT DATE: 9/4/2009 PROJECT MANAGER: N. Avery DRAWN BY: I. Shea DESIGNED BY: M. Miller CHECKED BY: N. Avery LUDLOW SHEET 18 SHEET 26 OF 204												

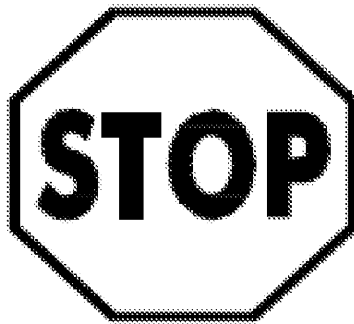

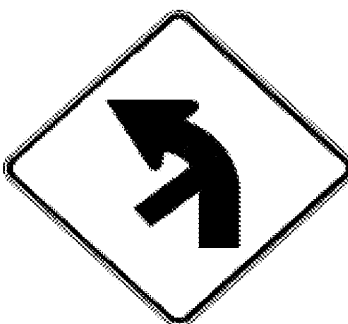



DIRECTION	MILEPOINT	LOCATION CODE (SHEET 2)	SIGN CODE	WIDTH (IN)	HEIGHT (IN)	SHEETING REMARKS	SIGN LEGEND	NEW SIGNS		EXISTING SIGNS				EXIST POST		NUMBER OF NEW POSTS	SQUARE STEEL (IN)			TUBULAR STEEL Ø (IN)				SIGN FRAME REQUIRED	REMARKS	SIGN DETAIL		
								"A"	"B"	RETAIN	SALVAGE FROM	SALVAGE TO	REMOVE	RETAIN	REMOVE		(LB / FT)			(LB / FT)						DETAIL IN SHS	DETAIL ON SHEET NUMBER	DETAIL ON STD SHEET NUMBER
																	1.75	2.00	2.50	3.00	3.50	4.00	5.00					
LUDLOW VT 100							FY-FLUORESCENT YELLOW FYG-FLUORESCENT YELLOW GREEN																"SHS"-STANDARD HIGHWAY SIGNS					
			F M3-3	24	12			2.00							2			X				#3C	GREEN ON WHITE SHEETING	X	7			
			F M1-5	30	24			5.00																	E-136B			
			F M6-1L	21	15			2.19																				
			F M3-3	24	12			2.00																				
			F M1-5	30	24			5.00																	E-136B			
			F M6-1L	21	15			2.19																				
			F M3-1	24	12			2.00																				
			F M1-5	30	24			5.00																	E-136B			
			F M6-1R	21	15			2.19																				
SB	5.110		F VR-040	24	24		THROUGH WAY ENDS HERE						1			X						BEHIND RAIL						
			E VR-041	24	24		THROUGH WAY BEGINS HERE (ON BACK)						1															
SB	5.080		F R1-1	30	30								1			X						RETAIN EXISTING POST w/ SINGLE FLASHING BEACON ON TOP						
			F R1-1	30	30			6.25																X				
SIGN SUMMARY SHEET							SHEET TOTALS	33.82	0.00	0	0	0	3	0	0	2	30						PROJECT NAME: Ludlow-Waitsfield VT100					
							SF	SF	EA	EA	EA	EA	EA	EA	EA	EA	FT						PROJECT NUMBER: STPG SIGN(27)					
VERMONT AGENCY OF TRANSPORTATION							TOWN TOTALS	647.4	0.0	13.0	4.0	4.0	135	0.0	0.0	106	1590.0						FILE NAME: Ludlow.xls	PLOT DATE: 9/4/2009				
																						PROJECT MANAGER: N. Avery	DRAWN BY: I. Shea					
																						DESIGNED BY: M. Miller	CHECKED BY: N. Avery					
																						LUDLOW SHEET 19	SHEET 27 OF 204					


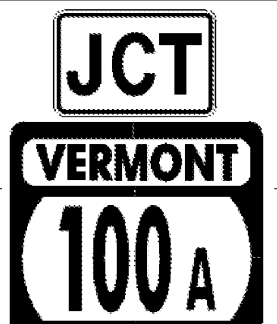
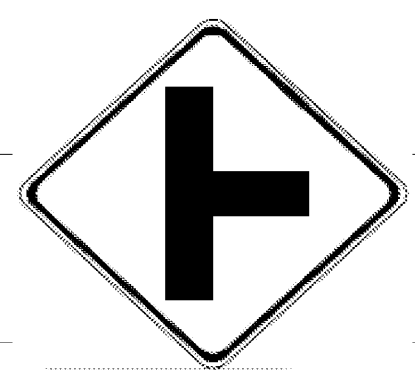




DIRECTION	MILEPOINT	LOCATION CODE (SHEET 2)	SIGN CODE	WIDTH (IN)	HEIGHT (IN)	SHEETING REMARKS	SIGN LEGEND	NEW SIGNS		EXISTING SIGNS				EXIST POST		NUMBER OF NEW POSTS	SQUARE STEEL (IN)			TUBULAR STEEL Ø (IN)				SIGN FRAME REQUIRED	REMARKS	SIGN DETAIL		
								"A"	"B"	RETAIN	SALVAGE FROM	SALVAGE TO	REMOVE	RETAIN	REMOVE		1.75	2.00	2.50	3.00	3.50	4.00	5.00			DETAIL IN SHS	DETAIL ON SHEET NUMBER	DETAIL ON STD SHEET NUMBER
																	(LB / FT)			(LB / FT)								
PLYMOUTH VT 100							FY-FLUORESCENT YELLOW FYG-FLUORESCENT YELLOW GREEN															"SHS"-STANDARD HIGHWAY SIGNS						
NB	0.000	C	VD-024	60	7.5		PLYMOUTH LUDLOW																					
		C	VD-024	72	10			5.00																4				
		C	VD-700	6	10			0.42																	E-138			
		C	VD-700	6	10			0.42																	E-138			
NB	0.017	A	VD-062BRN	72	16		BUSINESS SIGN			1														CAMP PLYMOUTH				
NB	0.055	A	R2-1	24	30							1																
		A	R2-1	24	30			5.00						1										X				
NB	0.091	A	D1-1A	54	7.5																							
		A	D1-1A	54	7.5																							
		A	D1-1A	72	12			6.00																		5		
		A	D1-1A	72	12			6.00																			5	
NB	0.132	D	R1-1	30	30		STOP																				KINGDOM RD (TH-2)	
NB	0.132	C	VR-017	24	30		LEGAL LOAD LIMIT 24,000 POUNDS																				KINGDOM RD (TH-2)	
		C	n/a	18	24		NO PARKING				1	1															RE-INSTALL TO UNDER THE NEW LEGAL LOAD LIMIT SIGN	
		C	VR-017	24	30			5.00																			E-141	
SIGN SUMMARY SHEET							SHEET TOTALS	27.84	0.00	1	1	1	6	0	0	6	90							PROJECT NAME: Ludlow-Waitsfield VT110				
								SF	SF	EA	EA	EA	EA	EA	EA	EA	FT							PROJECT NUMBER: STPG SIGN(27)				
VERMONT AGENCY OF TRANSPORTATION							TOWN TOTALS	668.4	0.0	31.0	4.0	4.0	135	0.0	0.0	111	1665.0							FILE NAME: Plymouth.xls	PLOT DATE: 9/8/2009			
																							PROJECT MANAGER: N. Avery	DRAWN BY: I. Shea				
																							DESIGNED BY: M. Miller	CHECKED BY: N. Avery				
																							PLYMOUTH SHEET 1	SHEET 28 OF 204				

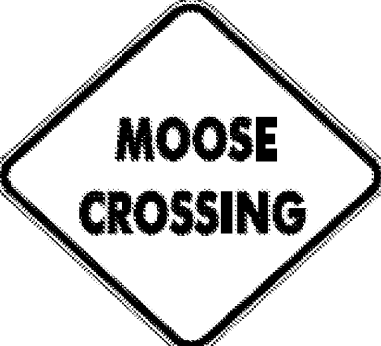
DIRECTION	MILEPOINT	LOCATION CODE (SHEET 2)	SIGN CODE	WIDTH (IN)	HEIGHT (IN)	SHEETING REMARKS	SIGN LEGEND	NEW SIGNS		EXISTING SIGNS				EXIST POST		NUMBER OF NEW POSTS	SQUARE STEEL (IN)			TUBULAR STEEL Ø (IN)				SIGN FRAME REQUIRED	REMARKS	SIGN DETAIL		
								"A"	"B"	RETAIN	SALVAGE FROM	SALVAGE TO	REMOVE	RETAIN	REMOVE		1.75	2.00	2.50	3.00	3.50	4.00	5.00			DETAIL IN SHS	DETAIL ON SHEET NUMBER	DETAIL ON STD SHEET NUMBER
																	(LB / FT)			(LB / FT)								
PLYMOUTH VT 100							FY-FLUORESCENT YELLOW FYG-FLUORESCENT YELLOW GREEN															"SHS"-STANDARD HIGHWAY SIGNS						
NB	0.144	D	R1-1	30	30																							
		D	R1-1	30	30			6.25																X				
NB	0.170	A	M3-1	24	12																							
		A	M1-5	30	24																							
		A	M3-1	24	12			2.00																X				
		A	M1-5	30	24			5.00																	E-136B			
NB	0.300	A	R2-1	24	30																							
		A	R2-1	24	30			5.00																X				
NB	0.740	C	VM-607	24	30		43RD INF DIV MEMORIAL HIGHWAY			1																		
NB	0.750	C	VR-023B	24	30		\$500 FINE FOR THROWING TRASH ON HIGHWAYS AND STREAMS			1																		
NB	1.132	A	VW-219	30	30		SUMMER CAMP AREA																					
NB	1.880	C	VR-023B	24	30		\$500 FINE FOR THROWING TRASH ON HIGHWAYS AND STREAMS																					
SIGN SUMMARY SHEET							SHEET TOTALS	18.25	0.00	2	0	0	6	0	0	3	45					PROJECT NAME: Ludlow-Waitsfield VT110						
								SF	SF	EA	EA	EA	EA	EA	EA	EA	FT					PROJECT NUMBER: STPG SIGN(27)						
VERMONT AGENCY OF TRANSPORTATION							TOWN TOTALS	668.4	0.0	31.0	4.0	4.0	135	0.0	0.0	111	1665.0					FILE NAME: Plymouth.xls	PLOT DATE: 9/8/2009					
																						PROJECT MANAGER: N. Avery	DRAWN BY: I. Shea					
																						DESIGNED BY: M. Miller	CHECKED BY: N. Avery					
																						PLYMOUTH SHEET 2	SHEET 29	OF 204				






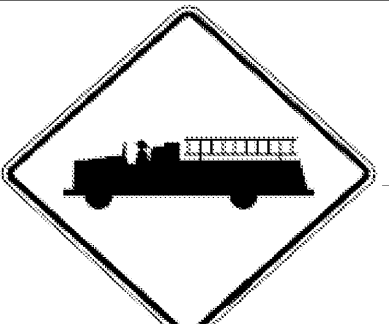
DIRECTION	MILEPOINT	LOCATION CODE (SHEET 2)	SIGN CODE	WIDTH (IN)	HEIGHT (IN)	SHEETING REMARKS	SIGN LEGEND	NEW SIGNS		EXISTING SIGNS				EXIST POST		NUMBER OF NEW POSTS	SQUARE STEEL (IN)			TUBULAR STEEL Ø (IN)				SIGN FRAME REQUIRED	REMARKS	SIGN DETAIL			
								"A"	"B"	RETAIN	SALVAGE FROM	SALVAGE TO	REMOVE	RETAIN	REMOVE		1.75	2.00	2.50	FOUNDATION	3.00	3.50	4.00			5.00	DETAIL IN SHS	DETAIL ON SHEET NUMBER	DETAIL ON STD SHEET NUMBER
																	(LB / FT)				(LB / FT)								
PLYMOUTH VT 100							FY-FLUORESCENT YELLOW FYG-FLUORESCENT YELLOW GREEN															"SHS"-STANDARD HIGHWAY SIGNS							
NB	1.948	C	VR-017	24	30																			SCOUT CAMP RD (TH-42)					
		C	VR-017	24	30			5.00																		E-141			
NB	1.956	D	R1-1	30	30																			SCOUT CAMP RD (TH-42)					
		D	R1-1	30	30			6.25															X						
NB	1.975	A	M3-1	24	12																			GREEN ON WHITE SHEETING	X				
		A	M1-5	30	24			5.00																INSTALL 100 FT± NORTH OF SCOUT CAMP RD (TH-42)			E-136B		
NB	2.045	A	W2-2L	30	30																								
		A	W2-2Ma	30	30			6.25																BEHIND RAIL		6			
NB	2.634	C	VR-017	24	30																			BILLINGS RD (TH-37)					
		C	VR-017	24	30			5.00																		E-141			
NB	2.642	D	R1-1	30	30		STOP			1														BILLINGS RD (TH-37)					
NB	2.685	A	W1-10L	30	30		CURVE LEFT w/ SIDE ROAD LEFT																						
																													
NB	2.715	A	W1-2Mb L	30	30			6.25																INSTALL 160 FT± NORTH OF PREVIOUS POSITION		6			
NB	2.842	A	VW-000	30	30																								
		A	W7-3A	24	18																								
SIGN SUMMARY SHEET							SHEET TOTALS	35.75	0.00	1	0	0	7	0	0	6	90					PROJECT NAME: Ludlow-Waitsfield VT110							
								SF	SF	EA	EA	EA	EA	EA	EA	EA	FT					PROJECT NUMBER: STPG SIGN(27)							
VERMONT AGENCY OF TRANSPORTATION							TOWN TOTALS	668.4	0.0	31.0	4.0	4.0	135	0.0	0.0	111	1665.0					FILE NAME: Plymouth.xls	PLOT DATE: 9/8/2009						
																						PROJECT MANAGER: N. Avery	DRAWN BY: I. Shea						
																						DESIGNED BY: M. Miller	CHECKED BY: N. Avery						
																						PLYMOUTH SHEET 3	SHEET 30	OF 204					







*SEE FIELD NOTES:
NO PAY. NOT THERE.
THE SIGNS WERE NOT
IN PLACE. NO PAYMENT
WAS MADE.


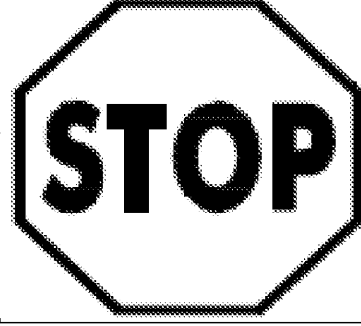

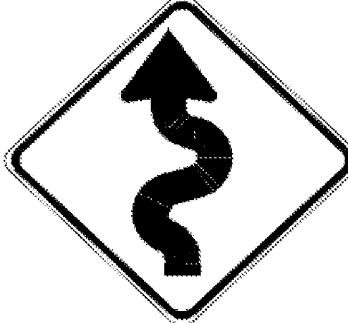




DIRECTION	MILEPOINT	LOCATION CODE (SHEET 2)	SIGN CODE	WIDTH (IN)	HEIGHT (IN)	SHEETING REMARKS	SIGN LEGEND	NEW SIGNS		EXISTING SIGNS				EXIST POST		NUMBER OF NEW POSTS	SQUARE STEEL (IN)			TUBULAR STEEL Ø (IN)				SIGN FRAME REQUIRED	REMARKS	SIGN DETAIL		
								"A"	"B"	RETAIN	SALVAGE FROM	SALVAGE TO	REMOVE	RETAIN	REMOVE		1.75	2.00	2.50	3.00	3.50	4.00	5.00			DETAIL IN SHS	DETAIL ON SHEET NUMBER	DETAIL ON STD SHEET NUMBER
																	(LB / FT)			(LB / FT)								
PLYMOUTH VT 100							FY-FLUORESCENT YE/ FYG-FLUORESCENT Y																"SHS"-STANDARD HIGHWAY SIGNS					
		A	VW-000	30	30			6.25							1	X								INSTALL BEHIND RAIL 30 FT± IN ADVANCE OF THE BRIDGE #106 BRIDGE PLAQUE			E-153	
		A	W7-3A	24	18			3.00																X				
NB	3.081	A	VW-054R	30	30		HIDDEN DRIVE RIGHT						1		X													
		A	W1-10L	30	30		REVERSE CURVE LEFT w/ MINOR SIDE ROAD LEFT						1															
		A	W13-1	18	18		40 MPH (PLAQUE)						1															
NB	3.133	A	W1-2Mb L	30	30			6.25							1	X								INSTALL 275 FT± NORTH OF ASSEMBLY THAT WAS JUST REMOVED		6		
NB	4.087	A	VW-054A	30	30		HIDDEN DRIVES RIGHT						1		X													
NB	4.155	A	VW-133R	30	30			6.25							1	X								INSTALL 360 FT± NORTH OF PREVIOUS POSITION			E-154	
NB	4.862	A	W3-5	36	36								1		X													
		A	W3-5	36	36			9.00							2	X								X				
NB	4.901	A	VD-062AL	72	16		BUSINESS SIGN			1						X												
		A	VD-062BRN	72	16		BUSINESS SIGN			1																		
		A	VD-062BRN	72	16		BUSINESS SIGN			1																		
NB	4.953	A	VD-018	30	18			3.75					1		X												E-128B	
		A	VD-018	30	18											X												
SIGN SUMMARY SHEET							SHEET TOTALS	34.50	0.00	3	0	0	6	0	0	6	90											
								SF	SF	EA	EA	EA	EA	EA	EA	EA	FT											
VERMONT AGENCY OF TRANSPORTATION							TOWN TOTALS	668.4	0.0	31.0	4.0	4.0	135	0.0	0.0	111	1665.0											
																					PROJECT NAME:	Ludlow-Waitsfield VT110						
																					PROJECT NUMBER:	STPG SIGN(27)						
												FILE NAME:	Plymouth.xls				PLOT DATE:	9/8/2009										
												PROJECT MANAGER:	N. Avery				DRAWN BY:	I. Shea										
												DESIGNED BY:	M. Miller				CHECKED BY:	N. Avery										
												PLYMOUTH SHEET 4					SHEET	31		OF	204							




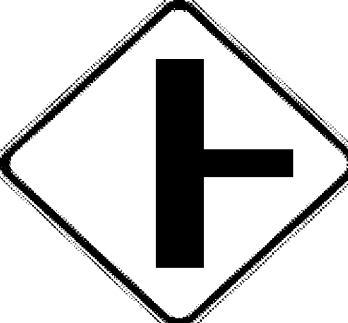



DIRECTION	MILEPOINT	LOCATION CODE (SHEET 2)	SIGN CODE	WIDTH (IN)	HEIGHT (IN)	SHEETING REMARKS	SIGN LEGEND	NEW SIGNS		EXISTING SIGNS				EXIST POST		NUMBER OF NEW POSTS	SQUARE STEEL (IN)			TUBULAR STEEL Ø (IN)				SIGN FRAME REQUIRED	REMARKS	SIGN DETAIL		
								"A"	"B"	RETAIN	SALVAGE FROM	SALVAGE TO	REMOVE	RETAIN	REMOVE		1.75	2.00	2.50	3.00	3.50	4.00	5.00			DETAIL IN SHS	DETAIL ON SHEET NUMBER	DETAIL ON STD SHEET NUMBER
																	(LB / FT)			(LB / FT)								
PLYMOUTH VT 100							FY-FLUORESCENT YELLOW FYG-FLUORESCENT YELLOW GREEN																"SHS"-STANDARD HIGHWAY SIGNS					
NB	5.000	A	R2-1	24	30							1		X														
		A	R2-1	30	36			7.50							1		X								6			
NB	5.132	A	M2-1	21	15		JCT					1		X														
		A	M1-5	30	24		VERMONT 100A					1																
		A	M2-1	21	15			2.19							1		X							X				
		A	M1-5	30	24			5.00																		E-136B		
NB	5.190	A	W2-2R	30	30		SIDE ROAD RIGHT					1		X														
		A	W13-1	18	18		20 MPH (PLAQUE)					1																
		A	W2-2R	30	30			6.25							1		X							X				
		A	W16-8	24	8			1.33																X				
NB	5.220	A	D1-1A	72	10							1		X														
		A	D1-1A	72	10							1																
		A	D1-1A	72	10							1																
		A	D1-1A	72	12			6.00							2		X								5			
		A	D1-1A	72	12			6.00																	5			
SIGN SUMMARY SHEET							SHEET TOTALS	34.27	0.00	0	0	0	8	0	0	5	75						PROJECT NAME: Ludlow-Waitsfield VT110 PROJECT NUMBER: STPG SIGN(27)					
VERMONT AGENCY OF TRANSPORTATION							TOWN TOTALS	668.4	0.0	31.0	4.0	4.0	135	0.0	0.0	111	1665.0						FILE NAME: Plymouth.xls PLOT DATE: 9/8/2009 PROJECT MANAGER: N. Avery DRAWN BY: I. Shea DESIGNED BY: M. Miller CHECKED BY: N. Avery PLYMOUTH SHEET 5 SHEET 32 OF 204					



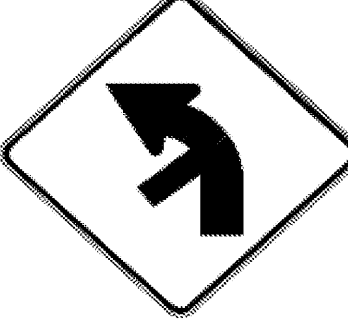


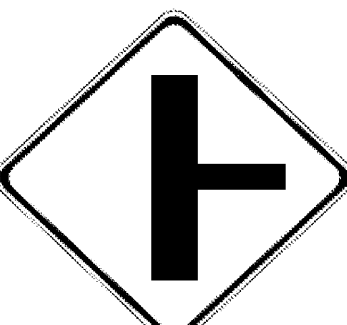


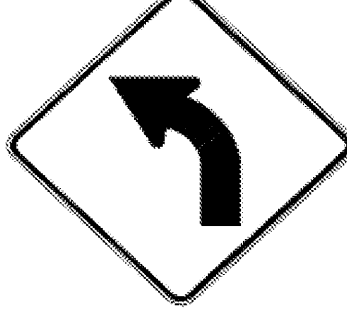


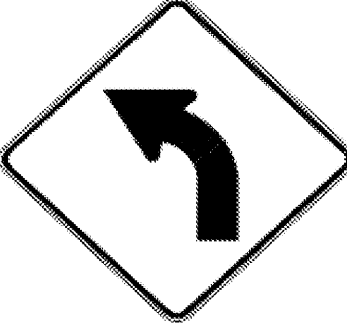
DIRECTION	MILEPOINT	LOCATION CODE (SHEET 2)	SIGN CODE	WIDTH (IN)	HEIGHT (IN)	SHEETING REMARKS	SIGN LEGEND	NEW SIGNS		EXISTING SIGNS				EXIST POST		NUMBER OF NEW POSTS	SQUARE STEEL (IN) (LB / FT)			TUBULAR STEEL Ø (IN) (LB / FT)				SIGN FRAME REQUIRED	REMARKS	SIGN DETAIL						
								"A"	"B"	RETAIN	SALVAGE FROM	SALVAGE TO	REMOVE	RETAIN	REMOVE		1.75	2.00	2.50	FOUNDATION	3.00	3.50	4.00			5.00	DETAIL IN SHS	DETAIL ON SHEET NUMBER	DETAIL ON STD SHEET NUMBER			
																														1.88	2.42	3.35
PLYMOUTH VT 100							FY-FLUORESCENT YELLOW FYG-FLUORESCENT YELLOW GREEN															"SHS"-STANDARD HIGHWAY SIGNS										
		A	D1-1A	72	12			6.00																					5			
NB	5.268	A	M3-1	24	12																											
		A	M1-5	30	24																											
		A	M6-3	21	15																											
		A	M3-1	24	12																											
		A	M1-5	30	24																											
		A	M6-1	21	15																											
		A	M3-1	24	12			2.00							2	X					#2B	GREEN ON WHITE SHEETING	X									
		A	M1-5	30	24			5.00																							E-136B	
		A	M6-3	21	15			2.19														GREEN ON WHITE SHEETING	X									
		A	M3-1	24	12			2.00														GREEN ON WHITE SHEETING	X									
		A	M1-5	30	24			5.00																							E-136B	
		A	M6-1R	21	15			2.19														GREEN ON WHITE SHEETING	X									
NB	5.309	D	R1-1	30	30																											
		D	R1-1	36	36			9.00							2	X																
SIGN SUMMARY SHEET							SHEET TOTALS	33.38	0.00	0	0	0	7	0	0	4	60							PROJECT NAME: Ludlow-Waitsfield VT110								
								SF	SF	EA	EA	EA	EA	EA	EA	EA	FT						PROJECT NUMBER: STPG SIGN(27)									
VERMONT AGENCY OF TRANSPORTATION							TOWN TOTALS	668.4	0.0	31.0	4.0	4.0	135	0.0	0.0	111	1665.0						FILE NAME: Plymouth.xls	PLOT DATE: 9/8/2009								
																						PROJECT MANAGER: N. Avery	DRAWN BY: I. Shea									
																						DESIGNED BY: M. Miller	CHECKED BY: N. Avery									
																						PLYMOUTH SHEET 6	SHEET 33 OF 204									



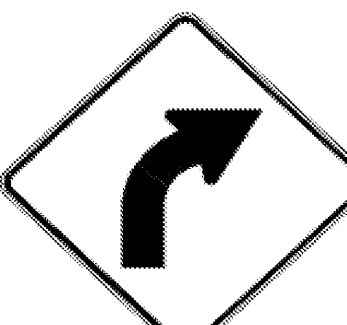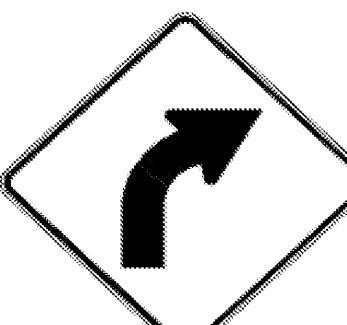


DIRECTION	MILEPOINT	LOCATION CODE (SHEET 2)	SIGN CODE	WIDTH (IN)	HEIGHT (IN)	SHEETING REMARKS	SIGN LEGEND	NEW SIGNS		EXISTING SIGNS				EXIST POST		NUMBER OF NEW POSTS	SQUARE STEEL (IN)			TUBULAR STEEL Ø (IN)				SIGN FRAME REQUIRED	REMARKS	SIGN DETAIL		
								"A"	"B"	RETAIN	SALVAGE FROM	SALVAGE TO	REMOVE	RETAIN	REMOVE		1.75	2.00	2.50	3.00	3.50	4.00	5.00			DETAIL IN SHS	DETAIL ON SHEET NUMBER	DETAIL ON STD SHEET NUMBER
																	(LB / FT)			(LB / FT)								
PLYMOUTH VT 100							FY-FLUORESCENT YELLOW FYG-FLUORESCENT YELLOW GREEN																"SHS"-STANDARD HIGHWAY SIGNS					
NB	5.324	A	M3-1	24	12		NORTH																					
		A	M1-5	30	24		VERMONT 100																					
NB	5.336	A	D2-1	72	12			6.00																		5		
		A	M3-1	24	12			2.00																	X			
		A	M1-5	30	24			5.00																		E-136B		
NB	5.365	A	D2-1	72	10		W. BRIDGEWATER 5																					
NB	5.390	A	R2-1	24	30																							
		A	R2-1	24	30			5.00																	X			
NB	5.467	A	W11-1	30	30																							
		A	W16-1	18	24																							
		A	W11-1	30	30			6.25																	X			
		A	W16-1	18	24			3.00																	X			
NB	5.526	A	W11-8	30	30																							
		A	W11-8	30	30			6.25																	X			
NB	5.580	A	W11-6H	30	30		SNOWMOBILE SYMBOL (HINGED)																					
SIGN SUMMARY SHEET							SHEET TOTALS		33.50	0.00	0	0	0	8	0	0	5	75						PROJECT NAME: Ludlow-Waitsfield VT110				
							SF	SF	EA	EA	EA	EA	EA	EA	EA	EA	EA	FT						PROJECT NUMBER: STPG SIGN(27)				
VERMONT AGENCY OF TRANSPORTATION							TOWN TOTALS		668.4	0.0	31.0	4.0	4.0	135	0.0	0.0	111	1665.0						FILE NAME: Plymouth.xls				
																								PLOT DATE: 9/8/2009				
																								DRAWN BY: I. Shea				
																								DESIGNED BY: M. Miller				
																								CHECKED BY: N. Avery				
																								SHEET 34 OF 204				


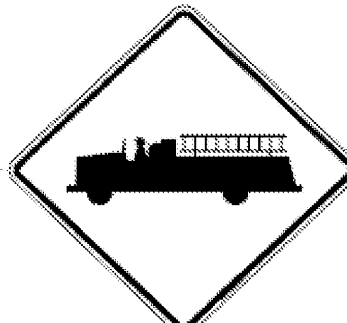


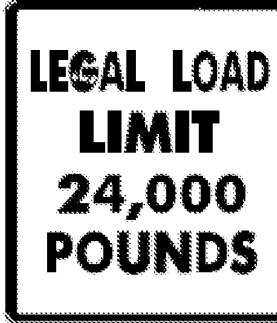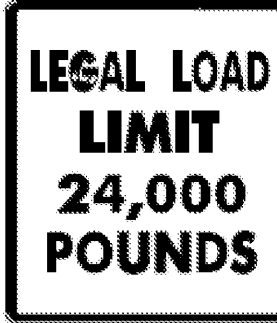DIRECTION	MILEPOINT	LOCATION CODE (SHEET 2)	SIGN CODE	WIDTH (IN)	HEIGHT (IN)	SHEETING REMARKS	SIGN LEGEND	NEW SIGNS		EXISTING SIGNS				EXIST POST		NUMBER OF NEW POSTS	SQUARE STEEL (IN)			TUBULAR STEEL Ø (IN)				SIGN FRAME REQUIRED	REMARKS	SIGN DETAIL			
								"A"	"B"	RETAIN	SALVAGE FROM	SALVAGE TO	REMOVE	RETAIN	REMOVE		(LB / FT)			(LB / FT)						DETAIL IN SHS	DETAIL ON SHEET NUMBER	DETAIL ON STD SHEET NUMBER	
																	1.75	2.00	2.50	3.00	3.50	4.00	5.00						
PLYMOUTH VT 100							FY-FLUORESCENT YELLOW FYG-FLUORESCENT YELLOW GREEN																"SHS"-STANDARD HIGHWAY SIGNS						
			A W16-2	24	18		1500 FT (PLAQUE) 																						
			A W11-6H	30	30			6.25										X									E-153		
NB	5.617		A R2-1	24	30		SPEED LIMIT 35			1																			
NB	5.655		A S1-1YG	30	30		PENTAGONAL SCHOOL SYMBOL			1																			
			A W16-9YG	24	12		AHEAD (PLAQUE)			1																			
NB	5.770		A D1-1E	54	7.5		<--- PLYMOUTH SCHOOL			1																			
NB	5.818		A R2-1	24	30																								
			A R2-1	24	30			5.00										X							X				
NB	5.890		C VR-017	24	30																								
			C VR-017	24	30			5.00										X									E-141		
NB	5.896		D R1-1	30	30																								
			D R1-1	30	30			6.25										X							X				
NB	5.943		A W2-2MaR	30	30			6.25										X										INSTALL 250 FT± NORTH OF RICKS RD (TH-12)	
			A W16-8	24	8			1.33																				6	
																												8	
NB	5.990		A R2-1	24	30		SPEED LIMIT 50																						
SIGN SUMMARY SHEET							SHEET TOTALS	30.08	0.00	4	0	0	5	0	0	5		75											
								SF	SF	EA	EA	EA	EA	EA	EA	EA		FT											
VERMONT AGENCY OF TRANSPORTATION							TOWN TOTALS	668.4	0.0	31.0	4.0	4.0	135	0.0	0.0	111		1665.0											
																			PROJECT NAME:	Ludlow-Waitsfield VT110									
																			PROJECT NUMBER:	STPG SIGN(27)									
																			FILE NAME:	Plymouth.xls									
																			PROJECT MANAGER:	N. Avery									
																			DESIGNED BY:	M. Miller									
																			PLYMOUTH SHEET	8									
																			PLOT DATE:	9/8/2009									
																			DRAWN BY:	I. Shea									
																			CHECKED BY:	N. Avery									
																			SHEET	35 OF 204									




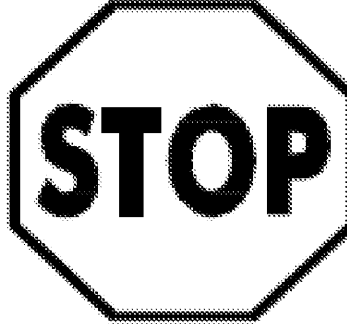

DIRECTION	MILEPOINT	LOCATION CODE (SHEET 2)	SIGN CODE	WIDTH (IN)	HEIGHT (IN)	SHEETING REMARKS	SIGN LEGEND	NEW SIGNS		EXISTING SIGNS				EXIST POST		NUMBER OF NEW POSTS	SQUARE STEEL (IN)			TUBULAR STEEL Ø (IN)				SIGN FRAME REQUIRED	REMARKS	SIGN DETAIL		
								"A"	"B"	RETAIN	SALVAGE FROM	SALVAGE TO	REMOVE	RETAIN	REMOVE		(LB / FT)			(LB / FT)						DETAIL IN SHS	DETAIL ON SHEET NUMBER	DETAIL ON STD SHEET NUMBER
																	1.75	2.00	2.50	3.00	3.50	4.00	5.00					
PLYMOUTH VT 100							FY-FLUORESCENT YELLOW FYG-FLUORESCENT YELLOW GREEN															"SHS"-STANDARD HIGHWAY SIGNS						
NB	5.998	C	VR-017	24	30							1		X									RICKS RD (TH-12)					
		C	VR-017	24	30			5.00								1	X								E-141			
NB	6.004	D	R1-1	30	30							1		X									RICKS RD (TH-12)					
		D	R1-1	30	30			6.25							1	X							REINSTALL THE STREET NAME SIGN ON TOP OF THE NEW STOP SIGN POST	X				
NB	6.016	A	R2-1	24	30			5.00							1	X							INSTALL 65 FT± NORTH OF RICKS RD (TH-12)	X				
NB	6.128	A	W1-5L	30	30		WINDING CURVES LEFT (SYMBOL) 					1		X														
NB	6.250	A	W1-5L	30	30			6.25							1	X							INSTALL 645 FT± NORTH OF PREVIOUS POSITION, BEHIND RAIL.	X				
		A	W7-3A	24	18			3.00																X				
NB	6.796	A	W11-6	30	30							1		X									BEHIND RAIL					
		A	W11-6	30	30			6.25							1	X							HINGED SIGN; INSTALL IN CLOSED POSITION			E-153		
NB	7.062	A	W1-5L	30	30		WINDING CURVES LEFT 					1		X									BEHIND RAIL					
NB	7.297	A	W1-2Mb L	30	30			6.25							1	X							INSTALL 265 FT± SOUTH OF THE "WATCH FOR TURNING VEHICLES" SIGN		6			
NB	7.363	A	VW-205	30	30		WATCH FOR TURNING VEHICLES					1		X														
NB	7.520	A	VW-285	30	30							1		X									REMOVE ATTACHED FLAGS					
		A	VW-285	30	30			6.25							1	X									6			
SIGN SUMMARY SHEET							SHEET TOTALS	44.25	0.00	0	0	0	7	0	0	7	105						PROJECT NAME: Ludlow-Waitsfield VT110					
VERMONT AGENCY OF TRANSPORTATION								SF	SF	EA	EA	EA	EA	EA	EA	EA	FT						PROJECT NUMBER: STPG SIGN(27)					
							TOWN TOTALS	668.4	0.0	31.0	4.0	4.0	135	0.0	0.0	111	1665.0						FILE NAME: Plymouth.xls	PLOT DATE: 9/8/2009				
																						PROJECT MANAGER: N. Avery	DRAWN BY: I. Shea					
																						DESIGNED BY: M. Miller	CHECKED BY: N. Avery					
																						PLYMOUTH SHEET 9	SHEET 36	OF 204				






DIRECTION	MILEPOINT	LOCATION CODE (SHEET 2)	SIGN CODE	WIDTH (IN)	HEIGHT (IN)	SHEETING REMARKS	SIGN LEGEND	NEW SIGNS		EXISTING SIGNS				EXIST POST		NUMBER OF NEW POSTS	SQUARE STEEL (IN)			TUBULAR STEEL Ø (IN)				SIGN FRAME REQUIRED	REMARKS	SIGN DETAIL		
								"A"	"B"	RETAIN	SALVAGE FROM	SALVAGE TO	REMOVE	RETAIN	REMOVE		1.75	2.00	2.50	3.00	3.50	4.00	5.00			DETAIL IN SHS	DETAIL ON SHEET NUMBER	DETAIL ON STD SHEET NUMBER
																	(LB / FT)			(LB / FT)								
																1.88	2.42	3.35	FOUNDATION	7.60	9.00	10.80	14.60					
PLYMOUTH VT 100							FY-FLUORESCENT YELLOW FYG-FLUORESCENT YELLOW GREEN																"SHS"-STANDARD HIGHWAY SIGNS					
NB	7.575	A	W2-2R	30	30																							
		A	W2-2MaR	30	30			6.25																			6	
NB	7.648	C	VR-017	24	30																							
		C	VR-017	24	30			5.00																				
NB	7.656	D	R1-1	30	30																							
		D	R1-1	30	30			6.25																				
NB	7.748	A	W1-2L	30	30																							
		A	W1-2L	30	30			6.25																				
NB	8.760	C	VR-017	24	30																							
		C	VR-017	24	30			5.00																				
NB	8.768	D	R1-1	30	30																							
		D	R1-1	30	30			6.25																				
NB	8.894	A	W1-5L	30	30		WINDING CURVES LEFT																					
NB	9.070	A	VW-081	30	30		TRUCKS ENTERING RIGHT 																					
		A	W1-2L	30	30			6.25																				
SIGN SUMMARY SHEET							SHEET TOTALS	41.25	0.00	0	0	0	8	0	0	7	105							PROJECT NAME: Ludlow-Waitsfield VT110				
								SF	SF	EA	EA	EA	EA	EA	EA	EA	FT						PROJECT NUMBER: STPG SIGN(27)					
VERMONT AGENCY OF TRANSPORTATION							TOWN TOTALS	668.4	0.0	31.0	4.0	4.0	135	0.0	0.0	111	1665.0						FILE NAME: Plymouth.xls	PLOT DATE: 9/8/2009				
																						PROJECT MANAGER: N. Avery	DRAWN BY: I. Shea					
																						DESIGNED BY: M. Miller	CHECKED BY: N. Avery					
																						PLYMOUTH SHEET 10	SHEET 37	OF 204				




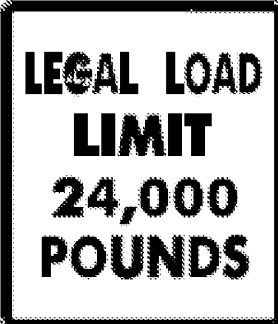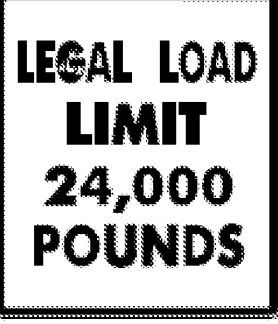


DIRECTION	MILEPOINT	LOCATION CODE (SHEET 2)	SIGN CODE	WIDTH (IN)	HEIGHT (IN)	SHEETING REMARKS	SIGN LEGEND	NEW SIGNS		EXISTING SIGNS				EXIST POST		NUMBER OF NEW POSTS	SQUARE STEEL (IN)			TUBULAR STEEL Ø (IN)				SIGN FRAME REQUIRED	REMARKS	SIGN DETAIL		
								"A"	"B"	RETAIN	SALVAGE FROM	SALVAGE TO	REMOVE	RETAIN	REMOVE		1.75	2.00	2.50	3.00	3.50	4.00	5.00			DETAIL IN SHS	DETAIL ON SHEET NUMBER	DETAIL ON STD SHEET NUMBER
																	(LB / FT)			(LB / FT)								
PLYMOUTH VT 100							FY-FLUORESCENT YELLOW FYG-FLUORESCENT YELLOW GREEN															"SHS"-STANDARD HIGHWAY SIGNS						
NB	9.130	A	VW-081	30	30			6.25															INSTALL 315 FT± NORTH OF NEW CURVE LEFT SIGN		7			
SB	9.464	F	W1-5L	30	30		WINDING CURVES LEFT																					
SB	9.405	F	VW-084	30	30		TRUCKS ENTERING LEFT																					
		F	W1-5L	36	36	FY	 	9.00																X				
SB	9.367	F	VW-084	30	30			6.25															INSTALL 200 FT± SOUTH OF THE NEW WINDING CURVES LEFT SIGN		7			
SB	8.400	F	W1-5R	30	30		WINDING CURVES RIGHT																					
SB	7.954	F	W1-2R	30	30																							
		F	W1-2R	30	30			6.25																X				
SB	7.736	F	VW-285	30	30																		REMOVE ATTACHED FLAGS					
		F	VW-285	30	30			6.25																	6			
SB	7.513	F	VR-020	24	30																		RED TEXT AND BORDER ON WHITE BACKGROUND		6			
		F	VR-020	24	30			5.00																				
SB	7.496	G	VR-017	24	30																		SHREWSBURY RD (STATE FOREST HWY)					
		G	VR-017	24	30			5.00																		E-141		
SB	7.488	H	R1-1	30	30																		SHREWSBURY RD (STATE FOREST HWY)					
SIGN SUMMARY SHEET							SHEET TOTALS	44.00	0.00	0	0	0	8	0	0	8	120							PROJECT NAME: Ludlow-Waitsfield VT110				
								SF	SF	EA	EA	EA	EA	EA	EA	EA	FT						PROJECT NUMBER: STPG SIGN(27)					
VERMONT AGENCY OF TRANSPORTATION							TOWN TOTALS	668.4	0.0	31.0	4.0	4.0	135	0.0	0.0	111	1665.0						FILE NAME: Plymouth.xls	PLOT DATE: 9/8/2009				
																						PROJECT MANAGER: N. Avery	DRAWN BY: I. Shea					
																						DESIGNED BY: M. Miller	CHECKED BY: N. Avery					
																						PLYMOUTH SHEET 11	SHEET 38 OF 204					

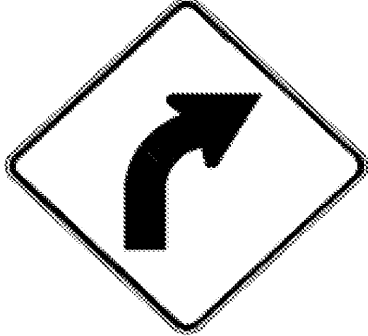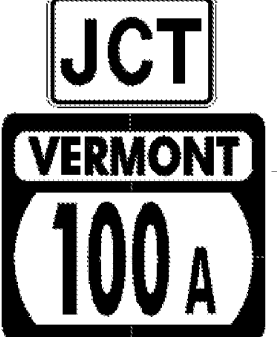

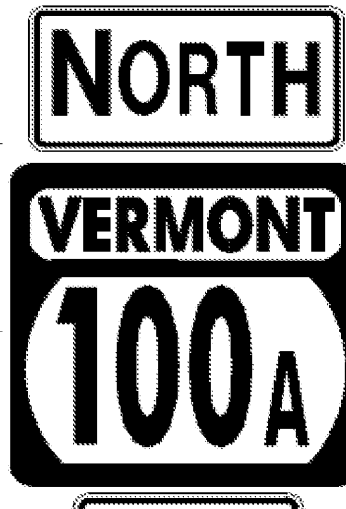

DIRECTION	MILEPOINT	LOCATION CODE (SHEET 2)	SIGN CODE	WIDTH (IN)	HEIGHT (IN)	SHEETING REMARKS	SIGN LEGEND	NEW SIGNS		EXISTING SIGNS				EXIST POST		NUMBER OF NEW POSTS	SQUARE STEEL (IN)			TUBULAR STEEL Ø (IN)				SIGN FRAME REQUIRED	REMARKS	SIGN DETAIL		
								"A"	"B"	RETAIN	SALVAGE FROM	SALVAGE TO	REMOVE	RETAIN	REMOVE		1.75	2.00	2.50	3.00	3.50	4.00	5.00			DETAIL IN SHS	DETAIL ON SHEET NUMBER	DETAIL ON STD SHEET NUMBER
																	(LB / FT)			(LB / FT)								
PLYMOUTH VT 100							FY-FLUORESCENT YELLOW FYG-FLUORESCENT YELLOW GREEN															"SHS"-STANDARD HIGHWAY SIGNS						
			H R1-1	30	30			6.25							1	X								X				
SB	7.460		F VR-020	24	30								1		X													
			F VR-020	24	30			5.00						1	X										6			
SB	7.030		F W11-6	30	30								1		X													
			F W11-6	30	30			6.25						1	X										E-153			
SB	6.800		F W1-5L	30	30		WINDING CURVES LEFT						1		X													
SB	6.376		G VM-607	24	30		43RD INF DIV MEMORIA HWY			1					X													
SB	6.374		G VR-023B	24	36		\$500 FINE FOR THROWING TRASH ON HIGHWAYS AND STREAMS			1					X													
SB	6.344		F W1-2R	30	30	FY	CURVE RIGHT			1					X													
			F W13-1	21	21	FY	40 MPH PLAQUE			1																		
SB	6.130		F W3-5	36	36		SPEED REDUCTION AHEAD 35 MPH			1					X													
SB	6.080		F VW-054	30	30		HIDDEN DRIVE RIGHT						1		X													
			F VD-018	30	18			3.75						1	X										INSTALL IN FORMER POSITION OF HIDDEN DRIVE RIGHT SIGN	E-128B		
SB	6.045		F VD-018	30	18		PLYMOUTH UNION TYSON 6						1		X													
			F VW-133R	30	30	FY		6.25						1	X													
SIGN SUMMARY SHEET							SHEET TOTALS	27.50	0.00	5	0	0	5	0	0	5	75											
VERMONT AGENCY OF TRANSPORTATION								SF	SF	EA	EA	EA	EA	EA	EA	EA	FT											
							TOWN TOTALS	668.4	0.0	31.0	4.0	4.0	135	0.0	0.0	111	1665.0											
															PROJECT NAME:	Ludlow-Waitsfield VT110												
															PROJECT NUMBER:	STPG SIGN(27)												
															FILE NAME:	Plymouth.xls				PLOT DATE:	9/8/2009							
															PROJECT MANAGER:	N. Avery				DRAWN BY:	I. Shea							
															DESIGNED BY:	M. Miller				CHECKED BY:	N. Avery							
															PLYMOUTH SHEET 12					SHEET	39		OF	204				


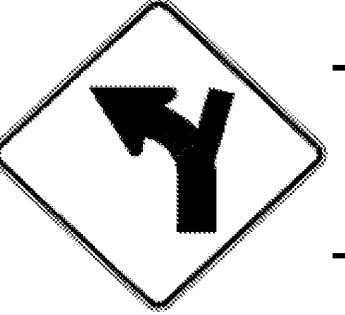
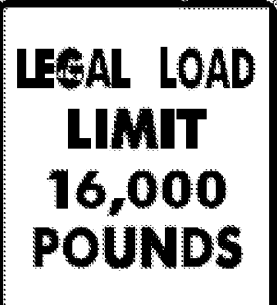

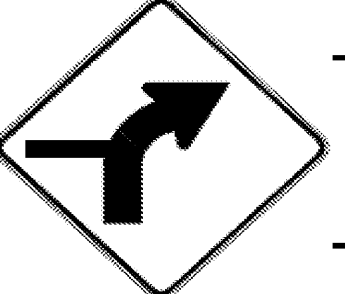
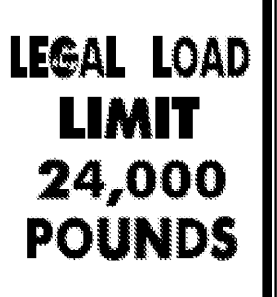
DIRECTION	MILEPOINT	LOCATION CODE (SHEET 2)	SIGN CODE	WIDTH (IN)	HEIGHT (IN)	SHEETING REMARKS	SIGN LEGEND	NEW SIGNS		EXISTING SIGNS				EXIST POST		NUMBER OF NEW POSTS	SQUARE STEEL (IN)			TUBULAR STEEL Ø (IN)				SIGN FRAME REQUIRED	REMARKS	SIGN DETAIL		
								"A"	"B"	RETAIN	SALVAGE FROM	SALVAGE TO	REMOVE	RETAIN	REMOVE		1.75	2.00	2.50	3.00	3.50	4.00	5.00			DETAIL IN SHS	DETAIL ON SHEET NUMBER	DETAIL ON STD SHEET NUMBER
																	(LB / FT)			(LB / FT)								
PLYMOUTH VT 100							FY-FLUORESCENT YELLOW FYG-FLUORESCENT YELLOW GREEN															"SHS"-STANDARD HIGHWAY SIGNS						
SB	5.993	F	R2-1	24	30																							
		F	R2-1	30	36			7.50																	6			
SB	5.960	F	W11-6H	30	30		HINGED SNOWMOBILE SIGN																					
		F	W16-2	24	18		1500 FT (PLAQUE)																					
SB	5.927	F	S1-1YG	30	30		PENTAGONAL SCHOOL SYMBOL			1																		
		F	W16-9YG	24	12		AHEAD PLAQUE			1																		
SB	5.870	F	W11-8	30	30																							
		F	W11-8	30	30			6.25															X					
SB	5.841	F	R2-1	24	30		SPEED LIMIT 35				1	1																
SB	5.806	G	VR-017	24	30																							
		G	VR-017	24	30			5.00																	E-141			
SB	5.801	H	R1-1	30	30																							
		H	R1-1	30	30			6.25																X				
SB	5.800	G	VR-017	24	30																							
SIGN SUMMARY SHEET							SHEET TOTALS	25.00	0.00	2	1	1	7	0	0	5	75					PROJECT NAME: Ludlow-Waitsfield VT110						
								SF	SF	EA	EA	EA	EA	EA	EA	EA	FT					PROJECT NUMBER: STPG SIGN(27)						
VERMONT AGENCY OF TRANSPORTATION							TOWN TOTALS	668.4	0.0	31.0	4.0	4.0	135	0.0	0.0	111	1665.0					FILE NAME: Plymouth.xls	PLOT DATE: 9/8/2009					
																						PROJECT MANAGER: N. Avery	DRAWN BY: I. Shea					
																						DESIGNED BY: M. Miller	CHECKED BY: N. Avery					
																						PLYMOUTH SHEET 13	SHEET 40 OF 204					


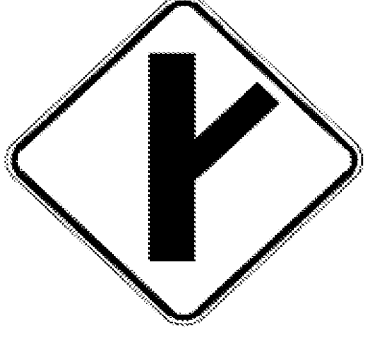



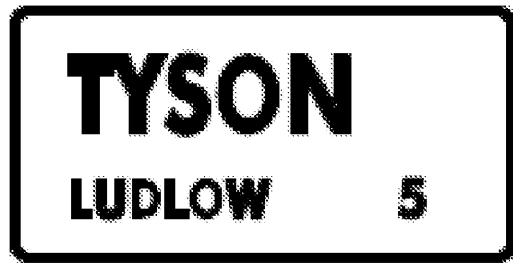
DIRECTION	MILEPOINT	LOCATION CODE (SHEET 2)	SIGN CODE	WIDTH (IN)	HEIGHT (IN)	SHEETING REMARKS	SIGN LEGEND	NEW SIGNS		EXISTING SIGNS				EXIST POST		NUMBER OF NEW POSTS	SQUARE STEEL (IN)			TUBULAR STEEL Ø (IN)				SIGN FRAME REQUIRED	REMARKS	SIGN DETAIL				
								"A"	"B"	RETAIN	SALVAGE FROM	SALVAGE TO	REMOVE	RETAIN	REMOVE		1.75	2.00	2.50	3.00	3.50	4.00	5.00			DETAIL IN SHS	DETAIL ON SHEET NUMBER	DETAIL ON STD SHEET NUMBER		
																	(LB / FT)			(LB / FT)										
PLYMOUTH VT 100							FY-FLUORESCENT YELLOW FYG-FLUORESCENT YELLOW GREEN																"SHS"-STANDARD HIGHWAY SIGNS							
			G VR-017	24	30			5.00								1		X										E-141		
SB	5.798		H R1-1	30	30		STOP			1																	SCHOOL DRIVE (TH-47) (NORTH SIDE OF LOOP)			
SB	5.791		F D1-1E	72	10		PLYMOUTH SCHOOL --->			1																				
SB	5.764		G VR-017	24	30								1					X									SCHOOL DRIVE (TH-47) (SOUTH SIDE OF LOOP)			
			G VR-017	24	30			5.00							1		X											E-141		
SB	5.758		H R1-1	30	30		STOP			1																	SCHOOL DRIVE (TH-47) (SOUTH SIDE OF LOOP)			
SB	5.730		G VR-017	24	30								1					X									TOWN OFFICE RD (TH-50)			
			G VR-017	24	30			5.00							1		X											E-141		
SB	5.730		H R1-1	30	30								1					X									TOWN OFFICE RD (TH-50)			
			H R1-1	30	30			6.25							1		X								X					
SB	5.665		F VD-062BRN	72	16		BUSINESS SIGN			1								X												
			F VD-062BRN	72	16		BUSINESS SIGN			1																				
SB	5.610		F R2-1	24	30									1				X												
			F R2-1	24	30			5.00							1		X								X					
SB	5.536		F W1-2R	30	30		CURVE RIGHT												1											
SIGN SUMMARY SHEET VERMONT AGENCY OF TRANSPORTATION							SHEET TOTALS		26.25	0.00	5	0	0	5	0	0	5		75							PROJECT NAME: Ludlow-Waitsfield VT110 PROJECT NUMBER: STPG SIGN(27)				
							SF	SF	EA	EA	EA	EA	EA	EA	EA		EA		FT									FILE NAME: Plymouth.xls PROJECT MANAGER: N. Avery DESIGNED BY: M. Miller PLYMOUTH SHEET 14	PLOT DATE: 9/8/2009 DRAWN BY: I. Shea CHECKED BY: N. Avery SHEET 41 OF 204	
							TOWN TOTALS		668.4	0.0	31.0	4.0	4.0	135	0.0	0.0	111		1665.0											







DIRECTION	MILEPOINT	LOCATION CODE (SHEET 2)	SIGN CODE	WIDTH (IN)	HEIGHT (IN)	SHEETING REMARKS	SIGN LEGEND	NEW SIGNS		EXISTING SIGNS				EXIST POST		NUMBER OF NEW POSTS	SQUARE STEEL (IN)			TUBULAR STEEL Ø (IN)				SIGN FRAME REQUIRED	REMARKS	SIGN DETAIL		
								"A"	"B"	RETAIN	SALVAGE FROM	SALVAGE TO	REMOVE	RETAIN	REMOVE		1.75	2.00	2.50	3.00	3.50	4.00	5.00			DETAIL IN SHS	DETAIL ON SHEET NUMBER	DETAIL ON STD SHEET NUMBER
																	(LB / FT)			(LB / FT)								
PLYMOUTH VT 100							FY-FLUORESCENT YELLOW FYG-FLUORESCENT YELLOW GREEN															"SHS"-STANDARD HIGHWAY SIGNS						
SB	5.506	F	W1-2R	30	30			6.25							1	X							INSTALL 160 FT± SOUTH OF PREVIOUS LOCATION	X				
SB	5.475	F	M2-1	21	15		JCT																					
		F	M1-5	30	24		VERMONT 100A																					
SB	5.465	F	M2-1	21	15			2.19							1	X							INSTALL 50 FT± SOUTH OF PREVIOUS LOCATION; GREEN ON WHITE SHEETING	X				
		F	M1-5	30	24			5.00																		E-136B		
SB	5.424	F	D1-1A	72	10		UP LUDLOW 11																					
		F	D1-1A	72	10		<--- (45 DEG) PLYMOUTH 1																					
		F	D1-1A	72	10		<--- (45 DEG) BRIDGEWATER CORS 7																					
SB	5.414	F	D1-1A	72	12			6.00							2	X							INSTALL 50 FT± SOUTH OF PREVIOUS LOCATION		5			
		F	D1-1A	72	12			6.00																	5			
		F	D1-1A	72	12			6.00																	5			
SB	5.352	F	M3-1	24	12																							
		F	M1-5	30	24																							
		F	M6-1	21	15																							
		F	M3-3	24	12																							
SIGN SUMMARY SHEET							SHEET TOTALS	31.44	0.00	0	0	0	9	0	0	4	60							PROJECT NAME: Ludlow-Waitsfield VT110				
								SF	SF	EA	EA	EA	EA	EA	EA	EA	FT						PROJECT NUMBER: STPG SIGN(27)					
VERMONT AGENCY OF TRANSPORTATION							TOWN TOTALS	668.4	0.0	31.0	4.0	4.0	135	0.0	0.0	111	1665.0						FILE NAME: Plymouth.xls	PLOT DATE: 9/8/2009				
																						PROJECT MANAGER: N. Avery	DRAWN BY: I. Shea					
																						DESIGNED BY: M. Miller	CHECKED BY: N. Avery					
																						PLYMOUTH SHEET 15	SHEET 42 OF 204					


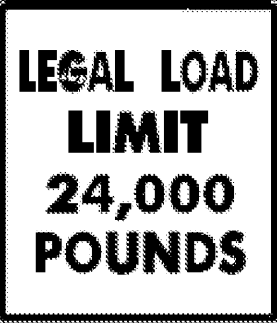

DIRECTION	MILEPOINT	LOCATION CODE (SHEET 2)	SIGN CODE	WIDTH (IN)	HEIGHT (IN)	SHEETING REMARKS	SIGN LEGEND	NEW SIGNS		EXISTING SIGNS				EXIST POST		NUMBER OF NEW POSTS	SQUARE STEEL (IN)			TUBULAR STEEL Ø (IN)				SIGN FRAME REQUIRED	REMARKS	SIGN DETAIL											
								"A"	"B"	RETAIN	SALVAGE FROM	SALVAGE TO	REMOVE	RETAIN	REMOVE		1.75	2.00	2.50	FOUNDATION	3.00	3.50	4.00			5.00	DETAIL IN SHS	DETAIL ON SHEET NUMBER	DETAIL ON STD SHEET NUMBER								
																	(LB / FT)				(LB / FT)																
PLYMOUTH VT 100							FY-FLUORESCENT YELLOW FYG-FLUORESCENT YELLOW GREEN																"SHS"-STANDARD HIGHWAY SIGNS														
			F M1-5	30	24																																
			F M6-3	21	15																																
			F M3-1	24	12			2.00							2	X					#2B		GREEN ON WHITE SHEETING	X													
			F M1-5	30	24			5.00																											E-136B		
			F M6-1	21	15			2.19															GREEN ON WHITE SHEETING	X													
			F M3-3	24	12			2.00																GREEN ON WHITE SHEETING	X												
			F M1-5	30	24			5.00																												E-136B	
			F M6-3	21	15			2.19																GREEN ON WHITE SHEETING	X												
SB	5.320	G	VR-017	24	30		LEGAL LOAD LIMIT 24,000 POUNDS																	DEAD END RD (TH-44)													
		H	R1-1	30	30		STOP																	THE LEFT-SIDE STOP SIGN FOR TH-44 WON'T BE REPLACED													
		G	VR-017	24	30			5.00							1	X																					E-141
SB	5.318	H	R1-1	30	30		STOP			1														DEAD END RD (TH-44)													
SB	5.275	F	M3-3	24	12																																
		F	M1-5	24	24																																
		F	D2-1	72	12			6.00							2	X								INSTALL DESTINATION SIGN ON TOP													
SIGN SUMMARY SHEET							SHEET TOTALS		29.38	0.00	1	0	0	6	0	0	5	75					PROJECT NAME: Ludlow-Waitsfield VT110														
									SF	SF	EA	EA	EA	EA	EA	EA	EA	EA	EA	EA	EA	EA	PROJECT NUMBER: STPG SIGN(27)														
																							FILE NAME: Plymouth.xls														
																							PLOT DATE: 9/8/2009														
																							DRAWN BY: I. Shea														
																							DESIGNED BY: M. Miller														
																							CHECKED BY: N. Avery														
																							PLYMOUTH SHEET 16														
																							SHEET 43 OF 204														
VERMONT AGENCY OF TRANSPORTATION							TOWN TOTALS		668.4	0.0	31.0	4.0	4.0	135	0.0	0.0	111	1665.0																			


DIRECTION	MILEPOINT	LOCATION CODE (SHEET 2)	SIGN CODE	WIDTH (IN)	HEIGHT (IN)	SHEETING REMARKS	SIGN LEGEND	NEW SIGNS		EXISTING SIGNS				EXIST POST		NUMBER OF NEW POSTS	SQUARE STEEL (IN)			TUBULAR STEEL Ø (IN)				SIGN FRAME REQUIRED	REMARKS	SIGN DETAIL		
								"A"	"B"	RETAIN	SALVAGE FROM	SALVAGE TO	REMOVE	RETAIN	REMOVE		1.75	2.00	2.50	3.00	3.50	4.00	5.00			DETAIL IN SHS	DETAIL ON SHEET NUMBER	DETAIL ON STD SHEET NUMBER
																	(LB / FT)			(LB / FT)								
PLYMOUTH VT 100							FY-FLUORESCENT YELLOW FYG-FLUORESCENT YELLOW GREEN															"SHS"-STANDARD HIGHWAY SIGNS						
			F M3-3	24	12			2.00																				
			F M1-5	30	24			5.00																	E-136B			
SB	5.233		F D2-1	72	10	LUDLOW 11						1																
			F R2-1	24	30			5.00						1		X								X				
SB	5.187		F R2-1	24	30	SPEED LIMIT 35						1																
SB	5.153		F W11-1	30	30							1																
			F W16-1	18	24							1																
			F W11-1	30	30			6.25						1		X								X				
			F W16-1	18	24			3.00																X				
SB	5.010		F R2-1	24	30							1													BEHIND RAIL			
			F R2-1	24	30			5.00						1		X								X				
SB	4.982		G VR-017	24	30	LEGAL LOAD LIMIT 16,000 POUNDS				1															PAILLE RD (TH-55); CLASS III ROAD SERVES ONE HOUSE; RETAIN SIGN			
SB	4.976		H R1-1	30	30	STOP						1													PAILLE RD (TH-55); STOP SIGN TO BE REMOVED			
SB	4.928		F VW-000	30	30	MOOSE CROSSING				1																		
			F W7-3A	24	18	NEXT 2 MILES (PLAQUE)				1																		
SIGN SUMMARY SHEET							SHEET TOTALS		26.25	0.00	3	0	0	6	0	0	3	45						PROJECT NAME: Ludlow-Waitsfield VT110				
							SF	SF	EA	EA	EA	EA	EA	EA	EA	EA	EA	FT						PROJECT NUMBER: STPG SIGN(27)				
VERMONT AGENCY OF TRANSPORTATION							TOWN TOTALS		668.4	0.0	31.0	4.0	4.0	135	0.0	0.0	111	1665.0						FILE NAME: Plymouth.xls				
																								PLOT DATE: 9/8/2009				
																								DRAWN BY: I. Shea				
																								DESIGNED BY: M. Miller				
																								CHECKED BY: N. Avery				
																								PLYMOUTH SHEET 17				
																								SHEET 44 OF 204				




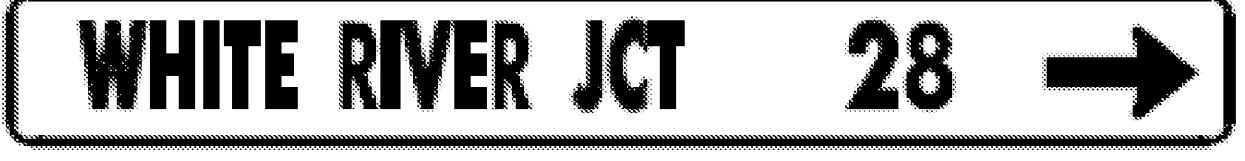
DIRECTION	MILEPOINT	LOCATION CODE (SHEET 2)	SIGN CODE	WIDTH (IN)	HEIGHT (IN)	SHEETING REMARKS	SIGN LEGEND	NEW SIGNS		EXISTING SIGNS				EXIST POST		NUMBER OF NEW POSTS	SQUARE STEEL (IN)			TUBULAR STEEL Ø (IN)				SIGN FRAME REQUIRED	REMARKS	SIGN DETAIL		
								"A"	"B"	RETAIN	SALVAGE FROM	SALVAGE TO	REMOVE	RETAIN	REMOVE		1.75	2.00	2.50	3.00	3.50	4.00	5.00			DETAIL IN SHS	DETAIL ON SHEET NUMBER	DETAIL ON STD SHEET NUMBER
																	(LB / FT)			(LB / FT)								
PLYMOUTH VT 100							FY-FLUORESCENT YELLOW FYG-FLUORESCENT YELLOW GREEN															"SHS"-STANDARD HIGHWAY SIGNS						
SB	4.388	F	VW-054	30	30		HIDDEN DRIVE RIGHT																					
																												
SB	4.357	F	VW-054R	30	30			6.25																INSTALL 165 FT± SOUTH OF PREVIOUS LOCATION		E-154		
SB	3.517	F	VD-123	36	36		511 TRAVEL INFO w/ PHONE SYMBOL			1																		
																												
SB	3.324	F	W1-2Mi L	30	30			6.25																INSTALL 500 FT± NORTH OF TH-23; MAINTAIN 10 FT MIN TO UTILITY POLE #232/VTEL 44		6		
SB	3.228	G	VR-017	24	30		LEGAL LOAD LIMIT 24,000 POUNDS																	TH-23				
							SPEED LIMIT 35			1	1													SPEED LIMIT SIGN UNDER THE NEW LEGAL LOAD LIMIT SIGN				
								5.00																				
																								SALVAGE THE TOWN-OWNED SPEED LIMIT SIGN TO UNDER THE NEW LEGAL LOAD LIMIT SIGN.		E-141		
SB	3.224	H	R1-1	24	24																			TH-23				
								6.25																	X			
SB	2.880	F	W1-10R	30	30		MODIFIED RIGHT CURVE																					
																												
SB	2.874	F	W1-2McR	30	30			6.25																INSTALL 300 FT± NORTH OF TH-60		6		
SB	2.818	G	VR-017	24	30																			TH-60				
							SPEED LIMIT 35			1	1													REINSTALL THE SPEED LIMIT SIGN UNDER THE NEW LEGAL LOAD LIMIT SIGN				
								5.00																				
SIGN SUMMARY SHEET							SHEET TOTALS	35.00	0.00	1	2	2	5	0	0	6	90							PROJECT NAME: Ludlow-Waitsfield VT110				
								SF	SF	EA	EA	EA	EA	EA	EA	EA	FT							PROJECT NUMBER: STPG SIGN(27)				
							TOWN TOTALS	668.4	0.0	31.0	4.0	4.0	135	0.0	0.0	111	1665.0							FILE NAME: Plymouth.xls				
VERMONT AGENCY OF TRANSPORTATION																								PLOT DATE: 9/8/2009				
																								DRAWN BY: I. Shea				
																								DESIGNED BY: M. Miller				
																								CHECKED BY: N. Avery				
																								PLYMOUTH SHEET 18				
																								SHEET 45 OF 204				

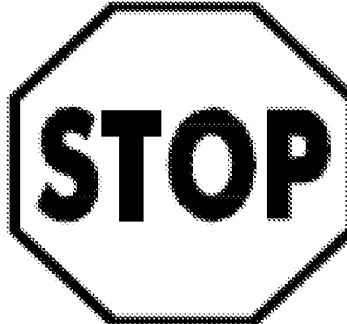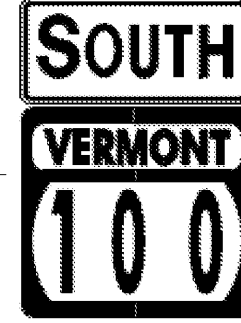








DIRECTION	MILEPOINT	LOCATION CODE (SHEET 2)	SIGN CODE	WIDTH (IN)	HEIGHT (IN)	SHEETING REMARKS	SIGN LEGEND	NEW SIGNS		EXISTING SIGNS				EXIST POST		NUMBER OF NEW POSTS	SQUARE STEEL (IN)			TUBULAR STEEL Ø (IN)				SIGN FRAME REQUIRED	REMARKS	SIGN DETAIL		
								"A"	"B"	RETAIN	SALVAGE FROM	SALVAGE TO	REMOVE	RETAIN	REMOVE		1.75	2.00	2.50	3.00	3.50	4.00	5.00			DETAIL IN SHS	DETAIL ON SHEET NUMBER	DETAIL ON STD SHEET NUMBER
																	(LB / FT)			(LB / FT)								
PLYMOUTH VT 100							FY-FLUORESCENT YELLOW FYG-FLUORESCENT YELLOW GREEN															"SHS"-STANDARD HIGHWAY SIGNS						
SB	2.810	H	R1-1	30	30																							
		H	R1-1	30	30			6.25																				
SB	2.772	F	VD-062BRN 72		16		BUSINESS SIGN			1																		
SB	2.210	F	W2-2R	30	30		SIDE ROAD RIGHT																					
SB	2.158	F	W2-3MaR	30	30			6.25																	6			
SB	2.121	G	VR-017	24	30																							
		G	VR-017	24	30			5.00																	E-141			
SB	2.115	H	R1-1	30	30																							
		H	R1-1	30	30			6.25																	X			
SB	2.014	F	VW-219	30	30		SUMMER CAMP AREA																					
SB	0.420	F	R2-5A	24	30		REDUCED SPEED AHEAD																					
		F	W3-5	36	36			9.00																	X			
SB	0.350	F	W1-2R	30	30		CURVE RIGHT																					
		F	VD-018	30	18			3.75																	E-128B			
SIGN SUMMARY SHEET							SHEET TOTALS	36.50	0.00	1	0	0	7	0	0	7	105				PROJECT NAME: Ludlow-Waitsfield VT110 PROJECT NUMBER: STPG SIGN(27)							
VERMONT AGENCY OF TRANSPORTATION							TOWN TOTALS	668.4	0.0	31.0	4.0	4.0	135	0.0	0.0	111	1665.0				FILE NAME: Plymouth.xls PLOT DATE: 9/8/2009 PROJECT MANAGER: N. Avery DRAWN BY: I. Shea DESIGNED BY: M. Miller CHECKED BY: N. Avery PLYMOUTH SHEET 19 SHEET 46 OF 204							


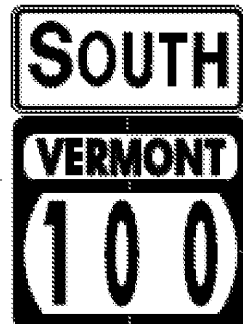
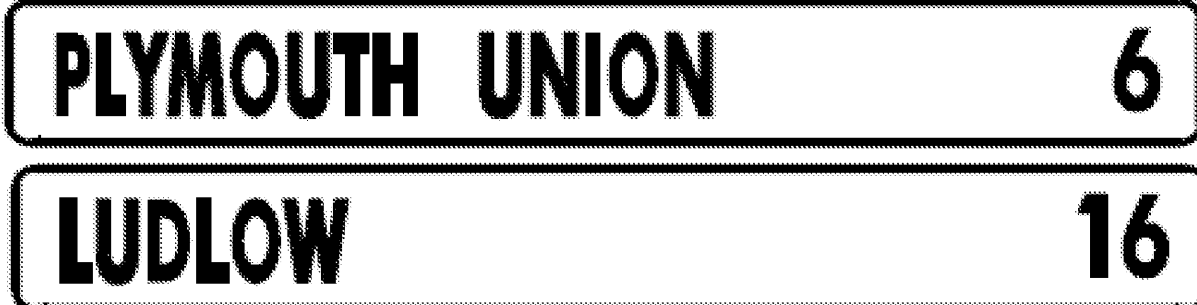
DIRECTION	MILEPOINT	LOCATION CODE (SHEET 2)	SIGN CODE	WIDTH (IN)	HEIGHT (IN)	SHEETING REMARKS	SIGN LEGEND	NEW SIGNS		EXISTING SIGNS				EXIST POST		NUMBER OF NEW POSTS	SQUARE STEEL (IN)			TUBULAR STEEL Ø (IN)				SIGN FRAME REQUIRED	REMARKS	SIGN DETAIL		
								"A"	"B"	RETAIN	SALVAGE FROM	SALVAGE TO	REMOVE	RETAIN	REMOVE		(LB / FT)			(LB / FT)						DETAIL IN SHS	DETAIL ON SHEET NUMBER	DETAIL ON STD SHEET NUMBER
																	1.75	2.00	2.50	3.00	3.50	4.00	5.00					
PLYMOUTH VT 100							FY-FLUORESCENT YELLOW FYG-FLUORESCENT YELLOW GREEN																"SHS"-STANDARD HIGHWAY SIGNS					
SB	0.315	F	R2-1	24	30																							
		F	R2-1	30	36			7.50																	6			
SB	0.275	F	D1-1A	54	7.5	<--- SO READING 7																						
		F	D1-1A	54	7.5	<--- FELCHVILLE 10																						
		F	D1-1A	72	12		6.00																	5				
		F	D1-1A	72	12		6.00																	5				
SB	0.232	F	VD-062AS	72	16	BUSINESS SIGN			1																			
		F	VD-062AS	72	16	BUSINESS SIGN			1																			
SB	0.156	G	VR-017	24	30																		(TH-15)					
		G	VR-017	24	30			5.00																		E-141		
SB	0.150	H	R1-1	30	30																		(TH-15)					
		H	R1-1	30	30			6.25																X				
SB	0.140	F	M3-3	24	12																							
		F	M1-5	24	24																							
		F	M3-3	24	12			2.00																GREEN ON WHITE SHEETING	X			
SIGN SUMMARY SHEET							SHEET TOTALS		32.75	0.00	2	0	0	6	0	0	6	90				PROJECT NAME: Ludlow-Waitsfield VT110						
							SF	SF	EA	EA	EA	EA	EA	EA	EA	EA	EA	FT				PROJECT NUMBER: STPG SIGN(27)						
VERMONT AGENCY OF TRANSPORTATION							TOWN TOTALS		668.4	0.0	31.0	4.0	4.0	135	0.0	0.0	111	1665.0				FILE NAME: Plymouth.xls	PLOT DATE: 9/8/2009					
																						PROJECT MANAGER: N. Avery	DRAWN BY: I. Shea					
																						DESIGNED BY: M. Miller	CHECKED BY: N. Avery					
																						PLYMOUTH SHEET 20	SHEET 47 OF 204					



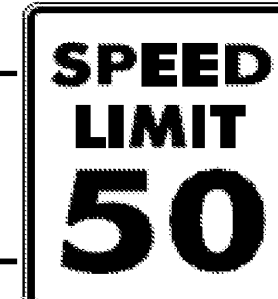
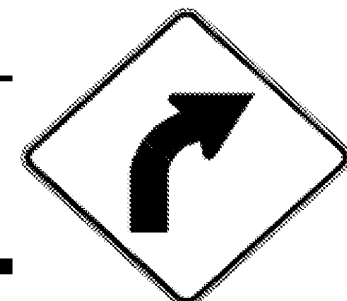
DIRECTION	MILEPOINT	LOCATION CODE (SHEET 2)	SIGN CODE	WIDTH (IN)	HEIGHT (IN)	SHEETING REMARKS	SIGN LEGEND	NEW SIGNS		EXISTING SIGNS				EXIST POST		NUMBER OF NEW POSTS	SQUARE STEEL (IN)			TUBULAR STEEL Ø (IN)				SIGN FRAME REQUIRED	REMARKS	SIGN DETAIL						
								"A"	"B"	RETAIN	SALVAGE FROM	SALVAGE TO	REMOVE	RETAIN	REMOVE		1.75	2.00	2.50	3.00	3.50	4.00	5.00			DETAIL IN SHS	DETAIL ON SHEET NUMBER	DETAIL ON STD SHEET NUMBER				
																	(LB / FT)			(LB / FT)												
PLYMOUTH VT 100							FY-FLUORESCENT YELLOW FYG-FLUORESCENT YELLOW GREEN															"SHS"-STANDARD HIGHWAY SIGNS										
			F M1-5	24	24			5.00																			E-136B					
SB	0.107		F R2-1	24	30							1																				
			F R2-1	24	30			5.00						1		X								X								
SB	0.033		G VR-017	24	30							1																				
			G VR-017	24	30			5.00						1		X												E-141				
SB	0.027		H R1-1	30	30							1																				
			H R1-1	30	30			6.25						1		X								X								
								SHEET TOTALS		21.25	0.00	0	0	0	3	0	0	3	45													
								SF	SF	EA	EA	EA	EA	EA	EA	EA	EA	EA	EA	EA	EA	EA	EA	EA	EA	EA	EA	EA	EA	EA	EA	EA
VERMONT AGENCY OF TRANSPORTATION								TOWN TOTALS		668.4	0.0	31.0	4.0	4.0	135	0.0	0.0	111	1665.0													
									PROJECT NAME: Ludlow-Waitsfield VT110												PROJECT NUMBER: STPG SIGN(27)											
									FILE NAME: Plymouth.xls												PLOT DATE: 9/8/2009											
									PROJECT MANAGER: N. Avery												DRAWN BY: I. Shea											
									DESIGNED BY: M. Miller												CHECKED BY: N. Avery											
									PLYMOUTH SHEET 21												SHEET 48 OF 204											






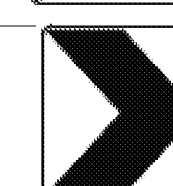
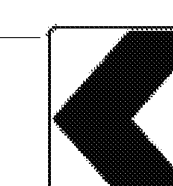
DIRECTION	MILEPOINT	LOCATION CODE (SHEET 2)	SIGN CODE	WIDTH (IN)	HEIGHT (IN)	SHEETING REMARKS	SIGN LEGEND	NEW SIGNS		EXISTING SIGNS				EXIST POST		NUMBER OF NEW POSTS	SQUARE STEEL (IN)			TUBULAR STEEL Ø (IN)				SIGN FRAME REQUIRED	REMARKS	SIGN DETAIL			
								"A"	"B"	RETAIN	SALVAGE FROM	SALVAGE TO	REMOVE	RETAIN	REMOVE		1.75	2.00	2.50	FOUNDATION	3.00	3.50	4.00			5.00	DETAIL IN SHS	DETAIL ON SHEET NUMBER	DETAIL ON STD SHEET NUMBER
																	(LB / FT)				(LB / FT)								
BRIDGEWATER VT 100							FY-FLUORESCENT YELLOW FYG-FLUORESCENT YELLOW GREEN													"SHS"-STANDARD HIGHWAY SIGNS									
NB	0.000	C	VD-024	60	7.5						1				X														
		C	VD-024	72	10		BRIDGEWATER						6.00			2		X							INSTALL IN THE SAME POSITION AS THE REMOVAL		4		
		C	VD-700	6	10		1000 1405 0000						0.42												BRIDGEWATER MILE MARKER; INSTALL ON THE LEFT POST UNDER BRIDGEWATER			E-138	
		C	VD-700	6	10		1000 1412 0973						0.42												PLYMOUTH MILE MARKER; INSTALL ON THE RIGHT POST UNDER PLYMOUTH			E-138	
NB	0.536	A	VD-062C	74.75	16		TRAVEL INFORMATION SYMBOLS			1					X														
		A	VD-062BC	74.75	16		TRAVEL INFORMATION			1																			
NB	0.770	A	VD-062B	72	16		BUSINESS SIGN			1					X														
		A	VD-062AS	72	16		BUSINESS SIGN			1																			
		A	VD-062AL	72	16		BUSINESS SIGN			1																			
NB	0.798	A	W3-1	36	36		STOP AHEAD SYMBOL			1	1				X	2		X							RESET TO SPEC, NEW POSTS.				
NB	0.838	A	M2-1	21	15							1			X														
		A	M1-4	24	24							1																	
		A	M2-1	21	15								2.19			1		X							BLACK ON WHITE SHEETING		X		
		A	M1-4	24	24								4.00															E-136A	
SIGN SUMMARY SHEET							SHEET TOTALS	13.03	0.00	5	1	1	3	0	0	5		75							PROJECT NAME: Ludlow-Waitsfield VT100				
								SF	SF	EA	EA	EA	EA	EA	EA	EA	EA	EA			FT							PROJECT NUMBER: STPG SIGN(27)	
VERMONT AGENCY OF TRANSPORTATION							TOWN TOTALS	111.1	0.0	12.0	1.0	1.0	25	0.0	0.0	15		225.0					FILE NAME: Bridgewater.xls			PLOT DATE: 9/15/2009			
																							PROJECT MANAGER: N. Avery			DRAWN BY: I. Shea			
																								DESIGNED BY: M. Miller			CHECKED BY: N. Avery		
																								BRIDGEWATER SHEET 1			SHEET 49	OF 204	



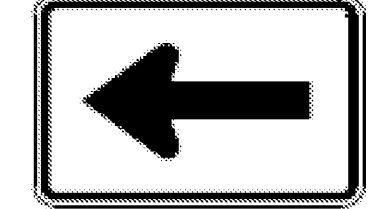
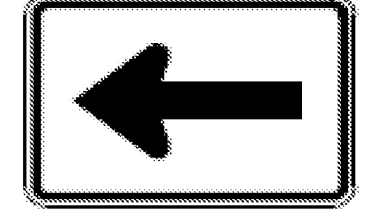
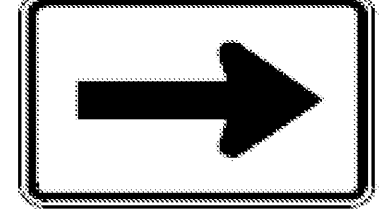



DIRECTION	MILEPOINT	LOCATION CODE (SHEET 2)	SIGN CODE	WIDTH (IN)	HEIGHT (IN)	SHEETING REMARKS	SIGN LEGEND	NEW SIGNS		EXISTING SIGNS				EXIST POST		NUMBER OF NEW POSTS	SQUARE STEEL (IN) (LB / FT)			TUBULAR STEEL Ø (IN) (LB / FT)				SIGN FRAME REQUIRED	REMARKS	SIGN DETAIL		
								"A"	"B"	RETAIN	SALVAGE FROM	SALVAGE TO	REMOVE	RETAIN	REMOVE		1.75	2.00	2.50	3.00	3.50	4.00	5.00			DETAIL IN SHS	DETAIL ON SHEET NUMBER	DETAIL ON STD SHEET NUMBER
																	1.88	2.42	3.35	FOUNDATION								
BRIDGEWATER VT 100							FY-FLUORESCENT YELLOW FYG-FLUORESCENT YELLOW GREEN														"SHS"-STANDARD HIGHWAY SIGNS							
NB	0.870	A	D1-1A	72	10																							
		A	D1-1A	72	10																							
		A	D1-1A	72	10																							
		A	D1-1A	72	10																							
		A	D1-1A	72	12			6.00					2				X								5			
		A	D1-1A	72	12			6.00																	5			
		A	D1-1A	72	12			6.00																	5			
		A	D1-1A	72	12			6.00																	5			
NB	0.905	A	M3-4	24	12							1	X															
		A	M1-4	24	24							1																
		A	M6-1	21	15							1																
		A	M3-1	24	12							1																
		A	M1-5A	24	24							1																
		A	M6-1	21	15							1																
		A	M3-2	24	12							1																
SIGN SUMMARY SHEET							SHEET TOTALS	24.00	0.00	0	0	0	11	0	0	2	30					PROJECT NAME: Ludlow-Waitsfield VT100						
								SF	SF	EA	EA	EA	EA	EA	EA	EA	FT					PROJECT NUMBER: STPG SIGN(27)						
							TOWN TOTALS	111.1	0.0	12.0	1.0	1.0	25	0.0	0.0	15	225.0					FILE NAME: Bridgewater.xls	PLOT DATE: 9/15/2009					
VERMONT AGENCY OF TRANSPORTATION																					PROJECT MANAGER: N. Avery	DRAWN BY: I. Shea						
																				DESIGNED BY: M. Miller	CHECKED BY: N. Avery							
																				BRIDGEWATER SHEET 2			SHEET 50 OF 204					



DIRECTION	MILEPOINT	LOCATION CODE (SHEET 2)	SIGN CODE	WIDTH (IN)	HEIGHT (IN)	SHEETING REMARKS	SIGN LEGEND	NEW SIGNS		EXISTING SIGNS				EXIST POST		NUMBER OF NEW POSTS	SQUARE STEEL (IN)			TUBULAR STEEL Ø (IN)				SIGN FRAME REQUIRED	REMARKS	SIGN DETAIL		
								"A"	"B"	RETAIN	SALVAGE FROM	SALVAGE TO	REMOVE	RETAIN	REMOVE		(LB / FT)			(LB / FT)						DETAIL IN SHS	DETAIL ON SHEET NUMBER	DETAIL ON STD SHEET NUMBER
																	1.75	2.00	2.50	3.00	3.50	4.00	5.00					
								1.88	2.42	3.35	FOUNDATION	7.60	9.00	10.80	14.60													
BRIDGEWATER VT 100							FY-FLUORESCENT YELLOW FYG-FLUORESCENT YELLOW GREEN														"SHS"-STANDARD HIGHWAY SIGNS							
			A M1-4	24	24								1															
			A M6-1	21	15								1															
			A M3-4	24	12			2.00												#3B	BLACK ON WHITE SHEETING	X						
			A M1-4	24	24			4.00																	E-136A			
			A M6-1L	21	15		  	2.19															BLACK ON WHITE SHEETING	X				
			A M3-1	24	12		  	2.00															GREEN ON WHITE SHEETING	X				
			A M1-5	30	24			5.00																	E-136B			
			A M6-1L	21	15		  	2.19															GREEN ON WHITE SHEETING	X				
			A M3-2	24	12			2.00																				
			A M1-4	24	24			4.00																	E-136A			
			A M6-1R	21	15			2.19																				
NB	0.934	A	n/a	n/a	n/a		REMOVE EMPTY POST																					
NB	0.943	A	VR-040	24	24		THROUGH WAY ENDS HERE						1															
		B	VR-041	24	24		THROUGH WAY BEGINS HERE						1															
NB	0.956	J	R4-7	24	30		KEEP RIGHT SYMBOL ("BULLNOSE")			1																		
SIGN SUMMARY SHEET							SHEET TOTALS				25.57	0.00	1	0	0	4	0	0	0	0	0					PROJECT NAME: Ludlow-Waitsfield VT100		
											SF	SF	EA	EA	EA	EA	EA	EA	EA	EA	EA	EA	EA	EA	EA	EA	EA	EA
VERMONT AGENCY OF TRANSPORTATION							TOWN TOTALS				111.1	0.0	12.0	1.0	1.0	25	0.0	0.0	15	225.0					FILE NAME: Bridgewater.xls			
																										DRAWN BY: I. Shea		
																											DESIGNED BY: M. Miller	
																											CHECKED BY: N. Avery	
																											SHEET 51 OF 204	

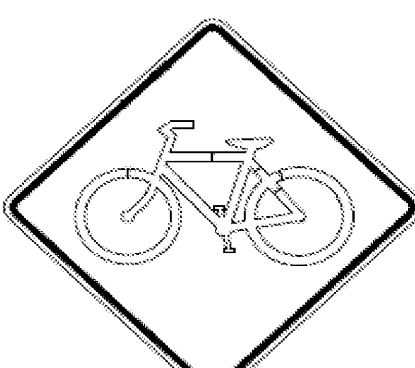


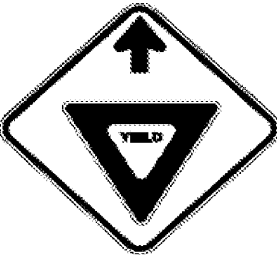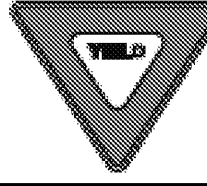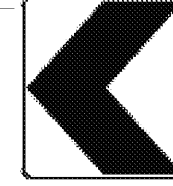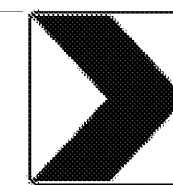
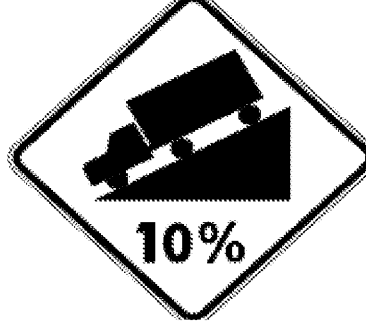

DIRECTION	MILEPOINT	LOCATION CODE (SHEET 2)	SIGN CODE	WIDTH (IN)	HEIGHT (IN)	SHEETING REMARKS	SIGN LEGEND	NEW SIGNS		EXISTING SIGNS				EXIST POST		NUMBER OF NEW POSTS	SQUARE STEEL (IN)			TUBULAR STEEL Ø (IN)				SIGN FRAME REQUIRED	REMARKS	SIGN DETAIL		
								"A"	"B"	RETAIN	SALVAGE FROM	SALVAGE TO	REMOVE	RETAIN	REMOVE		(LB / FT)			(LB / FT)						DETAIL IN SHS	DETAIL ON SHEET NUMBER	DETAIL ON STD SHEET NUMBER
																	1.75	2.00	2.50	3.00	3.50	4.00	5.00					
BRIDGEWATER VT 100							FY-FLUORESCENT YELLOW FYG-FLUORESCENT YELLOW GREEN															"SHS"-STANDARD HIGHWAY SIGNS						
		J	OM1-1	18	18		YELLOW CLUSTER			1													LOCATED IN THE SMALL RAISED MEDIAN AT THE JCT w/ US RT 4					
		K	OM1-1	18	18		YELLOW CLUSTER			1																		
NB	0.960	A	R1-1	30	30								1			X							BEHIND RAIL. RIGHT-SIDE STOP SIGN FOR VT-100					
		A	R1-1	36	36			9.00								2		X						X				
NB	0.960	J	R1-1	30	30		STOP			1					X								LEFT-SIDE STOP SIGN FOR VT-100					
		J	OM1-1	18	18		YELLOW CLUSTER			1																		
		K	R4-7	24	30		KEEP RIGHT SYMBOL ("BULLNOSE") ON BACK			1																		
		K	OM1-1	18	18		YELLOW CLUSTER ~ INSTALLED ON BACK			1																		
SB	0.921	F	M3-3	24	12								1			X												
		F	M1-5A	24	24									1														
		F	M3-3	24	12			2.00								1		X						GREEN ON WHITE SHEETING	X			
		F	M1-5A	30	24			5.00																		E-136B		
SB	0.902	F	D2-1	72	10									1			X											
		F	D2-1	72	10									1														
		F	D2-1	72	12			6.00								2		X								5		
SIGN SUMMARY SHEET							SHEET TOTALS	22.00	0.00	6	0	0	5	0	0	5		75					PROJECT NAME: Ludlow-Waitsfield VT100					
								SF	SF	EA	EA	EA	EA	EA	EA	EA		FT				PROJECT NUMBER: STPG SIGN(27)						
VERMONT AGENCY OF TRANSPORTATION							TOWN TOTALS	111.1	0.0	12.0	1.0	1.0	25	0.0	0.0	15		225.0					FILE NAME: Bridgewater.xls	PLOT DATE: 9/15/2009				
																						PROJECT MANAGER: N. Avery	DRAWN BY: I. Shea					
																						DESIGNED BY: M. Miller	CHECKED BY: N. Avery					
																						BRIDGEWATER SHEET 4	SHEET 52	OF 204				

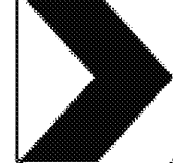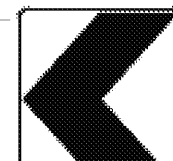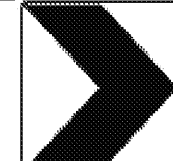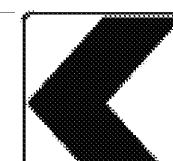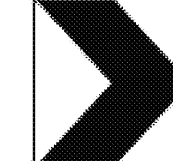
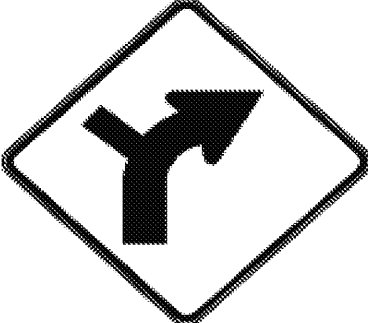

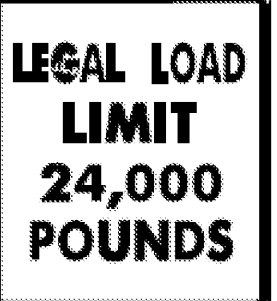


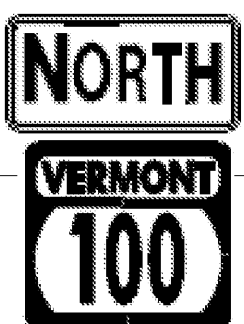
DIRECTION	MILEPOINT	LOCATION CODE (SHEET 2)	SIGN CODE	WIDTH (IN)	HEIGHT (IN)	SHEETING REMARKS	SIGN LEGEND	NEW SIGNS		EXISTING SIGNS				EXIST POST		NUMBER OF NEW POSTS	SQUARE STEEL (IN)			TUBULAR STEEL Ø (IN)				SIGN FRAME REQUIRED	REMARKS	SIGN DETAIL			
								"A"	"B"	RETAIN	SALVAGE FROM	SALVAGE TO	REMOVE	RETAIN	REMOVE		(LB / FT)			(LB / FT)						DETAIL IN SHS	DETAIL ON SHEET NUMBER	DETAIL ON STD SHEET NUMBER	
																	1.75	2.00	2.50	3.00	3.50	4.00	5.00						
BRIDGEWATER VT 100							FY-FLUORESCENT YELLOW FYG-FLUORESCENT YELLOW GREEN															"SHS"-STANDARD HIGHWAY SIGNS							
			F D2-1	72	12			6.00																5					
SB	0.862		F W11-1	30	30		  																						
			F W16-1	18	24							1																	
			F W11-1	30	30				6.25					1		X								X					
			F W16-1	18	24				3.00															X					
SB	0.824		F R2-1	24	30			5.00					1		X								X		INSTALL 200 FT± SOUTH OF BIKE / SHARE THE ROAD SIGNS				
SB	0.045		F W1-2R	30	30			6.25					1		X								X		INSTALL 240 FT± NORTH OF AND ACROSS FROM THE BRIDGEWATER / PLYMOUTH TOWN LINE SIGN.				
VT 100 BECOMES US 4. RESUME VT 100 IN KILLINGTON																													
								SHEET TOTALS		26.50	0.00	0	0	0	2	0	0	3	45										
								SF	SF	EA	EA	EA	EA	EA	EA	EA	EA	EA	EA	EA	EA	EA	EA	EA	EA	EA	EA	EA	
								TOWN TOTALS		111.1	0.0	12.0	1.0	1.0	25	0.0	0.0	15	225.0										
SIGN SUMMARY SHEET																				PROJECT NAME: Ludlow-Waitsfield VT100 PROJECT NUMBER: STPG SIGN(27)									
VERMONT AGENCY OF TRANSPORTATION																				FILE NAME: Bridgewater.xls PROJECT MANAGER: N. Avery DESIGNED BY: M. Miller BRIDGEWATER SHEET 5									
																				PLOT DATE: 9/15/2009 DRAWN BY: I. Shea CHECKED BY: N. Avery SHEET 53 OF 204									

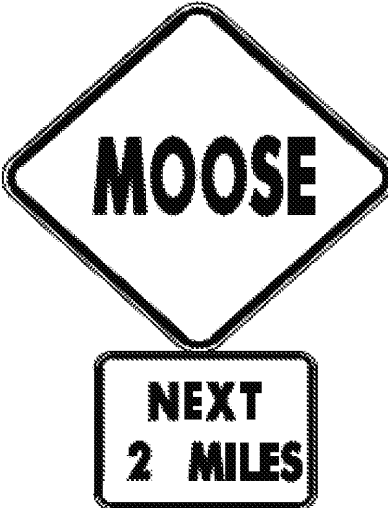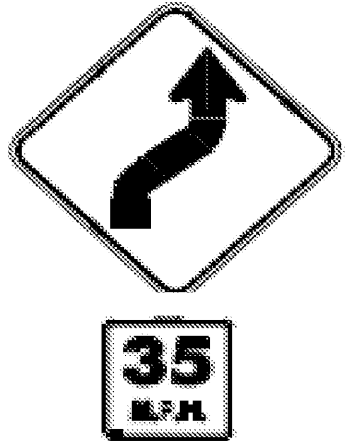

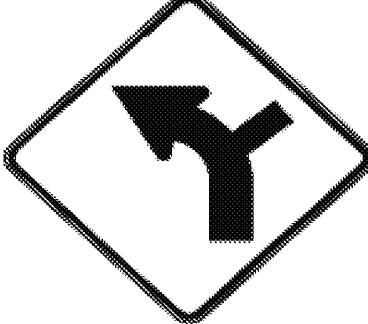



DIRECTION	MILEPOINT	LOCATION CODE (SHEET 2)	SIGN CODE	WIDTH (IN)	HEIGHT (IN)	SHEETING REMARKS	SIGN LEGEND	NEW SIGNS		EXISTING SIGNS				EXIST POST		NUMBER OF NEW POSTS	SQUARE STEEL (IN)			TUBULAR STEEL Ø (IN)				SIGN FRAME REQUIRED	REMARKS	SIGN DETAIL		
								"A"	"B"	RETAIN	SALVAGE FROM	SALVAGE TO	REMOVE	RETAIN	REMOVE		(LB / FT)			(LB / FT)						DETAIL IN SHS	DETAIL ON SHEET NUMBER	DETAIL ON STD SHEET NUMBER
																	1.75	2.00	2.50	3.00	3.50	4.00	5.00					
KILLINGTON VT 100							FY-FLUORESCENT YELLOW FYG-FLUORESCENT YELLOW GREEN																"SHS"-STANDARD HIGHWAY SIGNS					
NB	0.060	A	W3-2	36	36																							
		A	W3-2	36	36			9.00																		X		
NB	0.100	A	R1-2	30	30																							
		A	R1-2	48	48			6.93																		X		
NB	0.120	A	W1-8	18	24																							
		B	W1-8	18	24																							
		A	W1-8	24	30	FY		5.00																		X		
		B	W1-8	24	30	FY		5.00																		X		
NB	0.145	A	W1-8	18	24																							
		B	W1-8	18	24																							
		A	W1-8	24	30	FY		5.00																		X		
		B	W1-8	24	30	FY		5.00																		X		
NB	0.165	A	W1-8	18	24																							
		B	W1-8	18	24																							
		A	W1-8	24	30	FY		5.00																		X		
SIGN SUMMARY SHEET							SHEET TOTALS		40.93	0.00	0	0	0	8	0	0	9	135					PROJECT NAME: Ludlow-Waitsfield VT100					
							SF	SF	EA	EA	EA	EA	EA	EA	EA	EA	EA	FT					PROJECT NUMBER: STPG SIGN(27)					
VERMONT AGENCY OF TRANSPORTATION							TOWN TOTALS		567.0	0.0	28.0	0.0	0.0	114	0.0	0.0	88	1320.0					FILE NAME: Killington.xls PLOT DATE: 9/8/2009					
																						PROJECT MANAGER: N. Avery DRAWN BY: I. Shea						
																						DESIGNED BY: J. Kelly CHECKED BY: N. Avery						
																						KILLINGTON SHEET 1 SHEET 54 OF 204						






DIRECTION	MILEPOINT	LOCATION CODE (SHEET 2)	SIGN CODE	WIDTH (IN)	HEIGHT (IN)	SHEETING REMARKS	SIGN LEGEND	NEW SIGNS		EXISTING SIGNS				EXIST POST		NUMBER OF NEW POSTS	SQUARE STEEL (IN)			TUBULAR STEEL Ø (IN)				SIGN FRAME REQUIRED	REMARKS	SIGN DETAIL		
								"A"	"B"	RETAIN	SALVAGE FROM	SALVAGE TO	REMOVE	RETAIN	REMOVE		(LB / FT)			(LB / FT)						DETAIL IN SHS	DETAIL ON SHEET NUMBER	DETAIL ON STD SHEET NUMBER
																	1.75	2.00	2.50	3.00	3.50	4.00	5.00					
KILLINGTON VT 100							FY-FLUORESCENT YELLOW FYG-FLUORESCENT YELLOW GREEN																"SHS"-STANDARD HIGHWAY SIGNS					
			B	W1-8	24	30	FY		5.00							1		X							X			
NB	0.185		A	W1-8	18	24							1		X													
			B	W1-8	18	24							1															
			A	W1-8	24	30	FY		5.00						1		X							INSTALL ON SEPARATE POSTS AND ANGLED TOWARDS TRAFFIC	X			
			B	W1-8	24	30	FY		5.00						1		X								X			
NB	0.205		A	W1-8	18	24							1		X													
			B	W1-8	18	24							1															
			A	W1-8	24	30	FY		5.00						1		X							INSTALL ON SEPARATE POSTS AND ANGLED TOWARDS TRAFFIC	X			
			B	W1-8	24	30	FY		5.00						1		X								X			
NB	0.225		A	W1-8	18	24		CHEVRON							1		X							REMOVE NORTHERN CHEVRON ASSEMBLY				
			B	W1-8	18	24		CHEVRON							1													
			A	D2-1	72	12			6.00						2		X									5		
			A	D2-1	72	12			6.00																	5		
			A	M3-1	24	12			2.00															GREEN ON WHITE SHEETING; INSTALL ON LEFT POST	X			
			A	M1-5	30	24			5.00																	E-136B		
SIGN SUMMARY SHEET							SHEET TOTALS		44.00	0.00	0	0	0	6	0	0	7	105										
VERMONT AGENCY OF TRANSPORTATION							SF	SF	EA	EA	EA	EA	EA	EA	EA	EA	EA	EA	FT									
							TOWN TOTALS		567.0	0.0	28.0	0.0	0.0	114	0.0	0.0	88	1320.0										
							PROJECT NAME: Ludlow-Waitsfield VT100															PROJECT NUMBER: STPG SIGN(27)						
							FILE NAME: Killington.xls															PLOT DATE: 9/8/2009						
							PROJECT MANAGER: N. Avery															DRAWN BY: I. Shea						
							DESIGNED BY: J. Kelly															CHECKED BY: N. Avery						
							KILLINGTON SHEET 2															SHEET 55 OF 204						


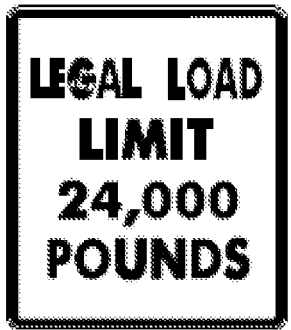


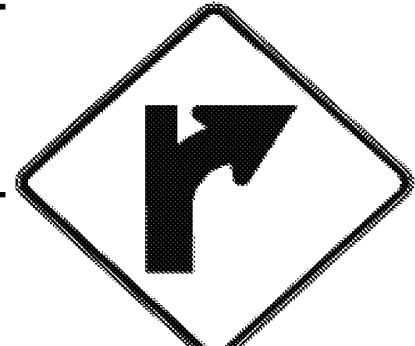DIRECTION	MILEPOINT	LOCATION CODE (SHEET 2)	SIGN CODE	WIDTH (IN)	HEIGHT (IN)	SHEETING REMARKS	SIGN LEGEND	NEW SIGNS		EXISTING SIGNS				EXIST POST		NUMBER OF NEW POSTS	SQUARE STEEL (IN)			TUBULAR STEEL Ø (IN)				SIGN FRAME REQUIRED	REMARKS	SIGN DETAIL		
								"A"	"B"	RETAIN	SALVAGE FROM	SALVAGE TO	REMOVE	RETAIN	REMOVE		1.75	2.00	2.50	3.00	3.50	4.00	5.00			DETAIL IN SHS	DETAIL ON SHEET NUMBER	DETAIL ON STD SHEET NUMBER
																	(LB / FT)			(LB / FT)								
KILLINGTON VT 100							FY-FLUORESCENT YELLOW FYG-FLUORESCENT YELLOW GREEN															"SHS"-STANDARD HIGHWAY SIGNS						
NB	0.405	A	VW-000	30	30																							
		A	W7-3A	24	18																							
		A	VW-000	30	30			6.25																	E-153			
		A	W7-3A	24	18			3.00																X				
NB	0.455	A	W11-2YG	30	30		PEDESTRIAN			1																		
		A	W16-9YG	24	10		AHEAD			1																		
NB	0.555	C	R7-2S	24	30		NO PARKING (ARROWS)			1																		
		C	VR-147	24	18		DEC 1 TO MAR 31			1																		
		C	VM-607	24	30		43RD INF DIV			1																		
NB	0.570	A	W11-2YG	30	30		PEDESTRIAN			1																		
		A	W16-7YG	24	12		DIAGONAL ARROW			1																		
NB	0.635	A	W1-5R	30	30																							
		A	W13-1	18	18																							
		A	W1-5R	30	30			6.25																	X			
		A	W13-1	18	18			2.25																	X			
SIGN SUMMARY SHEET							SHEET TOTALS	17.75	0.00	7	0	0	4	0	0	2	30						PROJECT NAME: Ludlow-Waitsfield VT100					
							SF	SF	EA	EA	EA	EA	EA	EA	EA	FT						PROJECT NUMBER: STPG SIGN(27)						
							TOWN TOTALS	567.0	0.0	28.0	0.0	0.0	114	0.0	0.0	88	1320.0						FILE NAME: Killington.xls	PLOT DATE: 9/8/2009				
VERMONT AGENCY OF TRANSPORTATION																					PROJECT MANAGER: N. Avery	DRAWN BY: I. Shea						
																				DESIGNED BY: J. Kelly	CHECKED BY: N. Avery							
																				KILLINGTON SHEET 3	SHEET 56 OF 204							



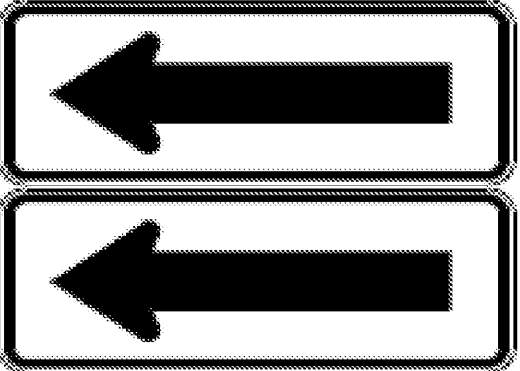
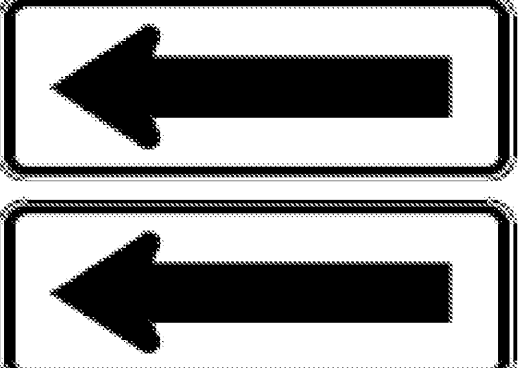

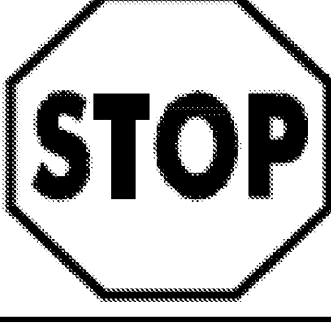
DIRECTION	MILEPOINT	LOCATION CODE (SHEET 2)	SIGN CODE	WIDTH (IN)	HEIGHT (IN)	SHEETING REMARKS	SIGN LEGEND	NEW SIGNS		EXISTING SIGNS				EXIST POST		NUMBER OF NEW POSTS	SQUARE STEEL (IN)			TUBULAR STEEL Ø (IN)				SIGN FRAME REQUIRED	REMARKS	SIGN DETAIL													
								"A"	"B"	RETAIN	SALVAGE FROM	SALVAGE TO	REMOVE	RETAIN	REMOVE		1.75	2.00	2.50	3.00	3.50	4.00	5.00			DETAIL IN SHS	DETAIL ON SHEET NUMBER	DETAIL ON STD SHEET NUMBER											
																	(LB / FT)			(LB / FT)																			
KILLINGTON VT 100							FY-FLUORESCENT YELLOW FYG-FLUORESCENT YELLOW GREEN															"SHS"-STANDARD HIGHWAY SIGNS																	
NB	0.675	A	VD-062AS	72	16		BUSINESS SIGN			1																													
NB	0.810	A	W1-10L	30	30								1																										
		A	S3-1	30	30								1																										
		A	W1-10L	30	30			6.25							2		X																						
		A	S3-1	30	30			6.25																															
NB	0.950	C	VR-017	24	30								1																										
		C	VR-017	24	30			5.00							1		X																				E-141		
NB	0.960	D	R1-1	30	30																																		
		D	R1-1	30	30			6.25																															
NB	1.135	A	W7-1	30	30		HILL SYMBOL 																																
		A	W7-1b	30	30			6.25																															
NB	1.440	A	W1-5L	30	30		LEFT WINDING CURVES																																
		A	W13-1	18	18		35 MPH PLAQUE 																																
NB	1.468	A	W1-4R	30	30			6.25																															
		A	W13-1	18	18			2.25																															
SIGN SUMMARY SHEET							SHEET TOTALS		38.50	0.00	1	0	0	7	0	0	6	90																					
							SF	SF	EA	EA	EA	EA	EA	EA	EA	EA	EA	FT																					
VERMONT AGENCY OF TRANSPORTATION							TOWN TOTALS		567.0	0.0	28.0	0.0	0.0	114	0.0	0.0	88	1320.0																					
												PROJECT NAME: Ludlow-Waitsfield VT100																											
												PROJECT NUMBER: STPG SIGN(27)																											
												FILE NAME: Killington.xls				PLOT DATE: 9/8/2009																							
												PROJECT MANAGER: N. Avery				DRAWN BY: I. Shea																							
												DESIGNED BY: J. Kelly				CHECKED BY: N. Avery																							
												KILLINGTON SHEET 4				SHEET 57 OF 204																							



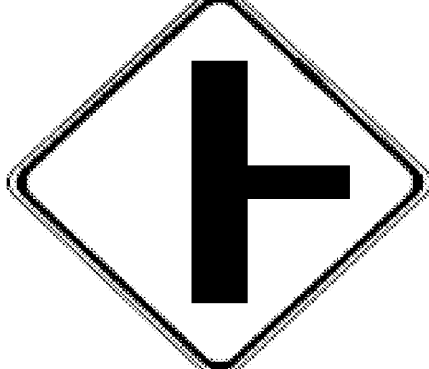

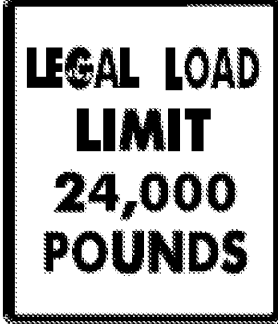

DIRECTION	MILEPOINT	LOCATION CODE (SHEET 2)	SIGN CODE	WIDTH (IN)	HEIGHT (IN)	SHEETING REMARKS	SIGN LEGEND	NEW SIGNS		EXISTING SIGNS				EXIST POST		NUMBER OF NEW POSTS	SQUARE STEEL (IN)			TUBULAR STEEL Ø (IN)				SIGN FRAME REQUIRED	REMARKS	SIGN DETAIL			
								"A"	"B"	RETAIN	SALVAGE FROM	SALVAGE TO	REMOVE	RETAIN	REMOVE		1.75	2.00	2.50	3.00	3.50	4.00	5.00			DETAIL IN SHS	DETAIL ON SHEET NUMBER	DETAIL ON STD SHEET NUMBER	
																	(LB / FT)			(LB / FT)									
KILLINGTON VT 100							FY-FLUORESCENT YELLOW FYG-FLUORESCENT YELLOW GREEN																"SHS"-STANDARD HIGHWAY SIGNS						
NB	1.900	A	W2-2ML	30	30		MODIFIED LEFT SIDE ROAD																						
		A	S3-1	30	30																								
		A	S3-1	30	30			6.25																	X				
NB	1.965	A	VW-054R	30	30																								
		A	W1-10R	30	30			6.25																		X			
		A	VW-054R	30	30			6.25																					
NB	2.265	A	W1-6	48	24		LEFT ARROW																						
NB	2.290	C	VR-017	24	30																								
		C	VR-017	24	30			5.00																					
NB	2.300	D	R1-1	30	30																								
		D	R1-1	30	30			6.25																	X				
NB	2.310	C	VR-017	24	30																								
								5.00																					
NB	2.320	B	W1-6	48	24		RIGHT ARROW																						
NB	2.330	D	R1-1	30	30																								
		D	R1-1	30	30			6.25																	X				
SIGN SUMMARY SHEET							SHEET TOTALS	41.25	0.00	2	0	0	6	0	0	7	105												
VERMONT AGENCY OF TRANSPORTATION							TOWN TOTALS	567.0	0.0	28.0	0.0	0.0	114	0.0	0.0	88	1320.0												
PROJECT NAME: Ludlow-Waitsfield VT100																					PROJECT NUMBER: STPG SIGN(27)								
FILE NAME: Killington.xls												PLOT DATE: 9/8/2009																	
PROJECT MANAGER: N. Avery												DRAWN BY: I. Shea																	
DESIGNED BY: J. Kelly												CHECKED BY: N. Avery																	
KILLINGTON SHEET 5																					SHEET 58 OF 204								



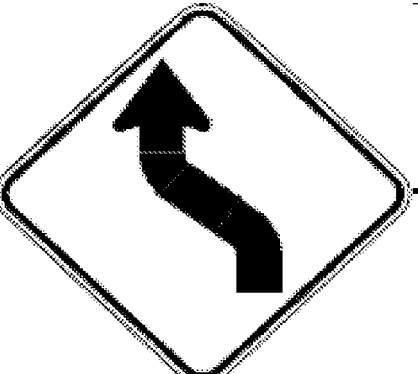

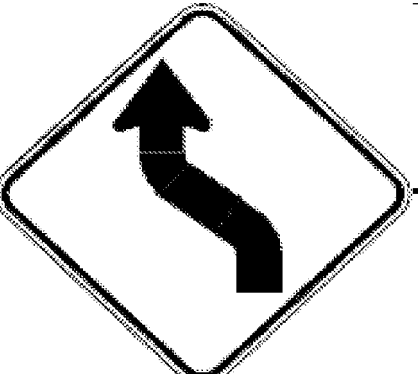
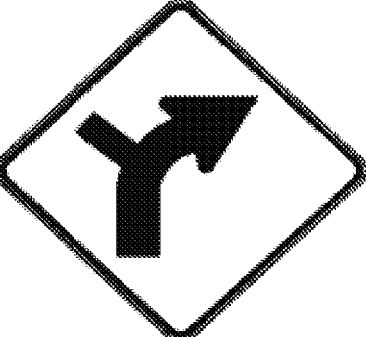




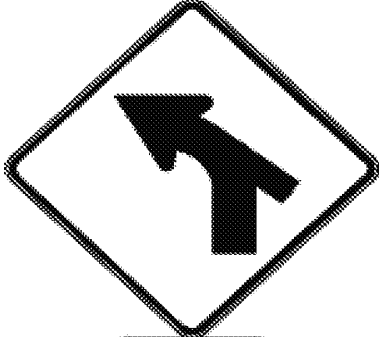


DIRECTION	MILEPOINT	LOCATION CODE (SHEET 2)	SIGN CODE	WIDTH (IN)	HEIGHT (IN)	SHEETING REMARKS	SIGN LEGEND	NEW SIGNS		EXISTING SIGNS				EXIST POST		NUMBER OF NEW POSTS	SQUARE STEEL (IN)			TUBULAR STEEL Ø (IN)				SIGN FRAME REQUIRED	REMARKS	SIGN DETAIL		
								"A"	"B"	RETAIN	SALVAGE FROM	SALVAGE TO	REMOVE	RETAIN	REMOVE		1.75	2.00	2.50	3.00	3.50	4.00	5.00			DETAIL IN SHS	DETAIL ON SHEET NUMBER	DETAIL ON STD SHEET NUMBER
																	(LB / FT)			(LB / FT)								
KILLINGTON VT 100							FY-FLUORESCENT YELLOW FYG-FLUORESCENT YELLOW GREEN																"SHS"-STANDARD HIGHWAY SIGNS					
NB	2.360	A	M3-1S	24	12					1																		
		A	M1-5	30	24		VERMONT 100			1																		
NB	2.505	A	S3-1	30	30							1																
		A	S3-1	30	30			6.25						1		X								X				
NB	2.530	A	VD-062AS	72	16		BUSINESS SIGN			1																		
NB	2.590	C	VR-017	24	30							1													TH-6, DOUBLEDAY HILL RD			
		C	VR-017	24	30			5.00						1		X										E-141		
NB	2.595	D	R1-1	30	30							1													TH-6, DOUBLEDAY HILL RD			
		D	R1-1	30	30			6.25						1		X								X				
NB	2.615	A	W1-2MgR	30	30		MODIFIED RIGHT CURVE					1																
		A	W13-1	18	18		35 MPH PLAQUE 					1																
NB	2.657	A	VW-205	36	36			9.00						2		X									INSTALL 40 FEET SOUTH OF EXISTING ASSEMBLY			
NB	2.665	A	VW-205	36	36		WATCH FOR TURNING VEHICLES 					1																
NB	2.695	A	VR-615	30	36		LEFT TURN YIELD TO THRU TRAFFIC 					1																
		A	W1-2MgR	30	30	FY		6.25						1		X										6		
SIGN SUMMARY SHEET							SHEET TOTALS	32.75	0.00	3	0	0	7	0	0	6	90								PROJECT NAME: Ludlow-Waitsfield VT100			
								SF	SF	EA	EA	EA	EA	EA	EA	EA	FT								PROJECT NUMBER: STPG SIGN(27)			
VERMONT AGENCY OF TRANSPORTATION							TOWN TOTALS	567.0	0.0	28.0	0.0	0.0	114	0.0	0.0	88	1320.0								FILE NAME: Killington.xls			
																									PLOT DATE: 9/8/2009			
																									DRAWN BY: I. Shea			
																									DESIGNED BY: J. Kelly			
																									CHECKED BY: N. Avery			
																									KILLINGTON SHEET 6			
																									SHEET 59 OF 204			

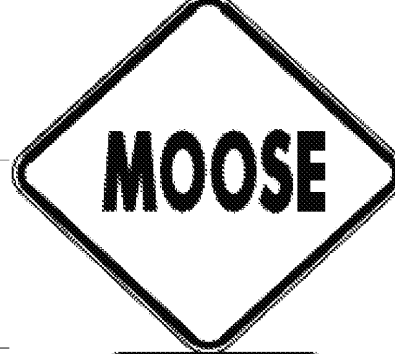DIRECTION	MILEPOINT	LOCATION CODE (SHEET 2)	SIGN CODE	WIDTH (IN)	HEIGHT (IN)	SHEETING REMARKS	SIGN LEGEND	NEW SIGNS		EXISTING SIGNS				EXIST POST		NUMBER OF NEW POSTS	SQUARE STEEL (IN)			TUBULAR STEEL Ø (IN)				SIGN FRAME REQUIRED	REMARKS	SIGN DETAIL		
								"A"	"B"	RETAIN	SALVAGE FROM	SALVAGE TO	REMOVE	RETAIN	REMOVE		(LB / FT)			(LB / FT)						DETAIL IN SHS	DETAIL ON SHEET NUMBER	DETAIL ON STD SHEET NUMBER
																	1.75	2.00	2.50	3.00	3.50	4.00	5.00					
KILLINGTON VT 100							FY-FLUORESCENT YELLOW FYG-FLUORESCENT YELLOW GREEN																"SHS"-STANDARD HIGHWAY SIGNS					
			A	W13-1	18	18	FY		2.25																X			
NB	2.735		A	VR-615	30	36			7.50						1		X								6			
NB	2.740		A	VW-054R	30	30		HIDDEN DRIVE RIGHT							1		X											
			A	S3-1	30	30		SCHOOL BUS STOP AHEAD							1													
																												
NB	2.760		A	VW-054R	30	30			6.25						2		X											
			A	S3-1	30	30			6.25														X					
																												
NB	3.275		C	VR-017	24	30									1		X											
			C	VR-017	24	30		LEGAL LOAD LIMIT 24,000 POUNDS	5.00						1		X							E-141				
			C	N/A	N/A	N/A																						
								TOWN NEIGHBORHOOD WATCH SIGN							1		X											
NB	3.285		D	R1-1	30	30																						
			D	R1-1	30	30			6.25						1		X						X					
NB	3.605		A	W1-5R	30	30																						
			A	W13-1	18	18		RIGHT WINDING CURVES							1		X											
								35 MPH PLAQUE							1													
NB	3.643		A	W1-5R	30	30			6.25						1		X						X					
			A	W13-1	18	18			2.25														X					
SIGN SUMMARY SHEET							SHEET TOTALS	42.00	0.00	0	0	0	7	0	0	6	90					PROJECT NAME: Ludlow-Waitsfield VT100						
VERMONT AGENCY OF TRANSPORTATION								SF	SF	EA	EA	EA	EA	EA	EA	EA	FT					PROJECT NUMBER: STPG SIGN(27)						
							TOWN TOTALS	567.0	0.0	28.0	0.0	0.0	114	0.0	0.0	88	1320.0					FILE NAME: Killington.xls	PLOT DATE: 9/8/2009					
																					PROJECT MANAGER: N. Avery	DRAWN BY: I. Shea						
																					DESIGNED BY: J. Kelly	CHECKED BY: N. Avery						
																					KILLINGTON SHEET 7	SHEET 60 OF 204						

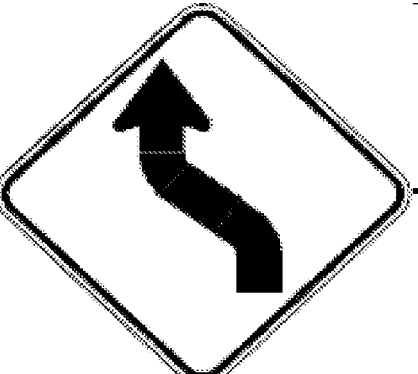




DIRECTION	MILEPOINT	LOCATION CODE (SHEET 2)	SIGN CODE	WIDTH (IN)	HEIGHT (IN)	SHEETING REMARKS	SIGN LEGEND	NEW SIGNS		EXISTING SIGNS				EXIST POST		NUMBER OF NEW POSTS	SQUARE STEEL (IN)			TUBULAR STEEL Ø (IN)				SIGN FRAME REQUIRED	REMARKS	SIGN DETAIL			
								"A"	"B"	RETAIN	SALVAGE FROM	SALVAGE TO	REMOVE	RETAIN	REMOVE		1.75	2.00	2.50	FOUNDATION	3.00	3.50	4.00			5.00	DETAIL IN SHS	DETAIL ON SHEET NUMBER	DETAIL ON STD SHEET NUMBER
																	(LB / FT)				(LB / FT)								
KILLINGTON VT 100							FY-FLUORESCENT YELLOW FYG-FLUORESCENT YELLOW GREEN															"SHS"-STANDARD HIGHWAY SIGNS							
NB	3.890	A	W1-2L	30	30		LEFT CURVE																						
		A	W13-1	18	18		35 MPH PLAQUE																						
																													
NB	3.928						A	W1-2L	30	30			6.25						1			X							
		A	W13-1	18	18			2.25																					
																													
SB	3.575						G	VR-017	24	30									1						X				
		G	VR-017	24	30			5.00						1			X							E-141					
																													
SB	3.570						H	R1-1	30	30									1						X				
		H	R1-1	30	30			6.25						1			X							X					
SB	3.010	F	W1-5L	30	30		LEFT WINDING CURVES																						
		F	W13-1	18	18		35 MPH PLAQUE																						
SB	2.945	F	W1-2McL	30	30		LEFT CURVE WITH RH SIDE ROAD																						
		F	W13-1	18	18		35 MPH PLAQUE																						
SB	2.885	F	VD-062AS	72	16		BUSINESS SIGN																						
																													
SB	2.853						F	VW-205	36	36									1						X				
		F	VW-205	36	36			9.00						2			X							E-154					
SIGN SUMMARY SHEET							SHEET TOTALS		28.75	0.00	1	0	0	9	0	0	5	75						PROJECT NAME: Ludlow-Waitsfield VT100					
							SF	SF	EA	EA	EA	EA	EA	EA	EA	EA	EA	EA	EA	EA	EA	EA	EA	EA	EA	EA	PROJECT NUMBER: STPG SIGN(27)		
VERMONT AGENCY OF TRANSPORTATION							TOWN TOTALS		567.0	0.0	28.0	0.0	0.0	114	0.0	0.0	88	1320.0				FILE NAME: Killington.xls	PLOT DATE: 9/8/2009						
																						PROJECT MANAGER: N. Avery	DRAWN BY: I. Shea						
																						DESIGNED BY: J. Kelly	CHECKED BY: N. Avery						
																						KILLINGTON SHEET 8	SHEET 61 OF 204						


DIRECTION	MILEPOINT	LOCATION CODE (SHEET 2)	SIGN CODE	WIDTH (IN)	HEIGHT (IN)	SHEETING REMARKS	SIGN LEGEND	NEW SIGNS		EXISTING SIGNS				EXIST POST		NUMBER OF NEW POSTS	SQUARE STEEL (IN)			TUBULAR STEEL Ø (IN)				SIGN FRAME REQUIRED	REMARKS	SIGN DETAIL		
								"A"	"B"	RETAIN	SALVAGE FROM	SALVAGE TO	REMOVE	RETAIN	REMOVE		1.75	2.00	2.50	3.00	3.50	4.00	5.00			DETAIL IN SHS	DETAIL ON SHEET NUMBER	DETAIL ON STD SHEET NUMBER
																	(LB / FT)			(LB / FT)								
																	1.88	2.42	3.35	FOUNDATION	7.60	9.00	10.80	14.60				
KILLINGTON VT 100							FY-FLUORESCENT YELLOW FYG-FLUORESCENT YELLOW GREEN																	"SHS"-STANDARD HIGHWAY SIGNS				
SB	2.830	F	W1-2MhL	30	30	FY		6.25							1	X									6			
		F	W13-1	18	18	FY		2.25																X				
SB	2.790	F	W1-6	48	24								1		X													
		E	W1-6	48	24			1																				
		F	W1-6	48	24	FY			8.00						2		X								INSTALL BACK TO BACK ON SAME POSTS	X		
		E	W1-6	48	24	FY			8.00																	X		
SB	2.760	F	W1-6	48	24							1		X														
		E	W1-6	48	24			1																				
		F	W1-6	48	24	FY		8.00						2		X								INSTALL BACK TO BACK ON SAME POSTS	X			
		E	W1-6	48	24	FY		8.00																	X			
SB	2.755	G	VR-017	24	30							1		X										TH-32, COFFEEHOUSE RD				
		G	VR-017	24	30			5.00						1		X										E-141		
SB	2.740	H	R1-1	30	30							1		X										TH-32, COFFEEHOUSE RD				
		H	R1-1	30	30			6.25						1		X									X			
SB	2.665	F	VW-000	30	30							1		X														
SIGN SUMMARY SHEET							SHEET TOTALS	51.75	0.00	0	0	0	7	0	0	7	105						PROJECT NAME: Ludlow-Waitsfield VT100					
								SF	SF	EA	EA	EA	EA	EA	EA	EA	FT						PROJECT NUMBER: STPG SIGN(27)					
VERMONT AGENCY OF TRANSPORTATION							TOWN TOTALS	567.0	0.0	28.0	0.0	0.0	114	0.0	0.0	88	1320.0						FILE NAME: Killington.xls	PLOT DATE: 9/8/2009				
																							PROJECT MANAGER: N. Avery	DRAWN BY: I. Shea				
																							DESIGNED BY: J. Kelly	CHECKED BY: N. Avery				
																							KILLINGTON SHEET 9	SHEET 62 OF 204				



DIRECTION	MILEPOINT	LOCATION CODE (SHEET 2)	SIGN CODE	WIDTH (IN)	HEIGHT (IN)	SHEETING REMARKS	SIGN LEGEND	NEW SIGNS		EXISTING SIGNS				EXIST POST		NUMBER OF NEW POSTS	SQUARE STEEL (IN)			TUBULAR STEEL Ø (IN)				SIGN FRAME REQUIRED	REMARKS	SIGN DETAIL				
								"A"	"B"	RETAIN	SALVAGE FROM	SALVAGE TO	REMOVE	RETAIN	REMOVE		1.75	2.00	2.50	3.00	3.50	4.00	5.00			DETAIL IN SHS	DETAIL ON SHEET NUMBER	DETAIL ON STD SHEET NUMBER		
																	(LB / FT)			(LB / FT)										
KILLINGTON VT 100							FY-FLUORESCENT YELLOW FYG-FLUORESCENT YELLOW GREEN																"SHS"-STANDARD HIGHWAY SIGNS							
			F W7-3A	24	18		 																							
			F VW-000	30	30			6.25											X							E-153				
			F W7-3A	24	18			3.00																X						
SB	2.265		F M3-3S	24	12		SOUTH			1																				
			F M1-5	30	24		VERMONT 100			1																				
SB	2.093		F W2-2MR	30	30		 																							
			F S3-1	30	30																									
			F W2-2MaR	30	30			6.25											X						6					
			F S3-1	30	30		6.25																X							
SB	2.005		G VR-017	24	30																									
			G VR-017	24	30			5.00											X						E-141					
SB	1.995		H R1-1	30	30																									
			H R1-1	30	30			6.25											X					X						
SB	1.390		G VM-607	24	30		43RD INF DIV			1																				
SB	1.260		F W1-5L	30	30																									
SIGN SUMMARY SHEET							SHEET TOTALS	33.00	0.00	3	0	0	6	0	0	5	75													
								SF	SF	EA	EA	EA	EA	EA	EA	EA	EA	EA	EA	EA	EA	EA	EA	EA	EA	EA	EA	EA	EA	EA
							TOWN TOTALS	567.0	0.0	28.0	0.0	0.0	114	0.0	0.0	88	1320.0													
VERMONT AGENCY OF TRANSPORTATION																						PROJECT NAME: Ludlow-Waitsfield VT100								
																						PROJECT NUMBER: STPG SIGN(27)								
																						FILE NAME: Killington.xls	PLOT DATE: 9/8/2009							
																						PROJECT MANAGER: N. Avery	DRAWN BY: I. Shea							
																						DESIGNED BY: J. Kelly	CHECKED BY: N. Avery							
																						KILLINGTON SHEET 10	SHEET 63	OF 204						



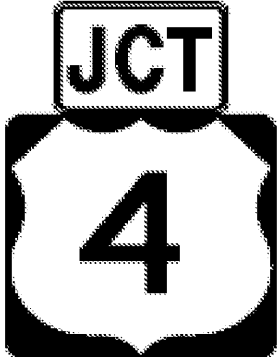

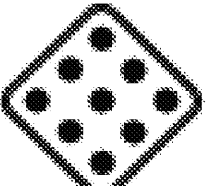
DIRECTION	MILEPOINT	LOCATION CODE (SHEET 2)	SIGN CODE	WIDTH (IN)	HEIGHT (IN)	SHEETING REMARKS	SIGN LEGEND	NEW SIGNS		EXISTING SIGNS				EXIST POST		NUMBER OF NEW POSTS	SQUARE STEEL (IN)			TUBULAR STEEL Ø (IN)				SIGN FRAME REQUIRED	REMARKS	SIGN DETAIL					
								"A"	"B"	RETAIN	SALVAGE FROM	SALVAGE TO	REMOVE	RETAIN	REMOVE		1.75	2.00	2.50	FOUNDATION	3.00	3.50	4.00			5.00	DETAIL IN SHS	DETAIL ON SHEET NUMBER	DETAIL ON STD SHEET NUMBER		
																	(LB / FT)				(LB / FT)										
KILLINGTON VT 100							FY-FLUORESCENT YELLOW FYG-FLUORESCENT YELLOW GREEN																"SHS"-STANDARD HIGHWAY SIGNS								
		F	W13-1	18	18																										
		F	W1-5L	30	30			6.25																				X			
		F	W13-1	18	18			2.25																				X			
SB	1.132	F	W1-4L	30	30			6.25																				X		INSTALL 200 FEET NORTH OF BUSINESS SIGNS	
		F	W13-1	18	18			2.25																				X			
SB	1.170	F	VD-062BRN	72	16		BUSINESS SIGN			1				X																	
		F	VD-062B	72	16		BUSINESS SIGN			1				X																	
SB	1.085	F	W1-10R	30	30										1																
		F	S3-1	30	30										1																
		F	W1-10R	30	30			6.25																				X			
		F	S3-1	30	30			6.25																				X			
SB	1.000	F	VW-054R	30	30		HIDDEN DRIVE RIGHT 								1																
SB	0.955	F	VW-054R	30	30			6.25																							
SB	0.830	F	VW-205	36	36										1																
		F	VW-205	36	36			9.00																							
SIGN SUMMARY SHEET							SHEET TOTALS		44.75	0.00	2	0	0	5	0	0	7	105									PROJECT NAME: Ludlow-Waitsfield VT100				
							SF	SF	EA	EA	EA	EA	EA	EA	EA	EA	EA	EA	EA	EA	EA	EA	EA	EA	EA	EA	EA	EA	EA	PROJECT NUMBER: STPG SIGN(27)	
VERMONT AGENCY OF TRANSPORTATION							TOWN TOTALS		567.0	0.0	28.0	0.0	0.0	114	0.0	0.0	88	1320.0						FILE NAME: Killington.xls PLOT DATE: 9/8/2009							
																								PROJECT MANAGER: N. Avery DRAWN BY: I. Shea							
																								DESIGNED BY: J. Kelly CHECKED BY: N. Avery							
																								KILLINGTON SHEET 11 SHEET 64 OF 204							


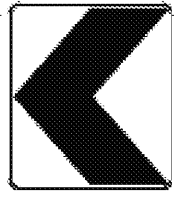
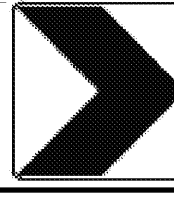
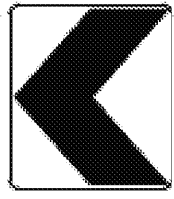
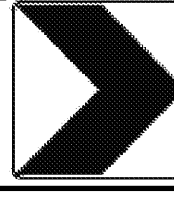
RESET TO SPEC, NEW POSTS 17.33+17.50+0.42
LENGTHEN POST TO MEET SPEC +0.42


DIRECTION	MILEPOINT	LOCATION CODE (SHEET 2)	SIGN CODE	WIDTH (IN)	HEIGHT (IN)	SHEETING REMARKS	SIGN LEGEND	NEW SIGNS		EXISTING SIGNS				EXIST POST		NUMBER OF NEW POSTS	SQUARE STEEL (IN)			TUBULAR STEEL Ø (IN)				SIGN FRAME REQUIRED	REMARKS	SIGN DETAIL																		
								"A"	"B"	RETAIN	SALVAGE FROM	SALVAGE TO	REMOVE	RETAIN	REMOVE		1.75	2.00	2.50	3.00	3.50	4.00	5.00			DETAIL IN SHS	DETAIL ON SHEET NUMBER	DETAIL ON STD SHEET NUMBER																
																	(LB / FT)			(LB / FT)																								
KILLINGTON VT 100							FY-FLUORESCENT YELLOW FYG-FLUORESCENT YELLOW GREEN															"SHS"-STANDARD HIGHWAY SIGNS																						
SB	0.655	F	W11-2YG	30	30		PEDESTRIAN			1																																		
		F	W16-9YG	24	10		AHEAD			1																																		
SB	0.570	F	W11-2YG	30	30		PEDESTRIAN			1																																		
		F	W16-7YG	24	12		DOWN ARROW			1																																		
SB	0.375	F	VD-062BM	72	16		BUSINESS SIGN			1																																		
		F	VD-062M	72	16		BUSINESS SIGN			1																																		
		F	VD-062M	72	16		BUSINESS SIGN			1																																		
SB	0.345	F	VD-062C	74.75	16		TRAVEL INFO SIGN			1																																		
		F	VD-062BC	74.75	16		TRAVEL INFO SIGN			1																																		
SB	0.305	F	M2-1	21	15			2.19							1		X																	INSTALL 200 FEET SOUTH OF TRAVEL INFO SIGN	X									
		F	M1-4	24	24			4.00																										X										
SB	0.290	F	M2-2	48	96		JUNCTION DIAGRAMATICAL SIGN																																					
SB	0.265	F	D1-1A	72	12			6.00																																				
		F	D1-1A	72	12			6.00																																				
		F	D1-1A	72	12			6.00																																				
SIGN SUMMARY SHEET								24.19	0.00	9	0	0	1	0	0	3		45																										
							ALS	SF	SF	EA	EA	EA	EA	EA	EA	EA		FT																										
VERMONT AGENCY OF TRANSPORTATION							TOWN TOTALS	567.0	0.0	28.0	0.0	0.0	114	0.0	0.0	88		1320.0																										
																					PROJECT NAME:	Ludlow-Waitsfield VT100																						
																					PROJECT NUMBER:	STPG SIGN(27)																						
												FILE NAME:	Killington.xls					PLOT DATE:	9/8/2009																									
												PROJECT MANAGER:	N. Avery					DRAWN BY:	I. Shea																									
												DESIGNED BY:	J. Kelly					CHECKED BY:	N. Avery																									
																					KILLINGTON SHEET 12																				SHEET	65	OF	204

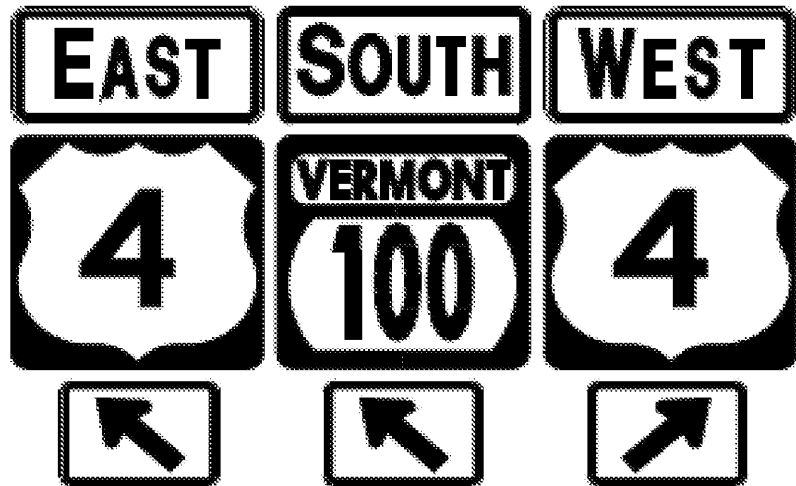
DIRECTION	MILEPOINT	LOCATION CODE (SHEET 2)	SIGN CODE	WIDTH (IN)	HEIGHT (IN)	SHEETING REMARKS	SIGN LEGEND	NEW SIGNS		EXISTING SIGNS				EXIST POST		NUMBER OF NEW POSTS	SQUARE STEEL (IN)			TUBULAR STEEL Ø (IN)				SIGN FRAME REQUIRED	REMARKS	SIGN DETAIL								
								"A"	"B"	RETAIN	SALVAGE FROM	SALVAGE TO	REMOVE	RETAIN	REMOVE		1.75	2.00	2.50	3.00	3.50	4.00	5.00			DETAIL IN SHS	DETAIL ON SHEET NUMBER	DETAIL ON STD SHEET NUMBER						
																	(LB / FT)			(LB / FT)														
																	1.88	2.42	3.35	FOUNDATION	7.60	9.00	10.80						14.60					
KILLINGTON VT 100							FY-FLUORESCENT YELLOW FYG-FLUORESCENT YELLOW GREEN															"SHS"-STANDARD HIGHWAY SIGNS												
			F	D1-1A	72	12		6.00																				5						
SB	0.250		F	VD-018	30	18	KILLINGTON VILLAGE SIGN																											
SB	0.225		F	M3-2	24	12		2.00																										
			F	M1-4	24	24		4.00																										
			F	M6-2L	21	15		2.19																										
			F	M3-3	24	12		2.00																										
			F	M1-5	30	24		5.00																										
			F	M6-2L	21	15		2.19																										
			F	M3-4	24	12		2.00																										
			F	M1-4	24	24		4.00																										
			F	M6-2L	21	15		2.19																										
SB	0.205		F	M3-2	24	12	EAST																											
			F	M1-4	24	24	US ROUTE 4																											
			F	M6-2S	21	15	LEFT ARROW (45 DEGREES)																											
			F	M3-3S	24	12	SOUTH																											
SIGN SUMMARY SHEET							SHEET TOTALS	31.57	0.00	0	0	0	5	0	0	2	30																	
							SF	SF	EA	EA	EA	EA	EA	EA	EA	EA	FT																	
VERMONT AGENCY OF TRANSPORTATION							TOWN TOTALS	567.0	0.0	28.0	0.0	0.0	114	0.0	0.0	88	1320.0																	
																					PROJECT NAME:	Ludlow-Waitsfield VT100												
																					PROJECT NUMBER:	STPG SIGN(27)												
											FILE NAME:	Killington.xls				PLOT DATE:	9/8/2009																	
											PROJECT MANAGER:	N. Avery				DRAWN BY:	I. Shea																	
											DESIGNED BY:	J. Kelly				CHECKED BY:	N. Avery																	
											KILLINGTON SHEET 13	SHEET	66		OF	204																		

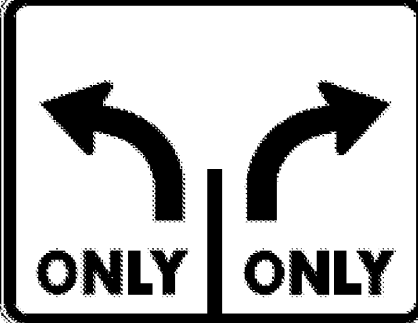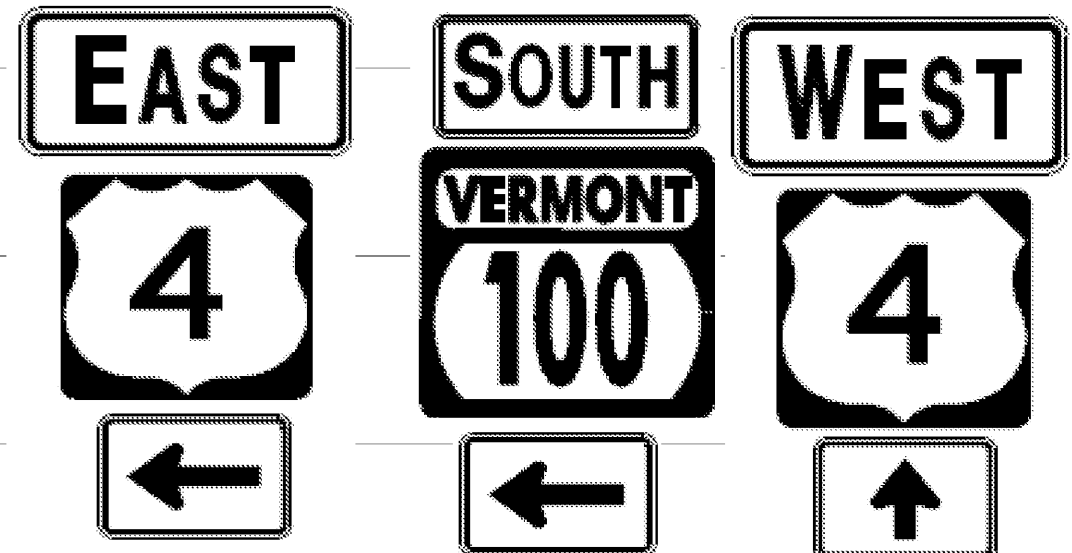
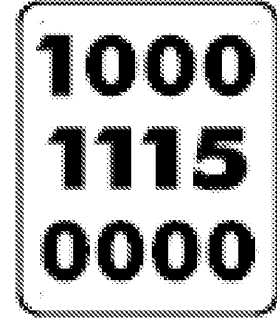
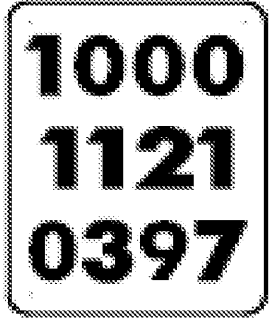

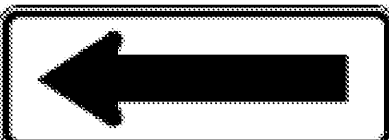
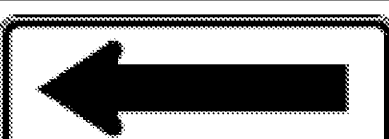
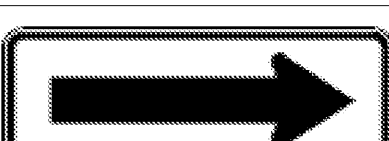
DIRECTION	MILEPOINT	LOCATION CODE (SHEET 2)	SIGN CODE	WIDTH (IN)	HEIGHT (IN)	SHEETING REMARKS	SIGN LEGEND	NEW SIGNS		EXISTING SIGNS				EXIST POST		NUMBER OF NEW POSTS	SQUARE STEEL (IN)			TUBULAR STEEL Ø (IN)				SIGN FRAME REQUIRED	REMARKS	SIGN DETAIL																		
								"A"	"B"	RETAIN	SALVAGE FROM	SALVAGE TO	REMOVE	RETAIN	REMOVE		(LB / FT)			(LB / FT)						DETAIL IN SHS	DETAIL ON SHEET NUMBER	DETAIL ON STD SHEET NUMBER																
																	1.75	2.00	2.50	3.00	3.50	4.00	5.00																					
KILLINGTON VT 100							FY-FLUORESCENT YELLOW FYG-FLUORESCENT YELLOW GREEN																"SHS"-STANDARD HIGHWAY SIGNS																					
			F M1-5	30	24		VERMONT ROUTE 100						1																															
			F M6-2S	21	15		LEFT ARROW (45 DEGREES)						1																															
			F M3-4	24	12		WEST						1																															
			F M1-4	24	24		US ROUTE 4						1																															
			F M6-2	21	15		RIGHT ARROW (45 DEGREES)						1																															
SB	0.185		F VR-925	36	30			7.50								2	X																				INSTALL 80 FEET NORTH OF EXISTING AND AT BEGINNING OF SOLID WHITE LINE			E-145A				
SB	0.170		F VR-925	30	36		LANE ASSIGNMENT SIGN						1	X																														
SB	0.100		F M3-2	24	12			2.00								2	X						#3B														INSTALL AT BREAK IN CENTERLINE	X						
			F M1-4	24	24			4.00																														BLACK ON WHITE SHEETING	X					
			F M6-1L	21	15			2.19																														BLACK ON WHITE SHEETING	X					
			F M3-3	24	12			2.00																														GREEN ON WHITE SHEETING	X					
			F M1-5	30	24			5.00																															GREEN ON WHITE SHEETING			E-136B		
			F M6-1L	21	15			2.19																														GREEN ON WHITE SHEETING	X					
			F M3-4	24	12			2.00																														GREEN ON WHITE SHEETING	X					
			F M1-4	24	24			4.00																														BLACK ON WHITE SHEETING	X					
SIGN SUMMARY SHEET							SHEET TOTALS		30.88	0.00	0	0	0	6	0	0	4	60																						PROJECT NAME: Ludlow-Waitsfield VT100				
									SF	SF	EA	EA	EA	EA	EA	EA	EA	FT																						PROJECT NUMBER: STPG SIGN(27)				
VERMONT AGENCY OF TRANSPORTATION							TOWN TOTALS		567.0	0.0	28.0	0.0	0.0	114	0.0	0.0	88	1320.0																						FILE NAME: Killington.xls	PLOT DATE: 9/8/2009			
																																								PROJECT MANAGER: N. Avery	DRAWN BY: I. Shea			
																																								DESIGNED BY: J. Kelly	CHECKED BY: N. Avery			
																																									KILLINGTON SHEET 14	SHEET 67 OF 204		

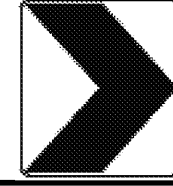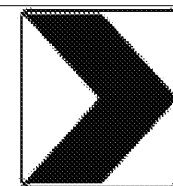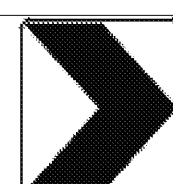
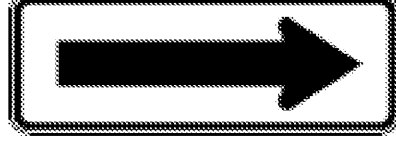
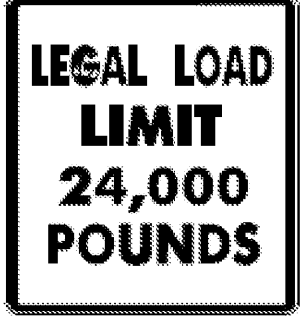


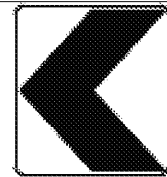

DIRECTION	MILEPOINT	LOCATION CODE (SHEET 2)	SIGN CODE	WIDTH (IN)	HEIGHT (IN)	SHEETING REMARKS	SIGN LEGEND	NEW SIGNS		EXISTING SIGNS				EXIST POST		NUMBER OF NEW POSTS	SQUARE STEEL (IN)			TUBULAR STEEL Ø (IN)				SIGN FRAME REQUIRED	REMARKS	SIGN DETAIL				
								"A"	"B"	RETAIN	SALVAGE FROM	SALVAGE TO	REMOVE	RETAIN	REMOVE		1.75	2.00	2.50	3.00	3.50	4.00	5.00			DETAIL IN SHS	DETAIL ON SHEET NUMBER	DETAIL ON STD SHEET NUMBER		
																	(LB / FT)			(LB / FT)										
KILLINGTON VT 100							FY-FLUORESCENT YELLOW FYG-FLUORESCENT YELLOW GREEN																"SHS"-STANDARD HIGHWAY SIGNS							
			F M6-3	21	15			2.19																BLACK ON WHITE SHEETING	X					
SB	0.090		E W1-8	18	24								1		X															
			E W1-8	24	30	FY		5.00						1		X									X					
SB	0.085		E W1-8	18	24								1		X															
SB	0.075		E W1-8	18	24								1		X															
			E W1-8	24	30	FY		5.00						1		X									X					
SB	0.065		E W1-8	18	24								1		X															
SB	0.060		E W1-8	18	24								1		X															
			E W1-8	24	30	FY		5.00						1		X									X					
SB	0.055		E W1-8	18	24								1		X															
SB	0.045		F R1-1	30	30								1		X									JCT OF US-4 EAST & VT-100 SOUTH						
			F R1-1	30	30			6.25						1		X									X					
VT ROUTE 100 JOINS US ROUTE 4																														
NB	0.020		A OM1-1	18	18								1		X															
			A OM1-1	18	18			2.25						1		X									INSTALL NEW AT 4 FEET HT.	X				
SIGN SUMMARY SHEET							SHEET TOTALS		25.69	0.00	0	0	0	8	0	0	5	75												
VERMONT AGENCY OF TRANSPORTATION							SF	SF	EA	EA	EA	EA	EA	EA	EA	EA	EA	EA	FT											
							TOWN TOTALS		567.0	0.0	28.0	0.0	0.0	114	0.0	0.0	88	1320.0												
							PROJECT NAME: Ludlow-Waitsfield VT100															PROJECT NUMBER: STPG SIGN(27)			FILE NAME: Killington.xls			PLOT DATE: 9/8/2009		
																						DESIGNED BY: J. Kelly			DRAWN BY: I. Shea			CHECKED BY: N. Avery		
																						KILLINGTON SHEET 15			SHEET 68 OF 204					

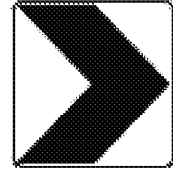

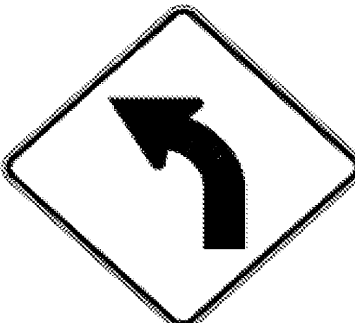
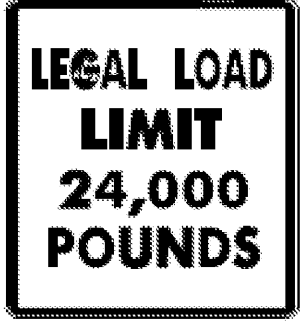

DIRECTION	MILEPOINT	LOCATION CODE (SHEET 2)	SIGN CODE	WIDTH (IN)	HEIGHT (IN)	SHEETING REMARKS	SIGN LEGEND	NEW SIGNS		EXISTING SIGNS				EXIST POST		NUMBER OF NEW POSTS	SQUARE STEEL (IN)			TUBULAR STEEL Ø (IN)				SIGN FRAME REQUIRED	REMARKS	SIGN DETAIL		
								"A"	"B"	RETAIN	SALVAGE FROM	SALVAGE TO	REMOVE	RETAIN	REMOVE		1.75	2.00	2.50	3.00	3.50	4.00	5.00			DETAIL IN SHS	DETAIL ON SHEET NUMBER	DETAIL ON STD SHEET NUMBER
																	(LB / FT)			(LB / FT)								
KILLINGTON VT 100							FY-FLUORESCENT YELLOW FYG-FLUORESCENT YELLOW GREEN															"SHS"-STANDARD HIGHWAY SIGNS						
NB	0.020	A	M3-1S	24	12																							
		A	M1-5	30	24																							
		A	M6-2S	21	15		←←← LEFT (45 DEG DOWN)																					
		A	M3-1S	24	12																							
		A	M1-5	30	24																					E-136B		
		A	M6-1L	21	15																							
NB	0.025	A	W1-8	18	24		CHEVRON																					
NB	0.030	A	W1-8	18	24																							
		A	W1-8	24	30	FY																				INSTALL ON SEPARATE POSTS AND ANGLED TOWARDS TRAFFIC		
		B	W1-8	24	30	FY																						
NB	0.035	A	W1-8	18	24		CHEVRON																					
NB	0.045	A	W1-8	18	24																							
		A	W1-8	24	30	FY																				INSTALL ON SEPARATE POSTS AND ANGLED TOWARDS TRAFFIC		
		B	W1-8	24	30	FY																						
NB	0.050	B	D1-1A	72	10		DESTINATION BOARD																			ASSEMBLY IS LOCATED IN "Y" OF VT 100 & US RT 4 INTERSECTION		
SIGN SUMMARY SHEET							SHEET TOTALS		29.19	0.00	0	0	0	8	0	0	5	75	PROJECT NAME: Ludlow-Waitsfield VT100									
VERMONT AGENCY OF TRANSPORTATION							SF	SF	EA	EA	EA	EA	EA	EA	EA	EA	EA	EA	FT	PROJECT NUMBER: STPG SIGN(27)								
							TOWN TOTALS		567.0	0.0	28.0	0.0	0.0	114	0.0	0.0	88	1320.0	FILE NAME: Killington.xls PLOT DATE: 9/8/2009									
																			PROJECT MANAGER: N. Avery DRAWN BY: I. Shea									
																			DESIGNED BY: J. Kelly CHECKED BY: N. Avery									
																			KILLINGTON SHEET 16 SHEET 69 OF 204									


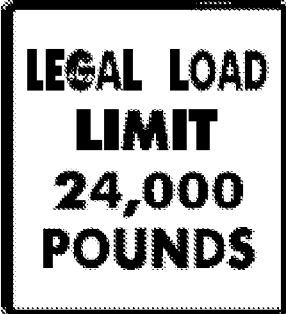






DIRECTION	MILEPOINT	LOCATION CODE (SHEET 2)	SIGN CODE	WIDTH (IN)	HEIGHT (IN)	SHEETING REMARKS	SIGN LEGEND	NEW SIGNS		EXISTING SIGNS				EXIST POST		NUMBER OF NEW POSTS	SQUARE STEEL (IN)			TUBULAR STEEL Ø (IN)				SIGN FRAME REQUIRED	REMARKS	SIGN DETAIL						
								"A"	"B"	RETAIN	SALVAGE FROM	SALVAGE TO	REMOVE	RETAIN	REMOVE		1.75	2.00	2.50	3.00	3.50	4.00	5.00			DETAIL IN SHS	DETAIL ON SHEET NUMBER	DETAIL ON STD SHEET NUMBER				
																	(LB / FT)			(LB / FT)												
KILLINGTON VT 100							FY-FLUORESCENT YELLOW FYG-FLUORESCENT YELLOW GREEN																"SHS"-STANDARD HIGHWAY SIGNS									
			B	D1-1A	72	10	DESTINATION BOARD																									
			B	D1-1A	72	10	DESTINATION BOARD																									
			B	D1-1A	72	10	DESTINATION BOARD																									
			B	M3-2	24	12	EAST																									
			B	M1-4	24	24	US 4																									
			B	M6-1	21	15	<--LEFT																									
			B	M3-3	24	12	SOUTH																									
			B	M1-5A	24	24	VT 100																									
			B	M6-1	21	15	<---LEFT																									
			B	M3-4	24	12	WEST																									
			B	M1-4	24	24	US 4																									
			B	M6-1	21	15	RIGHT --->																									
NB	0.055		A	W1-8	18	24	CHEVRON																									
NB	0.060		A	W1-8	18	24																										
			A	W1-8	24	30	FY 	5.00							1			X														
SIGN SUMMARY SHEET							SHEET TOTALS	5.00	0.00	0	0	0	14	0	0	1		15														
								SF	SF	EA	EA	EA	EA	EA	EA	EA		FT														
VERMONT AGENCY OF TRANSPORTATION							TOWN TOTALS	567.0	0.0	28.0	0.0	0.0	114	0.0	0.0	88		1320.0														
															PROJECT NAME:	Ludlow-Waitsfield VT100																
															PROJECT NUMBER:	STPG SIGN(27)																
															FILE NAME:	Killington.xls						PLOT DATE:	9/8/2009									
															PROJECT MANAGER:	N. Avery						DRAWN BY:	I. Shea									
															DESIGNED BY:	J. Kelly						CHECKED BY:	N. Avery									
															KILLINGTON SHEET 17													SHEET	70	OF	204	



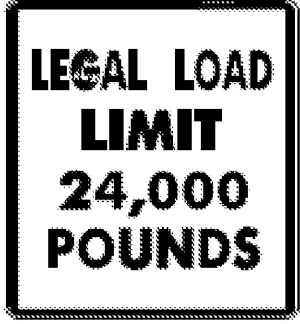

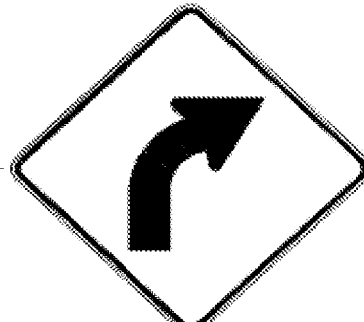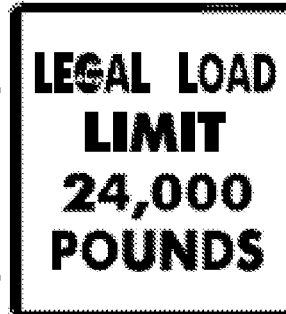


DIRECTION	MILEPOINT	LOCATION CODE (SHEET 2)	SIGN CODE	WIDTH (IN)	HEIGHT (IN)	SHEETING REMARKS	SIGN LEGEND	NEW SIGNS		EXISTING SIGNS				EXIST POST		NUMBER OF NEW POSTS	SQUARE STEEL (IN)			TUBULAR STEEL Ø (IN)				SIGN FRAME REQUIRED	REMARKS	SIGN DETAIL		
								"A"	"B"	RETAIN	SALVAGE FROM	SALVAGE TO	REMOVE	RETAIN	REMOVE		(LB / FT)			(LB / FT)						DETAIL IN SHS	DETAIL ON SHEET NUMBER	DETAIL ON STD SHEET NUMBER
																	1.75	2.00	2.50	3.00	3.50	4.00	5.00					
																	1.88	2.42	3.35	FOUNDATION	7.60	9.00	10.80					
KILLINGTON VT 100		FY-FLUORESCENT YELLOW FYG-FLUORESCENT YELLOW GREEN				5.00									1	X						"SHS"-STANDARD HIGHWAY SIGNS	X					
	B	W1-8	24			30	FY																					
SIGN SUMMARY SHEET							SHEET TOTALS		5.00	0.00	0	0	0	0	0	0	1	15				PROJECT NAME: Ludlow-Waitsfield VT100						
VERMONT AGENCY OF TRANSPORTATION							SF	SF		EA	EA	EA	EA	EA	EA	EA	EA	EA	FT				PROJECT NUMBER: STPG SIGN(27)					
							TOWN TOTALS		567.0	0.0	28.0	0.0	0.0	114	0.0	0.0	88	1320.0				FILE NAME: Killington.xls	PLOT DATE: 9/8/2009					
																					PROJECT MANAGER: N. Avery	DRAWN BY: I. Shea						
																					DESIGNED BY: J. Kelly	CHECKED BY: N. Avery						
																					KILLINGTON SHEET 18	SHEET 71	OF 204					





DIRECTION	MILEPOINT	LOCATION CODE (SHEET 2)	SIGN CODE	WIDTH (IN)	HEIGHT (IN)	SHEETING REMARKS	SIGN LEGEND	NEW SIGNS		EXISTING SIGNS				EXIST POST		NUMBER OF NEW POSTS	SQUARE STEEL (IN)			TUBULAR STEEL Ø (IN)				SIGN FRAME REQUIRED	REMARKS	SIGN DETAIL		
								"A"	"B"	RETAIN	SALVAGE FROM	SALVAGE TO	REMOVE	RETAIN	REMOVE		1.75	2.00	2.50	3.00	3.50	4.00	5.00			DETAIL IN SHS	DETAIL ON SHEET NUMBER	DETAIL ON STD SHEET NUMBER
																	(LB / FT)			(LB / FT)								
PITTSFIELD VT 100							FY-FLUORESCENT YELLOW FYG-FLUORESCENT YELLOW GREEN															"SHS"-STANDARD HIGHWAY SIGNS						
NB	0.000	C	VD-024	60	7.5																							
		C	VD-024	72	10			5.00																4				
		C	VD-700	6	10			0.42															INSTALL BELOW PITTSFIELD		E-138			
		C	VD-700	6	10			0.42															INSTALL BELOW KILLINGTON		E-138			
NB	0.140	B	W1-6	48	24																							
		B	OM1-1	18	18		CLUSTER																					
		B	W1-6	48	24	FY		8.00															X					
NB	0.160	A	W1-6	48	24																							
		A	OM1-1	18	18		CLUSTER																					
		A	W1-6	48	24	FY		8.00															X					
NB	0.410	A	W1-6	48	24																							
		B	W1-6	48	24																							
		A	W1-6	48	24	FY		8.00															INSTALL BACK TO BACK	X				
		B	W1-6	48	24	FY		8.00																X				
SIGN SUMMARY SHEET							SHEET TOTALS	37.84	0.00	0	0	0	7	0	0	8	120							PROJECT NAME: Ludlow-Waitsfield VT100				
								SF	SF	EA	EA	EA	EA	EA	EA	EA	FT							PROJECT NUMBER: STPG SIGN(27)				
VERMONT AGENCY OF TRANSPORTATION							TOWN TOTALS	297.1	0.0	15.0	1.0	1.0	51	0.0	0.0	52	780.0							FILE NAME: Pittsfield.xls	PLOT DATE: 9/9/2009			
																								PROJECT MANAGER: N. Avery	DRAWN BY: I. Shea			
																								DESIGNED BY: J. Kelly	CHECKED BY: N. Avery			
																								PITTSFIELD SHEET 1	SHEET 72 OF 204			








DIRECTION	MILEPOINT	LOCATION CODE (SHEET 2)	SIGN CODE	WIDTH (IN)	HEIGHT (IN)	SHEETING REMARKS	SIGN LEGEND	NEW SIGNS		EXISTING SIGNS				EXIST POST		NUMBER OF NEW POSTS	SQUARE STEEL (IN)			TUBULAR STEEL Ø (IN)				SIGN FRAME REQUIRED	REMARKS	SIGN DETAIL		
								"A"	"B"	RETAIN	SALVAGE FROM	SALVAGE TO	REMOVE	RETAIN	REMOVE		1.75	2.00	2.50	3.00	3.50	4.00	5.00			DETAIL IN SHS	DETAIL ON SHEET NUMBER	DETAIL ON STD SHEET NUMBER
																	(LB / FT)			(LB / FT)								
PITTSFIELD VT 100							FY-FLUORESCENT YELLOW FYG-FLUORESCENT YELLOW GREEN															"SHS"-STANDARD HIGHWAY SIGNS						
NB	0.440	A	W1-6	48	24		 																					
		B	W1-6	48	24																							
		A	W1-6	48	24	FY		8.00								X								INSTALL BACK TO BACK	X			
		B	W1-6	48	24	FY		8.00																	X			
NB	1.378	C	VR-017	24	24																							
		C	VR-017	24	30			5.00								X											E-141	
NB	1.384	D	R1-1	30	30																							
		D	R1-1	30	30			6.25								X								TH-16, SOUTH HILL RD REINSTALL STREET SIGN ABOVE NEW SIGN.	X			
NB	2.411	A	VW-202	30	30																							
		A	VW-202	30	30			6.25								X											E-154	
NB	2.573	A	S3-1	30	30		SCHOOL BUS STOP AHEAD				1					X												
NB	3.167	A	W3-5	36	36																							
		A	W3-5	36	36			9.00								X									X			
NB	3.205	A	VD-018	30	18																							
		A	VD-018	30	18			3.75								X											E-128B	
SIGN SUMMARY SHEET							SHEET TOTALS	46.25	0.00	1	0	0	7	0	0	8	120						PROJECT NAME: Ludlow-Waitsfield VT100					
								SF	SF	EA	EA	EA	EA	EA	EA	EA	FT					PROJECT NUMBER: STPG SIGN(27)						
VERMONT AGENCY OF TRANSPORTATION							TOWN TOTALS	297.1	0.0	15.0	1.0	1.0	51	0.0	0.0	52	780.0					FILE NAME: Pittsfield.xls	PLOT DATE: 9/9/2009					
																					PROJECT MANAGER: N. Avery	DRAWN BY: I. Shea						
																					DESIGNED BY: J. Kelly	CHECKED BY: N. Avery						
																					PITTSFIELD SHEET 2	SHEET 73	OF 204					

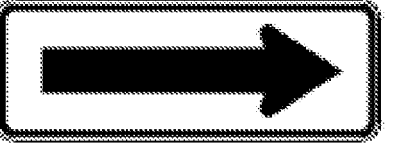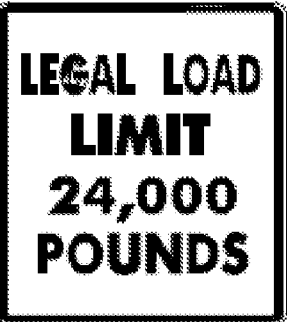


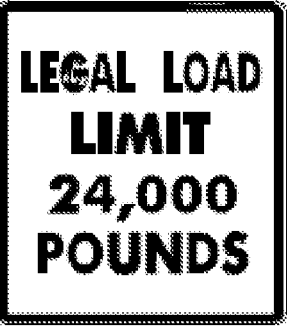


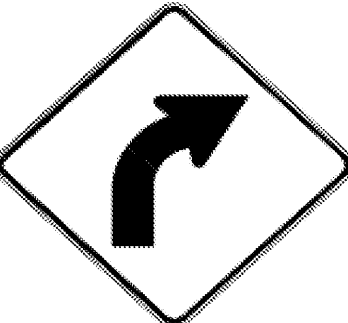
DIRECTION	MILEPOINT	LOCATION CODE (SHEET 2)	SIGN CODE	WIDTH (IN)	HEIGHT (IN)	SHEETING REMARKS	SIGN LEGEND	NEW SIGNS		EXISTING SIGNS				EXIST POST		NUMBER OF NEW POSTS	SQUARE STEEL (IN)			TUBULAR STEEL Ø (IN)				SIGN FRAME REQUIRED	REMARKS	SIGN DETAIL								
								"A"	"B"	RETAIN	SALVAGE FROM	SALVAGE TO	REMOVE	RETAIN	REMOVE		1.75	2.00	2.50	3.00	3.50	4.00	5.00			DETAIL IN SHS	DETAIL ON SHEET NUMBER	DETAIL ON STD SHEET NUMBER						
																	(LB / FT)			(LB / FT)														
PITTSFIELD VT 100							FY-FLUORESCENT YELLOW FYG-FLUORESCENT YELLOW GREEN																"SHS"-STANDARD HIGHWAY SIGNS											
NB	3.242	A	R2-1	30	36		SPEED LIMIT 40			1																								
NB	3.250	C	VR-017	24	24																													
		C	VR-017	24	30			5.00																						E-141				
NB	3.255	D	R1-1	30	30																													
		D	R1-1	30	30			6.25																			X							
NB	3.436	A	VD-062AS	72	16		BUSINESS SIGN			1																								
NB	3.470	A	R2-1	30	36		SPEED LIMIT 35			1																								
NB	3.551	A	W1-2L	30	30																													
		A	W1-2L	30	30			6.25																		X								
NB	3.561	C	VR-017	24	30																													
		C	VR-017	24	30			5.00																					E-141					
NB	3.568	D	R1-1	30	30																													
		D	R1-1	30	30			6.25																		X								
NB	3.620	A	R2-1	24	30		SPEED LIMIT 35			1																								
NB	3.715	A	VD-062B	72	16		BUSINESS SIGN			1																								
SIGN SUMMARY SHEET							SHEET TOTALS		28.75	0.00	5	0	0	5	0	0	5	75																
							SF	SF	EA	EA	EA	EA	EA	EA	EA	EA	EA	EA	EA	EA	EA	EA	EA	EA	EA	EA	EA	EA	EA	EA	EA	EA	EA	EA
							TOWN TOTALS		297.1	0.0	15.0	1.0	1.0	51	0.0	0.0	52	780.0																
VERMONT AGENCY OF TRANSPORTATION																						PROJECT NAME: Ludlow-Waitsfield VT100												
																						PROJECT NUMBER: STPG SIGN(27)												
																						FILE NAME: Pittsfield.xls	PLOT DATE: 9/9/2009											
																						PROJECT MANAGER: N. Avery	DRAWN BY: I. Shea											
																						DESIGNED BY: J. Kelly	CHECKED BY: N. Avery											
																						PITTSFIELD SHEET 3	SHEET 74 OF 204											







DIRECTION	MILEPOINT	LOCATION CODE (SHEET 2)	SIGN CODE	WIDTH (IN)	HEIGHT (IN)	SHEETING REMARKS	SIGN LEGEND	NEW SIGNS		EXISTING SIGNS				EXIST POST		NUMBER OF NEW POSTS	SQUARE STEEL (IN)			TUBULAR STEEL Ø (IN)				SIGN FRAME REQUIRED	REMARKS	SIGN DETAIL			
								"A"	"B"	RETAIN	SALVAGE FROM	SALVAGE TO	REMOVE	RETAIN	REMOVE		1.75	2.00	2.50	FOUNDATION	3.00	3.50	4.00			5.00	DETAIL IN SHS	DETAIL ON SHEET NUMBER	DETAIL ON STD SHEET NUMBER
																	(LB / FT)				(LB / FT)								
PITTSFIELD VT 100							FY-FLUORESCENT YELLOW FYG-FLUORESCENT YELLOW GREEN															"SHS"-STANDARD HIGHWAY SIGNS							
NB	3.780	A	R2-1	24	30		 	5.00							1		X												
NB	3.790	C	VR-017	24	30			5.00							1		X							TH-7, VILLAGE GREEN (SOUTH) INSTALL 20 FEET FROM VT-100			E-141		
NB	3.790	D	R1-1	30	30								1			X								TH-7, VILLAGE GREEN (SOUTH) SIGN AND POST ARE IN ISLAND					
		D	R1-1	30	30			6.25						1		X							X						
NB	3.790	A	R2-1	24	30		SPEED LIMIT 35										X												
NB	3.800	D	R1-1	30	30								1			X								TH-7, VILLAGE GREEN (SOUTH)					
		D	R1-1	30	30			6.25						1		X							X	REINSTALL STREET SIGN ABOVE NEW SIGN.					
NB	3.900	A	W1-2R	30	30								1			X													
		A	W1-2R	30	30			6.25						1		X							X						
NB	3.929	C	VR-017	24	30			5.00							1		X							INSTALL 20 FEET FROM VT-100			E-141		
NB	3.930	D	R1-1	30	30								1			X								TH-7, VILLAGE GREEN (NORTH)					
		D	R1-1	30	30			6.25						1		X							X	ON ISLAND					
NB	3.932	D	R1-1	30	30								1			X								TH-7, VILLAGE GREEN (NORTH)					
		D	R1-1	30	30			6.25						1		X							X						
NB	4.090	A	R2-1	24	30		SPEED LIMIT 40									X													
SIGN SUMMARY SHEET							SHEET TOTALS	46.25	0.00	1	0	0	6	0	0	8		120						PROJECT NAME: Ludlow-Waitsfield VT100					
								SF	SF	EA	EA	EA	EA	EA	EA	EA		FT					PROJECT NUMBER: STPG SIGN(27)						
VERMONT AGENCY OF TRANSPORTATION							TOWN TOTALS	297.1	0.0	15.0	1.0	1.0	51	0.0	0.0	52		780.0					FILE NAME: Pittsfield.xls	PLOT DATE: 9/9/2009					
																						PROJECT MANAGER: N. Avery	DRAWN BY: I. Shea						
																						DESIGNED BY: J. Kelly	CHECKED BY: N. Avery						
																						PITTSFIELD SHEET 4	SHEET 75 OF 204						



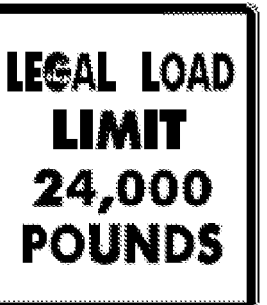

DIRECTION	MILEPOINT	LOCATION CODE (SHEET 2)	SIGN CODE	WIDTH (IN)	HEIGHT (IN)	SHEETING REMARKS	SIGN LEGEND	NEW SIGNS		EXISTING SIGNS				EXIST POST		NUMBER OF NEW POSTS	SQUARE STEEL (IN)			TUBULAR STEEL Ø (IN)				SIGN FRAME REQUIRED	REMARKS	SIGN DETAIL		
								"A"	"B"	RETAIN	SALVAGE FROM	SALVAGE TO	REMOVE	RETAIN	REMOVE		(LB / FT)			(LB / FT)						DETAIL IN SHS	DETAIL ON SHEET NUMBER	DETAIL ON STD SHEET NUMBER
																	1.75	2.00	2.50	3.00	3.50	4.00	5.00					
PITTSFIELD VT 100							FY-FLUORESCENT YELLOW FYG-FLUORESCENT YELLOW GREEN																"SHS"-STANDARD HIGHWAY SIGNS					
NB	4.298	A	R2-1	24	30																							
		A	R2-1	24	30			5.00																	X			
NB	4.640	A	W1-4R	30	30		RIGHT REVERSE CURVE																					
		A	W13-1	18	18		45 MPH PLAQUE																					
NB	4.685	A	VW-060	30	30		HIDDEN DRIVES																					
NB	4.730	A	S3-1	30	30		SCHOOL BUS STOP AHEAD																					
																												
NB	4.735	A	VW-060	30	30			6.25																		E-154		
		A	S3-1	30	30			6.25																	X			
NB	4.775	A	W1-4R	30	30			6.25																				
		A	W13-1	18	18			2.25																	X			
SB	4.787	G	VR-017	24	30																							
		G	VR-017	24	30			5.00																		TH-2, LIBERTY HILL RD		
SB	4.780	H	R1-1	30	30																							
		H	R1-1	30	30			6.25																	X	TH-2, LIBERTY HILL RD		
SB	4.380	F	W3-5	36	36		SPEED REDUCTION (40)																					
SIGN SUMMARY SHEET							SHEET TOTALS		37.25	0.00	1	0	0	7	0	0	6	90					PROJECT NAME: Ludlow-Waitsfield VT100					
							SF	SF	EA	EA	EA	EA	EA	EA	EA	EA	EA	FT					PROJECT NUMBER: STPG SIGN(27)					
VERMONT AGENCY OF TRANSPORTATION							TOWN TOTALS		297.1	0.0	15.0	1.0	1.0	51	0.0	0.0	52	780.0					FILE NAME: Pittsfield.xls					
																							PLOT DATE: 9/9/2009					
																							DRAWN BY: I. Shea					
																							DESIGNED BY: J. Kelly					
																							CHECKED BY: N. Avery					
																							SHEET 76 OF 204					

DIRECTION	MILEPOINT	LOCATION CODE (SHEET 2)	SIGN CODE	WIDTH (IN)	HEIGHT (IN)	SHEETING REMARKS	SIGN LEGEND	NEW SIGNS		EXISTING SIGNS				EXIST POST		NUMBER OF NEW POSTS	SQUARE STEEL (IN)			TUBULAR STEEL Ø (IN)				SIGN FRAME REQUIRED	REMARKS	SIGN DETAIL			
								"A"	"B"	RETAIN	SALVAGE FROM	SALVAGE TO	REMOVE	RETAIN	REMOVE		1.75	2.00	2.50	FOUNDATION	3.00	3.50	4.00			5.00	DETAIL IN SHS	DETAIL ON SHEET NUMBER	DETAIL ON STD SHEET NUMBER
																	(LB / FT)				(LB / FT)								
PITTSFIELD VT 100							FY-FLUORESCENT YELLOW FYG-FLUORESCENT YELLOW GREEN																"SHS"-STANDARD HIGHWAY SIGNS						
SB	4.345	F	VD-018	30	18																								
		F	VD-018	30	18			3.75							1											8			
SB	4.298	F	R2-1	30	36		SPEED LIMIT 40			1																			
SB	4.210	F	VD-062B	72	16		BUSINESS SIGN			1																			
SB	4.145	F	D9-1	24	30		PHONE SYMBOL					1																	
SB	4.090	F	R2-1	30	36		SPEED LIMIT 35			1																			
SB	4.050	F	W1-2L	30	30		LEFT CURVE			1																			
SB	4.005	F	W1-6	48	24							1																	
		F	W1-6	48	24			8.00							2+												NEEDS TWO POSTS, NOT ONE	X	
SB	3.995	E	W1-6	48	24							1																	
		E	W1-6	48	24			8.00							2+												NEEDS TWO POSTS, NOT ONE	X	
SB	3.989	G	VR-017	24	24							1														TH-1, UPPER MICHIGAN RD			
		G	VR-017	24	30			5.00							1													E-141	
		G		24	30						1	1															REINSTALL TOWN'S SIGN BELOW NEW LEGAL LOAD		
SB	3.982	H	R1-1	30	30							1														TH-1, UPPER MICHIGAN RD			
SIGN SUMMARY SHEET							SHEET TOTALS	24.75	0.00	4	1	1	6	0	0	4	60							PROJECT NAME: Ludlow-Waitsfield VT100					
								SF	SF	EA	EA	EA	EA	EA	EA	EA	EA	EA	EA	EA	EA	EA	EA	EA	EA	EA	EA	PROJECT NUMBER: STPG SIGN(27)	
VERMONT AGENCY OF TRANSPORTATION							TOWN TOTALS	297.1	0.0	15.0	1.0	1.0	51	0.0	0.0	52	780.0							FILE NAME: Pittsfield.xls					
																												PLOT DATE: 9/9/2009	
																						PROJECT MANAGER: N. Avery							
																							DRAWN BY: I. Shea						
																							DESIGNED BY: J. Kelly						
																							CHECKED BY: N. Avery						
																							SHEET 77 OF 204						

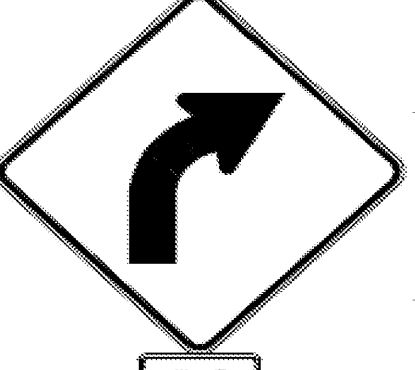DIRECTION	MILEPOINT	LOCATION CODE (SHEET 2)	SIGN CODE	WIDTH (IN)	HEIGHT (IN)	SHEETING REMARKS	SIGN LEGEND	NEW SIGNS		EXISTING SIGNS				EXIST POST		NUMBER OF NEW POSTS	SQUARE STEEL (IN)			TUBULAR STEEL Ø (IN)				SIGN FRAME REQUIRED	REMARKS	SIGN DETAIL		
								"A"	"B"	RETAIN	SALVAGE FROM	SALVAGE TO	REMOVE	RETAIN	REMOVE		1.75	2.00	2.50	3.00	3.50	4.00	5.00			DETAIL IN SHS	DETAIL ON SHEET NUMBER	DETAIL ON STD SHEET NUMBER
																	(LB / FT)			(LB / FT)								
PITTSFIELD VT 100							FY-FLUORESCENT YELLOW FYG-FLUORESCENT YELLOW GREEN															"SHS"-STANDARD HIGHWAY SIGNS						
			H R1-1	30	30			6.25							1	X								X				
SB	3.870	F	R2-1	24	30								1		X													
		F	R2-1	24	30			5.00							1	X								X				
SB	3.800	F	W1-2R	30	30		RIGHT CURVE 						1		X													
SB	3.772	F	W1-2R	30	30			6.25							1	X								X	INSTALL 150 FEET SOUTH OF EXISTING RIGHT CURVE SIGN			
SB	3.716	F	R2-1	24	30		SPEED LIMIT 35			1				X														
SB	3.618	G	VR-017	24	30								1		X										TH-6, LOWER MICHIGAN RD			
		G	VR-017	24	30			5.00							1	X									E-141			
SB	3.612	H	R1-1	30	30								1		X										TH-6, LOWER MICHIGAN RD			
		H	R1-1	30	30			6.25							1	X								X				
SB	3.470	F	R2-1	24	30								1		X													
		F	R2-1	24	30			5.00							1	X								X				
SB	3.242	F	R2-1	24	30								1		X													
		F	R2-1	24	30			5.00							1	X								X				
SB	2.780	F	S3-1	30	30		SCHOOL BUS STOP AHEAD			1				X														
SIGN SUMMARY SHEET							SHEET TOTALS	38.75	0.00	2	0	0	6	0	0	7	105							PROJECT NAME: Ludlow-Waitsfield VT100				
								SF	SF	EA	EA	EA	EA	EA	EA	EA	FT							PROJECT NUMBER: STPG SIGN(27)				
VERMONT AGENCY OF TRANSPORTATION							TOWN TOTALS	297.1	0.0	15.0	1.0	1.0	51	0.0	0.0	52	780.0							FILE NAME: Pittsfield.xls	PLOT DATE: 9/9/2009			
																								PROJECT MANAGER: N. Avery	DRAWN BY: I. Shea			
																								DESIGNED BY: J. Kelly	CHECKED BY: N. Avery			
																								PITTSFIELD SHEET 7	SHEET 78	OF 204		

DIRECTION	MILEPOINT	LOCATION CODE (SHEET 2)	SIGN CODE	WIDTH (IN)	HEIGHT (IN)	SHEETING REMARKS	SIGN LEGEND	NEW SIGNS		EXISTING SIGNS				EXIST POST		NUMBER OF NEW POSTS	SQUARE STEEL (IN)			TUBULAR STEEL Ø (IN)				SIGN FRAME REQUIRED	REMARKS	SIGN DETAIL			
								"A"	"B"	RETAIN	SALVAGE FROM	SALVAGE TO	REMOVE	RETAIN	REMOVE		1.75	2.00	2.50	FOUNDATION	3.00	3.50	4.00			5.00	DETAIL IN SHS	DETAIL ON SHEET NUMBER	DETAIL ON STD SHEET NUMBER
																	(LB / FT)				(LB / FT)								
PITTSFIELD VT 100							FY-FLUORESCENT YELLOW FYG-FLUORESCENT YELLOW GREEN															"SHS"-STANDARD HIGHWAY SIGNS							
SB	2.705	H	R1-1	30	30																			TH-4, TOWNSHEND BROOK RD (NORTH)					
		H	R1-1	30	30			6.25																REINSTALL STREET SIGN ABOVE NEW STOP SIGN	X				
SB	2.690	F	VW-202	30	30																			SIGN INCORRECTLY SET INITIALLY, USED LONGER POST @ SECOND ATTEMPT.					
		F	VW-202	30	30			6.25																		E-154			
SB	2.687	G	VR-017	24	30																			TH-4, TOWNSHEND BROOK RD (NORTH)					
		G	VR-017	24	30			5.00																		E-141			
SB	2.650	G	VR-017	24	30																			TH-23, TOWNSHEND BROOK RD (SOUTH)					
		G	VR-017	24	30			5.00																		E-141			
SB	2.640	H	R1-1	30	30																			TH-23, TOWNSHEND BROOK RD (SOUTH)					
		H	R1-1	30	30			6.25																		X			
SB	0.840	F	R2-1	24	30		SPEED LIMIT 50																						
SB	0.665	F	W1-5L	30	30																								
		F	W13-1	18	18																								
		F	W1-5L	30	30	FY		6.25																		X			
		F	W13-1	18	18	FY		2.25																		X			
SIGN SUMMARY SHEET							SHEET TOTALS	37.25	0.00	0	0	0	8	0	0	6	90							PROJECT NAME: Ludlow-Waitsfield VT100					
								SF	SF	EA	EA	EA	EA	EA	EA	EA	FT							PROJECT NUMBER: STPG SIGN(27)					
VERMONT AGENCY OF TRANSPORTATION							TOWN TOTALS	297.1	0.0	15.0	1.0	1.0	51	0.0	0.0	52	780.0							FILE NAME: Pittsfield.xls	PLOT DATE: 9/9/2009				
																								PROJECT MANAGER: N. Avery	DRAWN BY: I. Shea				
																								DESIGNED BY: J. Kelly	CHECKED BY: N. Avery				
																								PITTSFIELD SHEET 8	SHEET 79 OF 204				

DIRECTION	MILEPOINT	LOCATION CODE (SHEET 2)	SIGN CODE	WIDTH (IN)	HEIGHT (IN)	SHEETING REMARKS	SIGN LEGEND	NEW SIGNS		EXISTING SIGNS				EXIST POST		NUMBER OF NEW POSTS	SQUARE STEEL (IN)			TUBULAR STEEL Ø (IN)				SIGN FRAME REQUIRED	REMARKS	SIGN DETAIL						
								"A"	"B"	RETAIN	SALVAGE FROM	SALVAGE TO	REMOVE	RETAIN	REMOVE		1.75	2.00	2.50	3.00	3.50	4.00	5.00			DETAIL IN SHS	DETAIL ON SHEET NUMBER	DETAIL ON STD SHEET NUMBER				
																	(LB / FT)			(LB / FT)												
STOCKBRIDGE VT 100							FY-FLUORESCENT YELLOW FYG-FLUORESCENT YELLOW GREEN															"SHS"-STANDARD HIGHWAY SIGNS										
NB	0.000	C	VD-024	60	7.5							1			X																	
		C	VD-025	60	7.5								1																			
		C	VD-024	72	10		STOCKBRIDGE	PITTSFIELD	5.00						2	X												4				
		C	VD-025	72	10		WINDSOR CO.	RUTLAND CO.	5.00																			4				
		C	VD-700	6	10		1000 1419 0000	1000 1115 0487	0.42																							E-138
		C	VD-700	6	10				0.42																						E-138	
NB	0.520	A	W1-2R	30	30		CURVE RIGHT					1			X																	
		A	W13-1	18	18		40 MPH (PLAQUE)					1																				
NB	0.580	A	VW-060	30	30		HIDDEN DRIVES						1		X																	
		A	W1-2R	30	30	FY			6.25						1	X															X	
		A	W13-1	18	18	FY			2.25																							
NB	0.610	A	VW-060	30	30	FY			6.25						1	X																7
NB	0.640	A	W11-3	30	30								1		X																	
		A	W7-3A	30	30								1																			
		A	W11-3	30	30				6.25						1	X															X	
SIGN SUMMARY SHEET							SHEET TOTALS		31.84	0.00	0	0	0	7	0	0	5	75							PROJECT NAME: Ludlow-Waitsfield VT100							
									SF	SF	EA	EA	EA	EA	EA	EA	EA	FT							PROJECT NUMBER: STPG SIGN(27)							
VERMONT AGENCY OF TRANSPORTATION							TOWN TOTALS		676.7	0.0	3.0	8.0	8.0	140	0.0	0.0	107	1605.0							FILE NAME: Stockbridae.xls							
																									PLOT DATE: 9/9/2009							
																									DRAWN BY: I. Shea							
																									DESIGNED BY: M. Miller							
																									CHECKED BY: N. Avery							
																									STOCKBRIDGE SHEET 1							
																									SHEET 80 OF 204							




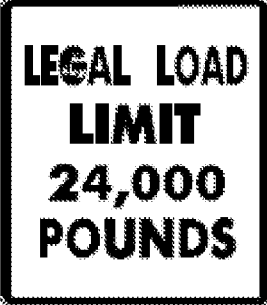






DIRECTION	MILEPOINT	LOCATION CODE (SHEET 2)	SIGN CODE	WIDTH (IN)	HEIGHT (IN)	SHEETING REMARKS	SIGN LEGEND	NEW SIGNS		EXISTING SIGNS				EXIST POST		NUMBER OF NEW POSTS	SQUARE STEEL (IN)			TUBULAR STEEL Ø (IN)				SIGN FRAME REQUIRED	REMARKS	SIGN DETAIL			
								"A"	"B"	RETAIN	SALVAGE FROM	SALVAGE TO	REMOVE	RETAIN	REMOVE		1.75	2.00	2.50	FOUNDATION	3.00	3.50	4.00			5.00	DETAIL IN SHS	DETAIL ON SHEET NUMBER	DETAIL ON STD SHEET NUMBER
																	(LB / FT)				(LB / FT)								
STOCKBRIDGE VT 100							FY-FLUORESCENT YELLOW FYG-FLUORESCENT YELLOW GREEN																"SHS"-STANDARD HIGHWAY SIGNS						
		A	W7-3A	24	18			3.00																		X			
NB	0.924	C	VR-017	24	30								1		X													CANTON DR (TH-49)	
		C	VR-017	24	30			5.00						1		X												RE-INSTALL STREET SIGN BACK ONTO THE TOP OF THIS NEW POST	
NB	0.932	D	R1-1	30	30								1		X													CANTON DR (TH-49)	
		D	R1-1	30	30			6.25						1		X									X			REINSTALL STREET NAME SIGN ON TOP OF NEW POST	
NB	1.340	A	VD-062B	72	16					1					X													ONLY ONE SIGN EXISTING	
		A	VD-062B	72	16					+																			
		A	VD-062B	72	16		BUSINESS SIGN				1			2		X												SALVAGE THE SIGNS ONTO NEW POSTS; "OLD HOTEL" ON TOP	
		A	VD-062B	72	16		BUSINESS SIGN			+																		ONLY ONE SIGN	
NB	1.570	C	VR-017	24	30								1		X													SOUTH HILL RD (TH-19)	
		C	VR-017	24	30			5.00						1		X													
NB	1.578	D	R1-1	30	30								1		X													SOUTH HILL RD (TH-19)	
		D	R1-1	30	30			6.25						1		X									X			RE-INSTALL STREET SIGN BACK ONTO THE TOP OF THIS NEW POST	
NB	1.635	A	W2-5	30	30								1		X														
		A	W16-2	24	18								1																
SIGN SUMMARY SHEET							SHEET TOTALS	25.50	0.00	0	2	2	6	0	0	6		90											PROJECT NAME: Ludlow-Waitsfield VT100
								SF	SF	EA	EA	EA	EA	EA	EA	EA		FT											PROJECT NUMBER: STPG SIGN(27)
VERMONT AGENCY OF TRANSPORTATION							TOWN TOTALS	676.7	0.0	3.0	8.0	8.0	140	0.0	0.0	107		1605.0											FILE NAME: Stockbridge.xls
																												PLOT DATE: 9/9/2009	
																												PROJECT MANAGER: N. Avery	
																												DESIGNED BY: M. Miller	
																												CHECKED BY: N. Avery	
																													SHEET 81 OF 204







DIRECTION	MILEPOINT	LOCATION CODE (SHEET 2)	SIGN CODE	WIDTH (IN)	HEIGHT (IN)	SHEETING REMARKS	SIGN LEGEND	NEW SIGNS		EXISTING SIGNS				EXIST POST		NUMBER OF NEW POSTS	SQUARE STEEL (IN)			TUBULAR STEEL Ø (IN)				SIGN FRAME REQUIRED	REMARKS	SIGN DETAIL		
								"A"	"B"	RETAIN	SALVAGE FROM	SALVAGE TO	REMOVE	RETAIN	REMOVE		1.75	2.00	2.50	3.00	3.50	4.00	5.00			DETAIL IN SHS	DETAIL ON SHEET NUMBER	DETAIL ON STD SHEET NUMBER
																	(LB / FT)			(LB / FT)								
STOCKBRIDGE VT 100							FY-FLUORESCENT YELLOW FYG-FLUORESCENT YELLOW GREEN															"SHS"-STANDARD HIGHWAY SIGNS						
			A	M2-1	21	15																						
			A	M1-5	30	24																						
			A	W2-5	30	30		6.25																				
			A	W16-2	24	18		3.00																				
			A	M2-1	21	15		2.19																				
			A	M1-5	30	24		5.00																		E-136B		
NB	1.740		A	D1-1A	72	10																						
			A	D1-1A	72	10																						
			A	D1-1A	72	10																						
			A	D1-1A	72	12		6.00																		5		
			A	D1-1A	72	12		6.00																		5		
			A	D1-1A	72	12		6.00																		5		
NB	1.790		A	M3-1	24	12																						
			A	M1-5	30	24	2.00																					
			A	M6-2L	21	15	5.00																		E-136B			
			A	M6-2L	21	15	2.19																					
SIGN SUMMARY SHEET							SHEET TOTALS		43.63	0.00	0	0	0	5	0	0	6	90						PROJECT NAME: Ludlow-Waitsfield VT100				
							SF	SF	EA	EA	EA	EA	EA	EA	EA	EA	EA	FT						PROJECT NUMBER: STPG SIGN(27)				
VERMONT AGENCY OF TRANSPORTATION							TOWN TOTALS		676.7	0.0	3.0	8.0	8.0	140	0.0	0.0	107	1605.0						FILE NAME: Stockbridge.xls				
																								PLOT DATE: 9/9/2009				
																									DRAWN BY: I. Shea			
																									DESIGNED BY: M. Miller			
																									CHECKED BY: N. Avery			
																									SHEET 82 OF 204			



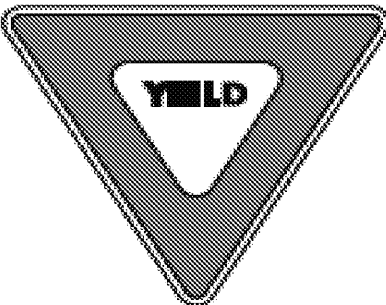
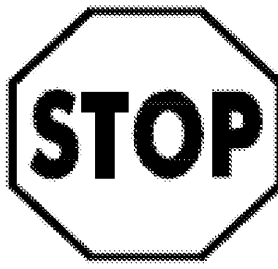
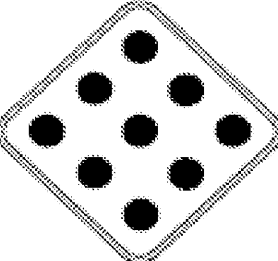
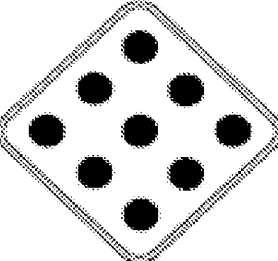



DIRECTION	MILEPOINT	LOCATION CODE (SHEET 2)	SIGN CODE	WIDTH (IN)	HEIGHT (IN)	SHEETING REMARKS	SIGN LEGEND	NEW SIGNS		EXISTING SIGNS				EXIST POST		NUMBER OF NEW POSTS	SQUARE STEEL (IN)			TUBULAR STEEL Ø (IN)				SIGN FRAME REQUIRED	REMARKS	SIGN DETAIL		
								"A"	"B"	RETAIN	SALVAGE FROM	SALVAGE TO	REMOVE	RETAIN	REMOVE		(LB / FT)			(LB / FT)						DETAIL IN SHS	DETAIL ON SHEET NUMBER	DETAIL ON STD SHEET NUMBER
																	1.75	2.00	2.50	3.00	3.50	4.00	5.00					
STOCKBRIDGE VT 100							FY-FLUORESCENT YELLOW FYG-FLUORESCENT YELLOW GREEN															"SHS"-STANDARD HIGHWAY SIGNS						
			A	M3-2	24	12																		GREEN ON WHITE SHEETING	X			
			A	M1-5	30	24		2.00																		E-136B		
			A	M6-2R	21	15		5.00																GREEN ON WHITE SHEETING	X			
NB	1.820		A	M3-1	24	12																						
			A	M1-5	30	24																						
			A	M6-1	21	15																						
			A	M3-2	24	12																						
			A	M1-5	30	24																						
			A	M6-2	21	15																						
NB	1.830		A	VR-615	30	36																						
			A	VR-615	30	36																						
NB	1.850		A	OM1-1	18	18																						
			A	OM1-1	18	18																						
NB	1.894		A	M3-1	24	12																						
			A	M1-5	30	24																						
SIGN SUMMARY SHEET							SHEET TOTALS		18.94	0.00	0	0	0	10	0	0	2	30	PROJECT NAME: Ludlow-Waitsfield VT100				PROJECT NUMBER: STPG SIGN(27)					
VERMONT AGENCY OF TRANSPORTATION							SF	SF	EA	EA	EA	EA	EA	EA	EA	EA	EA	EA	FT	FILE NAME: Stockbridae.xls				PLOT DATE: 9/9/2009				
TOWN TOTALS							676.7	0.0	3.0	8.0	8.0	140	0.0	0.0	107	1605.0	PROJECT MANAGER: N. Avery				DRAWN BY: I. Shea							
															DESIGNED BY: M. Miller				CHECKED BY: N. Avery									
															STOCKBRIDGE SHEET 4				SHEET 83 OF 204									



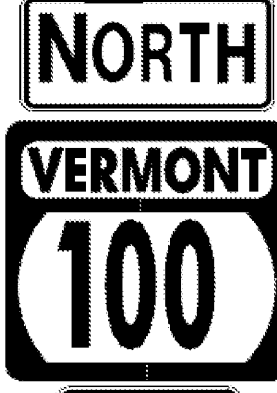
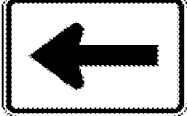
DIRECTION	MILEPOINT	LOCATION CODE (SHEET 2)	SIGN CODE	WIDTH (IN)	HEIGHT (IN)	SHEETING REMARKS	SIGN LEGEND	NEW SIGNS		EXISTING SIGNS				EXIST POST		NUMBER OF NEW POSTS	SQUARE STEEL (IN)			TUBULAR STEEL Ø (IN)				SIGN FRAME REQUIRED	REMARKS	SIGN DETAIL										
								"A"	"B"	RETAIN	SALVAGE FROM	SALVAGE TO	REMOVE	RETAIN	REMOVE		1.75	2.00	2.50	3.00	3.50	4.00	5.00			DETAIL IN SHS	DETAIL ON SHEET NUMBER	DETAIL ON STD SHEET NUMBER								
																	(LB / FT)			(LB / FT)																
STOCKBRIDGE VT 100							FY-FLUORESCENT YELLOW FYG-FLUORESCENT YELLOW GREEN																"SHS"-STANDARD HIGHWAY SIGNS													
			A	M6-2	21	15						1																								
			B	OM1-1	18	18						1																								
			A	M3-2	24	12						1																								
			A	M1-5	30	24						1																								
			A	M6-2	21	15						1																								
			B	OM1-1	18	18						1																								
			A	M3-1	24	12				2.00						2	X					#2B	GREEN ON WHITE SHEETING	X												
			A	M1-5	30	24				5.00													INSTALL ALL SIGNS SAME AS EXISTING, IN THE SMALL RAISED MEDIAN AT JCT w/ VT-107									E-136B				
			A	M6-2L	21	15				2.19													GREEN ON WHITE SHEETING	X												
			B	OM1-1	18	18				2.25													YELLOW/YELLOW CLUSTER MOUNTED ON BACK UNDER THE LEFT ARROW; ASSURE 4 FT VERTICAL CLEARANCE	X												
			A	M3-2	24	12				2.00													GREEN ON WHITE SHEETING	X												
			A	M1-5	30	24				5.00																									E-136B	
			A	M6-2R	21	15				2.19													GREEN ON WHITE SHEETING	X												
			B	OM1-1	18	18				2.25													YELLOW/YELLOW CLUSTER MOUNTED ON BACK UNDER THE RIGHT ARROW; ASSURE 4 FT VERTICAL CLEARANCE	X												
			NB	1.894	B	R1-2	36	36															LEFT-SIDE "GATEPOSTED" YIELD SIGN FOR SB VT-100 TRAFFIC CONTINUING SOUTH													
SIGN SUMMARY SHEET							SHEET TOTALS		22.88	0.00	0	0	0	7	0	0	2	30	PROJECT NAME: Ludlow-Waitsfield VT100																	
									SF	SF	EA	EA	EA	EA	EA	EA	EA	FT	PROJECT NUMBER: STPG SIGN(27)																	
VERMONT AGENCY OF TRANSPORTATION							TOWN TOTALS		676.7	0.0	3.0	8.0	8.0	140	0.0	0.0	107	1605.0	FILE NAME: Stockbridge.xls PLOT DATE: 9/9/2009																	
																			PROJECT MANAGER: N. Avery DRAWN BY: I. Shea																	
																			DESIGNED BY: M. Miller CHECKED BY: N. Avery																	
																			STOCKBRIDGE SHEET 5 SHEET 84 OF 204																	


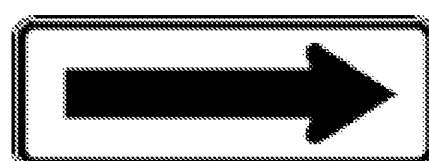
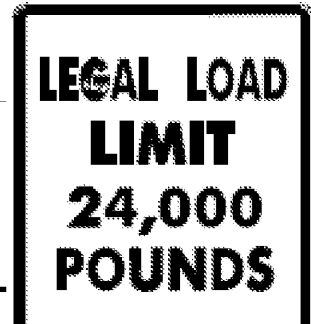
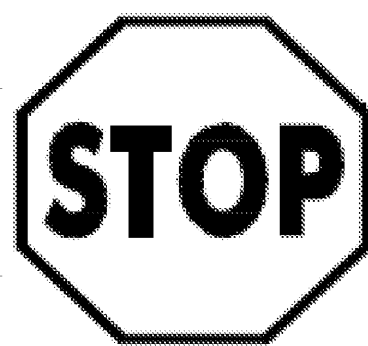

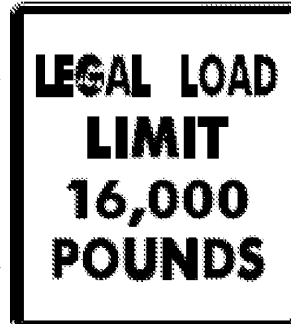


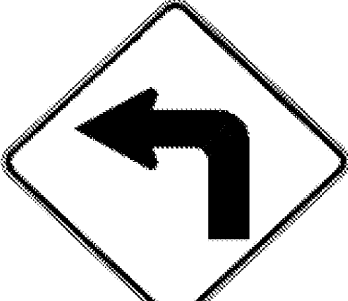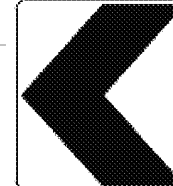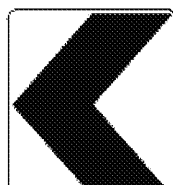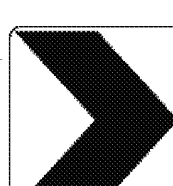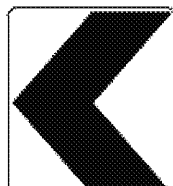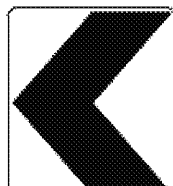

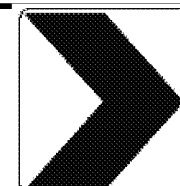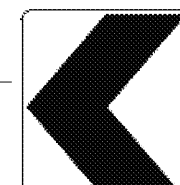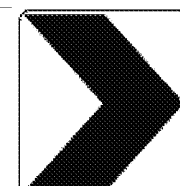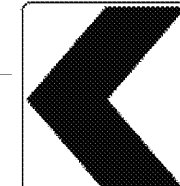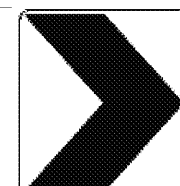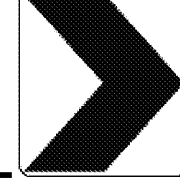

DIRECTION	MILEPOINT	LOCATION CODE (SHEET 2)	SIGN CODE	WIDTH (IN)	HEIGHT (IN)	SHEETING REMARKS	SIGN LEGEND	NEW SIGNS		EXISTING SIGNS				EXIST POST		NUMBER OF NEW POSTS	SQUARE STEEL (IN)			TUBULAR STEEL Ø (IN)				SIGN FRAME REQUIRED	REMARKS	SIGN DETAIL		
								"A"	"B"	RETAIN	SALVAGE FROM	SALVAGE TO	REMOVE	RETAIN	REMOVE		1.75	2.00	2.50	3.00	3.50	4.00	5.00			DETAIL IN SHS	DETAIL ON SHEET NUMBER	DETAIL ON STD SHEET NUMBER
																	(LB / FT)			(LB / FT)								
STOCKBRIDGE VT 100							FY-FLUORESCENT YELLOW FYG-FLUORESCENT YELLOW GREEN															"SHS"-STANDARD HIGHWAY SIGNS						
		B	R1-2	36	36			3.89							1	X							INSTALL IN THE SAME POSITION AS THE EXISTING SIGN, IN SMALL RAISED MEDIAN	X				
NB	1.902	C	R1-1	30	30								1		X								FACES SB VT-100 TRAFFIC TURNING LEFT AT THE SLIP-RAMP TO EB VT-107, IN OTHER SMALL MEDIAN					
		C	R1-1	30	30			6.25							1	X								INSTALL IN THE SAME POSITION AS EXISTING	X			
		D	OM1-1	18	18			2.25																INSTALL ON BACK OF STOP SIGN POST AT 4 FT VERTICAL CLEARANCE	X			
NB	1.913	D	R1-1	30	30								1		X								FACES WB VT-107 TRAFFIC TURNING RIGHT AT THE SLIP-RAMP TO NB VT-100					
		D	R1-1	30	30			6.25							1	X								INSTALL IN THE SAME POSITION AS EXISTING	X			
NB	1.923	A	R2-1	24	30		SPEED LIMIT 50						1		X													
NB	1.933	A	M3-1	24	12			2.00							1	X								GREEN ON WHITE SHEETING	X			
		A	M1-5	30	24			5.00																INSTALL ASSEMBLY 50 FT± NORTH OF THE JUST-REMOVED SPEED LIMIT SIGN			E-136B	
NB	1.985	A	D2-1	72	12			6.00							2	X								INSTALL 25 FT± SOUTH OF THE LEFT TURN / 30 MPH WARNING SIGN ASSEMBLY		5		
		A	D2-1	72	12			6.00																		5		
NB	1.990	A	W1-1L	30	30		LEFT TURN						1		X													
		A	W13-1	18	18		30 MPH (PLAQUE)						1															
NB	2.052	A	D2-1	72	10		STOCKBRIDGE 1						1		X													
		A	D2-1	72	10		ROCHESTER 9						1															
SIGN SUMMARY SHEET							SHEET TOTALS	37.64	0.00	0	0	0	7	0	0	6	90							PROJECT NAME: Ludlow-Waitsfield VT100				
								SF	SF	EA	EA	EA	EA	EA	EA	EA	FT							PROJECT NUMBER: STPG SIGN(27)				
VERMONT AGENCY OF TRANSPORTATION							TOWN TOTALS	676.7	0.0	3.0	8.0	8.0	140	0.0	0.0	107	1605.0							FILE NAME: Stockbridge.xls				
																							PLOT DATE: 9/9/2009					
																							PROJECT MANAGER: N. Avery					
																						DRAWN BY: I. Shea						
																						DESIGNED BY: M. Miller						
																						CHECKED BY: N. Avery						
																							SHEET 85 OF 204					



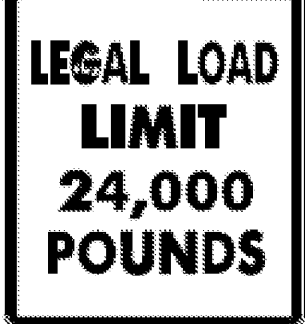


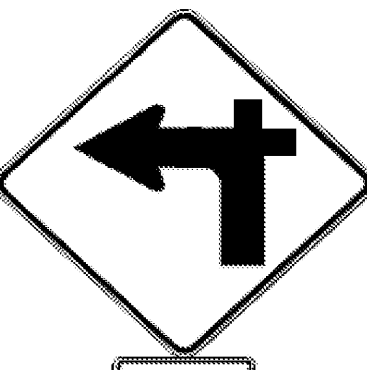

DIRECTION	MILEPOINT	LOCATION CODE (SHEET 2)	SIGN CODE	WIDTH (IN)	HEIGHT (IN)	SHEETING REMARKS	SIGN LEGEND	NEW SIGNS		EXISTING SIGNS				EXIST POST		NUMBER OF NEW POSTS	SQUARE STEEL (IN)			TUBULAR STEEL Ø (IN)				SIGN FRAME REQUIRED	REMARKS	SIGN DETAIL		
								"A"	"B"	RETAIN	SALVAGE FROM	SALVAGE TO	REMOVE	RETAIN	REMOVE		1.75	2.00	2.50	3.00	3.50	4.00	5.00			DETAIL IN SHS	DETAIL ON SHEET NUMBER	DETAIL ON STD SHEET NUMBER
																	(LB / FT)			(LB / FT)								
STOCKBRIDGE VT 100							FY-FLUORESCENT YELLOW FYG-FLUORESCENT YELLOW GREEN																"SHS"-STANDARD HIGHWAY SIGNS					
		A	W1-1L	30	30	FY		6.25							1	X									X			
		A	W13-1	18	18	FY		2.25																	X			
NB	2.077	A	W1-8	18	24								1	X														
		A	W1-8	18	24	FY		3.00							1	X									X			
NB	2.107	A	W1-8	18	24								1	X														
		A	W1-8	18	24	FY		3.00							1	X									X			
NB	2.108	B	W1-8	18	24								1	X														
		B	W1-8	18	24	FY		3.00							1	X									X			
NB	2.120	A	W1-8	18	24								1	X														
		A	W1-8	18	24	FY		3.00							1	X									X			
NB	2.121	B	W1-8	18	24	FY																						
		B	W1-8	18	24	FY	3.00							1	X									X				
NB	2.132	A	W1-8	18	24								1	X														
		A	W1-8	18	24	FY		3.00							1	X									X			
NB	2.133	B	W1-8	18	24																							
		B	W1-8	18	24	FY																						
SIGN SUMMARY SHEET							SHEET TOTALS		26.50	0.00	0	0	0	6	0	0	7	105										
VERMONT AGENCY OF TRANSPORTATION							SF	SF	EA	EA	EA	EA	EA	EA	EA	EA	EA	EA	FT									
							TOWN TOTALS		676.7	0.0	3.0	8.0	8.0	140	0.0	0.0	107	1605.0										
																	PROJECT NAME: Ludlow-Waitsfield VT100											
																	PROJECT NUMBER: STPG SIGN(27)											
																	FILE NAME: Stockbridge.xls	PLOT DATE: 9/9/2009										
																	PROJECT MANAGER: N. Avery	DRAWN BY: I. Shea										
																	DESIGNED BY: M. Miller	CHECKED BY: N. Avery										
																	STOCKBRIDGE SHEET 7	SHEET 86	OF 204									



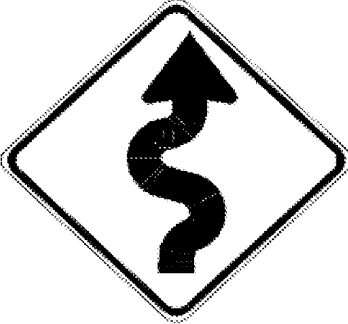

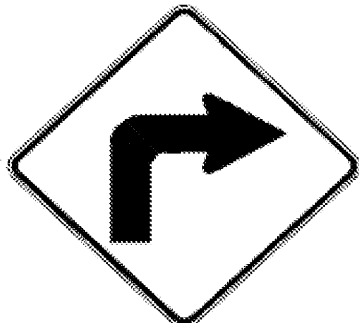
DIRECTION	MILEPOINT	LOCATION CODE (SHEET 2)	SIGN CODE	WIDTH (IN)	HEIGHT (IN)	SHEETING REMARKS	SIGN LEGEND	NEW SIGNS		EXISTING SIGNS				EXIST POST		NUMBER OF NEW POSTS	SQUARE STEEL (IN)			TUBULAR STEEL Ø (IN)				SIGN FRAME REQUIRED	REMARKS	SIGN DETAIL				
								"A"	"B"	RETAIN	SALVAGE FROM	SALVAGE TO	REMOVE	RETAIN	REMOVE		1.75	2.00	2.50	3.00	3.50	4.00	5.00			DETAIL IN SHS	DETAIL ON SHEET NUMBER	DETAIL ON STD SHEET NUMBER		
																	(LB / FT)			(LB / FT)										
STOCKBRIDGE VT 100							FY-FLUORESCENT YELLOW FYG-FLUORESCENT YELLOW GREEN																"SHS"-STANDARD HIGHWAY SIGNS							
			B	W1-8	18	24		3.00							1		X									X				
NB	2.143		A	W1-8	18	24								1		X												BEHIND RAIL, JUST BEYOND UTILITY POLE		
			A	W1-8	18	24		3.00						1		X									X			MAINTAIN 10 FT MIN. TO POLE BEHIND RAIL, 5 FT± NORTH OF THE NB-FACING CHEVRON; THIS CHEVRON FACES SB		
NB	2.144		B	W1-8	18	24								1		X														
			B	W1-8	18	24		3.00						1		X									X					
NB	2.157		A	W1-8	18	24		3.00						1		X										X		INSTALL NEW SIGN 5 FT± SOUTH OF THE SB-FACING CHEVRON BEHIND RAIL.		
NB	2.158		B	W1-8	18	24								1		X												BEHIND RAIL, FACES SB		
			B	W1-8	18	24		3.00						1		X										X		FACES SB		
NB	2.170		B	W1-8	18	24		3.00						1		X										X		INSTALL 65 FT± NORTH OF PREVIOUS CHEVRONS; SINGLE SB-FACING SIGN BEHIND RAIL		
NB	2.230		C	VM-607	24	30	43rd INF DIV MEMORIAL HIGHWAY			1						X												IN SMALL PULLOUT ON RIGHT		
NB	2.400		A	R2-5A	30	30	REDUCED SPEED AHEAD							1		X														
NB	2.430		A	W3-5	36	36		9.00						2		X										X		INSTALL 160 FT± NORTH OF THE REMOVED REDUCED SPEED AHEAD SIGN		
NB	2.540		A	VW-202	30	30	TRUCKS ENTERING 							1		X														
			A	R2-1	30	36		7.50						1		X												260 FT± SOUTH OF JCT w/ TIMBER HAWK RD (TH-58) ON THE LEFT; SPEED 40 SIGN AHEAD IS PLACED INCORRECTLY		
NB	2.580		A	R2-1	24	30	SPEED LIMIT 40							1		X														
SIGN SUMMARY SHEET							SHEET TOTALS	34.50	0.00	1	0	0	6	0	0	9	135													
VERMONT AGENCY OF TRANSPORTATION								SF	SF	EA	EA	EA	EA	EA	EA	EA	EA	FT												
							TOWN TOTALS	676.7	0.0	3.0	8.0	8.0	140	0.0	0.0	107	1605.0													
PROJECT NAME: Ludlow-Waitsfield VT100																					PROJECT NUMBER: STPG SIGN(27)									
FILE NAME: Stockbridge.xls												PLOT DATE: 9/9/2009																		
PROJECT MANAGER: N. Avery												DRAWN BY: I. Shea																		
DESIGNED BY: M. Miller												CHECKED BY: N. Avery																		
STOCKBRIDGE SHEET 8																					SHEET 87 OF 204									









DIRECTION	MILEPOINT	LOCATION CODE (SHEET 2)	SIGN CODE	WIDTH (IN)	HEIGHT (IN)	SHEETING REMARKS	SIGN LEGEND	NEW SIGNS		EXISTING SIGNS				EXIST POST		NUMBER OF NEW POSTS	SQUARE STEEL (IN)			TUBULAR STEEL Ø (IN)				SIGN FRAME REQUIRED	REMARKS	SIGN DETAIL		
								"A"	"B"	RETAIN	SALVAGE FROM	SALVAGE TO	REMOVE	RETAIN	REMOVE		(LB / FT)			(LB / FT)						DETAIL IN SHS	DETAIL ON SHEET NUMBER	DETAIL ON STD SHEET NUMBER
																	1.75	2.00	2.50	3.00	3.50	4.00	5.00					
								1.88	2.42	3.35	FOUNDATION	7.60	9.00	10.80	14.60													
STOCKBRIDGE VT 100							FY-FLUORESCENT YELLOW FYG-FLUORESCENT YELLOW GREEN															"SHS"-STANDARD HIGHWAY SIGNS						
							MOVE AHEAD 1350 FT (0.25 MI)±															BRIDGE PROJECT TO REPLACE SIGNS WITHIN THE "GAP" ZONE						
NB	2.830	A	W1-1McL	30	30		LEFT TURN AT 4-WAY INTERSECTION SYMBOL				1				X								SALVAGE SIGNS TO A NEW POSITION FURTHER AHEAD					
		A	W13-1	18	18		20 MPH (PLAQUE) 				1																	
NB	2.883	A	W1-1McL	30	30								1		X								RE-INSTALL 280 FT± NORTH OF PREVIOUS POSITION					
		A	W13-1	18	18						1												MAINTAIN 10 FT MINIMUM TO UTILITY POLE					
NB	2.935	A	M3-1	24	12								1		X													
		A	M1-5	30	24								1															
		A	M6-1	21	15								1															
		A	M3-1	24	12			2.00						1		X								GREEN ON WHITE SHEETING	X			
		A	M1-5	30	24			5.00																		E-136B		
		A	M6-1L	21	15			2.19															GREEN ON WHITE SHEETING	X				
NB	2.936	C	M3-3	24	12								1		X													
		C	M1-5	30	24								1															
		C	M6-1	21	15								1															
		C	M3-3	24	12			2.00						1		X								GREEN ON WHITE SHEETING	X			
SIGN SUMMARY SHEET							SHEET TOTALS		11.19	0.00	0	2	2	6	0	0	3	45								PROJECT NAME: Ludlow-Waitsfield VT100		
							SF	SF	EA	EA	EA	EA	EA	EA	EA	EA	EA	EA	EA	EA	EA	EA	EA	EA	EA	EA	EA	PROJECT NUMBER: STPG SIGN(27)
																						FILE NAME: Stockbridae.xls	PLOT DATE: 9/9/2009					
VERMONT AGENCY OF TRANSPORTATION							TOWN TOTALS		676.7	0.0	3.0	8.0	8.0	140	0.0	0.0	107	1605.0						DESIGNED BY: M. Miller	CHECKED BY: N. Avery			
															PROJECT MANAGER: N. Avery	DRAWN BY: I. Shea												
															DESIGNED BY: M. Miller	CHECKED BY: N. Avery												
															STOCKBRIDGE SHEET 9	SHEET 88 OF 204												



DIRECTION	MILEPOINT	LOCATION CODE (SHEET 2)	SIGN CODE	WIDTH (IN)	HEIGHT (IN)	SHEETING REMARKS	SIGN LEGEND	NEW SIGNS		EXISTING SIGNS				EXIST POST		NUMBER OF NEW POSTS	SQUARE STEEL (IN)			TUBULAR STEEL Ø (IN)				SIGN FRAME REQUIRED	REMARKS	SIGN DETAIL		
								"A"	"B"	RETAIN	SALVAGE FROM	SALVAGE TO	REMOVE	RETAIN	REMOVE		(LB / FT)			(LB / FT)						DETAIL IN SHS	DETAIL ON SHEET NUMBER	DETAIL ON STD SHEET NUMBER
																	1.75	2.00	2.50	3.00	3.50	4.00	5.00					
STOCKBRIDGE VT 100							FY-FLUORESCENT YELLOW FYG-FLUORESCENT YELLOW GREEN															"SHS"-STANDARD HIGHWAY SIGNS						
		C	M1-5	30	24			5.00															SIGNS FACE SB VT-100 TRAFFIC AT THE 4-WAY INTERSECTION			E-136B		
		C	M6-1R	21	15			2.19															GREEN ON WHITE SHEETING	X				
NB	2.931	C	W1-6	48	24							1		X									ALSO FACES SB VT-100 TRAFFIC AT THE 4-WAY INTERSECTION					
		C	W1-6	48	24			8.00							2	X							NEXT TO (LEFT OF) THE SOUTH/VT 100/ --> SIGNS; MATCH HEIGHTS OF TOP OF BOTH ASSEMBLIES	X				
NB	2.932	C	VR-017	24	30							1		X									BLACKMER BLVD (TH-1)					
		C	n/a	18	24		NO THRU TRUCKS 					1											ILLEGAL SIGN, DO NOT REPLACE OR RE-INSTALL; RETURN TO TOWN					
		C	VR-017	24	30			5.00						1	X										E-141			
NB	2.940	D	R1-1	30	30							1		X									BLACKMER BLVD (TH-1);					
		D	W4-4A	30	15		TRAFFIC FROM LEFT DOES NOT STOP (PLAQUE)			1	1																	
		D	R1-1	30	30			6.25							1	X									X			
NB	2.942	C	VR-017	24	24							1		X									STOCKBRIDGE COMMON (TH-3)					
		D	R1-1	30	30		STOP (INSTALLED ON BACK)					1																
		C	VR-017	24	24		 	5.00							1	X										E-141		
		D	R1-1	30	30			6.25																X				
SIGN SUMMARY SHEET							SHEET TOTALS	37.69	0.00	0	1	1	6	0	0	5	75							PROJECT NAME: Ludlow-Waitsfield VT100				
								SF	SF	EA	EA	EA	EA	EA	EA	EA	FT							PROJECT NUMBER: STPG SIGN(27)				
VERMONT AGENCY OF TRANSPORTATION							TOWN TOTALS	676.7	0.0	3.0	8.0	8.0	140	0.0	0.0	107	1605.0							FILE NAME: Stockbridge.xls	PLOT DATE: 9/9/2009			
																							PROJECT MANAGER: N. Avery	DRAWN BY: I. Shea				
																							DESIGNED BY: M. Miller	CHECKED BY: N. Avery				
																							STOCKBRIDGE SHEET 10	SHEET 89 OF 204				


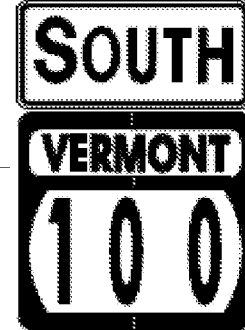

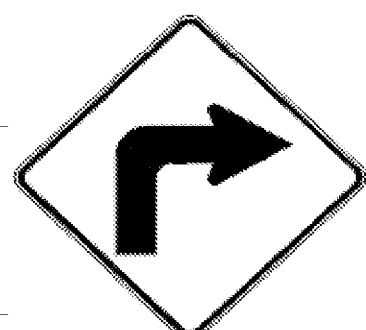

DIRECTION	MILEPOINT	LOCATION CODE (SHEET 2)	SIGN CODE	WIDTH (IN)	HEIGHT (IN)	SHEETING REMARKS	SIGN LEGEND	NEW SIGNS		EXISTING SIGNS				EXIST POST		NUMBER OF NEW POSTS	SQUARE STEEL (IN)			TUBULAR STEEL Ø (IN)				SIGN FRAME REQUIRED	REMARKS	SIGN DETAIL		
								"A"	"B"	RETAIN	SALVAGE FROM	SALVAGE TO	REMOVE	RETAIN	REMOVE		1.75	2.00	2.50	3.00	3.50	4.00	5.00			DETAIL IN SHS	DETAIL ON SHEET NUMBER	DETAIL ON STD SHEET NUMBER
																	(LB / FT)			(LB / FT)								
STOCKBRIDGE VT 100							FY-FLUORESCENT YELLOW FYG-FLUORESCENT YELLOW GREEN															"SHS"-STANDARD HIGHWAY SIGNS						
NB	2.950	D	R1-1	30	30		STOP					1				X								STOCKBRIDGE COMMON (TH-3)				
		D	W4-4B	30	15		ONCOMING TRAFFIC DOES NOT STOP (PLAQUE)		1	1																		
		D	R1-1	30	30			6.25								X								X				
NB	2.960	A	M3-1	24	12							1				X												
		A	M1-5	30	24							1																
		A	M3-1	24	12			2.00								X							X	GREEN ON WHITE SHEETING				
		A	M1-5	30	24			5.00																			E-136B	
NB	2.985	A	W1-3R	30	30		REVERSE TURN RIGHT (SYMBOL)					1				X												
		A	W13-1	18	18		35 MPH (PLAQUE)					1												PLAQUE WON'T BE REPLACED				
		A	W1-5R	30	30			6.25								X							X					
NB	3.100	A	R2-1	24	30							1				X												
		A	R2-1	24	30			5.00								X							X					
NB	3.210	A	W1-1R	30	30		RIGHT TURN					1				X												
		A	W13-1	18	18		30 MPH (PLAQUE)					1																
SIGN SUMMARY SHEET							SHEET TOTALS	24.50	0.00	0	1	1	8	0	0	4	60											
VERMONT AGENCY OF TRANSPORTATION								SF	SF	EA	EA	EA	EA	EA	EA	EA	EA	FT										
							TOWN TOTALS	676.7	0.0	3.0	8.0	8.0	140	0.0	0.0	107	1605.0											
								PROJECT NAME: Ludlow-Waitsfield VT100										PROJECT NUMBER: STPG SIGN(27)										
								FILE NAME: Stockbridge.xls					PLOT DATE: 9/9/2009					DRAWN BY: I. Shea										
								PROJECT MANAGER: N. Avery					DESIGNED BY: M. Miller					CHECKED BY: N. Avery										
								STOCKBRIDGE SHEET 11										SHEET 90 OF 204										

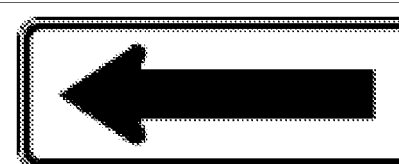

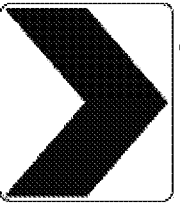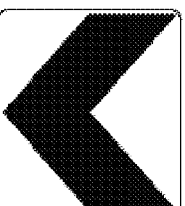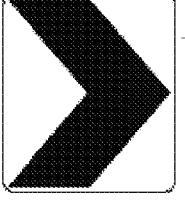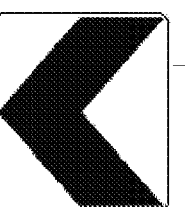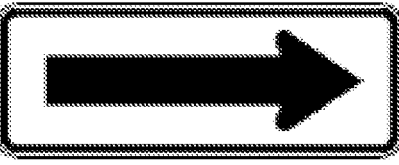


DIRECTION	MILEPOINT	LOCATION CODE (SHEET 2)	SIGN CODE	WIDTH (IN)	HEIGHT (IN)	SHEETING REMARKS	SIGN LEGEND	NEW SIGNS		EXISTING SIGNS				EXIST POST		NUMBER OF NEW POSTS	SQUARE STEEL (IN)			TUBULAR STEEL Ø (IN)				SIGN FRAME REQUIRED	REMARKS	SIGN DETAIL		
								"A"	"B"	RETAIN	SALVAGE FROM	SALVAGE TO	REMOVE	RETAIN	REMOVE		(LB / FT)			(LB / FT)						DETAIL IN SHS	DETAIL ON SHEET NUMBER	DETAIL ON STD SHEET NUMBER
																	1.75	2.00	2.50	3.00	3.50	4.00	5.00					
STOCKBRIDGE VT 100							FY-FLUORESCENT YELLOW FYG-FLUORESCENT YELLOW GREEN																"SHS"-STANDARD HIGHWAY SIGNS					
NB	3.222	A	W1-2R	30	30	FY		6.25							1	X								INSTALL 65 FT± NORTH OF PREVIOUS POSITION	X			
		A	W13-1	18	18	FY			2.25																X			
NB	3.598	C	VR-017	24	30		 							1										STOCKBRIDGE COMMON (TH-3) RE-INSTALL THE TOWN-OWNED SPEED LIMIT SIGN UNDER THE NEW LEGAL LOAD LIMIT SIGN				
		C	R2-1	24	30	SPEED LIMIT 25					1	1																
		C	VR-017	24	30				5.00							1	X							INSTALL AT A POINT JUST BEYOND THE CONVERGANCE OF THE TWO APPROACHES			E-141	
NB	3.606	D	R1-1	30	30									1										STOCKBRIDGE COMMON (TH-3)				
		D	R1-1	30	30				6.25							1	X							SOUTHERLY APPROACH	X			
NB	3.620	D	R1-1	30	30									1										STOCKBRIDGE COMMON (TH-3)				
		D	R1-1	30	30				6.25							1	X							NORTHERLY APPROACH	X			
NB	3.635	A	R2-1	24	30			5.00							1	X								INSTALL 80 FT± NORTH OF TH-3; TO 10 FT IN FRONT OF UTILITY POLE	X			
NB	4.642	A	W1-2R	36	36	CURVE RIGHT									1													
		A	W13-1	24	24	35 MPH (PLAQUE)								1														
NB	4.672	A	W1-2R	36	36	FY		9.00							2	X								INSTALL 160 FT± NORTH OF PREVIOUS POSITION	X			
		A	W13-1	24	24	FY			4.00																X			
SIGN SUMMARY SHEET							SHEET TOTALS	44.00	0.00	0	1	1	5	0	0	7	105						PROJECT NAME: Ludlow-Waitsfield VT100					
								SF	SF	EA	EA	EA	EA	EA	EA	EA	FT						PROJECT NUMBER: STPG SIGN(27)					
VERMONT AGENCY OF TRANSPORTATION							TOWN TOTALS	676.7	0.0	3.0	8.0	8.0	140	0.0	0.0	107	1605.0						FILE NAME: Stockbridge.xls	PLOT DATE: 9/29/2009				
																							PROJECT MANAGER: N. Avery	DRAWN BY: I. Shea				
																							DESIGNED BY: M. Miller	CHECKED BY: N. Avery				
																							STOCKBRIDGE SHEET 12	SHEET 91	OF 204			

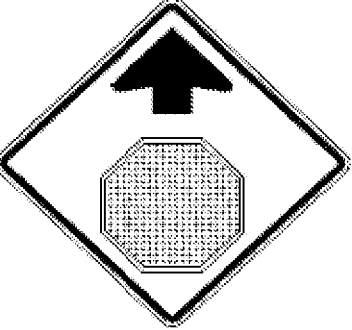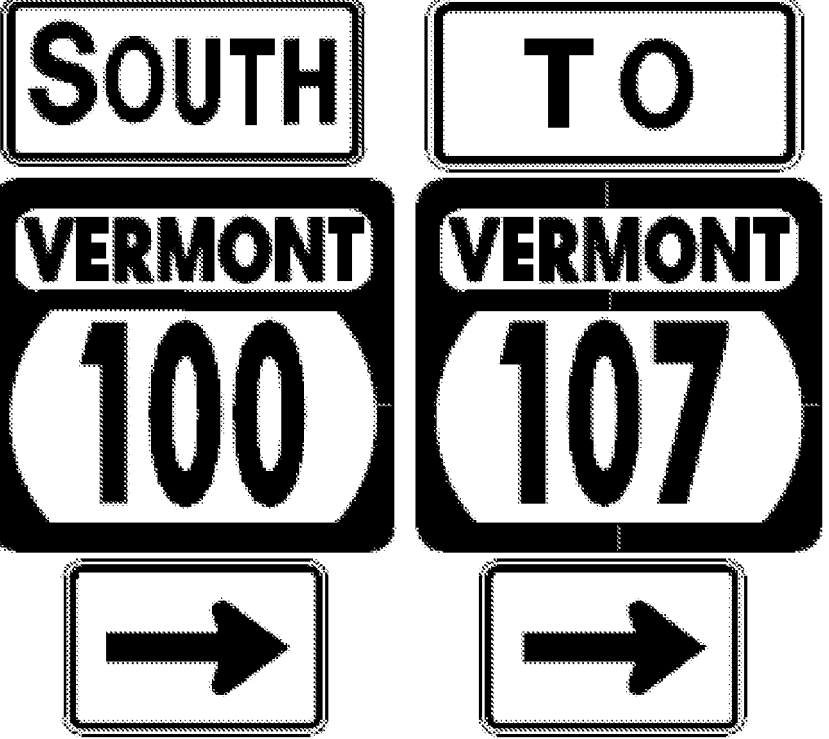DIRECTION	MILEPOINT	LOCATION CODE (SHEET 2)	SIGN CODE	WIDTH (IN)	HEIGHT (IN)	SHEETING REMARKS	SIGN LEGEND	NEW SIGNS		EXISTING SIGNS				EXIST POST		NUMBER OF NEW POSTS	SQUARE STEEL (IN)			TUBULAR STEEL Ø (IN)				SIGN FRAME REQUIRED	REMARKS	SIGN DETAIL			
								"A"	"B"	RETAIN	SALVAGE FROM	SALVAGE TO	REMOVE	RETAIN	REMOVE		1.75	2.00	2.50	FOUNDATION	3.00	3.50	4.00			5.00	DETAIL IN SHS	DETAIL ON SHEET NUMBER	DETAIL ON STD SHEET NUMBER
																	(LB / FT)				(LB / FT)								
STOCKBRIDGE VT 100							FY-FLUORESCENT YELLOW FYG-FLUORESCENT YELLOW GREEN																"SHS"-STANDARD HIGHWAY SIGNS						
SB	4.800	F	W1-2L	36	36																								
		F	W13-1	24	24																								
		F	W1-2L	36	36	FY																					X		
		F	W13-1	24	24	FY																					X		
SB	4.710	E	W1-6	48	24																								
		E	W1-6	48	24	FY																					X		
SB	4.703	F	W1-6	48	24																								
		F	W1-6	48	24	FY																					X		
SB	3.436	F	W1-1L	30	30																								
		F	W13-1	18	18																								
		F	W1-1L	36	36	FY																					X		
		F	W13-1	24	24	FY																					X		
SB	3.377	F	W1-6	48	24																								
		F	W1-6	48	24	FY																					X		
SB	3.376	E	W1-8	18	24																								
SIGN SUMMARY SHEET							SHEET TOTALS	50.00	0.00	0	0	0	8	0	0	10	150								PROJECT NAME: Ludlow-Waitsfield VT100				
								SF	SF	EA	EA	EA	EA	EA	EA	EA	FT								PROJECT NUMBER: STPG SIGN(27)				
VERMONT AGENCY OF TRANSPORTATION							TOWN TOTALS	676.7	0.0	3.0	8.0	8.0	140	0.0	0.0	107	1605.0								FILE NAME: Stockbridge.xls	PLOT DATE: 9/29/2009			
																									PROJECT MANAGER: N. Avery	DRAWN BY: I. Shea			
																									DESIGNED BY: M. Miller	CHECKED BY: N. Avery			
																									STOCKBRIDGE SHEET 13	SHEET 92 OF 204			


DIRECTION	MILEPOINT	LOCATION CODE (SHEET 2)	SIGN CODE	WIDTH (IN)	HEIGHT (IN)	SHEETING REMARKS	SIGN LEGEND	NEW SIGNS		EXISTING SIGNS				EXIST POST		NUMBER OF NEW POSTS	SQUARE STEEL (IN)			TUBULAR STEEL Ø (IN)				SIGN FRAME REQUIRED	REMARKS	SIGN DETAIL			
								"A"	"B"	RETAIN	SALVAGE FROM	SALVAGE TO	REMOVE	RETAIN	REMOVE		1.75	2.00	2.50	FOUNDATION	3.00	3.50	4.00			5.00	DETAIL IN SHS	DETAIL ON SHEET NUMBER	DETAIL ON STD SHEET NUMBER
																	(LB / FT)				(LB / FT)								
STOCKBRIDGE VT 100							FY-FLUORESCENT YELLOW FYG-FLUORESCENT YELLOW GREEN																"SHS"-STANDARD HIGHWAY SIGNS						
		E	W1-8	18	24	FY		3.00							1		X							INSTALL ON ITS OWN POST 5 FT± SOUTH OF THE LARGE ARROW; FACES NB TRAFFIC	X				
SB	3.360	F	W1-8	18	24							1		X									TWO CHEVRONS INSTALLED BACK-TO-BACK						
		E	W1-8	18	24							1												RESET TO SPEC, NEW POST.					
		F	W1-8	18	24	FY		3.00							1		X							FACES SB TRAFFIC	X				
		E	W1-8	18	24	FY		3.00																FACES NB TRAFFIC; INSTALL BACK-TO-BACK w/ SB FACING CHEVRON.	X				
SB	3.336	F	W1-8	18	24							1		X										RESET TO SPEC, NEW POST.					
		F	W1-8	18	24	FY		3.00							1		X							INSTALL 5 FT± IN ADVANCE OF LARGE ARROW RIGHT THAT FACES NB. THIS CHEVRON FACES SB TRAFFIC.	X				
SB	3.335	E	W1-6	48	24							1		X										FACES NB TRAFFIC					
		E	W1-6	48	24			8.00							2		X								RESET TO SPEC, NEW POSTS.	X			
SB	3.254	F	R2-5A	24	30		REDUCED SPEED AHEAD					1		X															
SB	3.179	F	W3-5	36	36			9.00							2		X							INSTALL 400 FT± SOUTH OF THE JUST-REMOVED REDUCED SPEED AHEAD SIGN	X				
SB	3.090	F	R2-1	24	30							1		X										RESET TO SPEC, NEW POST.					
		F	R2-1	30	36			7.50							1		X							INSTALL ACROSS FROM THE NB-FACING SPEED LIMIT 50 SIGN		6			
SB	3.050	F	S3-1	30	30							1		X										RESET TO SPEC, NEW POST.					
		F	S3-1	30	30			6.25							1		X												
SIGN SUMMARY SHEET							SHEET TOTALS	42.75	0.00	0	0	0	7	0	0	9	135									PROJECT NAME: Ludlow-Waitsfield VT100			
								SF	SF	EA	EA	EA	EA	EA	EA	EA	EA	EA	EA	EA	EA	EA	EA	EA	EA	EA	EA	EA	PROJECT NUMBER: STPG SIGN(27)
VERMONT AGENCY OF TRANSPORTATION							TOWN TOTALS	676.7	0.0	3.0	8.0	8.0	140	0.0	0.0	107	1605.0							FILE NAME: Stockbridge.xls					
																								PLOT DATE: 9/9/2009					
																									PROJECT MANAGER: N. Avery				
																									DRAWN BY: I. Shea				
																									DESIGNED BY: M. Miller				
																									CHECKED BY: N. Avery				
																									STOCKBRIDGE SHEET 14				
																									SHEET 93 OF 204				




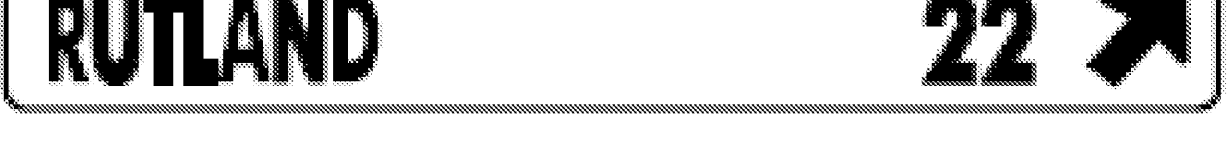

DIRECTION	MILEPOINT	LOCATION CODE (SHEET 2)	SIGN CODE	WIDTH (IN)	HEIGHT (IN)	SHEETING REMARKS	SIGN LEGEND	NEW SIGNS		EXISTING SIGNS				EXIST POST		NUMBER OF NEW POSTS	SQUARE STEEL (IN)			TUBULAR STEEL Ø (IN)				SIGN FRAME REQUIRED	REMARKS	SIGN DETAIL			
								"A"	"B"	RETAIN	SALVAGE FROM	SALVAGE TO	REMOVE	RETAIN	REMOVE		1.75	2.00	2.50	FOUNDATION	3.00	3.50	4.00			5.00	DETAIL IN SHS	DETAIL ON SHEET NUMBER	DETAIL ON STD SHEET NUMBER
																	(LB / FT)				(LB / FT)								
STOCKBRIDGE VT 100							FY-FLUORESCENT YELLOW FYG-FLUORESCENT YELLOW GREEN																"SHS"-STANDARD HIGHWAY SIGNS						
SB	3.013	F	W3-1	36	36																								
		F	W3-1	36	36			9.00																					
SB	2.990	F	M3-3	24	12																								
		F	M1-5	30	24																								
		F	M6-1R	21	15																								
		F	M4-5	24	12																								
		F	M1-5	30	24																								
		F	M6-1R	21	15																								
		F	M3-3	24	12			2.00																#2B	GREEN ON WHITE SHEETING	X			
		F	M1-5	30	24			5.00																					
		F	M6-1R	21	15			2.19																					
		F	M4-5	24	12			2.00																					
		F	M1-5	30	24			5.00																					
		F	M6-1R	21	15			2.19																					
SB	2.950	F	R1-1	48	48		STOP																						
SIGN SUMMARY SHEET							SHEET TOTALS	27.38	0.00	0	0	0	8	0	0	4	60					PROJECT NAME: Ludlow-Waitsfield VT100							
								SF	SF	EA	EA	EA	EA	EA	EA	EA	FT					PROJECT NUMBER: STPG SIGN(27)							
VERMONT AGENCY OF TRANSPORTATION							TOWN TOTALS	676.7	0.0	3.0	8.0	8.0	140	0.0	0.0	107	1605.0					FILE NAME: Stockbridae.xls	PLOT DATE: 9/9/2009						
																						PROJECT MANAGER: N. Avery	DRAWN BY: I. Shea						
																						DESIGNED BY: M. Miller	CHECKED BY: N. Avery						
																						STOCKBRIDGE SHEET 15	SHEET 94 OF 204						

DIRECTION	MILEPOINT	LOCATION CODE (SHEET 2)	SIGN CODE	WIDTH (IN)	HEIGHT (IN)	SHEETING REMARKS	SIGN LEGEND	NEW SIGNS		EXISTING SIGNS				EXIST POST		NUMBER OF NEW POSTS	SQUARE STEEL (IN)			TUBULAR STEEL Ø (IN)				SIGN FRAME REQUIRED	REMARKS	SIGN DETAIL			
								"A"	"B"	RETAIN	SALVAGE FROM	SALVAGE TO	REMOVE	RETAIN	REMOVE		1.75	2.00	2.50	FOUNDATION	3.00	3.50	4.00			5.00	DETAIL IN SHS	DETAIL ON SHEET NUMBER	DETAIL ON STD SHEET NUMBER
																	(LB / FT)				(LB / FT)								
STOCKBRIDGE VT 100							FY-FLUORESCENT YELLOW FYG-FLUORESCENT YELLOW GREEN																"SHS"-STANDARD HIGHWAY SIGNS						
		F	W4-4A	36	15		TRAFFIC FROM RIGHT DOES NOT STOP (PLAQUE)			1	1														RE-INSTALL UNDER THE NEW SIGN, SPAN BOTH POSTS				
		F	R1-1	48	48			16.00							2		X								RELOCATED DUE TO OUT OF SPEC, NEW POSTS.	X			
SB	2.885	F	M3-3	24	12							1					X												
		F	M1-5	30	24							1																	
		F	M3-3	24	12			2.00							1		X								GREEN ON WHITE SHEETING	X			
		F	M1-5	30	24			5.00																				E-136B	
MOVE AHEAD 1600 FT (0.30 MI)±																									BRIDGE PROJECT TO REPLACE SIGNS WITHIN THE "GAP" ZONE				
SB	2.575	F	R2-1	24	30		SPEED LIMIT 50					1					X												
		F	R2-1	24	30			5.00							1		X								0.05 MI± SOUTH OF TIMBER HAWK RD; INSTALL ACROSS FROM THE NB FACING SPEED LIMIT 40 SIGN	X			
SB	2.240	F	W1-1R	30	30		RIGHT TURN SYMBOL					1					X												
		F	W13-1	18	18		30 MPH (PLAQUE)					1																	
SB	2.200	F	VW-133	30	30		HIDDEN DRIVE LEFT					1					X												
		F	W1-1R	30	30	FY		6.25							1		X								INSTALL IN THE SAME LOCATION AS THE JUST-REMOVED HIDDEN DRIVE SIGN	X			
		F	W13-1	18	18	FY		2.25																	RESET TO SPEC, NEW POST.	X			
SIGN SUMMARY SHEET							SHEET TOTALS	36.50	0.00	0	1	1	6	0	0	5		75								PROJECT NAME: Ludlow-Waitsfield VT100			
								SF	SF	EA	EA	EA	EA	EA	EA	EA		FT								PROJECT NUMBER: STPG SIGN(27)			
VERMONT AGENCY OF TRANSPORTATION							TOWN TOTALS	676.7	0.0	3.0	8.0	8.0	140	0.0	0.0	107		1605.0								FILE NAME: Stockbridge.xls			
																									PLOT DATE: 9/9/2009				
																									PROJECT MANAGER: N. Avery				
																									DRAWN BY: I. Shea				
																									DESIGNED BY: M. Miller				
																									CHECKED BY: N. Avery				
																									STOCKBRIDGE SHEET 16	SHEET 95	OF	204	

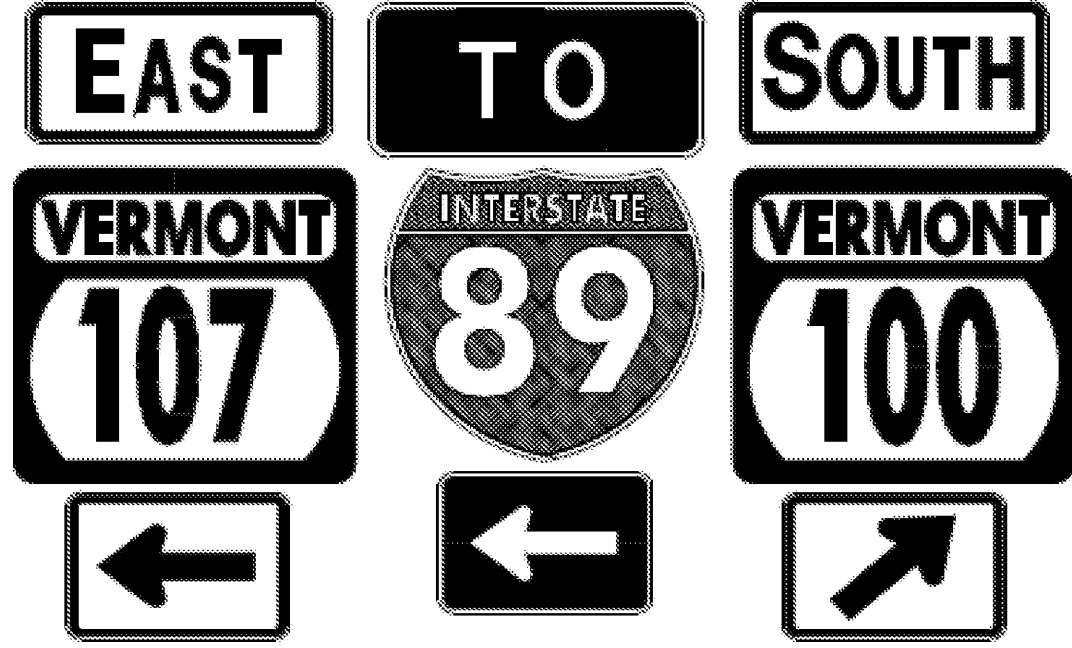

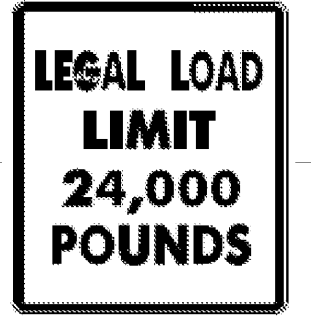
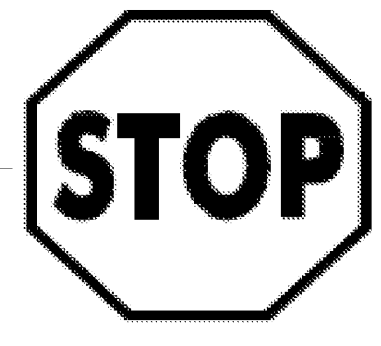
DIRECTION	MILEPOINT	LOCATION CODE (SHEET 2)	SIGN CODE	WIDTH (IN)	HEIGHT (IN)	SHEETING REMARKS	SIGN LEGEND	NEW SIGNS		EXISTING SIGNS				EXIST POST		NUMBER OF NEW POSTS	SQUARE STEEL (IN)			TUBULAR STEEL Ø (IN)				SIGN FRAME REQUIRED	REMARKS	SIGN DETAIL			
								"A"	"B"	RETAIN	SALVAGE FROM	SALVAGE TO	REMOVE	RETAIN	REMOVE		1.75	2.00	2.50	3.00	3.50	4.00	5.00			DETAIL IN SHS	DETAIL ON SHEET NUMBER	DETAIL ON STD SHEET NUMBER	
																	(LB / FT)			(LB / FT)									
																	1.88	2.42	3.35	FOUNDATION	7.60	9.00	10.80	14.60					
STOCKBRIDGE VT 100							FY-FLUORESCENT YELLOW FYG-FLUORESCENT YELLOW GREEN															"SHS"-STANDARD HIGHWAY SIGNS							
SB	2.035	F	M2-1	21	15																								
		F	M1-5	30	24																								
		F	M2-1	21	15			2.19							1		X							GREEN ON WHITE SHEETING	X				
		F	M1-5	30	24			5.00																		E-136B			
SB	2.000	F	W3-2	48	48		YIELD			1																			
SB	1.955	F	D1-1A	72	10																								
		F	D1-1A	72	10																								
		F	D1-1A	72	10																								
		F	D1-1A	72	10																								
		F	D1-1A	72	12			6.00							2		X									5			
		F	D1-1A	72	12			6.00																		5			
		F	D1-1A	72	12			6.00																		5			
		F	D1-1A	72	12			6.00																		5			
SB	1.920	F	M4-5	24	12																					REMOVE ALL SIGNS AND THE SIGN FRAME; RETAIN THE TUBULAR POSTS			
		F	M1-1	24	24																								
SIGN SUMMARY SHEET							SHEET TOTALS	31.19	0.00	1	0	0	8	0	0	3	45						PROJECT NAME: Ludlow-Waitsfield VT100						
								SF	SF	EA	EA	EA	EA	EA	EA	EA	FT					PROJECT NUMBER: STPG SIGN(27)							
VERMONT AGENCY OF TRANSPORTATION							TOWN TOTALS	676.7	0.0	3.0	8.0	8.0	140	0.0	0.0	107	1605.0					FILE NAME: Stockbridae.xls	PLOT DATE: 9/9/2009						
																					PROJECT MANAGER: N. Avery	DRAWN BY: I. Shea							
																					DESIGNED BY: M. Miller	CHECKED BY: N. Avery							
																					STOCKBRIDGE SHEET 17	SHEET 96 OF 204							

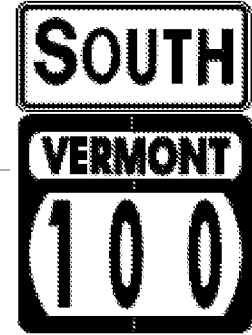DIRECTION	MILEPOINT	LOCATION CODE (SHEET 2)	SIGN CODE	WIDTH (IN)	HEIGHT (IN)	SHEETING REMARKS	SIGN LEGEND	NEW SIGNS		EXISTING SIGNS				EXIST POST		NUMBER OF NEW POSTS	SQUARE STEEL (IN)			TUBULAR STEEL Ø (IN)				SIGN FRAME REQUIRED	REMARKS	SIGN DETAIL					
								"A"	"B"	RETAIN	SALVAGE FROM	SALVAGE TO	REMOVE	RETAIN	REMOVE		1.75	2.00	2.50	3.00	3.50	4.00	5.00			DETAIL IN SHS	DETAIL ON SHEET NUMBER	DETAIL ON STD SHEET NUMBER			
																	(LB / FT)			(LB / FT)											
STOCKBRIDGE VT 100							FY-FLUORESCENT YELLOW FYG-FLUORESCENT YELLOW GREEN															"SHS"-STANDARD HIGHWAY SIGNS									
			F	M6-1	21	15																									
			F	M3-2	24	12																									
			F	M1-5	30	24																									
			F	M6-1	21	15																									
			F	M3-3	24	12																									
			F	M1-5	30	24																									
			F	M6-2	21	15																									
			F	M3-2	24	12																									
			F	M1-5	30	24																									
			F	M6-11L	21	15																									
			F	M4-5	24	12																									
			F	M1-1	24	24																									
			F	M6-1L	21	15																									
			F	M3-3	24	12																									
			F	M1-5	30	24																									
SIGN SUMMARY SHEET							SHEET TOTALS								24.38	0.00	0	0	0	7	0	0	0	0	0						
VERMONT AGENCY OF TRANSPORTATION							SF	SF	EA	EA	EA	EA	EA	EA	EA	EA	EA	EA	EA	EA	EA	EA	EA	EA	EA	EA					
VERMONT AGENCY OF TRANSPORTATION							TOWN TOTALS								676.7	0.0	3.0	8.0	8.0	140	0.0	0.0	107	1605.0							
																					PROJECT NAME:		Ludlow-Waitsfield VT100								
																					PROJECT NUMBER:		STPG SIGN(27)								
																					FILE NAME:		Stockbridae.xls								
																					PLOT DATE:		9/9/2009								
																					PROJECT MANAGER:		N. Avery								
																					DRAWN BY:		I. Shea								
																					DESIGNED BY:		M. Miller								
																					CHECKED BY:		N. Avery								
																					STOCKBRIDGE SHEET 18		SHEET 97 OF 204								



DIRECTION	MILEPOINT	LOCATION CODE (SHEET 2)	SIGN CODE	WIDTH (IN)	HEIGHT (IN)	SHEETING REMARKS	SIGN LEGEND	NEW SIGNS		EXISTING SIGNS				EXIST POST		NUMBER OF NEW POSTS	SQUARE STEEL (IN)			TUBULAR STEEL Ø (IN)				SIGN FRAME REQUIRED	REMARKS	SIGN DETAIL			
								"A"	"B"	RETAIN	SALVAGE FROM	SALVAGE TO	REMOVE	RETAIN	REMOVE		1.75	2.00	2.50	FOUNDATION	3.00	3.50	4.00			5.00	DETAIL IN SHS	DETAIL ON SHEET NUMBER	DETAIL ON STD SHEET NUMBER
																	(LB / FT)				(LB / FT)								
STOCKBRIDGE VT 100							FY-FLUORESCENT YELLOW FYG-FLUORESCENT YELLOW GREEN															"SHS"-STANDARD HIGHWAY SIGNS							
		F	M6-2R	21	15			2.19														GREEN ON WHITE SHEETING	X						
SB	1.880	F	R1-2	48	48		YIELD			1			X																
SB	1.838	F	R2-1	24	30		SPEED LIMIT 50					1		X															
		F	M3-3	24	12			2.00						1		X						GREEN ON WHITE SHEETING	X						
		F	M1-5	30	24			5.00															RESET TO SPEC, NEW POST.			E-136B			
SB	1.800	F	D2-1	72	12		  	6.00						2		X						INSTALL 200 FT± SOUTH OF THE JUST-INSTALLED ROUTE MARKER ASSEMBLY			5				
		F	D2-1	72	12			6.00														MAINTAIN 10 FT MINIMUM TO UTILITY POLE			5				
		F	D2-1	72	12			6.00														RESET TO SPEC.			5				
SB	1.750	F	D2-1	72	12		PITTSFIELD 3					1		X															
		F	D2-1	72	12		KILLINGTON 11					1																	
		F	D2-1	72	12		RUTLAND 22					1																	
SB	1.685	F	M3-3	24	12		SOUTH					1		X															
		F	M1-5	30	24		VERMONT 100					1																	
SB	1.555	F	R2-1	24	30			5.00						1		X						INSTALL 130 FT± SOUTH OF JCT w/ SOUTH HILL RD (TH-19)	RESET TO SPEC, NEW POST.	X					
SB	1.200	F	W11-3	30	30							1		X															
SIGN SUMMARY SHEET							SHEET TOTALS	32.19	0.00	1	0	0	7	0	0	4	60								PROJECT NAME: Ludlow-Waitsfield VT100				
								SF	SF	EA	EA	EA	EA	EA	EA	EA	EA	EA	EA	EA	EA	FT						PROJECT NUMBER: STPG SIGN(27)	
VERMONT AGENCY OF TRANSPORTATION							TOWN TOTALS	676.7	0.0	3.0	8.0	8.0	140	0.0	0.0	107	1605.0						FILE NAME: Stockbridge.xls	PLOT DATE: 9/9/2009					
																						PROJECT MANAGER: N. Avery	DRAWN BY: I. Shea						
																						DESIGNED BY: M. Miller	CHECKED BY: N. Avery						
																						STOCKBRIDGE SHEET 19	SHEET 98	OF 204					

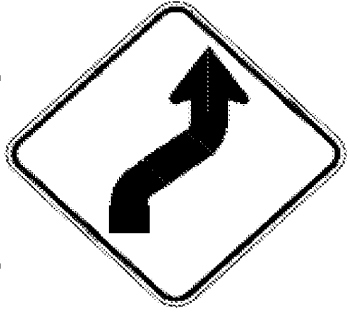


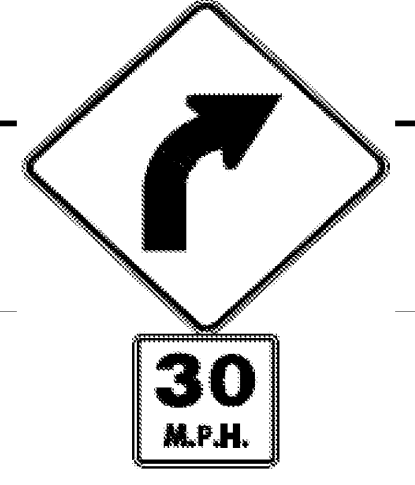
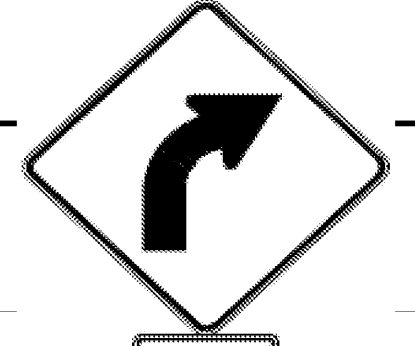
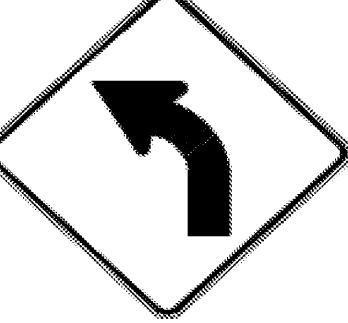
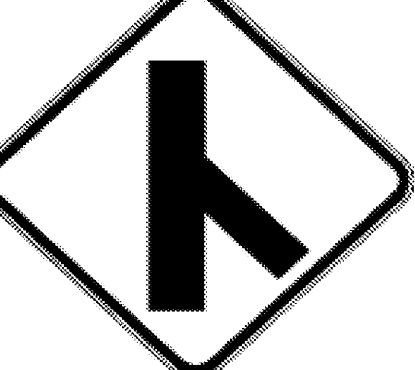



DIRECTION	MILEPOINT	LOCATION CODE (SHEET 2)	SIGN CODE	WIDTH (IN)	HEIGHT (IN)	SHEETING REMARKS	SIGN LEGEND	NEW SIGNS		EXISTING SIGNS				EXIST POST		NUMBER OF NEW POSTS	SQUARE STEEL (IN)			TUBULAR STEEL Ø (IN)				SIGN FRAME REQUIRED	REMARKS	SIGN DETAIL				
								"A"	"B"	RETAIN	SALVAGE FROM	SALVAGE TO	REMOVE	RETAIN	REMOVE		1.75	2.00	2.50	FOUNDATION	3.00	3.50	4.00			5.00	DETAIL IN SHS	DETAIL ON SHEET NUMBER	DETAIL ON STD SHEET NUMBER	
																	(LB / FT)				(LB / FT)									
STOCKBRIDGE VT 100							FY-FLUORESCENT YELLOW FYG-FLUORESCENT YELLOW GREEN																"SHS"-STANDARD HIGHWAY SIGNS							
		F	W7-3A	24	18								1																	
		F	W11-3	30	30			6.25							1		X								X					
		F	W7-3A	24	18			3.00																		X				
SB	0.810	F	W1-2L	30	30		CURVE LEFT						1		X															
		F	W13-1	18	18		40 MPH (PLAQUE)						1																	
SB	0.785	F	W1-2L	30	30	FY			6.25						1		X										INSTALL 130 FT± SOUTH OF PREVIOUS LOCATION			
		F	W13-1	18	18	FY		2.25																			RESET TO SPEC, NEW POST.			
SB	0.710	F	W1-6	48	24	FY		8.00																			235 FT± NORTH OF THE EXISTING BACK-TO-BACK ARROWS, INSTALL THIS NEW BACK-TO-BACK ARROW ASSEMBLY.			
		E	W1-6	48	24	FY		8.00																			RESET TO SPEC, NEW POSTS.			
SB	0.665	F	W1-6	48	24								1		X															
		E	W1-6	48	24								1																	
		F	W1-6	48	24	FY		8.00																			INSTALL BACK-TO-BACK, AS THE EXISTING ASSEMBLY			
		E	W1-6	48	24	FY		8.00																			X			
SB	0.320	F	W1-4R	30	30		REVERSE CURVE RIGHT						1		X															
		F	W13-1	18	18		45 MPH (PLAQUE)						1																	
SIGN SUMMARY SHEET							SHEET TOTALS		49.75	0.00	0	0	0	7	0	0	6	90										PROJECT NAME: Ludlow-Waitsfield VT100		
							SF	SF	EA	EA	EA	EA	EA	EA	EA	EA	EA	FT											PROJECT NUMBER: STPG SIGN(27)	
VERMONT AGENCY OF TRANSPORTATION							TOWN TOTALS		676.7	0.0	3.0	8.0	8.0	140	0.0	0.0	107	1605.0										FILE NAME: Stockbridge.xls		
																													PLOT DATE: 9/9/2009	
																														DRAWN BY: I. Shea
																														CHECKED BY: N. Avery
																														SHEET 99 OF 204





DIRECTION	MILEPOINT	LOCATION CODE (SHEET 2)	SIGN CODE	WIDTH (IN)	HEIGHT (IN)	SHEETING REMARKS	SIGN LEGEND	NEW SIGNS		EXISTING SIGNS				EXIST POST		NUMBER OF NEW POSTS	SQUARE STEEL (IN)			TUBULAR STEEL Ø (IN)				SIGN FRAME REQUIRED	REMARKS	SIGN DETAIL							
								"A"	"B"	RETAIN	SALVAGE FROM	SALVAGE TO	REMOVE	RETAIN	REMOVE		(LB / FT)			(LB / FT)						DETAIL IN SHS	DETAIL ON SHEET NUMBER	DETAIL ON STD SHEET NUMBER					
																	1.75	2.00	2.50	3.00	3.50	4.00	5.00										
STOCKBRIDGE VT 100							FY-FLUORESCENT YELLOW FYG-FLUORESCENT YELLOW GREEN																"SHS"-STANDARD HIGHWAY SIGNS										
SB	0.260	F	W1-4R	30	30			6.25							1		X							INSTALL 370 FT± SOUTH OF PREVIOUS POSITION; MAINTAIN 10 FT MIN TO POLE	X								
SB	0.210	F	VW-059	30	30		HIDDEN DRIVE (SINGULAR)					1					X																
		F	VW-060	30	30			6.25						1			X									7							
SB	0.017	G	VR-017	24	30							1					X							GUERNSEY HOLLOW RD (TH-41)									
		G	VR-017	24	30			5.00						1			X										E-141						
SB	0.011	H	R1-1	30	30							1					X							GUERNSEY HOLLOW RD (TH-41)									
		H	R1-1	30	30			6.25						1			X							REINSTALL THE STREET NAME SIGN ON TOP OF THE NEW POST	X								
SHEET TOTALS								23.75	0.00	0	0	0	3	0	0	4	60																
TOWN TOTALS								676.7	0.0	3.0	8.0	8.0	140	0.0	0.0	107	1605.0																


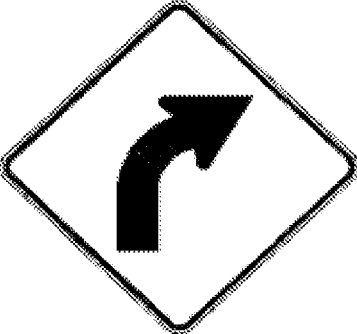

SIGN SUMMARY SHEET

VERMONT AGENCY OF TRANSPORTATION




PROJECT NAME: **Ludlow-Waitsfield VT100**
PROJECT NUMBER: **STPG SIGN(27)**
FILE NAME: **Stockbridge.xls** PLOT DATE: **9/9/2009**
PROJECT MANAGER: **N. Avery** DRAWN BY: **I. Shea**
DESIGNED BY: **M. Miller** CHECKED BY: **N. Avery**
STOCKBRIDGE SHEET 21 SHEET **100** OF **204**





DIRECTION	MILEPOINT	LOCATION CODE (SHEET 2)	SIGN CODE	WIDTH (IN)	HEIGHT (IN)	SHEETING REMARKS	SIGN LEGEND	NEW SIGNS		EXISTING SIGNS				EXIST POST		NUMBER OF NEW POSTS	SQUARE STEEL (IN)			TUBULAR STEEL Ø (IN)				SIGN FRAME REQUIRED	REMARKS	SIGN DETAIL		
								"A"	"B"	RETAIN	SALVAGE FROM	SALVAGE TO	REMOVE	RETAIN	REMOVE		1.75	2.00	2.50	3.00	3.50	4.00	5.00			DETAIL IN SHS	DETAIL ON SHEET NUMBER	DETAIL ON STD SHEET NUMBER
																	(LB / FT)			(LB / FT)								
ROCHESTER VT 100							FY-FLUORESCENT YELLOW FYG-FLUORESCENT YELLOW GREEN															"SHS"-STANDARD HIGHWAY SIGNS						
NB	0.000	C	VD-024	60	7.5																							
		C	VD-024	72	12			5.00										X							4			
		C	VD-700	6	10			0.42																		E-138		
		C	VD-700	6	10			0.42																		E-138		
NB	0.083	A	W1-2R	36	36		RIGHT CURVE																					
		A	W13-1	24	24		30 MPH PLAQUE 																					
NB	0.120	A	W1-2R	36	36	FY		9.00																				
		A	W13-1	24	24	FY		4.00																				
NB	0.610	A	W1-2L	30	30																							
		A	W1-2L	30	30			6.25																				
NB	0.925	A	W2-3MaR	30	30			6.25																				
		A	W16-8	30	8			1.67																		6		
NB	0.998	C	VR-017	24	30																							
		C	VR-017	24	30			5.00																				
NB	1.005	D	R1-1	30	30																							
SIGN SUMMARY SHEET							SHEET TOTALS	38.01	0.00	0	0	0	6	0	0	7	105					PROJECT NAME: Ludlow-Waitsfield VT100						
								SF	SF	EA	EA	EA	EA	EA	EA	EA	FT					PROJECT NUMBER: STPG SIGN(27)						
							TOWN TOTALS	593.8	0.0	60.0	9.0	9.0	115	0.0	0.0	102	1530.0					FILE NAME: Rochester.xls	PLOT DATE: 9/10/2009					
VERMONT AGENCY OF TRANSPORTATION																					PROJECT MANAGER: N. Avery	DRAWN BY: I. Shea						
																					DESIGNED BY: J. Kelly	CHECKED BY: N. Avery						
																					ROCHESTER SHEET 1	SHEET 101 OF 204						




DIRECTION	MILEPOINT	LOCATION CODE (SHEET 2)	SIGN CODE	WIDTH (IN)	HEIGHT (IN)	SHEETING REMARKS	SIGN LEGEND	NEW SIGNS		EXISTING SIGNS				EXIST POST		NUMBER OF NEW POSTS	SQUARE STEEL (IN)			TUBULAR STEEL Ø (IN)				SIGN FRAME REQUIRED	REMARKS	SIGN DETAIL			
								"A"	"B"	RETAIN	SALVAGE FROM	SALVAGE TO	REMOVE	RETAIN	REMOVE		1.75	2.00	2.50	3.00	3.50	4.00	5.00			DETAIL IN SHS	DETAIL ON SHEET NUMBER	DETAIL ON STD SHEET NUMBER	
																	(LB / FT)			(LB / FT)									
ROCHESTER VT 100							FY-FLUORESCENT YELLOW FYG-FLUORESCENT YELLOW GREEN																"SHS"-STANDARD HIGHWAY SIGNS						
		D	R1-1	30	30			6.25							1	X								X					
NB	1.245	A	VD-062AS	72	16		BUSINESS SIGN			1																			
								6.25							1	X										6			
		A	W16-8	30	8			1.67																	8				
NB	1.470	C	VR-017	24	30		LEGAL LOAD LIMIT 24,000 LBS			1																			
NB	1.477	D	R1-1	30	30		STOP			1																			
NB	1.740	A	R2-1	24	30		SPEED LIMIT 50							1		X													
NB	2.400	A	R2-1	24	30			5.00						1	X									X					
NB	2.540	A	VD-062AS	72	16		BUSINESS SIGN			1																			
NB	2.934	A	VD-018	30	18					1																			
		A	VD-018	30	18			3.75						1	X												E-128A		
NB	3.602	A	W3-5	36	36		SPEED REDUCTION (40)			1																			
NB	3.708	A	R2-1	30	36		SPEED LIMIT 40			1																			
NB	3.825	A	R2-1	24	30		SPEED LIMIT 40			1																			
NB	4.039	A	R2-1	24	30									1		X													
SIGN SUMMARY SHEET							SHEET TOTALS		22.92	0.00	8	0	0	2	0	0	4	60											
							SF	SF	EA	EA	EA	EA	EA	EA	EA	EA	EA	FT											
VERMONT AGENCY OF TRANSPORTATION							TOWN TOTALS		593.8	0.0	60.0	9.0	9.0	115	0.0	0.0	102	1530.0											
							PROJECT NAME: Ludlow-Waitsfield VT100															PROJECT NUMBER: STPG SIGN(27)							
							FILE NAME: Rochester.xls															PLOT DATE: 9/10/2009							
							PROJECT MANAGER: N. Avery															DRAWN BY: I. Shea							
							DESIGNED BY: J. Kelly															CHECKED BY: N. Avery							
							ROCHESTER SHEET 2															SHEET 102 OF 204							




DIRECTION	MILEPOINT	LOCATION CODE (SHEET 2)	SIGN CODE	WIDTH (IN)	HEIGHT (IN)	SHEETING REMARKS	SIGN LEGEND	NEW SIGNS		EXISTING SIGNS				EXIST POST		NUMBER OF NEW POSTS	SQUARE STEEL (IN)			TUBULAR STEEL Ø (IN)				SIGN FRAME REQUIRED	REMARKS	SIGN DETAIL			
								"A"	"B"	RETAIN	SALVAGE FROM	SALVAGE TO	REMOVE	RETAIN	REMOVE		1.75	2.00	2.50	FOUNDATION	3.00	3.50	4.00			5.00	DETAIL IN SHS	DETAIL ON SHEET NUMBER	DETAIL ON STD SHEET NUMBER
																	(LB / FT)				(LB / FT)								
																	1.88	2.42	3.35		7.60	9.00	10.80			14.60			
ROCHESTER VT 100							FY-FLUORESCENT YELLOW FYG-FLUORESCENT YELLOW GREEN														"SHS"-STANDARD HIGHWAY SIGNS								
		A	R2-1	24	30			5.00						1	X								X						
NB	4.145	A	W1-2R	30	30		RIGHT CURVE			1					X														
		A	W1-2R	30	30		RIGHT CURVE				1			1	X							RETAIN SIGN AND INSTALL ON NEW POST AT SAME LOCATION.	X						
NB	4.260	A	W1-2R	30	30								1		X							RESET TO SPEC, NEW POST.							
		A	W1-2R	30	30				6.25					1	X								X						
NB	4.295	A	VD-062B	72	16		BUSINESS SIGN			1					X														
		A	VD-062B	72	16		BUSINESS SIGN			1																			
NB	4.365	A	M2-1	21	15								1		X							GREEN ON WHITE SHEETING	X						
		A	M1-5A	24	24									1															
		A	M2-1	21	15				2.19								1	X											
		A	M1-5A	24	24				4.00																E-136B				
NB	4.445	A	D1-1A	72	10								1		X														
		A	D1-1A	72	10								1																
		A	D1-1A	72	10								1																
		A	D1-1A	72	10								1																
SIGN SUMMARY SHEET							SHEET TOTALS	17.44	0.00	2	1	1	7	0	0	4	60					PROJECT NAME: Ludlow-Waitsfield VT100							
								SF	SF	EA	EA	EA	EA	EA	EA	EA	FT					PROJECT NUMBER: STPG SIGN(27)							
VERMONT AGENCY OF TRANSPORTATION							TOWN TOTALS	593.8	0.0	60.0	9.0	9.0	115	0.0	0.0	102	1530.0					FILE NAME: Rochester.xls	PLOT DATE: 9/10/2009						
																						PROJECT MANAGER: N. Avery	DRAWN BY: I. Shea						
																						DESIGNED BY: J. Kelly	CHECKED BY: N. Avery						
																						ROCHESTER SHEET 3	SHEET 103 OF 204						







DIRECTION	MILEPOINT	LOCATION CODE (SHEET 2)	SIGN CODE	WIDTH (IN)	HEIGHT (IN)	SHEETING REMARKS	SIGN LEGEND	NEW SIGNS		EXISTING SIGNS				EXIST POST		NUMBER OF NEW POSTS	SQUARE STEEL (IN)			TUBULAR STEEL Ø (IN)				SIGN FRAME REQUIRED	REMARKS	SIGN DETAIL		
								"A"	"B"	RETAIN	SALVAGE FROM	SALVAGE TO	REMOVE	RETAIN	REMOVE		(LB / FT)			(LB / FT)						DETAIL IN SHS	DETAIL ON SHEET NUMBER	DETAIL ON STD SHEET NUMBER
																	1.75	2.00	2.50	3.00	3.50	4.00	5.00					
ROCHESTER VT 100							FY-FLUORESCENT YELLOW FYG-FLUORESCENT YELLOW GREEN															"SHS"-STANDARD HIGHWAY SIGNS						
		A	D1-1A	72	10						1																	
		A	D1-1A	72	12			6.00						2			X								5			
		A	D1-1A	72	12			6.00																	5			
		A	D1-1A	72	12			6.00																	5			
		A	D1-1A	72	12			6.00																	5			
NB	4.475	A	M3-4	24	12							1																
		A	M1-5A	24	24							1																
		A	M6-1	21	15							1																
		A	M3-1	24	12							1																
		A	M1-5A	24	24							1																
		A	M6-3	21	15							1																
		A	M3-4	24	12			2.00						2		X						#2A	GREEN ON WHITE SHEETING	X				
		A	M1-5	24	24			4.00																		E-136B		
		A	M6-1L	21	15			2.19															GREEN ON WHITE SHEETING	X				
		A	M3-1	24	12			2.00																GREEN ON WHITE SHEETING	X			
SIGN SUMMARY SHEET								SHEET TOTALS		34.19	0.00	0	0	0	7	0	0	4	60			PROJECT NAME: Ludlow-Waitsfield VT100						
VERMONT AGENCY OF TRANSPORTATION								SF	SF	EA	EA	EA	EA	EA	EA	EA	EA		FT			PROJECT NUMBER: STPG SIGN(27)	FILE NAME: Rochester.xls	PLOT DATE: 9/10/2009				
VERMONT AGENCY OF TRANSPORTATION								TOWN TOTALS		593.8	0.0	60.0	9.0	9.0	115	0.0	0.0	102	1530.0			PROJECT MANAGER: N. Avery	DRAWN BY: I. Shea					
VERMONT AGENCY OF TRANSPORTATION								TOWN TOTALS		593.8	0.0	60.0	9.0	9.0	115	0.0	0.0	102	1530.0			DESIGNED BY: J. Kelly	CHECKED BY: N. Avery	SHEET 104	OF	204		



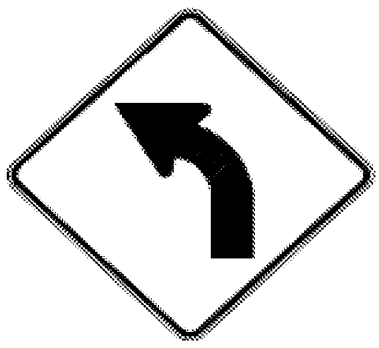



DIRECTION	MILEPOINT	LOCATION CODE (SHEET 2)	SIGN CODE	WIDTH (IN)	HEIGHT (IN)	SHEETING REMARKS	SIGN LEGEND	NEW SIGNS		EXISTING SIGNS				EXIST POST		NUMBER OF NEW POSTS	SQUARE STEEL (IN)			TUBULAR STEEL Ø (IN)				SIGN FRAME REQUIRED	REMARKS	SIGN DETAIL					
								"A"	"B"	RETAIN	SALVAGE FROM	SALVAGE TO	REMOVE	RETAIN	REMOVE		(LB / FT)			(LB / FT)						DETAIL IN SHS	DETAIL ON SHEET NUMBER	DETAIL ON STD SHEET NUMBER			
																	1.75	2.00	2.50	3.00	3.50	4.00	5.00								
ROCHESTER VT 100							FY-FLUORESCENT YELLOW FYG-FLUORESCENT YELLOW GREEN															"SHS"-STANDARD HIGHWAY SIGNS									
			A	M1-5	30	24		5.00																			E-136B				
			A	M6-3	21	15		2.19																			GREEN ON WHITE SHEETING	X			
NB	4.477		C	W1-7	48	24							1	X																	
			C	W1-7	48	24		8.00								2	X														
NB	4.505		A	M3-1	24	12							1	X																	
			A	M1-5A	24	24							1																		
			A	M3-1	24	12		2.00								1	X											GREEN ON WHITE SHEETING	X		
			A	M1-5	30	24		5.00																				E-136B			
NB	4.545		A	D2-1	72	10							1	X																	
			A	D2-1	72	10							1																		
			A	D2-1	72	12		6.00								2	X														
			A	D2-1	72	12		6.00																							
NB	4.585		A	W3-5	36	36	SPEED REDUCTION (30)					1		X																	
NB	4.620		A	W3-5	36	36	SPEED REDUCTION (30)						1															REINSTALL SPEED REDUCTION SIGN 185 FEET NORTH OF EXISTING LOCATION.			
NB	4.635		A	VD-018	30	18	ROCHESTER VILLAGE SIGN						1															REINSTALL VILLAGE SIGN 160 FEET NORTH OF EXISTING LOCATION.			
SIGN SUMMARY SHEET							SHEET TOTALS		34.19	0.00	0	2	1	5	0	0	7	105													
VERMONT AGENCY OF TRANSPORTATION							SF	SF	EA	EA	EA	EA	EA	EA	EA	EA	EA	EA	FT												
							TOWN TOTALS		593.8	0.0	60.0	9.0	9.0	115	0.0	0.0	102	1530.0													
																			PROJECT NAME:	Ludlow-Waitsfield VT100											
																			PROJECT NUMBER:	STPG SIGN(27)											
																			FILE NAME:	Rochester.xls					PLOT DATE:	9/10/2009					
																			PROJECT MANAGER:	N. Avery					DRAWN BY:	I. Shea					
																			DESIGNED BY:	J. Kelly					CHECKED BY:	N. Avery					
																			ROCHESTER SHEET 5					SHEET 105 OF 204							


DIRECTION	MILEPOINT	LOCATION CODE (SHEET 2)	SIGN CODE	WIDTH (IN)	HEIGHT (IN)	SHEETING REMARKS	SIGN LEGEND	NEW SIGNS		EXISTING SIGNS				EXIST POST		NUMBER OF NEW POSTS	SQUARE STEEL (IN)			TUBULAR STEEL Ø (IN)				SIGN FRAME REQUIRED	REMARKS	SIGN DETAIL		
								"A"	"B"	RETAIN	SALVAGE FROM	SALVAGE TO	REMOVE	RETAIN	REMOVE		(LB / FT)			(LB / FT)						DETAIL IN SHS	DETAIL ON SHEET NUMBER	DETAIL ON STD SHEET NUMBER
																	1.75	2.00	2.50	3.00	3.50	4.00	5.00					
ROCHESTER VT 100							FY-FLUORESCENT YELLOW FYG-FLUORESCENT YELLOW GREEN																"SHS"-STANDARD HIGHWAY SIGNS					
NB	4.665	A	W2-2R	30	30		RIGHT SIDE ROAD																					
		A	VD-018	30	18		ROCHESTER VILLAGE SIGN				1																	
NB	4.715	A	R2-1	30	36																							
		A	R2-1	30	36			7.50																		6		
NB	4.755	C	VR-017	24	30		LEGAL LOAD LIMIT 24,000 LBS																					
		C	N/A				(TOWN'S WOODLAWN CEMETARY SIGN)				1	1																
NB	4.760	D	R1-1	30	30		STOP																					
NB	4.957	C	VR-017	24	30																							
		C	VR-017	24	30			5.00																		E-141		
NB	4.962	D	R1-1	30	30																							
		D	R1-1	30	30			6.25																	X			
NB	4.965	A	S1-1YG	36	36		SCHOOL PENTAGON				1																	
		A	W16-9YG	24	10		AHEAD				1																	
NB	4.990	A	R2-1	24	30																							
		A	R2-1	24	30			5.00																	X			
SIGN SUMMARY SHEET							SHEET TOTALS	23.75	0.00	2	1	2	7	0	0	5	75								PROJECT NAME: Ludlow-Waitsfield VT100			
								SF	SF	EA	EA	EA	EA	EA	EA	EA	FT							PROJECT NUMBER: STPG SIGN(27)				
VERMONT AGENCY OF TRANSPORTATION							TOWN TOTALS	593.8	0.0	60.0	9.0	9.0	115	0.0	0.0	102	1530.0							FILE NAME: Rochester.xls				
																								PLOT DATE: 9/10/2009				
																								DRAWN BY: I. Shea				
																								CHECKED BY: N. Avery				
																								DESIGNED BY: J. Kelly				
																								ROCHESTER SHEET 6				
																								SHEET 106 OF 204				


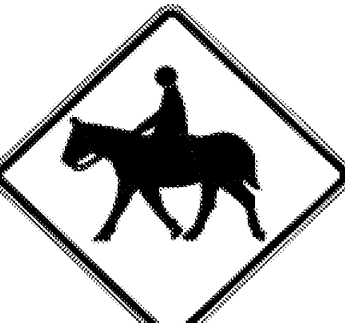
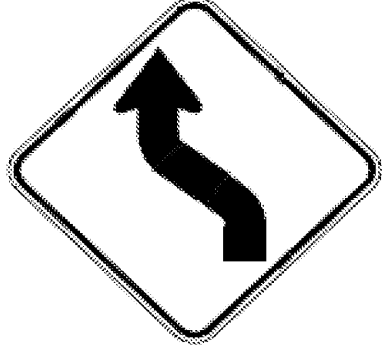

DIRECTION	MILEPOINT	LOCATION CODE (SHEET 2)	SIGN CODE	WIDTH (IN)	HEIGHT (IN)	SHEETING REMARKS	SIGN LEGEND	NEW SIGNS		EXISTING SIGNS				EXIST POST		NUMBER OF NEW POSTS	SQUARE STEEL (IN)			TUBULAR STEEL Ø (IN)				SIGN FRAME REQUIRED	REMARKS	SIGN DETAIL							
								"A"	"B"	RETAIN	SALVAGE FROM	SALVAGE TO	REMOVE	RETAIN	REMOVE		1.75	2.00	2.50	3.00	3.50	4.00	5.00			DETAIL IN SHS	DETAIL ON SHEET NUMBER	DETAIL ON STD SHEET NUMBER					
																	(LB / FT)			(LB / FT)													
ROCHESTER VT 100							FY-FLUORESCENT YELLOW FYG-FLUORESCENT YELLOW GREEN																"SHS"-STANDARD HIGHWAY SIGNS										
NB	5.080	A	VD-062BC	74.75	16		TRAVEL INFO SIGN			1																							
		A	VD-062C	74.75	16		TRAVEL INFO SIGN			1																							
NB	5.125	A	S1-1YG	36	36		SCHOOL PENTAGON			1																							
		A	W16-7YG	30	18		DIAGONAL ARROW			1																							
NB	5.210	C	VR-017	24	30								1																	TH-22, PARK ROW			
		D	R1-1	30	30								1																				
		C	VR-017	24	30			5.00							1		X													INSTALL BACK TO BACK AS EXISTING			
		D	R1-1	30	30			6.25																						X			
NB	5.225	A	R2-1	24	30							1					X																
		A	R2-1	24	30			5.00							1		X													X			
NB	5.250	A	W11-2YG	30	30		PEDESTRIAN			1																							
		A	W16-7YG	24	12		DIAGONAL ARROW			1																							
NB	5.267	A	W11-8	30	30		FIRE TRUCK			1							X																
NB	5.272	C	VR-017	24	30		LEGAL LOAD LIMIT 24,000 LBS			1							X													TH-1, BETHEL MTN ROAD SOUTH SIDE OF ROAD			
		D	R1-1	30	30		STOP			1																				RETAIN BACK TO BACK ASSEMBLY			
SIGN SUMMARY SHEET							SHEET TOTALS		16.25	0.00	9	0	0	3	0	0	2	30															
VERMONT AGENCY OF TRANSPORTATION							SF	SF	EA	EA	EA	EA	EA	EA	EA	EA	EA	EA	FT														
							TOWN TOTALS		593.8	0.0	60.0	9.0	9.0	115	0.0	0.0	102	1530.0															
															PROJECT NAME:	Ludlow-Waitsfield VT100																	
															PROJECT NUMBER:	STPG SIGN(27)																	
															FILE NAME:	Rochester.xls						PLOT DATE:	9/10/2009										
															PROJECT MANAGER:	N. Avery						DRAWN BY:	I. Shea										
															DESIGNED BY:	J. Kelly						CHECKED BY:	N. Avery										
															ROCHESTER SHEET 7													SHEET 107 OF 204					

DIRECTION	MILEPOINT	LOCATION CODE (SHEET 2)	SIGN CODE	WIDTH (IN)	HEIGHT (IN)	SHEETING REMARKS	SIGN LEGEND	NEW SIGNS		EXISTING SIGNS				EXIST POST		NUMBER OF NEW POSTS	SQUARE STEEL (IN)			TUBULAR STEEL Ø (IN)				SIGN FRAME REQUIRED	REMARKS	SIGN DETAIL		
								"A"	"B"	RETAIN	SALVAGE FROM	SALVAGE TO	REMOVE	RETAIN	REMOVE		1.75	2.00	2.50	3.00	3.50	4.00	5.00			DETAIL IN SHS	DETAIL ON SHEET NUMBER	DETAIL ON STD SHEET NUMBER
																	(LB / FT)			(LB / FT)								
																	1.88	2.42	3.35	FOUNDATION	7.60	9.00	10.80					
ROCHESTER VT 100							FY-FLUORESCENT YELLOW FYG-FLUORESCENT YELLOW GREEN															"SHS"-STANDARD HIGHWAY SIGNS						
NB	5.320	A	W11-2YG	30	30		PEDESTRIAN			1				X														
		A	W16-7YG	24	12		DIAGONAL ARROW			1																		
NB	5.340	C	VR-017	24	30									1														
		C	VR-017	24	30				5.00						1			X										
		D	R1-1	30	30		STOP			1	1																	
NB	5.342	A	W11-2YG	30	30		PEDESTRIAN			1				X														
		A	W16-7YG	24	12		DIAGONAL ARROW			1																		
NB	5.422	A	R2-1	24	30									1														
		A	R2-1	30	30				6.25						1			X							X			
NB	5.447	A	W1-2L	30	30		LEFT CURVE							1														
																												
NB	5.480	A	W1-2L	30	30				6.25						1			X							X			
NB	5.507	C	VR-017	24	30		LEGAL LOAD LIMIT 24,000 LBS			1				X														
		D	R1-1	30	30		STOP			1																		
NB	5.530	A	VW-619	30	30		SHOULDER NARROWS			1				X														
NB	5.574	A	R2-1	24	30									1														
SIGN SUMMARY SHEET							SHEET TOTALS		17.50	0.00	7	1	1	4	0	0	3	45					PROJECT NAME: Ludlow-Waitsfield VT100					
									SF	SF	EA	EA	EA	EA	EA	EA	EA	FT					PROJECT NUMBER: STPG SIGN(27)					
VERMONT AGENCY OF TRANSPORTATION							TOWN TOTALS		593.8	0.0	60.0	9.0	9.0	115	0.0	0.0	102	1530.0					FILE NAME: Rochester.xls					
																							PLOT DATE: 9/10/2009					
																							DRAWN BY: I. Shea					
																							DESIGNED BY: J. Kelly					
																							CHECKED BY: N. Avery					
																							SHEET 108 OF 204					

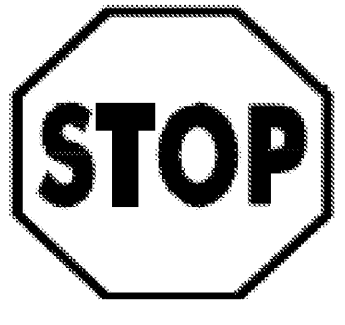
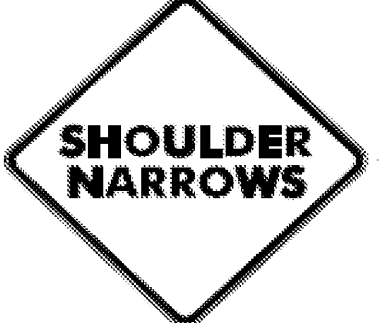
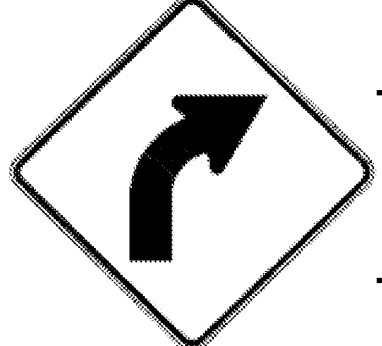
DIRECTION	MILEPOINT	LOCATION CODE (SHEET 2)	SIGN CODE	WIDTH (IN)	HEIGHT (IN)	SHEETING REMARKS	SIGN LEGEND	NEW SIGNS		EXISTING SIGNS				EXIST POST		NUMBER OF NEW POSTS	SQUARE STEEL (IN)			TUBULAR STEEL Ø (IN)				SIGN FRAME REQUIRED	REMARKS	SIGN DETAIL		
								"A"	"B"	RETAIN	SALVAGE FROM	SALVAGE TO	REMOVE	RETAIN	REMOVE		1.75	2.00	2.50	3.00	3.50	4.00	5.00			DETAIL IN SHS	DETAIL ON SHEET NUMBER	DETAIL ON STD SHEET NUMBER
																	(LB / FT)			(LB / FT)								
ROCHESTER VT 100							FY-FLUORESCENT YELLOW FYG-FLUORESCENT YELLOW GREEN															"SHS"-STANDARD HIGHWAY SIGNS						
			A	R2-1	24	30		5.00											X					X				
NB	5.812		A	D5-5A	24	24						1			X													
			A	VD-058	24	8						1																
			A	D5-5A	24	24		4.00							1		X							X				
			A	VD-058	24	8		1.33																		E-132		
NB	5.863		A	W1-4L	30	30	LEFT REVERSE CURVE					1			X													
NB	5.902		A	W11-7	30	30							1			X												
			A	W11-7	30	30		6.25							1		X							X				
			F	W11-7P	24	18	EQUESTRIAN XING						1															
NB	5.951		A	W1-4L	30	30		6.25							1		X						INSTALL 260 FEET NORTH OF EQUESTRIAN SIGN ASSEMBLY	X				
NB	5.984		A	R2-1	24	30						1				X												
			A	R2-1	24	30		5.00							1		X							X				
NB	6.376		C	VR-017	24	30							1			X							TH-16, SKY HOLLOW RD					
			C	VR-017	24	30		5.00							1		X									E-141		
NB	6.383		D	R1-1	30	30							1			X							TH-16, SKY HOLLOW RD					
SIGN SUMMARY SHEET							SHEET TOTALS	32.83	0.00	0	0	0	8	0	0	6	90						PROJECT NAME: Ludlow-Waitsfield VT100					
							SF	SF	EA	EA	EA	EA	EA	EA	EA	EA	EA	EA	EA	EA	EA	EA	EA	EA	EA	EA	PROJECT NUMBER: STPG SIGN(27)	
VERMONT AGENCY OF TRANSPORTATION							TOWN TOTALS	593.8	0.0	60.0	9.0	9.0	115	0.0	0.0	102	1530.0						FILE NAME: Rochester.xls					
							PROJECT MANAGER: N. Avery			PLOT DATE: 9/10/2009																		
DESIGNED BY: J. Kelly			DRAWN BY: I. Shea																									
ROCHESTER SHEET 9			CHECKED BY: N. Avery																									
SHEET 109 OF 204			SHEET																									

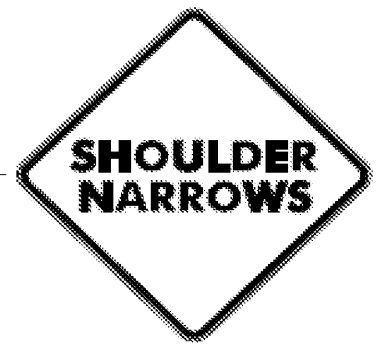

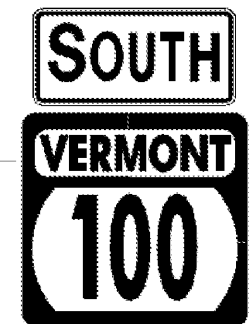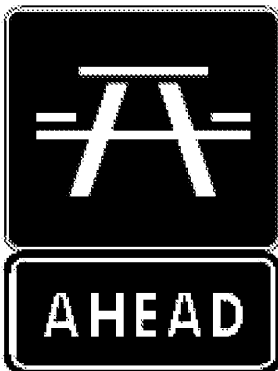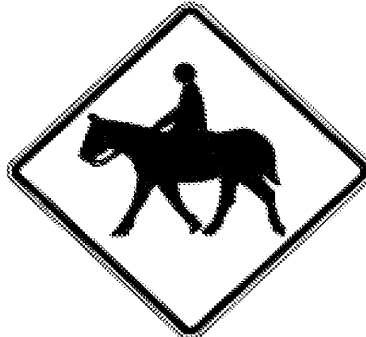



DIRECTION	MILEPOINT	LOCATION CODE (SHEET 2)	SIGN CODE	WIDTH (IN)	HEIGHT (IN)	SHEETING REMARKS	SIGN LEGEND	NEW SIGNS		EXISTING SIGNS				EXIST POST		NUMBER OF NEW POSTS	SQUARE STEEL (IN)			TUBULAR STEEL Ø (IN)				SIGN FRAME REQUIRED	REMARKS	SIGN DETAIL		
								"A"	"B"	RETAIN	SALVAGE FROM	SALVAGE TO	REMOVE	RETAIN	REMOVE		(LB / FT)			(LB / FT)						DETAIL IN SHS	DETAIL ON SHEET NUMBER	DETAIL ON STD SHEET NUMBER
																	1.75	2.00	2.50	3.00	3.50	4.00	5.00					
ROCHESTER VT 100							FY-FLUORESCENT YELLOW FYG-FLUORESCENT YELLOW GREEN																"SHS"-STANDARD HIGHWAY SIGNS					
		D	R1-1	30	30			6.25							1	X									X			
			N/A				TOWN'S STREET NAME SIGN			1	1																	
NB	6.406	A	VW-619	30	30								1		X													
		A	VW-619	30	30			6.25							1	X										6		
NB	6.530	A	W1-2R	30	30			6.25							1	X									X			
NB	6.802	A	VD-062AS	72	16		BUSINESS SIGN			1				X														
NB	6.842	A	VD-062B	72	16		BUSINESS SIGN			1				X														
		A	VD-062AS	72	16		BUSINESS SIGN			1																		
NB	6.919	A	VD-062D	24	24		TRAVEL INFO SIGN			1				X														
NB	7.114	C	VR-017	24	30								1		X													
		C	VR-017	24	30			5.00							1	X										E-141		
NB	7.121	D	R1-1	30	30								1		X													
		D	R1-1	30	30			6.25							1	X									X			
NB	7.180	A	VW-619	30	30								1		X													
		A	VW-619	30	30			6.25							1	X										E-151		
SIGN SUMMARY SHEET							SHEET TOTALS	36.25	0.00	4	1	1	4	0	0	6	90								PROJECT NAME: Ludlow-Waitsfield VT100			
								SF	SF	EA	EA	EA	EA	EA	EA	EA	FT									PROJECT NUMBER: STPG SIGN(27)		
							TOWN TOTALS	593.8	0.0	60.0	9.0	9.0	115	0.0	0.0	102	1530.0								FILE NAME: Rochester.xls			
VERMONT AGENCY OF TRANSPORTATION																									PLOT DATE: 9/10/2009			
																									DRAWN BY: I. Shea			
																									DESIGNED BY: J. Kelly			
																									CHECKED BY: N. Avery			
																									SHEET 110 OF 204			

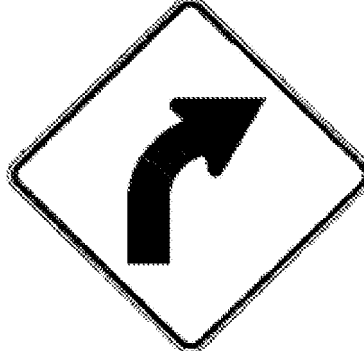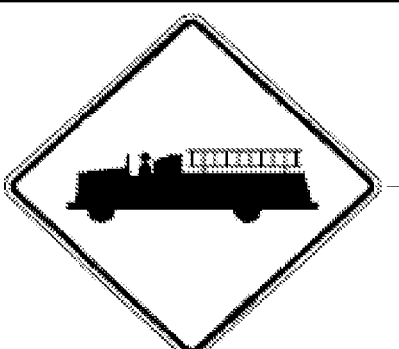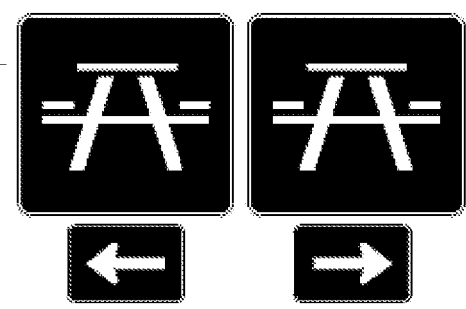


DIRECTION	MILEPOINT	LOCATION CODE (SHEET 2)	SIGN CODE	WIDTH (IN)	HEIGHT (IN)	SHEETING REMARKS	SIGN LEGEND	NEW SIGNS		EXISTING SIGNS				EXIST POST		NUMBER OF NEW POSTS	SQUARE STEEL (IN)			TUBULAR STEEL Ø (IN)				SIGN FRAME REQUIRED	REMARKS	SIGN DETAIL			
								"A"	"B"	RETAIN	SALVAGE FROM	SALVAGE TO	REMOVE	RETAIN	REMOVE		1.75	2.00	2.50	3.00	3.50	4.00	5.00			DETAIL IN SHS	DETAIL ON SHEET NUMBER	DETAIL ON STD SHEET NUMBER	
																	(LB / FT)			(LB / FT)									
ROCHESTER VT 100							FY-FLUORESCENT YELLOW FYG-FLUORESCENT YELLOW GREEN															"SHS"-STANDARD HIGHWAY SIGNS							
NB	7.218	A	M3-1S	24	12																								
		A	M1-5	30	24																								
		A	M3-1	24	12			2.00							1		X												
		A	M1-5	30	24			5.00																				E-136B	
NB	7.907	A	W11-7	30	30		EQUESTRIAN SIGN					1																	
NB	8.191	A	W1-2L	30	30		LEFT CURVE					1																	
SB	8.128	F	W11-7	30	30		EQUESTRIAN SIGN					1																	
SB	7.632	F	VD-062AS	72	16		BUSINESS SIGN					1																	
SB	7.562	F	VD-062C	74.75	16		TRAVEL INFO SIGN					1																	
		F	VD-062BC	74.75	16		TRAVEL INFO SIGN					1																	
SB	7.467	F	VD-062B	72	16		BUSINESS SIGN					1																	
		F	VD-062AS	72	16		BUSINESS SIGN					1																	
SB	7.237	F	M3-3S	24	12		SOUTH																						
		F	M1-5	30	24		VERMONT 100																						
SB	7.107	F	VD-062D	24	24		TRAVEL INFO SIGN																					RETAIN SIGN AND REPLACE POST.	
SIGN SUMMARY SHEET							SHEET TOTALS	7.00	0.00	8	1	1	4	0	0	2	30							PROJECT NAME: Ludlow-Waitsfield VT100					
								SF	SF	EA	EA	EA	EA	EA	EA	EA	FT							PROJECT NUMBER: STPG SIGN(27)					
VERMONT AGENCY OF TRANSPORTATION							TOWN TOTALS	593.8	0.0	60.0	9.0	9.0	115	0.0	0.0	102	1530.0							FILE NAME: Rochester.xls					
																								PLOT DATE: 9/10/2009					
																								PROJECT MANAGER: N. Avery					
																								DRAWN BY: I. Shea					
																								DESIGNED BY: J. Kelly					
																								CHECKED BY: N. Avery					
																								ROCHESTER SHEET 11					
																								SHEET 111 OF 204					






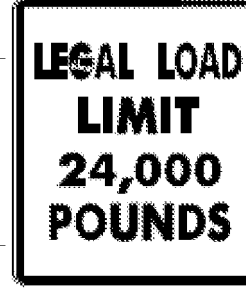

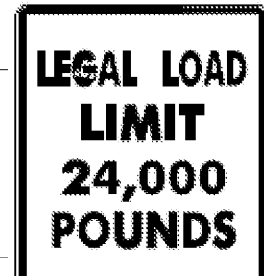DIRECTION	MILEPOINT	LOCATION CODE (SHEET 2)	SIGN CODE	WIDTH (IN)	HEIGHT (IN)	SHEETING REMARKS	SIGN LEGEND	NEW SIGNS		EXISTING SIGNS				EXIST POST		NUMBER OF NEW POSTS	SQUARE STEEL (IN)			TUBULAR STEEL Ø (IN)				SIGN FRAME REQUIRED	REMARKS	SIGN DETAIL		
								"A"	"B"	RETAIN	SALVAGE FROM	SALVAGE TO	REMOVE	RETAIN	REMOVE		1.75	2.00	2.50	3.00	3.50	4.00	5.00			DETAIL IN SHS	DETAIL ON SHEET NUMBER	DETAIL ON STD SHEET NUMBER
																	(LB / FT)			(LB / FT)								
ROCHESTER VT 100							FY-FLUORESCENT YELLOW FYG-FLUORESCENT YELLOW GREEN																"SHS"-STANDARD HIGHWAY SIGNS					
SB	6.932	F	M3-3	24	12			2.00															INSTALL AT EDGE OF MOWED LAWN. GREEN ON WHITE SHEETING					
		F	M1-5	30	24			5.00																	X			
SB	6.755	F	W1-2L	30	30			6.25															INSTALL ON NORTH SIDE OF UTILITY POLE WITH TWIN GUY WIRES			E-136B		
SB	6.355	F	VD-062B	72	16		BUSINESS SIGN			1																		
SB	6.260	F	W1-4L	30	30		LEFT REVERSE CURVE																					
SB	6.220	F	D5-5A	24	24																							
		F	VD-058	24	8																							
		F	D5-5A	24	24			4.00																	X			
		F	VD-058	24	8			1.33																		E-132		
SB	6.150	F	W11-7	30	30																							
		F	W11-7	30	30				6.25																X			
		F	W11-7P	18	18			EQUESTRIAN XING																				
SB	6.115	F	VW-619	30	30																							
		F	VW-619	30	30				6.25																		6	
SB	6.093	F	W3-5	36	36		SPEED REDUCTION (40)			1																		
SIGN SUMMARY SHEET							SHEET TOTALS	31.08	0.00	2	0	0	6	0	0	5	75							PROJECT NAME: Ludlow-Waitsfield VT100				
								SF	SF	EA	EA	EA	EA	EA	EA	EA	FT						PROJECT NUMBER: STPG SIGN(27)					
VERMONT AGENCY OF TRANSPORTATION							TOWN TOTALS	593.8	0.0	60.0	9.0	9.0	115	0.0	0.0	102	1530.0						FILE NAME: Rochester.xls	PLOT DATE: 9/10/2009				
																						PROJECT MANAGER: N. Avery	DRAWN BY: I. Shea					
																						DESIGNED BY: J. Kelly	CHECKED BY: N. Avery					
																						ROCHESTER SHEET 12	SHEET 112 OF 204					


DIRECTION	MILEPOINT	LOCATION CODE (SHEET 2)	SIGN CODE	WIDTH (IN)	HEIGHT (IN)	SHEETING REMARKS	SIGN LEGEND	NEW SIGNS		EXISTING SIGNS				EXIST POST		NUMBER OF NEW POSTS	SQUARE STEEL (IN)			TUBULAR STEEL Ø (IN)				SIGN FRAME REQUIRED	REMARKS	SIGN DETAIL			
								"A"	"B"	RETAIN	SALVAGE FROM	SALVAGE TO	REMOVE	RETAIN	REMOVE		1.75	2.00	2.50	FOUNDATION	3.00	3.50	4.00			5.00	DETAIL IN SHS	DETAIL ON SHEET NUMBER	DETAIL ON STD SHEET NUMBER
																	(LB / FT)				(LB / FT)								
ROCHESTER VT 100							FY-FLUORESCENT YELLOW FYG-FLUORESCENT YELLOW GREEN															"SHS"-STANDARD HIGHWAY SIGNS							
SB	6.070	F	D5-5A	24	24																								
		F	N/A	24	6																								
		E	D5-5A	24	24																								
		E	N/A	24	6																								
		F	D5-5A	24	24			4.00							1			X							INSTALL BACK TO BACK		X		
		F	D5-5AL	24	6			1.00																	ARROW IS SEPARATE BUT PART OF D5-5A SIGN CODE.		X		
		E	D5-5A	24	24			4.00																	ARROW IS SEPARATE BUT PART OF D5-5A SIGN CODE.		X		
		E	D5-5AR	24	6			1.00																	ARROW IS SEPARATE BUT PART OF D5-5A SIGN CODE.		X		
SB	6.000	F	R2-1	24	30																								
		F	R2-1	30	36			7.50							1			X										6	
SB	5.764	F	W3-5	36	36		SPEED REDUCTION (30)				1	1			X	2		X							RETAIN SIGN. INSTALL ON TWO NEW POSTS AT LEAST 10 FEET NORTH OF POLES.				
SB	5.715	F	VD-018	30	18		ROCHESTER VILLAGE SIGN				1				X														
SB	5.677	F	W1-2R	30	30		RIGHT CURVE																						
		F	W11-8	30	30			6.25							1			X									X		
SB	5.630	F	W1-2R	30	30			6.25							1			X			RESET TO SPEC, NEW POST.				INSTALL 200 FEET NORTH OF SPEED LIMIT 30 SIGN ASSEMBLY.		X		
SIGN SUMMARY SHEET							SHEET TOTALS	30.00	0.00	1	1	1	6	0	0	6	90									PROJECT NAME: Ludlow-Waitsfield VT100			
								SF	SF	EA	EA	EA	EA	EA	EA	EA	FT									PROJECT NUMBER: STPG SIGN(27)			
VERMONT AGENCY OF TRANSPORTATION							TOWN TOTALS	593.8	0.0	60.0	9.0	9.0	115	0.0	0.0	102	1530.0									FILE NAME: Rochester.xls			
																										PLOT DATE: 9/10/2009			
																										PROJECT MANAGER: N. Avery			
																										DESIGNED BY: J. Kelly			
																										CHECKED BY: N. Avery			
																										SHEET 113 OF 204			



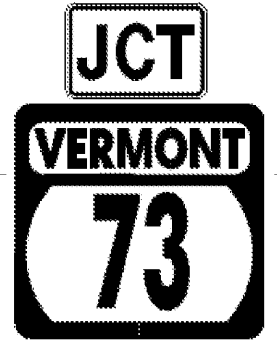







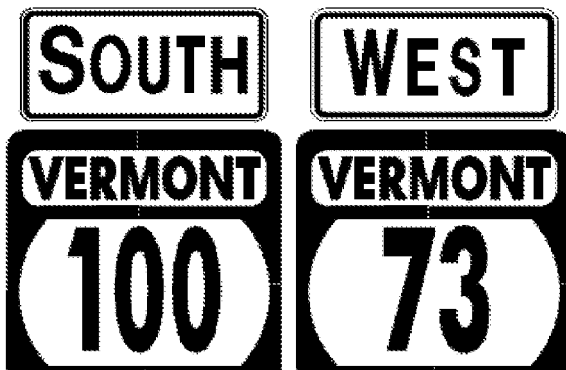

DIRECTION	MILEPOINT	LOCATION CODE (SHEET 2)	SIGN CODE	WIDTH (IN)	HEIGHT (IN)	SHEETING REMARKS	SIGN LEGEND	NEW SIGNS		EXISTING SIGNS				EXIST POST		NUMBER OF NEW POSTS	SQUARE STEEL (IN)			TUBULAR STEEL Ø (IN)				SIGN FRAME REQUIRED	REMARKS	SIGN DETAIL			
								"A"	"B"	RETAIN	SALVAGE FROM	SALVAGE TO	REMOVE	RETAIN	REMOVE		1.75	2.00	2.50	FOUNDATION	3.00	3.50	4.00			5.00	DETAIL IN SHS	DETAIL ON SHEET NUMBER	DETAIL ON STD SHEET NUMBER
																	(LB / FT)				(LB / FT)								
ROCHESTER VT 100							FY-FLUORESCENT YELLOW FYG-FLUORESCENT YELLOW GREEN															"SHS"-STANDARD HIGHWAY SIGNS							
SB	5.592	F	R2-1	24	30																		RESET TO SPEC, NEW POST.						
		F	R2-1	30	36			7.50															NOTE LARGER SIGN SIZE		6				
SB	5.522	F	W11-2YG	30	30		PEDESTRIAN				1																		
			W16-9YG	24	12		AHEAD				1																		
SB	5.478	G	VR-017	24	30																		TH-52, PEAVINE RD						
		H	R1-1	30	30																		TH-52, PEAVINE RD						
		G	VR-017	24	30																		INSTALL SIGNS BACK TO BACK AS EXISTING			E-141			
		H	R1-1	30	30			5.00																X					
								6.25																					
SB	5.462	F	R2-1	24	30																								
		F	R2-1	24	30			5.00																X					
SB	5.438	G	VR-017	24	3																		TH-21, RIVER BROOK DR						
		H	R1-1	30	30																		TH-21, RIVER BROOK DR						
		G	VR-017	24	30																		INSTALL SIGNS BACK TO BACK AS EXISTING			E-141			
		H	R1-1	30	30			5.00																X					
								6.25																					
SB	5.367	F	W11-2YG	30	30		PEDESTRIAN				1																		
SIGN SUMMARY SHEET							SHEET TOTALS		35.00	0.00	3	0	0	6	0	0	4	60							PROJECT NAME: Ludlow-Waitsfield VT100				
							SF	SF	EA	EA	EA	EA	EA	EA	EA	EA	EA	EA	EA	EA	EA	EA	EA	EA	EA	EA	EA	PROJECT NUMBER: STPG SIGN(27)	
VERMONT AGENCY OF TRANSPORTATION							TOWN TOTALS		593.8	0.0	60.0	9.0	9.0	115	0.0	0.0	102	1530.0				FILE NAME: Rochester.xls	PLOT DATE: 9/10/2009						
																						PROJECT MANAGER: N. Avery	DRAWN BY: I. Shea						
																						DESIGNED BY: J. Kelly	CHECKED BY: N. Avery						
																						ROCHESTER SHEET 14	SHEET 114 OF 204						


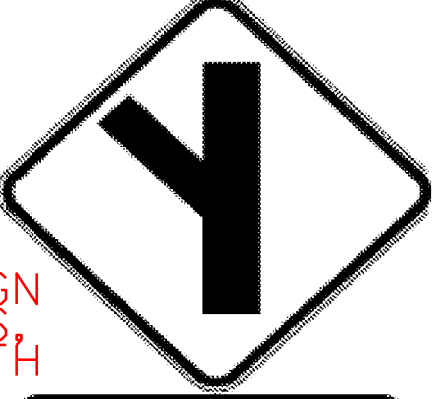

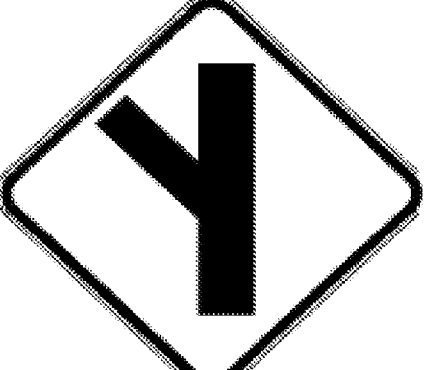

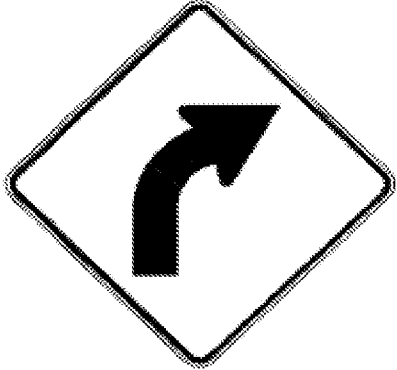

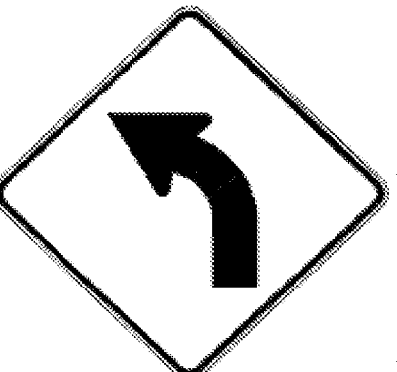

DIRECTION	MILEPOINT	LOCATION CODE (SHEET 2)	SIGN CODE	WIDTH (IN)	HEIGHT (IN)	SHEETING REMARKS	SIGN LEGEND	NEW SIGNS		EXISTING SIGNS				EXIST POST		NUMBER OF NEW POSTS	SQUARE STEEL (IN)			TUBULAR STEEL Ø (IN)				SIGN FRAME REQUIRED	REMARKS	SIGN DETAIL						
								"A"	"B"	RETAIN	SALVAGE FROM	SALVAGE TO	REMOVE	RETAIN	REMOVE		(LB / FT)			(LB / FT)						DETAIL IN SHS	DETAIL ON SHEET NUMBER	DETAIL ON STD SHEET NUMBER				
																	1.75	2.00	2.50	3.00	3.50	4.00	5.00									
ROCHESTER VT 100							FY-FLUORESCENT YELLOW FYG-FLUORESCENT YELLOW GREEN																"SHS"-STANDARD HIGHWAY SIGNS									
			F W16-7YG	24	12		DIAGONAL ARROW			1																						
SB	5.338		F W11-2YG	30	30		PEDESTRIAN			1				X																		
			F W16-7YG	24	12		DIAGONAL ARROW			1																						
SB	5.290		G VR-017	24	30		 							1		X																
			H R1-1	24	24																											
			G VR-017	24	30																											
			H R1-1	24	24																											
SB	5.268		F W11-2YG	30	30		PEDESTRIAN			1				X																		
			F W16-7YG	24	12		DIAGONAL ARROW			1																						
SB	5.258		F R2-1	24	30																											
			F R2-1	24	30																											
SB	5.199		F S1-1YG	36	36		SCHOOL PENTAGON			1				X																		
			F W16-9YG	24	10		AHEAD			1																						
SB	5.130		F S1-1YG	36	36		SCHOOL PENTAGON			1				X																		
			F W16-7YG	30	18		DIAGONAL ARROW			1																						
SIGN SUMMARY SHEET							SHEET TOTALS		16.25	0.00	9	0	0	3	0	0	2	30							PROJECT NAME:	Ludlow-Waitsfield VT100						
							SF	SF	EA	EA	EA	EA	EA	EA	EA	EA	EA	FT							PROJECT NUMBER:	STPG SIGN(27)						
VERMONT AGENCY OF TRANSPORTATION							TOWN TOTALS		593.8	0.0	60.0	9.0	9.0	115	0.0	0.0	102	1530.0							FILE NAME:	Rochester.xls			PLOT DATE:	9/10/2009		
																									DESIGNED BY:	J. Kelly			CHECKED BY:	N. Avery		
																									ROCHESTER SHEET 15				SHEET	115 OF 204		

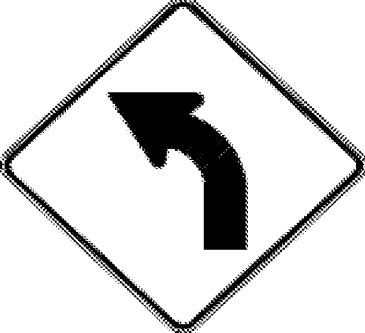

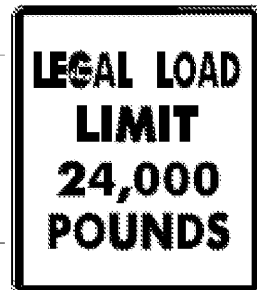



DIRECTION	MILEPOINT	LOCATION CODE (SHEET 2)	SIGN CODE	WIDTH (IN)	HEIGHT (IN)	SHEETING REMARKS	SIGN LEGEND	NEW SIGNS		EXISTING SIGNS				EXIST POST		NUMBER OF NEW POSTS	SQUARE STEEL (IN)			TUBULAR STEEL Ø (IN)				SIGN FRAME REQUIRED	REMARKS	SIGN DETAIL		
								"A"	"B"	RETAIN	SALVAGE FROM	SALVAGE TO	REMOVE	RETAIN	REMOVE		1.75	2.00	2.50	3.00	3.50	4.00	5.00			DETAIL IN SHS	DETAIL ON SHEET NUMBER	DETAIL ON STD SHEET NUMBER
																	(LB / FT)			(LB / FT)								
ROCHESTER VT 100							FY-FLUORESCENT YELLOW FYG-FLUORESCENT YELLOW GREEN															"SHS"-STANDARD HIGHWAY SIGNS						
SB	5.025	F	R2-1	24	30																							
		F	R2-1	24	30			5.00																	X			
SB	4.715	F	R2-1	24	30																							
		F	R2-1	24	30			5.00																	X			
SB	4.595	F	M2-1	21	15																							
		F	M1-5A	24	24																							
		F	M2-1	21	15			2.19																	X			
		F	M1-5A	24	24			4.00																		E-136B		
SB	4.565	F	D1-1A	72	10																							
		F	D1-1A	72	10																							
		F	D1-1A	72	10																							
		F	D1-1A	72	10																							
		F	D1-1A	72	12			6.00																		5		
		F	D1-1A	72	12			6.00																		5		
		F	D1-1A	72	12			6.00																		5		
SIGN SUMMARY SHEET							SHEET TOTALS	34.19	0.00	0	0	0	8	0	0	5	75						PROJECT NAME: Ludlow-Waitsfield VT100					
								SF	SF	EA	EA	EA	EA	EA	EA	EA	FT						PROJECT NUMBER: STPG SIGN(27)					
VERMONT AGENCY OF TRANSPORTATION							TOWN TOTALS	593.8	0.0	60.0	9.0	9.0	115	0.0	0.0	102	1530.0						FILE NAME: Rochester.xls	PLOT DATE: 9/10/2009				
																							PROJECT MANAGER: N. Avery	DRAWN BY: I. Shea				
																							DESIGNED BY: J. Kelly	CHECKED BY: N. Avery				
																							ROCHESTER SHEET 16	SHEET 116 OF 204				



DIRECTION	MILEPOINT	LOCATION CODE (SHEET 2)	SIGN CODE	WIDTH (IN)	HEIGHT (IN)	SHEETING REMARKS	SIGN LEGEND	NEW SIGNS		EXISTING SIGNS				EXIST POST		NUMBER OF NEW POSTS	SQUARE STEEL (IN)			TUBULAR STEEL Ø (IN)				SIGN FRAME REQUIRED	REMARKS	SIGN DETAIL			
								"A"	"B"	RETAIN	SALVAGE FROM	SALVAGE TO	REMOVE	RETAIN	REMOVE		1.75	2.00	2.50	FOUNDATION	3.00	3.50	4.00			5.00	DETAIL IN SHS	DETAIL ON SHEET NUMBER	DETAIL ON STD SHEET NUMBER
																	(LB / FT)				(LB / FT)								
ROCHESTER VT 100							FY-FLUORESCENT YELLOW FYG-FLUORESCENT YELLOW GREEN															"SHS"-STANDARD HIGHWAY SIGNS							
		F	D1-1A	72	12			6.00																		5			
SB	4.540	G	VM-607	24	30		43RD INF DIV			1			X																
SB	4.540	G	VR-023B	24	30		\$500 FINE FOR THROWING TRASH			1			X																
SB	4.522	F	M3-3S	24	12								1	X															
		F	M1-5	30	24								1																
		F	M6-3S	21	15								1																
		F	M3-4S	24	12								1																
		F	M1-5	24	24								1																
		F	M6-1S	21	15								1																
		F	M3-3	24	12			2.00							2	X					#2A	GREEN ON WHITE SHEETING	X	X					
		F	M1-5	30	24			5.00														FRAME					E-136B		
		F	M6-3	21	15			2.19														GREEN ON WHITE SHEETING	X						
		F	M3-4	24	12			2.00														GREEN ON WHITE SHEETING	X					E-136B	
		F	M1-5	24	24			4.00																					
		F	M6-1R	21	15			2.19														GREEN ON WHITE SHEETING	X						
SIGN SUMMARY SHEET							SHEET TOTALS	23.38	0.00	2	0	0	6	0	0	2	30							PROJECT NAME: Ludlow-Waitsfield VT100					
								SF	SF	EA	EA	EA	EA	EA	EA	EA	FT							PROJECT NUMBER: STPG SIGN(27)					
VERMONT AGENCY OF TRANSPORTATION							TOWN TOTALS	593.8	0.0	60.0	9.0	9.0	115	0.0	0.0	102	1530.0							FILE NAME: Rochester.xls	PLOT DATE: 9/10/2009				
																								PROJECT MANAGER: N. Avery	DRAWN BY: I. Shea				
																								DESIGNED BY: J. Kelly	CHECKED BY: N. Avery				
																								ROCHESTER SHEET 17	SHEET 117 OF 204				



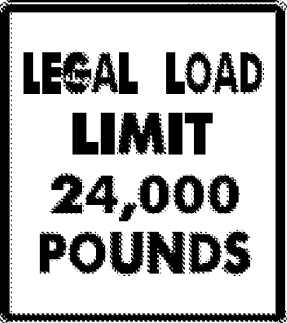
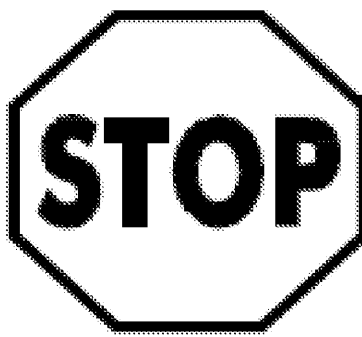

DIRECTION	MILEPOINT	LOCATION CODE (SHEET 2)	SIGN CODE	WIDTH (IN)	HEIGHT (IN)	SHEETING REMARKS	SIGN LEGEND	NEW SIGNS		EXISTING SIGNS				EXIST POST		NUMBER OF NEW POSTS	SQUARE STEEL (IN)			TUBULAR STEEL Ø (IN)				SIGN FRAME REQUIRED	REMARKS	SIGN DETAIL												
								"A"	"B"	RETAIN	SALVAGE FROM	SALVAGE TO	REMOVE	RETAIN	REMOVE		1.75	2.00	2.50	3.00	3.50	4.00	5.00			DETAIL IN SHS	DETAIL ON SHEET NUMBER	DETAIL ON STD SHEET NUMBER										
																	(LB / FT)			(LB / FT)																		
																1.88	2.42	3.35	FOUNDATION				7.60	9.00	10.80	14.60												
ROCHESTER VT 100							FY-FLUORESCENT YELLOW FYG-FLUORESCENT YELLOW GREEN																"SHS"-STANDARD HIGHWAY SIGNS															
SB	4.450	F	M3-3S	24	12		SOUTH																															
		F	M1-5	30	24		VERMONT 100																															
		F	M3-3	24	12			2.00																	X													
		F	M1-5	30	24			5.00																				E-136B										
SB	4.435	F	W1-2L	30	30		LEFT CURVE				1																											
		F	D2-1	72	12			6.00																				5										
		F	D2-1	72	12			6.00																				5										
SB	4.385	F	D2-1	72	10		STOCKBRIDGE 6																															
		F	D2-1	72	10		BETHEL 18																															
		F	W1-2L	30	30		LEFT CURVE				1														X													
SB	4.344	F	VD-018	30	18		TALCVILLE VILLAGE SIGN				1																											
SB	4.305	F	R2-1	24	30																																	
		F	R2-1	24	30			5.00																		X												
SB	4.268	F	W1-2L	30	30		LEFT CURVE																															
																																						
SB	4.235	F	W1-2L	30	30			6.25																														
SIGN SUMMARY SHEET							SHEET TOTALS	30.25	0.00	1	1	1	6	0	0	6	90																					
								SF	SF	EA	EA	EA	EA	EA	EA	EA	FT																					
VERMONT AGENCY OF TRANSPORTATION							TOWN TOTALS	593.8	0.0	60.0	9.0	9.0	115	0.0	0.0	102	1530.0																					
PROJECT NAME: Ludlow-Waitsfield VT100																					PROJECT NUMBER: STPG SIGN(27)						FILE NAME: Rochester.xls						PLOT DATE: 9/10/2009					
DESIGNED BY: J. Kelly																					DRAWN BY: N. Avery						CHECKED BY: N. Avery						SHEET 118 OF 204					

DIRECTION	MILEPOINT	LOCATION CODE (SHEET 2)	SIGN CODE	WIDTH (IN)	HEIGHT (IN)	SHEETING REMARKS	SIGN LEGEND	NEW SIGNS		EXISTING SIGNS				EXIST POST		NUMBER OF NEW POSTS	SQUARE STEEL (IN)			TUBULAR STEEL Ø (IN)				SIGN FRAME REQUIRED	REMARKS	SIGN DETAIL		
								"A"	"B"	RETAIN	SALVAGE FROM	SALVAGE TO	REMOVE	RETAIN	REMOVE		1.75	2.00	2.50	3.00	3.50	4.00	5.00			DETAIL IN SHS	DETAIL ON SHEET NUMBER	DETAIL ON STD SHEET NUMBER
																	(LB / FT)			(LB / FT)								
ROCHESTER VT 100							FY-FLUORESCENT YELLOW FYG-FLUORESCENT YELLOW GREEN																"SHS"-STANDARD HIGHWAY SIGNS					
SB	4.023	G	VR-017	24	30																							
		G	VR-017	24	30			5.00																			E-141	
SB	4.016	H	R1-1	30	30																							
		H	R1-1	30	30			6.25																	X			
SB	3.991	F	R2-1	24	30		SPEED LIMIT 40			1																		
SB	3.720	F	R2-1	24	30																							
		F	R2-1	24	30			5.00																	X			
SB	2.820	F	VD-062AS	72	16		BUSINESS SIGN			1																		
SB	2.704	G	VR-017	24	30																							
		G	VR-017	24	30			5.00																			E-141	
SB	2.697	H	R1-1	30	30																							
		H	R1-1	30	30			6.25																	X			
SB	2.150	G	VR-023B	24	30		\$500 FINE FOR THROWING TRASH																					
SIGN SUMMARY SHEET							SHEET TOTALS	27.50	0.00	2	0	0	6	0	0	5	75											
VERMONT AGENCY OF TRANSPORTATION								SF	SF	EA	EA	EA	EA	EA	EA	EA	FT											
							TOWN TOTALS	593.8	0.0	60.0	9.0	9.0	115	0.0	0.0	102	1530.0											
												PROJECT NAME: Ludlow-Waitsfield VT100		PROJECT NUMBER: STPG SIGN(27)		FILE NAME: Rochester.xls		PLOT DATE: 9/10/2009										
												DESIGNED BY: J. Kelly		DRAWN BY: I. Shea		CHECKED BY: N. Avery		SHEET 119 OF 204										


DIRECTION	MILEPOINT	LOCATION CODE (SHEET 2)	SIGN CODE	WIDTH (IN)	HEIGHT (IN)	SHEETING REMARKS	SIGN LEGEND	NEW SIGNS		EXISTING SIGNS				EXIST POST		NUMBER OF NEW POSTS	SQUARE STEEL (IN)			TUBULAR STEEL Ø (IN)				SIGN FRAME REQUIRED	REMARKS	SIGN DETAIL			
								"A"	"B"	RETAIN	SALVAGE FROM	SALVAGE TO	REMOVE	RETAIN	REMOVE		1.75	2.00	2.50	FOUNDATION	3.00	3.50	4.00			5.00	DETAIL IN SHS	DETAIL ON SHEET NUMBER	DETAIL ON STD SHEET NUMBER
																	(LB / FT)				(LB / FT)								
ROCHESTER VT 100							FY-FLUORESCENT YELLOW FYG-FLUORESCENT YELLOW GREEN																"SHS"-STANDARD HIGHWAY SIGNS						
SB	1.844	F	R2-1	24	30																								
		F	R2-1	24	30			5.00																	X				
SB	1.570	F	W2-3MaL W2-3MaR	30	30			+6.25 6.25																		6			
		F	W16-8	30	8			1.67																	8				
SB	1.118	F	W2-3MaL	30	30		LEFT ANGLED SIDE ROAD 																						
SB	1.095	F	W2-3MaL	30	30			6.25																	6				
		F	W16-8	30	8			1.67																	8				
SB	0.768	F	W1-2R	30	30		RIGHT CURVE 																						
SB	0.720	F	W1-2R	30	30			6.25																X					
		F	W13-1	18	18			2.25																X					
SB	0.440	F	W1-2L	30	30																								
		F	W13-1	18	18																								
SB	0.390	F	W1-2L	30	30	FY		6.25																X					
		F	W13-1	18	18	FY		2.25																X					
SB	0.355	F	W1-6	48	24																								
SIGN SUMMARY SHEET							SHEET TOTALS	44.09 37.84	0.00	0	0	0	6	0	0	5	75						PROJECT NAME: Ludlow-Waitsfield VT100						
								SF	SF	EA	EA	EA	EA	EA	EA	EA	FT						PROJECT NUMBER: STPG SIGN(27)						
VERMONT AGENCY OF TRANSPORTATION							TOWN TOTALS	593.8	0.0	60.0	9.0	9.0	115	0.0	0.0	102	1530.0						FILE NAME: Rochester.xls	PLOT DATE: 9/10/2009					
																							PROJECT MANAGER: N. Avery	DRAWN BY: I. Shea					
																							DESIGNED BY: J. Kelly	CHECKED BY: N. Avery					
																							ROCHESTER SHEET 20	SHEET 120 OF 204					

DIRECTION	MILEPOINT	LOCATION CODE (SHEET 2)	SIGN CODE	WIDTH (IN)	HEIGHT (IN)	SHEETING REMARKS	SIGN LEGEND	NEW SIGNS		EXISTING SIGNS				EXIST POST		NUMBER OF NEW POSTS	SQUARE STEEL (IN)			TUBULAR STEEL Ø (IN)				SIGN FRAME REQUIRED	REMARKS	SIGN DETAIL			
								"A"	"B"	RETAIN	SALVAGE FROM	SALVAGE TO	REMOVE	RETAIN	REMOVE		1.75	2.00	2.50	3.00	3.50	4.00	5.00			DETAIL IN SHS	DETAIL ON SHEET NUMBER	DETAIL ON STD SHEET NUMBER	
																	(LB / FT)			(LB / FT)									
ROCHESTER VT 100							FY-FLUORESCENT YELLOW FYG-FLUORESCENT YELLOW GREEN																"SHS"-STANDARD HIGHWAY SIGNS						
			F	W1-6	48	24		8.00							2		X									X			
SB	0.355		E	W1-6	48	24						1			X														
			E	W1-6	48	24		8.00							2		X									X			
SB	0.258		F	W1-6	48	24						1			X														
			F	W1-6	48	24		8.00							2		X									X			
SB	0.258		E	W1-6	48	24						1			X														
			E	W1-6	48	24		8.00							2		X									X			
SB	0.218		F	W1-6	48	24						1			X														
			F	W1-6	48	24		8.00							2		X									X			
SB	0.218		E	W1-6	48	24						1			X														
			E	W1-6	48	24		8.00							2		X									X			
SIGN SUMMARY SHEET							SHEET TOTALS	48.00	0.00	0	0	0	5	0	0	12	180												
VERMONT AGENCY OF TRANSPORTATION								SF	SF	EA	EA	EA	EA	EA	EA	EA	EA	FT											
							TOWN TOTALS	593.8	0.0	60.0	9.0	9.0	115	0.0	0.0	102	1530.0												
PROJECT NAME: Ludlow-Waitsfield VT100																					PROJECT NUMBER: STPG SIGN(27)								
FILE NAME: Rochester.xls												PLOT DATE: 9/10/2009																	
PROJECT MANAGER: N. Avery												DRAWN BY: I. Shea																	
DESIGNED BY: J. Kelly												CHECKED BY: N. Avery																	
ROCHESTER SHEET 21												SHEET 121 OF 204																	

DIRECTION	MILEPOINT	LOCATION CODE (SHEET 2)	SIGN CODE	WIDTH (IN)	HEIGHT (IN)	SHEETING REMARKS	SIGN LEGEND	NEW SIGNS		EXISTING SIGNS				EXIST POST		NUMBER OF NEW POSTS	SQUARE STEEL (IN)			TUBULAR STEEL Ø (IN)				SIGN FRAME REQUIRED	REMARKS	SIGN DETAIL		
								"A"	"B"	RETAIN	SALVAGE FROM	SALVAGE TO	REMOVE	RETAIN	REMOVE		1.75	2.00	2.50	3.00	3.50	4.00	5.00			DETAIL IN SHS	DETAIL ON SHEET NUMBER	DETAIL ON STD SHEET NUMBER
																	(LB / FT)			(LB / FT)								
HANCOCK VT-100							FY-FLUORESCENT YELLOW FYG-FLUORESCENT YELLOW GREEN															"SHS"-STANDARD HIGHWAY SIGNS						
NB	0.000	C	VD-024	60	7.5							1																
		C	VD-025	60	7.5							1																
		C	VD-024	72	10		HANCOCK	ROCHESTER	6.00							2		X								E-124		
		C	VD-025	72	10		ADDISON CO	WINDSOR CO	6.00																	E-124		
		C	VD-700	6	10		1000 0108 0000	1000 1415 0835	0.42																	E-138		
		C	VD-700	6	10				0.42																	E-138		
NB	0.150	A	S3-1	30	30							1																
		A	W16-4	24	18							1																
		A	S3-1	30	30				6.25							1		X								X		
		A	W16-4	30	24				5.00																	X		
NB	0.203	A	W3-5	36	36		SPEED REDUCTION 35				1																	
NB	0.235	A	VD-018	30	18		HANCOCK LOWER GRANVILLE 3					1														E-128A		
		A	VD-018	30	18				3.75																			
NB	0.292	A	W1-2R	30	30		RIGHT CURVE				1							X										
NB	0.351	A	R2-1	30	36		SPEED LIMIT 35 PLAQUE				1							X										
SIGN SUMMARY SHEET							SHEET TOTALS				27.84	0.00	3	0	0	5	0	0	3	45				PROJECT NAME: Ludlow-Waitsfield VT100				
											SF	SF	EA	EA	EA	EA	EA	EA	EA	FT				PROJECT NUMBER: STPG SIGN(27)				
																				FILE NAME: Hancock.xls			PLOT DATE: 9/10/2009					
VERMONT AGENCY OF TRANSPORTATION																				PROJECT MANAGER: N. Avery			DRAWN BY: I. Shea					
							TOWN TOTALS				370.6	0.0	32.0	6.0	6.0	78	0.0	0.0	50	750.0				DESIGNED BY: J. Kelly				
																				CHECKED BY: J. Kelly			SHEET 122 OF 204					

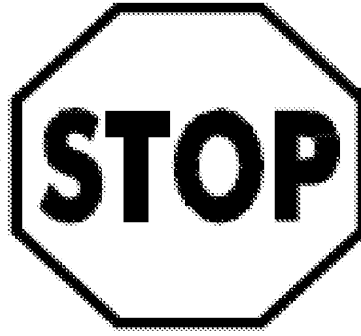


DIRECTION	MILEPOINT	LOCATION CODE (SHEET 2)	SIGN CODE	WIDTH (IN)	HEIGHT (IN)	SHEETING REMARKS	SIGN LEGEND	NEW SIGNS		EXISTING SIGNS				EXIST POST		NUMBER OF NEW POSTS	SQUARE STEEL (IN)			TUBULAR STEEL Ø (IN)				SIGN FRAME REQUIRED	REMARKS	SIGN DETAIL		
								"A"	"B"	RETAIN	SALVAGE FROM	SALVAGE TO	REMOVE	RETAIN	REMOVE		1.75	2.00	2.50	3.00	3.50	4.00	5.00			DETAIL IN SHS	DETAIL ON SHEET NUMBER	DETAIL ON STD SHEET NUMBER
																	(LB / FT)			(LB / FT)								
HANCOCK VT-100							FY-FLUORESCENT YELLOW FYG-FLUORESCENT YELLOW GREEN															"SHS"-STANDARD HIGHWAY SIGNS						
		D	R1-1	30	30			6.25								1		X						TH-8, RECREATION DRIVE	X			
		A					RECREATION DR STREET SIGN			1	1													RETAIN SIGN AND INSTALL ABOVE NEW STOP SIGN.				
NB	0.840	A	R2-1	24	30							1			X													
		A	R2-1	24	30			5.00							1		X								X			
NB	0.842	C	VR-017	24	24								1			X												
		C	VR-017	24	30			5.00							1		X							TH-9, VIRGIN AVE			E-141	
NB	0.847	D	R1-1	24	24								1			X												
		D	R1-1	30	30			6.25							1		X							TH-9, VIRGIN AVE	X			
NB	0.897	A	S1-1	36	36	FYG	SCHOOL PENTAGON			1						X								RETAIN SIGNS AND POSTS, IF PRESENT.				
		A	W16-9	36	12	FYG	AHEAD			1																		
NB	0.929	C	VR-017	24	30		LEGAL LOAD LIMIT 24,000 LBS			1						X												
NB	0.935	D	R1-1	30	30		STOP			1						X												
NB	0.948	A	R2-1	24	30								1			X												
		A	R2-1	24	30			5.00							1		X							X				
NB	1.027	A	S1-1	36	36	FYG	SCHOOL PENTAGON			1						X								RETAIN SIGNS AND POST, IF PRESENT.				
SIGN SUMMARY SHEET							SHEET TOTALS		27.50	0.00	5	1	1	4	0	0	5	75						PROJECT NAME: Ludlow-Waitsfield VT100				
							SF	SF	EA	EA	EA	EA	EA	EA	EA	EA	EA	FT							PROJECT NUMBER: STPG SIGN(27)			
VERMONT AGENCY OF TRANSPORTATION							TOWN TOTALS		370.6	0.0	32.0	6.0	6.0	78	0.0	0.0	50	750.0						FILE NAME: Hancock.xls	PLOT DATE: 9/10/2009			
																							PROJECT MANAGER: N. Avery	DRAWN BY: I. Shea				
																							DESIGNED BY: J. Kelly	CHECKED BY: J. Kelly				
																							HANCOCK SHEET 3					
																							SHEET 124 OF 204					

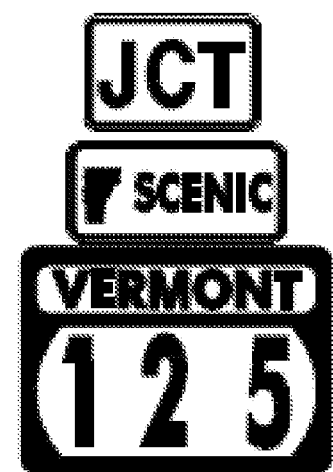




DIRECTION	MILEPOINT	LOCATION CODE (SHEET 2)	SIGN CODE	WIDTH (IN)	HEIGHT (IN)	SHEETING REMARKS	SIGN LEGEND	NEW SIGNS		EXISTING SIGNS				EXIST POST		NUMBER OF NEW POSTS	SQUARE STEEL (IN)			TUBULAR STEEL Ø (IN)				SIGN FRAME REQUIRED	REMARKS	SIGN DETAIL			
								"A"	"B"	RETAIN	SALVAGE FROM	SALVAGE TO	REMOVE	RETAIN	REMOVE		1.75	2.00	2.50	FOUNDATION	3.00	3.50	4.00			5.00	DETAIL IN SHS	DETAIL ON SHEET NUMBER	DETAIL ON STD SHEET NUMBER
																	(LB / FT)				(LB / FT)								
HANCOCK VT-100							FY-FLUORESCENT YELLOW FYG-FLUORESCENT YELLOW GREEN															"SHS"-STANDARD HIGHWAY SIGNS							
		A	W16-7	30	18	FYG	DIAGONAL ARROW			1																			
		A	R6-2	36	12		ONE WAY (TOWN)				1	1			1		X									RELOCATE TOWN "ONE WAY" SIGNS TO OUTSIDE OF ROW.			
		B	R6-2	36	12		ONE WAY (TOWN)				1	1																	
NB	1.050	A	M2-1S	21	15								X		X														
		A	VM-064	24	12								X																
		A	M1-5	24	24								X																
		A	M2-1	21	15			2.19						1		X									X	INSTALL AT LEAST 10 FEET FROM UTILITY POLE. GREEN ON WHITE SHEETING			
		A	VM-064	24	12			2.00																		GREEN ON WHITE SHEETING			
		A	M1-5	30	24			5.00																		E-136B			
NB	1.118	A	VW-145	72	48		NOT RECOMMENDED FOR TRACTOR TRAILERS			1				X															
NB	1.167	A	D1-1A	72	10								1		X														
		A	D1-1A	72	10								1		X														
		A	D1-1A	72	10								1		X														
		A	D1-1A	72	10								1		X														
		A	D1-1A	72	12			6.00							2		X									5			
SIGN SUMMARY SHEET							SHEET TOTALS	15.19	0.00	2	2	2	7	0	0	4	60					PROJECT NAME: Ludlow-Waitsfield VT100							
								SF	SF	EA	EA	EA	EA	EA	EA	EA	FT					PROJECT NUMBER: STPG SIGN(27)							
VERMONT AGENCY OF TRANSPORTATION							TOWN TOTALS	370.6	0.0	32.0	6.0	6.0	78	0.0	0.0	50	750.0					FILE NAME: Hancock.xls	PLOT DATE: 9/10/2009						
																						PROJECT MANAGER: N. Avery	DRAWN BY: I. Shea						
																						DESIGNED BY: J. Kelly	CHECKED BY: J. Kelly						
																						HANCOCK SHEET 4	SHEET 125 OF 204						

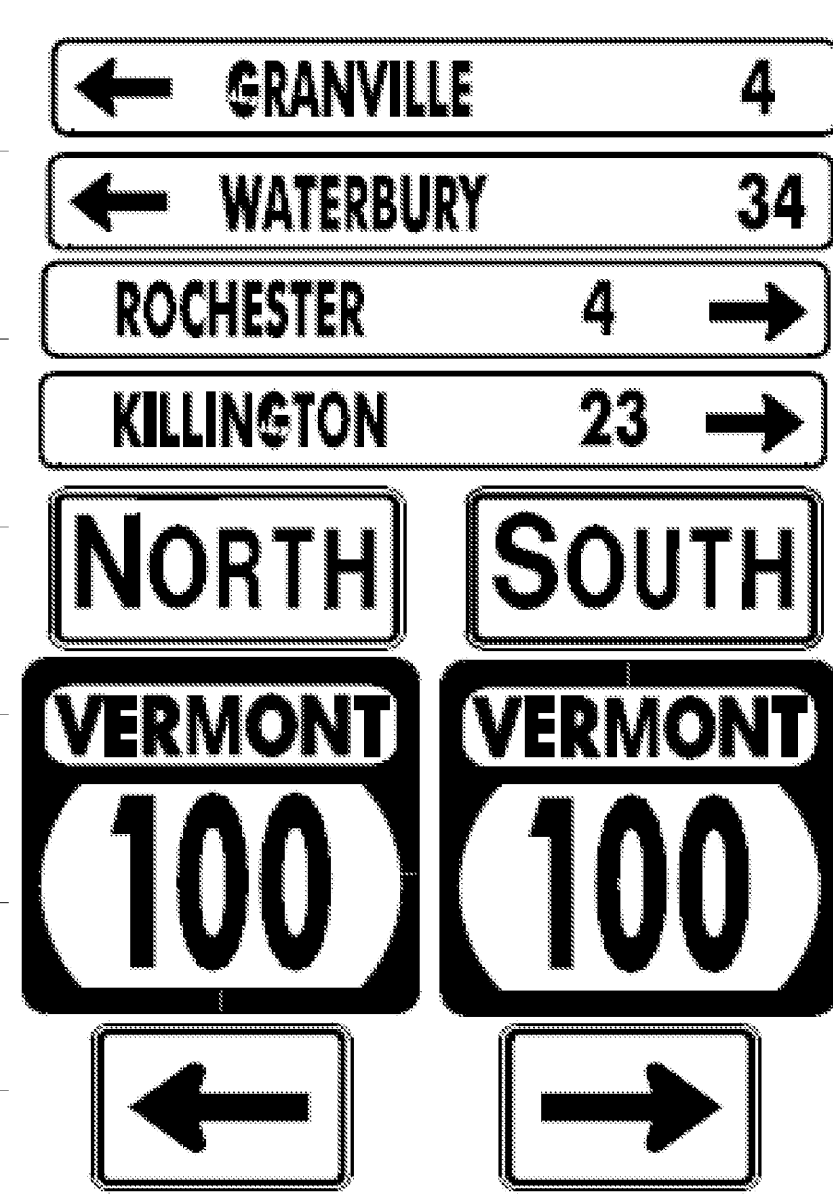





DIRECTION	MILEPOINT	LOCATION CODE (SHEET 2)	SIGN CODE	WIDTH (IN)	HEIGHT (IN)	SHEETING REMARKS	SIGN LEGEND	NEW SIGNS		EXISTING SIGNS				EXIST POST		NUMBER OF NEW POSTS	SQUARE STEEL (IN)			TUBULAR STEEL Ø (IN)				SIGN FRAME REQUIRED	REMARKS	SIGN DETAIL		
								"A"	"B"	RETAIN	SALVAGE FROM	SALVAGE TO	REMOVE	RETAIN	REMOVE		(LB / FT)			(LB / FT)						DETAIL IN SHS	DETAIL ON SHEET NUMBER	DETAIL ON STD SHEET NUMBER
																	1.75	2.00	2.50	3.00	3.50	4.00	5.00					
HANCOCK VT-100							FY-FLUORESCENT YELLOW FYG-FLUORESCENT YELLOW GREEN																"SHS"-STANDARD HIGHWAY SIGNS					
			A	D1-1A	72	12		6.00																		5		
			A	D1-1A	72	12		6.00																		5		
			A	D1-1A	72	12		6.00																		5		
NB	1.183		A	M3-4	24	12						1			X													
			A	VM-064	24	12						1																
			A	M1-5	24	24						1																
			A	M6-1	21	15						1																
			A	M3-1	24	12						1																
			A	M1-5	24	24						1																
			A	M6-3	21	15						1																
			A	M3-4	24	12		2.00								2		X				#2B	GREEN ON WHITE SHEETING	X				
			A	VM-064	24	12		2.00																		6		
			A	M1-5	30	24		5.00																		E-136B		
			A	M6-1L	21	15		2.19																GREEN ON WHITE SHEETING	X			
			A	M3-1	24	12		2.00																GREEN ON WHITE SHEETING	X			
SIGN SUMMARY SHEET							SHEET TOTALS	31.19	0.00	0	0	0	7	0	0	2	30							PROJECT NAME: Ludlow-Waitsfield VT100				
								SF	SF	EA	EA	EA	EA	EA	EA	EA	FT							PROJECT NUMBER: STPG SIGN(27)				
VERMONT AGENCY OF TRANSPORTATION							TOWN TOTALS	370.6	0.0	32.0	6.0	6.0	78	0.0	0.0	50	750.0							FILE NAME: Hancock.xls				
																								PLOT DATE: 9/10/2009				
																								PROJECT MANAGER: N. Avery				
																							DESIGNED BY: J. Kelly					
																							HANCOCK SHEET 5					
																								CHECKED BY: J. Kelly				
																									SHEET 126 OF 204			






DIRECTION	MILEPOINT	LOCATION CODE (SHEET 2)	SIGN CODE	WIDTH (IN)	HEIGHT (IN)	SHEETING REMARKS	SIGN LEGEND	NEW SIGNS		EXISTING SIGNS				EXIST POST		NUMBER OF NEW POSTS	SQUARE STEEL (IN)			TUBULAR STEEL Ø (IN)				SIGN FRAME REQUIRED	REMARKS	SIGN DETAIL				
								"A"	"B"	RETAIN	SALVAGE FROM	SALVAGE TO	REMOVE	RETAIN	REMOVE		1.75	2.00	2.50	3.00	3.50	4.00	5.00			DETAIL IN SHS	DETAIL ON SHEET NUMBER	DETAIL ON STD SHEET NUMBER		
																	(LB / FT)			(LB / FT)										
HANCOCK VT-100							FY-FLUORESCENT YELLOW FYG-FLUORESCENT YELLOW GREEN															"SHS"-STANDARD HIGHWAY SIGNS								
			A	M1-5	30	24		5.00																GREEN ON WHITE SHEETING			E-136B			
			A	M6-3	21	15		2.19																GREEN ON WHITE SHEETING	X					
NB	1.900		C	D1-1A	72	10																								
			C	D1-1A	72	10																								
			C	D1-1A	72	10																								
			C	D1-1A	72	10																								
			C	M3-1	24	12																								
			C	M1-5	24	24																								
			C	M6-1	21	15																								
			C	M3-3	24	12																								
			C	M1-5	24	24																								
			C	M6-1	21	15																								
			C	D1-1A	72	12		6.00							2												5			
			C	D1-1A	72	12		6.00																			5			
			C	D1-1A	72	12		6.00																			5			
SIGN SUMMARY SHEET							SHEET TOTALS	25.19	0.00	0	0	0	10	0	0	2	30													
								SF	SF	EA	EA	EA	EA	EA	EA	EA	FT													
VERMONT AGENCY OF TRANSPORTATION							TOWN TOTALS	370.6	0.0	32.0	6.0	6.0	78	0.0	0.0	50	750.0													
																			PROJECT NAME:	Ludlow-Waitsfield VT100										
																			PROJECT NUMBER:	STPG SIGN(27)										
																			FILE NAME:	Hancock.xls					PLOT DATE:	9/10/2009				
																			PROJECT MANAGER:	N. Avery					DRAWN BY:	I. Shea				
																			DESIGNED BY:	J. Kelly					CHECKED BY:	J. Kelly				
																			HANCOCK SHEET	6					SHEET	127 OF 204				


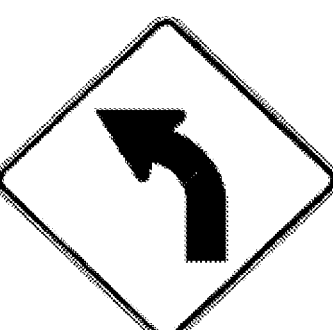
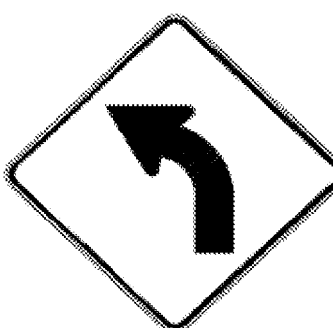
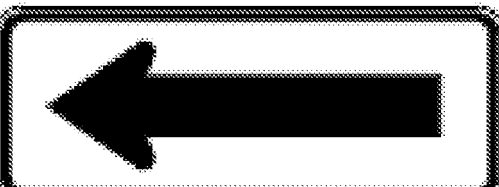


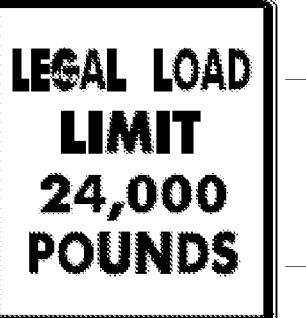
DIRECTION	MILEPOINT	LOCATION CODE (SHEET 2)	SIGN CODE	WIDTH (IN)	HEIGHT (IN)	SHEETING REMARKS	SIGN LEGEND	NEW SIGNS		EXISTING SIGNS				EXIST POST		NUMBER OF NEW POSTS	SQUARE STEEL (IN)			TUBULAR STEEL Ø (IN)				SIGN FRAME REQUIRED	REMARKS	SIGN DETAIL		
								"A"	"B"	RETAIN	SALVAGE FROM	SALVAGE TO	REMOVE	RETAIN	REMOVE		1.75	2.00	2.50	3.00	3.50	4.00	5.00			DETAIL IN SHS	DETAIL ON SHEET NUMBER	DETAIL ON STD SHEET NUMBER
																	(LB / FT)			(LB / FT)								
HANCOCK VT-100							FY-FLUORESCENT YELLOW FYG-FLUORESCENT YELLOW GREEN															"SHS"-STANDARD HIGHWAY SIGNS						
		C	D1-1A	72	12			6.00																	5			
		C	M3-1	24	12			2.00														GREEN ON WHITE SHEETING	X					
		C	M1-5	30	24			5.00																E-136B				
		C	M6-1L	21	15			2.19														GREEN ON WHITE SHEETING	X					
		C	M3-3	24	12			2.00														GREEN ON WHITE SHEETING	X					
		C	M1-5	30	24			5.00																E-136B				
		C	M6-1R	21	15			2.19														GREEN ON WHITE SHEETING	X					
NB	1,229	A	D2-1	72	10							1																
		A	D2-1	72	10							1																
		A	M3-1S	24	12							1																
		A	M1-5	24	24							1																
		A	D2-1	72	12			6.00							2		X								5			
		A	D2-1	72	12			6.00																5				
		A	M3-1	24	12			2.00															INSTALL GREEN ON WHITE SHEETING ROUTE MARKERS ON LEFT POST	X				
		A	M1-5	30	24			5.00																E-136B				
SIGN SUMMARY SHEET							SHEET TOTALS	43.38	0.00	0	0	0	4	0	0	2	30						PROJECT NAME: Ludlow-Waitsfield VT100					
								SF	SF	EA	EA	EA	EA	EA	EA	EA	FT						PROJECT NUMBER: STPG SIGN(27)					
VERMONT AGENCY OF TRANSPORTATION							TOWN TOTALS	370.6	0.0	32.0	6.0	6.0	78	0.0	0.0	50	750.0						FILE NAME: Hancock.xls	PLOT DATE: 9/10/2009				
																							PROJECT MANAGER: N. Avery	DRAWN BY: I. Shea				
																								DESIGNED BY: J. Kelly	CHECKED BY: J. Kelly			
																									HANCOCK SHEET 7	SHEET 128 OF 204		



DIRECTION	MILEPOINT	LOCATION CODE (SHEET 2)	SIGN CODE	WIDTH (IN)	HEIGHT (IN)	SHEETING REMARKS	SIGN LEGEND	NEW SIGNS		EXISTING SIGNS				EXIST POST		NUMBER OF NEW POSTS	SQUARE STEEL (IN)			TUBULAR STEEL Ø (IN)				SIGN FRAME REQUIRED	REMARKS	SIGN DETAIL		
								"A"	"B"	RETAIN	SALVAGE FROM	SALVAGE TO	REMOVE	RETAIN	REMOVE		1.75	2.00	2.50	3.00	3.50	4.00	5.00			DETAIL IN SHS	DETAIL ON SHEET NUMBER	DETAIL ON STD SHEET NUMBER
																	(LB / FT)			(LB / FT)								
HANCOCK VT-100							FY-FLUORESCENT YELLOW FYG-FLUORESCENT YELLOW GREEN															"SHS"-STANDARD HIGHWAY SIGNS						
NB	1.250	A	R2-1	24	30																							
		A	R2-1	24	30			5.00																	X			
NB	1.250	C	VR-017	24	30		LEGAL LOAD LIMIT 24,000 LBS																					
NB	1.255	D	R1-1	30	30		STOP																					
NB	1.254	B	W1-6	48	24																							
		B	W1-6	48	24			8.00																	X			
NB	1.310	A	R2-1	24	30																							
		A	R2-1	24	30			5.00																	X			
NB	2.236	A	VW-054L	30	30		HIDDEN DRIVE LEFT																					
NB	2.241	A	VW-054L	30	30																							
		A	VW-054L	30	30			6.25																		E-154		
NB	2.345	A	OM-3R	12	36		OBJECT MARKER RIGHT			1																		
NB	2.353	B	OM-3L	12	36		OBJECT MARKER LEFT			1																		
SB	2.480	F	VW-054R	30	30		HIDDEN DRIVE RIGHT																					
SB	2.430	F	VW-054R	30	30																							
		F	VW-054R	30	30			6.25																		E-154		
SB	2.365	F	OM-3R	12	36		OBJECT MARKER RIGHT			1																		
SIGN SUMMARY SHEET							SHEET TOTALS	30.50	0.00	3	0	0	7	0	0	6	90					PROJECT NAME: Ludlow-Waitsfield VT100						
								SF	SF	EA	EA	EA	EA	EA	EA	EA	FT					PROJECT NUMBER: STPG SIGN(27)						
							TOWN TOTALS	370.6	0.0	32.0	6.0	6.0	78	0.0	0.0	50	750.0					FILE NAME: Hancock.xls	PLOT DATE: 9/10/2009					
																						PROJECT MANAGER: N. Avery	DRAWN BY: I. Shea					
																						DESIGNED BY: J. Kelly	CHECKED BY: J. Kelly					
																						HANCOCK SHEET 8	SHEET 129 OF 204					

DIRECTION	MILEPOINT	LOCATION CODE (SHEET 2)	SIGN CODE	WIDTH (IN)	HEIGHT (IN)	SHEETING REMARKS	SIGN LEGEND	NEW SIGNS		EXISTING SIGNS				EXIST POST		NUMBER OF NEW POSTS	SQUARE STEEL (IN)			TUBULAR STEEL Ø (IN)				SIGN FRAME REQUIRED	REMARKS	SIGN DETAIL										
								"A"	"B"	RETAIN	SALVAGE FROM	SALVAGE TO	REMOVE	RETAIN	REMOVE		1.75	2.00	2.50	FOUNDATION	3.00	3.50	4.00			5.00	DETAIL IN SHS	DETAIL ON SHEET NUMBER	DETAIL ON STD SHEET NUMBER							
																														(LB / FT)			(LB / FT)			
																														1.88	2.42	3.35	7.60	9.00	10.80	14.60
HANCOCK VT-100							FY-FLUORESCENT YELLOW FYG-FLUORESCENT YELLOW GREEN														"SHS"-STANDARD HIGHWAY SIGNS															
SB	2.360	E	OM-3L	12	36		OBJECT MARKER LEFT				1																									
SB	2.245	G	VM-607	24	30		43RD INF DIV				1																									
SB	1.620	F	VD-062B	74.75	16		TRAVEL INFO SIGN				1																									
		F	VD-062C	74.75	16		TRAVEL INFO SIGN				1																									
SB	1.540	F	VD-062B	72	16		BUSINESS SIGN				1																									
SB	1.474	F	W3-5	36	36		SPEED REDUCTION (35)				1																									
SB	1.437	F	VD-018	30	18																															
		F	VD-018	30	18			3.75							1				X												E-128A					
SB	1.402	F	W1-4R	30	30		RIGHT REVERSE CURVE				1																									
		F	W13-1	18	18		35 MPH PLAQUE																													
SB	1.354	F	W2-1M	30	30		CROSSROADS				1																									
SB	1.316	F	R2-1	30	36		SPEED LIMIT 35				1																									
SB	1.295	F	VW-145	72	48		NOT RECOMMENDED FOR TRACTOR TRAILERS				1																									
SB	1.295	F	M2-1S	21	15																															
		F	VM-064	24	12																															
SIGN SUMMARY SHEET							SHEET TOTALS			3.75	0.00	10	0	0	4	0	0	1	15							PROJECT NAME: Ludlow-Waitsfield VT100										
							SF	SF	EA	EA	EA	EA	EA	EA	EA	EA	EA	EA	EA	EA	EA	EA	EA	EA	EA	EA	EA	EA	EA	EA	EA	EA	EA	EA	EA	PROJECT NUMBER: STPG SIGN(27)
							VERMONT AGENCY OF TRANSPORTATION							TOWN TOTALS			370.6	0.0	32.0	6.0	6.0	78	0.0	0.0	50	750.0			FILE NAME: Hancock.xls PLOT DATE: 9/10/2009							
																															PROJECT MANAGER: N. Avery DRAWN BY: I. Shea					
																															DESIGNED BY: J. Kelly CHECKED BY: J. Kelly					
																															PROJECT SHEET: HANCOCK SHEET 9 SHEET 130 OF 204					






DIRECTION	MILEPOINT	LOCATION CODE (SHEET 2)	SIGN CODE	WIDTH (IN)	HEIGHT (IN)	SHEETING REMARKS	SIGN LEGEND	NEW SIGNS		EXISTING SIGNS				EXIST POST		NUMBER OF NEW POSTS	SQUARE STEEL (IN)			TUBULAR STEEL Ø (IN)				SIGN FRAME REQUIRED	REMARKS	SIGN DETAIL			
								"A"	"B"	RETAIN	SALVAGE FROM	SALVAGE TO	REMOVE	RETAIN	REMOVE		1.75	2.00	2.50	FOUNDATION	3.00	3.50	4.00			5.00	DETAIL IN SHS	DETAIL ON SHEET NUMBER	DETAIL ON STD SHEET NUMBER
																	(LB / FT)				(LB / FT)								
HANCOCK VT-100							FY-FLUORESCENT YELLOW FYG-FLUORESCENT YELLOW GREEN															"SHS"-STANDARD HIGHWAY SIGNS							
		F	M1-5	24	24							1											RESET TO SPEC, NEW POST.						
		F	M2-1	21	15			2.19						1		X							GREEN ON WHITE SHEETING. INSTALL ASSEMBLY TO THE LEFT OF "NOT RECOMMENDED" ASSEMBLY	X					
		F	VM-064	24	12			2.00																6					
		F	M1-5	30	24			5.00																	E-136B				
SB	1.265	G	VR-017	24	30							1			X														
		G	VR-017	24	30			5.00						1		X							TH-7, BLAIR HILL RD REINSTALL TOWN'S SPEED LIMIT SIGN BELOW NEW LEGAL LOAD ASSEMBLY			E-141			
		G	R2-1	24	30		TOWN'S SPEED LIMIT 25			1	1																		
SB	1.260	H	R1-1	30	30							1			X														
		H	R1-1	30	30			6.25						1		X							TH-7, BLAIR HILL RD	X					
		F					BLAIR HILL RD STREET SIGN			1	1												REINSTALL TOWN'S STREET SIGN ABOVE NEW STOP SIGN						
SB	1.255	F	D1-1A	72	10							1			X														
		F	D2-1	72	10							1																	
		F	D2-2	72	10							1																	
		F	D2-3	72	10							1																	
		F	D1-1A	72	12			6.00						2		X									5				
SIGN SUMMARY SHEET							SHEET TOTALS	26.44	0.00	0	2	2	7	0	0	5	75								PROJECT NAME: Ludlow-Waitsfield VT100				
								SF	SF	EA	EA	EA	EA	EA	EA	EA	EA	EA	EA	EA	EA	EA	EA	EA	EA	EA	EA	PROJECT NUMBER: STPG SIGN(27)	
VERMONT AGENCY OF TRANSPORTATION							TOWN TOTALS	370.6	0.0	32.0	6.0	6.0	78	0.0	0.0	50	750.0						FILE NAME: Hancock.xls	PLOT DATE: 9/10/2009					
																						PROJECT MANAGER: N. Avery	DRAWN BY: I. Shea						
																						DESIGNED BY: J. Kelly	CHECKED BY: J. Kelly						
																						HANCOCK SHEET 10	SHEET 131 OF 204						


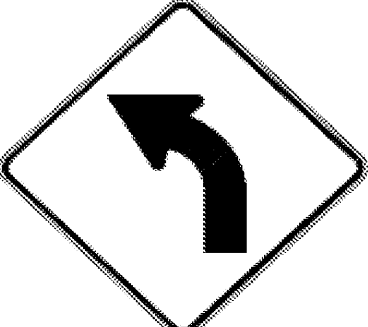



DIRECTION	MILEPOINT	LOCATION CODE (SHEET 2)	SIGN CODE	WIDTH (IN)	HEIGHT (IN)	SHEETING REMARKS	SIGN LEGEND	NEW SIGNS		EXISTING SIGNS				EXIST POST		NUMBER OF NEW POSTS	SQUARE STEEL (IN)			TUBULAR STEEL Ø (IN)				SIGN FRAME REQUIRED	REMARKS	SIGN DETAIL		
								"A"	"B"	RETAIN	SALVAGE FROM	SALVAGE TO	REMOVE	RETAIN	REMOVE		1.75	2.00	2.50	3.00	3.50	4.00	5.00			DETAIL IN SHS	DETAIL ON SHEET NUMBER	DETAIL ON STD SHEET NUMBER
																	(LB / FT)			(LB / FT)								
																	1.88	2.42	3.35	FOUNDATION	7.60	9.00	10.80					
HANCOCK VT-100							FY-FLUORESCENT YELLOW FYG-FLUORESCENT YELLOW GREEN																"SHS"-STANDARD HIGHWAY SIGNS					
		F	M1-5	30	24			5.00																			E-136B	
		F	M6-1R	21	15			2.19																	X		GREEN ON WHITE SHEETING	
SB	1.163	G	VR-017	24	30		LEGAL LOAD LIMIT 24,000 LBS			1																	TH-20, KILLOLEET DR.	
SB	1.159	H	R1-1	30	30		STOP			1																	TH-20, KILLOLEET DR.	
SB	1.148	F	S1-1	36	36	FYG	SCHOOL PENTAGON			1																	RETAIN SIGNS AND POSTS, IF PRESENT	
		F	W16-9	24	10	FYG	AHEAD			1																		
SB	1.113	F	R2-1	24	30							1																
		F	R2-1	24	30			5.00							1		X								X			
SB	1.060	F	D2-1	72	12		 	6.00							2		X										INSTALL ON NORTH SIDE OF UTILITY POLE 130 FEET NORTH OF CROSSWALK	
		F	D2-1	72	12			6.00																			5	
		F	M3-3	24	12			2.00																	X		INSTALL GREEN ON WHITE SHEETING ROUTE MARKERS ON LEFT POST	
		F	M1-5	30	24			5.00																			E-136B	
SB	1.027	F	S1-1	36	36	FYG	SCHOOL PENTAGON			1																	RETAIN SIGNS AND POSTS, IF PRESENT.	
		F	W16-7	30	18	FYG	DIAGONAL ARROW			1																		
SB	0.892	F	W11-2	30	30	FYG	PEDESTRIAN																					
SIGN SUMMARY SHEET							SHEET TOTALS	31.19	0.00	6	0	0	2	0	0	3	45											
VERMONT AGENCY OF TRANSPORTATION								SF	SF	EA	EA	EA	EA	EA	EA	EA	FT											
							TOWN TOTALS	370.6	0.0	32.0	6.0	6.0	78	0.0	0.0	50	750.0											
PROJECT NAME: Ludlow-Waitsfield VT100																					PROJECT NUMBER: STPG SIGN(27)							
FILE NAME: Hancock.xls														PLOT DATE: 9/10/2009														
PROJECT MANAGER: N. Avery														DRAWN BY: I. Shea														
DESIGNED BY: J. Kelly														CHECKED BY: J. Kelly														
HANCOCK SHEET 12														SHEET 133 OF 204														








DIRECTION	MILEPOINT	LOCATION CODE (SHEET 2)	SIGN CODE	WIDTH (IN)	HEIGHT (IN)	SHEETING REMARKS	SIGN LEGEND	NEW SIGNS		EXISTING SIGNS				EXIST POST		NUMBER OF NEW POSTS	SQUARE STEEL (IN)			TUBULAR STEEL Ø (IN)				SIGN FRAME REQUIRED	REMARKS	SIGN DETAIL			
								"A"	"B"	RETAIN	SALVAGE FROM	SALVAGE TO	REMOVE	RETAIN	REMOVE		1.75	2.00	2.50	FOUNDATION	3.00	3.50	4.00			5.00	DETAIL IN SHS	DETAIL ON SHEET NUMBER	DETAIL ON STD SHEET NUMBER
																	(LB / FT)				(LB / FT)								
HANCOCK VT-100							FY-FLUORESCENT YELLOW FYG-FLUORESCENT YELLOW GREEN																"SHS"-STANDARD HIGHWAY SIGNS						
SB	0.860	F	R2-1	24	30																								
		F	R2-1	24	30				5.00							1		X								X			
SB	0.629	F	R2-1	24	30		SPEED LIMIT 35 																						
		F	W1-2L	30	30				6.25							1		X							RESET TO SPEC, NEW POST.	X			
SB	0.535	F	W1-2L	30	30		LEFT CURVE 																						
		F	W1-2L	30	30				6.25							1		X							INSTALL 150 FT SOUTH OF EXISTING LOCATION	X			
SB	0.470	F	W1-6	48	24																								
		F	W1-6	48	24				8.00							2		X							RESET TO SPEC, NEW POSTS.	X			
SB	0.458	E	W1-6	48	24																								
		E	W1-6	48	24				8.00							2		X							RESET TO SPEC, NEW POSTS.	X			
SB	0.380	G	VR-017	24	30		LEGAL LOAD LIMIT 24,000 POUNDS 																						
		G	VR-017	24	30				5.00							1		X							TH-12, TUNNEL BROOK RD	E-141			
		G	R2-1								1	1													REINSTALL TOWN'S SPEED LIMIT 25 SIGN BELOW NEW LEGAL LOAD SIGN				
SB	0.375	H	R1-1	30	30		STOP 																						
		H	R1-1	30	30				6.25							1		X							TH-12, TUNNEL BROOK RD	X			
SIGN SUMMARY SHEET							SHEET TOTALS	44.75	0.00	0	1	1	7	0	0	9	135								PROJECT NAME: Ludlow-Waitsfield VT100				
								SF	SF	EA	EA	EA	EA	EA	EA	EA	EA	EA	EA	EA	EA	EA	EA	EA	EA	EA	EA	EA	PROJECT NUMBER: STPG SIGN(27)
VERMONT AGENCY OF TRANSPORTATION							TOWN TOTALS	370.6	0.0	32.0	6.0	6.0	78	0.0	0.0	50	750.0							FILE NAME: Hancock.xls					
																								PLOT DATE: 9/10/2009					
																									DRAWN BY: I. Shea				
																									DESIGNED BY: J. Kelly				
																									CHECKED BY: J. Kelly				
																									SHEET 134 OF 204				


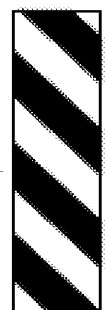
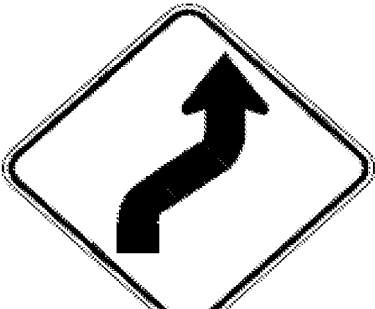




DIRECTION	MILEPOINT	LOCATION CODE (SHEET 2)	SIGN CODE	WIDTH (IN)	HEIGHT (IN)	SHEETING REMARKS	SIGN LEGEND	NEW SIGNS		EXISTING SIGNS				EXIST POST		NUMBER OF NEW POSTS	SQUARE STEEL (IN)			TUBULAR STEEL Ø (IN)				SIGN FRAME REQUIRED	REMARKS	SIGN DETAIL			
								"A"	"B"	RETAIN	SALVAGE FROM	SALVAGE TO	REMOVE	RETAIN	REMOVE		1.75	2.00	2.50	FOUNDATION	3.00	3.50	4.00			5.00	DETAIL IN SHS	DETAIL ON SHEET NUMBER	DETAIL ON STD SHEET NUMBER
																	(LB / FT)				(LB / FT)								
HANCOCK VT-100							FY-FLUORESCENT YELLOW FYG-FLUORESCENT YELLOW GREEN															"SHS"-STANDARD HIGHWAY SIGNS							
SB	0.357	F	R2-1	24	30																								
		F	R2-1	24	30			5.00																X					
SB	0.323	F	VW-544	30	30		EMERGENCY VEHICLES																						
SB	0.288	F	VW-081L	30	30		TRUCKS ENTERING																						
		F	VW-544	30	30																								
		F	VW-544	30	30			6.25																		E-154			
SIGN SUMMARY SHEET							SHEET TOTALS	11.25	0.00	0	0	0	3	0	0	2	30												
								SF	SF	EA	EA	EA	EA	EA	EA	EA	FT												
VERMONT AGENCY OF TRANSPORTATION							TOWN TOTALS	370.6	0.0	32.0	6.0	6.0	78	0.0	0.0	50	750.0												
								PROJECT NAME: Ludlow-Waitsfield VT100														PROJECT NUMBER: STPG SIGN(27)							
								FILE NAME: Hancock.xls											PLOT DATE: 9/10/2009										
								PROJECT MANAGER: N. Avery											DRAWN BY: I. Shea										
								DESIGNED BY: J. Kelly											CHECKED BY: J. Kelly										
								HANCOCK SHEET 14														SHEET 135 OF 204							

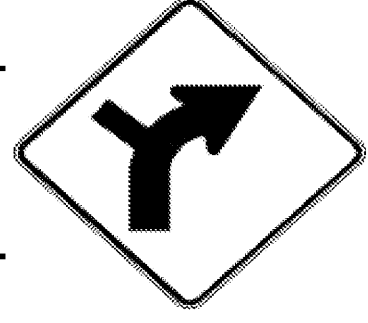

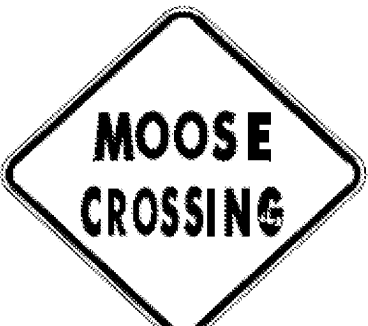


DIRECTION	MILEPOINT	LOCATION CODE (SHEET 2)	SIGN CODE	WIDTH (IN)	HEIGHT (IN)	SHEETING REMARKS	SIGN LEGEND	NEW SIGNS		EXISTING SIGNS				EXIST POST		NUMBER OF NEW POSTS	SQUARE STEEL (IN)			TUBULAR STEEL Ø (IN)				SIGN FRAME REQUIRED	REMARKS	SIGN DETAIL												
								"A"	"B"	RETAIN	SALVAGE FROM	SALVAGE TO	REMOVE	RETAIN	REMOVE		1.75	2.00	2.50	FOUNDATION	3.00	3.50	4.00			5.00	DETAIL IN SHS	DETAIL ON SHEET NUMBER	DETAIL ON STD SHEET NUMBER									
																	(LB / FT)				(LB / FT)																	
GRANVILLE VT 100							FY-FLUORESCENT YELLOW FYG-FLUORESCENT YELLOW GREEN															"SHS"-STANDARD HIGHWAY SIGNS																
NB	0.000	C	VD-024	60	7.5																																	
		C	VD-024	72	10			5.00																		4												
		C	VD-025	6	10			0.42																			E-138											
		C	VD-025	6	10			0.42																			E-138											
NB	0.578	C	VR-017	24	30																																	
		C	VR-017	24	30			5.00																			E-141											
NB	0.584	D	R1-1	30	30																																	
		D	R1-1	30	30			6.25																		X												
NB	0.955	A	OM-3R	12	36																																	
		A	OM-3R	12	36			3.00																		X												
NB	0.965	B	OM-3L	12	36																																	
		B	OM-3L	12	36			3.00																		X												
NB	1.305	A	W3-5	36	36																						X											
NB	1.335	A	VD-018	30	18	LOWER GRANVILLE VILLAGE SIGN																																
SIGN SUMMARY SHEET							SHEET TOTALS	23.09	0.00	1	0	0	6	0	0	6	90																					
								SF	SF	EA	EA	EA	EA	EA	EA	EA	EA	EA	EA	EA	EA	EA	EA	EA	EA	EA	EA	EA	EA	EA	EA	EA	EA	EA				
VERMONT AGENCY OF TRANSPORTATION							TOWN TOTALS	601.1	0.0	18.0	3.0	3.0	116	0.0	0.0	129	1935.0																					
																					PROJECT NAME:	Ludlow-Waitsfield VT100																
																					PROJECT NUMBER:	STPG SIGN(27)																
																					FILE NAME:	Granville.xls					PLOT DATE:	9/11/2009										
																					PROJECT MANAGER:	N. Avery					DRAWN BY:	I. Shea										
																					DESIGNED BY:	J. Kelly					CHECKED BY:	N. Avery										
																					GRANVILLE SHEET	1					SHEET	136					OF	204				












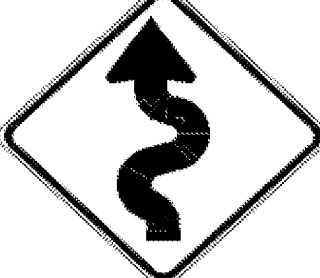

DIRECTION	MILEPOINT	LOCATION CODE (SHEET 2)	SIGN CODE	WIDTH (IN)	HEIGHT (IN)	SHEETING REMARKS	SIGN LEGEND	NEW SIGNS		EXISTING SIGNS				EXIST POST		NUMBER OF NEW POSTS	SQUARE STEEL (IN)			TUBULAR STEEL Ø (IN)				SIGN FRAME REQUIRED	REMARKS	SIGN DETAIL		
								"A"	"B"	RETAIN	SALVAGE FROM	SALVAGE TO	REMOVE	RETAIN	REMOVE		(LB / FT)			(LB / FT)						DETAIL IN SHS	DETAIL ON SHEET NUMBER	DETAIL ON STD SHEET NUMBER
																	1.75	2.00	2.50	3.00	3.50	4.00	5.00					
GRANVILLE VT 100							FY-FLUORESCENT YELLOW FYG-FLUORESCENT YELLOW GREEN															"SHS"-STANDARD HIGHWAY SIGNS						
NB	1.352	A	VD-018	30	18			3.75							1		X							INSTALL 90 FEET NORTH OF EXISTING VILLAGE SIGN			E-128A	
NB	1.400	A	R2-1	24	30																							
		A	R2-1	30	36			7.50							1		X										6	
NB	1.646	A	W11-6	30	30																							
		A	W11-6H	30	30			6.25							1		X							(HINGED)			E-153	
NB	1.800	A	S5-2	24	30		END SCHOOL ZONE			1																		
NB	1.860	A	R2-1	24	30																							
		A	R2-1	24	30			5.00							1		X									X		
NB	2.153	C	VR-017	24	30																							
		C	VR-017	24	30			5.00							1		X							TH-5, MATTSON RD			E-141	
SIGN SUMMARY SHEET							SHEET TOTALS	27.50	0.00	1	0	0	4	0	0	5		75							PROJECT NAME: Ludlow-Waitsfield VT100			
VERMONT AGENCY OF TRANSPORTATION							TOWN TOTALS	601.1	0.0	18.0	3.0	3.0	116	0.0	0.0	129		1935.0							PROJECT NUMBER: STPG SIGN(27)			
								SF	SF	EA	EA	EA	EA	EA	EA	EA	FT							FILE NAME: Granville.xls			PLOT DATE: 9/11/2009	
																								PROJECT MANAGER: N. Avery			DRAWN BY: I. Shea	
																								DESIGNED BY: J. Kelly			CHECKED BY: N. Avery	
																								GRANVILLE SHEET 2			SHEET 137 OF 204	


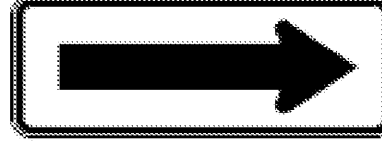




DIRECTION	MILEPOINT	LOCATION CODE (SHEET 2)	SIGN CODE	WIDTH (IN)	HEIGHT (IN)	SHEETING REMARKS	SIGN LEGEND	NEW SIGNS		EXISTING SIGNS				EXIST POST		NUMBER OF NEW POSTS	SQUARE STEEL (IN)			TUBULAR STEEL Ø (IN)				SIGN FRAME REQUIRED	REMARKS	SIGN DETAIL		
								"A"	"B"	RETAIN	SALVAGE FROM	SALVAGE TO	REMOVE	RETAIN	REMOVE		(LB / FT)			(LB / FT)						DETAIL IN SHS	DETAIL ON SHEET NUMBER	DETAIL ON STD SHEET NUMBER
																	1.75	2.00	2.50	3.00	3.50	4.00	5.00					
GRANVILLE VT 100							FY-FLUORESCENT YELLOW FYG-FLUORESCENT YELLOW GREEN																"SHS"-STANDARD HIGHWAY SIGNS					
NB	2.157	D	R1-1	30	30		STOP			1														TH-5, MATTSON RD				
NB	2.354	A	VD-062C	74.75	16		TRAVEL INFO SIGN			1																		
		A	VD-062BC	74.75	16		TRAVEL INFO SIGN			1																		
NB	2.419	A	W11-8	30	30		FIRE STATION			1																		
NB	2.469	A	VD-062AS	72	16		BUSINESS SIGN			1																		
NB	2.534	A	W3-5	36	36		SPEED REDUCTION (35)			1																		
NB	2.594	A	W1-2L	30	30		LEFT CURVE						1															
		A	W13-1	18	18		35 MPH PLAQUE						1															
NB	2.604	A	VD-018	30	18			3.75							1		X							INSTALL 165 FEET SOUTH OF EXISTING VILLAGE SIGN			E-128A	
NB	2.635	A	VD-018	30	18		GRANVILLE VILLAGE SIGN						1															
NB	2.642	A	W1-2L	30	30			6.25							1		X							INSTALL 200 FEET SOUTH OF SPEED LIMIT 35 SIGN	X			
		A	W13-1	18	18			2.25																		X		
NB	2.680	A	R2-1	30	36		SPEED LIMIT 35			1																		
NB	2.725	A	W1-6	48	24								1															
		A	W1-6	48	24			8.00							2		X									X		
SIGN SUMMARY SHEET							SHEET TOTALS	20.25	0.00	7	0	0	4	0	0	4		60										
VERMONT AGENCY OF TRANSPORTATION								SF	SF	EA	EA	EA	EA	EA	EA	EA		FT										
							TOWN TOTALS	601.1	0.0	18.0	3.0	3.0	116	0.0	0.0	129		1935.0										
PROJECT NAME: Ludlow-Waitsfield VT100																					PROJECT NUMBER: STPG SIGN(27)							
FILE NAME: Granville.xls														PLOT DATE: 9/11/2009														
PROJECT MANAGER: N. Avery														DRAWN BY: I. Shea														
DESIGNED BY: J. Kelly														CHECKED BY: N. Avery														
GRANVILLE SHEET 3														SHEET 138 OF 204														


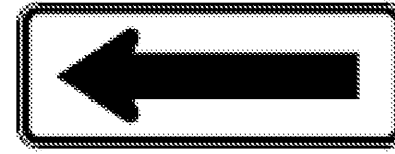
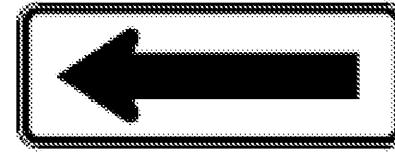










DIRECTION	MILEPOINT	LOCATION CODE (SHEET 2)	SIGN CODE	WIDTH (IN)	HEIGHT (IN)	SHEETING REMARKS	SIGN LEGEND	NEW SIGNS		EXISTING SIGNS				EXIST POST		NUMBER OF NEW POSTS	SQUARE STEEL (IN)			TUBULAR STEEL Ø (IN)				SIGN FRAME REQUIRED	REMARKS	SIGN DETAIL		
								"A"	"B"	RETAIN	SALVAGE FROM	SALVAGE TO	REMOVE	RETAIN	REMOVE		(LB / FT)			(LB / FT)						DETAIL IN SHS	DETAIL ON SHEET NUMBER	DETAIL ON STD SHEET NUMBER
																	1.75	2.00	2.50	3.00	3.50	4.00	5.00					
GRANVILLE VT 100							FY-FLUORESCENT YELLOW FYG-FLUORESCENT YELLOW GREEN															"SHS"-STANDARD HIGHWAY SIGNS						
NB	2.780	A	R2-1	24	30			5.00							1		X						INSTALL SIGN 290 FEET NORTH OF LARGE ARROW AND 10 FEET FROM UTILITY POLE	X				
NB	2.910	C	VR-017	24	30		LEGAL LOAD LIMIT 16,000 LBS			1	1				1		X						RETAIN SIGN AND INSTALL ON NEW POST. TH-2, POST OFFICE HILL					
NB	2.914	D	R1-1	30	30							1					X											
		D	R1-1	30	30			6.25							1		X						TH-2, POST OFFICE HILL	X				
NB	2.920	A	W1-2R	30	30		RIGHT CURVE					1					X											
NB	2.955	A	W1-10R	30	30			6.25							1		X						INSTALL 175 FEET NORTH OF EXISTING RIGHT CURVE AND 10 FEET FROM UTILITY POLE	X				
NB	3.036	A	R2-1	24	30							1					X											
		A	R2-1	24	30			5.00							1		X								X			
NB	3.081	A	M3-1S	24	12							1					X											
		A	M1-5	30	24							1																
		A	M3-1	24	12			2.00							1		X						GREEN ON WHITE SHEETING	X				
		A	M1-5	30	24			5.00																		E-136B		
NB	3.362	A	VW-000	30	30							1					X											
		A	W7-3A	24	18							1																
		A	VW-000	30	30			6.25							1		X									E-153		
SIGN SUMMARY SHEET							SHEET TOTALS	35.75	0.00	0	1	1	7	0	0	7		105						PROJECT NAME: Ludlow-Waitsfield VT100				
								SF	SF	EA	EA	EA	EA	EA	EA	EA		FT					PROJECT NUMBER: STPG SIGN(27)					
VERMONT AGENCY OF TRANSPORTATION							TOWN TOTALS	601.1	0.0	18.0	3.0	3.0	116	0.0	0.0	129		1935.0						FILE NAME: Granville.xls	PLOT DATE: 9/11/2009			
																							PROJECT MANAGER: N. Avery	DRAWN BY: I. Shea				
																							DESIGNED BY: J. Kelly	CHECKED BY: N. Avery				
																							GRANVILLE SHEET 4	SHEET 139 OF 204				

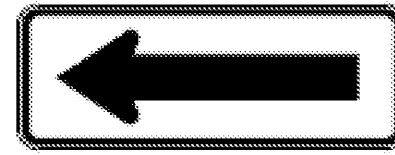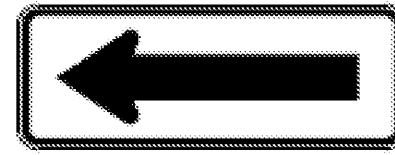




DIRECTION	MILEPOINT	LOCATION CODE (SHEET 2)	SIGN CODE	WIDTH (IN)	HEIGHT (IN)	SHEETING REMARKS	SIGN LEGEND	NEW SIGNS		EXISTING SIGNS				EXIST POST		NUMBER OF NEW POSTS	SQUARE STEEL (IN)			TUBULAR STEEL Ø (IN)				SIGN FRAME REQUIRED	REMARKS	SIGN DETAIL			
								"A"	"B"	RETAIN	SALVAGE FROM	SALVAGE TO	REMOVE	RETAIN	REMOVE		1.75	2.00	2.50	3.00	3.50	4.00	5.00			DETAIL IN SHS	DETAIL ON SHEET NUMBER	DETAIL ON STD SHEET NUMBER	
																	(LB / FT)			(LB / FT)									
																	1.88	2.42	3.35	FOUNDATION	7.60	9.00	10.80	14.60					
GRANVILLE VT 100							FY-FLUORESCENT YELLOW FYG-FLUORESCENT YELLOW GREEN																"SHS"-STANDARD HIGHWAY SIGNS						
			A W7-3A	24	18			3.00																	X				
NB	3.964		A OM-3R	12	36								1			X													
			A OM-3R	12	36			3.00						1		X									X				
NB	3.969		B OM-3L	12	36								1			X													
			B OM-3L	12	36			3.00						1		X									X				
NB	4.175		A W1-4R	30	30								1																
			A W13-1	18	18								1																
			A W1-4R	30	30	FY		6.25						1		X								X					
			A W13-1	18	18	FY		2.25																X					
NB	4.431		A OM-3R	12	36								1			X													
			A OM-3R	12	36			3.00						1		X								X					
NB	4.436		B OM-3L	12	36								1			X													
			B OM-3L	12	36			3.00						1		X								X					
NB	4.466		A W1-6	48	24								1			X													
			A W1-6	48	24	FY		8.00						2		X								X					
SIGN SUMMARY SHEET							SHEET TOTALS	31.50	0.00	0	0	0	7	0	0	7	105												
VERMONT AGENCY OF TRANSPORTATION								SF	SF	EA	EA	EA	EA	EA	EA	EA	EA	EA	EA	EA	EA	EA	EA	EA	EA	EA	EA	EA	EA
TOWN TOTALS							601.1	0.0	18.0	3.0	3.0	116	0.0	0.0	129	1935.0													
																	PROJECT NAME: Ludlow-Waitsfield VT100		PROJECT NUMBER: STPG SIGN(27)		FILE NAME: Granville.xls		PLOT DATE: 9/11/2009						
																	PROJECT MANAGER: N. Avery		DRAWN BY: I. Shea		DESIGNED BY: J. Kelly		CHECKED BY: N. Avery						
																	GRANVILLE SHEET 5		SHEET 140 OF 204										



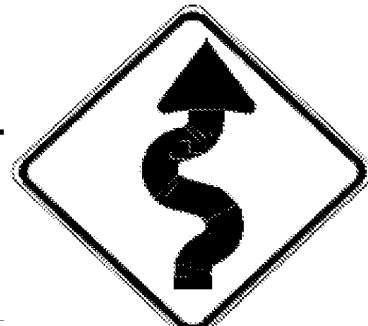

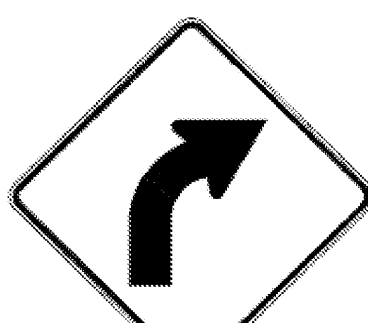

DIRECTION	MILEPOINT	LOCATION CODE (SHEET 2)	SIGN CODE	WIDTH (IN)	HEIGHT (IN)	SHEETING REMARKS	SIGN LEGEND	NEW SIGNS		EXISTING SIGNS				EXIST POST		NUMBER OF NEW POSTS	SQUARE STEEL (IN)			TUBULAR STEEL Ø (IN)				SIGN FRAME REQUIRED	REMARKS	SIGN DETAIL		
								"A"	"B"	RETAIN	SALVAGE FROM	SALVAGE TO	REMOVE	RETAIN	REMOVE		1.75	2.00	2.50	3.00	3.50	4.00	5.00			DETAIL IN SHS	DETAIL ON SHEET NUMBER	DETAIL ON STD SHEET NUMBER
																	(LB / FT)			(LB / FT)								
GRANVILLE VT 100							FY-FLUORESCENT YELLOW FYG-FLUORESCENT YELLOW GREEN																"SHS"-STANDARD HIGHWAY SIGNS					
NB	4.521	B	W1-6	48	24																							
		B	W1-6	48	24	FY		8.00																		X		
NB	4.843	A	W1-2L	30	30		LEFT CURVE																					
		A	W13-1	18	18		40 MPH PLAQUE																					
NB	4.878	A	W1-2L	30	30	FY		6.25																		X		
		A	W13-1	18	18	FY		2.25																		X		
NB	4.888	A	OM-3R	12	36																							
		A	OM-3R	12	36			3.00																		X		
NB	4.893	B	OM-3L	12	36																							
		B	OM-3L	12	36			3.00																		X		
NB	5.008	A	W1-4L	30	30		LEFT REVERSE CURVE																					
		A	W13-1	18	18		35 MPH PLAQUE																					
NB	5.033	A	W1-4L	30	30	FY		6.25																		X		
		A	W13-1	18	18	FY		2.25																		X		
NB	5.094	A	OM-3R	12	36																							
SIGN SUMMARY SHEET							SHEET TOTALS	31.00	0.00	0	0	0	8	0	0	6	90							PROJECT NAME: Ludlow-Waitsfield VT100				
								SF	SF	EA	EA	EA	EA	EA	EA	EA	FT							PROJECT NUMBER: STPG SIGN(27)				
VERMONT AGENCY OF TRANSPORTATION							TOWN TOTALS	601.1	0.0	18.0	3.0	3.0	116	0.0	0.0	129	1935.0							FILE NAME: Granville.xls PLOT DATE: 9/11/2009				
																								PROJECT MANAGER: N. Avery DRAWN BY: I. Shea				
																								DESIGNED BY: J. Kelly CHECKED BY: N. Avery				
																								GRANVILLE SHEET 6 SHEET 141 OF 204				



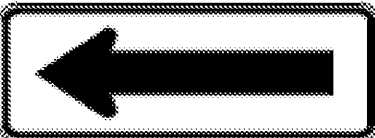


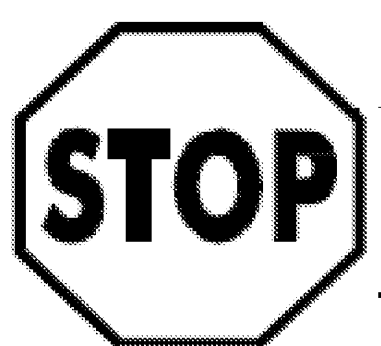

DIRECTION	MILEPOINT	LOCATION CODE (SHEET 2)	SIGN CODE	WIDTH (IN)	HEIGHT (IN)	SHEETING REMARKS	SIGN LEGEND	NEW SIGNS		EXISTING SIGNS				EXIST POST		NUMBER OF NEW POSTS	SQUARE STEEL (IN)			TUBULAR STEEL Ø (IN)				SIGN FRAME REQUIRED	REMARKS	SIGN DETAIL		
								"A"	"B"	RETAIN	SALVAGE FROM	SALVAGE TO	REMOVE	RETAIN	REMOVE		1.75	2.00	2.50	3.00	3.50	4.00	5.00			DETAIL IN SHS	DETAIL ON SHEET NUMBER	DETAIL ON STD SHEET NUMBER
																	(LB / FT)			(LB / FT)								
GRANVILLE VT 100							FY-FLUORESCENT YELLOW FYG-FLUORESCENT YELLOW GREEN															"SHS"-STANDARD HIGHWAY SIGNS						
			A OM-3R	12	36			3.00							1		X							X				
NB	5.099		B OM-3L	12	36								1			X												
			B OM-3L	12	36			3.00							1		X								X			
NB	5.495		A OM-3R	12	36								1			X												
			A OM-3R	12	36			3.00							1		X								X			
NB	5.500		B OM-3L	12	36								1			X												
			B OM-3L	12	36			3.00							1		X								X			
NB	5.708		A OM-3R	12	36								1			X												
			A OM-3R	12	36			3.00							1		X								X			
NB	5.713		B OM-3L	12	36								1			X												
			B OM-3L	12	36			3.00							1		X								X			
NB	5.781		A W1-5R	30	30		RIGHT WINDING CURVES						1			X												
			A W13-1	18	18		35 MPH PLAQUE						1															
NB	5.848		A W1-5L	30	30	FY		6.25							1		X								X			
			A W13-1	18	18	FY		2.25																	X			
SIGN SUMMARY SHEET							SHEET TOTALS	26.50	0.00	0	0	0	7	0	0	7	105											
VERMONT AGENCY OF TRANSPORTATION								SF	SF	EA	EA	EA	EA	EA	EA	EA	EA	FT										
							TOWN TOTALS	601.1	0.0	18.0	3.0	3.0	116	0.0	0.0	129	1935.0											
															PROJECT NAME:	Ludlow-Waitsfield VT100												
															PROJECT NUMBER:	STPG SIGN(27)												
															FILE NAME:	Granville.xls				PLOT DATE:	9/11/2009							
															PROJECT MANAGER:	N. Avery				DRAWN BY:	I. Shea							
															DESIGNED BY:	J. Kelly				CHECKED BY:	N. Avery							
															GRANVILLE SHEET 7					SHEET	142 OF 204							

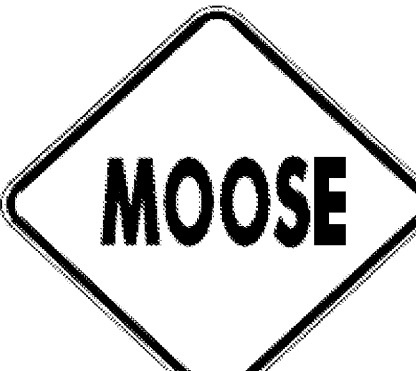

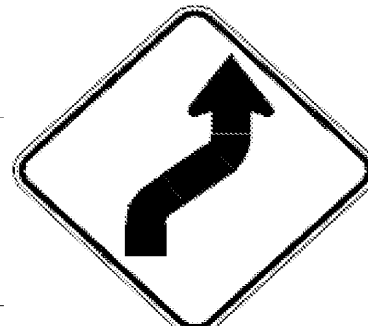

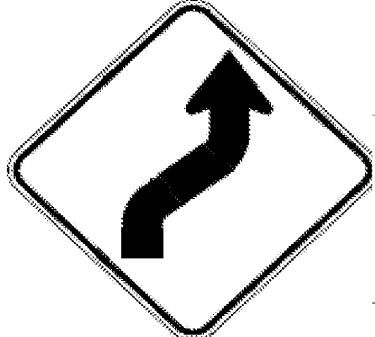



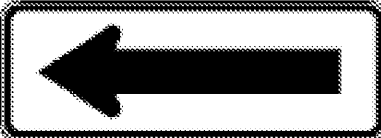
DIRECTION	MILEPOINT	LOCATION CODE (SHEET 2)	SIGN CODE	WIDTH (IN)	HEIGHT (IN)	SHEETING REMARKS	SIGN LEGEND	NEW SIGNS		EXISTING SIGNS				EXIST POST		NUMBER OF NEW POSTS	SQUARE STEEL (IN)			TUBULAR STEEL Ø (IN)				SIGN FRAME REQUIRED	REMARKS	SIGN DETAIL					
								"A"	"B"	RETAIN	SALVAGE FROM	SALVAGE TO	REMOVE	RETAIN	REMOVE		1.75	2.00	2.50	3.00	3.50	4.00	5.00			DETAIL IN SHS	DETAIL ON SHEET NUMBER	DETAIL ON STD SHEET NUMBER			
																	(LB / FT)			(LB / FT)											
								1.88	2.42	3.35	FOUNDATION				7.60		9.00	10.80	14.60												
GRANVILLE VT 100							FY-FLUORESCENT YELLOW FYG-FLUORESCENT YELLOW GREEN																"SHS"-STANDARD HIGHWAY SIGNS								
NB	6.077	A	W1-6	48	24							1		X																	
		A	W1-6	48	24	FY		8.00																		X					
NB	6.102	B	W1-6	48	24							1		X																	
		B	W1-6	48	24	FY		8.00																		X					
NB	6.253	A	W1-6	48	24							1		X																	
		A	W1-6	48	24	FY		8.00																		X					
NB	6.253	B	W1-6	48	24							1		X																	
		B	W1-6	48	24	FY		8.00																		X					
NB	6.403	A	W1-2L	30	30		LEFT CURVE					1		X																	
		A	W13-1	18	18		35 MPH PLAQUE					1																			
NB	6.441	A	W1-2L	30	30	FY		6.25							1																
		A	W13-1	18	18	FY		2.25																		X					
NB	6.442	A	W1-6	48	24							1		X																	
		A	W1-6	48	24	FY		8.00																		X					
NB	6.442	B	W1-6	48	24							1		X																	
SIGN SUMMARY SHEET							SHEET TOTALS	48.50	0.00	0	0	0	8	0	0	11	165								PROJECT NAME: Ludlow-Waitsfield VT100						
								SF	SF	EA	EA	EA	EA	EA	EA	EA	EA	EA	EA	EA	EA	EA	EA	EA		PROJECT NUMBER: STPG SIGN(27)					
							TOWN TOTALS	601.1	0.0	18.0	3.0	3.0	116	0.0	0.0	129	1935.0									FILE NAME: Granville.xls					
																									PLOT DATE: 9/11/2009						
VERMONT AGENCY OF TRANSPORTATION																									DRAWN BY: I. Shea						
																									DESIGNED BY: J. Kelly						
																									CHECKED BY: N. Avery						
																									SHEET 143 OF 204						
																									GRANVILLE SHEET 8						






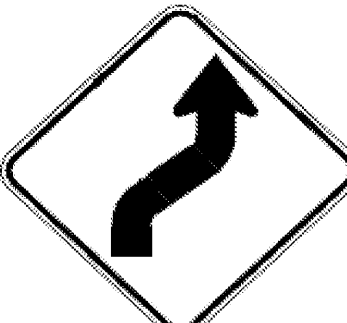


DIRECTION	MILEPOINT	LOCATION CODE (SHEET 2)	SIGN CODE	WIDTH (IN)	HEIGHT (IN)	SHEETING REMARKS	SIGN LEGEND	NEW SIGNS		EXISTING SIGNS				EXIST POST		NUMBER OF NEW POSTS	SQUARE STEEL (IN)			TUBULAR STEEL Ø (IN)				SIGN FRAME REQUIRED	REMARKS	SIGN DETAIL		
								"A"	"B"	RETAIN	SALVAGE FROM	SALVAGE TO	REMOVE	RETAIN	REMOVE		1.75	2.00	2.50	3.00	3.50	4.00	5.00			DETAIL IN SHS	DETAIL ON SHEET NUMBER	DETAIL ON STD SHEET NUMBER
																	(LB / FT)			(LB / FT)								
GRANVILLE VT 100							FY-FLUORESCENT YELLOW FYG-FLUORESCENT YELLOW GREEN																"SHS"-STANDARD HIGHWAY SIGNS					
			B W1-6	48	24	FY		8.00							2	X									X			
NB	6.499		A W1-6	48	24			8.00				1			X										X			
			A W1-6	48	24	FY		8.00						2	X										X			
NB	6.499		B W1-6	48	24			8.00				1			X										X			
			B W1-6	48	24	FY		8.00						2	X										X			
NB	6.539		A W1-6	48	24			8.00				1			X										X			
			A W1-6	48	24	FY		8.00						2	X										X			
NB	6.539		B W1-6	48	24			8.00				1			X										X			
			B W1-6	48	24	FY		8.00						2	X										X			
NB	6.775		C VR-017	24	30			5.00				1			X													
			C VR-017	24	30			5.00						1	X												E-141	
NB	6.780		D R1-1	30	30			6.25				1			X													
			D R1-1	30	30			6.25						1	X										X			
NB	6.855		A W1-4R	30	30		RIGHT REVERSE CURVE			1				X														
			A W13-1	18	18		40 MPH PLAQUE			1				X														
SIGN SUMMARY SHEET							SHEET TOTALS	51.25	0.00	2	0	0	6	0	0	12	180								PROJECT NAME: Ludlow-Waitsfield VT100			
							SF	SF	EA	EA	EA	EA	EA	EA	EA	EA		FT										PROJECT NUMBER: STPG SIGN(27)
VERMONT AGENCY OF TRANSPORTATION							TOWN TOTALS	601.1	0.0	18.0	3.0	3.0	116	0.0	0.0	129	1935.0							FILE NAME: Granville.xls	PLOT DATE: 9/11/2009			
																							PROJECT MANAGER: N. Avery	DRAWN BY: I. Shea				
																								DESIGNED BY: J. Kelly	CHECKED BY: N. Avery			
																								GRANVILLE SHEET 9	SHEET 144	OF 204		

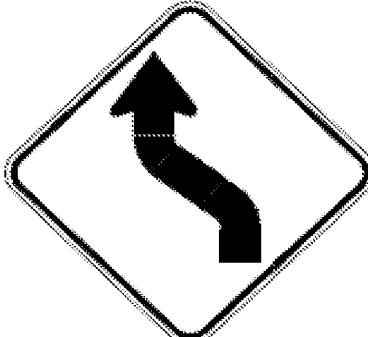DIRECTION	MILEPOINT	LOCATION CODE (SHEET 2)	SIGN CODE	WIDTH (IN)	HEIGHT (IN)	SHEETING REMARKS	SIGN LEGEND	NEW SIGNS		EXISTING SIGNS				EXIST POST		NUMBER OF NEW POSTS	SQUARE STEEL (IN)			TUBULAR STEEL Ø (IN)				SIGN FRAME REQUIRED	REMARKS	SIGN DETAIL										
								"A"	"B"	RETAIN	SALVAGE FROM	SALVAGE TO	REMOVE	RETAIN	REMOVE		1.75	2.00	2.50	3.00	3.50	4.00	5.00			DETAIL IN SHS	DETAIL ON SHEET NUMBER	DETAIL ON STD SHEET NUMBER								
																	(LB / FT)			(LB / FT)																
GRANVILLE VT 100							FY-FLUORESCENT YELLOW FYG-FLUORESCENT YELLOW GREEN															"SHS"-STANDARD HIGHWAY SIGNS														
NB	6.996	A	VW-000	30	30		MOOSE CROSSING				1																									
		A	W7-3A	24	18		NEXT 2 MILES				1																									
NB	7.055	A	VW-000	30	30		MOOSE CROSSING					1					X																			
		A	W7-3A	24	18		NEXT 2 MILES					1																								
NB	8.320	C	VR-017	24	30		TOWN'S NEIGHBORHOOD WATCH SIGN  						1																							
		D	R1-1	30	30																															
		C																																		
		C	VR-017	24	30										1			X																		
		D	R1-1	30	30																															
NB	8.326	D	R1-1	30	30																															
		D	R1-1	30	30																															
NB	9.138	C	VR-023B	24	30		\$500 FINE FOR THROWING TRASH																													
SB	8.620	F	VW-001	30	30		 																													
		F	W7-3A	24	18																															
		F	VW-001	30	30																															
SIGN SUMMARY SHEET							SHEET TOTALS	23.75	0.00	0	2	2	7	0	0	5	75							PROJECT NAME: Ludlow-Waitsfield VT100												
VERMONT AGENCY OF TRANSPORTATION								SF	SF	EA	EA	EA	EA	EA	EA	EA	FT							PROJECT NUMBER: STPG SIGN(27)												
							TOWN TOTALS	601.1	0.0	18.0	3.0	3.0	116	0.0	0.0	129	1935.0							FILE NAME: Granville.xls												
																							PLOT DATE: 9/11/2009													
																							DRAWN BY: I. Shea													
																							CHECKED BY: N. Avery													
																							SHEET 145 OF 204													

DIRECTION	MILEPOINT	LOCATION CODE (SHEET 2)	SIGN CODE	WIDTH (IN)	HEIGHT (IN)	SHEETING REMARKS	SIGN LEGEND	NEW SIGNS		EXISTING SIGNS				EXIST POST		NUMBER OF NEW POSTS	SQUARE STEEL (IN)			TUBULAR STEEL Ø (IN)				SIGN FRAME REQUIRED	REMARKS	SIGN DETAIL								
								"A"	"B"	RETAIN	SALVAGE FROM	SALVAGE TO	REMOVE	RETAIN	REMOVE		1.75	2.00	2.50	3.00	3.50	4.00	5.00			DETAIL IN SHS	DETAIL ON SHEET NUMBER	DETAIL ON STD SHEET NUMBER						
																	(LB / FT)			(LB / FT)														
GRANVILLE VT 100							FY-FLUORESCENT YELLOW FYG-FLUORESCENT YELLOW GREEN																"SHS"-STANDARD HIGHWAY SIGNS											
			F W7-3A	24	18			3.00							1	X									X									
SB	7.394	G	VR-023B	24	30		\$500 FINE FOR THROWING TRASH																											
SB	7.189	F	W1-4R	30	30																													
		F	W13-1	18	18		 																											
		F	W1-4R	30	30	FY			6.25							1	X										X							
		F	W13-1	18	18	FY			2.25																		X							
SB	6.706	F	W1-5R	30	30		RIGHT WINDING CURVES																											
		F	W13-1	18	18		35 MPH PLAQUE	 																										
SB	6.630	F	W1-5R	30	30				6.25							1	X										X		INSTALL 400 FEET SOUTH OF EXISTING WINDING ROAD RIGHT SIGN ASSEMBLY					
		F	W13-1	18	18			2.25																		X								
SB	6.606	F	W1-2R	30	30		RIGHT CURVE																											
		F	W13-1	18	18		35 MPH PLAQUE	 																										
SB	6.568	F	W1-2R	30	30	FY			6.25							1	X										X		INSTALL 200 FEET SOUTH OF EXISTING RIGHT CURVE ASSEMBLY					
		F	W13-1	18	18	FY		2.25																		X								
SB	6.164	F	W1-4R	30	30																													
SIGN SUMMARY SHEET							SHEET TOTALS	28.50	0.00	0	0	0	8	0	0	4	60																	
								SF	SF	EA	EA	EA	EA	EA	EA	EA	EA	EA	EA	EA	EA	EA	EA	EA	EA	EA	EA	EA	EA	EA	EA	EA	EA	EA
							TOWN TOTALS	601.1	0.0	18.0	3.0	3.0	116	0.0	0.0	129	1935.0																	
VERMONT AGENCY OF TRANSPORTATION																						PROJECT NAME: Ludlow-Waitsfield VT100												
																						PROJECT NUMBER: STPG SIGN(27)												
																						FILE NAME: Granville.xls	PLOT DATE: 9/11/2009											
																						PROJECT MANAGER: N. Avery	DRAWN BY: I. Shea											
																						DESIGNED BY: J. Kelly	CHECKED BY: N. Avery											
																						GRANVILLE SHEET 11	SHEET 146 OF 204											




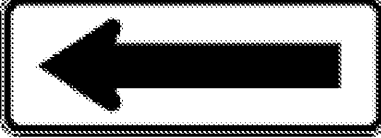
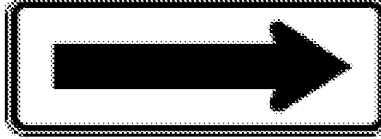


DIRECTION	MILEPOINT	LOCATION CODE (SHEET 2)	SIGN CODE	WIDTH (IN)	HEIGHT (IN)	SHEETING REMARKS	SIGN LEGEND	NEW SIGNS		EXISTING SIGNS				EXIST POST		NUMBER OF NEW POSTS	SQUARE STEEL (IN)			TUBULAR STEEL Ø (IN)				SIGN FRAME REQUIRED	REMARKS	SIGN DETAIL		
								"A"	"B"	RETAIN	SALVAGE FROM	SALVAGE TO	REMOVE	RETAIN	REMOVE		1.75	2.00	2.50	3.00	3.50	4.00	5.00			DETAIL IN SHS	DETAIL ON SHEET NUMBER	DETAIL ON STD SHEET NUMBER
																	(LB / FT)			(LB / FT)								
																	1.88	2.42	3.35	FOUNDATION	7.60	9.00	10.80					
GRANVILLE VT 100							FY-FLUORESCENT YELLOW FYG-FLUORESCENT YELLOW GREEN															"SHS"-STANDARD HIGHWAY SIGNS						
			F W13-1	18	18								1															
			F W1-4R	30	30	FY		6.25										X										X
			F W13-1	18	18	FY		2.25																				X
SB	5.998		F W1-6	48	24								1		X													
			F W1-6	48	24	FY		8.00										X										X
SB	5.707		F OM-3R	12	36								1		X													
			F OM-3R	12	36			3.00										X										X
SB	5.702		E OM-3L	12	36								1		X													
			E OM-3L	12	36			3.00										X										X
SB	5.672		F VR-020	24	30																							
			F VR-020	24	30			5.00										X										
			E VR-020	24	30			5.00																				
SB	5.637		G VM-607	24	30		43RD INF DIV				1				X													
SB	5.617		F VR-020	24	30									1		X												
			E VR-020	24	30									1														
SIGN SUMMARY SHEET							SHEET TOTALS		32.50	0.00	1	0	0	6	0	0	6	90					PROJECT NAME: Ludlow-Waitsfield VT100					
							SF	SF	EA	EA	EA	EA	EA	EA	EA	EA	EA	EA	EA	EA	EA	EA	EA	EA	EA	EA	EA	EA
VERMONT AGENCY OF TRANSPORTATION							TOWN TOTALS		601.1	0.0	18.0	3.0	3.0	116	0.0	0.0	129	1935.0					FILE NAME: Granville.xls	PLOT DATE: 9/11/2009				
																							PROJECT MANAGER: N. Avery	DRAWN BY: I. Shea				
																				DESIGNED BY: J. Kelly	CHECKED BY: N. Avery							
																				GRANVILLE SHEET 12				SHEET 147 OF 204				


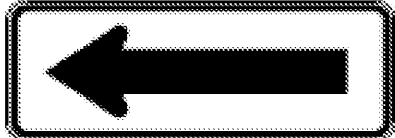

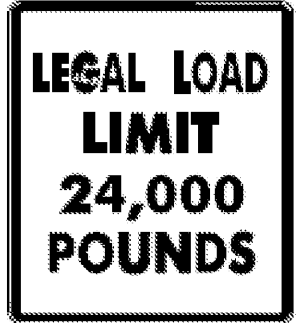

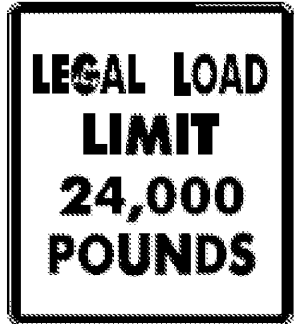

DIRECTION	MILEPOINT	LOCATION CODE (SHEET 2)	SIGN CODE	WIDTH (IN)	HEIGHT (IN)	SHEETING REMARKS	SIGN LEGEND	NEW SIGNS		EXISTING SIGNS				EXIST POST		NUMBER OF NEW POSTS	SQUARE STEEL (IN)			TUBULAR STEEL Ø (IN)				SIGN FRAME REQUIRED	REMARKS	SIGN DETAIL		
								"A"	"B"	RETAIN	SALVAGE FROM	SALVAGE TO	REMOVE	RETAIN	REMOVE		1.75	2.00	2.50	3.00	3.50	4.00	5.00			DETAIL IN SHS	DETAIL ON SHEET NUMBER	DETAIL ON STD SHEET NUMBER
																	(LB / FT)			(LB / FT)								
GRANVILLE VT 100							FY-FLUORESCENT YELLOW FYG-FLUORESCENT YELLOW GREEN																"SHS"-STANDARD HIGHWAY SIGNS					
			F VR-020	24	30				5.00															INSTALL BACK TO BACK AT SAME LOCATION		6		
			E VR-020	24	30				5.00																6			
SB	5.531		F VR-020	24	30								1										INSTALL 100 FEET NORTH OF GUARDRAIL		6			
			F VR-020	24	30				5.00																			
SB	5.500		F OM-3R	12	36								1															
			F OM-3R	12	36				3.00															X				
SB	5.495		E OM-3L	12	36								1															
			E OM-3L	12	36				3.00															X				
SB	5.240		F W1-4L	30	30		LEFT REVERSE CURVE						1															
			F W13-1	18	18		35 MPH PLAQUE						1															
SB	5.193		F W1-4L	30	30	FY			6.25														INSTALL 250 FEET SOUTH OF EXISTING REVERSE CURVE ASSEMBLY	X				
			F W13-1	18	18	FY			2.25															X				
SB	5.160		F W1-6	48	24								1															
			F W1-6	48	24	FY			8.00															X				
SB	5.140		E W1-6	48	24								1															
SIGN SUMMARY SHEET							SHEET TOTALS		37.50	0.00	0	0	0	7	0	0	7	105					PROJECT NAME: Ludlow-Waitsfield VT100					
									SF	SF	EA	EA	EA	EA	EA	EA	EA	FT					PROJECT NUMBER: STPG SIGN(27)					
VERMONT AGENCY OF TRANSPORTATION							TOWN TOTALS		601.1	0.0	18.0	3.0	3.0	116	0.0	0.0	129	1935.0					FILE NAME: Granville.xls	PLOT DATE: 9/11/2009				
																							PROJECT MANAGER: N. Avery	DRAWN BY: I. Shea				
																							DESIGNED BY: J. Kelly	CHECKED BY: N. Avery				
																							GRANVILLE SHEET 13	SHEET 148 OF 204				




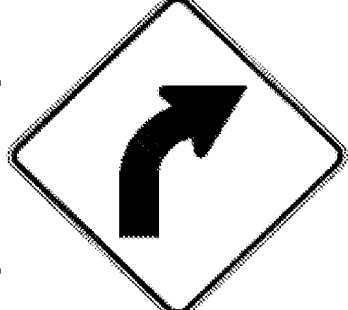

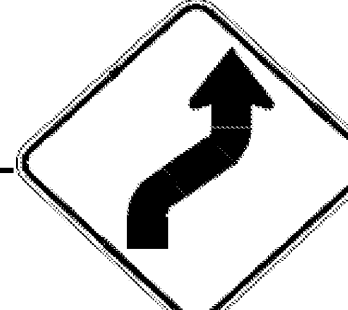
DIRECTION	MILEPOINT	LOCATION CODE (SHEET 2)	SIGN CODE	WIDTH (IN)	HEIGHT (IN)	SHEETING REMARKS	SIGN LEGEND	NEW SIGNS		EXISTING SIGNS				EXIST POST		NUMBER OF NEW POSTS	SQUARE STEEL (IN)			TUBULAR STEEL Ø (IN)				SIGN FRAME REQUIRED	REMARKS	SIGN DETAIL		
								"A"	"B"	RETAIN	SALVAGE FROM	SALVAGE TO	REMOVE	RETAIN	REMOVE		1.75	2.00	2.50	3.00	3.50	4.00	5.00			DETAIL IN SHS	DETAIL ON SHEET NUMBER	DETAIL ON STD SHEET NUMBER
																	(LB / FT)			(LB / FT)								
GRANVILLE VT 100							FY-FLUORESCENT YELLOW FYG-FLUORESCENT YELLOW GREEN															"SHS"-STANDARD HIGHWAY SIGNS						
			E W1-6	48	24	FY		8.00							2		X								X			
SB	5.092		F OM-3R	12	36								1			X												
			F OM-3R	12	36			3.00							1		X								X			
SB	5.089		E OM-3L	12	36								1			X												
			E OM-3L	12	36			3.00							1		X								X			
SB	4.897		F OM-3R	12	36								1			X												
			F OM-3R	12	36			3.00							1		X								X			
SB	4.889		E OM-3L	12	36								1			X												
			E OM-3L	12	36			3.00							1		X								X			
SB	4.617		F W1-4R	30	30		RIGHT REVERSE CURVE						1			X												
			F W13-1	18	18		35 MPH ADVISORY						1															
SB	4.598		F W1-4R	30	30	FY		6.25							1		X									INSTALL 100 FEET SOUTH OF EXISTING REVERSE CURVE ASSEMBLY		
			F W13-1	18	18	FY		2.25																		X		
SB	4.431		F OM-3R	12	36								1			X												
			F OM-3R	12	36			3.00							1		X								X			
SIGN SUMMARY SHEET							SHEET TOTALS	31.50	0.00	0	0	0	7	0	0	8		120										
								SF	SF	EA	EA	EA	EA	EA	EA	EA		FT										
VERMONT AGENCY OF TRANSPORTATION							TOWN TOTALS	601.1	0.0	18.0	3.0	3.0	116	0.0	0.0	129		1935.0										




PROJECT NAME: Ludlow-Waitsfield VT100
PROJECT NUMBER: STPG SIGN(27)
FILE NAME: Granville.xls
PROJECT MANAGER: N. Avery
DESIGNED BY: J. Kelly
GRANVILLE SHEET 14

PLOT DATE: 9/11/2009
DRAWN BY: I. Shea
CHECKED BY: N. Avery
SHEET 149 OF 204





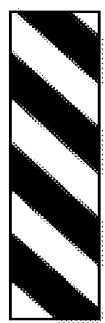
DIRECTION	MILEPOINT	LOCATION CODE (SHEET 2)	SIGN CODE	WIDTH (IN)	HEIGHT (IN)	SHEETING REMARKS	SIGN LEGEND	NEW SIGNS		EXISTING SIGNS				EXIST POST		NUMBER OF NEW POSTS	SQUARE STEEL (IN)			TUBULAR STEEL Ø (IN)				SIGN FRAME REQUIRED	REMARKS	SIGN DETAIL		
								"A"	"B"	RETAIN	SALVAGE FROM	SALVAGE TO	REMOVE	RETAIN	REMOVE		1.75	2.00	2.50	3.00	3.50	4.00	5.00			DETAIL IN SHS	DETAIL ON SHEET NUMBER	DETAIL ON STD SHEET NUMBER
																	(LB / FT)			(LB / FT)								
GRANVILLE VT 100							FY-FLUORESCENT YELLOW FYG-FLUORESCENT YELLOW GREEN															"SHS"-STANDARD HIGHWAY SIGNS						
SB	4.426	E	OM-3L	12	36																							
		E	OM-3L	12	36			3.00																X				
SB	4.328	F	W1-6	48	24	FY		8.00																	INSTALL 300 FEET NORTH OF EXISTING ASSEMBLY	X		
SB	4.300	E	W1-6	48	24	FY		8.00																	INSTALL 150 FEET SOUTH OF NEW ASSEMBLY ABOVE	X		
SB	4.271	F	W1-6	48	24																							
		F	W1-6	48	24	FY		8.00																X				
SB	4.240	E	W1-6	48	24																							
		E	W1-6	48	24	FY		8.00																X				
SB	3.971	F	OM-3R	12	36																							
		F	OM-3R	12	36			3.00																X				
SB	3.965	E	OM-3L	12	36																							
		E	OM-3L	12	36			3.00																X				
SB	3.271	F	VD-062BC	74.75	16		TRAVEL INFO SIGN			1																		
		F	VD-062C	74.75	16		TRAVEL INFO SIGN			1																		
SB	3.216	F	W3-5	36	36		SPEED REDUCTION (35)			1																		
SIGN SUMMARY SHEET							SHEET TOTALS	41.00	0.00	3	0	0	5	0	0	11	165											
VERMONT AGENCY OF TRANSPORTATION								SF	SF	EA	EA	EA	EA	EA	EA	EA	FT											
							TOWN TOTALS	601.1	0.0	18.0	3.0	3.0	116	0.0	0.0	129	1935.0											
															PROJECT NAME:	Ludlow-Waitsfield VT100												
															PROJECT NUMBER:	STPG SIGN(27)												
															FILE NAME:	Granville.xls			PLOT DATE:	9/11/2009								
															PROJECT MANAGER:	N. Avery			DRAWN BY:	I. Shea								
															DESIGNED BY:	J. Kelly			CHECKED BY:	N. Avery								
															GRANVILLE SHEET 15				SHEET	150 OF 204								


DIRECTION	MILEPOINT	LOCATION CODE (SHEET 2)	SIGN CODE	WIDTH (IN)	HEIGHT (IN)	SHEETING REMARKS	SIGN LEGEND	NEW SIGNS		EXISTING SIGNS				EXIST POST		NUMBER OF NEW POSTS	SQUARE STEEL (IN)			TUBULAR STEEL Ø (IN)				SIGN FRAME REQUIRED	REMARKS	SIGN DETAIL		
								"A"	"B"	RETAIN	SALVAGE FROM	SALVAGE TO	REMOVE	RETAIN	REMOVE		1.75	2.00	2.50	3.00	3.50	4.00	5.00			DETAIL IN SHS	DETAIL ON SHEET NUMBER	DETAIL ON STD SHEET NUMBER
																	(LB / FT)			(LB / FT)								
GRANVILLE VT 100							FY-FLUORESCENT YELLOW FYG-FLUORESCENT YELLOW GREEN																"SHS"-STANDARD HIGHWAY SIGNS					
SB	3.080	F	VD-018	30	18																							
		F	VD-018	30	18			3.75																		E-128A		
SB	3.036	F	R2-1	30	36		SPEED LIMIT 35			1																		
SB	3.000	F	W1-6	48	24																							
		F	W1-6	48	24			8.00																	X			
SB	3.001	E	W1-6	48	24																							
		E	W1-6	48	24			8.00																	X			
SB	3.002	G	VR-017	24	30																							
		G	VR-017	24	30			5.00																		E-141		
SB	2.990	H	R1-1	30	30																							
		H	R1-1	30	30			6.25																	X			
SB	2.988	G	VR-017	24	30																							
		G	VR-017	24	30			5.00																		E-141		
SB	2.985	H	R1-1	30	30																							
		H	R1-1	30	30			6.25																	X			
SIGN SUMMARY SHEET							SHEET TOTALS	42.25	0.00	1	0	0	7	0	0	9	135							PROJECT NAME: Ludlow-Waitsfield VT100				
								SF	SF	EA	EA	EA	EA	EA	EA	EA	FT							PROJECT NUMBER: STPG SIGN(27)				
VERMONT AGENCY OF TRANSPORTATION							TOWN TOTALS	601.1	0.0	18.0	3.0	3.0	116	0.0	0.0	129	1935.0							FILE NAME: Granville.xls	PLOT DATE: 9/11/2009			
																							PROJECT MANAGER: N. Avery	DRAWN BY: I. Shea				
																							DESIGNED BY: J. Kelly	CHECKED BY: N. Avery				
																							GRANVILLE SHEET 16	SHEET 151 OF 204				






DIRECTION	MILEPOINT	LOCATION CODE (SHEET 2)	SIGN CODE	WIDTH (IN)	HEIGHT (IN)	SHEETING REMARKS	SIGN LEGEND	NEW SIGNS		EXISTING SIGNS				EXIST POST		NUMBER OF NEW POSTS	SQUARE STEEL (IN)			TUBULAR STEEL Ø (IN)				SIGN FRAME REQUIRED	REMARKS	SIGN DETAIL		
								"A"	"B"	RETAIN	SALVAGE FROM	SALVAGE TO	REMOVE	RETAIN	REMOVE		(LB / FT)			(LB / FT)						DETAIL IN SHS	DETAIL ON SHEET NUMBER	DETAIL ON STD SHEET NUMBER
																	1.75	2.00	2.50	3.00	3.50	4.00	5.00					
GRANVILLE VT 100							FY-FLUORESCENT YELLOW FYG-FLUORESCENT YELLOW GREEN																"SHS"-STANDARD HIGHWAY SIGNS					
SB	2.975	F	W1-6	48	24																							
		F	W1-6	48	24			8.00																X				
SB	2.950	F	M3-3	24	12																							
		F	M1-5	24	30																							
		F	M3-3	24	12			2.00																	X			
		F	M1-5	24	30			5.00																		E-136B		
SB	2.869	F	VD-062AS	72	16		BUSINESS SIGN			1																		
SB	2.819	F	W1-2R	30	30		RIGHT CURVE																					
		F	R2-1	24	30																							
																												
SB	2.772	F	W1-2R	30	30																							
SB	2.680	F	R2-1	24	30																							
		F	R2-1	24	30																							
SB	2.638	F	W11-8	30	30		FIRE STATION			1																		
SB	2.236	F	W1-4R	30	30		RIGHT REVERSE CURVE																					
																												
SB	2.203	F	W1-4R	30	30																							
SIGN SUMMARY SHEET							SHEET TOTALS	37.50	0.00	2	0	0	6	0	0	7	105					PROJECT NAME: Ludlow-Waitsfield VT100						
								SF	SF	EA	EA	EA	EA	EA	EA	EA	FT					PROJECT NUMBER: STPG SIGN(27)						
VERMONT AGENCY OF TRANSPORTATION							TOWN TOTALS	601.1	0.0	18.0	3.0	3.0	116	0.0	0.0	129	1935.0					FILE NAME: Granville.xls						
																					PLOT DATE: 9/11/2009							
																					DRAWN BY: I. Shea							
																					DESIGNED BY: J. Kelly							
																					CHECKED BY: N. Avery							
																					SHEET 152 OF 204							

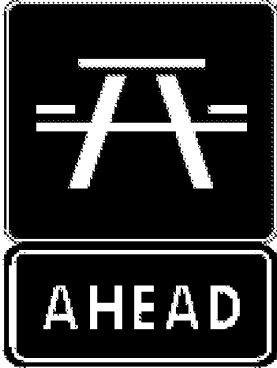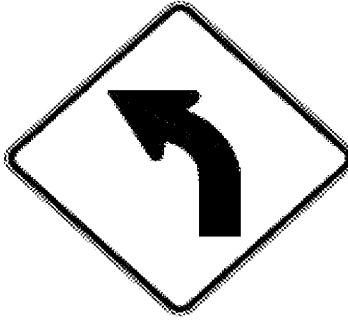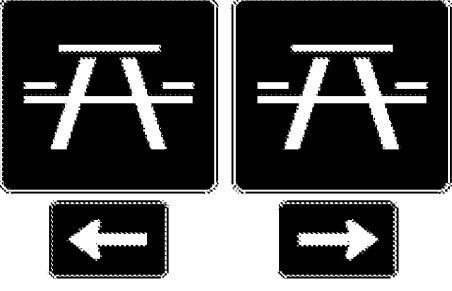

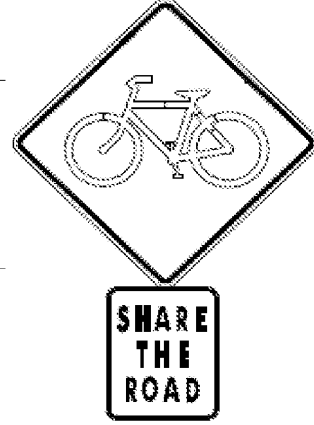
DIRECTION	MILEPOINT	LOCATION CODE (SHEET 2)	SIGN CODE	WIDTH (IN)	HEIGHT (IN)	SHEETING REMARKS	SIGN LEGEND	NEW SIGNS		EXISTING SIGNS				EXIST POST		NUMBER OF NEW POSTS	SQUARE STEEL (IN)			TUBULAR STEEL Ø (IN)				SIGN FRAME REQUIRED	REMARKS	SIGN DETAIL					
								"A"	"B"	RETAIN	SALVAGE FROM	SALVAGE TO	REMOVE	RETAIN	REMOVE		1.75	2.00	2.50	3.00	3.50	4.00	5.00			DETAIL IN SHS	DETAIL ON SHEET NUMBER	DETAIL ON STD SHEET NUMBER			
																	(LB / FT)			(LB / FT)											
GRANVILLE VT 100							FY-FLUORESCENT YELLOW FYG-FLUORESCENT YELLOW GREEN																"SHS"-STANDARD HIGHWAY SIGNS								
SB	2.026	F	R2-5A	24	30		REDUCED SPEED AHEAD						1		X																
SB	1.945	F	VD-018	30	18		LOWER GRANVILLE VILLAGE SIGN						1		X																
		F	W3-5	36	36			9.00							2		X									X					
SB	1.890	F	VD-018	30	18			3.75							1		X									X			INSTALL 290 FEET SOUTH OF EXISTING VILLAGE SIGN AND ON EDGE OF FIELD		
SB	1.860	F	R2-1	24	30								1		X																
		F	R2-1	30	36			7.50							1		X										6		INSTALL 10 FEET FROM AND ON NORTH SIDE OF UTILITY POLE		
SB	1.400	F	R2-1	24	30								1		X																
		F	R2-1	24	30			5.00							1		X									X					
SB	0.966	F	OM-3R	12	36									1		X															
SIGN SUMMARY SHEET							SHEET TOTALS	25.25	0.00	0	0	0	5	0	0	5	75														
								SF	SF	EA	EA	EA	EA	EA	EA	EA	FT														
VERMONT AGENCY OF TRANSPORTATION							TOWN TOTALS	601.1	0.0	18.0	3.0	3.0	116	0.0	0.0	129	1935.0														


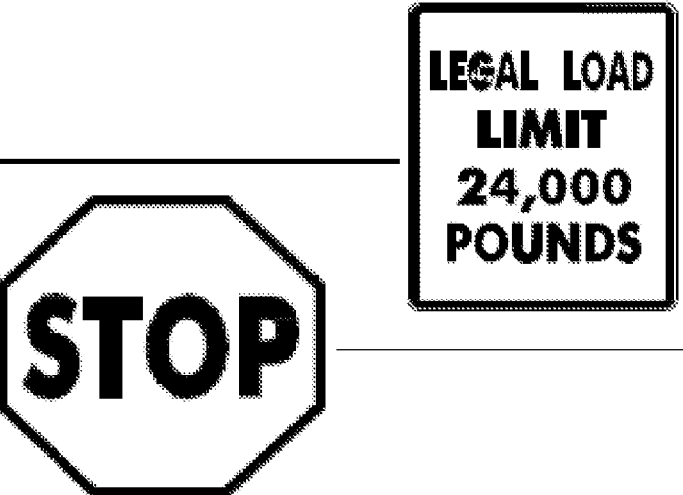

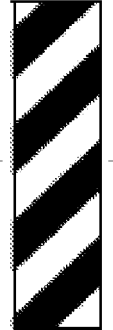
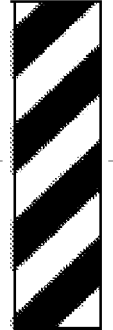





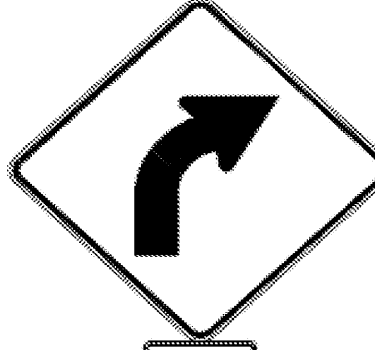




PROJECT NAME: Ludlow-Waitsfield VT100
PROJECT NUMBER: STPG SIGN(27)
FILE NAME: Granville.xls
PROJECT MANAGER: N. Avery
DESIGNED BY: J. Kelly
GRANVILLE SHEET 18
PLOT DATE: 9/11/2009
DRAWN BY: I. Shea
CHECKED BY: N. Avery
SHEET 153 OF 204

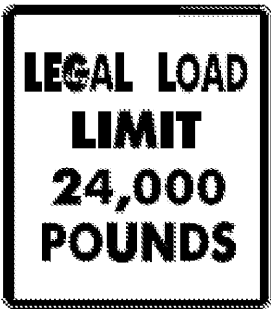


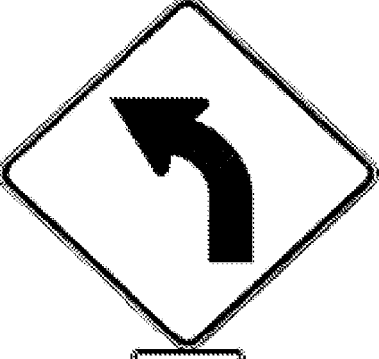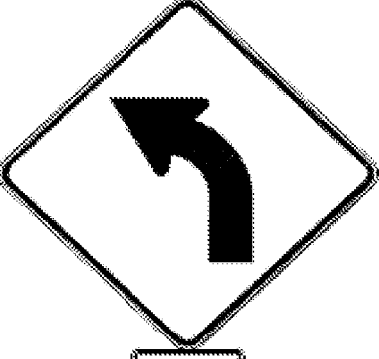DIRECTION	MILEPOINT	LOCATION CODE (SHEET 2)	SIGN CODE	WIDTH (IN)	HEIGHT (IN)	SHEETING REMARKS	SIGN LEGEND	NEW SIGNS		EXISTING SIGNS				EXIST POST		NUMBER OF NEW POSTS	SQUARE STEEL (IN)			TUBULAR STEEL Ø (IN)				SIGN FRAME REQUIRED	REMARKS	SIGN DETAIL		
								"A"	"B"	RETAIN	SALVAGE FROM	SALVAGE TO	REMOVE	RETAIN	REMOVE		(LB / FT)			(LB / FT)						DETAIL IN SHS	DETAIL ON SHEET NUMBER	DETAIL ON STD SHEET NUMBER
																	1.75	2.00	2.50	3.00	3.50	4.00	5.00					
WARREN VT 100							FY-FLUORESCENT YELLOW FYG-FLUORESCENT YELLOW GREEN																"SHS"-STANDARD HIGHWAY SIGNS					
NB	0.048	A	W1-2L	30	30																							
		A	D5-5A	24	24			4.00																	X			
		A	W16-9p	24	12			2.00																	X		WHITE ON BLUE SHEETING	
NB	0.107	A	D5-5A	24	24																							
		A	VD-058	24	8																							
		A	W1-2L	30	30			6.25																	X			
NB	0.180	A	D5-5A	24	24																							
		A	D5-5A	24	6			4.00																	X		INSTALL SIGN ACROSS FROM DRIVE TO PICNIC AREA REMOVE EMPTY SIGN POST	
		B	D5-5A	24	24			1.00																	X		ARROW IS SEPARATE BUT PART OF D5-5A SIGNCODE.	
		B	D5-5A	24	6			4.00																	X		ARROW IS SEPARATE BUT PART OF D5-5A SIGNCODE.	
NB	0.654	A	OM-3R	12	36																							
		A	OM-3R	12	36			3.00																	X			
NB	0.664	B	OM-3L	12	36																							
		B	OM-3L	12	36			3.00																	X			
NB	1.545	C	VR-017	24	24																					CHARLIE ASHLEY RD TH-47		
SIGN SUMMARY SHEET							SHEET TOTALS		28.25	0.00	0	0	0	6	0	0	5	75										PROJECT NAME: Ludlow-Waitsfield VT100
							SF	SF	EA	EA	EA	EA	EA	EA	EA	EA	EA	FT									PROJECT NUMBER: STPG SIGN(27)	
VERMONT AGENCY OF TRANSPORTATION							TOWN TOTALS		465.2	0.0	65.0	10.0	10.0	97	0.0	0.0	90	1350.0									FILE NAME: Warren.xls	
																										PLOT DATE: 9/14/2009		
																										DRAWN BY: I. Shea		
																										DESIGNED BY: D. Crosslev		
																										CHECKED BY: J. Kelly		
																										SHEET 155 OF 204		



DIRECTION	MILEPOINT	LOCATION CODE (SHEET 2)	SIGN CODE	WIDTH (IN)	HEIGHT (IN)	SHEETING REMARKS	SIGN LEGEND	NEW SIGNS		EXISTING SIGNS				EXIST POST		NUMBER OF NEW POSTS	SQUARE STEEL (IN)			TUBULAR STEEL Ø (IN)				SIGN FRAME REQUIRED	REMARKS	SIGN DETAIL												
								"A"	"B"	RETAIN	SALVAGE FROM	SALVAGE TO	REMOVE	RETAIN	REMOVE		1.75	2.00	2.50	FOUNDATION	3.00	3.50	4.00			5.00	DETAIL IN SHS	DETAIL ON SHEET NUMBER	DETAIL ON STD SHEET NUMBER									
																	(LB / FT)				(LB / FT)																	
WARREN VT 100							FY-FLUORESCENT YELLOW FYG-FLUORESCENT YELLOW GREEN																"SHS"-STANDARD HIGHWAY SIGNS															
		C	VR-017	24	30			5.00							1	X											E-141											
NB	1.545	D	R1-1	24	24																																	
		D	R1-1	30	30			6.25								1	X									X		CHARLIE ASHLEY RD TH-47										
NB	2.142	A	VW-054	30	30		HIDDEN DRIVE RIGHT				1					X											E-154											
NB	2.237	A	W1-4L	30	30	FY	LEFT REVERSE CURVE				1					X																						
		A	W13-1	18	18	FY	40 MPH PLAQUE				1																											
NB	2.338	A	W11-2	30	30	FYG	PEDESTRIAN SIGN (HINGED)				1					X																						
NB	2.500	C	VM-607	24	30		43RD INF DIV MEMORIAL HIGHWAY				1					X																						
NB	2.918	A	VD-062AS	72	16		BUSINESS SIGN				1					X																						
		A	VD-062AS	72	16		BUSINESS SIGN				1																											
		A	VD-062AS	72	16		BUSINESS SIGN				1																											
NB	3.040	A	VD-062AS	72	16		BUSINESS SIGN				1	1				X	2	X									REINSTALL THE SIGNS ONTO A NEW SET OF POSTS											
		A	VD-062AS	72	16		BUSINESS SIGN				1	1															ONLY 2 EXISTING SIGNS											
		A	VD-062AS	72	16		BUSINESS SIGN				1	1																										
NB	3.102	A	VD-062B	72	16		BUSINESS SIGN				1	1				X	2	X									REINSTALL THE SIGNS ONTO A NEW SET OF POSTS											
SIGN SUMMARY SHEET							SHEET TOTALS	11.25	0.00	8	3	3	1	0	0	6		90																				
								SF	SF	EA	EA	EA	EA	EA	EA	EA	EA	EA	EA	EA	EA	EA	EA	EA	EA	EA	EA	EA	EA	EA	EA	EA	EA					
VERMONT AGENCY OF TRANSPORTATION							TOWN TOTALS	465.2	0.0	65.0	10.0	10.0	97	0.0	0.0	90		1350.0																				
																						PROJECT NAME:	Ludlow-Waitsfield VT100										PROJECT NUMBER:	STPG SIGN(27)				
											FILE NAME:	Warren.xls					PLOT DATE:	9/14/2009																				
											PROJECT MANAGER:	N. Avery					DRAWN BY:	I. Shea																				
											DESIGNED BY:	D. Crosslev					CHECKED BY:	J. Kelly																				
											WARREN SHEET 2						SHEET	156					OF	204														

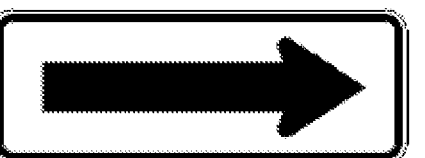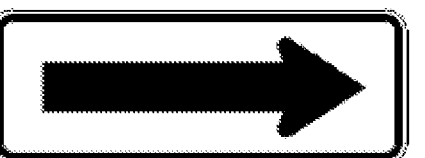

DIRECTION	MILEPOINT	LOCATION CODE (SHEET 2)	SIGN CODE	WIDTH (IN)	HEIGHT (IN)	SHEETING REMARKS	SIGN LEGEND	NEW SIGNS		EXISTING SIGNS				EXIST POST		NUMBER OF NEW POSTS	SQUARE STEEL (IN)			TUBULAR STEEL Ø (IN)				SIGN FRAME REQUIRED	REMARKS	SIGN DETAIL		
								"A"	"B"	RETAIN	SALVAGE FROM	SALVAGE TO	REMOVE	RETAIN	REMOVE		(LB / FT)			(LB / FT)						DETAIL IN SHS	DETAIL ON SHEET NUMBER	DETAIL ON STD SHEET NUMBER
																	1.75	2.00	2.50	3.00	3.50	4.00	5.00					
WARREN VT 100							FY-FLUORESCENT YELLOW FYG-FLUORESCENT YELLOW GREEN															"SHS"-STANDARD HIGHWAY SIGNS						
			C	M6-1	21	15							1															
			C	M3-1	24	12		2.00							2		X							INSTALL 4' BEHIND GUARD RAIL; GREEN ON WHITE SHEETING	X			
			C	M1-5	30	24		5.00																		E-136B		
			C	M6-1	21	15		2.19																GREEN ON WHITE SHEETING	X			
			C	M3-3	24	12		2.00																GREEN ON WHITE SHEETING	X			
			C	M1-5	30	24		5.00																			E-136B	
			C	M6-1	21	15		2.19																GREEN ON WHITE SHEETING	X			
NB	5.660		A	M3-1	24	12							1		X													
			A	M1-5	30	24							1															
			A	M3-1	24	12		2.00							1		X							GREEN ON WHITE SHEETING	X			
			A	M1-5	30	24		5.00																		E-136B		
NB	5.705		A	W1-2R	30	30	RIGHT CURVE						1		X													
			A	W13-1	18	18	35 MPH PLAQUE						1															
																												
NB	5.760		A	W1-2R	30	30		6.25							1		X							INSTALL 290 FT± NORTH OF ORIGINAL SIGN LOCATION	X			
			A	W13-1	24	24		4.00																		X		
SIGN SUMMARY SHEET							SHEET TOTALS		35.63	0.00	0	0	0	5	0	0	4	60										
VERMONT AGENCY OF TRANSPORTATION							SF	SF	EA	EA	EA	EA	EA	EA	EA	EA	EA	EA	FT									
							TOWN TOTALS		465.2	0.0	65.0	10.0	10.0	97	0.0	0.0	90	1350.0										
							PROJECT NAME: Ludlow-Waitsfield VT100															PROJECT NUMBER: STPG SIGN(27)						
							FILE NAME: Warren.xls															PLOT DATE: 9/14/2009						
							PROJECT MANAGER: N. Avery															DRAWN BY: I. Shea						
							DESIGNED BY: D. Crosslev															CHECKED BY: J. Kelly						
							WARREN SHEET 7															SHEET 161 OF 204						

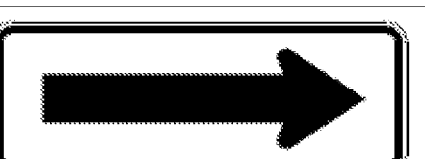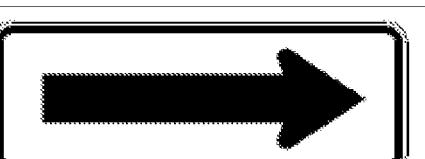DIRECTION	MILEPOINT	LOCATION CODE (SHEET 2)	SIGN CODE	WIDTH (IN)	HEIGHT (IN)	SHEETING REMARKS	SIGN LEGEND	NEW SIGNS		EXISTING SIGNS				EXIST POST		NUMBER OF NEW POSTS	SQUARE STEEL (IN)			TUBULAR STEEL Ø (IN)				SIGN FRAME REQUIRED	REMARKS	SIGN DETAIL					
								"A"	"B"	RETAIN	SALVAGE FROM	SALVAGE TO	REMOVE	RETAIN	REMOVE		1.75	2.00	2.50	3.00	3.50	4.00	5.00			DETAIL IN SHS	DETAIL ON SHEET NUMBER	DETAIL ON STD SHEET NUMBER			
																	(LB / FT)			(LB / FT)											
WARREN VT 100							FY-FLUORESCENT YELLOW FYG-FLUORESCENT YELLOW GREEN															"SHS"-STANDARD HIGHWAY SIGNS									
NB	5.942	C	VR-017	24	30																			AIRPORT RD TH-9							
		C	VR-017	24	30			5.00																REMOVE NEIGHBORHOOD WATCH SIGN; RETURN TO TOWN			E-141				
NB	5.950	D	R1-1	30	30																			AIRPORT RD TH-9							
		D	R1-1	30	30			6.25																	X						
NB	6.020	A	VW-205	36	36		WATCH FOR TURNING VEHICLES																								
NB	6.272	A	R2-1	24	30		SPEED LIMIT 50			1																					
SB	6.193	F	W11-1	30	30																										
		F	W16-1	18	18																										
		F	W11-1	30	30			6.25																	X						
		F	W16-1	18	24			3.00																	X						
SB	6.030	F	VD-062AL	72	16		BUSINESS SIGN			1	1													RE-INSTALL ON A NEW SET OF POSTS							
SB	6.000	F	W1-2L	30	30		LEFT CURVE																								
		F	W13-1	18	18		35 MPH PLAQUE																								
SB	5.962	F	W11-1	30	30		BICYCLE																								
SIGN SUMMARY SHEET							SHEET TOTALS	20.50	0.00	1	1	1	8	0	0	5	75							PROJECT NAME: Ludlow-Waitsfield VT100							
							SF	SF	EA	EA	EA	EA	EA	EA	EA	EA	EA	FT							PROJECT NUMBER: STPG SIGN(27)						
							TOWN TOTALS	465.2	0.0	65.0	10.0	10.0	97	0.0	0.0	90	1350.0								FILE NAME: Warren.xls						
VERMONT AGENCY OF TRANSPORTATION																									PROJECT MANAGER: N. Avery						
																									PLOT DATE: 9/14/2009						
																										DRAWN BY: I. Shea					
																										DESIGNED BY: D. Crossley					
																										CHECKED BY: J. Kelly					
																										WARREN SHEET 9					
																										SHEET 163 OF 204					


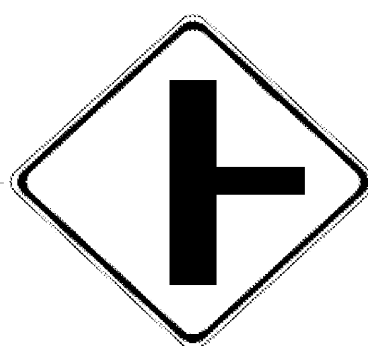



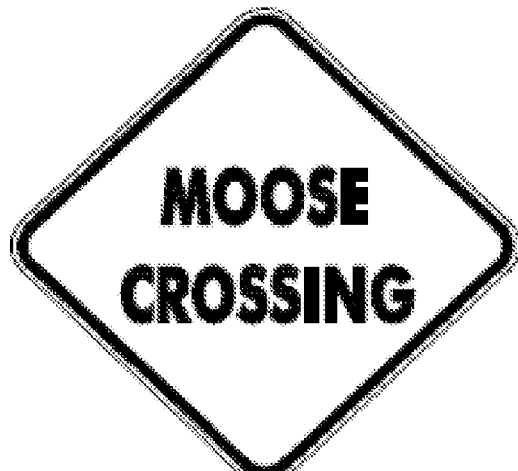

DIRECTION	MILEPOINT	LOCATION CODE (SHEET 2)	SIGN CODE	WIDTH (IN)	HEIGHT (IN)	SHEETING REMARKS	SIGN LEGEND	NEW SIGNS		EXISTING SIGNS				EXIST POST		NUMBER OF NEW POSTS	SQUARE STEEL (IN)			TUBULAR STEEL Ø (IN)				SIGN FRAME REQUIRED	REMARKS	SIGN DETAIL																								
								"A"	"B"	RETAIN	SALVAGE FROM	SALVAGE TO	REMOVE	RETAIN	REMOVE		1.75	2.00	2.50	FOUNDATION	3.00	3.50	4.00			5.00	DETAIL IN SHS	DETAIL ON SHEET NUMBER	DETAIL ON STD SHEET NUMBER																					
																	(LB / FT)				(LB / FT)																													
WARREN VT 100							FY-FLUORESCENT YELLOW FYG-FLUORESCENT YELLOW GREEN															"SHS"-STANDARD HIGHWAY SIGNS																												
		F	W16-1	18	18		SHARE THE ROAD 							1																																				
		F	W1-2L	30	30			6.25								1		X									X																							
		F	W13-1	24	24			4.00																			X																							
SB	5.930	F	OM-3R	12	36									1		X																																		
		F	OM-3R	12	36			3.00								1		X									X																							
SB	5.905	E	OM-3L	12	36									1		X																																		
		E	OM-3L	12	36			3.00								1		X									X																							
SB	5.867	F	W1-6	48	24									1		X																																		
		F	W1-6	48	24			8.00								1		X									X																							
SB	5.866	E	W1-6	48	24									1		X																																		
		E	W1-6	48	24			8.00								1		X									X																							
SB	5.831	F	W1-6	48	24									1		X																																		
		F	W1-6	48	24			8.00								1		X									X																							
SB	5.830	F	W1-6	48	24									1		X																																		
		F	W1-6	48	24			8.00								1		X									X																							
SIGN SUMMARY SHEET							SHEET TOTALS	48.25	0.00	0	0	0	7	0	0	7					105																													
							SF	SF	EA	EA	EA	EA	EA	EA	EA	EA	EA	EA	EA	EA	EA	EA	EA	EA	EA	EA	EA	EA	EA	EA	EA	EA	EA																	
VERMONT AGENCY OF TRANSPORTATION							TOWN TOTALS	465.2	0.0	65.0	10.0	10.0	97	0.0	0.0	90					1350.0																													
																					PROJECT NAME:	Ludlow-Waitsfield VT100										PROJECT NUMBER:					STPG SIGN(27)													
																					FILE NAME:	Warren.xls					PROJECT MANAGER:					N. Avery					PLOT DATE:					9/14/2009								
																					DESIGNED BY:					D. Crosslev					DRAWN BY:					I. Shea					CHECKED BY:					J. Kelly				
																					WARREN SHEET 10															SHEET					164 OF 204									

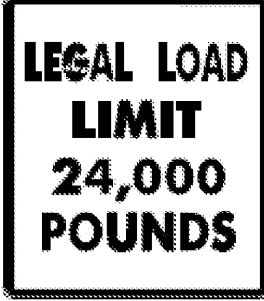

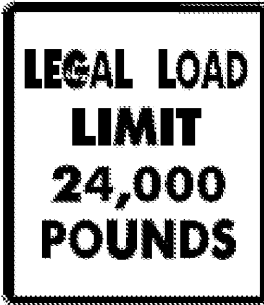


DIRECTION	MILEPOINT	LOCATION CODE (SHEET 2)	SIGN CODE	WIDTH (IN)	HEIGHT (IN)	SHEETING REMARKS	SIGN LEGEND	NEW SIGNS		EXISTING SIGNS				EXIST POST		NUMBER OF NEW POSTS	SQUARE STEEL (IN)			TUBULAR STEEL Ø (IN)				SIGN FRAME REQUIRED	REMARKS	SIGN DETAIL			
								"A"	"B"	RETAIN	SALVAGE FROM	SALVAGE TO	REMOVE	RETAIN	REMOVE		1.75	2.00	2.50	3.00	3.50	4.00	5.00			DETAIL IN SHS	DETAIL ON SHEET NUMBER	DETAIL ON STD SHEET NUMBER	
																	(LB / FT)			(LB / FT)									
WARREN VT 100							FY-FLUORESCENT YELLOW FYG-FLUORESCENT YELLOW GREEN															"SHS"-STANDARD HIGHWAY SIGNS							
SB	5.796	F	VD-062C	74.75	16		TRAVEL INFORMATION			1																			
		F	VD-062BC	74.75	16					1																			
SB	5.770	F	W2-2R	30	30																								
		F	W2-2MaR	30	30			6.25						1		X												6	
SB	5.741	F	VD-062BM	72	16		BUSINESS SIGN			1																			
		F	VD-062M	72	16		BUSINESS SIGN			1																			
		F	VD-062M	72	16		BUSINESS SIGN			1																			
SB	5.696	F	VD-062BM	72	16		BUSINESS SIGN			1																			
		F	VD-062M	72	16		BUSINESS SIGN			1																			
		F	VD-062M	72	16		BUSINESS SIGN			1																			
SB	5.658	F	D1-1A	72	10																								
		F	D1-1A	72	12			6.00						2		X												5	
SB	5.623	G	VR-017	24	30																								
		G	VR-017	24	30			5.00						1		X													
SB	5.617	H	R1-1	36	36																								
SIGN SUMMARY SHEET							SHEET TOTALS	17.25	0.00	8	0	0	4	0	0	4	60							PROJECT NAME: Ludlow-Waitsfield VT100					
								SF	SF	EA	EA	EA	EA	EA	EA	EA	FT							PROJECT NUMBER: STPG SIGN(27)					
VERMONT AGENCY OF TRANSPORTATION							TOWN TOTALS	465.2	0.0	65.0	10.0	10.0	97	0.0	0.0	90	1350.0							FILE NAME: Warren.xls	PLOT DATE: 9/14/2009				
																							PROJECT MANAGER: N. Avery	DRAWN BY: I. Shea					
																							DESIGNED BY: D. Crosslev	CHECKED BY: J. Kelly					
																							WARREN SHEET 11	SHEET 165 OF 204					

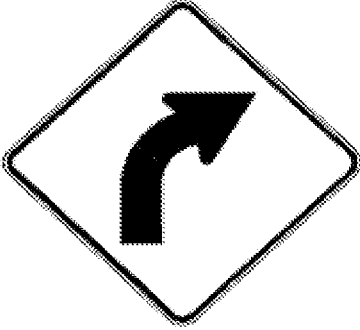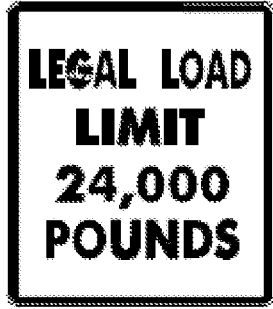DIRECTION	MILEPOINT	LOCATION CODE (SHEET 2)	SIGN CODE	WIDTH (IN)	HEIGHT (IN)	SHEETING REMARKS	SIGN LEGEND	NEW SIGNS		EXISTING SIGNS				EXIST POST		NUMBER OF NEW POSTS	SQUARE STEEL (IN)			TUBULAR STEEL Ø (IN)				SIGN FRAME REQUIRED	REMARKS	SIGN DETAIL			
								"A"	"B"	RETAIN	SALVAGE FROM	SALVAGE TO	REMOVE	RETAIN	REMOVE		1.75	2.00	2.50	3.00	3.50	4.00	5.00			DETAIL IN SHS	DETAIL ON SHEET NUMBER	DETAIL ON STD SHEET NUMBER	
																	(LB / FT)			(LB / FT)									
WARREN VT 100							FY-FLUORESCENT YELLOW FYG-FLUORESCENT YELLOW GREEN															"SHS"-STANDARD HIGHWAY SIGNS							
SB	4.480	F	VD-062AS	72	16		BUSINESS SIGN			1	1			X	2		X								REINSTALL THE SIGNS ONTO A NEW SET OF POSTS				
		F	VD-062AS	72	16		BUSINESS SIGN			1	1																		
		F	VD-062AS	72	16		BUSINESS SIGN			1	1																		
SB	4.423	G	VR-017	24	30									1	X										ELLEN RD TH- 46				
		G	VR-017	24	30			5.00							1		X											E-141	
SB	4.412	H	R1-1	30	30									1	X										ELLEN RD TH- 46				
		H	R1-1	30	30			6.25							1		X							X	REMOVE AND DISCARD INCORRECT MILE MARKER				
SB	4.380	F	VD-062B	72	16		BUSINESS SIGN			1				X															
		F	VD-062AL	72	16		BUSINESS SIGN			1																			
		F	VD-062AS	72	16		BUSINESS SIGN			1																			
SB	4.340	F	VD-062B	72	16		BUSINESS SIGN			1				X															
		F	VD-062AL	72	16		BUSINESS SIGN			1																			
		F	VD-062AS	72	16		BUSINESS SIGN			1																			
SB	4.300	F	W2-1M	36	36		MODIFIED CROSSROAD			1				X															
		F	W16-8A	48	15		<--- MAIN STREET WEST HILL RD --->			1																			
SIGN SUMMARY SHEET							SHEET TOTALS	11.25	0.00	8	3	3	2	0	0	4	60								PROJECT NAME: Ludlow-Waitsfield VT100				
								SF	SF	EA	EA	EA	EA	EA	EA	EA	FT								PROJECT NUMBER: STPG SIGN(27)				
VERMONT AGENCY OF TRANSPORTATION							TOWN TOTALS	465.2	0.0	65.0	10.0	10.0	97	0.0	0.0	90	1350.0								FILE NAME: Warren.xls	PLOT DATE: 9/14/2009			
																									PROJECT MANAGER: N. Avery	DRAWN BY: I. Shea			
																									DESIGNED BY: D. Crosslev	CHECKED BY: J. Kelly			
																									WARREN SHEET 13	SHEET 167 OF 204			



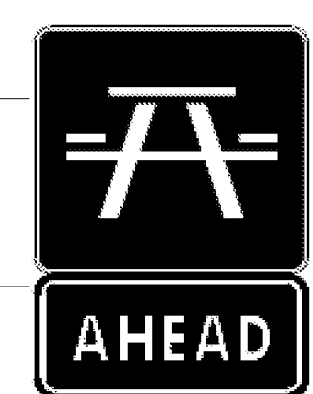



DIRECTION	MILEPOINT	LOCATION CODE (SHEET 2)	SIGN CODE	WIDTH (IN)	HEIGHT (IN)	SHEETING REMARKS	SIGN LEGEND	NEW SIGNS		EXISTING SIGNS				EXIST POST		NUMBER OF NEW POSTS	SQUARE STEEL (IN)			TUBULAR STEEL Ø (IN)				SIGN FRAME REQUIRED	REMARKS	SIGN DETAIL							
								"A"	"B"	RETAIN	SALVAGE FROM	SALVAGE TO	REMOVE	RETAIN	REMOVE		1.75	2.00	2.50	3.00	3.50	4.00	5.00			DETAIL IN SHS	DETAIL ON SHEET NUMBER	DETAIL ON STD SHEET NUMBER					
																	(LB / FT)			(LB / FT)													
WARREN VT 100							FY-FLUORESCENT YELLOW FYG-FLUORESCENT YELLOW GREEN																"SHS"-STANDARD HIGHWAY SIGNS										
SB	4.255	F	D1-1	72	12		<--- WARREN			1																							
		F	D1-1A	72	12		<--- ROXBURY 8			1																							
		F	D4-2	24	30		PARK AND RIDE			1																							
SB	4.210	F	D1-1	72	12		<--- WARREN						1																				
SB	4.190	G	VR-017	24	24		LEGAL LOAD LIMIT 24,000 POUNDS			1																							
SB	4.180	H	R1-1	30	30		STOP			1																							
SB	4.130	F	M3-3	24	12		SOUTH						1																				
			M1-5	30	24		VT 100						1																				
SB	4.124	G	VR-017	24	30								1																				
		G	VR-017	24	30			5.00						1					X													E-141	
SB	4.115	H	R1-1	30	30								1																				
		H	R1-1	30	30			6.25						1					X													X	
SB	3.789	F	VW-054R	30	30		HIDDEN DRIVE RIGHT						1																				
SB	3.588	F	VD-062AS	72	16		BUSINESS SIGN			1																							
		F	VD-062B	72	16		BUSINESS SIGN			1																							
SIGN SUMMARY SHEET							SHEET TOTALS	11.25	0.00	7	0	0	6	0	0	2	30							PROJECT NAME: Ludlow-Waitsfield VT100									
VERMONT AGENCY OF TRANSPORTATION								SF	SF	EA	EA	EA	EA	EA	EA	EA	FT							PROJECT NUMBER: STPG SIGN(27)									
							TOWN TOTALS	465.2	0.0	65.0	10.0	10.0	97	0.0	0.0	90	1350.0							FILE NAME: Warren.xls									
																							PLOT DATE: 9/14/2009										
																							DRAWN BY: I. Shea										
																							DESIGNED BY: D. Crosslev										
																							CHECKED BY: J. Kelly										
																							WARREN SHEET 14										
																							SHEET 168 OF 204										





DIRECTION	MILEPOINT	LOCATION CODE (SHEET 2)	SIGN CODE	WIDTH (IN)	HEIGHT (IN)	SHEETING REMARKS	SIGN LEGEND	NEW SIGNS		EXISTING SIGNS				EXIST POST		NUMBER OF NEW POSTS	SQUARE STEEL (IN)			TUBULAR STEEL Ø (IN)				SIGN FRAME REQUIRED	REMARKS	SIGN DETAIL		
								"A"	"B"	RETAIN	SALVAGE FROM	SALVAGE TO	REMOVE	RETAIN	REMOVE		1.75	2.00	2.50	3.00	3.50	4.00	5.00			DETAIL IN SHS	DETAIL ON SHEET NUMBER	DETAIL ON STD SHEET NUMBER
																	(LB / FT)			(LB / FT)								
WARREN VT 100							FY-FLUORESCENT YELLOW FYG-FLUORESCENT YELLOW GREEN															"SHS"-STANDARD HIGHWAY SIGNS						
SB	3.520	F	D1-1A	72	12			6.00						2	X								ASSEMBLY IS MISSING JUST IN FRONT OF MAILBOX #2849					
		F	D1-1A	72	12			6.00															ASSEMBLY IS MISSING	5				
SB	3.453	H	R1-1	30	30																		LINCOLN GAP RD TH-3					
		H	R1-1	30	30			6.25						1	X								LEFT-SIDE STOP SIGN FOR TH-3, BEHIND RAIL	X				
SB	3.442	G	VR-017	24	30																		LINCOLN GAP RD TH-3					
		G	VR-017	24	30			5.00						1	X											E-141		
SB	3.436	H	R1-1	30	30																		LINCOLN GAP RD TH-3					
		H	R1-1	36	36			9.00						2	X								RIGHT-SIDE STOP SIGN FOR TH-3	X				
SB	3.425	F	W2-1M	30	30		MODIFIED CROSSROAD			1																		
SB	3.355	G	VR-017	24	30																		BOBBIN MILL RD TH-43					
		G	VR-017	24	30			5.00						1	X											E-141		
SB	3.343	H	R1-1	30	30																		BOBBIN MILL RD TH-43					
		H	R1-1	30	30			6.25						1	X											X		
SIGN SUMMARY SHEET							SHEET TOTALS	43.50	0.00	1	0	0	5	0	0	8	120						PROJECT NAME: Ludlow-Waitsfield VT100					
VERMONT AGENCY OF TRANSPORTATION								SF	SF	EA	EA	EA	EA	EA	EA	EA	FT						PROJECT NUMBER: STPG SIGN(27)					
TOWN TOTALS							465.2	0.0	65.0	10.0	10.0	97	0.0	0.0	90	1350.0						FILE NAME: Warren.xls	PLOT DATE: 9/14/2009					
																					PROJECT MANAGER: N. Avery	DRAWN BY: I. Shea						
																					DESIGNED BY: D. Crosslev	CHECKED BY: J. Kelly						
																					WARREN SHEET 15	SHEET 169 OF 204						



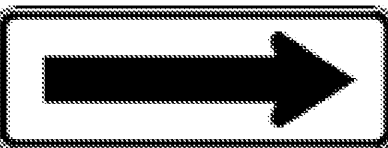

DIRECTION	MILEPOINT	LOCATION CODE (SHEET 2)	SIGN CODE	WIDTH (IN)	HEIGHT (IN)	SHEETING REMARKS	SIGN LEGEND	NEW SIGNS		EXISTING SIGNS				EXIST POST		NUMBER OF NEW POSTS	SQUARE STEEL (IN)			TUBULAR STEEL Ø (IN)				SIGN FRAME REQUIRED	REMARKS	SIGN DETAIL					
								"A"	"B"	RETAIN	SALVAGE FROM	SALVAGE TO	REMOVE	RETAIN	REMOVE		1.75	2.00	2.50	FOUNDATION	3.00	3.50	4.00			5.00	DETAIL IN SHS	DETAIL ON SHEET NUMBER	DETAIL ON STD SHEET NUMBER		
																	(LB / FT)				(LB / FT)										
WARREN VT 100							FY-FLUORESCENT YELLOW FYG-FLUORESCENT YELLOW GREEN															"SHS"-STANDARD HIGHWAY SIGNS									
		E	VR-072	24	30		ENCARE			1																					
SB	1.740	F	W1-2R	30	30		RIGHT CURVE					1		X																	
SB	1.620	F	W1-2R	30	30			6.25							1		X							X		INSTALL 635'+/- SOUTH OF ORIGINAL SIGN LOCATION					
SB	1.296	G	VR-017	24	24							1		X												STETSON HOLLOW RD TH-39					
		G	VR-017	24	30			5.00							1		X												E-141		
SB	1.288	H	R1-1	24	24							1		X												STETSON HOLLOW RD TH-39					
		H	R1-1	30	30			6.25							1		X							X							
SB	1.170	F	W1-2R	30	30		RIGHT CURVE					1		X																	
SB	1.115	F	W1-5 R	30	30							1		X																	
		F	W1-5 R	30	30	FY		6.25							1		X							X							
		F	W7-3A	24	18	FY		3.00																X							
SB	0.808	F	VW-000	30	30							1		X																	
		F	W7-3A	24	18							1																			
		F	VW-000	36	36	FY		9.00							2		X									RESET TO SPEC, NEW POSTS.			E-153		
		F	W7-3A	24	18	FY		3.00																X		INSTALL PLAQUE ON LEFT POST					
SIGN SUMMARY SHEET							SHEET TOTALS	38.75	0.00	1	0	0	7	0	0	6	90							PROJECT NAME: Ludlow-Waitsfield VT100				PROJECT NUMBER: STPG SIGN(27)			
								SF	SF	EA	EA	EA	EA	EA	EA	EA	EA	EA	EA	EA	EA	EA	EA	EA	EA	EA	FILE NAME: Warren.xls				PLOT DATE: 9/14/2009
VERMONT AGENCY OF TRANSPORTATION							TOWN TOTALS	465.2	0.0	65.0	10.0	10.0	97	0.0	0.0	90	1350.0							PROJECT MANAGER: N. Avery				DRAWN BY: I. Shea			
																						DESIGNED BY: D. Crosslev				CHECKED BY: J. Kelly					
																						WARREN SHEET 17				SHEET 171 OF 204					



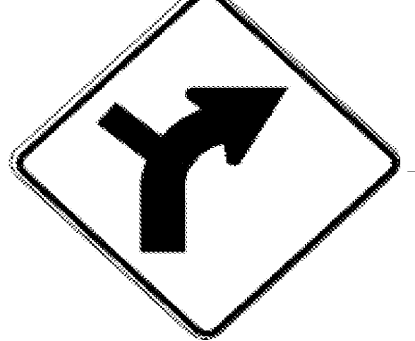


DIRECTION	MILEPOINT	LOCATION CODE (SHEET 2)	SIGN CODE	WIDTH (IN)	HEIGHT (IN)	SHEETING REMARKS	SIGN LEGEND	NEW SIGNS		EXISTING SIGNS				EXIST POST		NUMBER OF NEW POSTS	SQUARE STEEL (IN)			TUBULAR STEEL Ø (IN)				SIGN FRAME REQUIRED	REMARKS	SIGN DETAIL		
								"A"	"B"	RETAIN	SALVAGE FROM	SALVAGE TO	REMOVE	RETAIN	REMOVE		1.75	2.00	2.50	3.00	3.50	4.00	5.00			DETAIL IN SHS	DETAIL ON SHEET NUMBER	DETAIL ON STD SHEET NUMBER
																	(LB / FT)			(LB / FT)								
WARREN VT 100							FY-FLUORESCENT YELLOW FYG-FLUORESCENT YELLOW GREEN																"SHS"-STANDARD HIGHWAY SIGNS					
SB	0.670	F	OM-3R	12	36																							
		F	OM-3R	12	36																							X
SB	0.655	E	OM-3L	12	36																							
		E	OM-3L	12	36																							X
SB	0.475	F	D5-5A	24	24																							
		F	VD-058	24	8																							
		F	D5-5A	24	24																							X
		F	W16-9p	24	12																							X
SB	0.300	G	VR-023B	24	30																							
		G	VR-023B	24	30																							E-144
SB	0.190	G	VR-023B	24	36																							
		G	VR-023B	24	36																							E-144
SB	0.000	G	VD-024	60	7.5																							
		G	VD-025	60	7.5																							
		G	VD-024	72	10																							4
SIGN SUMMARY SHEET							SHEET TOTALS	27.00	0.00	0	0	0	8	0	0	5	75							PROJECT NAME: Ludlow-Waitsfield VT100				
VERMONT AGENCY OF TRANSPORTATION							TOWN TOTALS	465.2	0.0	65.0	10.0	10.0	97	0.0	0.0	90	1350.0							PROJECT NUMBER: STPG SIGN(27)				
								SF	SF	EA	EA	EA	EA	EA	EA	EA	FT							FILE NAME: Warren.xls	PLOT DATE: 9/14/2009			
																								PROJECT MANAGER: N. Avery	DRAWN BY: I. Shea			
																								DESIGNED BY: D. Crosslev	CHECKED BY: J. Kelly			
																								WARREN SHEET 18	SHEET 172 OF 204			


DIRECTION	MILEPOINT	LOCATION CODE (SHEET 2)	SIGN CODE	WIDTH (IN)	HEIGHT (IN)	SHEETING REMARKS	SIGN LEGEND	NEW SIGNS		EXISTING SIGNS				EXIST POST		NUMBER OF NEW POSTS	SQUARE STEEL (IN)			TUBULAR STEEL Ø (IN)				SIGN FRAME REQUIRED	REMARKS	SIGN DETAIL		
								"A"	"B"	RETAIN	SALVAGE FROM	SALVAGE TO	REMOVE	RETAIN	REMOVE		1.75	2.00	2.50	3.00	3.50	4.00	5.00			DETAIL IN SHS	DETAIL ON SHEET NUMBER	DETAIL ON STD SHEET NUMBER
																	(LB / FT)			(LB / FT)								
WAITSFIELD VT 100							FY-FLUORESCENT YELLOW FYG-FLUORESCENT YELLOW GREEN																"SHS"-STANDARD HIGHWAY SIGNS					
NB	0.000	C	VD-024	60	7.5																							
		C	VD-024	72	10			5.00																			4	
		C	VD-700	6	10			0.42																				E-138
		C	VD-700	6	10			0.42																				E-138
NB	0.300	A	VD-062AL	72	16		BUSINESS SIGN				1																	
		A	VD-062AL	72	16		BUSINESS SIGN				1																	
NB	0.379	A	VW-060	30	30																							
		A	VW-060	30	30			6.25																				7
NB	0.400	C	VR-017	24	30																							
		C	VR-017	24	30			5.00																				E-141
NB	0.408	D	R1-1	30	30																							
		D	R1-1	30	30			6.25																				X
NB	0.443	A	W1-4R	30	30		REVERSE CURVE RIGHT																					
NB	0.490	A	W1-4R	30	30																							
								6.25																				X
NB	0.510	A	W11-3	30	30		DEER CROSSING																				X	
SIGN SUMMARY SHEET							SHEET TOTALS	29.59	0.00	2	0	0	6	0	0	6	90							PROJECT NAME: Ludlow-Waitsfield VT100				
								SF	SF	EA	EA	EA	EA	EA	EA	EA	FT								PROJECT NUMBER: STPG SIGN(27)			
							VERMONT AGENCY OF TRANSPORTATION							TOWN TOTALS	684.6	0.0	99.0	18.0	18.0	141	0.0	0.0	129	1935.0				FILE NAME: Waitsfield.xls
																				DESIGNED BY: M. Miller	CHECKED BY: N. Avery							
																				PROJECT MANAGER: N. Avery	DRAWN BY: I. Shea							
																				WAITSFIELD SHEET 1	SHEET 174 OF 204							




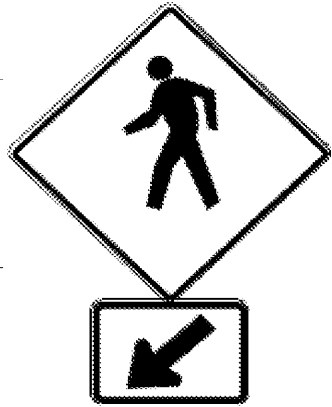
DIRECTION	MILEPOINT	LOCATION CODE (SHEET 2)	SIGN CODE	WIDTH (IN)	HEIGHT (IN)	SHEETING REMARKS	SIGN LEGEND	NEW SIGNS		EXISTING SIGNS				EXIST POST		NUMBER OF NEW POSTS	SQUARE STEEL (IN)			TUBULAR STEEL Ø (IN)				SIGN FRAME REQUIRED	REMARKS	SIGN DETAIL		
								"A"	"B"	RETAIN	SALVAGE FROM	SALVAGE TO	REMOVE	RETAIN	REMOVE		1.75	2.00	2.50	3.00	3.50	4.00	5.00			DETAIL IN SHS	DETAIL ON SHEET NUMBER	DETAIL ON STD SHEET NUMBER
																	(LB / FT)			(LB / FT)								
WAITSFIELD VT 100							FY-FLUORESCENT YELLOW FYG-FLUORESCENT YELLOW GREEN															"SHS"-STANDARD HIGHWAY SIGNS						
NB	0.653	C	VR-017	24	30																							
		C	VR-017	24	30			5.00																		E-141		
NB	0.661	D	R1-1	30	30																							
		D	R1-1	30	30			6.25															X					
NB	0.680	A	VW-054	30	30		HIDDEN DRIVE RIGHT 																					
NB	0.706	A	VW-054R	30	30			6.25																		E-154		
NB	0.717	A	W1-2L	30	30		CURVE LEFT																					
NB	0.940	A	VD-062B	72	16		BUSINESS SIGN			1																		
		A	VD-062AS	72	16		BUSINESS SIGN			1																		
NB	1.540	A	W1-6	48	24																							
		A	W1-6	48	24			8.00															X			FACES NB TRAFFIC; ON ITS OWN SET OF POSTS		
NB	1.541	B	W1-6	48	24																							
		B	W1-6	48	24			8.00															X			FACES SB TRAFFIC; ON ITS OWN SET OF POSTS		
NB	1.733	A	R2-5A	24	30		REDUCED SPEED AHEAD 																					
NB	1.759	A	W3-5	36	36			9.00																		INSTALL 140 FT± NORTH OF THE JUST-REMOVED SIGN		
SIGN SUMMARY SHEET							SHEET TOTALS	42.50	0.00	2	0	0	7	0	0	9	135						PROJECT NAME: Ludlow-Waitsfield VT100					
								SF	SF	EA	EA	EA	EA	EA	EA	EA	FT						PROJECT NUMBER: STPG SIGN(27)					
VERMONT AGENCY OF TRANSPORTATION							TOWN TOTALS	684.6	0.0	99.0	18.0	18.0	141	0.0	0.0	129	1935.0						FILE NAME: Waitsfield.xls	PLOT DATE: 9/15/2009				
																						PROJECT MANAGER: N. Avery	DRAWN BY: I. Shea					
																						DESIGNED BY: M. Miller	CHECKED BY: N. Avery					
																						WAITSFIELD SHEET 2	SHEET 175 OF 204					

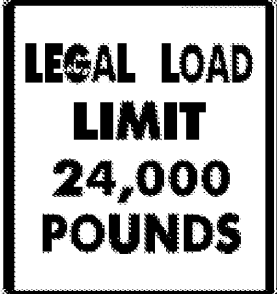




DIRECTION	MILEPOINT	LOCATION CODE (SHEET 2)	SIGN CODE	WIDTH (IN)	HEIGHT (IN)	SHEETING REMARKS	SIGN LEGEND	NEW SIGNS		EXISTING SIGNS				EXIST POST		NUMBER OF NEW POSTS	SQUARE STEEL (IN)			TUBULAR STEEL Ø (IN)				SIGN FRAME REQUIRED	REMARKS	SIGN DETAIL		
								"A"	"B"	RETAIN	SALVAGE FROM	SALVAGE TO	REMOVE	RETAIN	REMOVE		1.75	2.00	2.50	3.00	3.50	4.00	5.00			DETAIL IN SHS	DETAIL ON SHEET NUMBER	DETAIL ON STD SHEET NUMBER
																	(LB / FT)			(LB / FT)								
																1.88	2.42	3.35	FOUNDATION	7.60	9.00	10.80	14.60					
WAITSFIELD VT 100							FY-FLUORESCENT YELLOW FYG-FLUORESCENT YELLOW GREEN																"SHS"-STANDARD HIGHWAY SIGNS					
NB	1.860	A	R2-1	24	30																							
		A	R2-1	30	36			7.50																		6		
NB	1.903	A	W11-1	30	30																							
		A	W16-1	18	18																							
		A	W11-1	30	30			6.25																		X		
		A	W16-1	18	24			3.00																		X		
NB	1.925	A	OM-3R	12	36																							
		A	OM-3R	12	36			3.00																		X		
NB	1.960	B	OM-3L	12	36																							
		B	OM-3L	12	36			3.00																		X		
NB	2.020	A	VD-062AS	72	16		BUSINESS SIGN																					
		A	VD-062AS	72	16		BUSINESS SIGN																					
		A	VD-062AL	72	16		BUSINESS SIGN																					
NB	2.062	A	VD-062B	72	16		BUSINESS SIGN																					
		A	VD-062B	72	16		BUSINESS SIGN																					
SIGN SUMMARY SHEET								SHEET TOTALS		22.75	0.00	2	3	3	5	0	0	6	90					PROJECT NAME: Ludlow-Waitsfield VT100				
								SF	SF	EA	EA	EA	EA	EA	EA	EA	EA	EA	FT					PROJECT NUMBER: STPG SIGN(27)				
VERMONT AGENCY OF TRANSPORTATION								TOWN TOTALS		684.6	0.0	99.0	18.0	18.0	141	0.0	0.0	129	1935.0					FILE NAME: Waitsfield.xls				
																								PLOT DATE: 9/15/2009				
																								DRAWN BY: I. Shea				
																								DESIGNED BY: M. Miller				
																								CHECKED BY: N. Avery				
																								SHEET 176 OF 204				



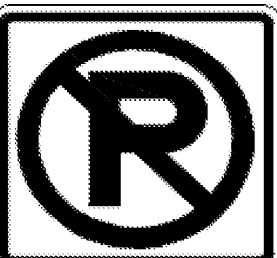
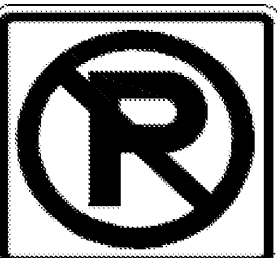

DIRECTION	MILEPOINT	LOCATION CODE (SHEET 2)	SIGN CODE	WIDTH (IN)	HEIGHT (IN)	SHEETING REMARKS	SIGN LEGEND	NEW SIGNS		EXISTING SIGNS				EXIST POST		NUMBER OF NEW POSTS	SQUARE STEEL (IN)			TUBULAR STEEL Ø (IN)				SIGN FRAME REQUIRED	REMARKS	SIGN DETAIL		
								"A"	"B"	RETAIN	SALVAGE FROM	SALVAGE TO	REMOVE	RETAIN	REMOVE		1.75	2.00	2.50	3.00	3.50	4.00	5.00			DETAIL IN SHS	DETAIL ON SHEET NUMBER	DETAIL ON STD SHEET NUMBER
																	(LB / FT)			(LB / FT)								
WAITSFIELD VT 100							FY-FLUORESCENT YELLOW FYG-FLUORESCENT YELLOW GREEN															"SHS"-STANDARD HIGHWAY SIGNS						
NB	2.110	A	R2-1	24	30																							
		A	R2-1	24	30			5.00																	X			
NB	2.206	A	VD-018	30	18		IRASVILLE  WAITSFIELD 1																					
NB	2.255	A	VD-018	30	18			3.75																		E-128B		
NB	2.285	A	VD-062C	74.75	16		TRAVEL INFO				1	1																
		A	VD-062BC	74.75	16		TRAVEL INFO				1	1																
NB	2.333	A	W3-5	36	36			9.00																	X			
NB	2.336	A	R2-5A	24	30		REDUCED SPEED AHEAD																					
NB	2.398	A	M2-1	21	15			2.19																	X			
		A	M1-5	24	24			4.00																		E-136B		
NB	2.422	A	M2-1	21	15		JCT																					
		A	M1-5	24	24		VERMONT 17																					
NB	2.431	C	VR-017	24	24																							
SIGN SUMMARY SHEET							SHEET TOTALS	23.94	0.00	0	2	2	6	0	0	7	105							PROJECT NAME: Ludlow-Waitsfield VT100				
								SF	SF	EA	EA	EA	EA	EA	EA	EA	FT							PROJECT NUMBER: STPG SIGN(27)				
VERMONT AGENCY OF TRANSPORTATION							TOWN TOTALS	684.6	0.0	99.0	18.0	18.0	141	0.0	0.0	129	1935.0							FILE NAME: Waitsfield.xls				
																								PLOT DATE: 9/15/2009				
																								DRAWN BY: I. Shea				
																								CHECKED BY: N. Avery				
																								SHEET 177 OF 204				


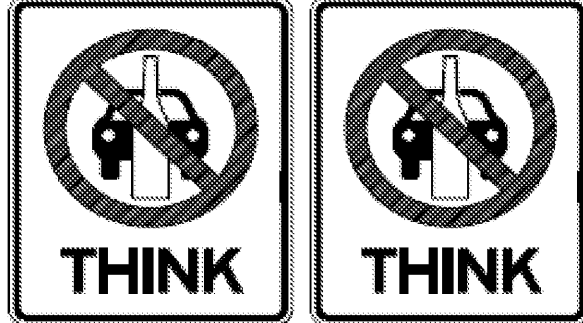

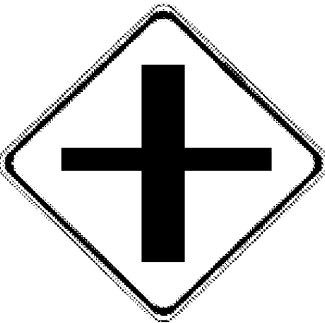
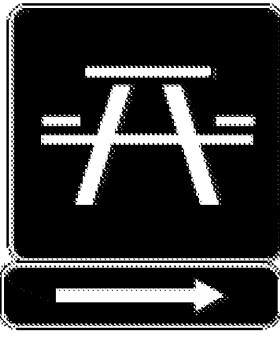
DIRECTION	MILEPOINT	LOCATION CODE (SHEET 2)	SIGN CODE	WIDTH (IN)	HEIGHT (IN)	SHEETING REMARKS	SIGN LEGEND	NEW SIGNS		EXISTING SIGNS				EXIST POST		NUMBER OF NEW POSTS	SQUARE STEEL (IN)			TUBULAR STEEL Ø (IN)				SIGN FRAME REQUIRED	REMARKS	SIGN DETAIL													
								"A"	"B"	RETAIN	SALVAGE FROM	SALVAGE TO	REMOVE	RETAIN	REMOVE		(LB / FT)			(LB / FT)						DETAIL IN SHS	DETAIL ON SHEET NUMBER	DETAIL ON STD SHEET NUMBER											
																	1.75	2.00	2.50	3.00	3.50	4.00	5.00																
WAITSFIELD VT 100							FY-FLUORESCENT YELLOW FYG-FLUORESCENT YELLOW GREEN																"SHS"-STANDARD HIGHWAY SIGNS																
			C VR-017	24	30			5.00								1		X									E-141												
NB	2.441		D R1-1	24	24																																		
			D R1-1	30	30			6.25								1		X							X														
NB	2.468		A W1-10R	30	30		MODIFIED RIGHT CURVE 																																
			A W1-10R	36	36	FY		9.00								2		X						X															
			A W16-8a	24	8	FY		1.33																			8												
NB	2.497		A R2-1	24	30		SPEED LIMIT 30 																																
			A R2-1	30	36			7.50								1		X									6												
NB	2.550		A D1-1A	72	12		WAITSFIELD 1 ---> (45 DEG)				1																												
			A D1-1A	72	12		WATERBURY 13 ---> (45 DEG)				1																												
			A D1-1S	72	12		<--- (45 DEG) MT ELLEN				1																												
			A D1-1S	72	12		<--- (45 DEG) MAD RIVER GLEN				1																												
NB	2.575		A M3-4	24	12																																		
			A M1-5	24	24																																		
			A M6-2L	21	15																																		
SIGN SUMMARY SHEET							SHEET TOTALS		29.08	0.00	4	0	0	6	0	0	5	75																					
							SF	SF	EA	EA	EA	EA	EA	EA	EA	EA	EA	EA	EA	EA	EA	EA	EA	EA	EA	EA	EA	EA	EA										
VERMONT AGENCY OF TRANSPORTATION							TOWN TOTALS		684.6	0.0	99.0	18.0	18.0	141	0.0	0.0	129	1935.0																					
																			PROJECT NAME:	Ludlow-Waitsfield VT100																			
																			PROJECT NUMBER:	STPG SIGN(27)																			
																			FILE NAME:	Waitsfield.xls						PLOT DATE:	9/15/2009												
																			PROJECT MANAGER:	N. Avery						DRAWN BY:	I. Shea												
																			DESIGNED BY:	M. Miller						CHECKED BY:	N. Avery												
																			WAITSFIELD SHEET 5							SHEET	178						OF	204					

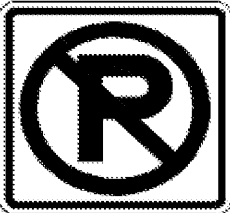


DIRECTION	MILEPOINT	LOCATION CODE (SHEET 2)	SIGN CODE	WIDTH (IN)	HEIGHT (IN)	SHEETING REMARKS	SIGN LEGEND	NEW SIGNS		EXISTING SIGNS				EXIST POST		NUMBER OF NEW POSTS	SQUARE STEEL (IN)			TUBULAR STEEL Ø (IN)				SIGN FRAME REQUIRED	REMARKS	SIGN DETAIL										
								"A"	"B"	RETAIN	SALVAGE FROM	SALVAGE TO	REMOVE	RETAIN	REMOVE		(LB / FT)			(LB / FT)						DETAIL IN SHS	DETAIL ON SHEET NUMBER	DETAIL ON STD SHEET NUMBER								
																	1.75	2.00	2.50	3.00	3.50	4.00	5.00													
WAITSFIELD VT 100							FY-FLUORESCENT YELLOW FYG-FLUORESCENT YELLOW GREEN																"SHS"-STANDARD HIGHWAY SIGNS													
NB	3.120	A	VD-062C	74.75	16		TRAVEL INFO LOGOS			1																										
		A	VD-062BC	74.75	16		TRAVEL INFO SIGN			1																										
NB	3.165	A	W11-2	30	30	FYG	PEDESTRIAN SYMBOL			1																										
		A	W11-2PB	24	18	FYG	BLIND PERSON (PLAQUE)			1																										
		A	W16-7	24	12	FYG	(45 DEG) DOWN ARROW LEFT			1																										
NB	3.200	A	R2-1	24	30			5.00							1		X															INSTALL 185 FT± NORTH OF THE PEDESTRIAN SIGNS	X			
NB	3.295	A	R2-1	24	30		SPEED LIMIT 30										1		X																	
NB	3.319	A	VD-062B	72	16		BUSINESS SIGN			1																										
		A	VD-062B	72	16		BUSINESS SIGN			1																										
		A	VD-062B	72	16		BUSINESS SIGN			1																										
NB	3.440	A	VD-062B	72	16		BUSINESS SIGN			1																										
		A	VD-062AL	72	16		BUSINESS SIGN			1																										
		A	VD-062AL	72	16		BUSINESS SIGN			1																										
NB	3.555	A	W11-2	30	30	FYG	PEDESTRIAN SYMBOL			1																										
		A	W16-9	24	10	FYG	AHEAD (PLAQUE)			1																										
SIGN SUMMARY SHEET							SHEET TOTALS		5.00	0.00	13	0	0	1	0	0	1	15																	PROJECT NAME: Ludlow-Waitsfield VT100	
									SF	SF	EA	EA	EA	EA	EA	EA	EA	FT																PROJECT NUMBER: STPG SIGN(27)		
VERMONT AGENCY OF TRANSPORTATION							TOWN TOTALS		684.6	0.0	99.0	18.0	18.0	141	0.0	0.0	129	1935.0																	FILE NAME: Waitsfield.xls	
																																		PLOT DATE: 9/15/2009		
																																			DRAWN BY: I. Shea	
																																			CHECKED BY: N. Avery	
																																				SHEET 181 OF 204

DIRECTION	MILEPOINT	LOCATION CODE (SHEET 2)	SIGN CODE	WIDTH (IN)	HEIGHT (IN)	SHEETING REMARKS	SIGN LEGEND	NEW SIGNS		EXISTING SIGNS				EXIST POST		NUMBER OF NEW POSTS	SQUARE STEEL (IN)			TUBULAR STEEL Ø (IN)				SIGN FRAME REQUIRED	REMARKS	SIGN DETAIL		
								"A"	"B"	RETAIN	SALVAGE FROM	SALVAGE TO	REMOVE	RETAIN	REMOVE		1.75	2.00	2.50	3.00	3.50	4.00	5.00			DETAIL IN SHS	DETAIL ON SHEET NUMBER	DETAIL ON STD SHEET NUMBER
																	(LB / FT)			(LB / FT)								
WAITSFIELD VT 100							FY-FLUORESCENT YELLOW FYG-FLUORESCENT YELLOW GREEN																"SHS"-STANDARD HIGHWAY SIGNS					
NB	3.580	A	R2-1	24	30																							
		A	R2-1	24	30			5.00							1		X								X			
NB	3.655	C	VR-017	24	30		POSTED BRIDGE AHEAD (TOWN) 																					
		C	n/a	24	30			5.00		1					1		X										E-141	
		C	VR-017	24	30																							
		C	n/a	24	30		POSTED BRIDGE AHEAD(TOWN)				1																	
NB	3.664	D	R1-1	30	30		STOP			1						X												
NB	3.666	A	W11-2	30	30	FYG	PEDESTRIAN SYMBOL																					
		A	W16-7	24	12	FYG	DIAGONAL ARROW																					
		A	R8-3A	24	24																							
		A	VR-644P	24	12			4.00							1		X								X			
		A	VR-644P	24	12		BEGIN (PLAQUE)																					
		A	VR-644P	24	12																							
NB	3.670	A	R8-3A	24	24			NO PARKING SYMBOL																				
		A	VR-644P	24	12		BEGIN (PLAQUE)																					
		A	W11-2	30	30	FYG																						
		A	W16-7	24	12	FYG																						
SIGN SUMMARY SHEET							SHEET TOTALS	24.25	0.00	1	1	1	6	0	0	4	60								PROJECT NAME: Ludlow-Waitsfield VT100			
								SF	SF	EA	EA	EA	EA	EA	EA	EA	FT								PROJECT NUMBER: STPG SIGN(27)			
							TOWN TOTALS	684.6	0.0	99.0	18.0	18.0	141	0.0	0.0	129	1935.0								FILE NAME: Waitsfield.xls			
																									PLOT DATE: 9/15/2009			
																									DRAWN BY: I. Shea			
																									DESIGNED BY: M. Miller			
																									CHECKED BY: N. Avery			
																									SHEET 182 OF 204			

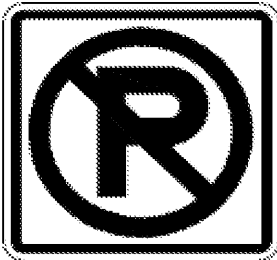DIRECTION	MILEPOINT	LOCATION CODE (SHEET 2)	SIGN CODE	WIDTH (IN)	HEIGHT (IN)	SHEETING REMARKS	SIGN LEGEND	NEW SIGNS		EXISTING SIGNS				EXIST POST		NUMBER OF NEW POSTS	SQUARE STEEL (IN)			TUBULAR STEEL Ø (IN)				SIGN FRAME REQUIRED	REMARKS	SIGN DETAIL		
								"A"	"B"	RETAIN	SALVAGE FROM	SALVAGE TO	REMOVE	RETAIN	REMOVE		1.75	2.00	2.50	3.00	3.50	4.00	5.00			DETAIL IN SHS	DETAIL ON SHEET NUMBER	DETAIL ON STD SHEET NUMBER
																	(LB / FT)			(LB / FT)								
WAITSFIELD VT 100							FY-FLUORESCENT YELLOW FYG-FLUORESCENT YELLOW GREEN															"SHS"-STANDARD HIGHWAY SIGNS						
NB	3.684	A	R8-3A	24	24																							
		A	M4-6P	24	12																							
		A	R8-3A	24	24																							
		A	M4-6P	24	12																							
NB	3.688	C	R7-2	24	36		NO PARKING SYMBOL w/ DATES & TIMES																					
																												
NB	3.712	A	R2-1	24	30																							
		A	R2-1	24	30		SPEED LIMIT 30																					
NB	3.760	C	R7-2	24	36		NO PARKING SYMBOL w/ DATES & TIMES																					
NB	3.800	A	VW-544	30	30																							
		A	W16-4	24	18																							
		A	VW-544	30	30																							
		A	W16-2A	24	12																							
NB	3.845	A	R8-3A	24	24		NO PARKING SYMBOL																					
		A	VR-644P	24	12		BEGIN PLAQUE																					
NB	3.890	A	R8-3A	24	24		NO PARKING SYMBOL																					
SIGN SUMMARY SHEET							SHEET TOTALS		22.25	0.00	5	0	0	5	0	0	3	45										
VERMONT AGENCY OF TRANSPORTATION							SF	SF	EA	EA	EA	EA	EA	EA	EA	EA	EA	EA	EA									
TOWN TOTALS							684.6	0.0	99.0	18.0	18.0	141	0.0	0.0	129	1935.0												
							PROJECT NAME: Ludlow-Waitsfield VT100										PROJECT NUMBER: STPG SIGN(27)											
							FILE NAME: Waitsfield.xls										PLOT DATE: 9/15/2009											
							PROJECT MANAGER: N. Avery										DRAWN BY: I. Shea											
							DESIGNED BY: M. Miller										CHECKED BY: N. Avery											
							WAITSFIELD SHEET 10										SHEET 183 OF 204											


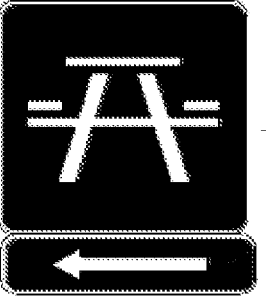
DIRECTION	MILEPOINT	LOCATION CODE (SHEET 2)	SIGN CODE	WIDTH (IN)	HEIGHT (IN)	SHEETING REMARKS	SIGN LEGEND	NEW SIGNS		EXISTING SIGNS				EXIST POST		NUMBER OF NEW POSTS	SQUARE STEEL (IN)			TUBULAR STEEL Ø (IN)				SIGN FRAME REQUIRED	REMARKS	SIGN DETAIL		
								"A"	"B"	RETAIN	SALVAGE FROM	SALVAGE TO	REMOVE	RETAIN	REMOVE		1.75	2.00	2.50	3.00	3.50	4.00	5.00			DETAIL IN SHS	DETAIL ON SHEET NUMBER	DETAIL ON STD SHEET NUMBER
																	(LB / FT)			(LB / FT)								
WAITSFIELD VT 100							FY-FLUORESCENT YELLOW FYG-FLUORESCENT YELLOW GREEN																"SHS"-STANDARD HIGHWAY SIGNS					
NB	3.916	A	R8-3A	24	24																							
		A	R8-3A	24	24			4.00																			X	
NB	3.940	A	R8-3A	24	24																							
		A	R8-3A	24	24			4.00																			X	
NB	3.958	A	S1-1	36	36	FYG	PENTAGONAL SCHOOL SYMBOL			1																		
		A	W16-9	36	20	FYG	AHEAD PLAQUE			1																		
NB	3.975	A	R8-3A	24	24																							
		A	M4-6	24	12																							
		A	R8-3A	24	24			4.00																			X	
		A	M4-6	24	12			2.00																			X	
NB	4.015	A	n/a	18	18					1																		
		B	n/a	18	18					1																		
		A	n/a	18	18		EXIT ONLY (TOWN SIGN)																					
		B	n/a	18	18		EXIT ONLY (ON BACK)																					
NB	4.051	A	VW-092	30	30		UNSAFE TO PASS																					
SIGN SUMMARY SHEET							SHEET TOTALS		14.00	0.00	2	2	2	5	0	0	4	60						PROJECT NAME: Ludlow-Waitsfield VT100				
							SF	SF	EA	EA	EA	EA	EA	EA	EA	EA	EA	FT						PROJECT NUMBER: STPG SIGN(27)				
VERMONT AGENCY OF TRANSPORTATION							TOWN TOTALS		684.6	0.0	99.0	18.0	18.0	141	0.0	0.0	129	1935.0						FILE NAME: Waitsfield.xls				
																								PLOT DATE: 9/15/2009				
																								DRAWN BY: I. Shea				
																								DESIGNED BY: M. Miller				
																								CHECKED BY: N. Avery				
																								SHEET 184 OF 204				





DIRECTION	MILEPOINT	LOCATION CODE (SHEET 2)	SIGN CODE	WIDTH (IN)	HEIGHT (IN)	SHEETING REMARKS	SIGN LEGEND	NEW SIGNS		EXISTING SIGNS				EXIST POST		NUMBER OF NEW POSTS	SQUARE STEEL (IN)			TUBULAR STEEL Ø (IN)				SIGN FRAME REQUIRED	REMARKS	SIGN DETAIL		
								"A"	"B"	RETAIN	SALVAGE FROM	SALVAGE TO	REMOVE	RETAIN	REMOVE		1.75	2.00	2.50	3.00	3.50	4.00	5.00			DETAIL IN SHS	DETAIL ON SHEET NUMBER	DETAIL ON STD SHEET NUMBER
																	(LB / FT)			(LB / FT)								
WAITSFIELD VT 100							FY-FLUORESCENT YELLOW FYG-FLUORESCENT YELLOW GREEN																"SHS"-STANDARD HIGHWAY SIGNS					
NB	4.170	A	R2-1	24	30																							
		A	R2-1	24	30			5.00																				X
NB	4.188	A	VR-072	24	30																							
		B	VR-072	24	30																							
		A	VR-072	24	30			5.00																				5
		B	VR-072	24	30			5.00																				5
NB	4.370	A	R2-1	24	30																							
		A	R2-1	24	30			5.00																				X
NB	4.532	A	OM-3R	12	36		OBJECT MARKER RIGHT			1																		
		B	OM-3L	12	36		OBJECT MARKER LEFT			1																		
NB	4.793	A	W11-6H	30	30		SNOWMOBILE SYMBOL (HINGED SIGN) 																					
NB	4.843	A	W2-1Mb	30	30			6.25																			6	
NB	4.876	A	VD-062B	72	16		BUSINESS SIGN			1																		
NB	4.900	A	D5-5A	24	24			4.00																				X
		A	D5-5A	24	6			1.00																				X
SIGN SUMMARY SHEET							SHEET TOTALS	31.25	0.00	3	0	0	5	0	0	5	75											
VERMONT AGENCY OF TRANSPORTATION							TOWN TOTALS	684.6	0.0	99.0	18.0	18.0	141	0.0	0.0	129	1935.0											
PROJECT NAME: Ludlow-Waitsfield VT100																					PROJECT NUMBER: STPG SIGN(27)							
FILE NAME: Waitsfield.xls												PLOT DATE: 9/15/2009																
PROJECT MANAGER: N. Avery												DRAWN BY: I. Shea																
DESIGNED BY: M. Miller												CHECKED BY: N. Avery																
WAITSFIELD SHEET 12																					SHEET 185 OF 204							






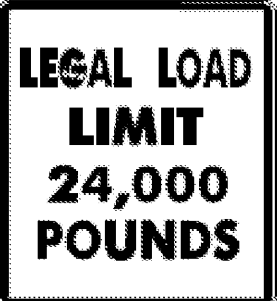

DIRECTION	MILEPOINT	LOCATION CODE (SHEET 2)	SIGN CODE	WIDTH (IN)	HEIGHT (IN)	SHEETING REMARKS	SIGN LEGEND	NEW SIGNS		EXISTING SIGNS				EXIST POST		NUMBER OF NEW POSTS	SQUARE STEEL (IN)			TUBULAR STEEL Ø (IN)				SIGN FRAME REQUIRED	REMARKS	SIGN DETAIL			
								"A"	"B"	RETAIN	SALVAGE FROM	SALVAGE TO	REMOVE	RETAIN	REMOVE		1.75	2.00	2.50	FOUNDATION	3.00	3.50	4.00			5.00	DETAIL IN SHS	DETAIL ON SHEET NUMBER	DETAIL ON STD SHEET NUMBER
																	(LB / FT)				(LB / FT)								
WAITSFIELD VT 100							FY-FLUORESCENT YELLOW FYG-FLUORESCENT YELLOW GREEN															"SHS"-STANDARD HIGHWAY SIGNS							
NB	7.055	A	M3-1	24	12			2.00							1		X						GREEN ON WHITE SHEETING; INSTALL 240 FT± NORTH OF NORTH FAYSTON RD	X					
		A	M1-5	30	24			5.00																	E-136B				
NB	7.410	A	W11-6H	30	30		SNOWMOBILE SYMBOL (HINGED)										1												
SB	7.235	F	W11-4	30	30		CATTLE SYMBOL (INSTALLED UNDER DUAL BEACONS)				1																		
		F	W11-1	24	18		CATTLE CROSSING (PLAQUE)				1																		
SB	7.095	F	VD-062AL	72	16		BUSINESS SIGN				1																		
SB	7.050	F	D1-1A	72	12			6.00							2		X				RESET TO SPEC, NEW POST.		INSTALL 235 FT± SOUTH OF THE BUSINESS SIGN; MAINTAIN 10 FT MIN TO UTILITY POLE		5				
SB	7.017	F	D1-1A	72	10		NORTH FAYSTON 3 --->						1																
SB	7.012	G	VR-017	24	30		LEGAL LOAD LIMIT 24,000 POUNDS				1												NORTH FAYSTON RD (TH-2)						
SB	7.004	H	R1-1	30	30		STOP				1												NORTH FAYSTON RD (TH-2)						
SB	6.965	F	M3-3	24	12								1																
		F	M1-5	24	24								1																
		F	M3-3	24	12			2.00							1		X				RESET TO SPEC, NEW POST.		GREEN ON WHITE SHEETING; INSTALL 200 FT± SOUTH OF TH-2; MAINTAIN 10 FT MIN TO UTILITY POLE	X					
		F	M1-5	30	24			5.00																	E-136B				
SB	6.743	F	VD-062B	72	16		BUSINESS SIGN				1																		
SIGN SUMMARY SHEET							SHEET TOTALS	20.00	0.00	6	0	0	4	0	0	4	60								PROJECT NAME: Ludlow-Waitsfield VT100				
								SF	SF	EA	EA	EA	EA	EA	EA	EA	EA	EA	EA	EA	EA	EA	EA	EA	EA	EA	EA	PROJECT NUMBER: STPG SIGN(27)	
VERMONT AGENCY OF TRANSPORTATION							TOWN TOTALS	684.6	0.0	99.0	18.0	18.0	141	0.0	0.0	129	1935.0						FILE NAME: Waitsfield.xls	PLOT DATE: 9/15/2009					
																						PROJECT MANAGER: N. Avery	DRAWN BY: I. Shea						
																						DESIGNED BY: M. Miller	CHECKED BY: N. Avery						
																						WAITSFIELD SHEET 15	SHEET 188 OF 204						

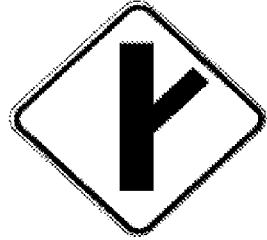



DIRECTION	MILEPOINT	LOCATION CODE (SHEET 2)	SIGN CODE	WIDTH (IN)	HEIGHT (IN)	SHEETING REMARKS	SIGN LEGEND	NEW SIGNS		EXISTING SIGNS				EXIST POST		NUMBER OF NEW POSTS	SQUARE STEEL (IN)			TUBULAR STEEL Ø (IN)				SIGN FRAME REQUIRED	REMARKS	SIGN DETAIL																			
								"A"	"B"	RETAIN	SALVAGE FROM	SALVAGE TO	REMOVE	RETAIN	REMOVE		1.75	2.00	2.50	FOUNDATION	3.00	3.50	4.00			5.00	DETAIL IN SHS	DETAIL ON SHEET NUMBER	DETAIL ON STD SHEET NUMBER																
																	(LB / FT)				(LB / FT)																								
WAITSFIELD VT 100							FY-FLUORESCENT YELLOW FYG-FLUORESCENT YELLOW GREEN																"SHS"-STANDARD HIGHWAY SIGNS																						
		F	VD-062B	72	16		BUSINESS SIGN			1																																			
		F	VD-062B	72	16		BUSINESS SIGN			1																																			
SB	6.671	G	VR-017	24	30		LEGAL LOAD LIMIT 24,000 POUNDS			1				X																			AIRPORT RD (TH-6);												
SB	6.663	H	R1-1	30	30		STOP			1				X																			AIRPORT RD (TH-6);												
SB	6.329	F	S3-1	30	30		SCHOOL BUS STOP AHEAD			1				X																															
SB	5.990	F	VW-054	30	30		HIDDEN DRIVE RIGHT						1		X																														
SB	5.950	F	VW-054R	30	30		HIDDEN DRIVE RIGHT	6.25							1		X																INSTALL BEHIND RAIL 210 FT± SOUTH OF PREVIOUS LOCATION.												
SB	5.735	G	VR-017	24	30		LEGAL LOAD LIMIT 24,000 POUNDS			1				X																				RIVERVIEW RD (TH-47);											
SB	5.727	H	R1-1	30	30		STOP			1				X																				RIVERVIEW RD (TH-47);											
SB	5.435	F	VW-060	30	30		HIDDEN DRIVES						1		X																														
SB	5.413	F	VW-060	30	30		HIDDEN DRIVES	6.25							2		X																INSTALL BEHIND RAIL 120 FT± SOUTH OF "HIDDEN DRIVES" REMOVAL, THIS SIGN ON TOP.												
		F	S3-1	30	30		SCHOOL BUS STOP AHEAD	6.25																										COMBINE WITH THE NEW HIDDEN DRIVES SIGN ON TWO POSTS, THIS SIGN ON THE BOTTOM.											
SB	5.390	F	S3-1	30	30		SCHOOL BUS STOP AHEAD						1		X																														
SB	5.325	F	W2-2R	30	30		SIDE ROAD RIGHT						1		X																														
		F	W16-8A	24	18		CENTER FAYSTON RD (PLAQUE)						1																																
SIGN SUMMARY SHEET							SHEET TOTALS											18.75	0.00	7	0	0	5	0	0	3	45																		
							SF	SF	EA	EA	EA	EA	EA	EA	EA	EA																													
VERMONT AGENCY OF TRANSPORTATION							TOWN TOTALS											684.6	0.0	99.0	18.0	18.0	141	0.0	0.0	129	1935.0																		
																						PROJECT NAME:		Ludlow-Waitsfield VT100										PROJECT NUMBER:		STPG SIGN(27)									
																						FILE NAME: Waitsfield.xls										PLOT DATE: 9/15/2009													
																						PROJECT MANAGER: N. Avery										DRAWN BY: I. Shea													
																						DESIGNED BY: M. Miller										CHECKED BY: N. Avery													
																						WAITSFIELD SHEET 16										SHEET 189 OF 204													












DIRECTION	MILEPOINT	LOCATION CODE (SHEET 2)	SIGN CODE	WIDTH (IN)	HEIGHT (IN)	SHEETING REMARKS	SIGN LEGEND	NEW SIGNS		EXISTING SIGNS				EXIST POST		NUMBER OF NEW POSTS	SQUARE STEEL (IN)			TUBULAR STEEL Ø (IN)				SIGN FRAME REQUIRED	REMARKS	SIGN DETAIL			
								"A"	"B"	RETAIN	SALVAGE FROM	SALVAGE TO	REMOVE	RETAIN	REMOVE		1.75	2.00	2.50	FOUNDATION	3.00	3.50	4.00			5.00	DETAIL IN SHS	DETAIL ON SHEET NUMBER	DETAIL ON STD SHEET NUMBER
																	(LB / FT)				(LB / FT)								
WAITSFIELD VT 100							FY-FLUORESCENT YELLOW FYG-FLUORESCENT YELLOW GREEN																"SHS"-STANDARD HIGHWAY SIGNS						
SB	5.320	F	W2-2MaR	30	30			6.25							1		X							RESET TO SPEC. NEW POST.	INSTALL 25 FT± SOUTH OF PREVIOUS LOCATION		6		
		F	W16-8	30	18			3.75																	MAINTAIN 10 FT MIN TO UTILITY POLE		8		
SB	5.244	G	VR-017	24	30		LEGAL LOAD LIMIT 24,000 POUNDS			1														CENTER FAYSTON RD (TH-7);					
SB	5.236	H	R1-1	30	30		STOP			1														CENTER FAYSTON RD (TH-7);					
SB	5.055	F	W11-6H	30	30		SNOWMOBILE SYMBOL (HINGED SIGN)						1																
SB	5.025	F	D5-5A	24	24			4.00							1										INSTALL 160 FT± SOUTH OF SNOWMOBILE SIGN REMOVAL; MAINTAIN 10 FT MIN TO GUY WIRE		X		
		F	D5-5A	24	6			1.00																	BOTH SIGNS WHITE ON BLUE SHEETING; ARROW IS A SEPERATE SIGN BUT PART OF THE D5-5A SIGN CODE		X		
SB	4.990	F	VD-062AS	72	16		BUSINESS SIGN			1	1														REINSTALL THE SIGNS ONTO A NEW SET OF POSTS				
		F	VD-062B	72	16		BUSINESS SIGN			1	1																		
SB	4.931	G	VR-017	24	30		LEGAL LOAD LIMIT 24,000 POUNDS			1															ARMSTRONG RD (TH-11);				
		H	R1-1	30	30			6.25								1									INSTALL BEHIND LEGAL LOAD SIGN; TO BE THE LEFT-SIDE STOP SIGN FOR TH-11		X		
SB	4.923	H	R1-1	30	30		STOP			1															ARMSTRONG RD (TH-11);				
SB	4.775	F	W2-3MaR	30	30		MINOR SIDE ROAD LEFT AT UP 45 DEG ANGLE						1																
SIGN SUMMARY SHEET							SHEET TOTALS	21.25	0.00	4	2	2	2	0	0	5		75								PROJECT NAME: Ludlow-Waitsfield VT100			
								SF	SF	EA	EA	EA	EA	EA	EA	EA	EA				FT								PROJECT NUMBER: STPG SIGN(27)
VERMONT AGENCY OF TRANSPORTATION							TOWN TOTALS	684.6	0.0	99.0	18.0	18.0	141	0.0	0.0	129		1935.0							FILE NAME: Waitsfield.xls	PLOT DATE: 9/15/2009			
																								PROJECT MANAGER: N. Avery	DRAWN BY: I. Shea				
																									DESIGNED BY: M. Miller	CHECKED BY: N. Avery			
																									WAITSFIELD SHEET 17	SHEET 190 OF 204			






DIRECTION	MILEPOINT	LOCATION CODE (SHEET 2)	SIGN CODE	WIDTH (IN)	HEIGHT (IN)	SHEETING REMARKS	SIGN LEGEND	NEW SIGNS		EXISTING SIGNS				EXIST POST		NUMBER OF NEW POSTS	SQUARE STEEL (IN)			TUBULAR STEEL Ø (IN)				SIGN FRAME REQUIRED	REMARKS	SIGN DETAIL				
								"A"	"B"	RETAIN	SALVAGE FROM	SALVAGE TO	REMOVE	RETAIN	REMOVE		1.75	2.00	2.50	FOUNDATION	3.00	3.50	4.00			5.00	DETAIL IN SHS	DETAIL ON SHEET NUMBER	DETAIL ON STD SHEET NUMBER	
																	(LB / FT)				(LB / FT)									
WAITSFIELD VT 100							FY-FLUORESCENT YELLOW FYG-FLUORESCENT YELLOW GREEN															"SHS"-STANDARD HIGHWAY SIGNS								
SB	4.750	F	W2-3MaR	30	30			6.25							1		X							RESET TO SPEC, NEW POST.	INSTALL BEHIND RAIL 130 FT± SOUTH OF PREVIOUS POSITION		6			
SB	4.696	G	VR-017	24	30		LEGAL LOAD LIMIT 24,000 POUNDS			1															OLD COUNTY RD (TH-12);					
SB	4.691	H	R1-1	30	30		STOP			1															OLD COUNTY RD (TH-12);					
SB	4.648	F	VD-062C	74.75	16		TRAVEL INFO LOGOS			1																				
		F	VD-062BC	74.75	16		TRAVEL INFO SIGN			1																				
SB	4.435	F	R2-5A	24	30		REDUCED SPEED AHEAD					1																		
		F	W3-5	36	36			9.00							2		X								RESET TO SPEC, NEW POSTS.		X			
SB	4.400	F	VD-018	30	18							1																		
		F	VD-018	30	18			3.75							1		X							RESET TO SPEC, NEW POST.	INSTALL 200 FT± NORTH OF THE SPEED LIMIT 40 SIGN; ASSURE 10 FT MIN TO UTILITY POLE				E-128B	
SB	4.360	F	R2-1	24	30							1																		
		F	R2-1	30	36			7.50							1		X							RESET TO SPEC, NEW POST.	NOTE LARGER SIZED SIGN		6			
SB	4.313	F	VD-062AS	72	16		BUSINESS SIGN			1																				
		F	VD-062B	72	16		BUSINESS SIGN			1																				
		F	VD-062AS	72	16		BUSINESS SIGN			1																				
SB	4.255	F	R2-5A	24	30		REDUCED SPEED AHEAD					1																		
SIGN SUMMARY SHEET							SHEET TOTALS	26.50	0.00	7	0	0	4	0	0	5		75								PROJECT NAME: Ludlow-Waitsfield VT100				
								SF	SF	EA	EA	EA	EA	EA	EA	EA		FT							PROJECT NUMBER: STPG SIGN(27)					
VERMONT AGENCY OF TRANSPORTATION							TOWN TOTALS	684.6	0.0	99.0	18.0	18.0	141	0.0	0.0	129		1935.0								FILE NAME: Waitsfield.xls	PLOT DATE: 9/15/2009			
																									PROJECT MANAGER: N. Avery	DRAWN BY: I. Shea				
																										DESIGNED BY: M. Miller	CHECKED BY: N. Avery			
																										WAITSFIELD SHEET 18	SHEET 191 OF 204			

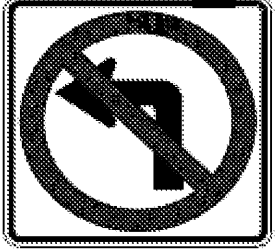





DIRECTION	MILEPOINT	LOCATION CODE (SHEET 2)	SIGN CODE	WIDTH (IN)	HEIGHT (IN)	SHEETING REMARKS	SIGN LEGEND	NEW SIGNS		EXISTING SIGNS				EXIST POST		NUMBER OF NEW POSTS	SQUARE STEEL (IN)			TUBULAR STEEL Ø (IN)				SIGN FRAME REQUIRED	REMARKS	SIGN DETAIL		
								"A"	"B"	RETAIN	SALVAGE FROM	SALVAGE TO	REMOVE	RETAIN	REMOVE		1.75	2.00	2.50	3.00	3.50	4.00	5.00			DETAIL IN SHS	DETAIL ON SHEET NUMBER	DETAIL ON STD SHEET NUMBER
																	(LB / FT)			(LB / FT)								
WAITSFIELD VT 100							FY-FLUORESCENT YELLOW FYG-FLUORESCENT YELLOW GREEN															"SHS"-STANDARD HIGHWAY SIGNS						
			F W3-5	36	36			9.00							2	X							ASSURE 10 FT MIN TO UTILITY POLE	X				
SB	4.207		F S1-1	36	36	FYG	PENTAGONAL SCHOOL SYMBOL			1																		
			F W16-9	36	20	FYG	AHEAD PLAQUE			1																		
SB	4.160		F R2-1	24	30							1																
			F R2-1	30	36			7.50						1	X										6			
SB	4.050		F R2-1	24	30		SPEED LIMIT 30						1															
SB	4.040		F R2-1	24	30			5.00						1	X								INSTALL 50 FT± SOUTH OF PREVIOUS POSITION	X				
SB	4.005		F VW-544	30	30							1																
			F W16-4	24	18							1																
			F VW-544	30	30			6.25						1	X								ASSURE 10 FT MIN DISTANCE TO UTILITY POLE			E-154		
			F W16-4	24	18			3.00																X				
SB	3.965		G VR-017	24	30							1																
			G VR-017	24	30			5.00						1	X											E-141		
SB	3.959		H R1-1	30	30							1																
			H R1-1	30	30			6.25						1	X									X				
SIGN SUMMARY SHEET							SHEET TOTALS	42.00	0.00	2	0	0	6	0	0	7	105							PROJECT NAME: Ludlow-Waitsfield VT100				
								SF	SF	EA	EA	EA	EA	EA	EA	EA	FT							PROJECT NUMBER: STPG SIGN(27)				
VERMONT AGENCY OF TRANSPORTATION							TOWN TOTALS	684.6	0.0	99.0	18.0	18.0	141	0.0	0.0	129	1935.0							FILE NAME: Waitsfield.xls	PLOT DATE: 9/15/2009			
																							PROJECT MANAGER: N. Avery	DRAWN BY: I. Shea				
																							DESIGNED BY: M. Miller	CHECKED BY: N. Avery				
																							WAITSFIELD SHEET 19	SHEET 192 OF 204				

DIRECTION	MILEPOINT	LOCATION CODE (SHEET 2)	SIGN CODE	WIDTH (IN)	HEIGHT (IN)	SHEETING REMARKS	SIGN LEGEND	NEW SIGNS		EXISTING SIGNS				EXIST POST		NUMBER OF NEW POSTS	SQUARE STEEL (IN)			TUBULAR STEEL Ø (IN)				SIGN FRAME REQUIRED	REMARKS	SIGN DETAIL									
								"A"	"B"	RETAIN	SALVAGE FROM	SALVAGE TO	REMOVE	RETAIN	REMOVE		1.75	2.00	2.50	3.00	3.50	4.00	5.00			DETAIL IN SHS	DETAIL ON SHEET NUMBER	DETAIL ON STD SHEET NUMBER							
																	(LB / FT)			(LB / FT)															
WAITSFIELD VT 100							FY-FLUORESCENT YELLOW FYG-FLUORESCENT YELLOW GREEN																"SHS"-STANDARD HIGHWAY SIGNS												
SB	3.880	F	VD-062B	72	16		BUSINESS SIGN			1																									
		F	VD-062AS	72	16		BUSINESS SIGN			1																									
SB	3.770	F	VD-062B	72	16		BUSINESS SIGN			1																									
		F	VD-062AL	72	16		BUSINESS SIGN			1																									
		F	VD-062AL	72	16		BUSINESS SIGN			1																									
SB	3.745	F	W11-2	30	30		 																												
		F	W16-9	24	12																														
		F	W11-2	30	30	FYG		6.25							1			X																	
		F	W16-9	24	12	FYG		2.00																											
SB	3.723	F	R2-1	24	30																														
		F	R2-1	24	30			5.00							1			X																	
SB	3.690	G	VR-017	24	30		LEGAL LOAD LIMIT 24,000 POUNDS																												
SB	3.680	H	R1-1	30	30																														
		H	VR-017	24	30			5.00																											
SB	3.660	F	W11-2	30	30	FYG	PEDESTRIAN SYMBOL			1																									
SIGN SUMMARY SHEET							SHEET TOTALS	18.25	0.00	7	0	0	4	0	0	2	30																		
VERMONT AGENCY OF TRANSPORTATION								SF	SF	EA	EA	EA	EA	EA	EA	EA	FT																		
							TOWN TOTALS	684.6	0.0	99.0	18.0	18.0	141	0.0	0.0	129	1935.0																		

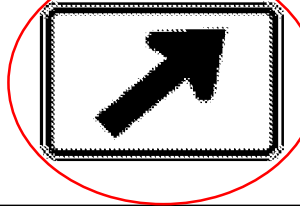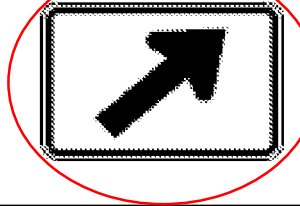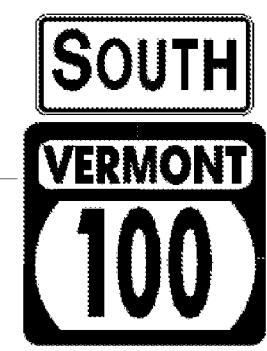
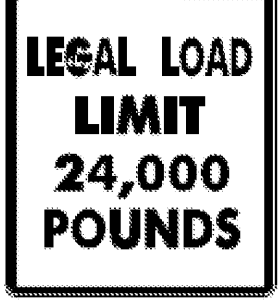

DIRECTION	MILEPOINT	LOCATION CODE (SHEET 2)	SIGN CODE	WIDTH (IN)	HEIGHT (IN)	SHEETING REMARKS	SIGN LEGEND	NEW SIGNS		EXISTING SIGNS				EXIST POST		NUMBER OF NEW POSTS	SQUARE STEEL (IN)			TUBULAR STEEL Ø (IN)				SIGN FRAME REQUIRED	REMARKS	SIGN DETAIL			
								"A"	"B"	RETAIN	SALVAGE FROM	SALVAGE TO	REMOVE	RETAIN	REMOVE		1.75	2.00	2.50	FOUNDATION	3.00	3.50	4.00			5.00	DETAIL IN SHS	DETAIL ON SHEET NUMBER	DETAIL ON STD SHEET NUMBER
																	(LB / FT)				(LB / FT)								
WAITSFIELD VT 100							FY-FLUORESCENT YELLOW FYG-FLUORESCENT YELLOW GREEN															"SHS"-STANDARD HIGHWAY SIGNS							
		F	W16-7	24	12	FYG	DIAGONAL ARROW PLAQUE			1																			
SB	3.661	G	VR-017	24	24							1	X										FARR LANE (TH-22)						
		G	VR-017	24	30				5.00					1	X								INSTALL FROM CURRENT LOCATION TO A POINT BEYOND THE UTILITY POLE GUY WIRES		E-141				
SB	3.650	H	R1-1	30	30							1	X										FARR LANE (TH-22)						
		H	R1-1	30	30				6.25					1	X									X					
SB	3.443	F	R2-1	24	30							1	X																
		F	R2-1	24	30				5.00					1	X									X					
SB	3.345	F	VD-018	30	18							1	X																
		F	VD-018	30	18				3.75					1	X				RESET TO SPEC, NEW POST.						E-128A				
SB	3.245	F	VD-062B	72	16		BUSINESS SIGN			1			X																
		F	VD-062B	72	16		BUSINESS SIGN			1																			
		F	VD-062B	72	16		BUSINESS SIGN			1																			
SB	3.184	F	W11-2YG	30	30	FYG	PEDESTRIAN SYMBOL			1			X																
		F	W11-2PB	24	18	FYG	BLIND PERSON (PLAQUE)			1																			
		F	W16-7YG	24	12	FYG	DIAGONAL ARROW			1																			
SIGN SUMMARY SHEET							SHEET TOTALS		20.00	0.00	7	0	0	4	0	0	4	60					PROJECT NAME: Ludlow-Waitsfield VT100						
							SF	SF	EA	EA	EA	EA	EA	EA	EA	FT					PROJECT NUMBER: STPG SIGN(27)								
VERMONT AGENCY OF TRANSPORTATION							TOWN TOTALS		684.6	0.0	99.0	18.0	18.0	141	0.0	0.0	129	1935.0					FILE NAME: Waitsfield.xls	PLOT DATE: 9/15/2009					
																							PROJECT MANAGER: N. Avery	DRAWN BY: I. Shea					
																							DESIGNED BY: M. Miller	CHECKED BY: N. Avery					
																							WAITSFIELD SHEET 21	SHEET 194 OF 204					

DIRECTION	MILEPOINT	LOCATION CODE (SHEET 2)	SIGN CODE	WIDTH (IN)	HEIGHT (IN)	SHEETING REMARKS	SIGN LEGEND	NEW SIGNS		EXISTING SIGNS				EXIST POST		NUMBER OF NEW POSTS	SQUARE STEEL (IN)			TUBULAR STEEL Ø (IN)				SIGN FRAME REQUIRED	REMARKS	SIGN DETAIL		
								"A"	"B"	RETAIN	SALVAGE FROM	SALVAGE TO	REMOVE	RETAIN	REMOVE		1.75	2.00	2.50	3.00	3.50	4.00	5.00			DETAIL IN SHS	DETAIL ON SHEET NUMBER	DETAIL ON STD SHEET NUMBER
																	(LB / FT)			(LB / FT)								
WAITSFIELD VT 100							FY-FLUORESCENT YELLOW FYG-FLUORESCENT YELLOW GREEN																"SHS"-STANDARD HIGHWAY SIGNS					
		E	R3-2	24	24			4.00								1	X								X			
SB	2.865	F	R2-1	24	30								1			X												
		F	R2-1	24	30			5.00								1	X								X			
SB	2.850	G	VR-017	24	24								1			X												
		G	VR-017	24	30			5.00								1	X									E-141		
SB	2.840	H	R1-1	24	24								1			X												
		F	R1-1	30	30			6.25								1	X								X			
SB	2.835	F	M3-3	24	12		SOUTH			1						X												
		F	M1-5	30	24		VERMONT 100			1																		
SB	2.794	F	M2-1	21	15			2.19								1	X								X			
		F	M1-5	24	24			4.00																		E-136B		
SB	2.787	F	M2-1	21	15		JCT						1			X												
		F	M1-5	24	24		VERMONT 17						1															
SB	2.740	F	D1-1A	72	12		<--- (45 DEG) WARREN 5			1	1				X													
		F	D1-1S	72	12		<--- (45 DEG) SUGARBUSH SKI AREA 6			1	1																	
SIGN SUMMARY SHEET							SHEET TOTALS	26.44	0.00	2	2	2	5	0	0	7		105										
								SF	SF	EA	EA	EA	EA	EA	EA	EA		FT										
VERMONT AGENCY OF TRANSPORTATION							TOWN TOTALS	684.6	0.0	99.0	18.0	18.0	141	0.0	0.0	129		1935.0										
																				PROJECT NAME:	Ludlow-Waitsfield VT100							
																				PROJECT NUMBER:	STPG SIGN(27)							
																				FILE NAME:	Waitsfield.xls							
																				PLOT DATE:	9/15/2009							
																				PROJECT MANAGER:	N. Avery							
																				DRAWN BY:	I. Shea							
																				DESIGNED BY:	M. Miller							
																				CHECKED BY:	N. Avery							
																				WAITSFIELD SHEET 23	SHEET 196 OF 204							

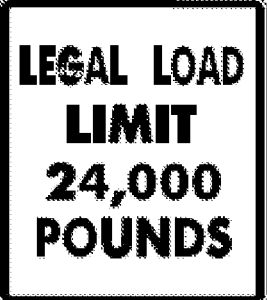DIRECTION	MILEPOINT	LOCATION CODE (SHEET 2)	SIGN CODE	WIDTH (IN)	HEIGHT (IN)	SHEETING REMARKS	SIGN LEGEND	NEW SIGNS		EXISTING SIGNS				EXIST POST		NUMBER OF NEW POSTS	SQUARE STEEL (IN)			TUBULAR STEEL Ø (IN)				SIGN FRAME REQUIRED	REMARKS	SIGN DETAIL			
								"A"	"B"	RETAIN	SALVAGE FROM	SALVAGE TO	REMOVE	RETAIN	REMOVE		1.75	2.00	2.50	FOUNDATION	3.00	3.50	4.00			5.00	DETAIL IN SHS	DETAIL ON SHEET NUMBER	DETAIL ON STD SHEET NUMBER
																	(LB / FT)				(LB / FT)								
WAITSFIELD VT 100							FY-FLUORESCENT YELLOW FYG-FLUORESCENT YELLOW GREEN															"SHS"-STANDARD HIGHWAY SIGNS							
		F	M3-3	24	12			2.00							2							#2A	GREEN ON WHITE SHEETING	X					
		F	M1-5	30	24			5.00																	E-136B				
		F	M6-2	21	15			2.19															GREEN ON WHITE SHEETING	X					
		F	M3-4	24	12			2.00															GREEN ON WHITE SHEETING	X					
		F	M1-5	24	24			4.00																		E-136B			
		F	M5-2R M6-3	21	15		 M5-2R	+2.19 2.19															GREEN ON WHITE SHEETING	X					
SB	2.630	H	R1-1	30	30		STOP			1																			
		G	OM1-1	18	18		OBJECT MARKER (ON BACK)			1																			
SB	2.600	H	R1-1	30	30		STOP			1													FACES EB VT-17 TRAFFIC AT THE SOUTHERLY APPROACH						
SB	2.569	F	M3-3	24	12			2.00							1								GREEN ON WHITE SHEETING	X					
		F	M1-5	30	24			5.00															INSTALL 50 FT± NORTH OF THE EXISTING ROUTE MARKERS, WHICH WILL BE REMOVED			E-136B			
SB	2.560	F	M3-3	24	12		SOUTH																BEHIND CABLE RAIL						
		F	M1-5	30	24		VERMONT 100																						
SB	2.525	F	D2-1	72	12		WARREN 5			1																			
		F	D1-1S	72	12		SUGARBUSH SKI AREA 6			1																			
SIGN SUMMARY SHEET							SHEET TOTALS	26.57 24.38	0.00	5	0	0	2	0	0	3	45						PROJECT NAME: Ludlow-Waitsfield VT100						
							SF	SF		EA	EA	EA	EA	EA	EA	EA	FT					PROJECT NUMBER: STPG SIGN(27)							
VERMONT AGENCY OF TRANSPORTATION							TOWN TOTALS	684.6	0.0	99.0	18.0	18.0	141	0.0	0.0	129	1935.0					FILE NAME: Waitsfield.xls	PLOT DATE: 9/15/2009						
																					PROJECT MANAGER: N. Avery	DRAWN BY: I. Shea							
																					DESIGNED BY: M. Miller	CHECKED BY: N. Avery							
																					WAITSFIELD SHEET 25	SHEET 198 OF 204							

DIRECTION	MILEPOINT	LOCATION CODE (SHEET 2)	SIGN CODE	WIDTH (IN)	HEIGHT (IN)	SHEETING REMARKS	SIGN LEGEND	NEW SIGNS		EXISTING SIGNS				EXIST POST		NUMBER OF NEW POSTS	SQUARE STEEL (IN)			TUBULAR STEEL Ø (IN)				SIGN FRAME REQUIRED	REMARKS	SIGN DETAIL			
								"A"	"B"	RETAIN	SALVAGE FROM	SALVAGE TO	REMOVE	RETAIN	REMOVE		1.75	2.00	2.50	FOUNDATION	3.00	3.50	4.00			5.00	DETAIL IN SHS	DETAIL ON SHEET NUMBER	DETAIL ON STD SHEET NUMBER
																	(LB / FT)				(LB / FT)								
WAITSFIELD VT 100							FY-FLUORESCENT YELLOW FYG-FLUORESCENT YELLOW GREEN																"SHS"-STANDARD HIGHWAY SIGNS						
		F	D2-1	72	12		GRANVILLE 16			1																			
SB	2.490	F	R2-1	24	30							1			X														
		F	R2-1	24	30			5.00						1		X							RESET TO SPEC. NEW POST.	ACROSS FROM ± THE NB SPEED LIMIT 30 SIGN	X				
SB	2.385	F	VD-062B	72	16		BUSINESS SIGN			1	1				X	1		X						LARGE SIGN: OK' D 2 POSTS.					
SB	2.050	F	R2-1	24	30							1			X														
		F	R2-1	24	30			5.00						1		X									X				
SB	1.980	G	VR-017	24	24							1			X									LAREAU RD (TH-39) SHARPLY SKEWED TOWN HIGHWAY INTERSECTION			E-141		
		G	VR-017	24	24			5.00						1		X													
SB	1.978	H	R1-1	30	30							1			X									LAREAU RD (TH-39) PROVIDE 10 FT MIN TO UTILITY POLE					
		H	R1-1	30	30			6.25						1		X									X				
SB	1.976	A	W11-1	30	30							1			X														
		A	W16-1	18	18							1																	
		A	W11-1	30	30			6.25						1		X									X				
		A	W16-1	18	24			3.00																	X				
SB	1.950	F	OM-3R	12	36							1			X														
SIGN SUMMARY SHEET							SHEET TOTALS	30.50	0.00	1	1	1	7	0	0	6	90							PROJECT NAME: Ludlow-Waitsfield VT100					
								SF	SF	EA	EA	EA	EA	EA	EA	EA	FT									PROJECT NUMBER: STPG SIGN(27)			
VERMONT AGENCY OF TRANSPORTATION							TOWN TOTALS	684.6	0.0	99.0	18.0	18.0	141	0.0	0.0	129	1935.0						FILE NAME: Waitsfield.xls	PLOT DATE: 9/15/2009					
																						PROJECT MANAGER: N. Avery	DRAWN BY: I. Shea						
																						DESIGNED BY: M. Miller	CHECKED BY: N. Avery						
																						WAITSFIELD SHEET 26	SHEET 199 OF 204						

DIRECTION	MILEPOINT	LOCATION CODE (SHEET 2)	SIGN CODE	WIDTH (IN)	HEIGHT (IN)	SHEETING REMARKS	SIGN LEGEND	NEW SIGNS		EXISTING SIGNS				EXIST POST		NUMBER OF NEW POSTS	SQUARE STEEL (IN)			TUBULAR STEEL Ø (IN)				SIGN FRAME REQUIRED	REMARKS	SIGN DETAIL			
								"A"	"B"	RETAIN	SALVAGE FROM	SALVAGE TO	REMOVE	RETAIN	REMOVE		1.75	2.00	2.50	FOUNDATION	3.00	3.50	4.00			5.00	DETAIL IN SHS	DETAIL ON SHEET NUMBER	DETAIL ON STD SHEET NUMBER
																	(LB / FT)				(LB / FT)								
WAITSFIELD VT 100							FY-FLUORESCENT YELLOW FYG-FLUORESCENT YELLOW GREEN																"SHS"-STANDARD HIGHWAY SIGNS						
		F	OM-3R	12	36			3.00							1		X								INSTALL AT 4 FT VERTICAL CLEARANCE	X			
SB	1.910	E	OM-3L	12	36							1		X															
		E	OM-3L	12	36			3.00							1		X									INSTALL AT 4 FT VERTICAL CLEARANCE	X		
SB	1.860	F	R2-1	24	30		SPEED LIMIT 50				1			X															
SB	1.200	F	VD-062B	72	16		BUSINESS SIGN				1			X															
SB	1.006	G	VR-017	24	30							1		X															
		G	VR-017	24	30			5.00							1		X											E-141	
SB	0.998	H	R1-1	30	30							1		X												KINGSBURY RD (TH-30) REMOVE AND DISCARD INCORRECT MILE MARKER PLAQUE	X		
		H	R1-1	30	30			6.25							1		X												
SB	0.970	F	W1-2R	30	30		CURVE RIGHT				1			X															
SB	0.677	F	W1-4R	30	30							1		X															
		F	W1-4R	30	30			6.25							1		X										X		
SB	0.570	F	VD-062AL	72	16		BUSINESS SIGN				1			X															
		F	VD-062AL	72	16		BUSINESS SIGN				1			X															
SB	0.455	F	W2-1Me	30	30			6.25							2		X					RESET TO SPEC. NEW POST.				INSTALL THIS ASSEMBLY ON 2 POSTS, THE INTESECTION WARNING SYMBOL ON TOP		7	
SIGN SUMMARY SHEET							SHEET TOTALS	29.75	0.00	5	0	0	4	0	0	7		105								PROJECT NAME: Ludlow-Waitsfield VT100			
								SF	SF	EA	EA	EA	EA	EA	EA	EA		FT								PROJECT NUMBER: STPG SIGN(27)			
VERMONT AGENCY OF TRANSPORTATION							TOWN TOTALS	684.6	0.0	99.0	18.0	18.0	141	0.0	0.0	129		1935.0								FILE NAME: Waitsfield.xls	PLOT DATE: 9/15/2009		
																									PROJECT MANAGER: N. Avery	DRAWN BY: I. Shea			
																									DESIGNED BY: M. Miller	CHECKED BY: N. Avery			
																									WAITSFIELD SHEET 27	SHEET 200 OF 204			

DIRECTION	MILEPOINT	LOCATION CODE (SHEET 2)	SIGN CODE	WIDTH (IN)	HEIGHT (IN)	SHEETING REMARKS	SIGN LEGEND	NEW SIGNS		EXISTING SIGNS				EXIST POST		NUMBER OF NEW POSTS	SQUARE STEEL (IN)			TUBULAR STEEL Ø (IN)				SIGN FRAME REQUIRED	REMARKS	SIGN DETAIL						
								"A"	"B"	RETAIN	SALVAGE FROM	SALVAGE TO	REMOVE	RETAIN	REMOVE		1.75	2.00	2.50	3.00	3.50	4.00	5.00			DETAIL IN SHS	DETAIL ON SHEET NUMBER	DETAIL ON STD SHEET NUMBER				
																	(LB / FT)			(LB / FT)												
WAITSFIELD VT 100							FY-FLUORESCENT YELLOW FYG-FLUORESCENT YELLOW GREEN															"SHS"-STANDARD HIGHWAY SIGNS										
			F S3-1	30	30			6.25																		INSTALL 105 FT± IN NORTH OF THE EXISTING ASSEMBLY (TO BE REMOVED)	X					
SB	0.435		F W2-2R	30	30		SIDE ROAD RIGHT SYMBOL						1		X																	
			F S3-1	30	30		SCHOOL BUS STOP AHEAD						1																			
SB	0.338		G VR-017	24	30								1		X											BUTTERNUT HILL RD (TH-29)						
			G VR-017	24	30			5.00						1		X													E-141			
SB	0.330		H R1-1	30	30								1		X											BUTTERNUT HILL RD (TH-29)						
			H R1-1	30	30			6.25						1		X												X				
SIGN SUMMARY SHEET							SHEET TOTALS	17.50	0.00	0	0	0	4	0	0	2	30															
VERMONT AGENCY OF TRANSPORTATION								SF	SF	EA	EA	EA	EA	EA	EA	EA	EA	FT														
							TOWN TOTALS	684.6	0.0	99.0	18.0	18.0	141	0.0	0.0	129	1935.0															
															PROJECT NAME:	Ludlow-Waitsfield VT100																
															PROJECT NUMBER:	STPG SIGN(27)																
															FILE NAME:	Waitsfield.xls					PLOT DATE:	9/15/2009										
															PROJECT MANAGER:	N. Avery					DRAWN BY:	I. Shea										
															DESIGNED BY:	M. Miller					CHECKED BY:	N. Avery										
															WAITSFIELD SHEET 28					SHEET 201 OF 204												

TOWN TOTAL SIGN SUMMARY SHEET

VT ROUTE 100 LUDLOW - WAITSFIELD STPG SIGN (27)

Townname	County	Town Mileage	NEW SIGNS (SF)		EXISTING SIGNS (EA)			EXIST POST (EA)		NUMBER OF NEW POSTS (EA)			SQUARE STEEL (IN)			TUBULAR STEEL Ø (IN)						
			TYPE A	TYPE B (NONE)	RETAIN	SALVAGE FROM	SALVAGE TO	REMOVE	RETAIN	REMOVE	1.75"	2"	2.5"	TOTAL POSTS	1.75	2.00	2.50	FOUNDATION	3.00	3.50	4.00	5.00
											(LB / FT)				(LB / FT)				(LB / FT)			
											1.88	2.42	3.35		1.88	2.42	3.35		1.88	2.42	3.35	7.60
Ludlow	Windsor	8.47	647.44	647.350	13	3 4	3 4	135	133	0	0	102	4	106	1400.8	1530	60	68.75				
Plymouth	Windsor	9.726	668.4	0	31	4	4	135	133	0	0	111	0	111	1577.0	1665	0					
Bridgewater	Windsor	0.967	111.1	0	12	1	1	25	0	0	0	15	0	15	204.6	225	0					
Killington	Rutland	3.969	567	0	28	0	0	114	0	0	0	86	2	88	1253.0	1290	30	33.17				
Pittsfield	Rutland	4.873	297.1	0	15	1	1	51	52	0	0	52	0	52	719.0	780	0					
Stockbridge	Windsor	5.132	676.7	0	3	7 8	7 8	140	0	0	0	105	2	107	1524.0	1575	30	29.34				
Rochester	Windsor	8.353	593.8	6.25 0	60	9	9	115	0	0	0	98	4	102	1321.0	1470	60	61.41				
Hancock	Addison	2.511	370.6	0	32	6 8	6 8	78	81	0	0	44	6	50	643.0	660	90	101.08				
Granville	Addison	9.687	601.1	0	18	3	3	116	0	0	0	129	0	129	1630.5	1935	0					
Warren	Washington	6.348	465.2	6.25 0	65	10	10	97	98	0	0	90	0	90	1209.0	1350	0					
Waitsfield	Washington	7.58	684.6	2.19 0	99	18	18	141	0	0	0	127	2	129	1802.0	1905	30	30.83				
			5682.88	Sub-Total		6266	6266	1147	1148					Sub-Total	0	14385	300	324.58				
			114.69	ADD ON												3295.27						
Estimated Salvaged Street Name Signs to be erected onto new posts =							17															
Salvaged From signs to be added to Remove total =								66														
			5697.57					1212								13646.12						
		TOTAL =	5683	0	376	6266	83	1213	0	0	0	959	20	979	14685		0	0	0	0	0	

PROJECT NAME: LUDLOW - WAITSFIELD
 PROJECT NUMBER: STPG SIGN (27)
 FILE NAME: 09b058_TS.DGN
 PROJECT LEADER: N. AVERY
 DESIGNED BY: N. AVERY
 TOWN TOTAL SIGN SUMMARY SHEET
 PLOT DATE: 16-SEP-2009
 DRAWN BY: N. AVERY
 CHECKED BY: A. GAMBLE
 SHEET 202 OF 204

Table 6H-2. Meaning of Symbols on Typical Application Diagrams

	Arrow panel
	Arrow panel support or trailer (shown facing down)
	Changeable message sign or support trailer
	Channelizing device
	Crash Cushion
	Direction of temporary traffic detour
	Direction of traffic
	Flagger
	High level warning device (Flag tree)
	Luminaire
	Pavement markings that should be removed for a long term project
	Sign (shown facing left)
	Surveyor
	Temporary barrier
	Temporary barrier with warning lights
	Traffic or Pedestrian signal
	Truck mounted attenuator
	Type III Barricade
	Warning lights
	Work space
	Work vehicle

Figure 6E-1. Use of Hand-Signaling Devices by Flaggers

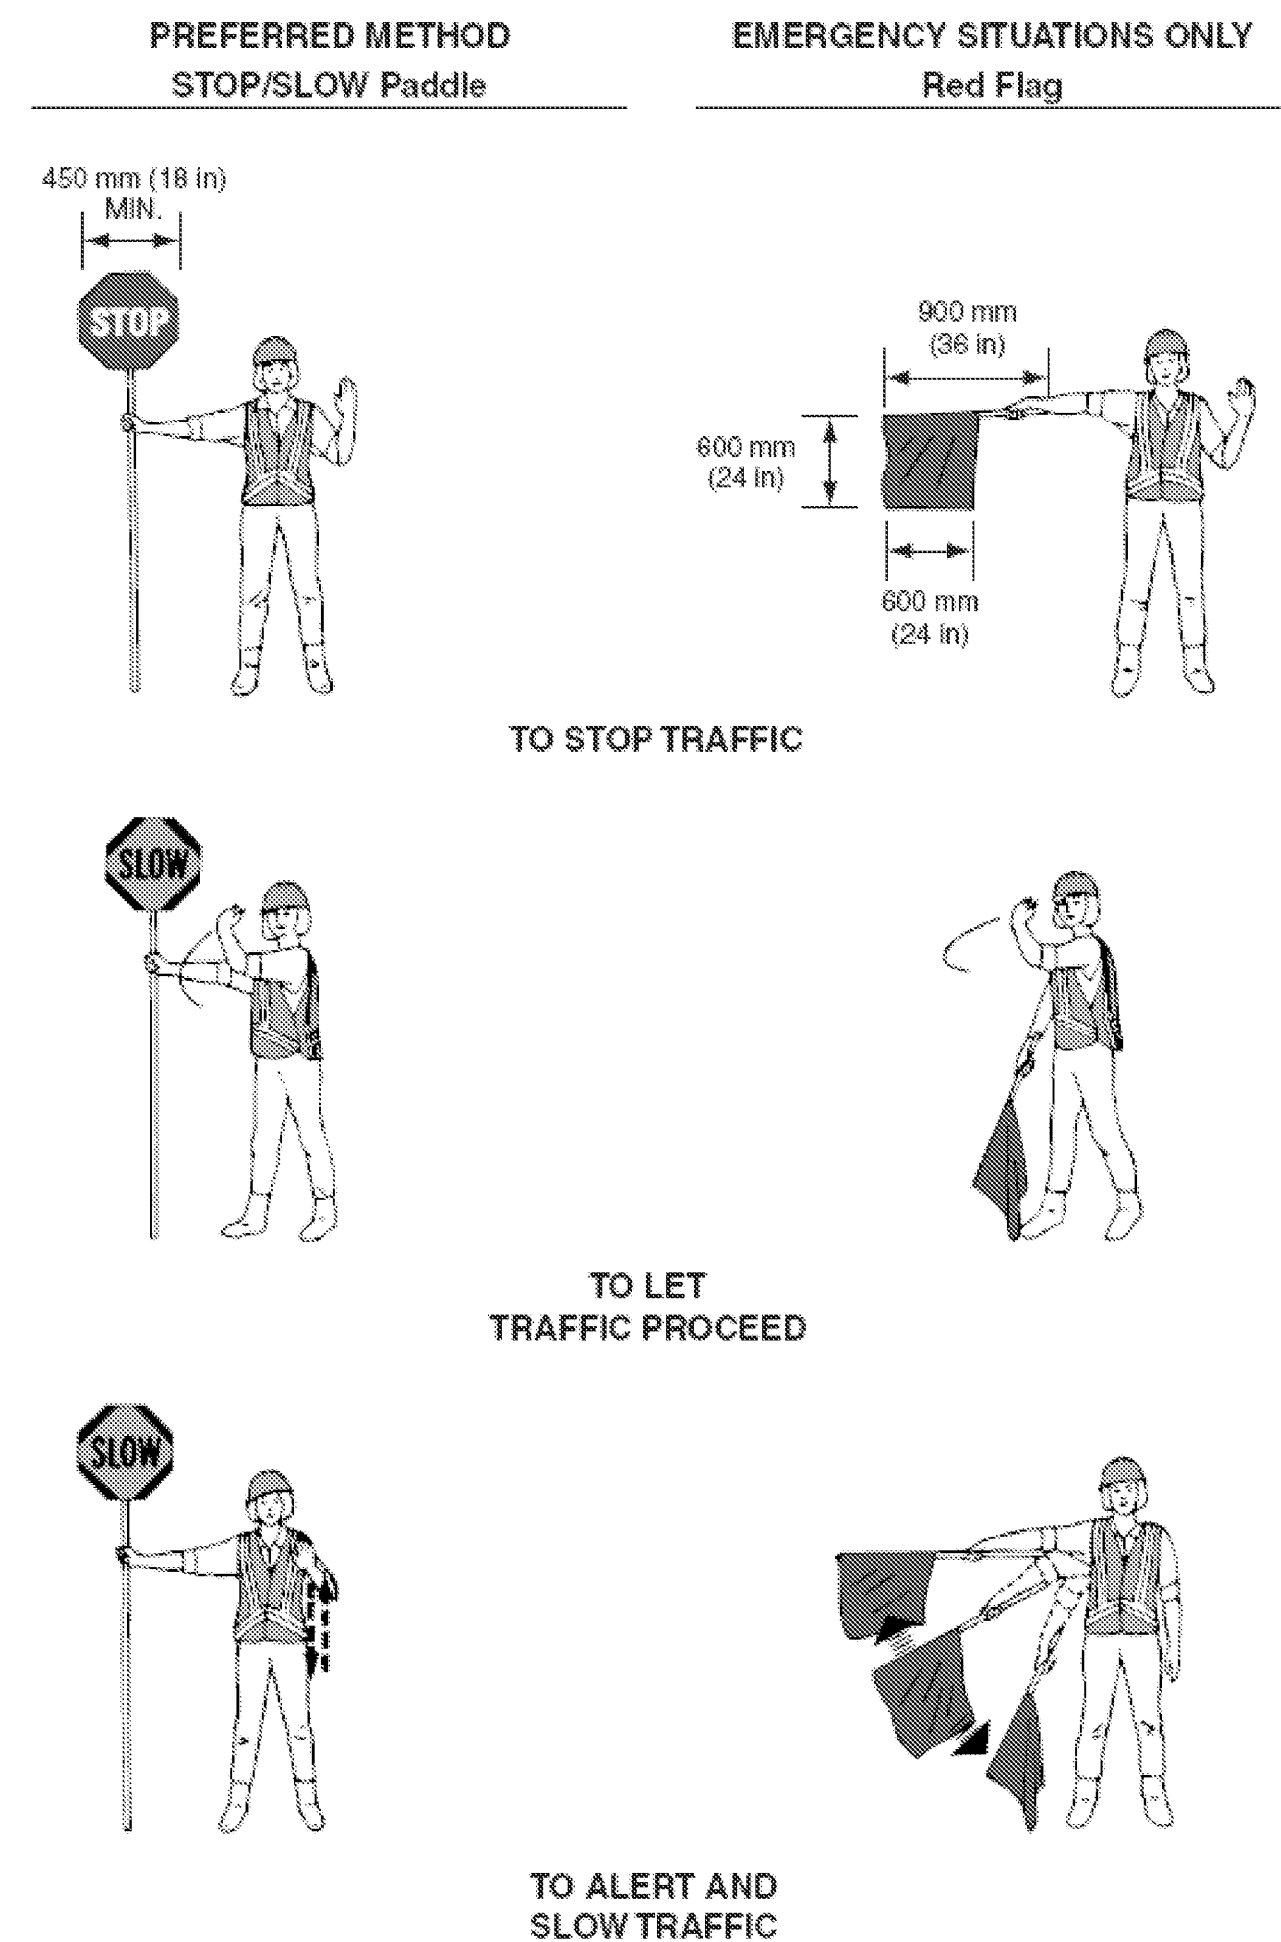


Figure 6C-2. Types of Tapers and Buffer Spaces

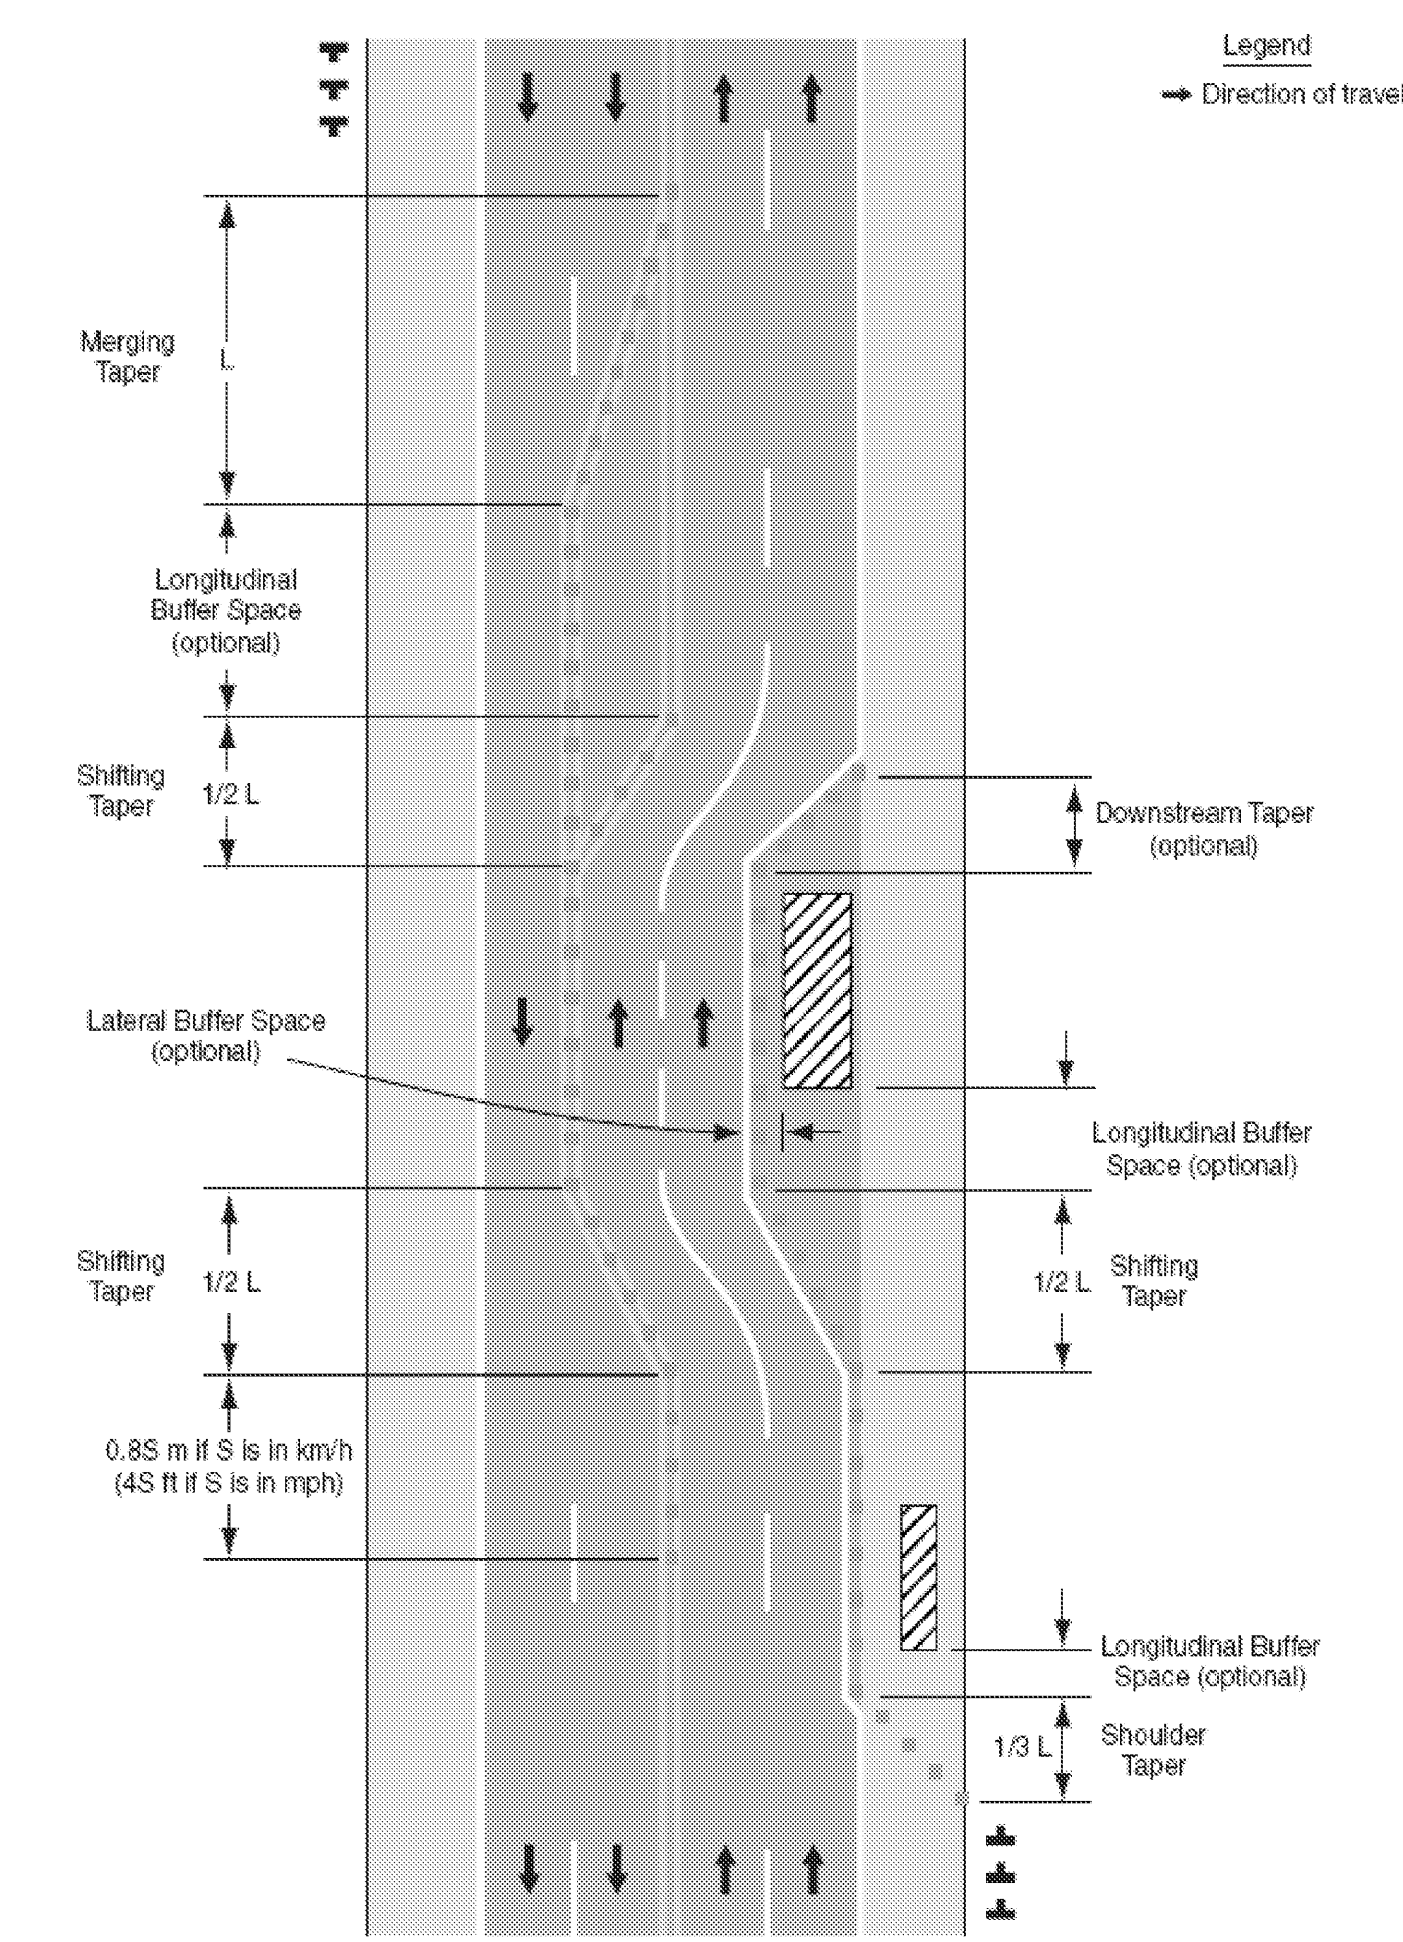


Figure 6H-1. Work Beyond the Shoulder (TA-1)

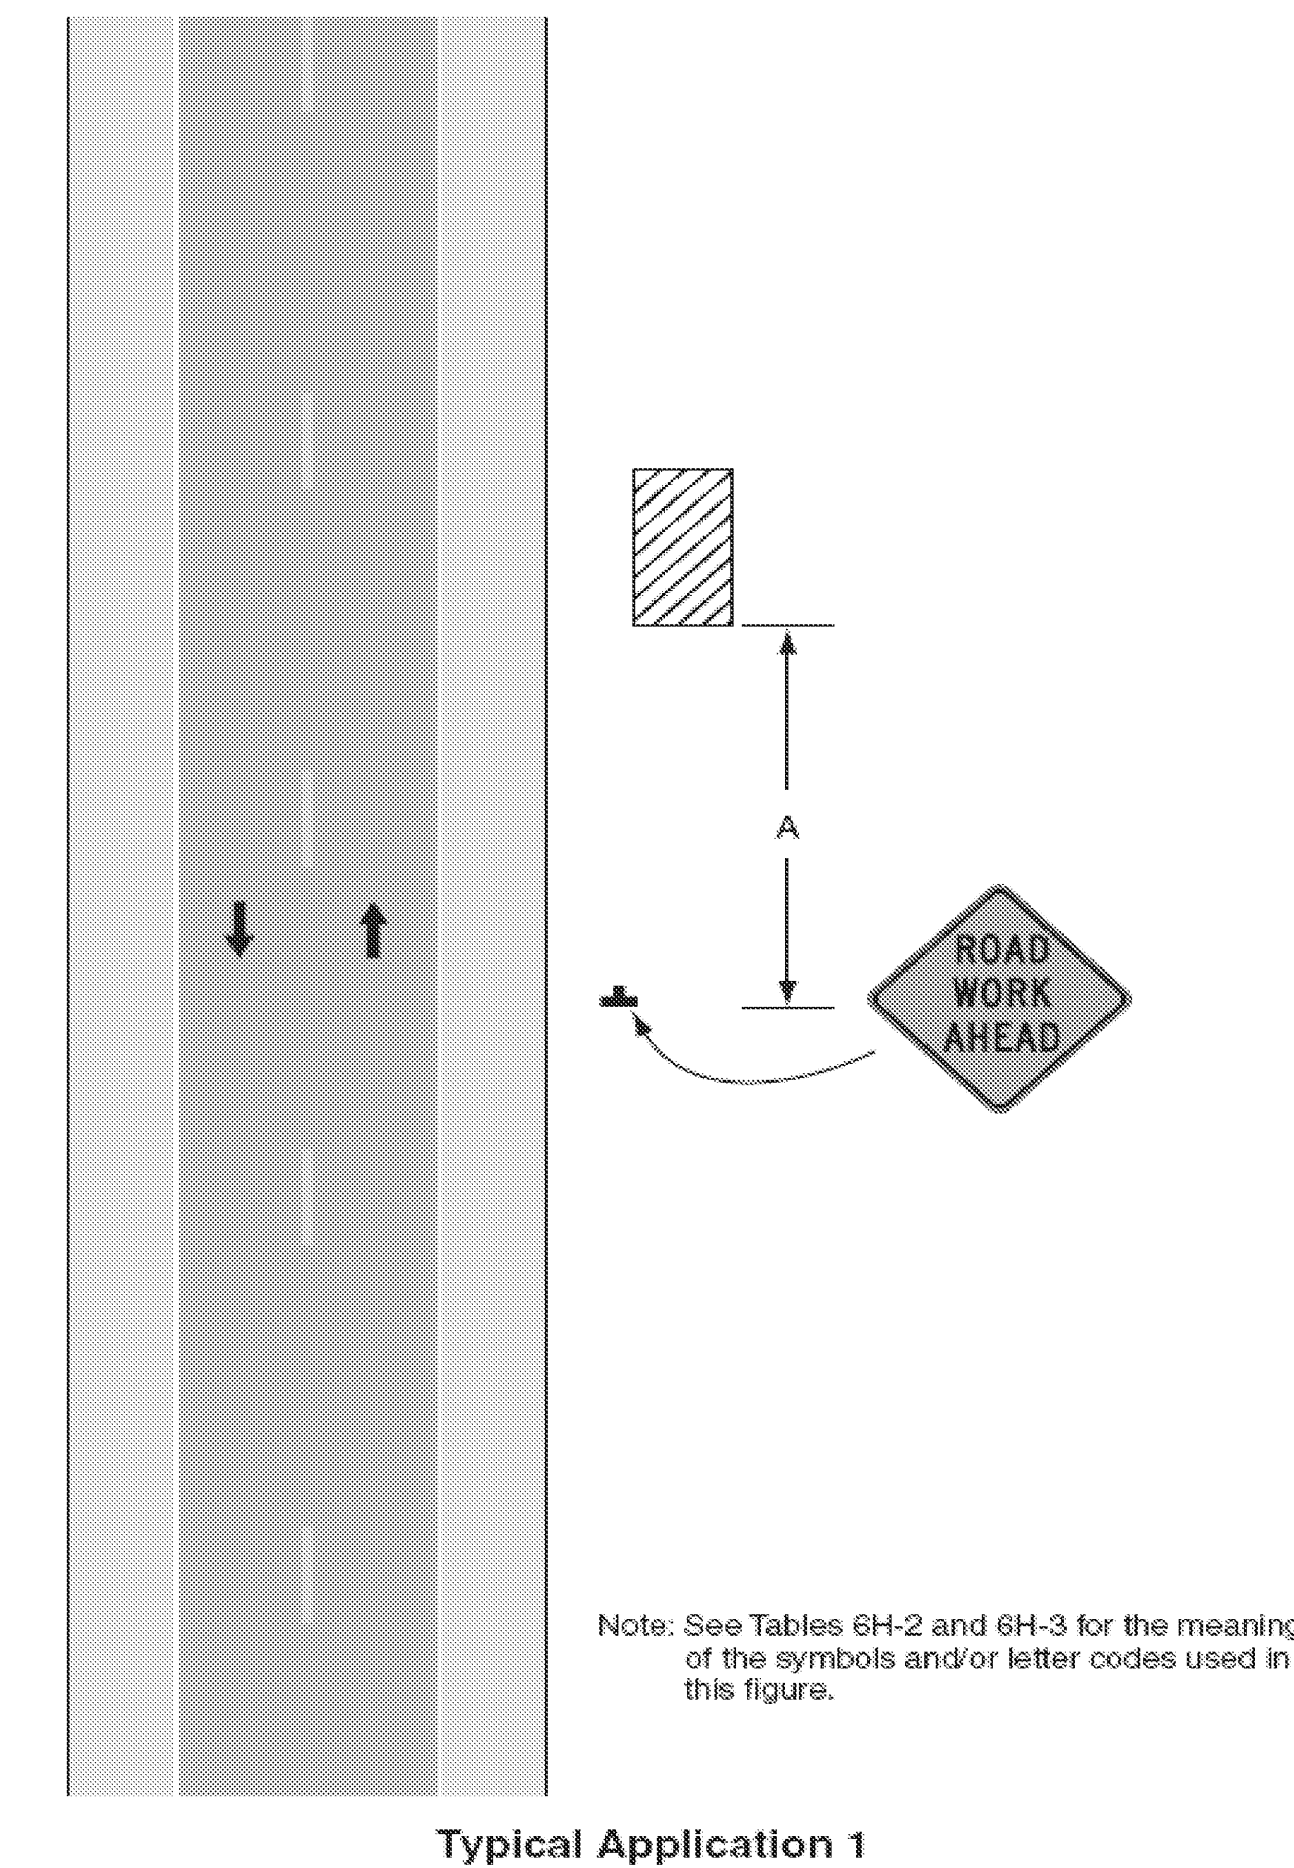


Table 6C-3. Taper Length Criteria for Temporary Traffic Control Zones


Type of Taper	Taper Length (L)*
Merging Taper	at least L
Shifting Taper	at least 0.5L
Shoulder Taper	at least 0.33L
One-Lane, Two-Way Traffic Taper	30 m (100 ft) maximum
Downstream Taper	30 m (100 ft) per lane

Table 6H-3. Meaning of Letter Codes on Typical Application Diagrams

Road Type	Distance Between Signs**		
	A	B	C
Urban (low speed)*	30 (100)	30 (100)	30 (100)
Urban (high speed)*	100 (350)	100 (350)	100 (350)
Rural	150 (500)	150 (500)	150 (500)
Expressway / Freeway	300 (1,000)	450 (1,500)	800 (2,640)

* Speed category to be determined by highway agency
 ** Distances are shown in meters (feet). The column headings A, B, and C are the dimensions shown in Figures shown on the Traffic Control Detail Sheets. The A dimension is the distance from the transition or point of restriction to the first sign. The B dimension is the distance between the first and second signs. The C dimension is the distance between the second and third signs. (The third sign is the first one in a three-sign series encountered by a driver approaching a TTC zone.)

Figure 6F-7. Channelizing Devices (Sheet 1 of 2)

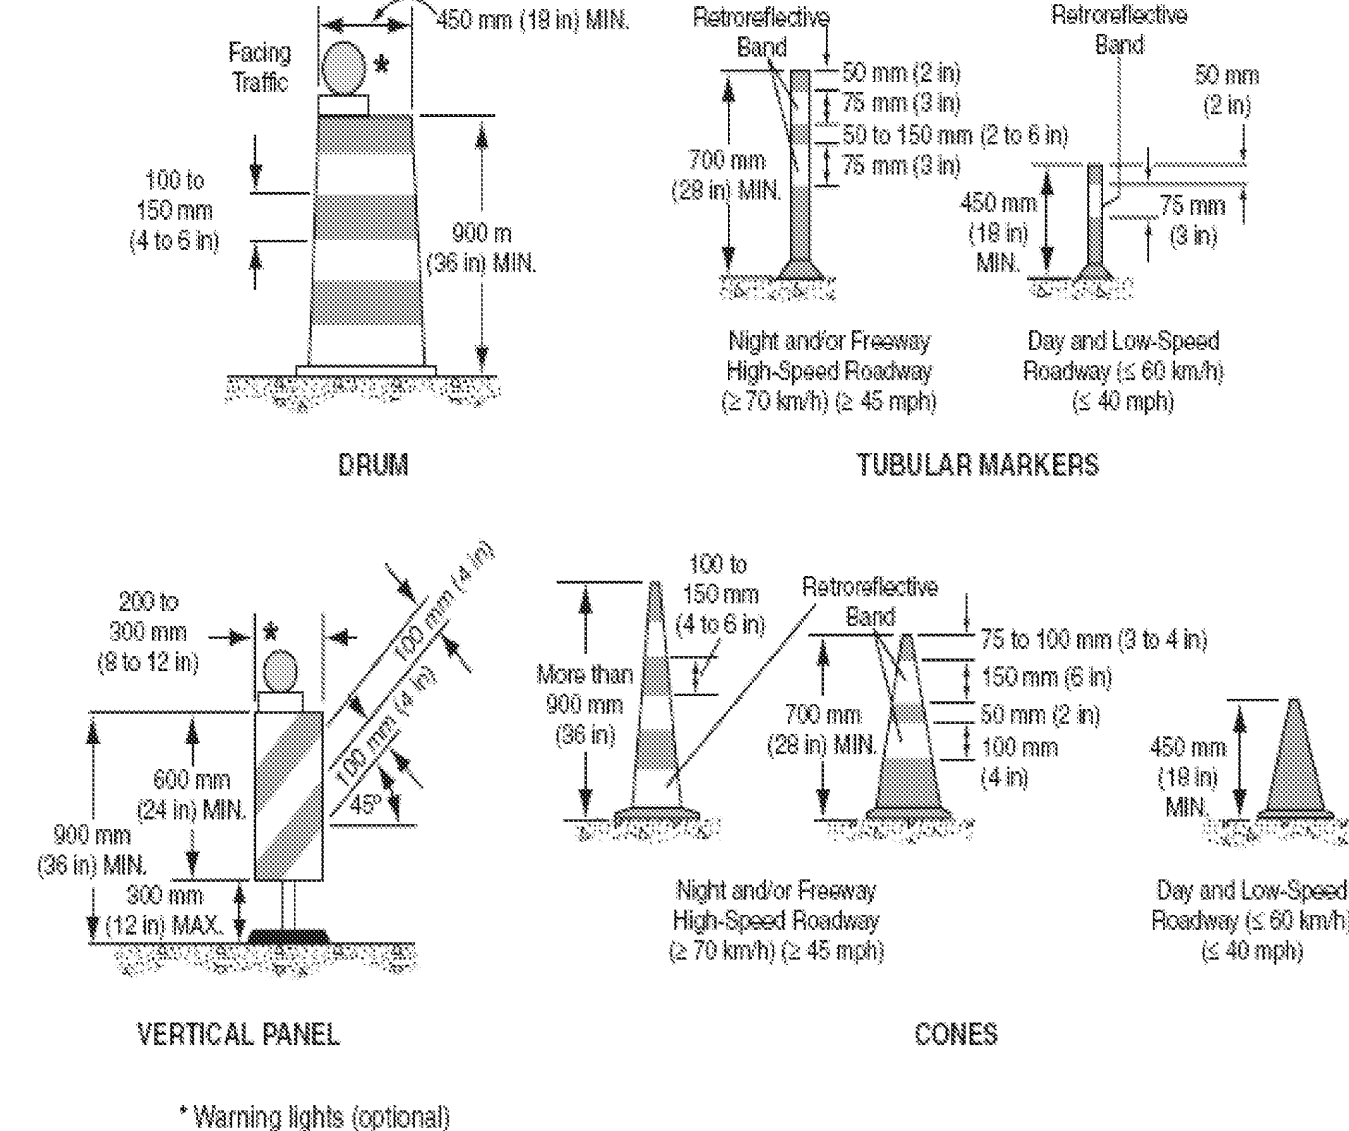

Note: If drums, cones, or tubular markers are used to channelize pedestrians, they shall be located such that there are no gaps between the bases of the devices, in order to create a continuous bottom, and the height of each individual drum, cone, or tubular marker shall be no less than 900 mm (36 in) to be detectable to users of long canes.

Table 6C-4. Formulas for Determining Taper Lengths

Speed Limit (S)	Taper Length (L) Meters	Speed Limit (S)	Taper Length (L) Feet
60 km/h or less	$L = \frac{WS^2}{155}$	40 mph or less	$L = \frac{WS^2}{60}$
70 km/h or more	$L = \frac{WS}{1.6}$	45 mph or more	$L = WS$

Where: L = taper length in meters (feet)

W = width of offset in meters (feet)

S = posted speed limit, or off-peak 85th-percentile speed prior to work starting, or the anticipated operating speed in km/h (mph)

TEMPORARY TRAFFIC CONTROL NOTES

- ALL TEMPORARY TRAFFIC CONTROL SHALL BE IN ACCORDANCE WITH THESE PROJECT PLANS, APPLICABLE VTRANS E-SERIES STANDARD DRAWINGS, AND THE MANUAL ON UNIFORM TRAFFIC CONTROL DEVICES (MUTCD), DATED 2003, AND ITS LATEST REVISIONS, OR AS DIRECTED BY THE RESIDENT ENGINEER. IF THE CONTRACTOR DOES NOT WISH TO FOLLOW THE TEMPORARY TRAFFIC CONTROL PROVIDED, HE/SHE MAY SUBMIT AN ALTERNATE PROPOSAL AT THE PRE-CONSTRUCTION MEETING IMPLEMENTING THE PROPOSED CHANGES FOR REVIEW AND APPROVAL BY THE RESIDENT ENGINEER.
- THE CONTRACTOR MUST PROVIDE ACCESS THROUGH THE WORK ZONE FOR EMERGENCY VEHICLES AT ALL TIMES.
- THE CONTRACTOR SHALL CONDUCT THE WORK AT ALL TIMES IN SUCH A MANNER AND IN SUCH SEQUENCE SO AS TO ENSURE THE LEAST INTERFERENCE WITH TRAFFIC OCCURS.
- SIGNS SHALL ONLY BE VISIBLE TO MOTORIST AT THE TIMES WHEN THE MESSAGE IS PERTINENT, I.E. A 'FLAGGER AHEAD' SIGN SHALL ONLY BE VISIBLE TO MOTORIST WHEN THE FLAGGER IS ACTUALLY PRESENT PERFORMING THEIR DUTIES.
- PAYMENT FOR CONSTRUCTION SIGNING WILL BE MADE UNDER CONTRACT ITEM 641.10.


PROJECT NAME: LUDLOW - WAITSFIELD

PROJECT NUMBER: STPG SIGN (27)

FILE NAME: 09B058_TS.DGN
 PROJECT LEADER: N. AVERY
 DESIGNED BY: N. AVERY
 TRAFFIC CONTROL I


PLOT DATE: 16-SEP-2009
 DRAWN BY: N. AVERY
 CHECKED BY: A. GAMBLE
 SHEET 203 OF 204

Figure 6H-3. Work on Shoulders (TA-3)

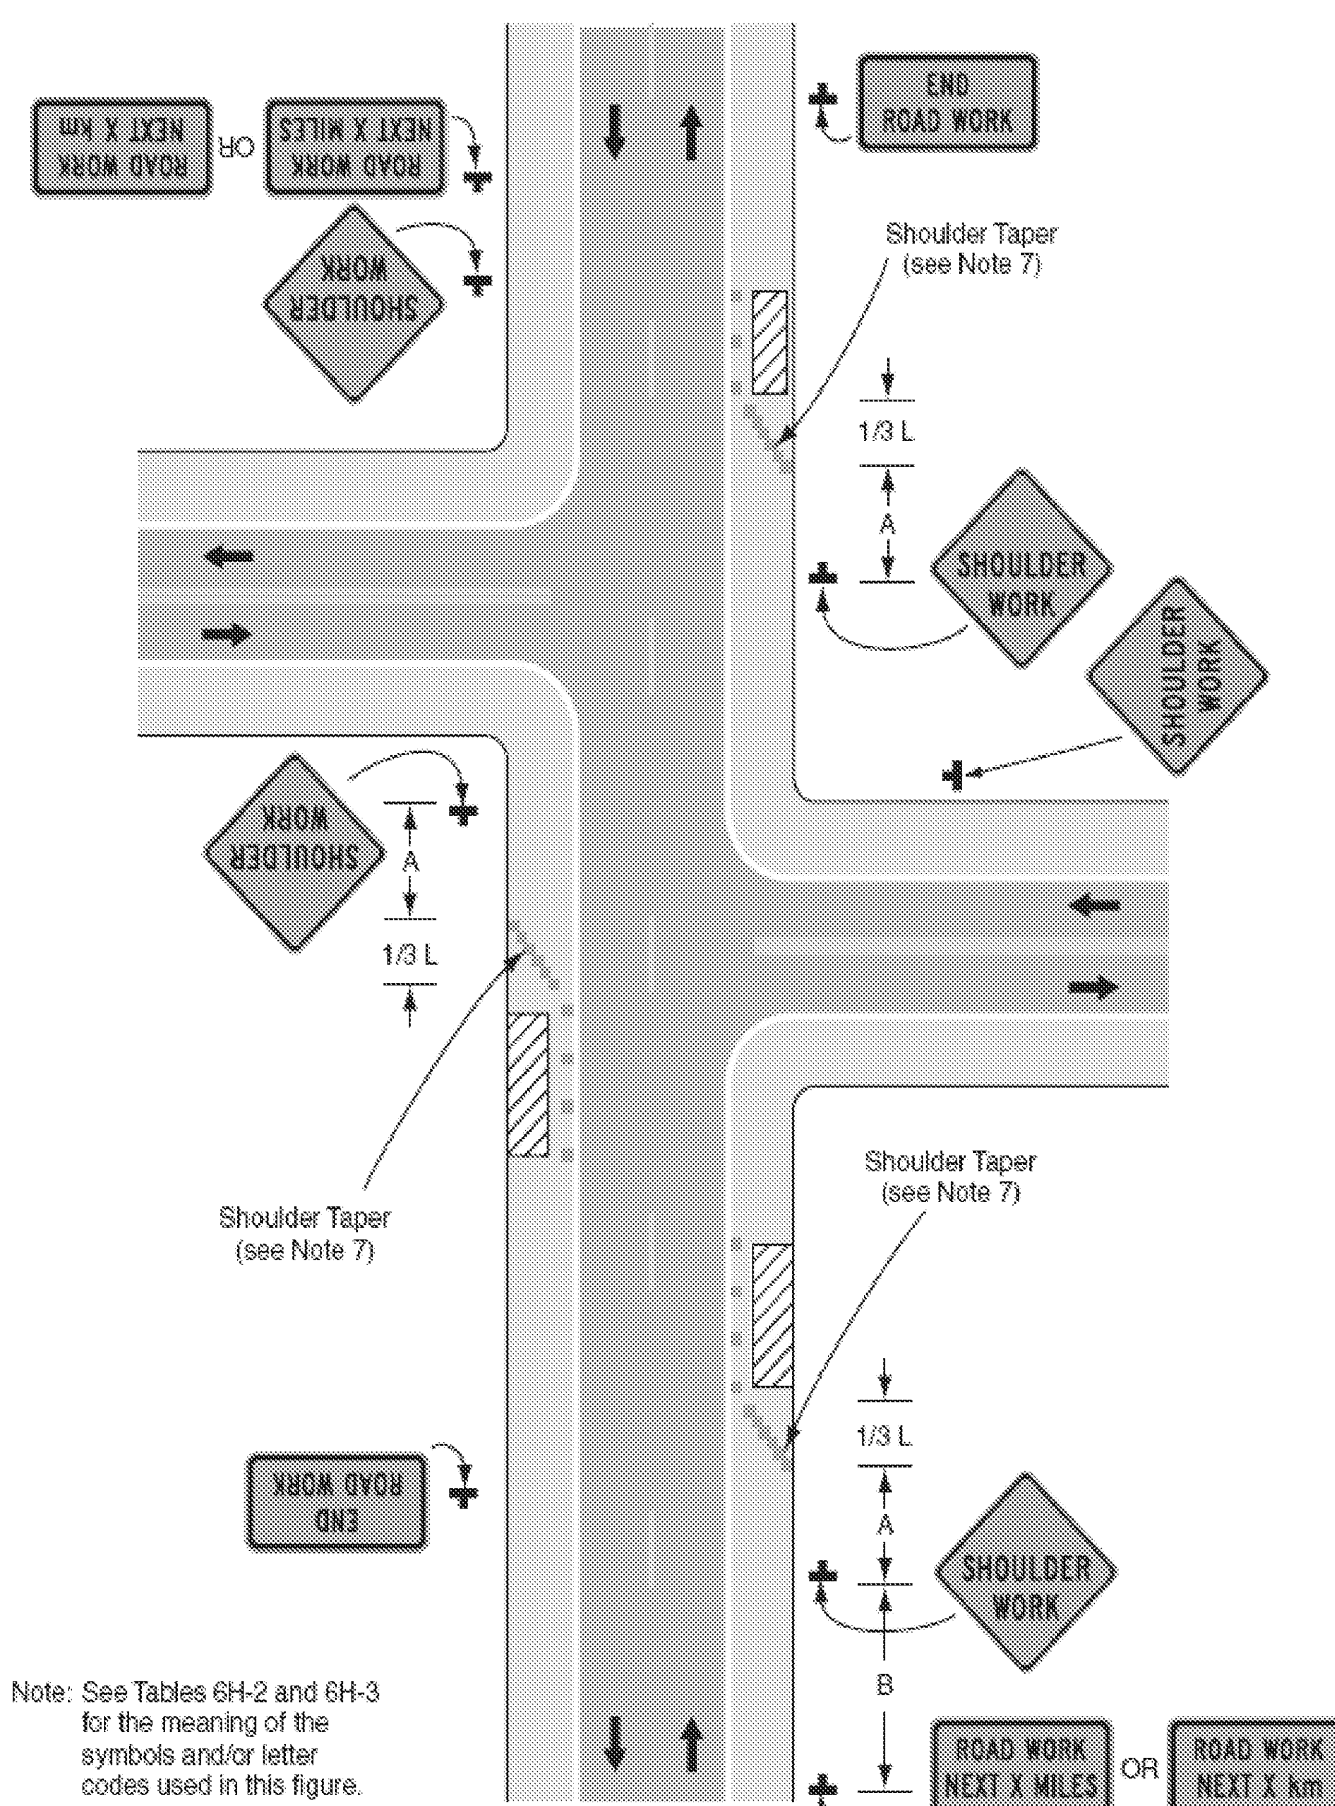


Typical Application 3

Figure 6H-4. Short-Duration or Mobile Operation on Shoulder (TA-4)

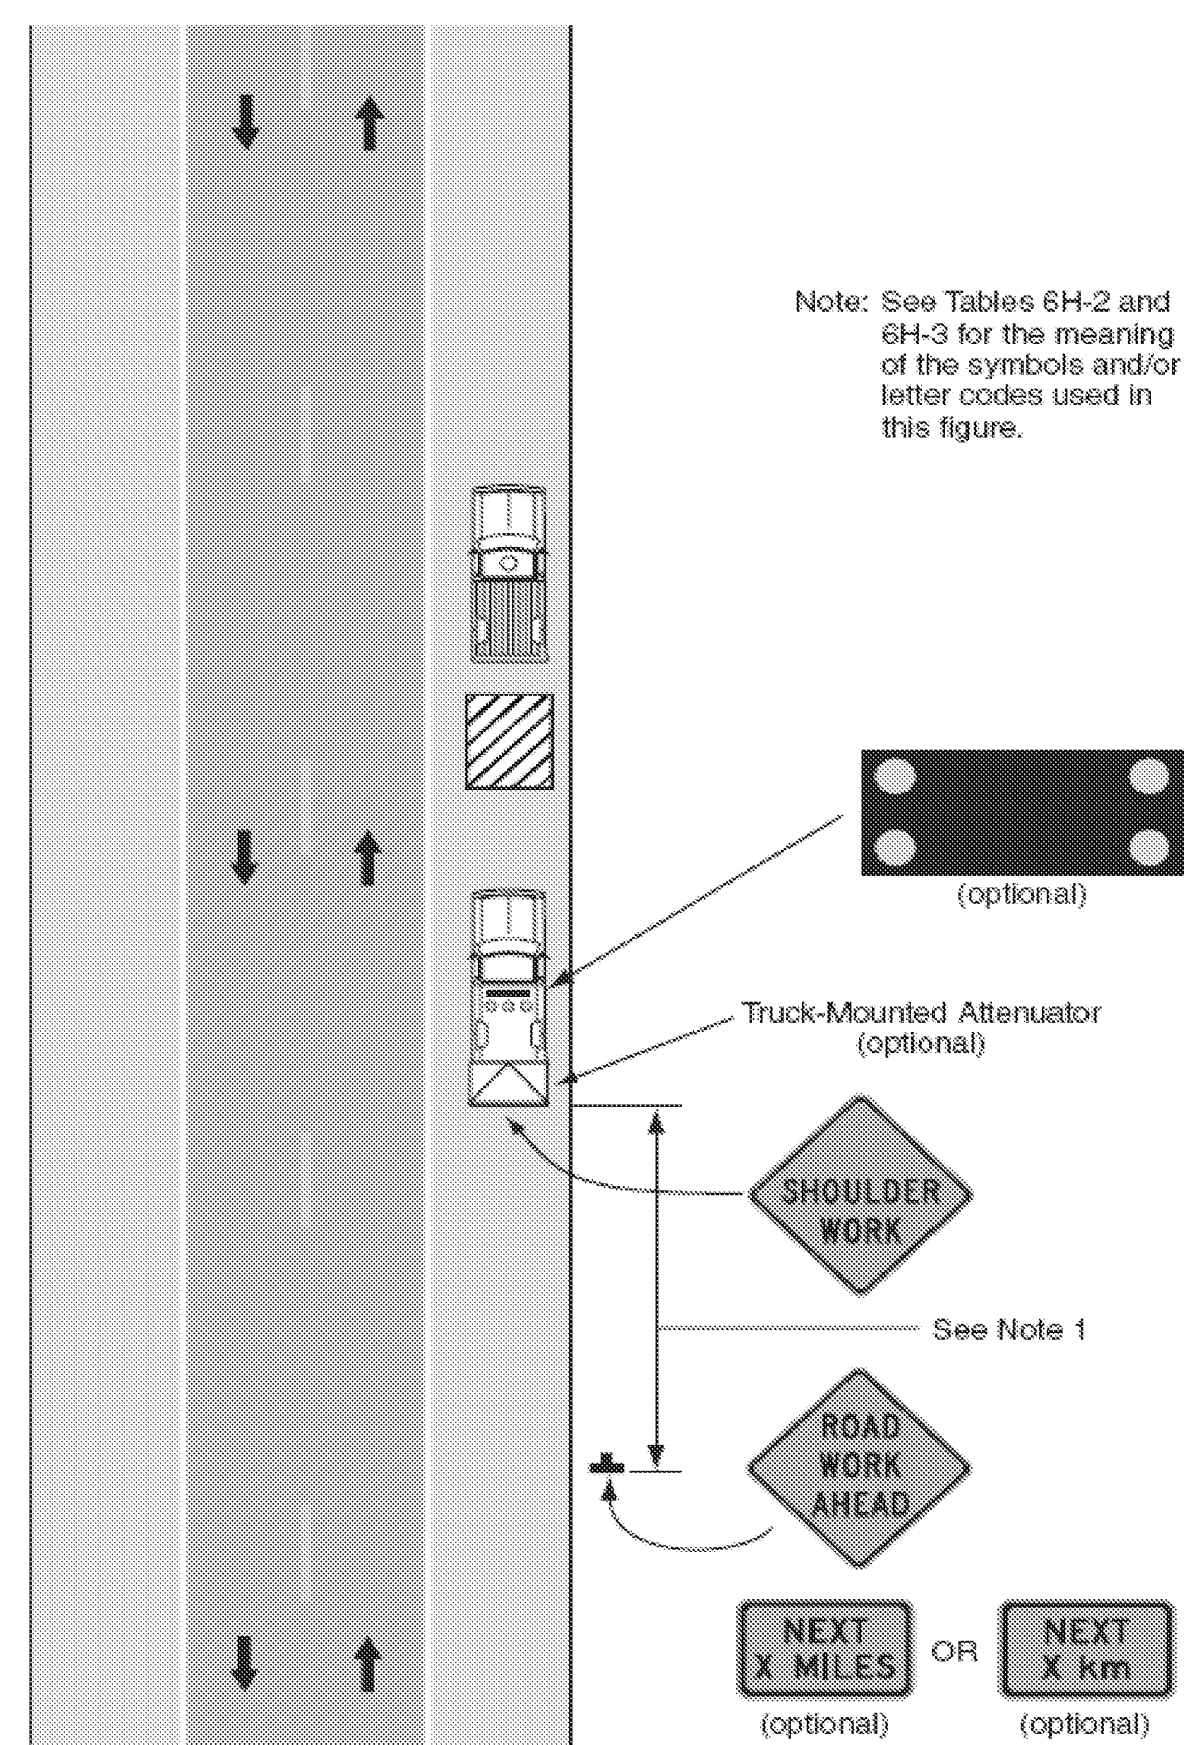


Typical Application 4

Figure 6H-6. Shoulder Work with Minor Encroachment (TA-6)

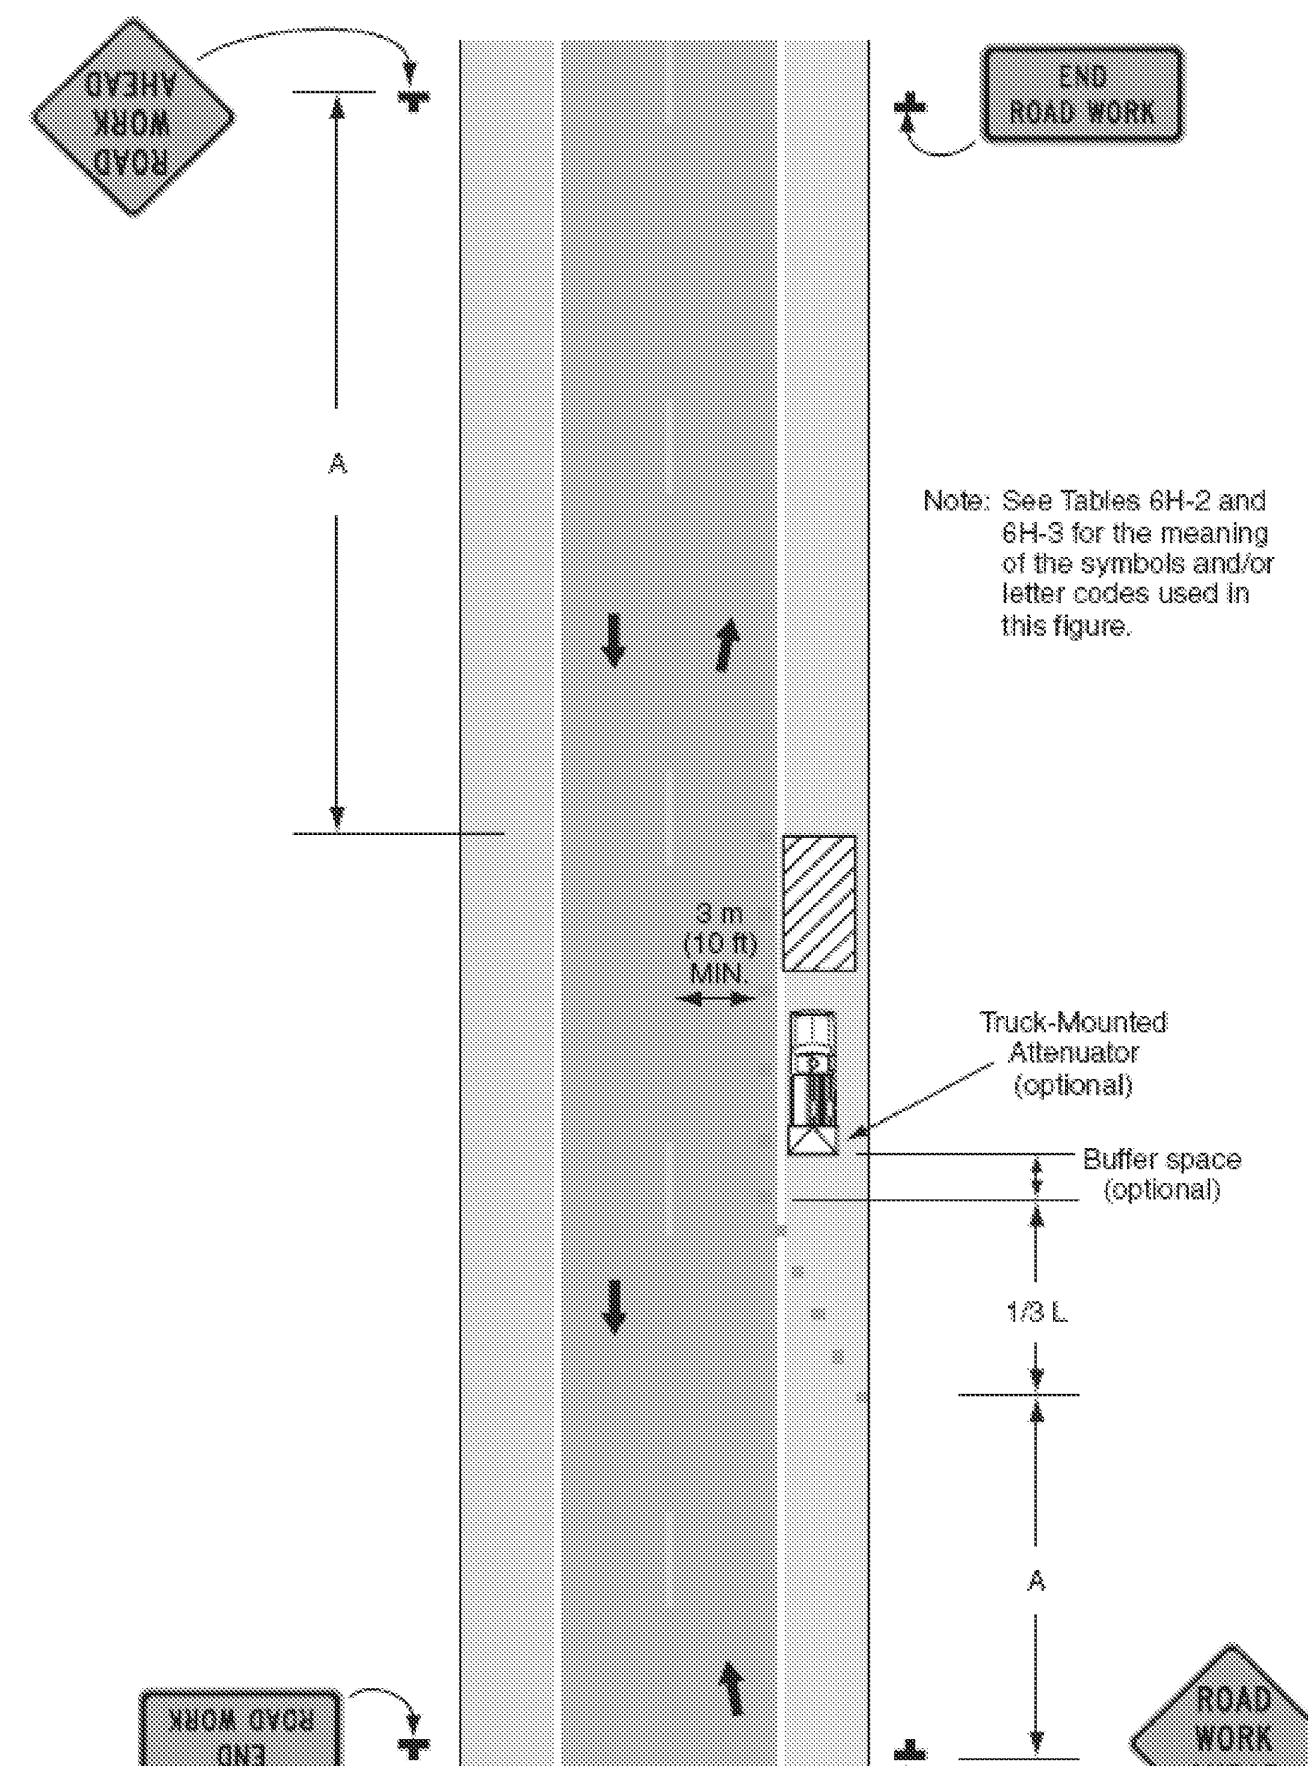

Typical Application 6

Figure 6H-10. Lane Closure on Two-Lane Road Using Flaggers (TA-10)

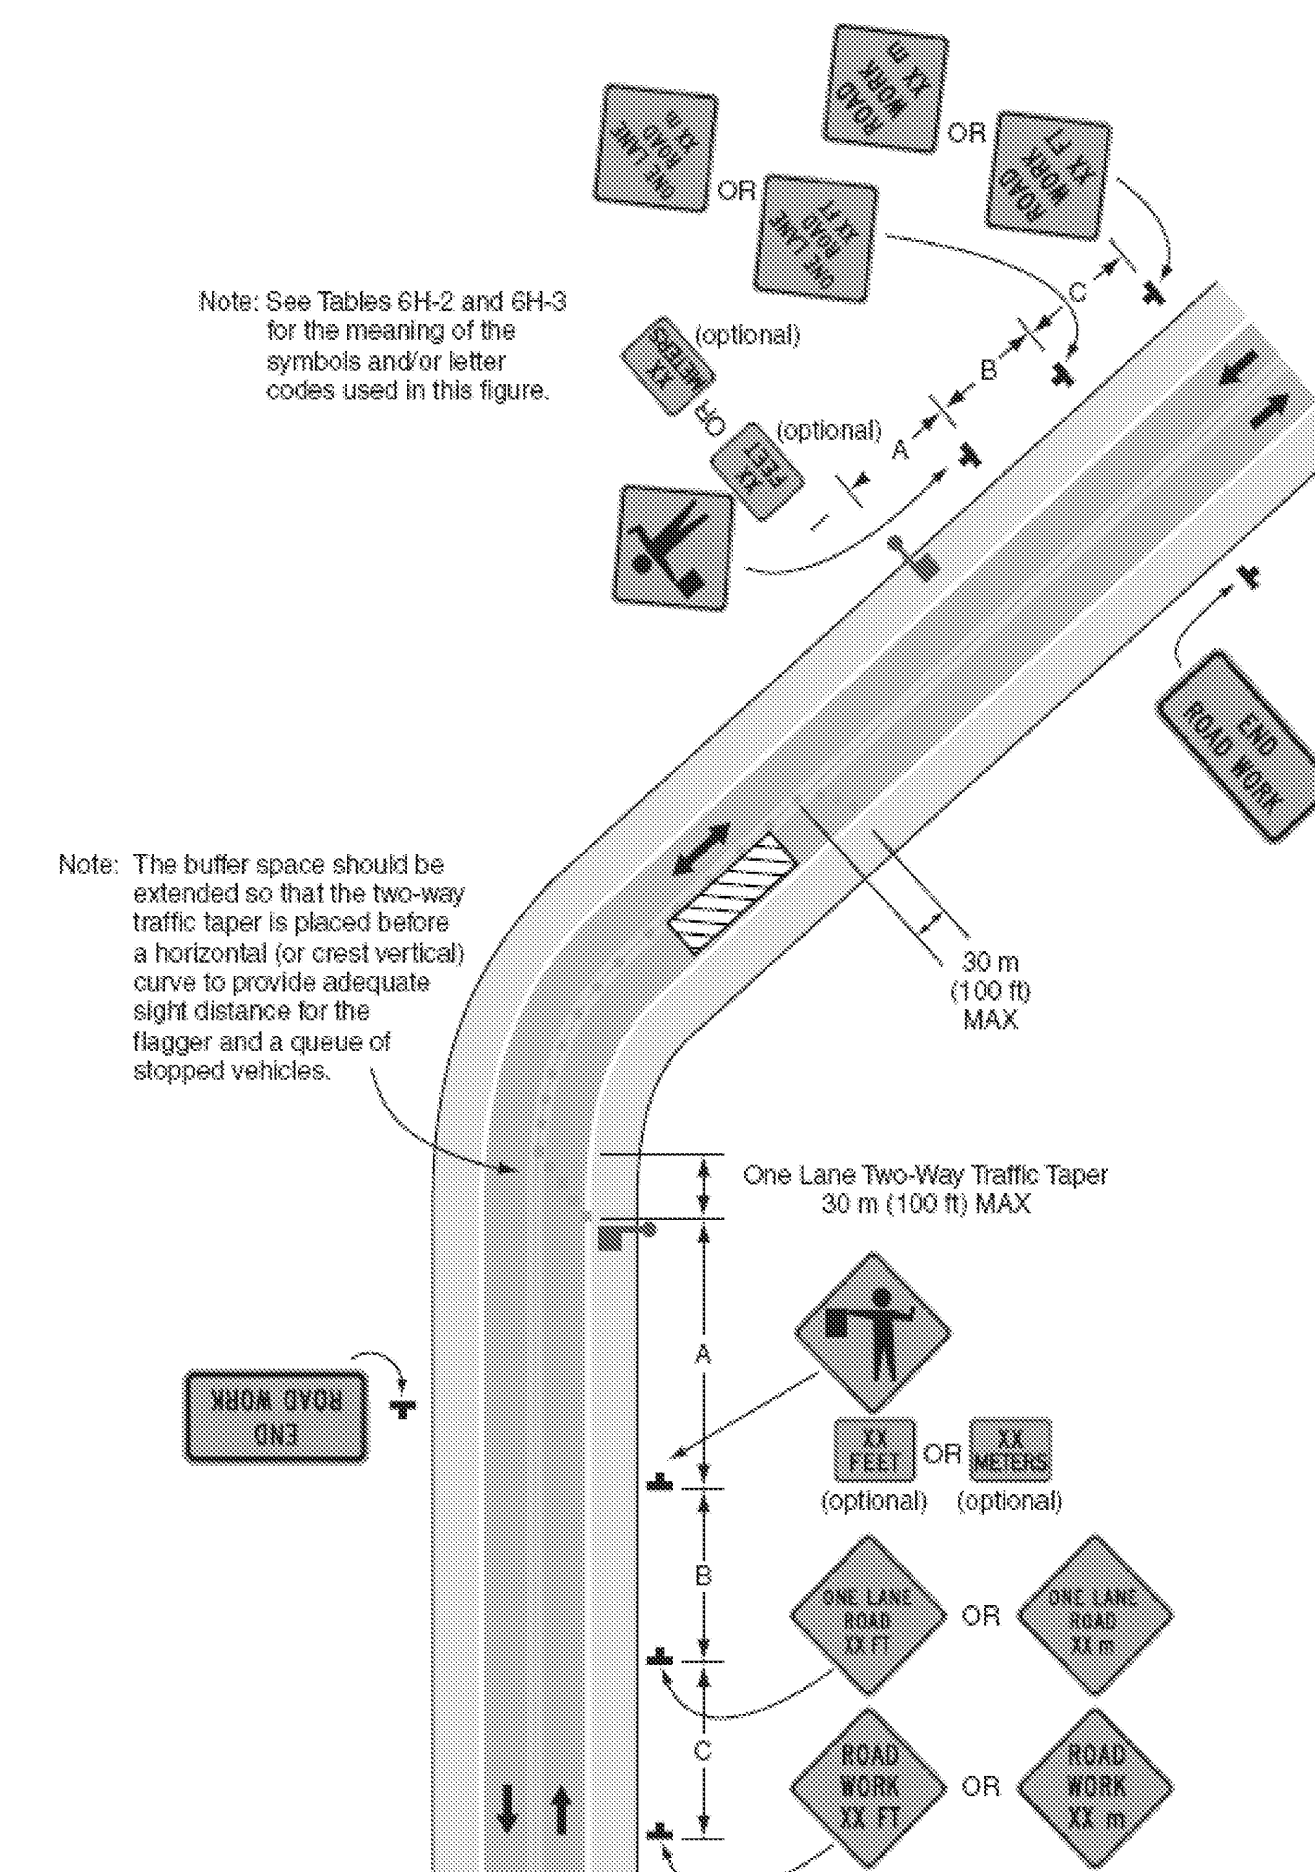

Typical Application 10

PROJECT NAME: LUDLOW - WAITSFIELD

PROJECT NUMBER: STPG SIGN (27)

FILE NAME: 09B058_TS.DGN

PROJECT LEADER: N. AVERY

DESIGNED BY: N. AVERY

TRAFFIC CONTROL 2

PLOT DATE: 16-SEP-2009

DRAWN BY: N. AVERY

CHECKED BY: A. GAMBLE

SHEET 204 OF 204