
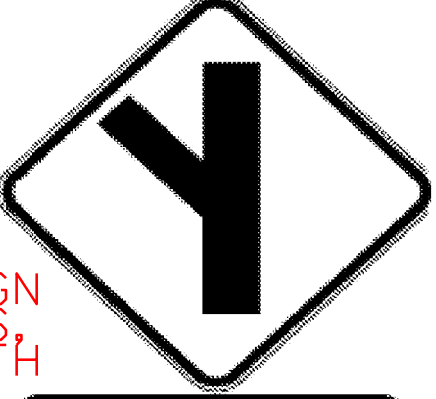

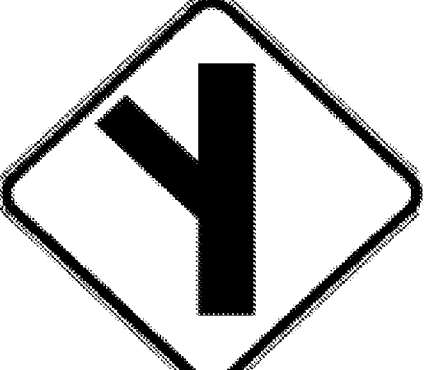

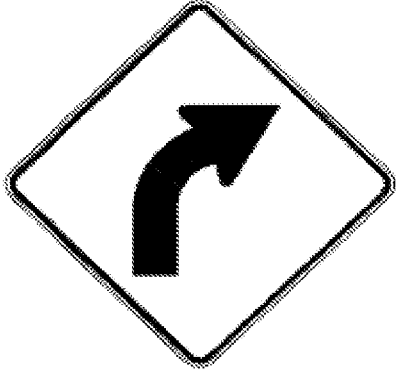

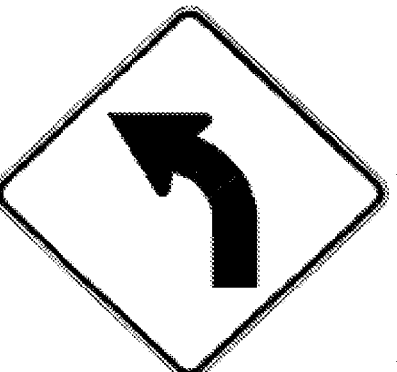



DIRECTION	MILEPOINT	LOCATION CODE (SHEET 2)	SIGN CODE	WIDTH (IN)	HEIGHT (IN)	SHEETING REMARKS	SIGN LEGEND	NEW SIGNS		EXISTING SIGNS				EXIST POST		NUMBER OF NEW POSTS	SQUARE STEEL (IN)			TUBULAR STEEL Ø (IN)				SIGN FRAME REQUIRED	REMARKS	SIGN DETAIL			
								"A"	"B"	RETAIN	SALVAGE FROM	SALVAGE TO	REMOVE	RETAIN	REMOVE		1.75	2.00	2.50	FOUNDATION	3.00	3.50	4.00			5.00	DETAIL IN SHS	DETAIL ON SHEET NUMBER	DETAIL ON STD SHEET NUMBER
																	(LB / FT)				(LB / FT)								
ROCHESTER VT 100							FY-FLUORESCENT YELLOW FYG-FLUORESCENT YELLOW GREEN																"SHS"-STANDARD HIGHWAY SIGNS						
SB	1.844	F	R2-1	24	30																								
		F	R2-1	24	30			5.00																X					
SB	1.570	F	W2-3MaL W2-3MaR	30	30			+6.25 6.25																	6				
		F	W16-8	30	8			1.67																	8				
SB	1.118	F	W2-3MaL	30	30		LEFT ANGLED SIDE ROAD 																						
SB	1.095	F	W2-3MaL	30	30			6.25																	6				
		F	W16-8	30	8			1.67																	8				
SB	0.768	F	W1-2R	30	30		RIGHT CURVE 																						
SB	0.720	F	W1-2R	30	30			6.25																	X				
		F	W13-1	18	18			2.25															X						
SB	0.440	F	W1-2L	30	30																								
		F	W13-1	18	18																								
SB	0.390	F	W1-2L	30	30	FY		6.25																	X				
		F	W13-1	18	18	FY		2.25															X						
SB	0.355	F	W1-6	48	24																								
SIGN SUMMARY SHEET							SHEET TOTALS	44.09 37.84	0.00	0	0	0	6	0	0	5	75						PROJECT NAME: Ludlow-Waitsfield VT100						
								SF	SF	EA	EA	EA	EA	EA	EA	EA	FT						PROJECT NUMBER: STPG SIGN(27)						
VERMONT AGENCY OF TRANSPORTATION							TOWN TOTALS	593.8	0.0	60.0	9.0	9.0	115	0.0	0.0	102	1530.0						FILE NAME: Rochester.xls	PLOT DATE: 9/10/2009					
																							PROJECT MANAGER: N. Avery	DRAWN BY: I. Shea					
																							DESIGNED BY: J. Kelly	CHECKED BY: N. Avery					
																							ROCHESTER SHEET 20	SHEET 120 OF 204					