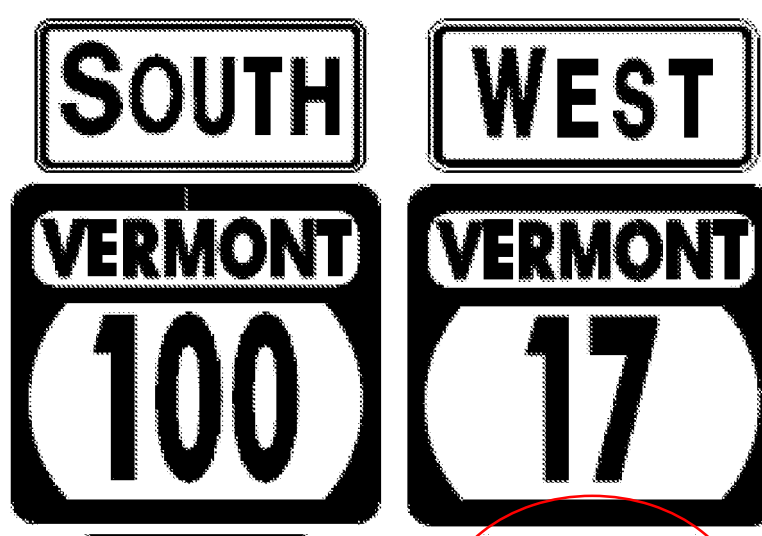
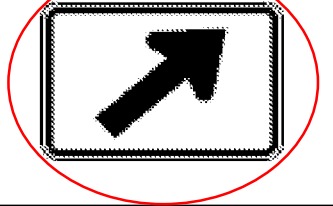
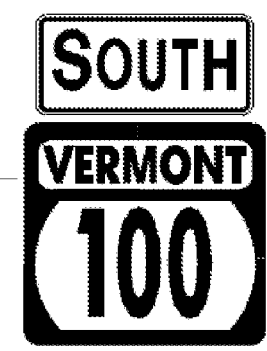


DIRECTION	MILEPOINT	LOCATION CODE (SHEET 2)	SIGN CODE	WIDTH (IN)	HEIGHT (IN)	SHEETING REMARKS	SIGN LEGEND	NEW SIGNS		EXISTING SIGNS				EXIST POST		NUMBER OF NEW POSTS	SQUARE STEEL (IN)			TUBULAR STEEL Ø (IN)				SIGN FRAME REQUIRED	REMARKS	SIGN DETAIL			
								"A"	"B"	RETAIN	SALVAGE FROM	SALVAGE TO	REMOVE	RETAIN	REMOVE		1.75	2.00	2.50	FOUNDATION	3.00	3.50	4.00			5.00	DETAIL IN SHS	DETAIL ON SHEET NUMBER	DETAIL ON STD SHEET NUMBER
																	(LB / FT)				(LB / FT)								
WAITSFIELD VT 100							FY-FLUORESCENT YELLOW FYG-FLUORESCENT YELLOW GREEN															"SHS"-STANDARD HIGHWAY SIGNS							
		F	M3-3	24	12			2.00							2							#2A	GREEN ON WHITE SHEETING	X					
		F	M1-5	30	24			5.00																	E-136B				
		F	M6-2	21	15			2.19															GREEN ON WHITE SHEETING	X					
		F	M3-4	24	12			2.00															GREEN ON WHITE SHEETING	X					
		F	M1-5	24	24			4.00															SIGN INCORRECT. REORDERED NEW, +2.19 SF			E-136B			
		F	M5-2R M6-3	21	15		 M5-2R	+2.19 2.19															GREEN ON WHITE SHEETING	X					
SB	2.630	H	R1-1	30	30		STOP			1			X																
		G	OM1-1	18	18		OBJECT MARKER (ON BACK)			1																			
SB	2.600	H	R1-1	30	30		STOP			1			X										FACES EB VT-17 TRAFFIC AT THE SOUTHERLY APPROACH						
SB	2.569	F	M3-3	24	12			2.00							1		X						GREEN ON WHITE SHEETING	X					
		F	M1-5	30	24			5.00															INSTALL 50 FT± NORTH OF THE EXISTING ROUTE MARKERS, WHICH WILL BE REMOVED			E-136B			
SB	2.560	F	M3-3	24	12		SOUTH						1				X						BEHIND CABLE RAIL						
		F	M1-5	30	24		VERMONT 100						1																
SB	2.525	F	D2-1	72	12		WARREN 5			1			X																
		F	D1-1S	72	12		SUGARBUSH SKI AREA 6			1																			
SIGN SUMMARY SHEET							SHEET TOTALS	26.57 24.38	0.00	5	0	0	2	0	0	3	45					PROJECT NAME: Ludlow-Waitsfield VT100							
							SF	SF		EA	EA	EA	EA	EA	EA	EA	FT					PROJECT NUMBER: STPG SIGN(27)							
VERMONT AGENCY OF TRANSPORTATION							TOWN TOTALS	684.6	0.0	99.0	18.0	18.0	141	0.0	0.0	129	1935.0					FILE NAME: Waitsfield.xls	PLOT DATE: 9/15/2009						
																						PROJECT MANAGER: N. Avery	DRAWN BY: I. Shea						
																						DESIGNED BY: M. Miller	CHECKED BY: N. Avery						
																						WAITSFIELD SHEET 25	SHEET 198 OF 204						