

# STATE OF VERMONT AGENCY OF TRANSPORTATION



## PROPOSED IMPROVEMENT TOWNS OF MORETOWN - NEWPORT COUNTIES OF WASHINGTON, LAMOILLE AND ORLEANS VERMONT ROUTE 100

BEGINNING AT THE WAITSFIELD-MORETOWN TOWN LINE ON VT ROUTE 100 IN THE TOWN OF MORETOWN AT MILE MARKER 0.000 AND EXTENDING NORTHERLY ALONG VT ROUTE 100 FOR A DISTANCE OF 62.359 MILES TO THE END OF VT ROUTE 100 AT THE INTERSECTION OF VT ROUTE 100, VT ROUTE 105 AND VT ROUTE 14 IN THE TOWN OF NEWPORT AT MILE MARKER 4.211, EXCLUDING CLASS I SECTIONS WITHIN THE PROJECT CORRIDOR.


LENGTH OF ROADWAY = 61.132 MILES  
LENGTH OF PROJECT = 58.753 MILES

WORK TO BE PERFORMED UNDER THIS PROJECT INCLUDES THE REMOVAL OF EXISTING SIGNS & POSTS AND THE INSTALLATION OF SIGNS & SIGN POSTS AND OTHER RELATED ITEMS.


INDEX OF SHEETS  
SEE SHEET 2

### RECORD PLANS

CONTRACTOR:	F. R. LAFAYETTE, INC. - ESSEX JUNCTION, VT
RESIDENT ENGINEER:	JEFF COTA
CONSTRUCTION BEGAN:	APRIL 12, 2010
CONSTRUCTION COMPLETE:	JULY 5, 2010
RECORD PLANS BY:	JEFF COTA & SANDRA SCHMITT
I HEREBY CERTIFY THAT ALL THE CONSTRUCTION REQUIRED BY THIS SET OF DRAWINGS HAS BEEN ACCOMPLISHED AS INDICATED HEREIN.	
BY	RESIDENT ENGINEER
DATE	10/30/13
NOTE: Any further information concerning final quantities, amounts or other details relative to this project may be found at Central Files in the electronic archives.	

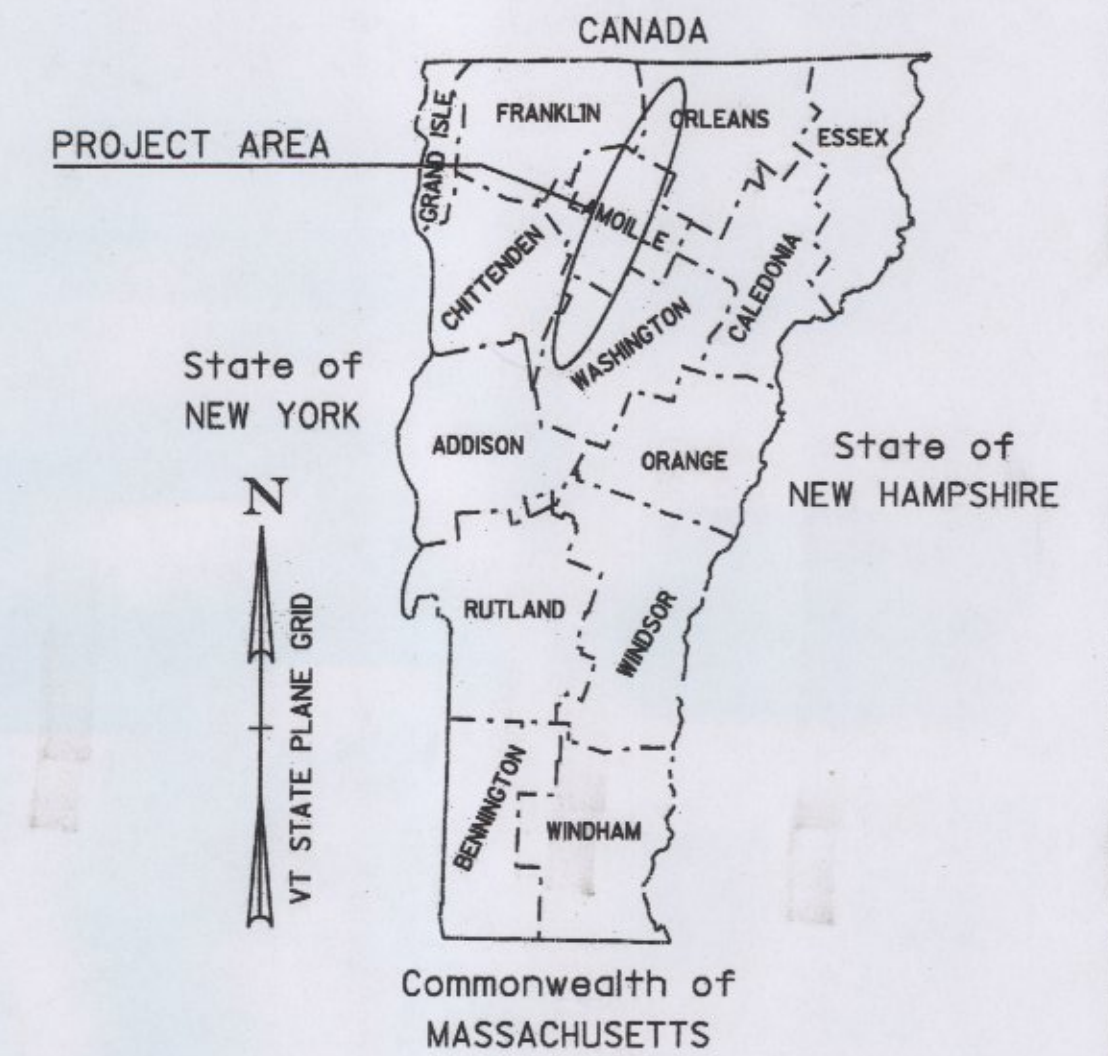

BEGIN PROJECT STPG SIGN (28)  
MORETOWN MM 0.000

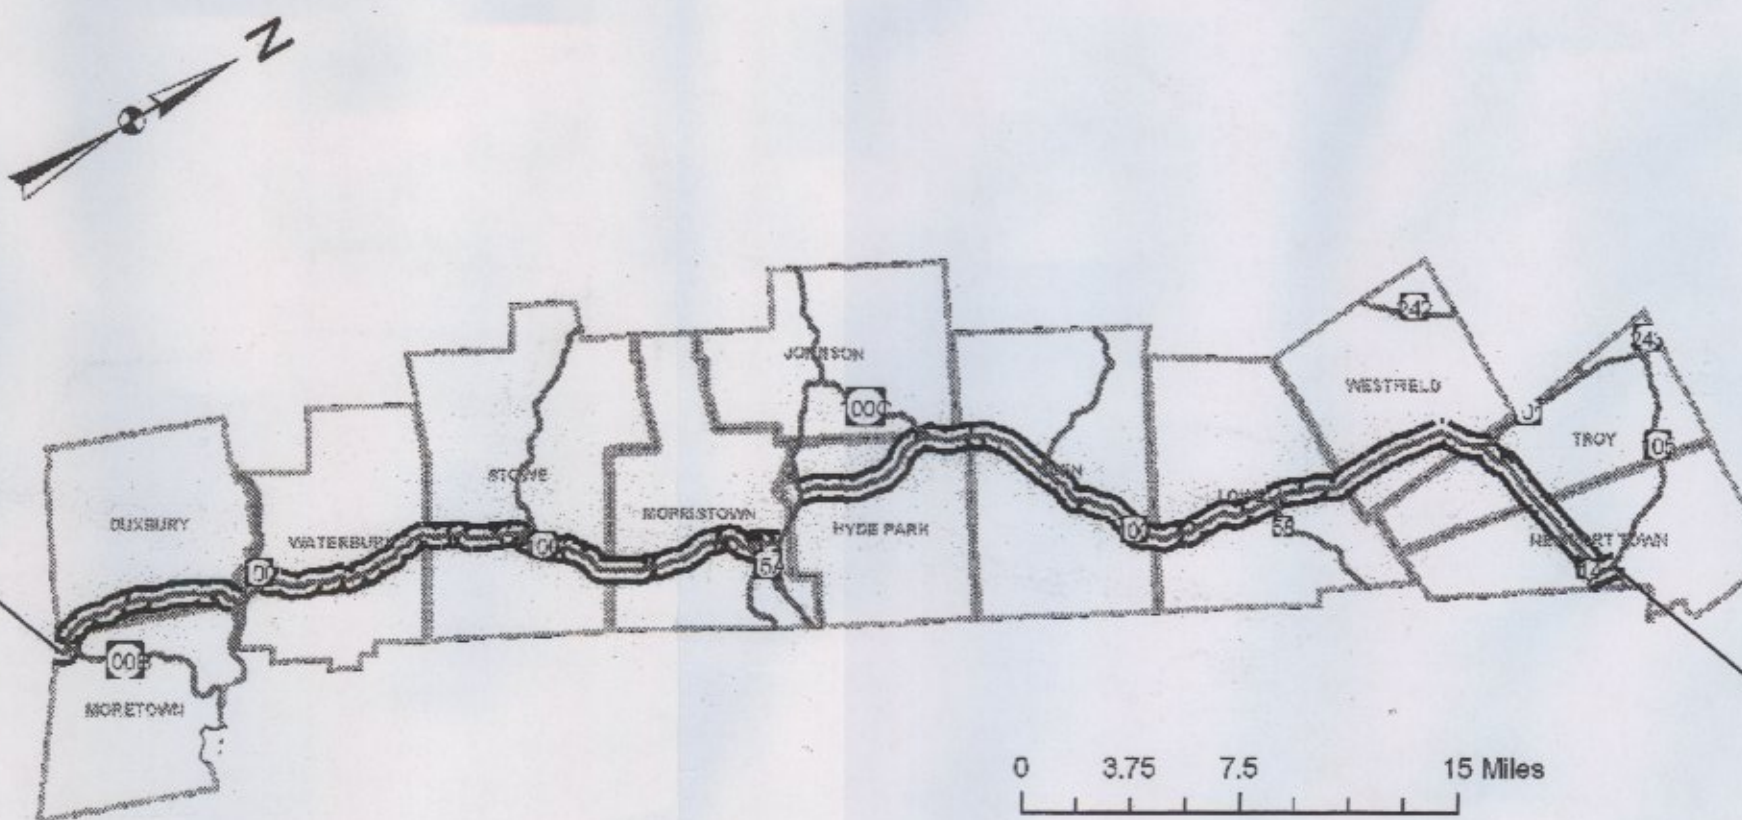

END PROJECT STPG SIGN (28)  
NEWPORT MM 4.211

### CONVENTIONAL SYMBOLS

COUNTY LINE	
TOWN LINE	
LIMITS OF ACCESS	
POINT OF ACCESS	
FENCE LINE	
STONE WALL	
TRAVELED WAY	
GUARD RAIL	
RAILROAD	
SURVEY LINE	
CULVERT	
POWER POLE	
TELEPHONE POLE	
TREES	
CONTROL OF ACCESS	
PROPERTY LINE	
R.O.W. TAKING LINE	
SLOPE RIGHTS	
TOP OF CUT	
TOE OF SLOPE	

SURVEYED BY : N/A  
SURVEYED DATE : N/A

DATUM  
VERTICAL N/A  
HORIZONTAL N/A

THESE PLANS ARE SUBJECT TO SUCH ENGINEERING CHANGES AS MAY BE REQUIRED BY THE FEDERAL HIGHWAY ADMINISTRATION OR THE DIRECTOR OF PROGRAM DEVELOPMENT.  
CONSTRUCTION IS TO BE CARRIED ON IN ACCORDANCE WITH THESE PLANS AND THE STANDARD SPECIFICATIONS FOR CONSTRUCTION DATED 2006, AS APPROVED BY THE FEDERAL HIGHWAY ADMINISTRATION ON JUNE 15, 2006 FOR USE ON THIS PROJECT, INCLUDING ALL SUBSEQUENT REVISIONS AND SUCH REVISED SPECIFICATIONS AND SPECIAL PROVISIONS AS ARE INCORPORATED IN THESE PLANS.

DIRECTOR OF PROGRAM DEVELOPMENT	
APPROVED	DATE 10/2/09
PROJECT MANAGER :	AMY GAMBLE
PROJECT NAME :	MORETOWN - NEWPORT TOWN
PROJECT NUMBER :	STPG SIGN (28)
SHEET 1 OF 166 SHEETS	