




1.5" RADIUS, 0.375" BORDER, 0.375" INDENT
 COLORS: LEGEND - BLACK
 BACKGROUND - YELLOW
 TEXT STYLE: B

* LATERAL SPACING TO OUTSIDE OF PANEL SHALL BE A MINIMUM OF 1.5"


W16-8

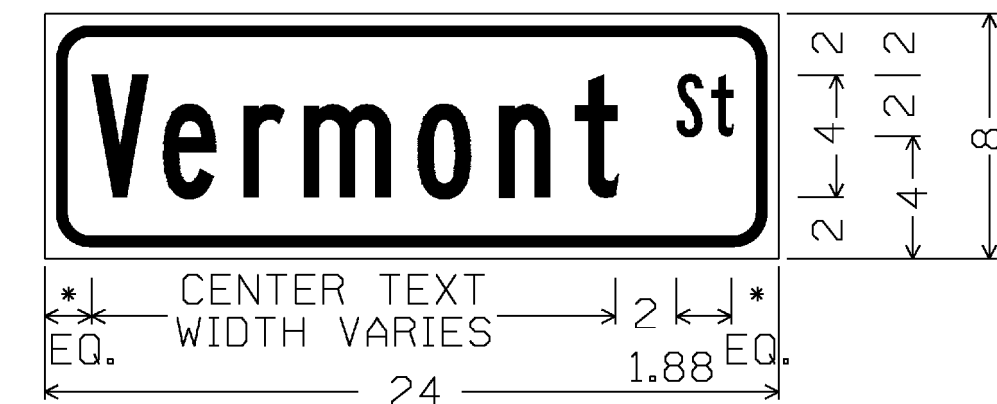

1.5" RADIUS, 0.375" BORDER, 0.375" INDENT
 COLORS: LEGEND - BLACK
 BACKGROUND - YELLOW
 TEXT STYLE: B


* LATERAL SPACING TO OUTSIDE OF PANEL SHALL BE A MINIMUM OF 1.5"

W16-8

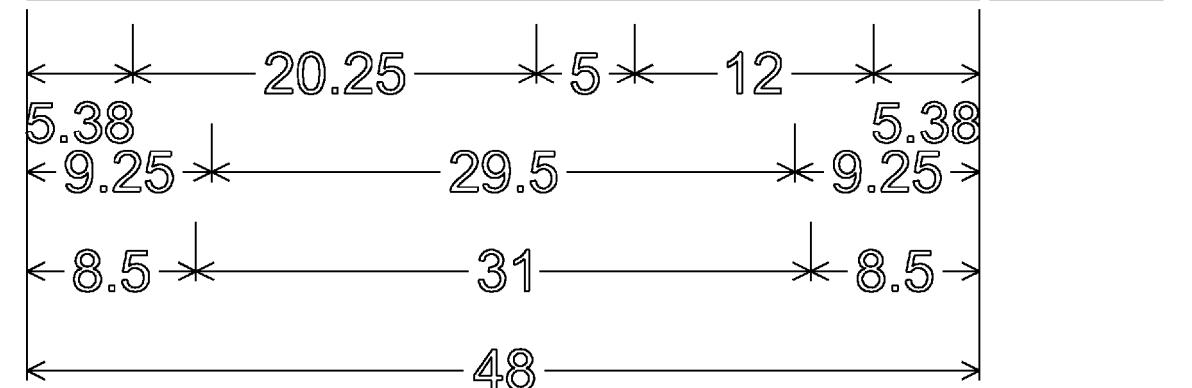

3.00" Radius, 1.00" Border, Black on White;
 "ROUTE FOR" D; "TRACTOR" D;
 "TRAILERS" D;

SIDE A

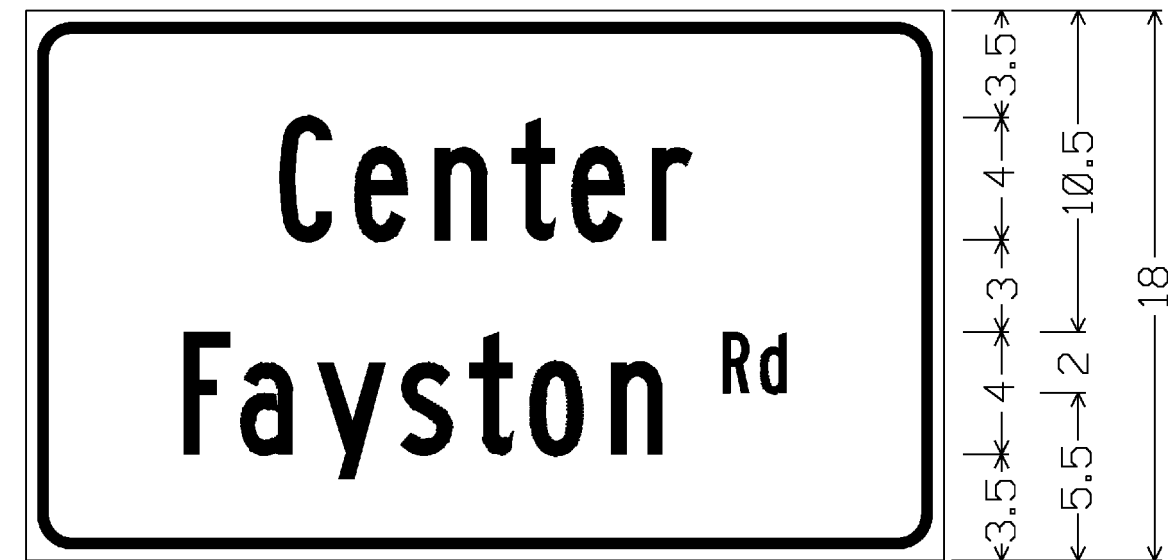


1.5" RADIUS, 0.375" BORDER, 0.375" INDENT
 COLORS: LEGEND - BLACK
 BACKGROUND - YELLOW
 TEXT STYLE: B

* LATERAL SPACING TO OUTSIDE OF PANEL SHALL BE A MINIMUM OF 1.5"

W16-8

ADVANCE STREET NAME WARNING SIGN PLAQUE NOTES:

- ALL ADVANCE STREET NAME PLAQUE SIGNS (W16-8 AND W16-8d) USED TO IDENTIFY THE NAME OF THE INTERSECTING STREETS SHALL HAVE INITIAL UPPER CASE LETTERS AND USED IN CONJUNCTION WITH LOWERCASE LETTERS (I.E. Main St, Foster Rd, East Ave, West Ln).

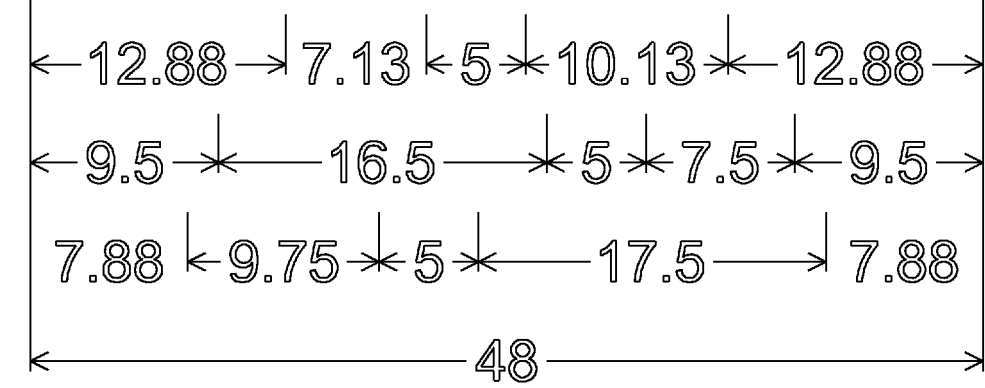

3.00" Radius, 1.00" Border, Black on White;
 "VT 108" D; "OPEN TO" D;
 "SKI AREA" D;



SIDE B





3" RADIUS, 0.75" BORDER, 0.50" INDENT
 COLORS: LEGEND - BLACK
 BACKGROUND - YELLOW
 TEXT STYLE: D STANDARD ARROW CUSTOM 6" WIDE X 4" HIGH

* LATERAL SPACING TO OUTSIDE OF PANEL SHALL BE A MINIMUM OF 3"

W16-8a

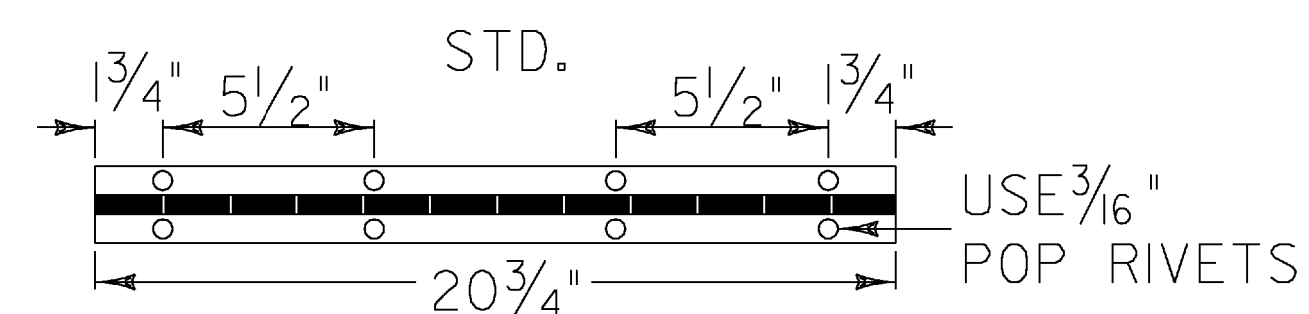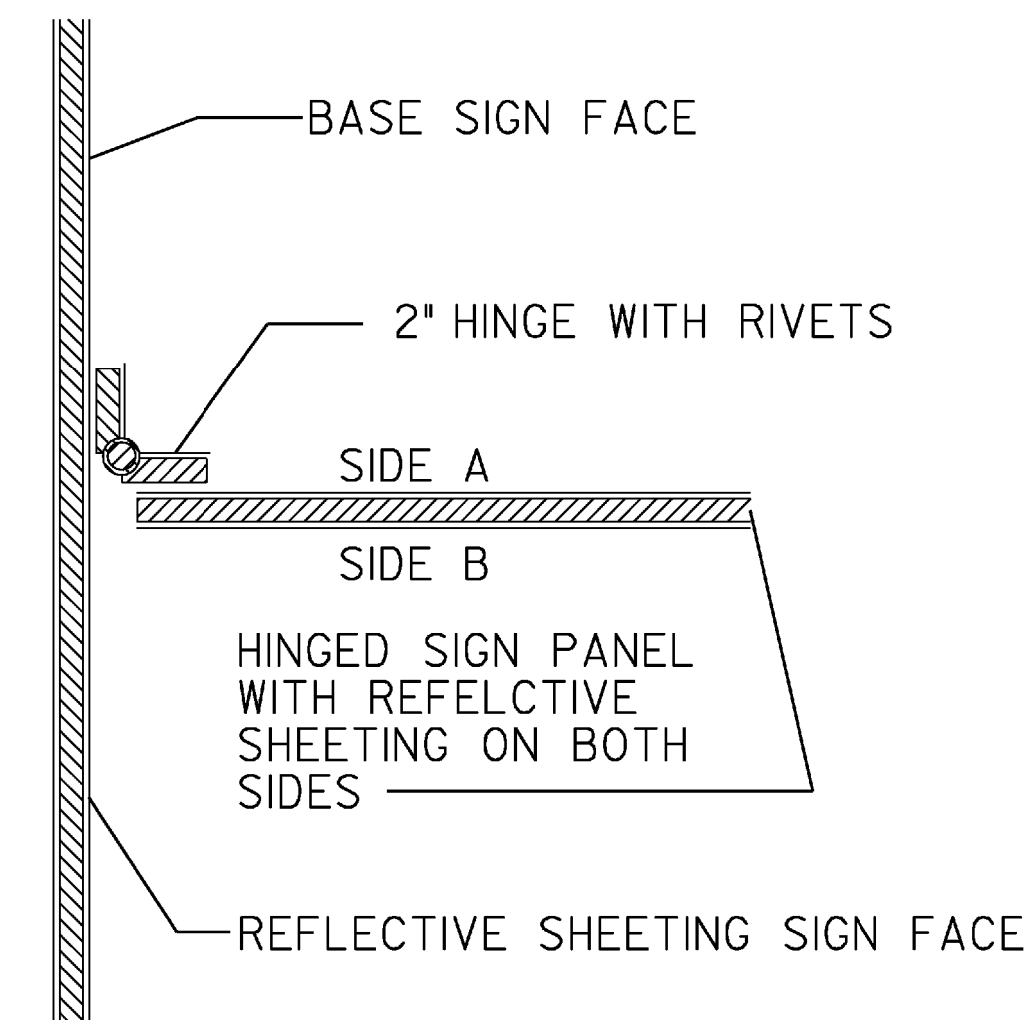

USE 2 - STANDARD 2" (WHITE) PIANO HINGE

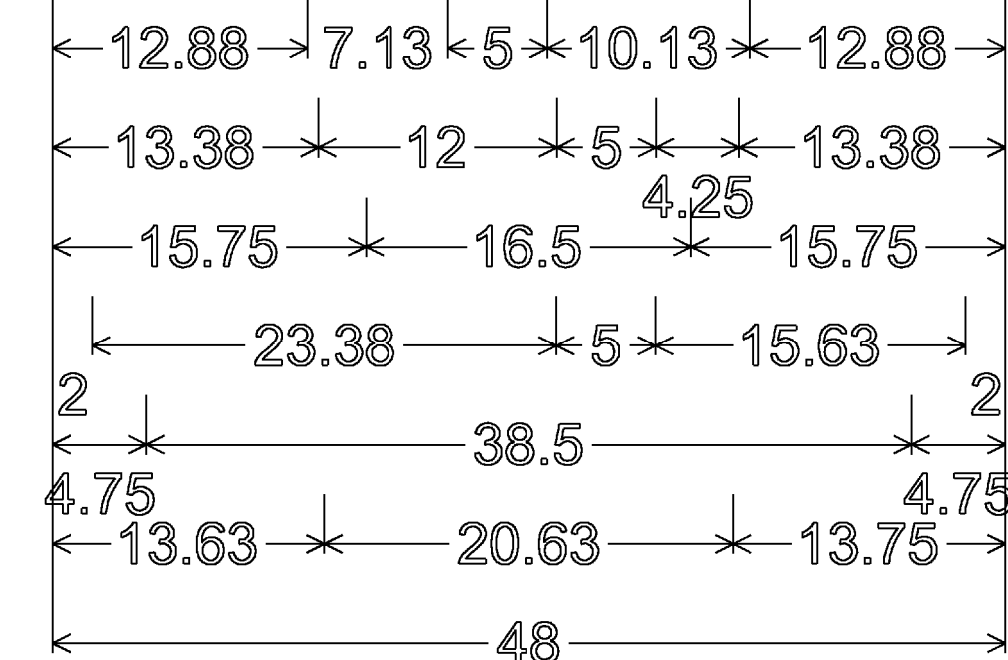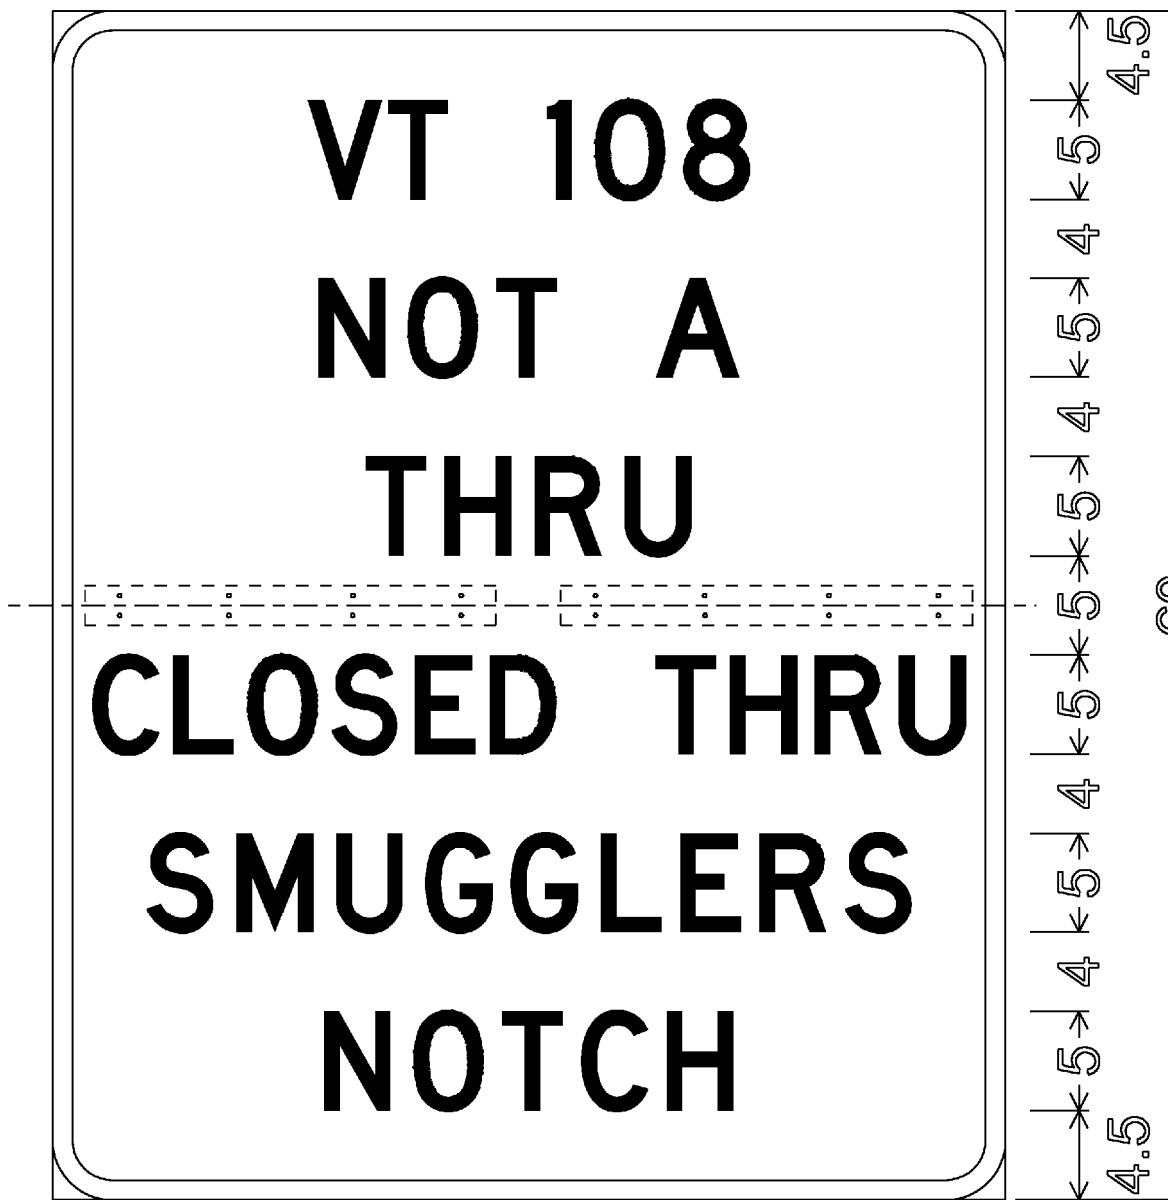

3.00" Radius, 1.00" Border, Black on White;
 "VT 108" D; "NOT A" D;
 "THRU" D;
 "CLOSED THRU" D specified length;
 "SMUGGLERS" D; "NOTCH" D;

**VR-493 H
 BASE SIGN**

PROJECT NAME: MORETOWN - NEWPORT TOWN	PLOT DATE: 30-SEP-2009
PROJECT NUMBER: STPG SIGN (28)	DRAWN BY: N. AVERY
FILE NAME: 09b060_TS.DGN	CHECKED BY: A. GAMBLE
DESIGNED BY: N. AVERY	WARNING STREET NAME PLAQUE DETAIL
PROJECT LEADER: N. AVERY	SHEET 8 OF 166