

# STATE OF VERMONT AGENCY OF TRANSPORTATION




## PROPOSED IMPROVEMENT TOWNS OF MORETOWN - NEWPORT COUNTIES OF WASHINGTON, LAMOILLE AND ORLEANS VERMONT ROUTE 100

BEGINNING AT THE WAITSFIELD-MORETOWN TOWN LINE ON VT ROUTE 100 IN THE TOWN OF MORETOWN AT MILE MARKER 0.000 AND EXTENDING NORTHERLY ALONG VT ROUTE 100 FOR A DISTANCE OF 62.359 MILES TO THE END OF VT ROUTE 100 AT THE INTERSECTION OF VT ROUTE 100, VT ROUTE 105 AND VT ROUTE 14 IN THE TOWN OF NEWPORT AT MILE MARKER 4.211, EXCLUDING CLASS I SECTIONS WITHIN THE PROJECT CORRIDOR.

LENGTH OF ROADWAY = 61.132 MILES  
LENGTH OF PROJECT = 58.753 MILES

WORK TO BE PERFORMED UNDER THIS PROJECT INCLUDES THE REMOVAL OF EXISTING SIGNS & POSTS AND THE INSTALLATION OF SIGNS & SIGN POSTS AND OTHER RELATED ITEMS.

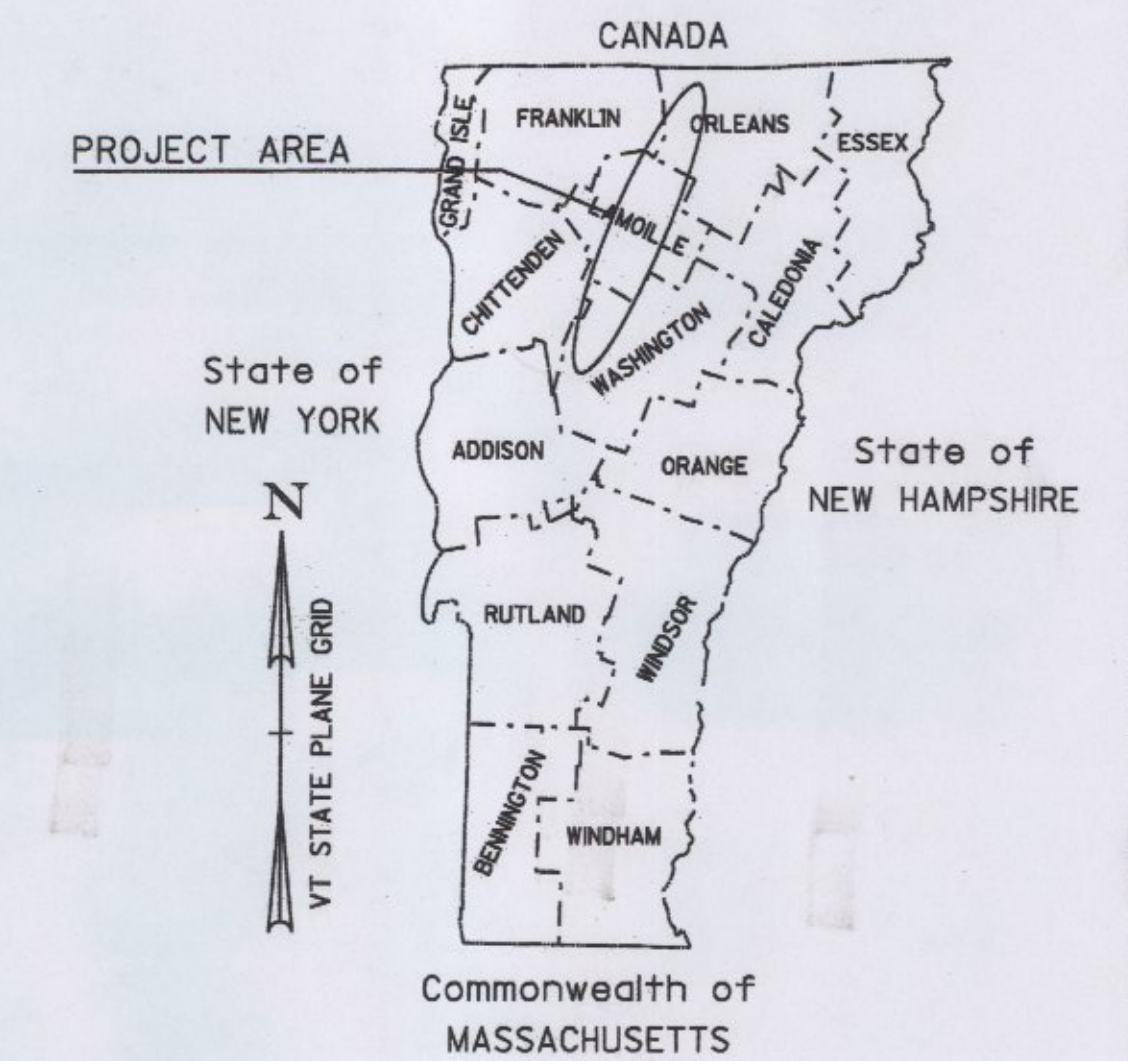

INDEX OF SHEETS  
SEE SHEET 2

### RECORD PLANS

CONTRACTOR:	F. R. LAFAYETTE, INC. - ESSEX JUNCTION, VT
RESIDENT ENGINEER:	JEFF COTA
CONSTRUCTION BEGAN:	APRIL 12, 2010
CONSTRUCTION COMPLETE:	JULY 5, 2010
RECORD PLANS BY:	JEFF COTA & SANDRA SCHMITT


I HEREBY CERTIFY THAT ALL THE CONSTRUCTION REQUIRED BY THIS SET OF DRAWINGS HAS BEEN ACCOMPLISHED AS INDICATED HEREIN.

BY [Signature] RESIDENT ENGINEER

DATE 10/30/13

NOTE: Any further information concerning final quantities, amounts or other details relative to this project may be found at Central Files in the electronic archives.

BEGIN PROJECT STPG SIGN (28)  
MORETOWN MM 0.000

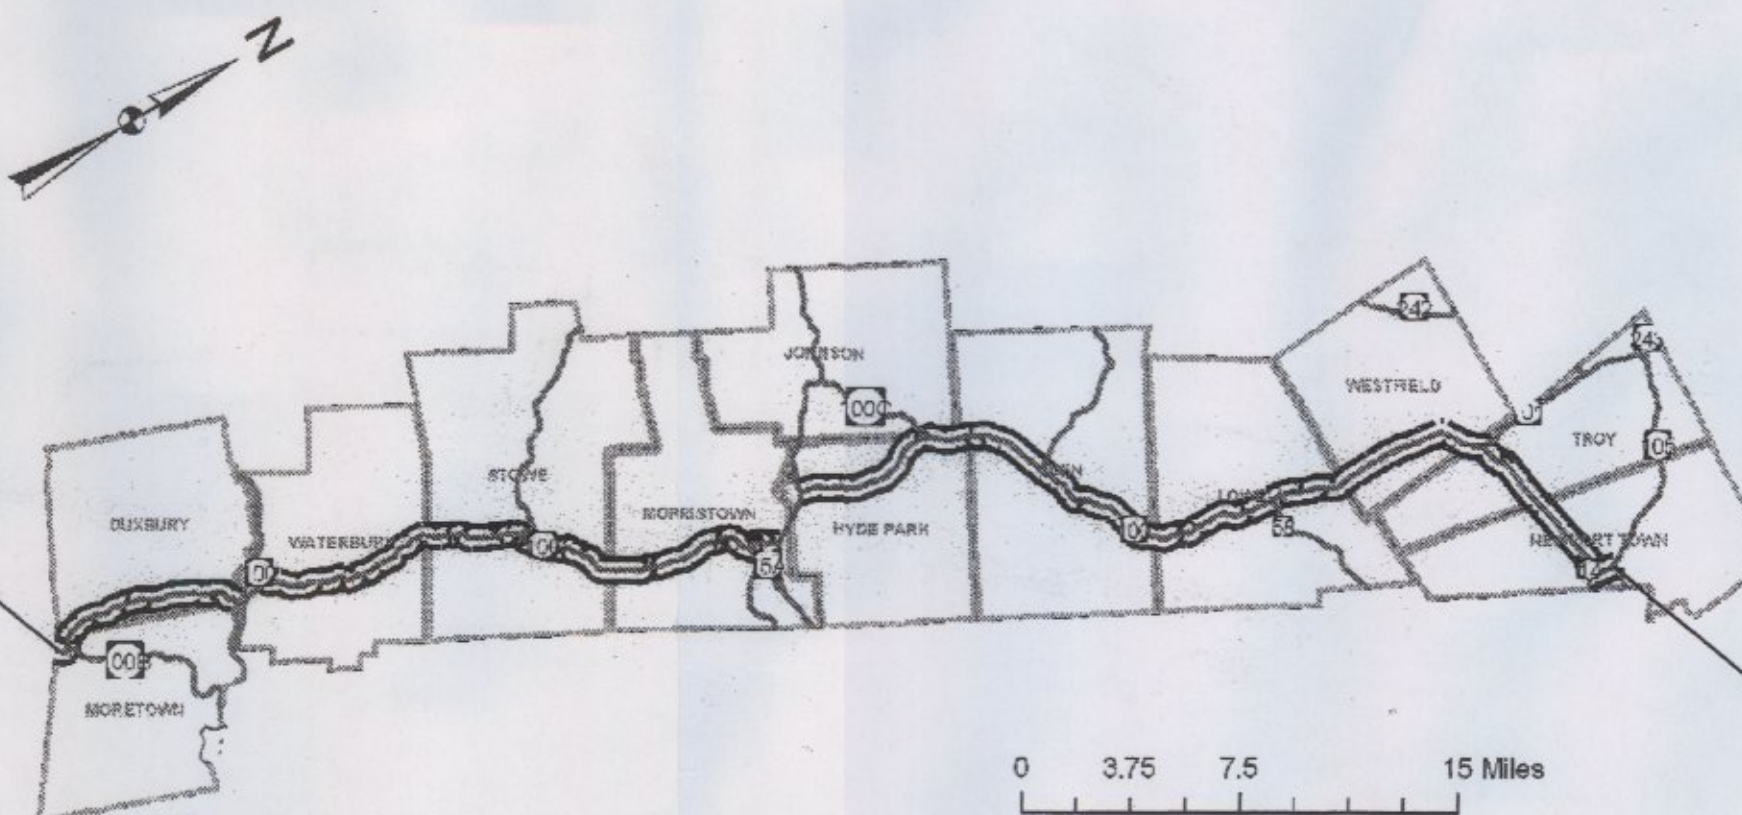

0 3.75 7.5 15 Miles

END PROJECT STPG SIGN (28)  
NEWPORT MM 4.211

### CONVENTIONAL SYMBOLS

COUNTY LINE	
TOWN LINE	
LIMITS OF ACCESS	
POINT OF ACCESS	
FENCE LINE	
STONE WALL	
TRAVELED WAY	
GUARD RAIL	
RAILROAD	
SURVEY LINE	
CULVERT	
POWER POLE	
TELEPHONE POLE	
TREES	
CONTROL OF ACCESS	
PROPERTY LINE	
R.O.W. TAKING LINE	
SLOPE RIGHTS	
TOP OF CUT	
TOE OF SLOPE	

SURVEYED BY : N/A  
SURVEYED DATE : N/A

DATUM  
VERTICAL N/A  
HORIZONTAL N/A

THESE PLANS ARE SUBJECT TO SUCH ENGINEERING CHANGES AS MAY BE REQUIRED BY THE FEDERAL HIGHWAY ADMINISTRATION OR THE DIRECTOR OF PROGRAM DEVELOPMENT.

CONSTRUCTION IS TO BE CARRIED ON IN ACCORDANCE WITH THESE PLANS AND THE STANDARD SPECIFICATIONS FOR CONSTRUCTION DATED 2006, AS APPROVED BY THE FEDERAL HIGHWAY ADMINISTRATION ON JUNE 15, 2006 FOR USE ON THIS PROJECT, INCLUDING ALL SUBSEQUENT REVISIONS AND SUCH REVISED SPECIFICATIONS AND SPECIAL PROVISIONS AS ARE INCORPORATED IN THESE PLANS.

DIRECTOR OF PROGRAM DEVELOPMENT	
APPROVED <u>[Signature]</u>	DATE <u>10/2/09</u>
PROJECT MANAGER :	AMY GAMBLE
PROJECT NAME :	MORETOWN - NEWPORT TOWN
PROJECT NUMBER :	STPG SIGN (28)
SHEET 1 OF 166 SHEETS	

INDEX OF SHEETS

1	TITLE SHEET
2	GENERAL NOTES
3	QUANTITY SHEET
4	COUNTY/ TOWN LINE DESIGN
5-6	SIGN DETAILS
7	GUIDE SIGN ASSEMBLY
8	WARNING STREET NAME PLAQUE DETAIL
9-18	MORETOWN TRAFFIC SIGN SUMMARY SHEETS I-10
19-32	DUXBURY TRAFFIC SIGN SUMMARY SHEETS I-14
33-55	WATERBURY TRAFFIC SIGN SUMMARY SHEETS I-23
56-75	STOWE TRAFFIC SIGN SUMMARY SHEETS I-20
76-90	MORRISTOWN TRAFFIC SIGN SUMMARY SHEETS I-15
91-103	HYDE PARK TRAFFIC SIGN SUMMARY SHEETS I-13
104-118	EDEN TRAFFIC SIGN SUMMARY SHEETS I-15
119-133	LOWELL TRAFFIC SIGN SUMMARY SHEETS I-15
134-138	WESTFIELD TRAFFIC SIGN SUMMARY SHEETS I-5
139-148	TROY TRAFFIC SIGN SUMMARY SHEETS I-10
149-163	NEWPORT TOWN TRAFFIC SIGN SUMMARY SHEETS I-15
164	TOWN TOTAL SIGN SUMMARY SHEET
165-166	TRAFFIC CONTROL SHEETS

STANDARDS

E-120	STANDARD SIGN PLACEMENT EXPRESSWAY AND FREEWAY	08/08/1995
E-121	STANDARD SIGN PLACEMENT CONVENTIONAL ROAD	08/08/1995
E-123	GUIDE SIGN PLACEMENT	03/16/2004
E-127	ROUTE MARKINGS AT RURAL INTERSECTIONS	08/08/1995
E-128A	VILLAGE SIGNS A-M	08/08/1995
E-128B	VILLAGE SIGNS N-W	08/08/1995
E-132	GENERAL MOTORIST SERVICES SIGN DETAIL	08/18/1995
E-136B	STATE ROUTE MARKER SIGN DETAILS	08/08/1995
E-136C	STATE NUMBER TOWN HIGHWAY SIGN DETAILS	08/08/1995
E-138	MILEMARKER DETAILS STATE AND TOWN HIGHWAYS	05/30/2003
E-141	REGULATORY SIGN DETAILS	09/20/1995
E-144	REGULATORY SIGN DETAILS	03/29/1999
E-145A	REGULATORY SIGN DETAILS LANE USE CONTROL SIGNS	12/23/1994
E-145B	REGULATORY SIGN DETAILS LANE USE CONTROL SIGNS	12/23/1994
E-153	WARNING SIGN DETAILS	05/01/2004
E-154	WARNING SIGN DETAILS	05/01/2004
E-164	SQUARE STEEL POSTS	06/08/2009

CLASS I SECTIONS OF HIGHWAY TO BE EXCLUDED FROM THIS PROJECT



TOWN	BEGIN MM	END MM	DISTANCE
STOWE	2.945	3.987	1.042
MORRISTOWN	4.851	6.188	1.337

TOTAL CLASS I MILEAGE 2.379

GENERAL NOTES

- ALL NEW SIGNS SHALL BE IN ACCORDANCE WITH THESE PLANS, THE LATEST EDITION OF THE 2003 MANUAL ON UNIFORM TRAFFIC CONTROL DEVICES, THE STANDARD HIGHWAY SIGN BOOK (SHS) PUBLISHED BY THE FEDERAL HIGHWAY ADMINISTRATION (FHWA), AND APPLICABLE VTRANS E-SERIES STANDARDS OR AS DIRECTED BY THE ENGINEER. SIGN LOCATIONS AS SHOWN ON THE PLANS ARE APPROXIMATE. EXACT LOCATIONS TO BE DETERMINED BY THE ENGINEER IN THE FIELD.
- ALL SIGNS WITHIN THE PROJECT LIMITS ARE TO BE REPLACED UNLESS OTHERWISE NOTED OR AS DIRECTED BY THE RESIDENT ENGINEER.
- THE CONTRACTOR SHALL BE RESPONSIBLE FOR REPAIRING ANY DAMAGE TO PRIVATE OR PUBLIC PROPERTY CAUSED BY THE CONTRACTOR, AT THEIR EXPENSE.
- ALL EXISTING MILE MARKER PLAQUES ATTACHED TO A DELINEATOR POST OR ATTACHED TO A RETAINED STAND ALONE SIGN POST ASSEMBLY SHALL BE RETAINED. IF AN EXISTING MILE MARKER PLAQUE IS ATTACHED TO A SIGN POST THAT IS TO BE REMOVED AND REPLACED IN THE SAME LOCATION, THE MILE MARKER PLAQUE SHALL BE REMOVED, SALVAGED AND INSTALLED TO THE NEW SIGN POST. IF AN EXISTING MILE MARKER PLAQUE IS ATTACHED TO A SIGN POST THAT IS TO BE RELOCATED TO A DIFFERENT LOCATION, THE MILE MARKER PLAQUE SHALL BE REMOVED, UNLESS OTHERWISE DIRECTED BY THE ENGINEER. PAYMENT FOR ANY OF THIS WORK SHALL BE INCIDENTAL TO ITEM 675.341 SQUARE TUBE POST AND ANCHOR. PAYMENT FOR NEW MILE MARKERS AS SHOWN ON THESE PLANS SHALL BE PAID FOR AS ITEM 675.20 TRAFFIC SIGN, TYPE A.
- SALVAGED SIGN TOTALS HAS BEEN ADDED TO THE TOTAL SIGN REMOVAL COLUMN ON THE TOWN TOTAL SIGN SUMMARY SHEET.
- EXISTING STREET NAME SIGNS ATTACHED TO SIGN POSTS THAT ARE TO BE REPLACED, SHALL BE REMOVED AND INSTALLED ONTO NEW POST. ALL WORK AND MATERIALS NECESSARY TO REMOVE AND INSTALL THE STREET NAME PLAQUES SHALL BE PAID UNDER ITEM 675.60 ERECTING SALVAGED SIGNS. AN ESTIMATED QUANTITY HAS BEEN ADDED TO PAY ITEM 675.60 TO PAY FOR THIS WORK.
- ALL EXISTING STREET NAME PLAQUES INSTALLED ON STAND ALONE SIGN POSTS SHALL BE RETAINED WITHIN THE PROJECT LIMITS.
- ALL SIGN PLACEMENT SHALL BE IN CONFORMANCE WITH STATE STANDARD E-120 STANDARD SIGN PLACEMENT CONVENTIONAL ROADS AND E-121 STANDARD SIGN PLACEMENT EXPRESSWAY AND FREEWAY.
- ALL SIGN LETTERING, DIGITS, ARROWS, AND DESIGN OF SYMBOLS FOR SIGNS DETAILED REFERENCED IN THESE PLANS SHALL CONFORM WITH THE "STANDARD ALPHABET FOR HIGHWAY SIGNS AND PAVEMENT MARKING" AS ADOPTED BY THE U.S. DEPARTMENT OF TRANSPORTATION AND THE FEDERAL HIGHWAY ADMINISTRATION (FHWA). UNLESS DETAILED WITHIN THESE PLANS.
- ALL COLORS SHALL CONFORM WITH THE STANDARD COLORS ADOPTED BY THE AMERICAN ASSOCIATION OF STATE HIGHWAY AND TRANSPORTATION OFFICIALS (AASHTO) AND APPROVED BY FHWA. UNLESS OTHERWISE NOTED.
- WITHIN THE TRAFFIC SIGN SUMMARY SHEETS FY= FLUORESCENT YELLOW SHEETING (ASTM VII, VIII, OR IX) AND FYG = FLUORESCENT YELLOW-GREEN SHEETING (ASTM TYPE VII, VIII, OR IX).
- SALVAGED SIGNS CALCULATED IN THE TRAFFIC SIGN SUMMARY SHEET HAVE BEEN INCLUDED INTO THE TOTAL FOR REMOVING SIGNS.
- UNLESS OTHERWISE DETAILED ON THE PLANS, ALL SIGN BASE MATERIAL SHALL BE FLAT SHEET ALUMINUM WITH THE FOLLOWING MINIMUM THICKNESSES:

SIZES	24" X 10"	24" X 12"	36" X 12"	
		24" X 18"	36" X 15"	
	24" X 24"	36" X 18"	48" X 18"	
	24" X 30"	36" X 24"	48" X 24"	
	9" X 12"	30" X 15"	30" X 42"	48" X 30"
	12" X 12"	30" X 18"	36" X 36"	48" X 42"
	18" X 18"	30" X 30"	36" X 48"	48" X 48"
	21" X 15"	30" X 42"	36" X 54"	48" X 60"
THICKNESS	0.060"	0.080"	0.100"	0.125"

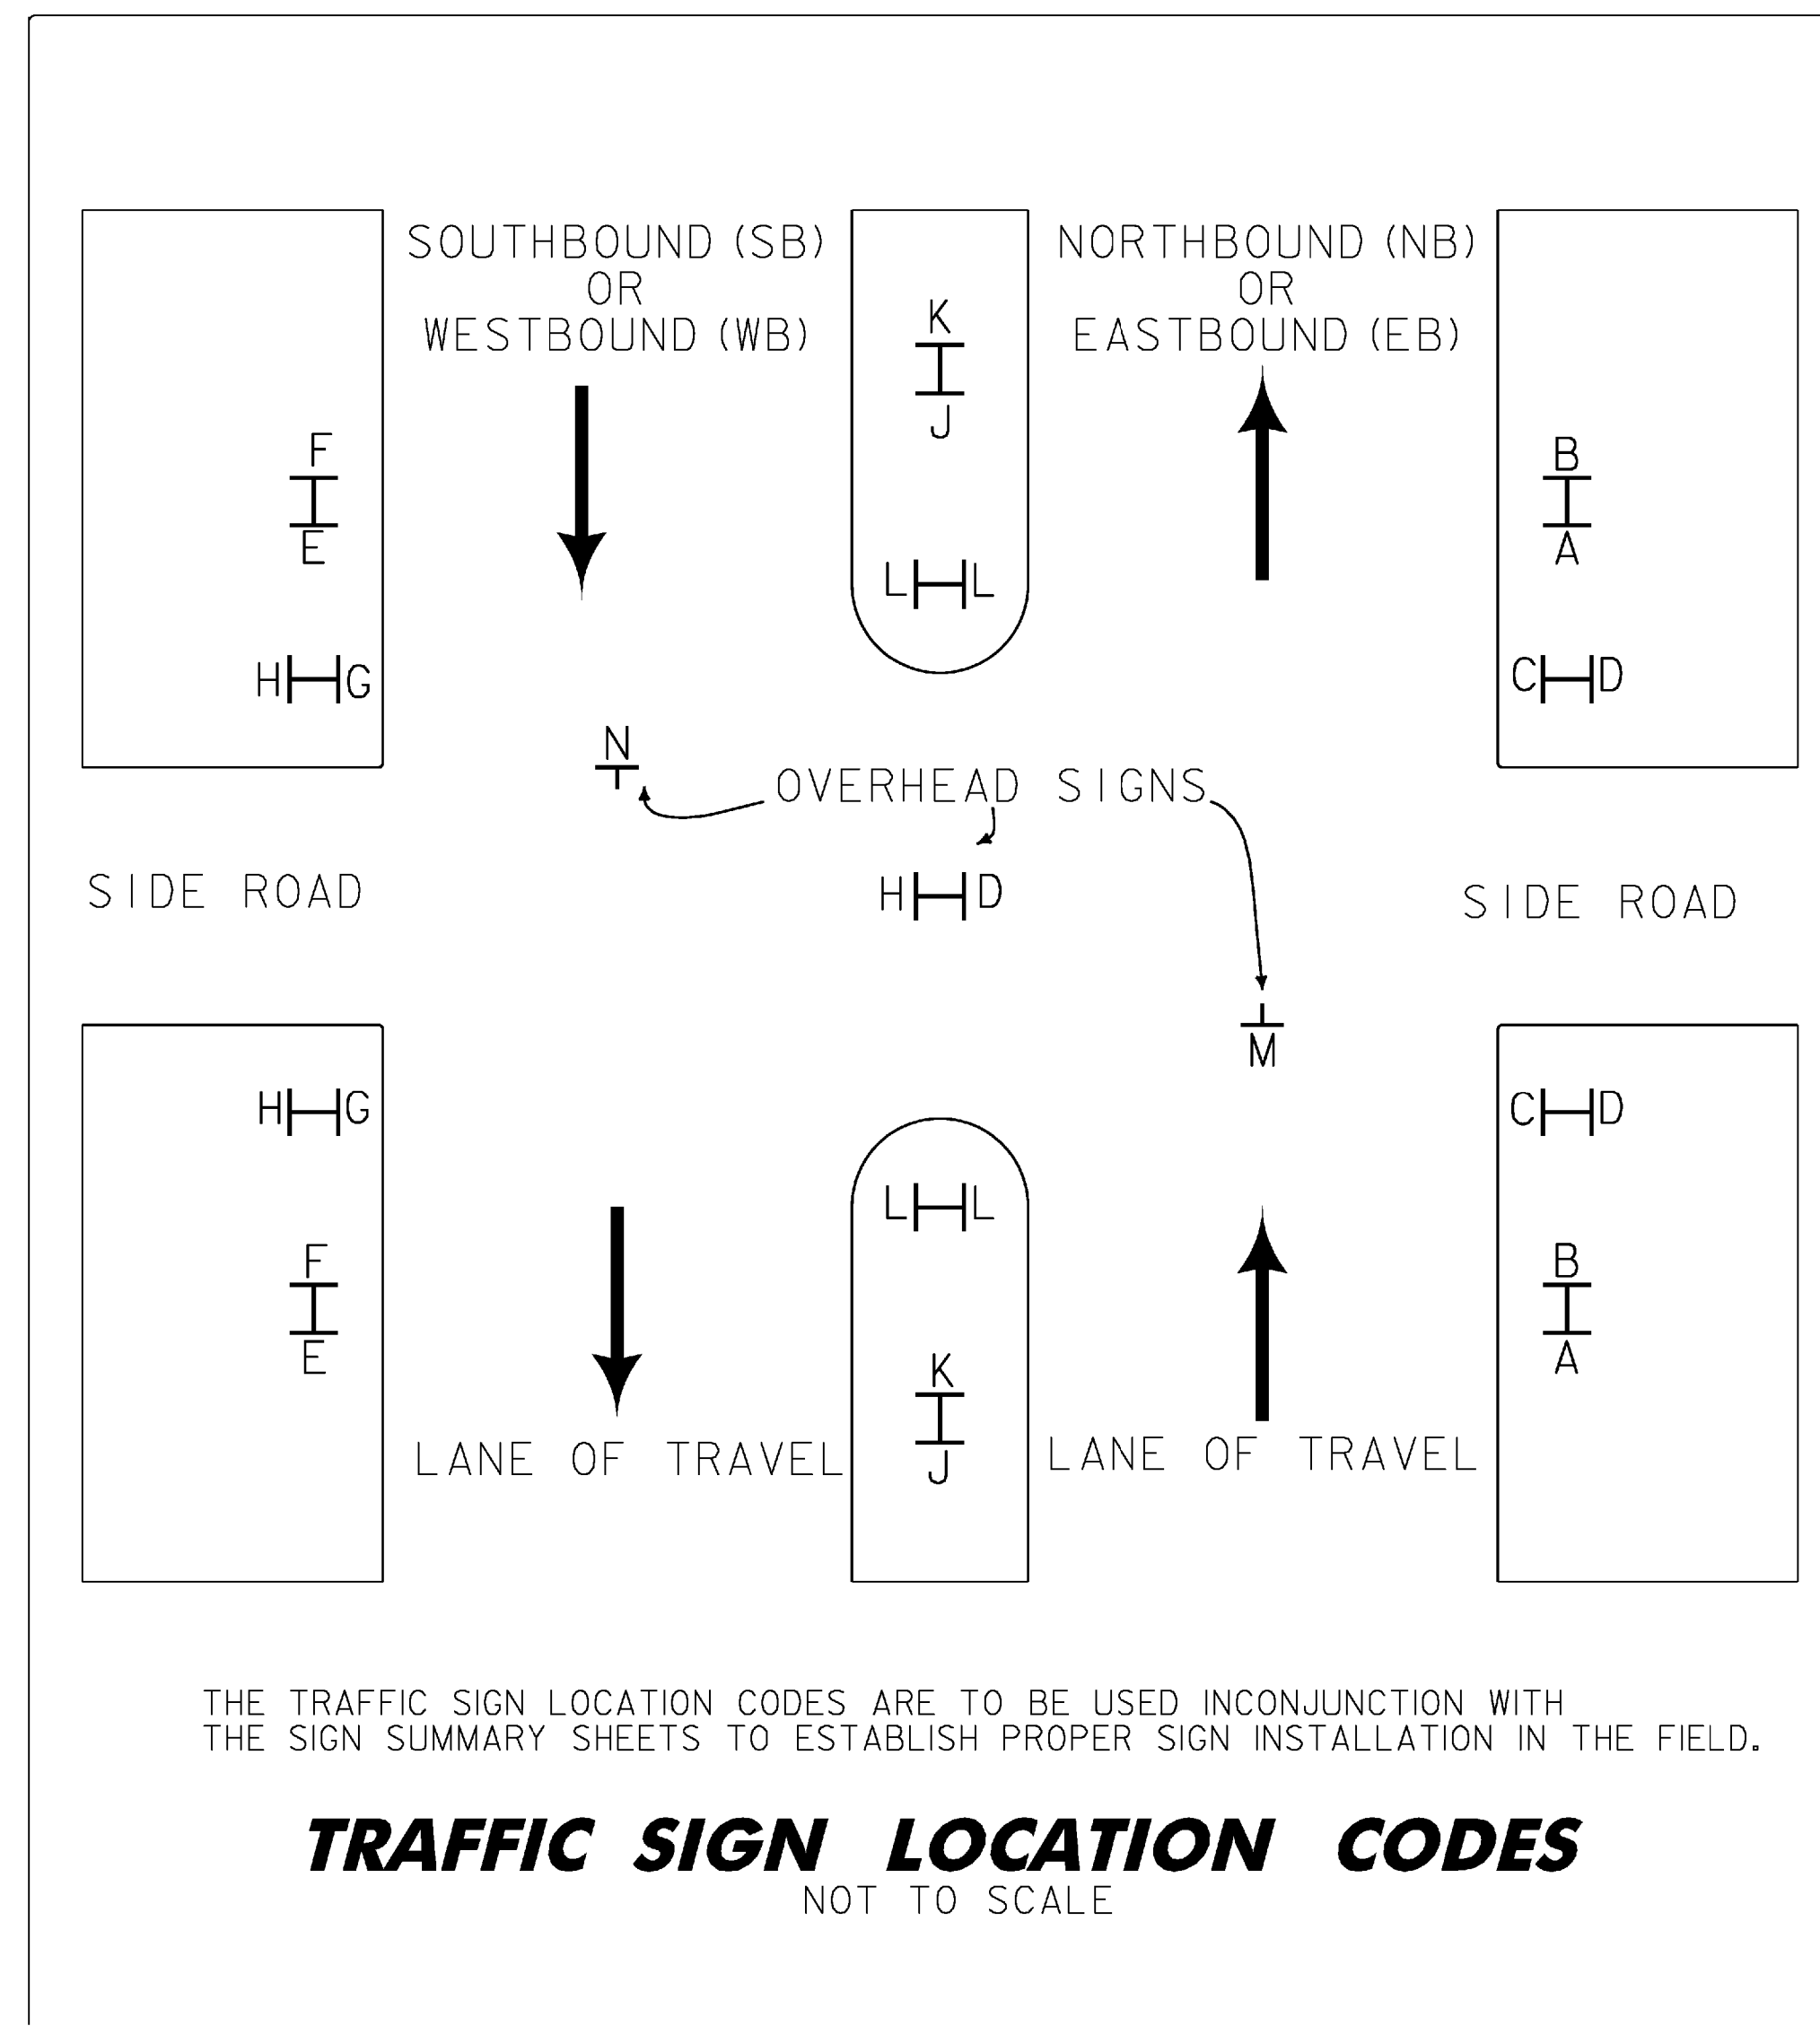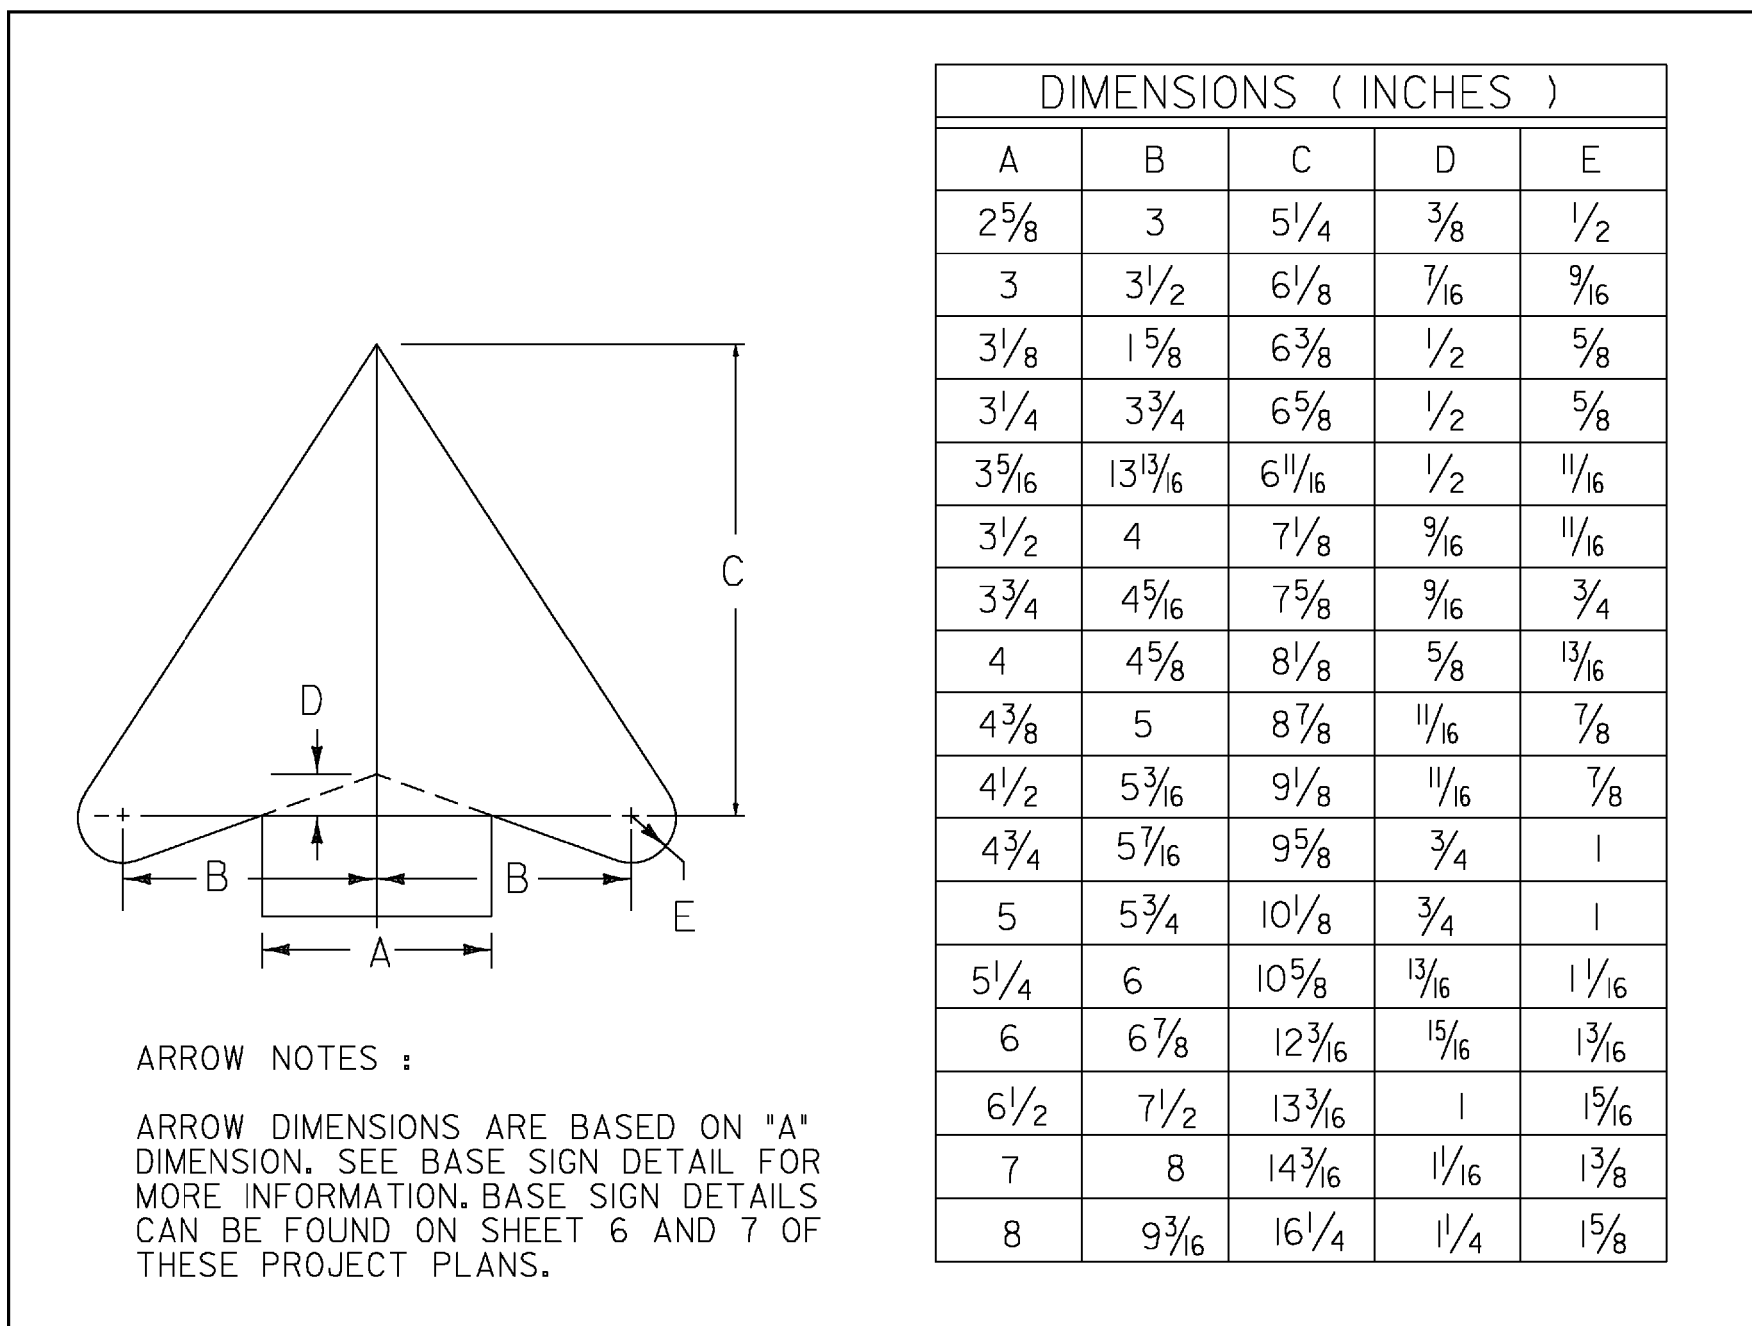

PROJECT NAME:	MORETOWN - NEWPORT TOWN
PROJECT NUMBER:	STPG SIGN (28)
FILE NAME:	09B060_TS.DGN
PROJECT LEADER:	N. AVERY
DESIGNED BY:	N. AVERY
GENERAL NOTES	
PLOT DATE:	30-SEP-2009
DRAWN BY:	N. AVERY
CHECKED BY:	A. GAMBLE
SHEET 2	OF 166

# QUANTITY SHEET 1

SUMMARY OF ESTIMATED QUANTITIES												TOTALS		DESCRIPTIONS				DETAILED SUMMARY OF QUANTITIES		
											ROADWAY	GRAND TOTAL	FINAL	UNIT	ITEMS	ITEM NUMBER	ROUND	QUANTITIES	UNIT	ITEMS
											1	1		CY	TRENCH EXCAVATION OF EARTH, EXPLORATORY (N.A.B.I.)	204.22				
											50	50		HR	UNIFORMED TRAFFIC OFFICERS	630.10				
											876	876		HR	FLAGGERS	630.15				
											1	1		LS	MOBILIZATION/DEMOBILIZATION	635.11				
											1	1		LS	TRAFFIC CONTROL	641.10				
											4214.6	4214.6		SF	TRAFFIC SIGNS, TYPE A	675.20				
											10335	10335		LF	SQUARE TUBE SIGN POST AND ANCHOR	675.341				
											853	853		EACH	REMOVING SIGNS	675.50				
											34	34		EACH	ERECTING SALVAGED SIGNS	675.60				

PROJECT NAME: MORETOWN - NEWPORT TOWN  
 PROJECT NUMBER: STPG SIGN (28)  
 FILE NAME: 09B060\_TS.DGN  
 PROJECT LEADER: N. AVERY  
 DESIGNED BY: N. AVERY  
 QUANTITY SHEET  
 PLOT DATE: 30-SEP-2009  
 DRAWN BY: N. AVERY  
 CHECKED BY: A. GAMBLE  
 SHEET 3 OF 166

TEXT	SERIES	DIMENSIONS
ADDISON	C	28.27
ALBANY	C	25.88
ALBURGH	C	29.99
ANDOVER	C	30.05
ARLINGTON	B	29.35
ATHENS	C	24.49
AVERILL	C	26.44
BAKERSFIELD	B	32.50
BARNARD	C	30.49
BARNET	C	24.83
BARRE CITY	B	32.50
BARRE TOWN	B	32.50
BARTON	C	25.38
BELVIDERE	C	32.50
BENNINGTON	B	32.50
BENSON	C	25.41
BERKSHIRE	B	29.04
BERLIN	C	22.50
BETHEL	C	23.80
BLOOMFIELD	B	32.13
BOLTON	C	24.39
BRADFORD	C	32.50
BRAINTREE	C	32.50
BRANDON	C	30.46
BRATTLEBORO	B	32.50
BRIDGEWATER	B	32.50
BRIDPORT	C	32.06
BRIGHTON	C	32.06
BRISTOL	C	27.24
BROOKFIELD	B	31.91
BROWNINGTON	B	31.22
BRUNSWICK	B	30.60
BURKE	C	20.93
BUELS GORE	B	32.50
BURLINGTON	B	32.50
CABOT	C	20.50
CALAIS	C	22.22
CAMBRIDGE	B	29.74
CANAAN	C	25.15
CASTLETON	B	29.32
CAVENDISH	C	32.50
CHARLESTON	B	32.50
CHARLOTTE	B	29.32
CHELSEA	C	28.84
CHESTER	C	28.46
CHITTENDEN	B	30.56
CLARENDON	B	30.32
COLCHESTER	B	32.50
CONCORD	C	30.42
CORINTH	C	27.27
CORNWALL	C	32.50
COVENTRY	C	32.50
CRAFTSBURY	B	32.50
DANBY	C	21.65
DANVILLE	C	31.16
DERBY	C	21.15
DORSET	C	24.55
DOVER	C	20.74
DUMMERSTON	B	32.50
DUXBURY	C	30.75
EDEN	C	15.85
ENOSBURG	C	32.50
EAST HAVEN	B	32.50
E. MONTPELIER	B (5'')	32.50
ELMORE	C	25.46
ESSEX	C	20.38
FAIRFAX	C	27.05
FAIRFIELD	C	32.50
FAIR HAVEN	B	32.50
FAIRLEE	C	26.12
FAYSTON	C	28.85
FERDINAND	B	29.17
FERRISBURGH	B	32.50
FLETCHER	C	31.85
FRANKLIN	C	31.31


TEXT	SERIES	DIMENSIONS
GEORGIA	C	27.74
GLOVER	C	25.00
GOSHEN	C	25.16
GLASTENBURY	B (5'')	31.32
GRAFTON	C	29.31
GRAND ISLE	B	32.50
GRANVILLE	C	32.50
GREENSBORO	B	32.50
GROTON	C	25.35
GUILDHALL	C	32.50
GUILFORD	C	31.78
HALIFAX	C	27.14
HANCOCK	C	29.96
HARDWICK	C	32.50
HARTFORD	C	32.50
HARTLAND	C	32.50
HIGHGATE	C	31.14
HINESBURG	B	29.23
HOLLAND	C	29.22
HUBBARDTON	B	31.42
HYDE PARK	B	32.50
IRA	C	10.15
IRASBURG	C	32.37
ISLE LA MOTTE	B (5'')	32.50
JAMAICA	C	28.26
JAY	C	11.85
JERICO	C	27.24
JOHNSON	C	30.39
KILLINGTON	B	30.16
KIRBY	B	18.99
LANDGROVE	B	30.33
LEICESTER	C	32.50
LEMINGTON	B	28.79
LONDONDERRY	B (5'')	32.18
LOWELL	C	25.04
LUDLOW	C	26.10
LUNENBERG	B	30.01
LYNDON	C	24.96
MAIDSTONE	B	29.51
MANCHESTER	B	32.50
MARLBORO	C	32.50
MARSHFIELD	B	32.47
MENDON	C	26.02
MIDDLEBURY	B	32.50
MIDDLESEX	B	29.06
MIDDLETOWN SPR	B (5'')	32.50
MILTON	C	22.63
MONTGOMERY	B	32.50
MONTPELIER	B	31.94
MORETOWN	C	32.50
MORGAN	C	26.52
MORRISTOWN	B	32.50
MOUNT HOLLY	B (5'')	31.97
MOUNT TABOR	B	32.02
NEWARK	C	25.65
NEWBURY	C	30.87
NEWFANE	C	29.73
NEW HAVEN	B	32.50
NEWPORT CITY	B (5'')	32.50
NEWPORT TOWN	B (5'')	32.50
NORTH HERO	B	32.50
NORTHFIELD	B	31.57
NORTON	C	25.60
NORWICH	C	28.77
ORANGE	C	25.88
ORWELL	C	25.57
PANTON	C	25.38
PAWLET	C	24.59
PEACHAM	C	30.23
PERU	C	16.38
PITTSFIELD	C	32.50
PITTSFORD	C	32.50
PLAINFIELD	B	29.65
PLYMOUTH	C	32.50
POMFRET	C	29.42

TEXT	SERIES	DIMENSIONS
POULTNEY	C	32.50
POWNAL	C	26.35
PROCTOR	C	29.31
PUTNEY	C	24.83
RANDOLPH	C	32.50
READING	C	27.47
READSBORO	B	31.09
RICHFORD	C	32.06
RICHMOND	C	32.50
RIPTON	C	22.97
ROCHESTER	B	29.54
ROCKINGHAM	B	32.50
ROXBURY	C	30.44
ROYLTON	C	32.50
RUPERT	C	24.94
RUTLAND CITY	B (5'')	32.50
RUTLAND TOWN	B (5'')	32.50
RYEGATE	C	28.47
ST. ALBANS CITY	B (5'')	32.50
ST. ALBANS TOWN	B (5'')	32.50
ST. GEORGE	B	32.50
ST. JOHNSBURY	B (5'')	32.50
SALISBURY	C	32.50
SEARSBURG	B	30.93
SHAFTSBURY	B	32.50
SHARON	C	25.91
SHEFFIELD	C	32.50
SHELDON	C	29.42
SHOREHAM	C	32.50
SHREWSBURY	B	32.50
S. BURLINGTON	B (5'')	32.50
SOUTH HERO	B	32.50
SPRINGFIELD	B	32.50
STAMFORD	C	32.50
STARKSBORO	B	32.50
STOCKBRIDGE	B	32.50
STOWE	C	21.30
STRAFFORD	B	30.42
STRATTON	C	32.06
SUDBURY	C	30.77
SUNDERLAND	B	32.50
SUTTON	C	24.21
SWANTON	C	30.22
THETFORD	C	32.50
TINMOUTH	C	32.14
TOPSHAM	C	30.53
TOWNSHEND	B	31.70
TROY	C	16.54
TUNBRIDGE	C	32.50
UNDERHILL	C	32.50
VERGENNES	B	30.03
VERNON	C	25.79
VERSHIRE	C	31.72
WAITSFIELD	B	30.44
WALDEN	C	25.46
WALLINGFORD	B	32.50
WALTHAM	C	29.91
WARDSBORO	B	32.29
WARREN	C	25.99
WARRENS GORE	B (5'')	32.50
WASHINGTON	B	32.50
WATERBURY	B	31.40
WATERFORD	B	30.65
WATERVILLE	B	31.35
WEATHERSFIELD	B (5'')	32.50
WELLS	C	20.83
WEST FAIRLEE	B (5'')	32.50
WESTFIELD	C	32.50
WEST HAVEN	B	32.50
WESTFORD	C	32.50
WESTMINSTER	B	32.50
WESTMORE	C	32.50
WESTON	C	25.85

TEXT	SERIES	DIMENSIONS
WEST RUTLAND	B (5'')	32.50
WEST WINDSOR	B (5'')	32.50
WEYBRIDGE	C	32.50
WHEELLOCK	C	32.50
WHITING	C	25.86
WHITINGHAM	B	32.50
WILLIAMSTOWN	B (5'')	32.50
WILLISTON	C	32.50
WILMINGTON	B	32.16
WINDHAM	C	29.66
WINDSOR	C	28.77
WINHALL	C	28.24
WINOOSKI	C	30.81
WOLCOTT	C	29.38
WOODBURY	C	32.50
WOODFORD	C	32.50
WOODSTOCK	B	31.79
WORCESTER	B	30.76


**NOTES:**

- WORD TO WORD SPACING FOR MULTIPLE TEXT TOWN NAMES IS ADJUSTABLE TO ACCOMMODATE DIMENSION REQUIREMENTS.
- DIMENSIONS SHOWN ARE APPROXIMATE AND MAY BE ADJUSTED SLIGHTLY TO ACCOMMODATE VARIOUS MANUFACTURER'S LETTER WIDTHS.
- ALL DIMENSIONS ARE IN INCHES UNLESS OTHERWISE NOTED

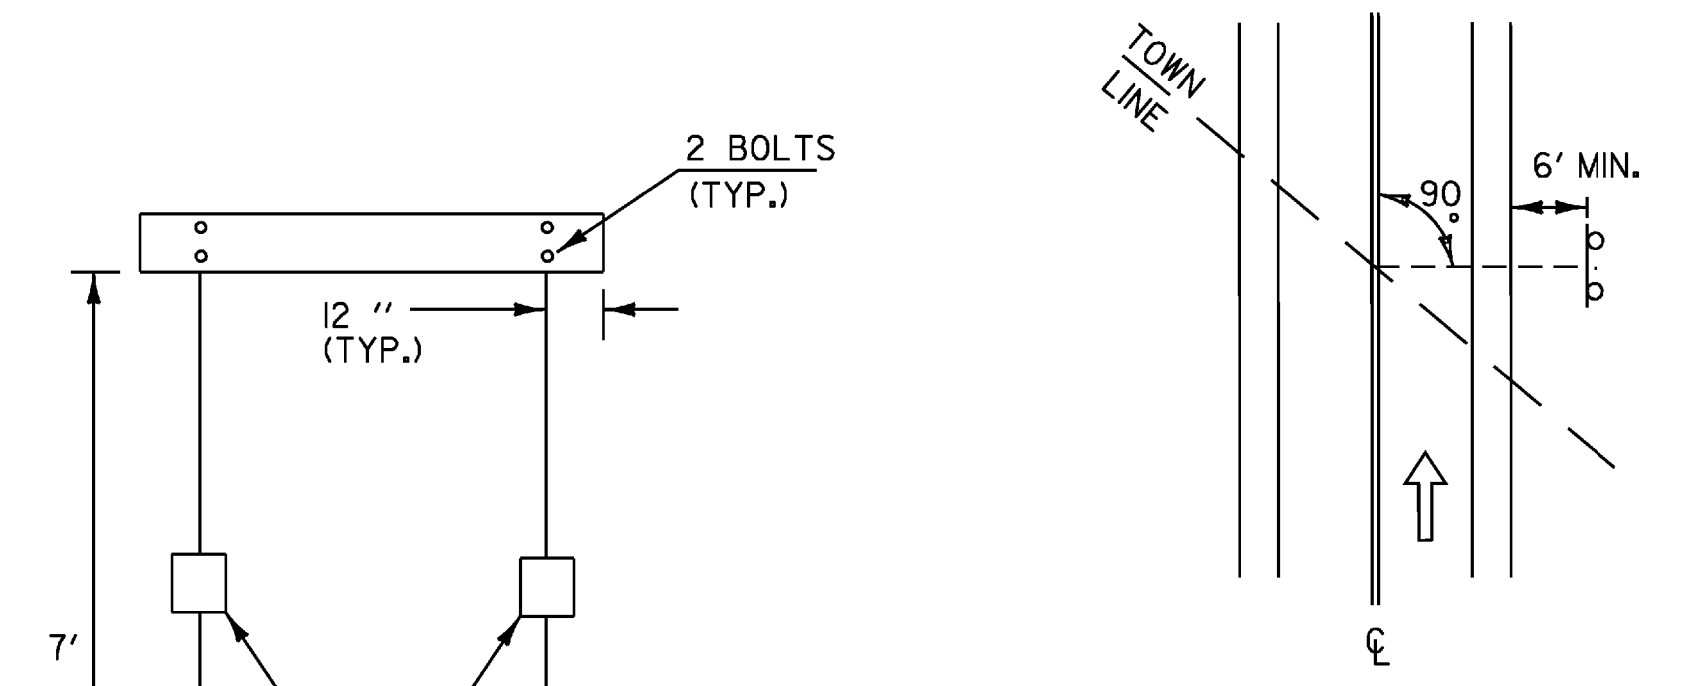

THE SIGN SHALL BE MOUNTED PARALLEL WITH THE ROADWAY, NORMALLY ON RIGHT SIDE TRAVELING WEST TO EAST OR SOUTH TO NORTH.

WHEN CROSSING COUNTY BOUNDARIES AN ADDITIONAL COUNTY LINE SIGN SHALL BE MOUNTED BELOW THE TOWN LINE SIGN MAINTAINING AN SEVEN FOOT CLEARANCE.

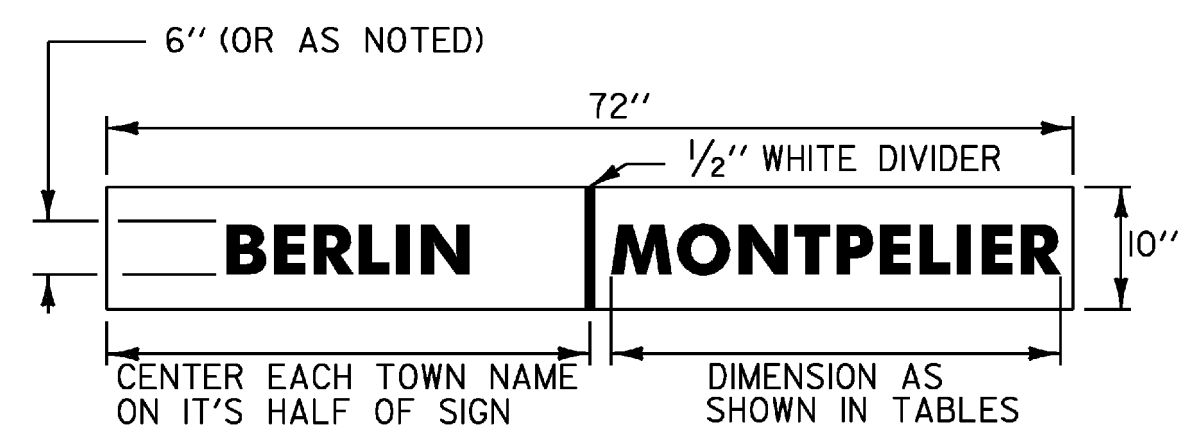

**VD-024  
VD-025 SIMILIAR**


TEXT	SERIES	DIMENSIONS
ADDISON CO.	B	32.50
BENNINGTON CO.	B (5'')	32.50
CALEDONIA CO.	B (5'')	32.50
CHITTENDEN CO.	B (5'')	32.50
ESSEX CO.	C	32.50
FRANKLIN CO.	B (5'')	32.50
GRAND ISLE CO.	B (5'')	32.50
LAMOILLE CO.	B (5'')	32.50
ORANGE CO.	B	32.50
ORLEANS CO.	B	32.50
RUTLAND CO.	B	32.50
WASHINGTON CO.	B (5'')	32.50
WINDHAM CO.	B	32.50
WINDSOR CO.	B	32.50

**VD-025**


**TOWN/COUNTY LINE SIGN NOTES:**

- THE SIGN BASE MATERIAL SHALL BE HIGH DENSITY OVERLAID PLYWOOD 5/8 INCH THICK OR ALUMINUM SHEETING 0.125" MINIMUM THICKNESS. THE RETROREFLECTIVE MATERIAL SHALL BE SHEETING APPLIED TO THE ENTIRE BACKGROUND OF THE SIGN. THE LEGEND SHALL BE CUT-OUT RETROREFLECTIVE LEGEND. ALL RETROREFLECTIVE MATERIAL SHALL BE EQUAL TO OR EXCEEDING THE "THE AMERICAN SOCIETY OF TESTING AND MATERIALS" (ASTM 4956-01) TYPE III SHEETING.
- SIGNS SHALL HAVE A MINIMUM ASTM TYP III SHEETING WITH A WHITE LEGEND ON A GREEN BACKGROUND.
- LEGEND SHALL CONFORM WITH THE STANDARD ALPHABETS FOR HIGHWAY SIGNS APPROVED BY THE NATIONAL JOINT COMMITTEE ON UNIFORM TRAFFIC CONTROL DEVICES.
- ALL SIGNS SHALL BE IN ACCORDANCE WITH "THE MANUAL ON UNIFORM TRAFFIC CONTROL DEVICES" (2003 MUTCD) AND THE "STANDARD HIGHWAY SIGNS" BOOK (SHS) PUBLISHED BY THE FEDERAL HIGHWAY ADMINISTRATION (FHWA).


PROJECT NAME:	MORETOWN - NEWPORT TOWN
PROJECT NUMBER:	STPG SIGN (28)
FILE NAME:	09B060_TS.DGN
PROJECT LEADER:	N. AVERY
DESIGNED BY:	N. AVERY
COUNTY / TOWN LINE DESIGN	
PLOT DATE:	30-SEP-2009
DRAWN BY:	N. AVERY
CHECKED BY:	A. GAMBLE
SHEET	4 OF 166

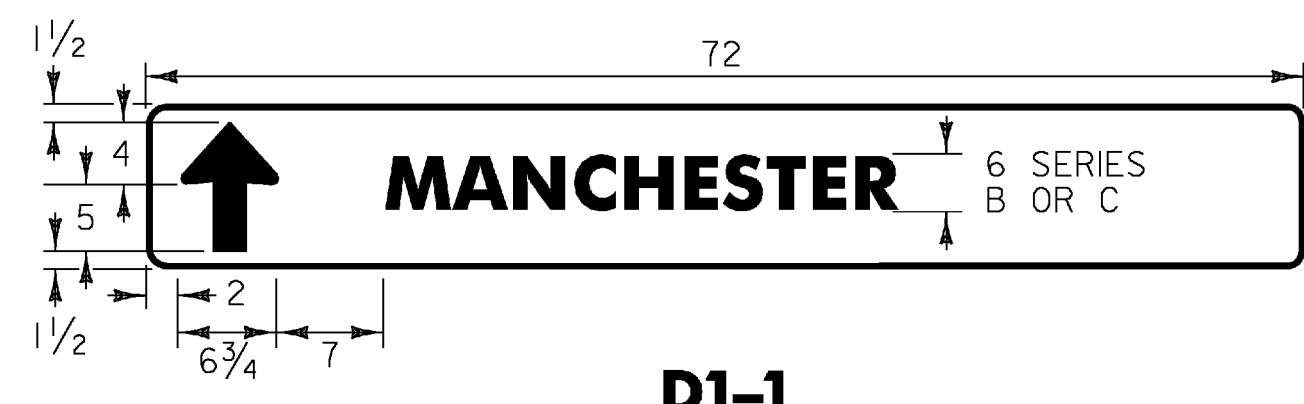


**D1-1**

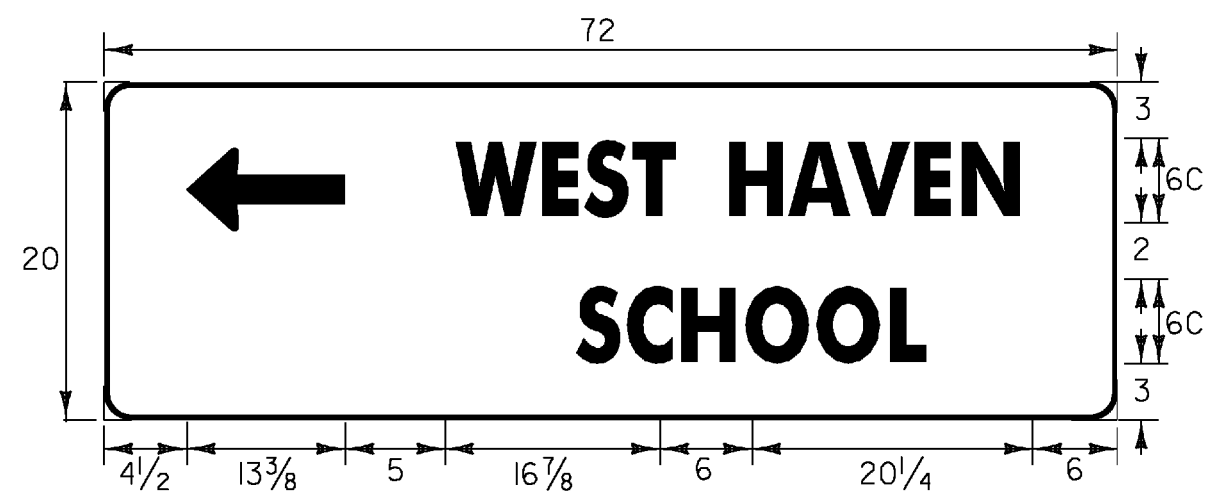

**D1-2 (L)**

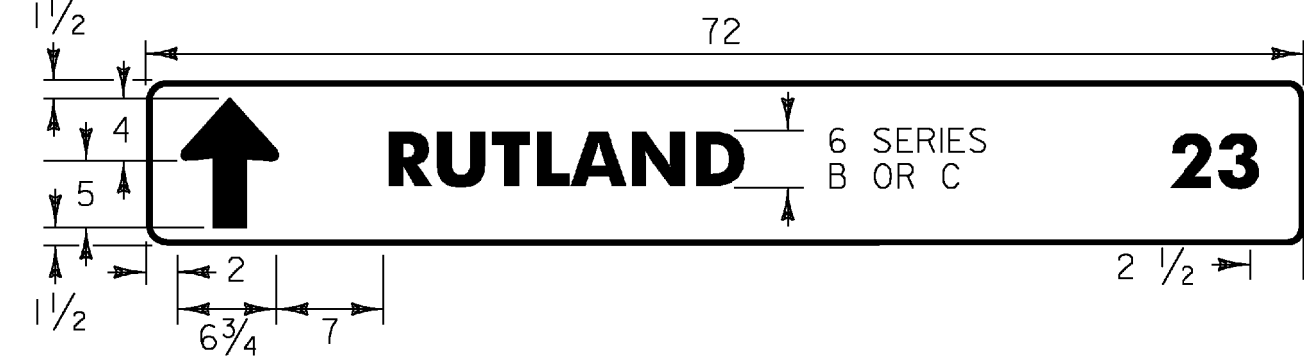


**D1-1A**

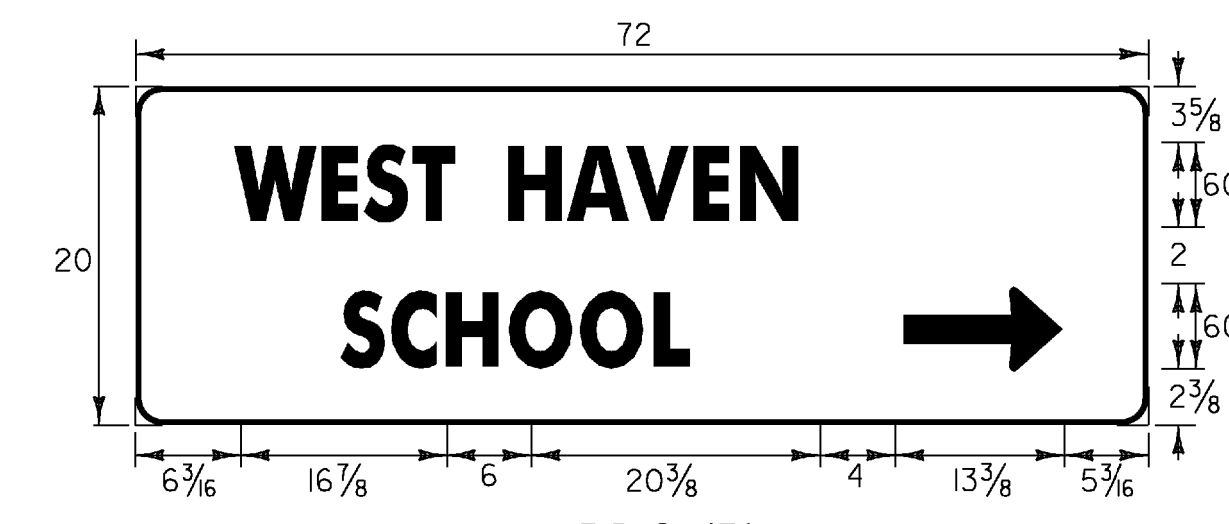


**D1-2 (R)**




**D1-1A**

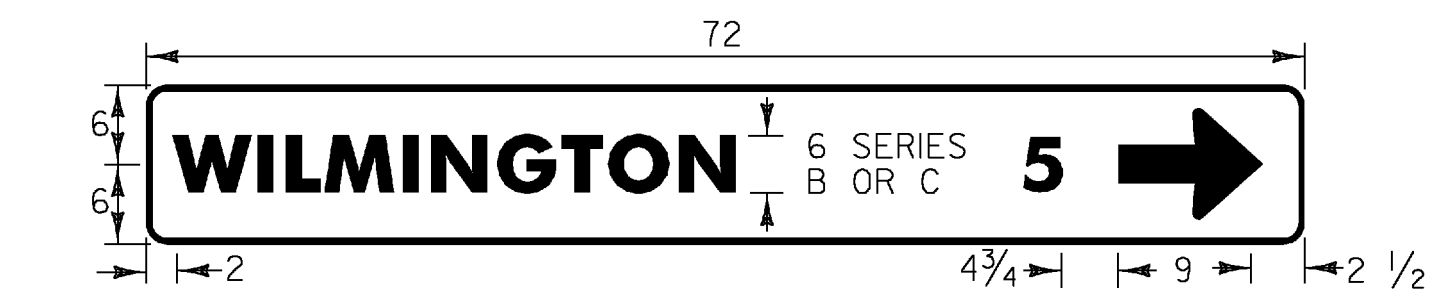

**D1-1A**

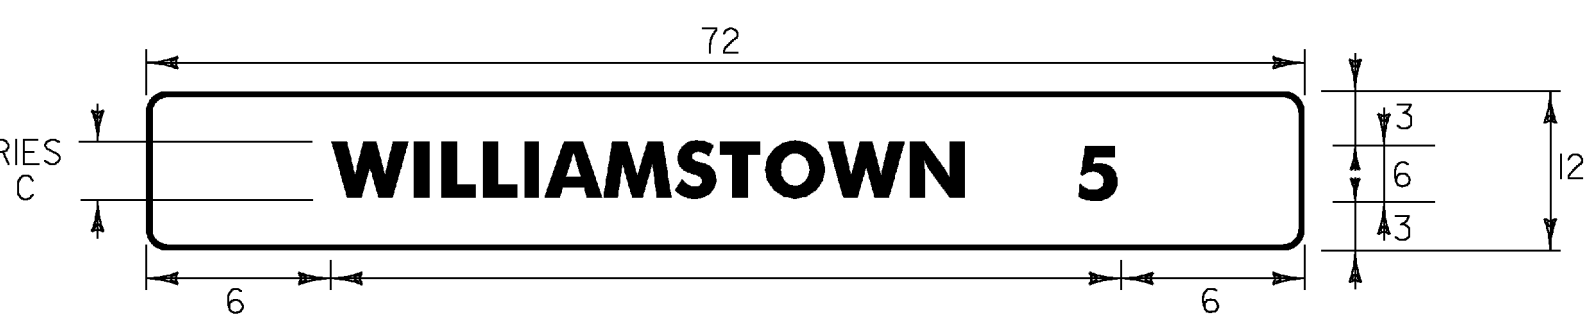

**D2-1**

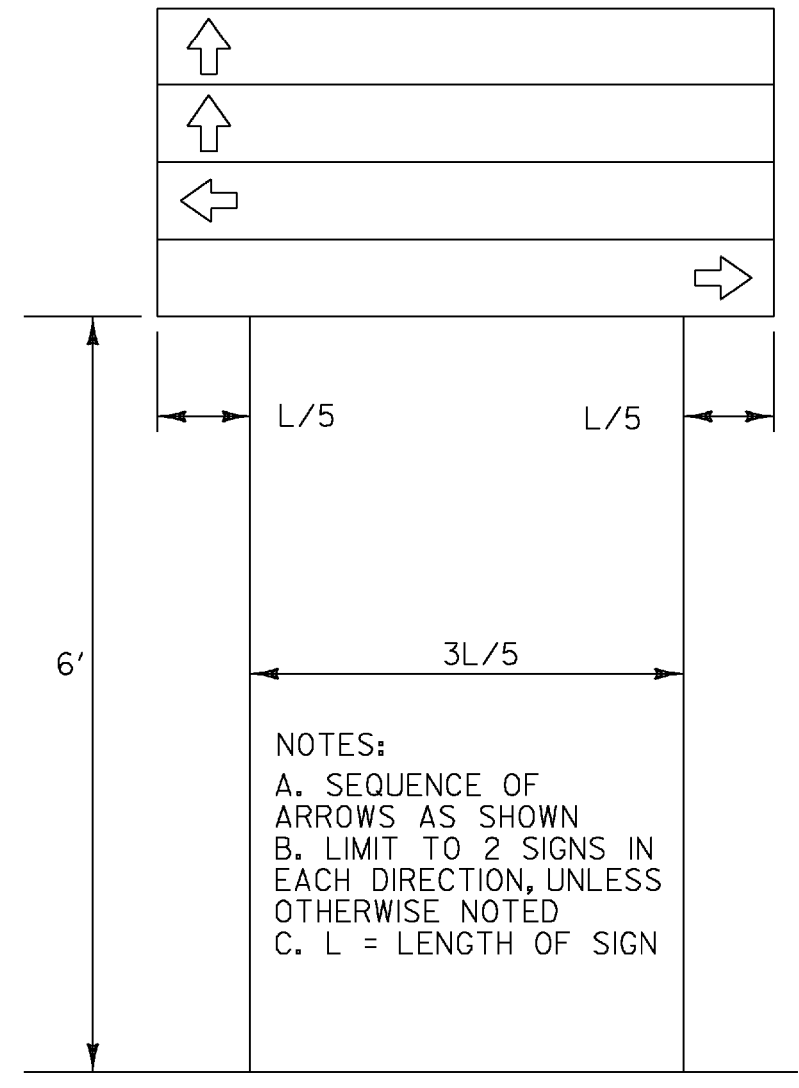


**DESTINATION ASSEMBLY**

NOTES:  
 A. SEQUENCE OF ARROWS AS SHOWN  
 B. LIMIT TO 2 SIGNS IN EACH DIRECTION, UNLESS OTHERWISE NOTED  
 C. L = LENGTH OF SIGN




1.5" Radius, 0.4" Border, White on Green;  
 Standard Arrow Custom 9.0" X 6.8" 180°; "STRATTON MTN" B specified length;  
 "SKI" C; "AREA" C; "10" B specified length;

**D1-1A**

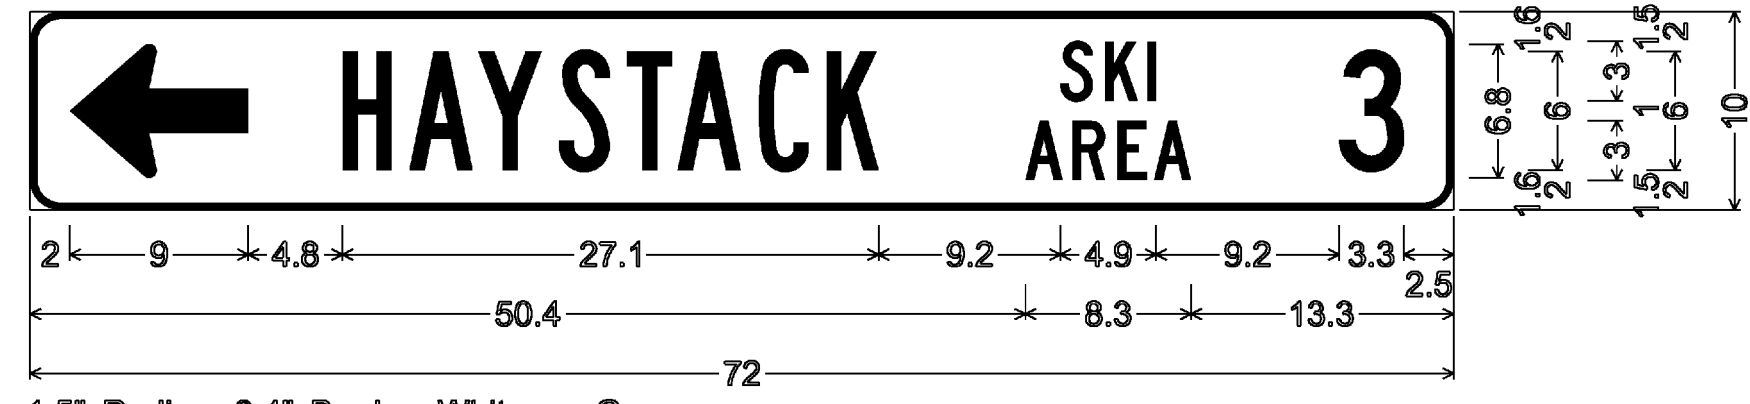


1.5" Radius, 0.4" Border, White on Green;  
 Standard Arrow Custom 9.0" X 6.8" 180°; "HAYSTACK" B; "SKI" C; "AREA" C; "3" C;

**D1-1A**

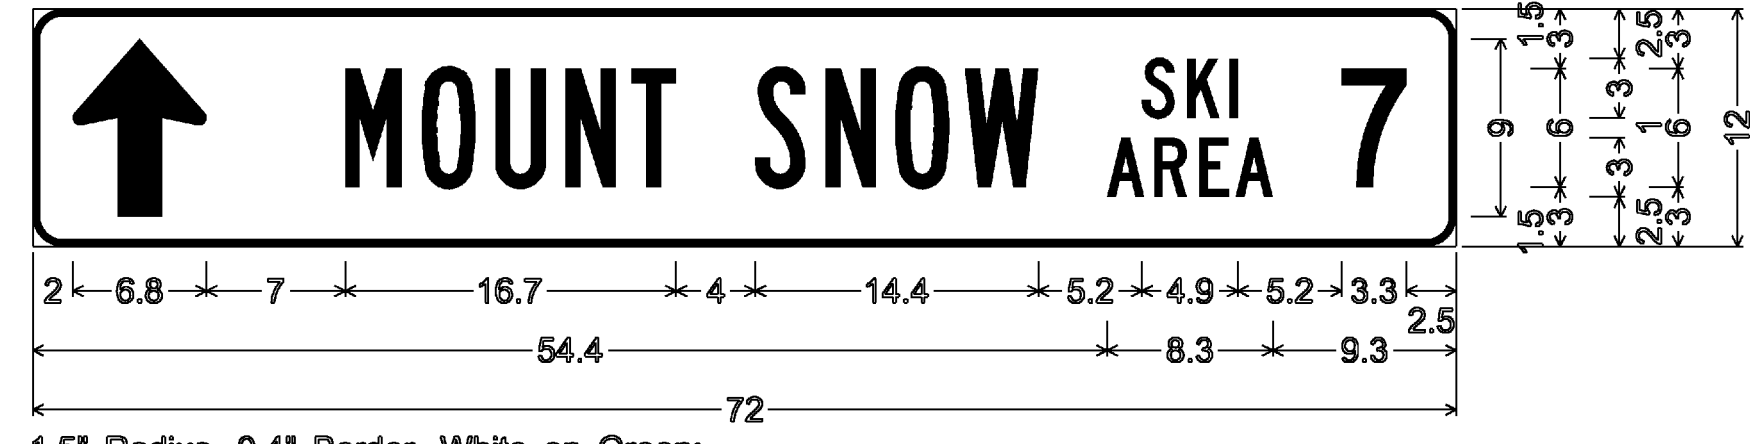


1.5" Radius, 0.4" Border, White on Green;  
 Standard Arrow Custom 9.0" X 6.8" 90°; "MOUNT SNOW" B 90% spacing; "SKI" C;  
 "AREA" C; "7" C;

**D1-1A**

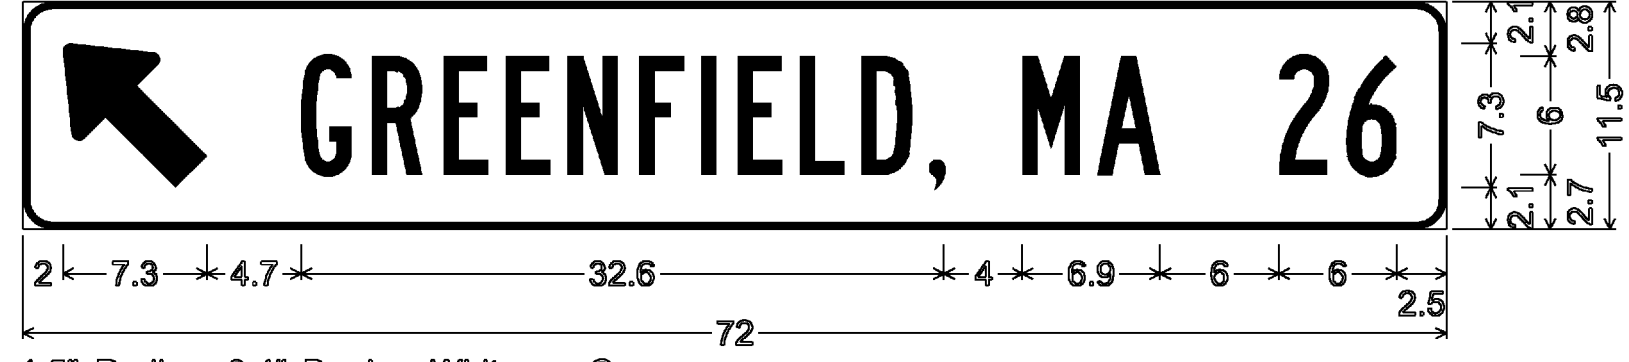


1.5" Radius, 0.4" Border, White on Green;  
 Arrow Custom - 9.0" 135°;  
 "GREENFIELD," B " " C "MA" B " " C "26" B specified length;

**D1-1A**

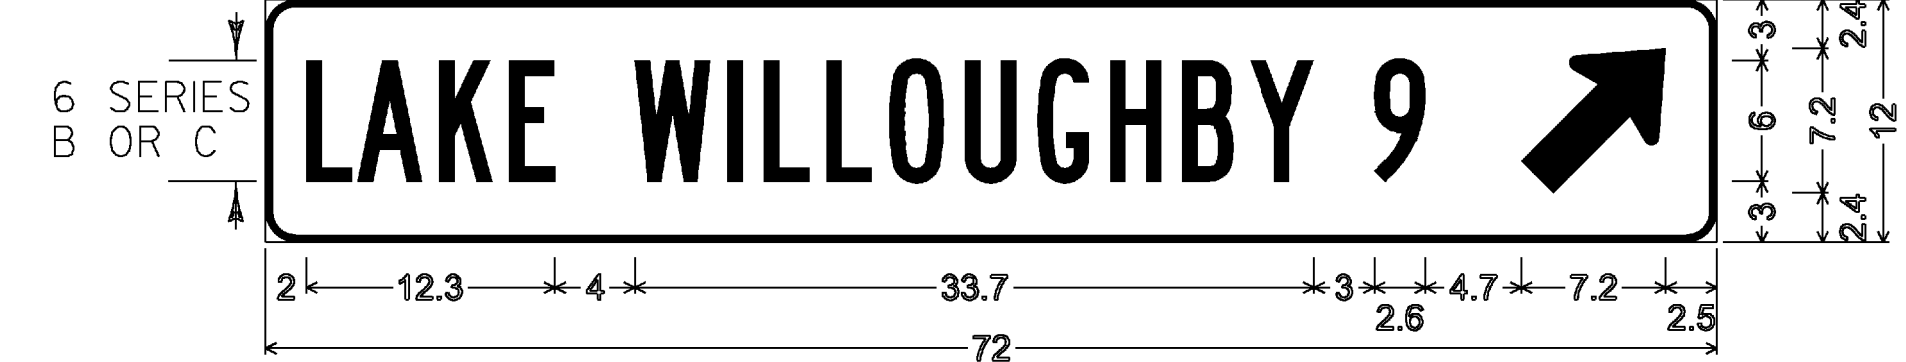

1.5" Radius, 0.4" Border, White on Green;  
 "LAKE WILLOUGHBY" B specified length; "9" B;  
 Standard Arrow Custom 9.0" X 6.0" 45°;

**D1-1A**

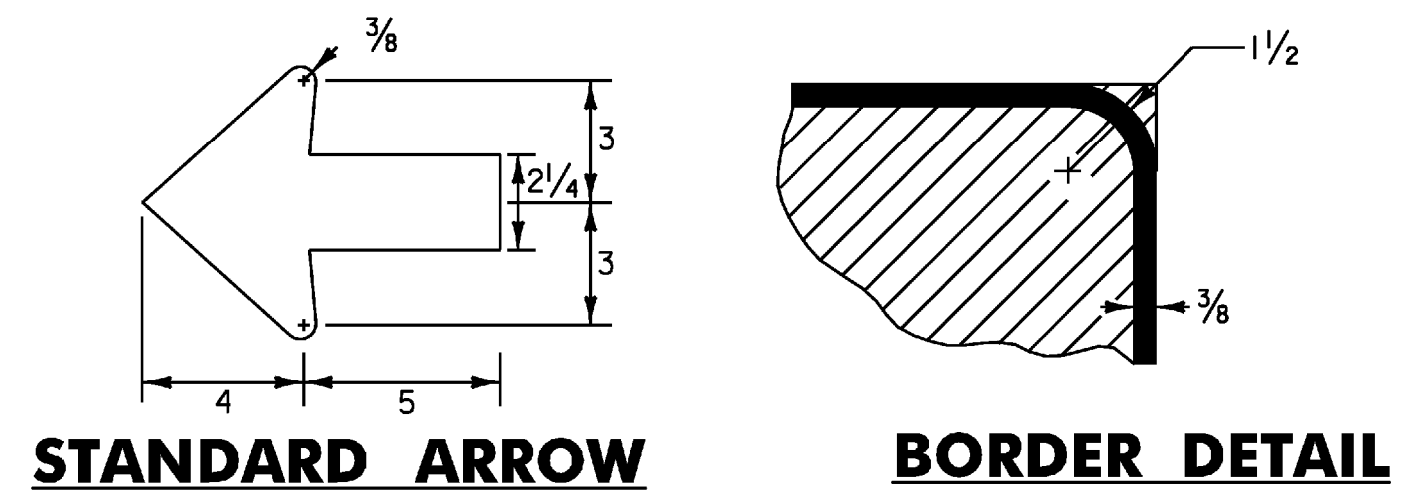


**STANDARD ARROW**


**BORDER DETAIL**

**STANDARD DESTINATION SIGN NOTES  
 D1-1, D1-1A, D1-2, D2-1**

- ALL SIGNS SHALL BE IN ACCORDANCE WITH THE MUTCD AND THE "STANDARD HIGHWAY SIGNS" BOOK (SHS) PUBLISHED BY THE FEDERAL HIGHWAY ADMINISTRATION (FHWA).
- THE SIGN BASE MATERIAL FOR STANDARD DESTINATION SIGNS SHALL BE HIGH DENSITY OVERLAPPED PLYWOOD 3/8 INCH THICK OR FLAT SHEET ALUMINUM 1/8 INCH THICK.
- THE DESTINATION SIGNS SHOWN ON THIS SHEET SHALL HAVE WHITE RETROREFLECTIVE ASTM TYPE III TEXT, ARROWS AND BORDERS ON A GREEN RETROREFLECTIVE ASTM TYPE III BACKGROUND. THE COLORS SHALL CONFORM WITH THE COLORS ADOPTED BY AASHTO AND APPROVED BY THE FHWA.
- MULTIPLE ASSEMBLIES SHALL USE THE SAME SIZE THROUGHOUT. DO NOT MIX AND MATCH OLDER SIGN SIZES WITH NEW SIGN HEIGHTS AND WIDTHS.
- ALL DIMENSIONS SHOWN IN INCHES UNLESS OTHERWISE NOTED.

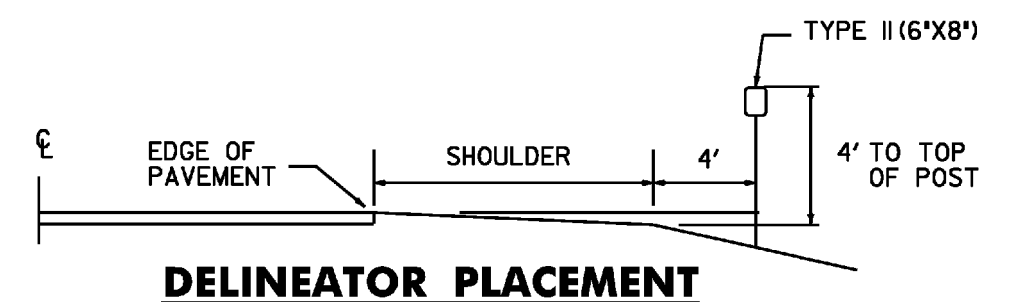

**DELINEATOR PLACEMENT**

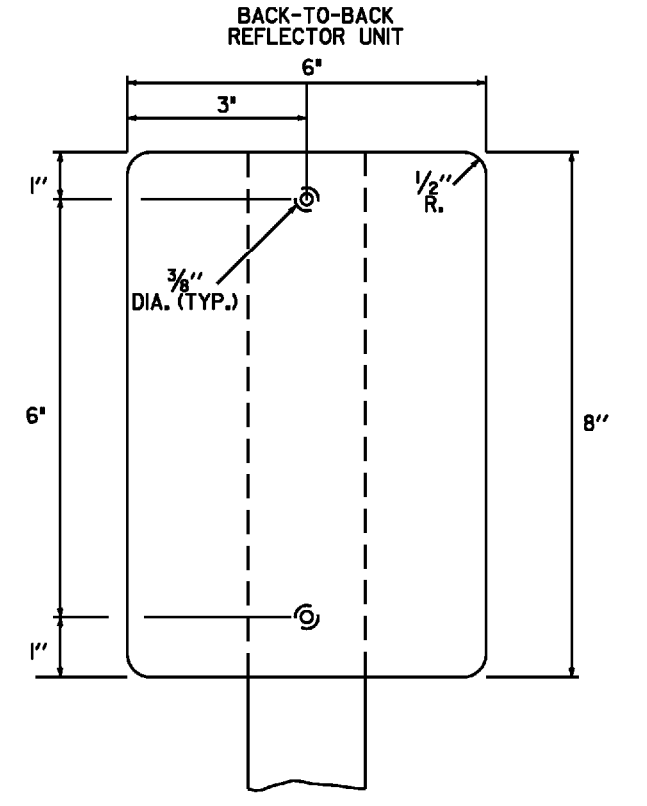


**TYPE II (6'x8')**

**DELINEATORS WITH RETROREFLECTIVE SHEETING**


MATERIAL FOR RETROREFLECTIVE SHEETING FOR DELINEATORS SHALL BE A 0.063" ALUMINUM BACKING WITH A WHITE ASTM TYPE III OR TYPE IV.

PROJECT NAME:	MORETOWN - NEWPORT TOWN
PROJECT NUMBER:	STPG SIGN (28)
FILE NAME:	09B060_TS.DGN
PROJECT LEADER:	N. AVERY
DESIGNED BY:	N. AVERY
SIGN DETAILS I	
PLOT DATE:	30-SEP-2009
DRAWN BY:	N. AVERY
CHECKED BY:	A. GAMBLE
SHEET	5 OF 166

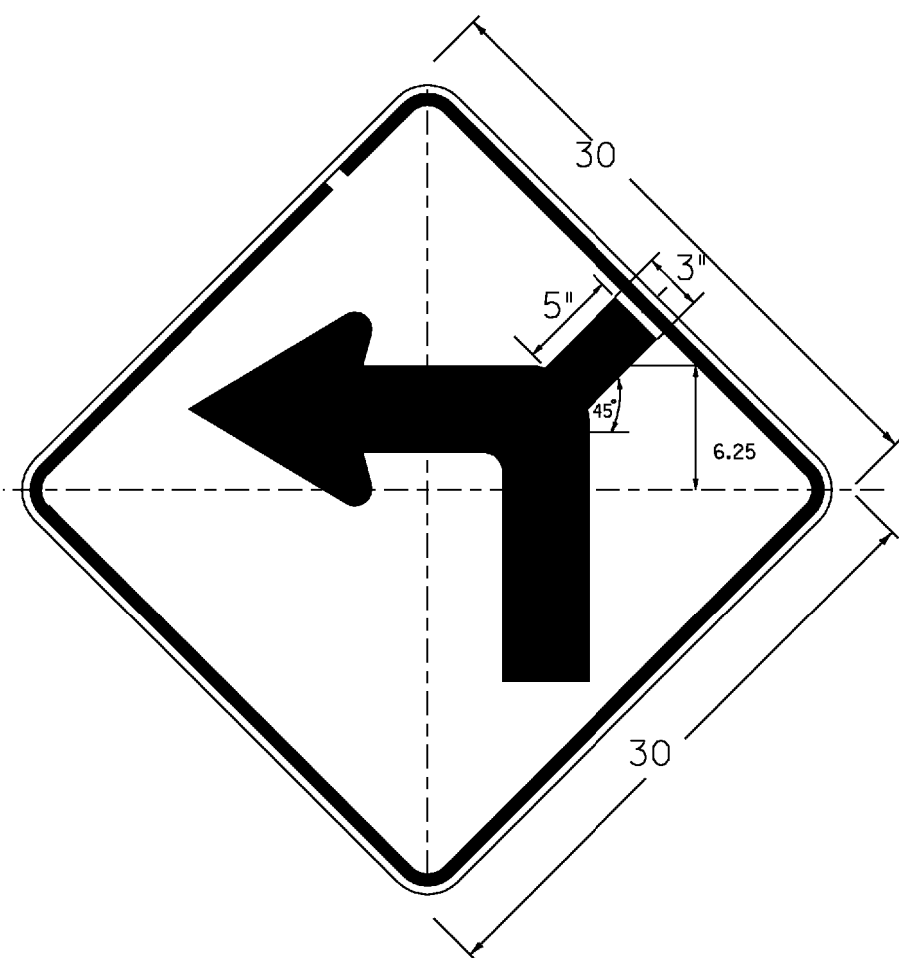


**W1-1Md L(R)**

DIMENSIONS NOT SHOWN FOR THIS DETAIL SHALL CONFORM TO THE LATEST EDITION OF THE 2003 MUTCD FOR SIGN DETAIL W1-1, UNLESS OTHERWISE NOTED FOR THIS DETAIL

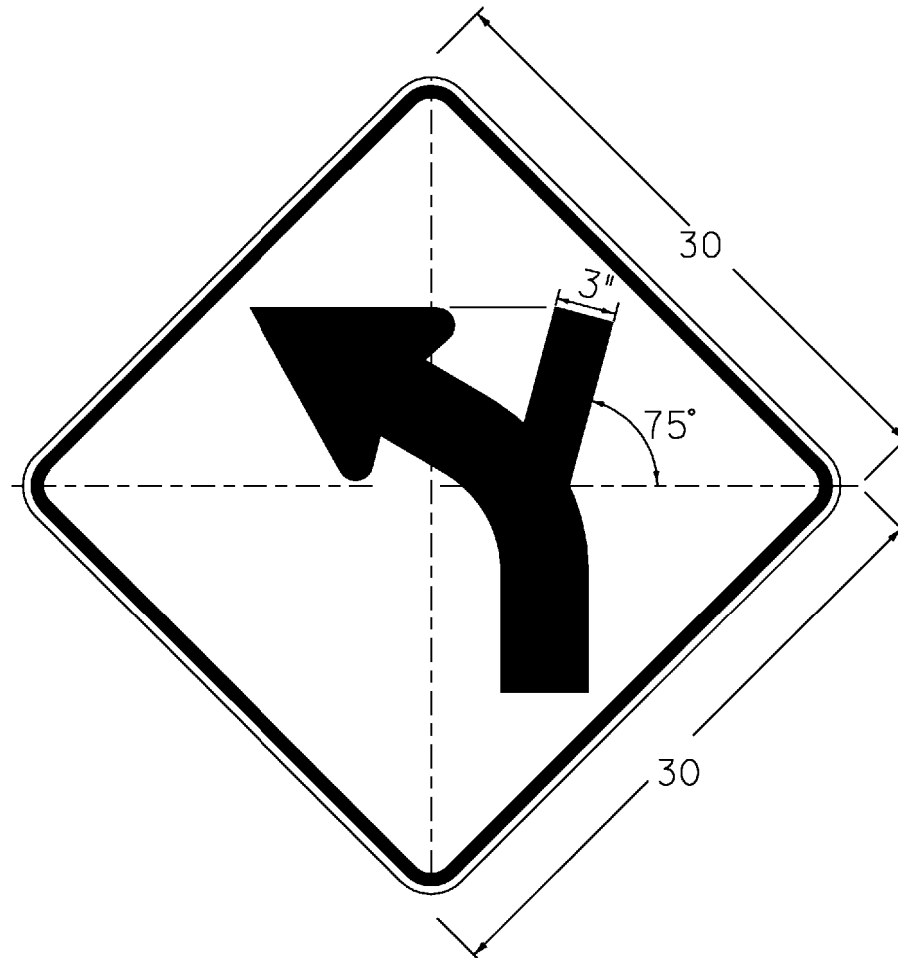


**W1-2Mi L(R)**

DIMENSIONS NOT SHOWN FOR THIS DETAIL SHALL CONFORM TO THE LATEST EDITION OF THE 2003 MUTCD FOR SIGN DETAIL W1-2, UNLESS OTHERWISE NOTED FOR THIS DETAIL

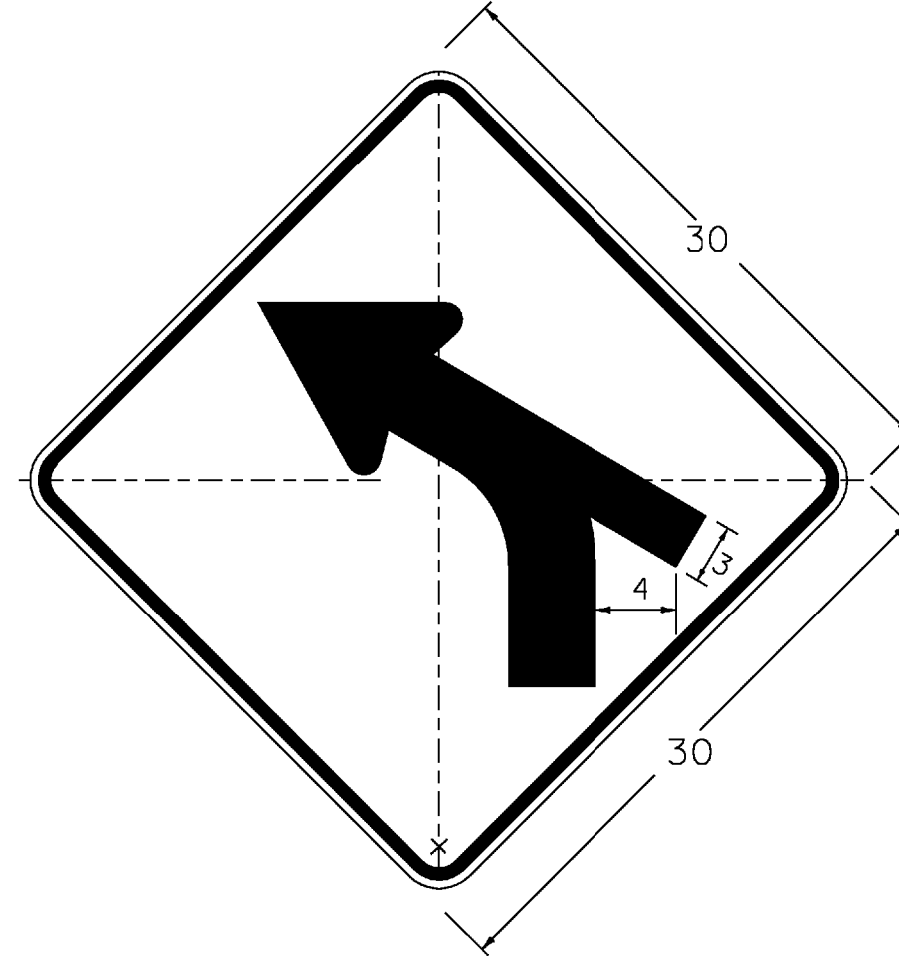


**W1-2Mh L(R)**

DIMENSIONS NOT SHOWN FOR THIS DETAIL SHALL CONFORM TO THE LATEST EDITION OF THE 2003 MUTCD FOR SIGN DETAIL W1-2, UNLESS OTHERWISE NOTED FOR THIS DETAIL

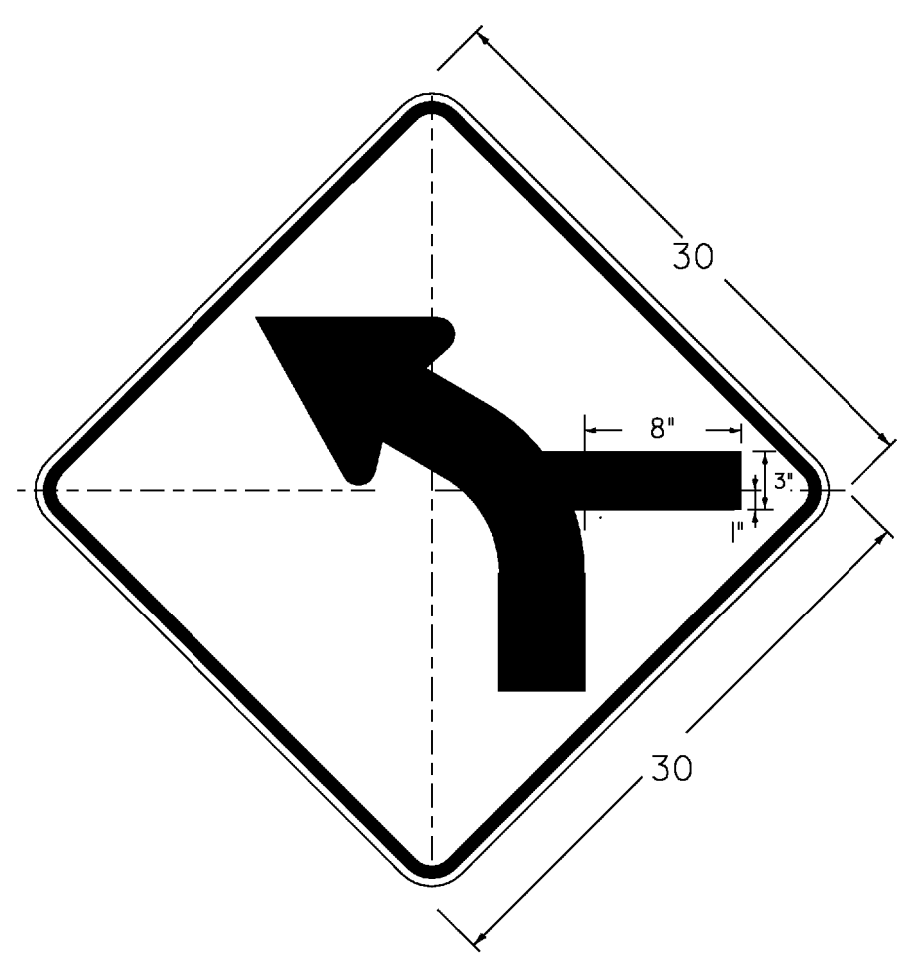


**W1-2Mc L**

DIMENSIONS NOT SHOWN FOR THIS DETAIL SHALL CONFORM TO THE LATEST EDITION OF THE 2003 MUTCD FOR SIGN DETAIL W1-2, UNLESS OTHERWISE NOTED FOR THIS DETAIL

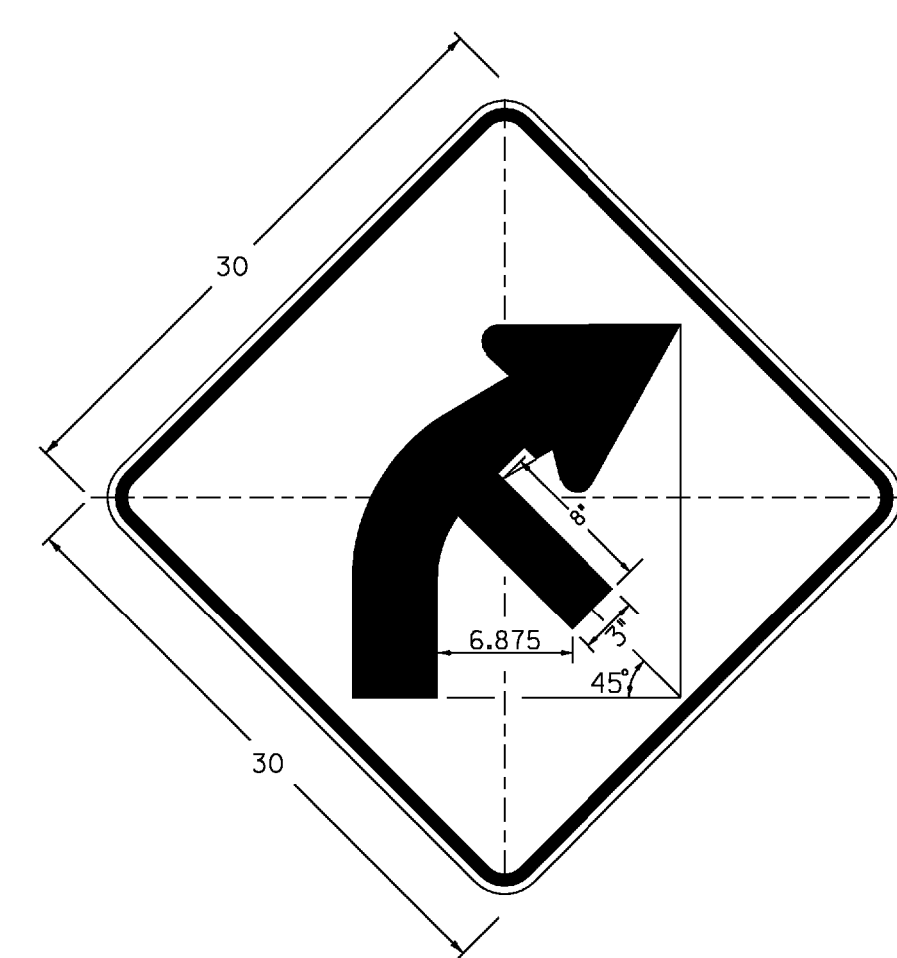


**W1-2Mb R(L)**

DIMENSIONS NOT SHOWN FOR THIS DETAIL SHALL CONFORM TO THE LATEST EDITION OF THE 2003 MUTCD FOR SIGN DETAIL W1-2, UNLESS OTHERWISE NOTED FOR THIS DETAIL

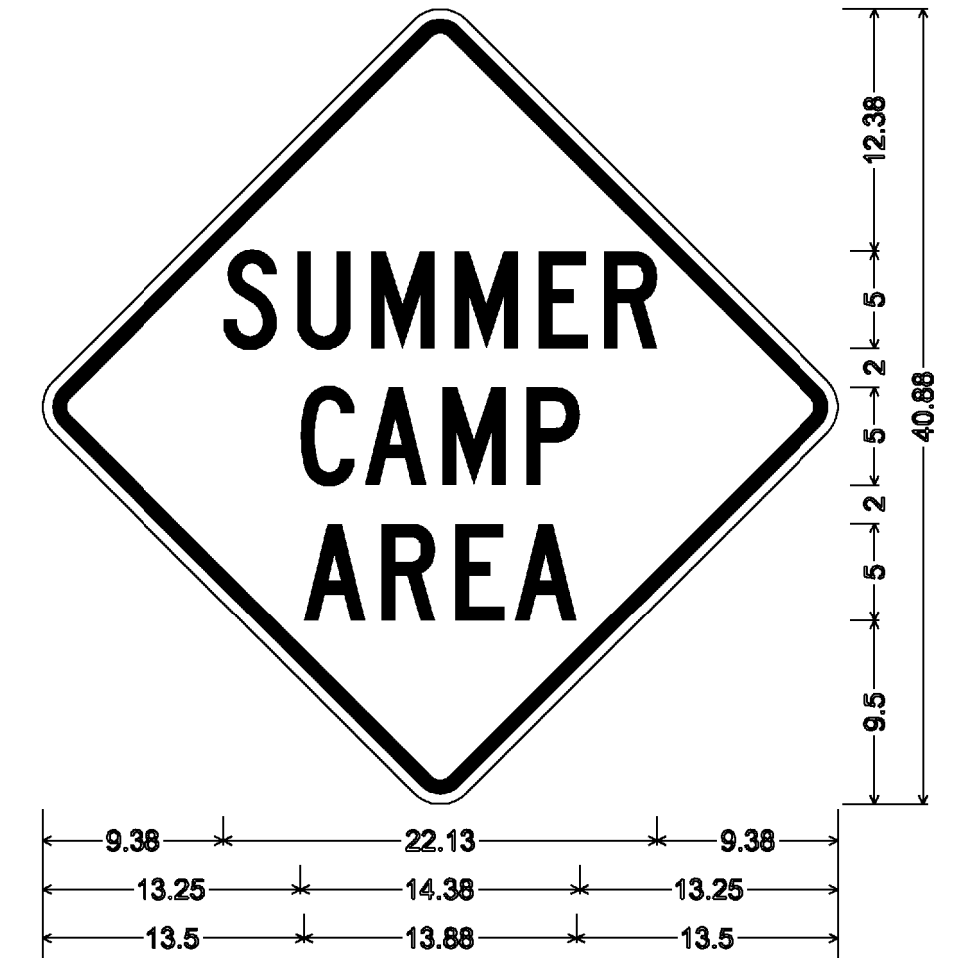


1.875" RADIUS, 0.75" BORDER, 0.5" INDENT  
 COLORS: LEGEND - BLACK  
 BACKGROUND - YELLOW  
 TEXT STYLE: "SUMMER" C; "CAMP" C; "AHEAD" C

**VW-219**

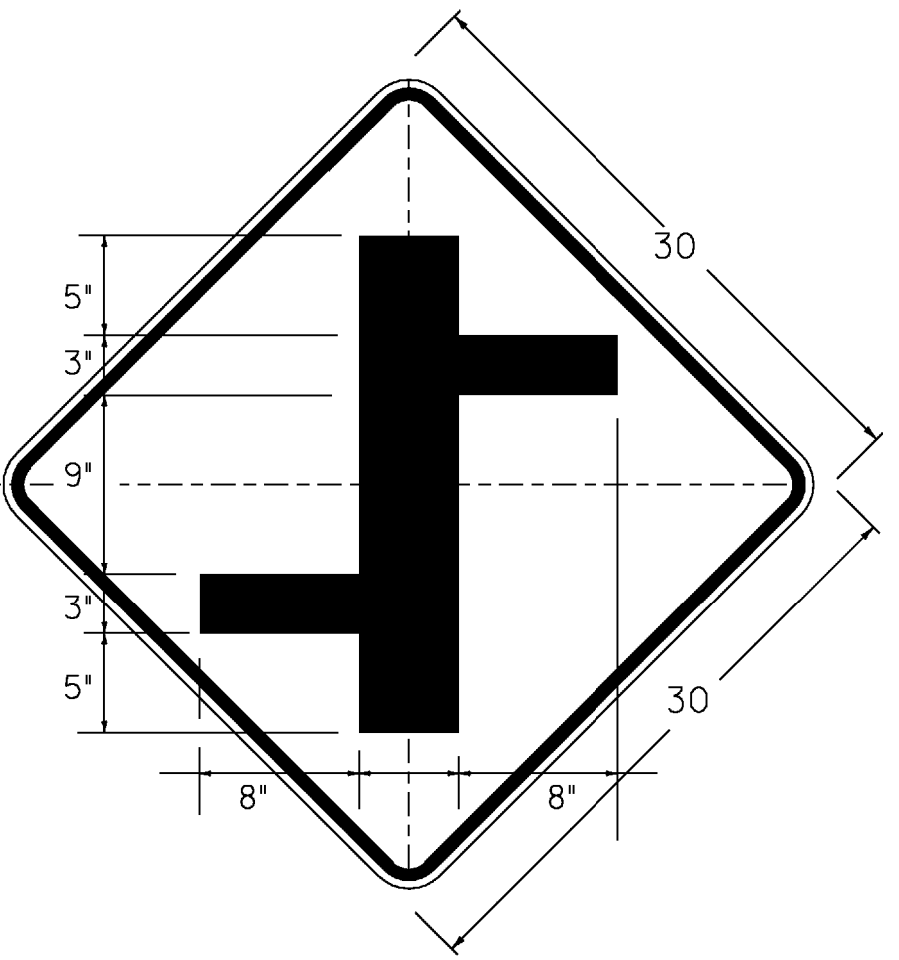


**W2-1Me**

DIMENSIONS NOT SHOWN FOR THIS DETAIL SHALL CONFORM TO THE LATEST EDITION OF THE 2003 MUTCD FOR SIGN DETAIL W2-1, UNLESS OTHERWISE NOTED FOR THIS DETAIL

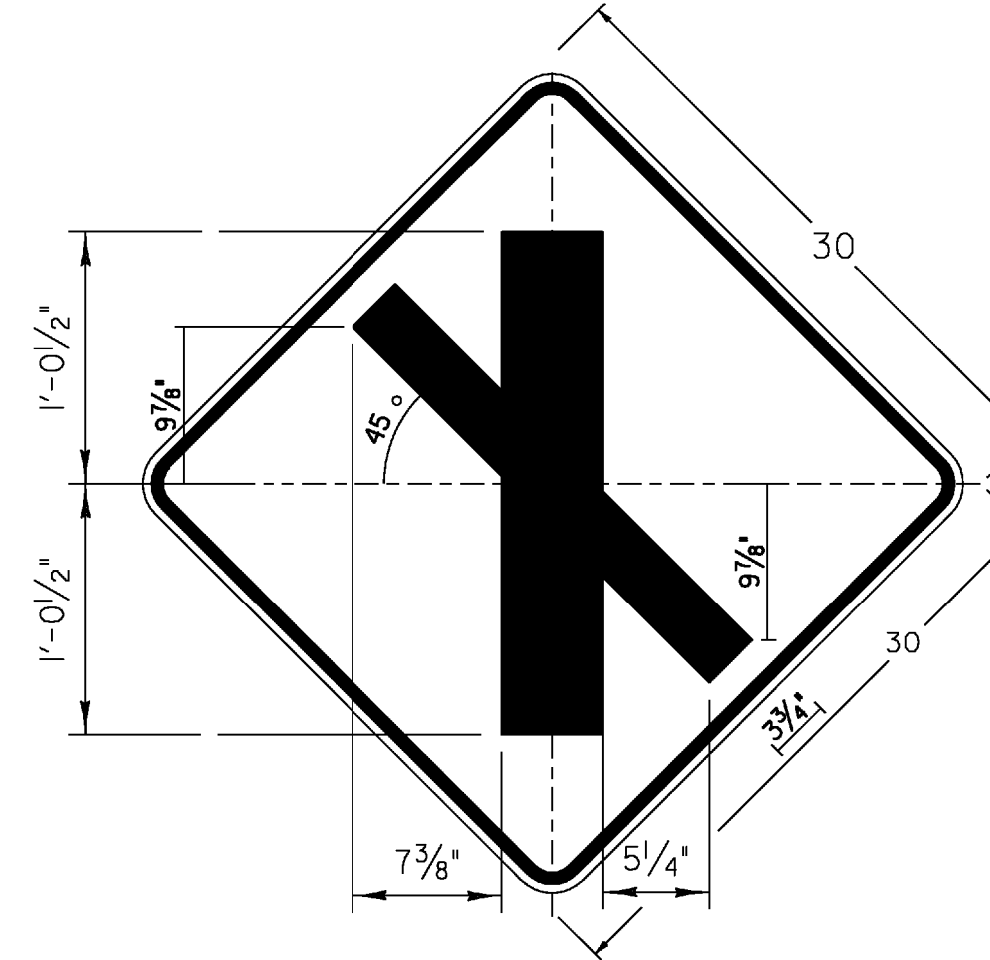


**W2-1Mh**

DIMENSIONS NOT SHOWN FOR THIS DETAIL SHALL CONFORM TO THE LATEST EDITION OF THE 2003 MUTCD FOR SIGN DETAIL W2-1, UNLESS OTHERWISE NOTED FOR THIS DETAIL

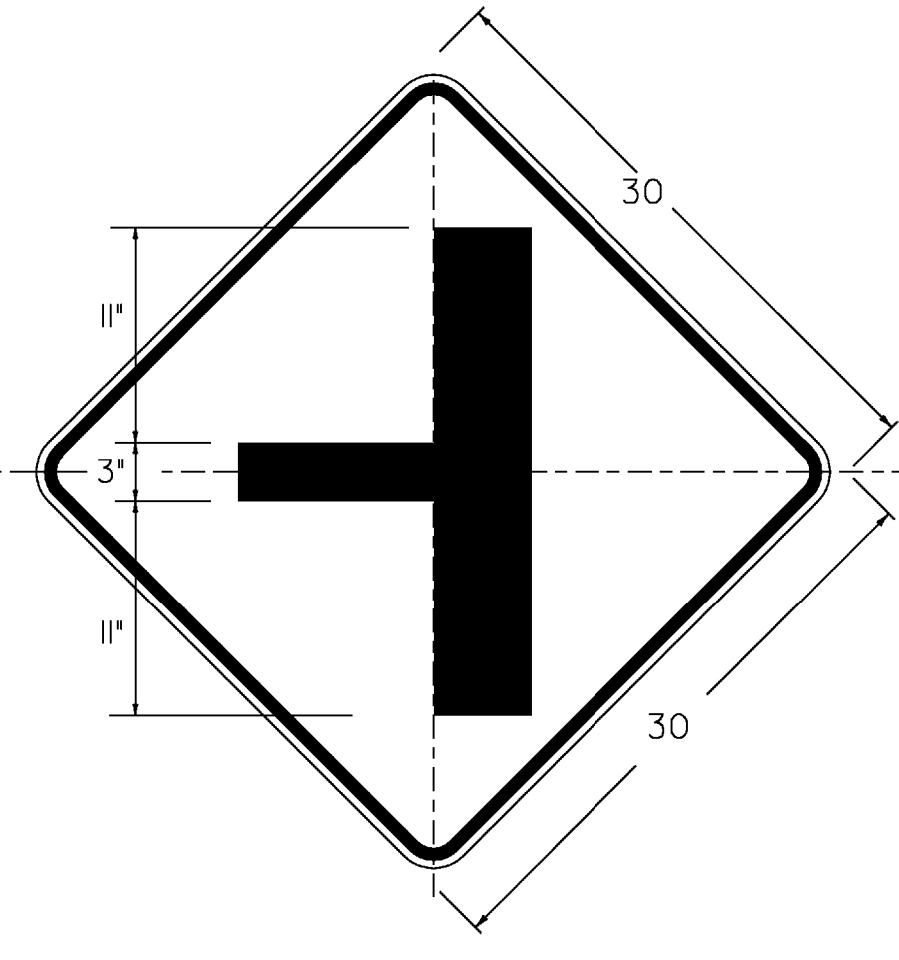


**W2-2Ma L(R)**

DIMENSIONS NOT SHOWN FOR THIS DETAIL SHALL CONFORM TO THE LATEST EDITION OF THE 2003 MUTCD FOR SIGN DETAIL W2-2, UNLESS OTHERWISE NOTED FOR THIS DETAIL

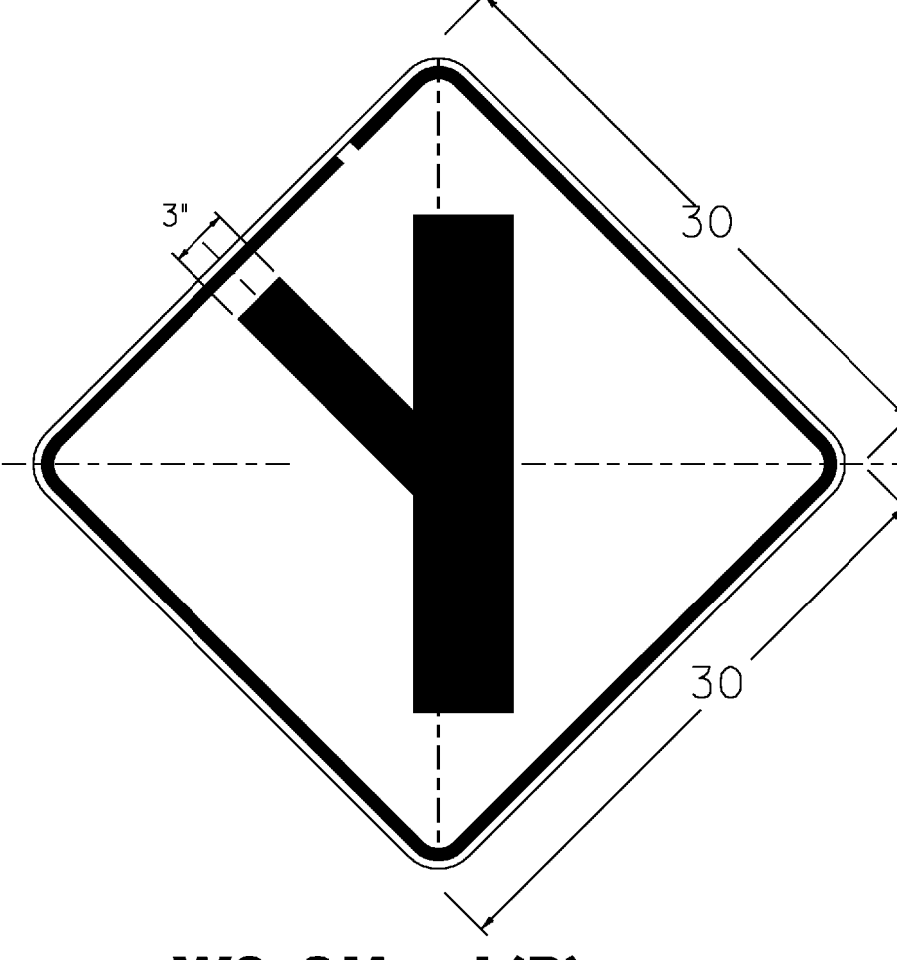


**W2-3Ma L(R)**

DIMENSIONS NOT SHOWN FOR THIS DETAIL SHALL CONFORM TO THE LATEST EDITION OF THE 2003 MUTCD FOR SIGN DETAIL W2-3, UNLESS OTHERWISE NOTED FOR THIS DETAIL

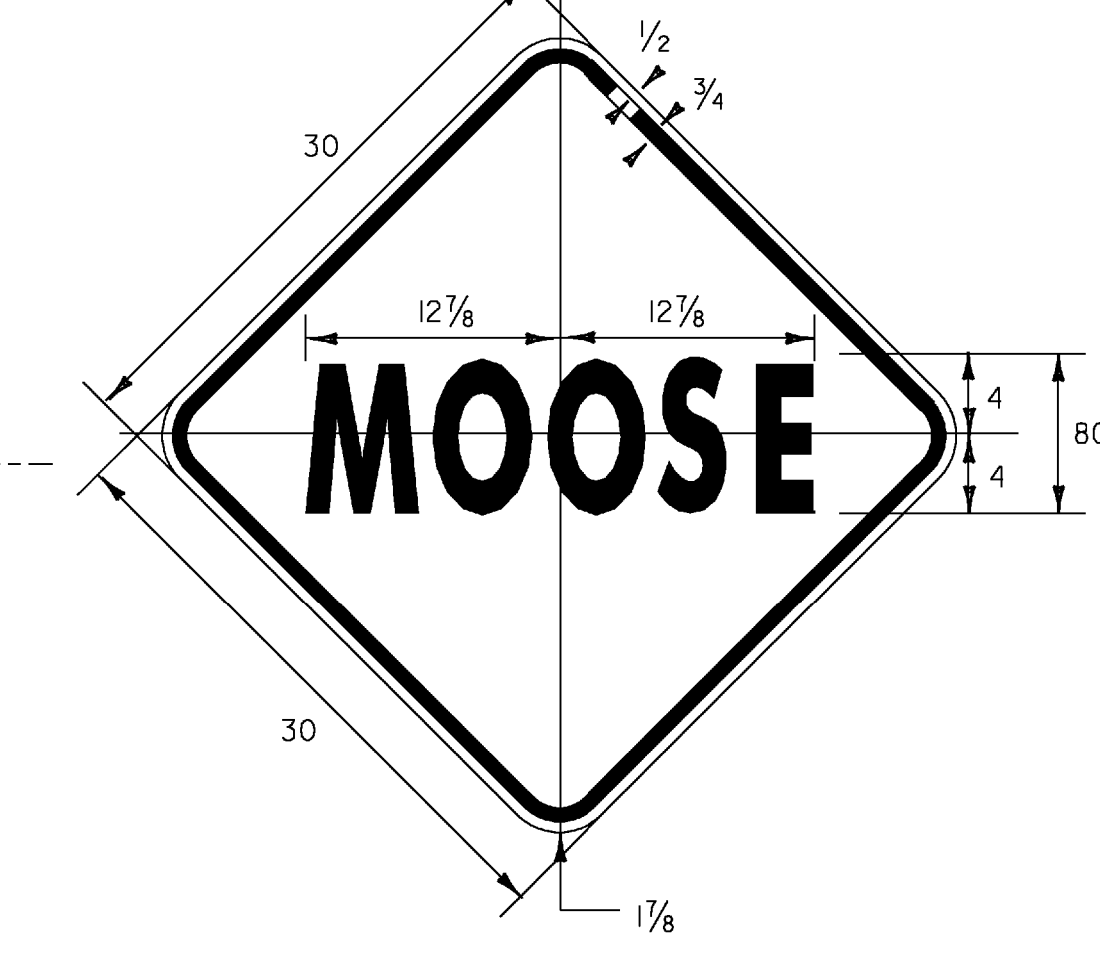


**VW-001**

COLORS: LEGEND - BLACK  
 BACKGROUND - YELLOW

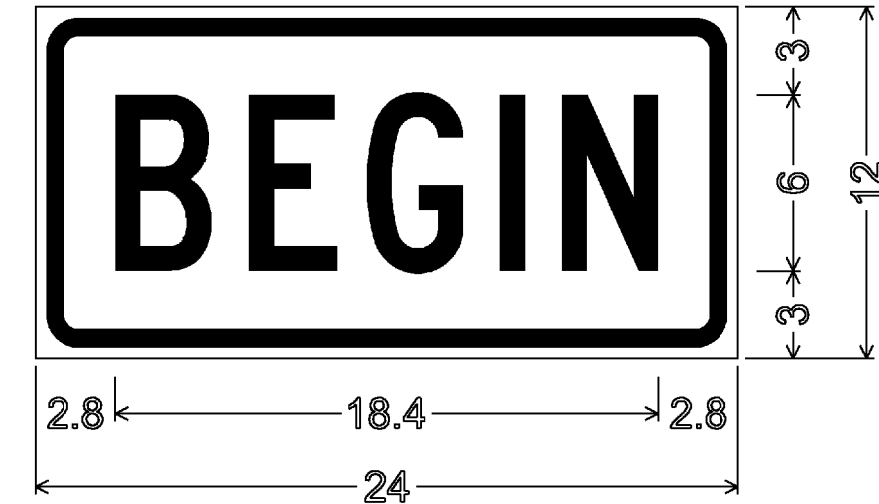


1.5" RADIUS, 0.625" BORDER, 0.375" INDENT  
 COLORS: LEGEND - RED  
 BACKGROUND - WHITE  
 TEXT STYLE: "BEGIN" C

**VR-644p**

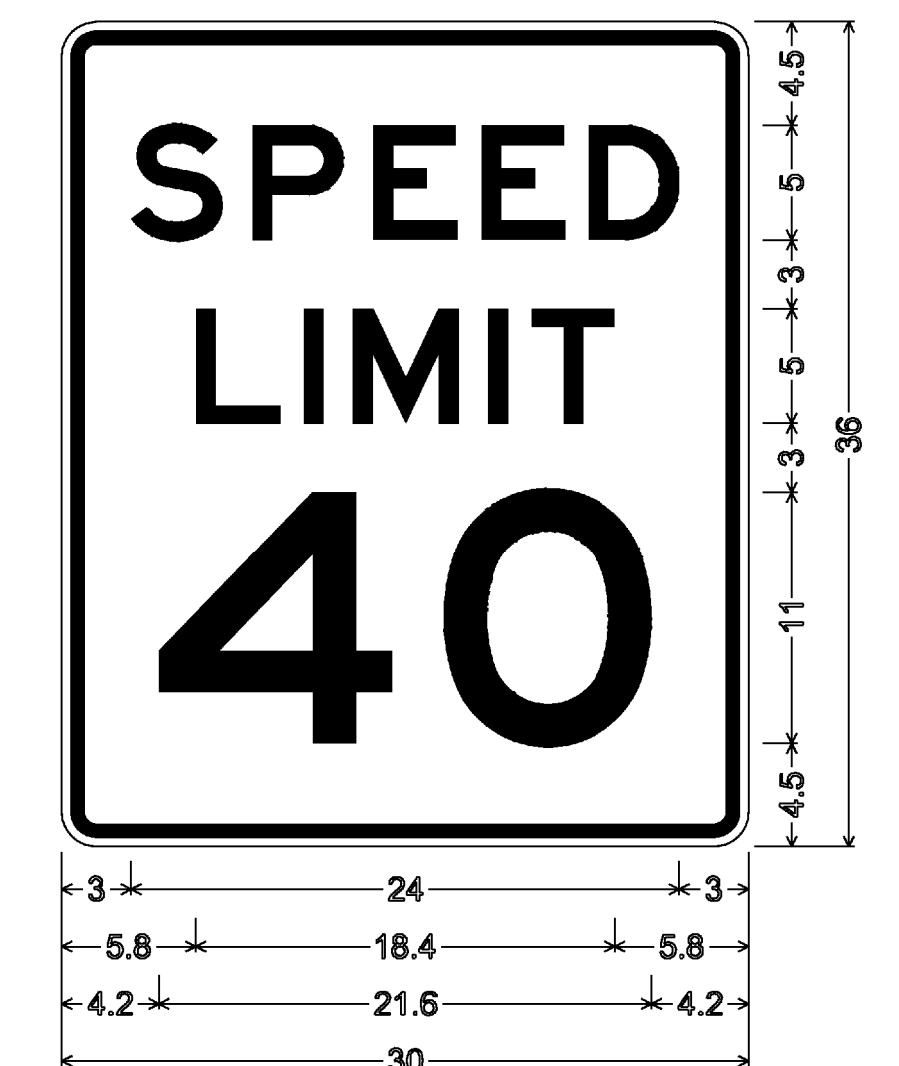


**R2-1**

1.5" RADIUS, 0.625" BORDER, 0.375" INDENT  
 COLORS: LEGEND - BLACK  
 BACKGROUND - WHITE  
 TEXT STYLE: "SPEED" E; "LIMIT" E; "40" E

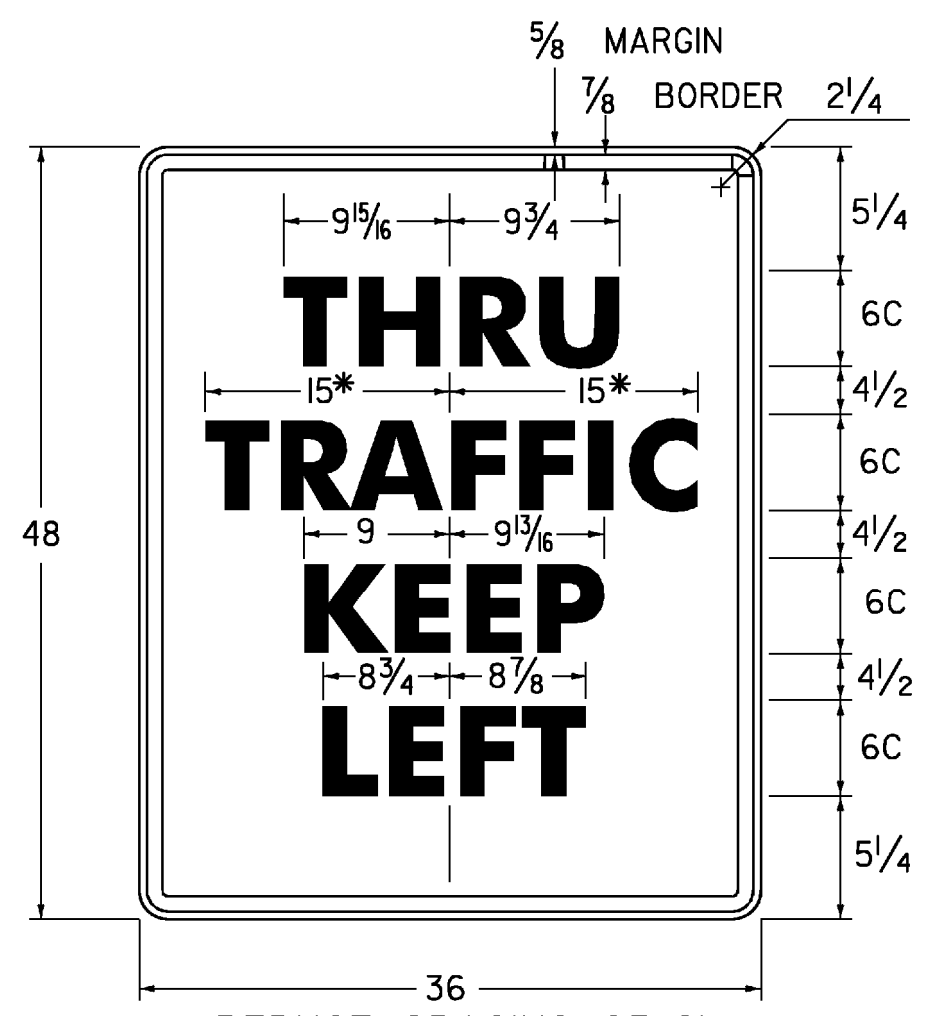

**VR-118L**

\* REDUCE SPACING 25 %  
 COLORS: LEGEND - BLACK  
 BACKGROUND - WHITE

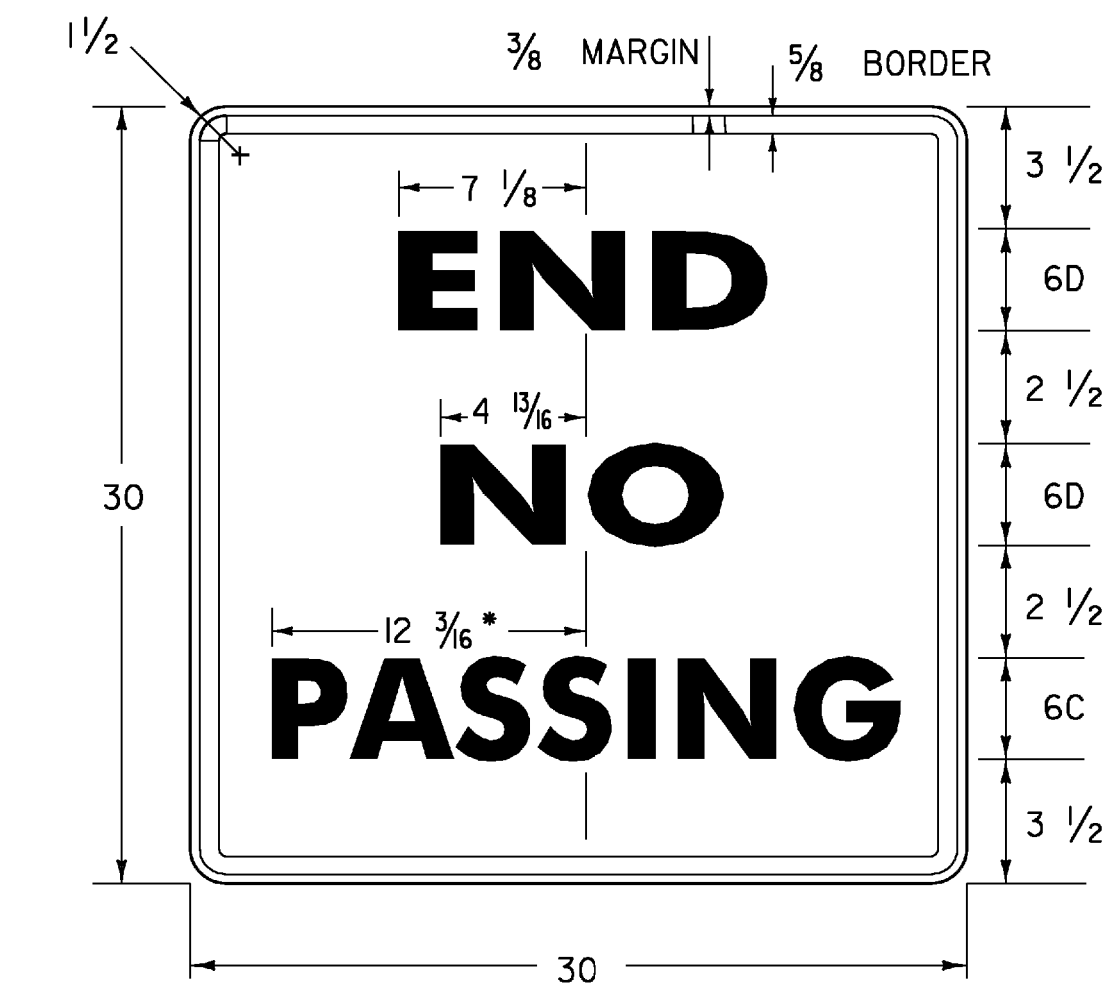


**VR-417**

\* REDUCE SPACING 50 %  
 COLORS: LEGEND - BLACK  
 BACKGROUND - WHITE



**VR-023b**

\* REDUCE SPACING 40%  
 \*\* REDUCE SPACING 60%  
 COLORS: LEGEND - BLACK  
 BACKGROUND - WHITE

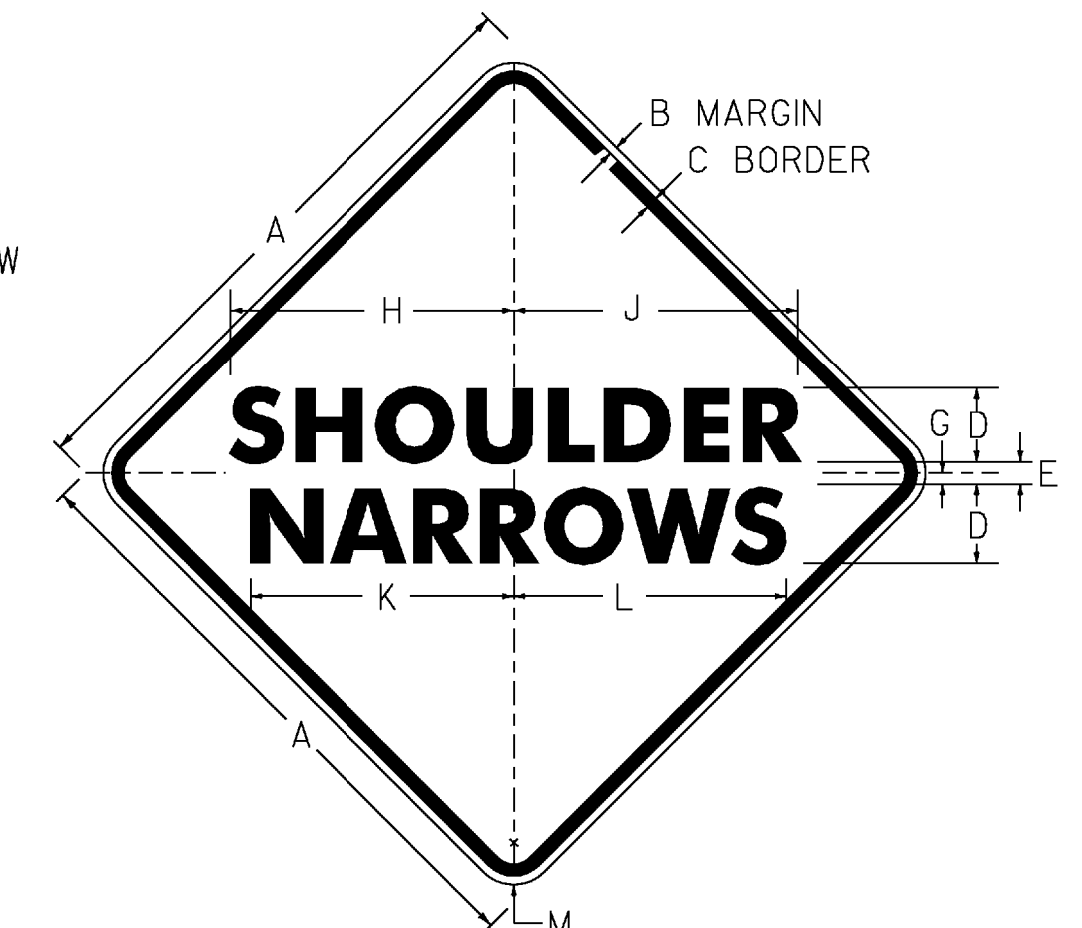

**VW-619**

COLORS: LEGEND - BLACK  
 BACKGROUND - YELLOW


SIGN	DIMENSIONS ( INCHES )											
	A	B	C	D	E	F	G	H	J	K	L	M
MIN & STD.	36	5/8	7/8	5C	3	6D	I	13 1/16	13 3/16	17 5/8	18 1/4	2 1/4
EXPWY.	48	3/4	1 1/4	7D	3 1/2	7D	I	23 13/16	23 7/8	21 1/2	21 1/16	3

PROJECT NAME: MORETOWN - NEWPORT TOWN  
 PROJECT NUMBER: STPG SIGN (28)

FILE NAME: 09B060\_TS.DGN  
 PROJECT LEADER: N. AVERY  
 DESIGNED BY: N. AVERY  
 SIGN DETAILS 2

PLOT DATE: 30-SEP-2009  
 DRAWN BY: N. AVERY  
 CHECKED BY: A. GAMBLE  
 SHEET 6 OF 166


**ROUTE MARKER ASSEMBLY FRAMES**

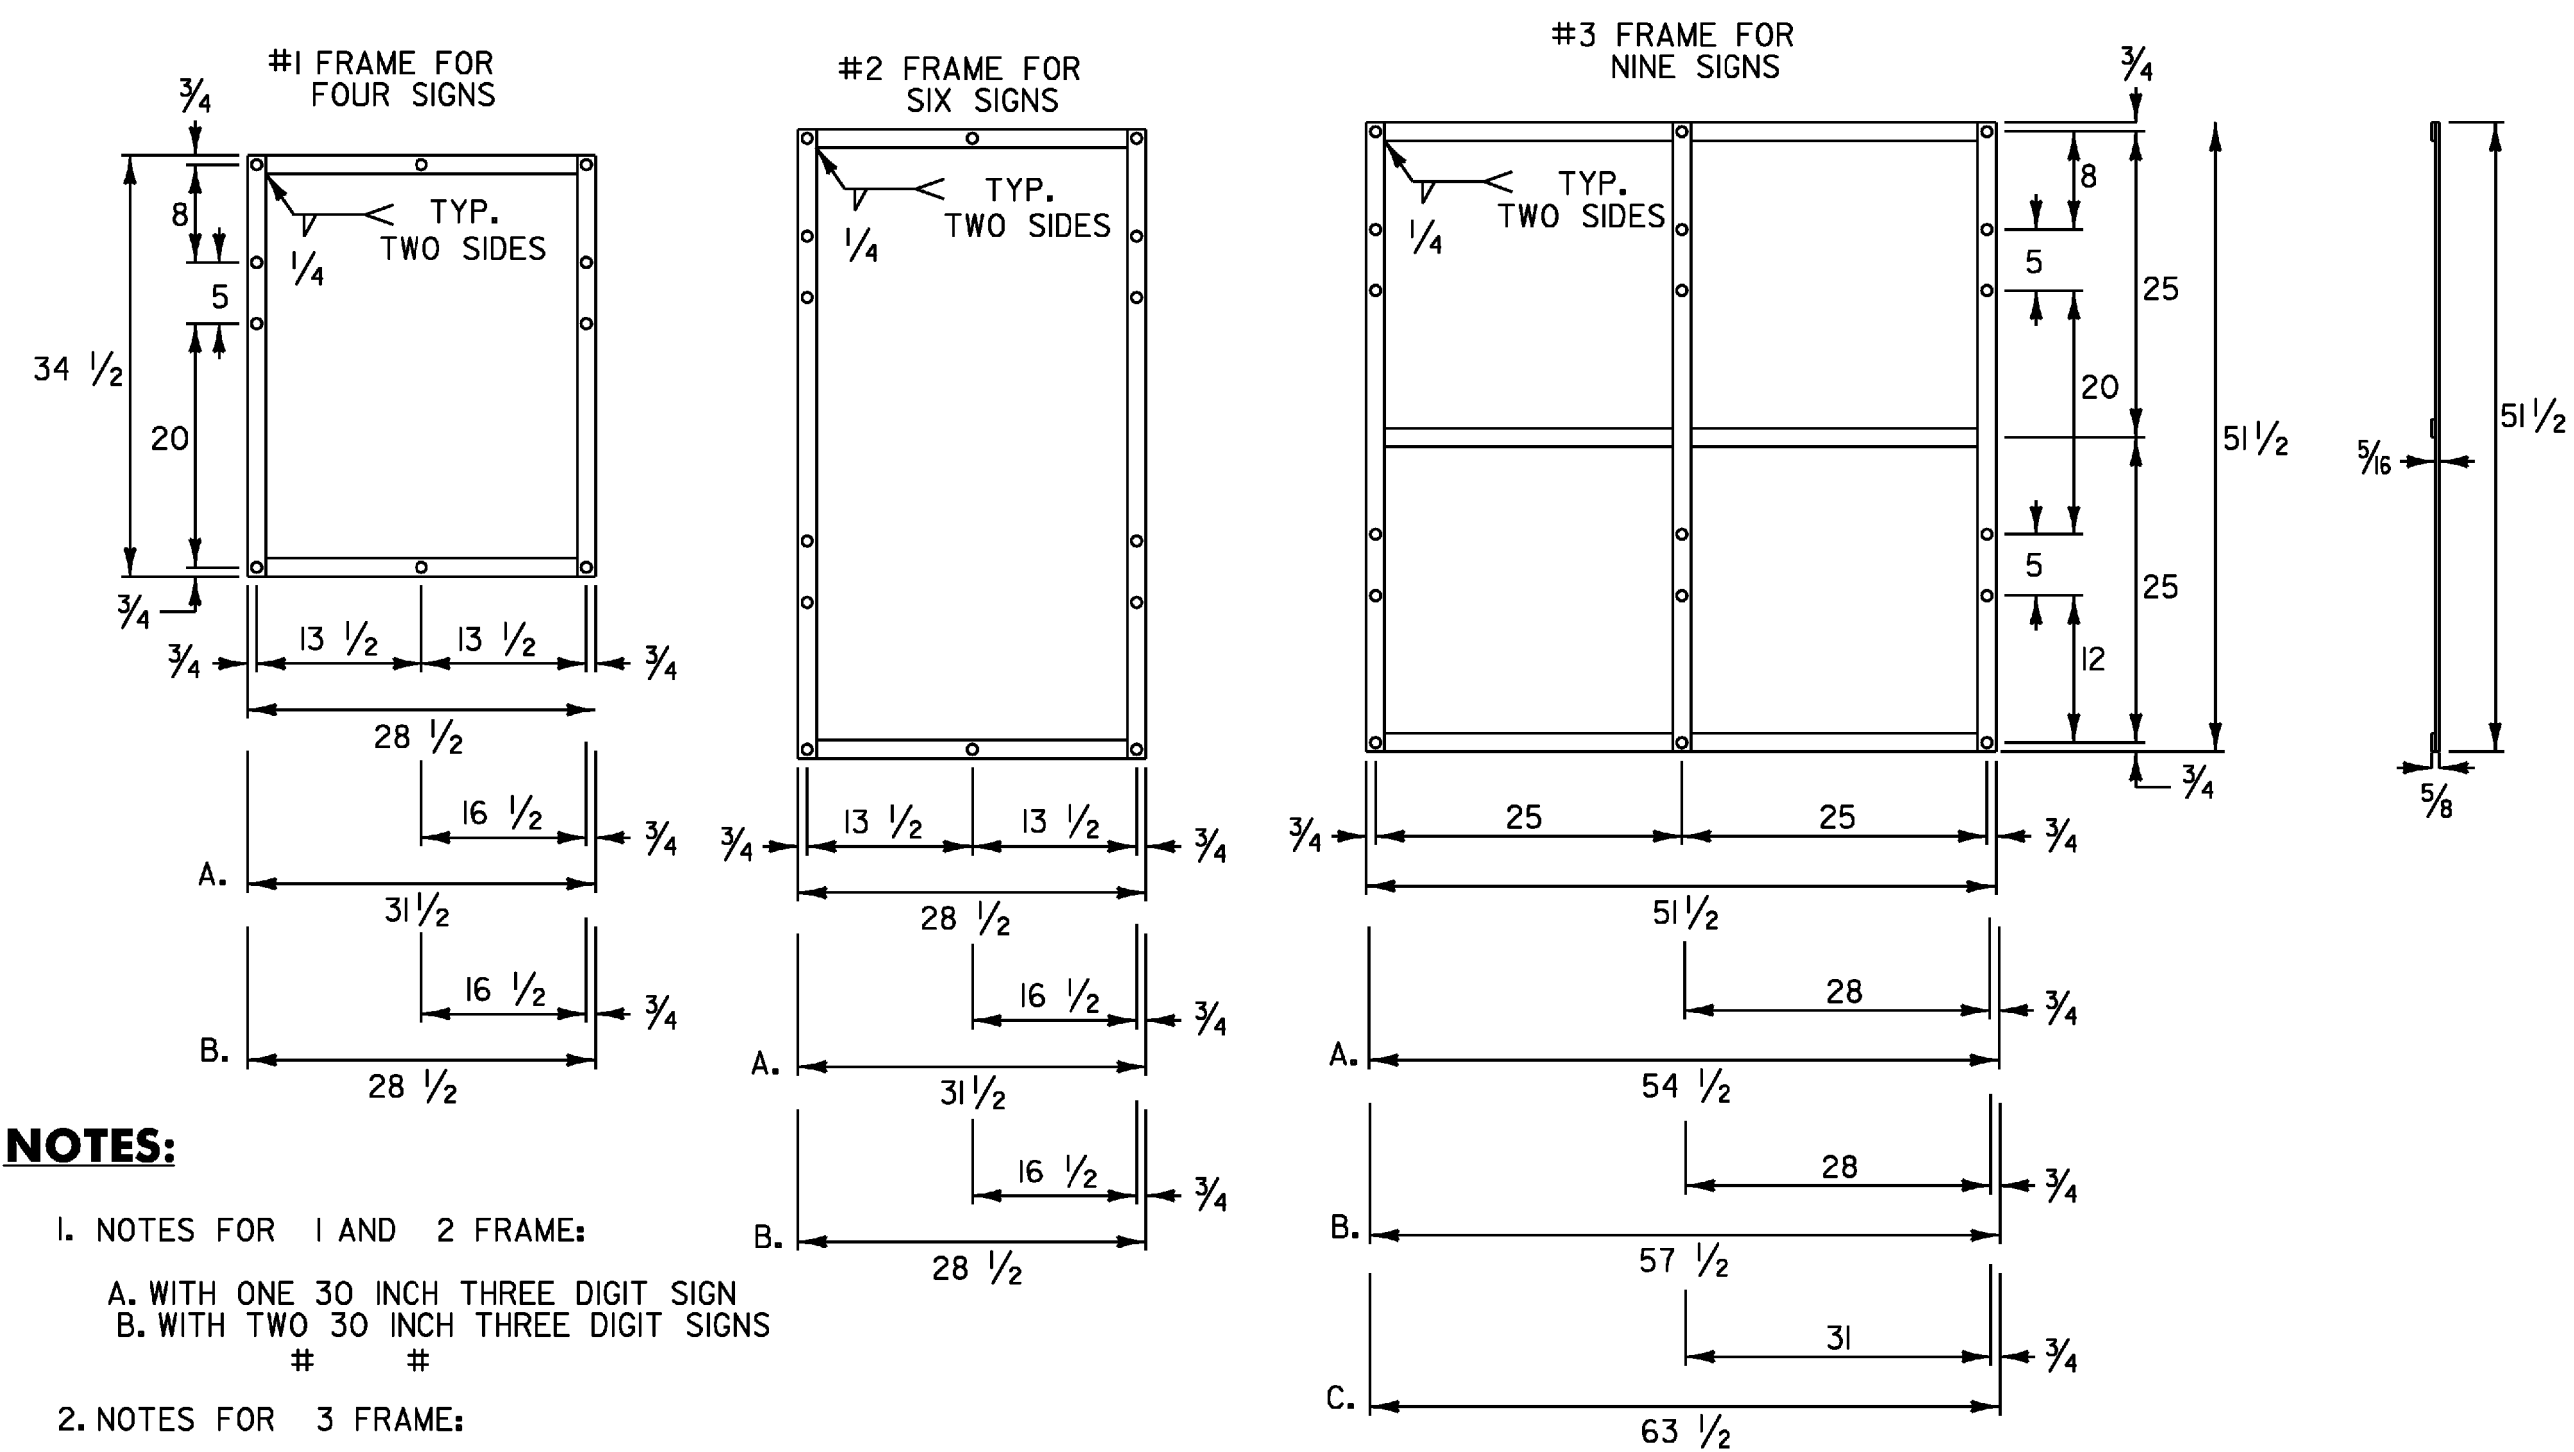

**NOTES:**

- NOTES FOR 1 AND 2 FRAME:
  - WITH ONE 30 INCH THREE DIGIT SIGN
  - WITH TWO 30 INCH THREE DIGIT SIGNS
- NOTES FOR 3 FRAME:
  - WITH ONE 30 INCH THREE DIGIT SIGN IN AN OUTSIDE POSITION.
  - WITH ONE 30 INCH THREE DIGIT SIGN IN THE CENTER POSITION OR TWO SUCH SIGNS IN THE OUTSIDE POSITIONS.
  - WITH THREE 30 INCH THREE DIGIT SIGNS.
- ALL HOLES SHALL BE 7/16 INCH DIAMETER. FOR OTHER SIGN COMBINATIONS, THAN ABOVE, THE FRAME DIMENSIONS AND HOLE SPACING SHALL BE MODIFIED AS NECESSARY. THE FRAME SHALL BE PAINTED WITH ONE COAT OF PRIMER AND A SECOND COAT OF BLACK PAINT. THE PAINT SHALL BE OF THE TYPE USED ON EXTERIOR METAL SURFACES TO PREVENT METAL CORROSION.
- STANDARD FRAMES SHALL BE 5/16 INCH x 1/2 INCH WELDED A-36 STEEL.
- ALL DIMENSIONS SHOWN IN INCHES UNLESS OTHERWISE NOTED.

**STANDARD MOUNTING OF ROUTE MARKER ASSEMBLIES**

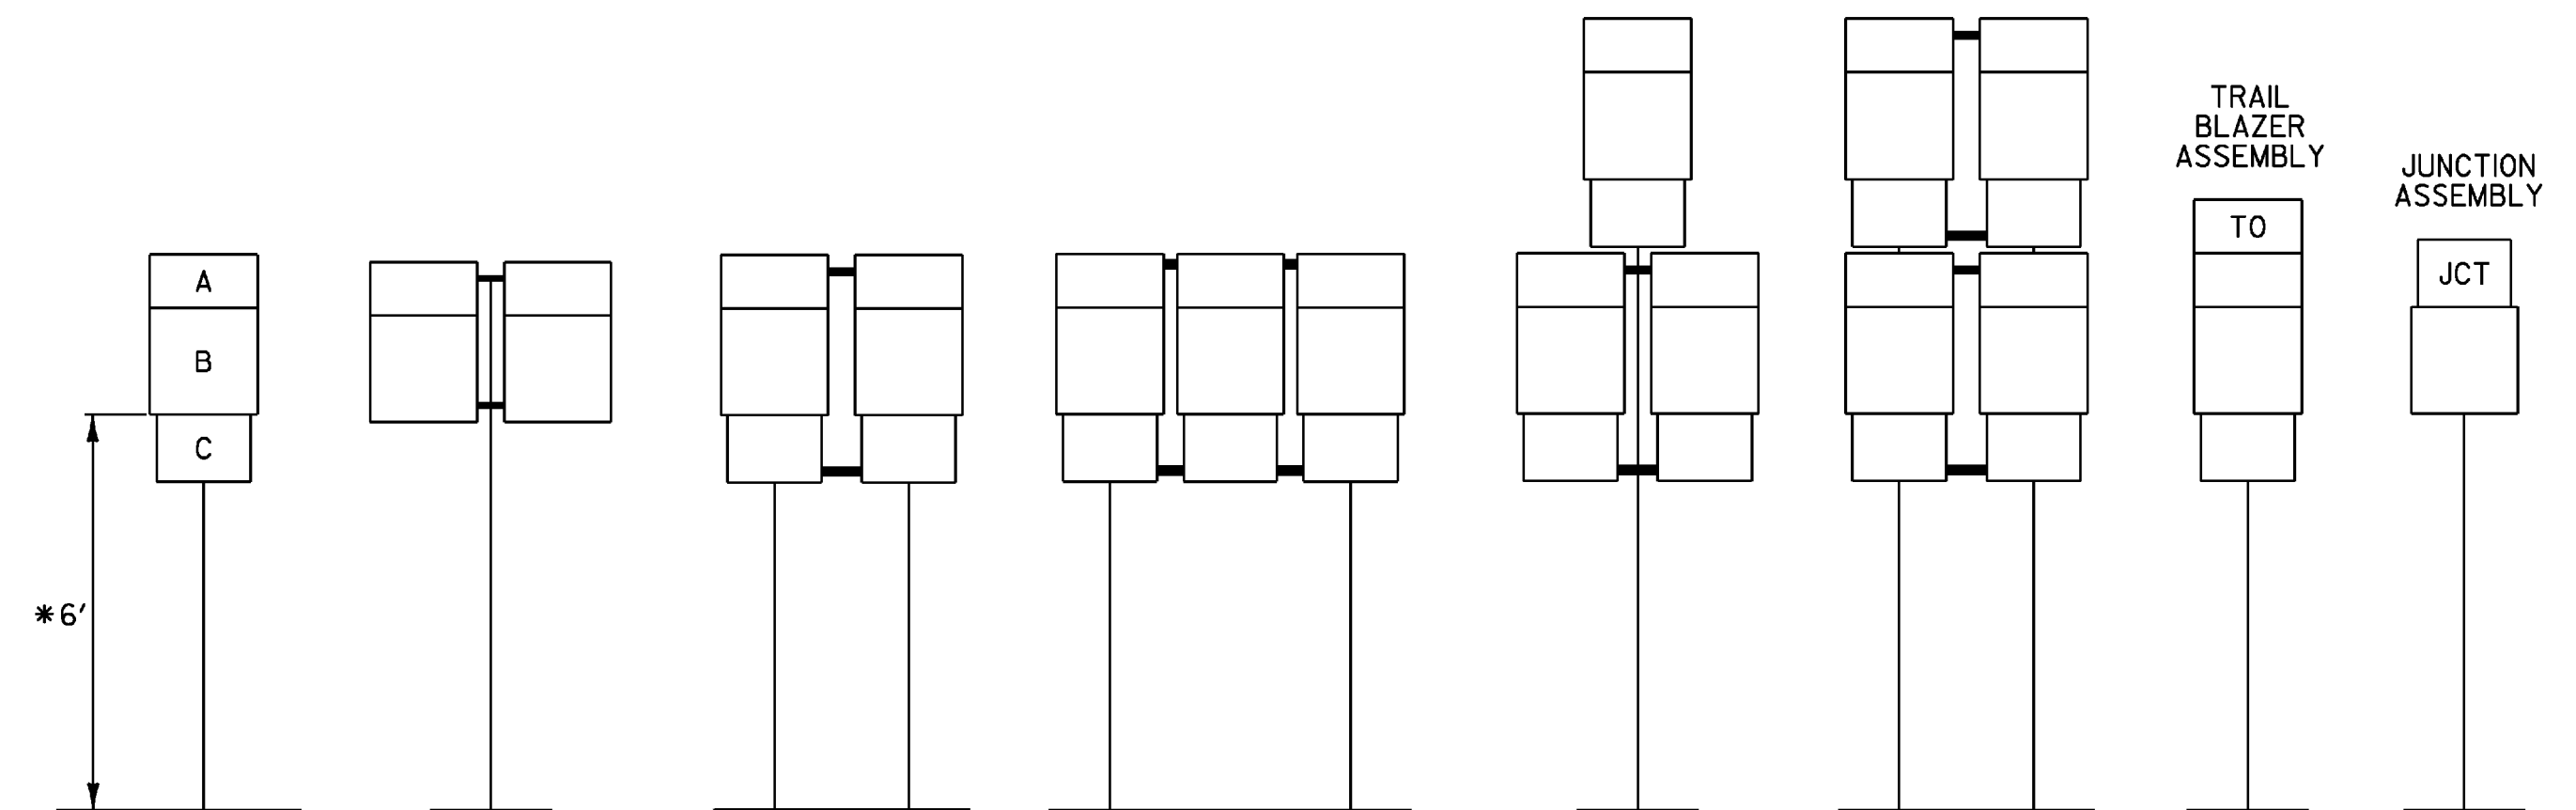

- A - CARDINAL DIRECTION MARKER
- B - ROUTE NUMBER
- C - ADVANCE TURN ARROW OR DIRECTIONAL ARROW


\* WHERE PARKING OR PEDESTRIAN TRAFFIC WILL OCCUR IN THE IMMEDIATE VICINITY OF THESE SIGNS MINIMUM VERTICAL CLEARANCE SHALL BE INCREASED TO SEVEN FEET

**INSTALLATION SEQUENCE:**


IN MULTIPLE HORIZONTAL MOUNTINGS PLACE A ROUTE MARKER ASSEMBLY INDICATING A LEFT TURN ON THE LEFT SIDE OF THE ASSEMBLY; RIGHT TURN ON THE RIGHT SIDE. FOR VERTICALLY STACKED MOUNTINGS PLACE THE STRAIGHT THROUGH MOVE INDICATION ON TOP, THE LEFT OR RIGHT TURNS AS APPROPRIATE BENEATH.

**NOTES:**


- ALL DIMENSIONS SHOWN IN INCHES UNLESS OTHERWISE NOTED.
- VERTICAL FRAME MEMBERS SHALL LINE UP WITH SIGN POST ON WHICH THEY ARE MOUNTED.

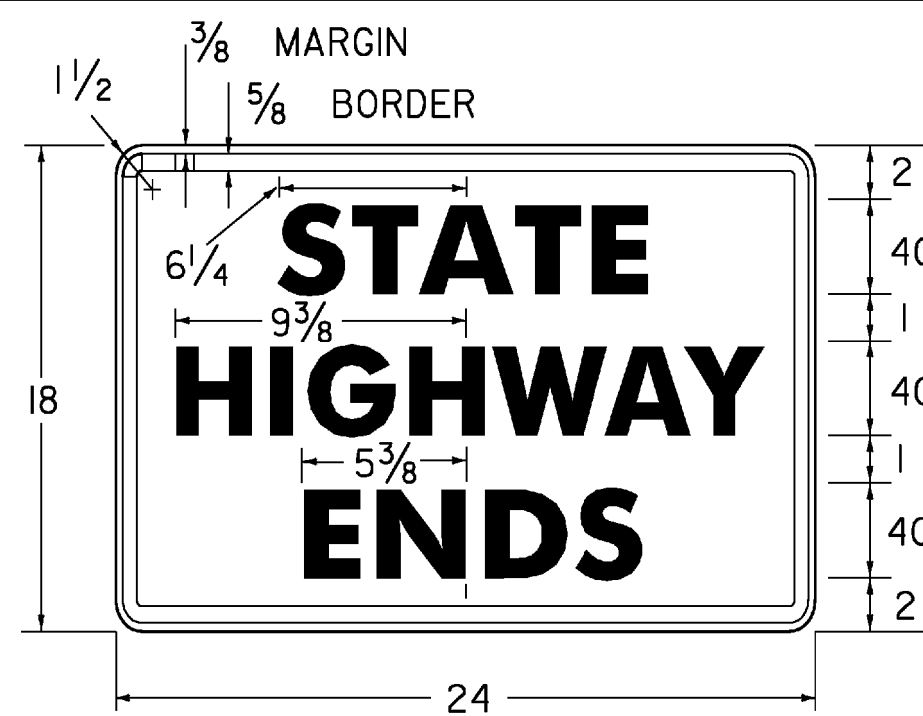


COLORS: LEGEND - BLACK  
BACKGROUND - WHITE  
**VR-038**

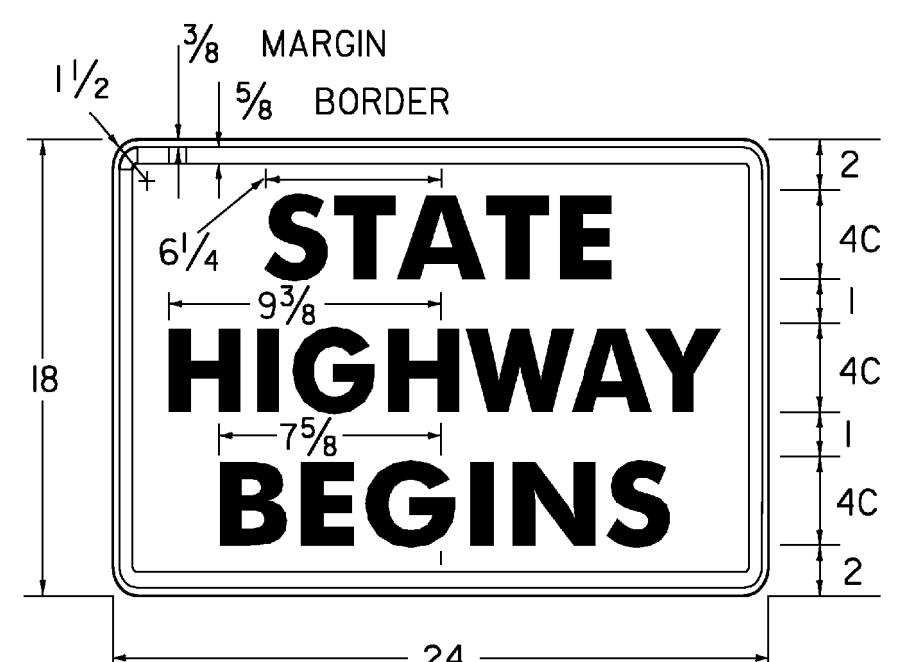

COLORS: LEGEND - BLACK  
BACKGROUND - WHITE  
**VR-039**


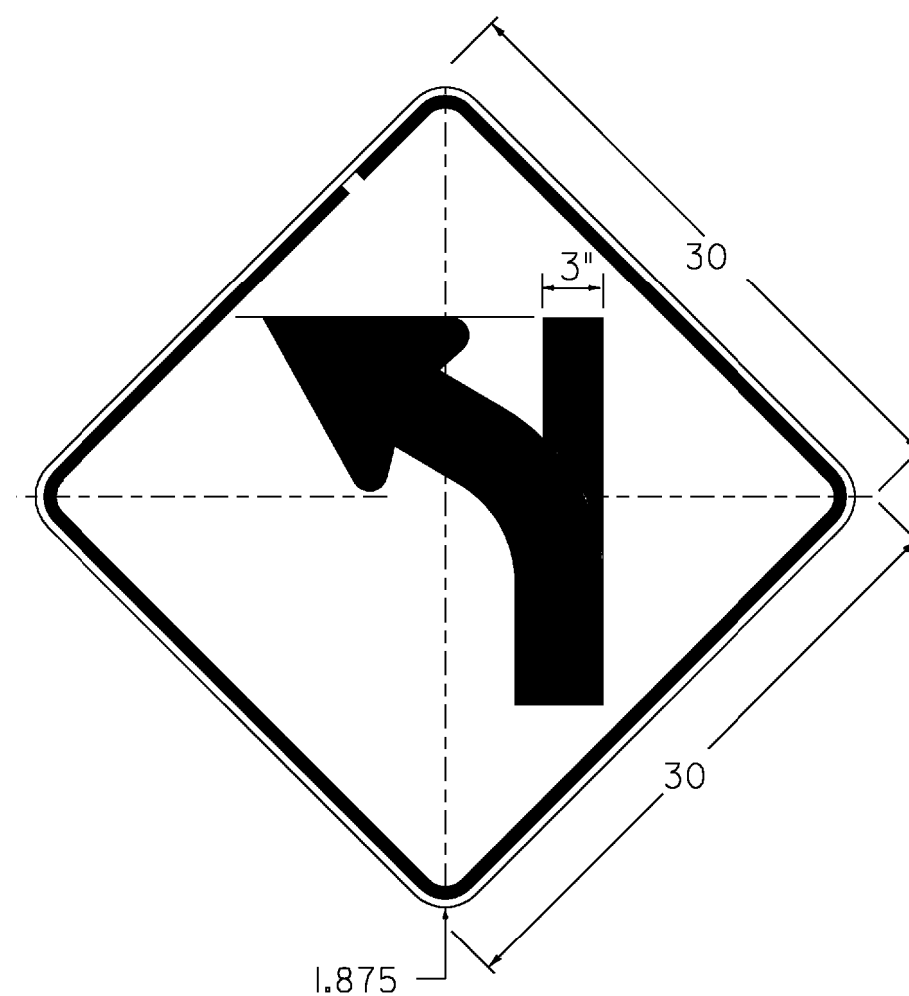


**W1-2Mg L(R)**  
DIMENSIONS NOT SHOWN  
FOR THIS DETAIL SHALL CONFORM  
TO THE LATEST EDITION OF THE 2003 MUTCD  
FOR SIGN DETAIL W1-2.  
UNLESS OTHERWISE NOTED FOR THIS DETAIL

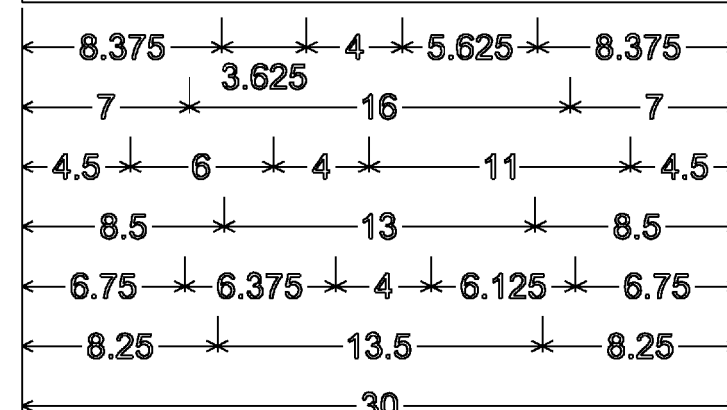

1.875" RADIUS, 0.75" BORDER, 0.50" INDENT  
COLORS: LEGEND - BLACK  
BACKGROUND - WHITE  
TEXT STYLE: "VT 108" B; "THROUGH" B;  
"THE NOTCH" B; "CLOSED" B;  
"FOR THE" B; "SEASON" B

**VR-474H**

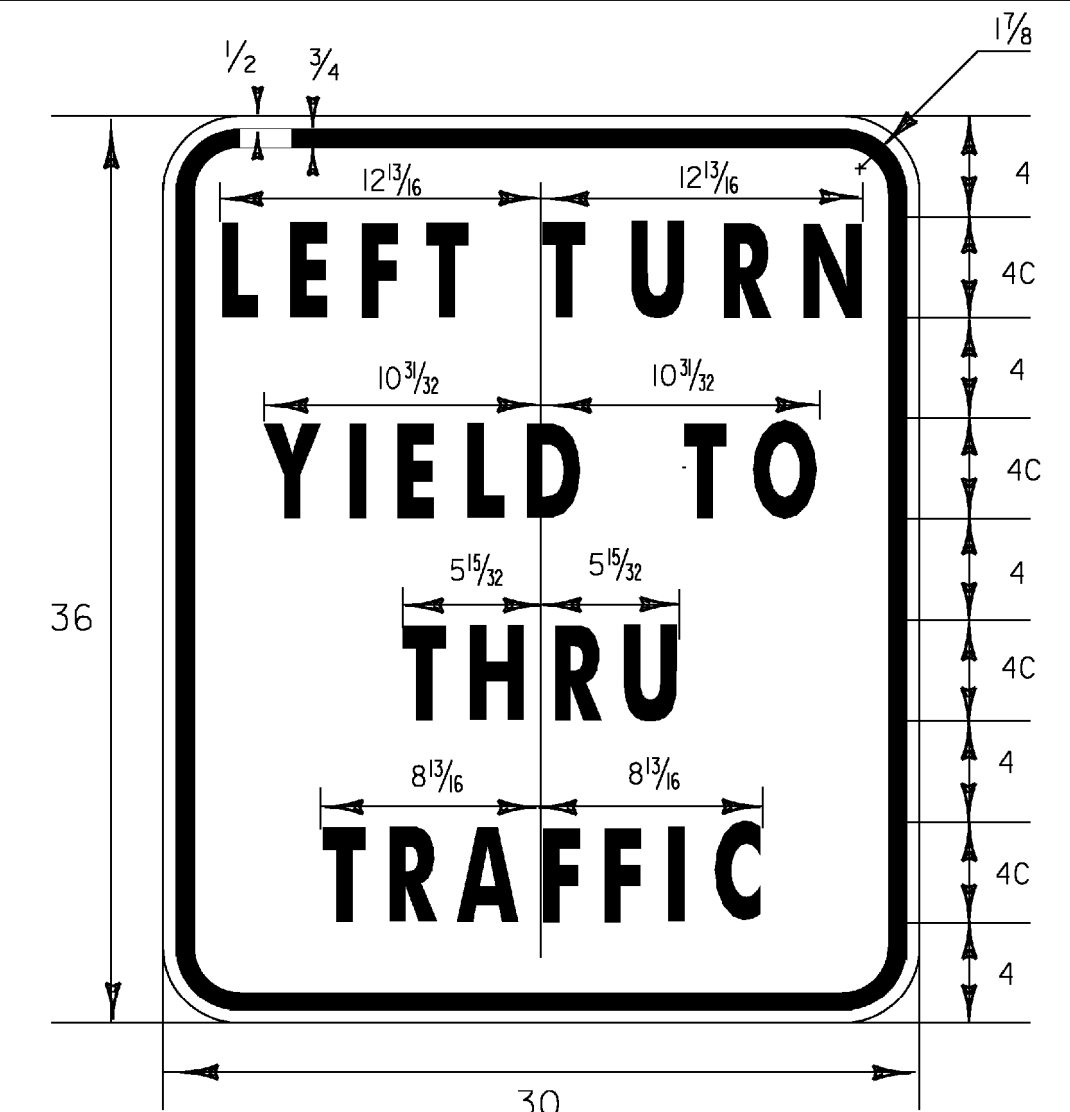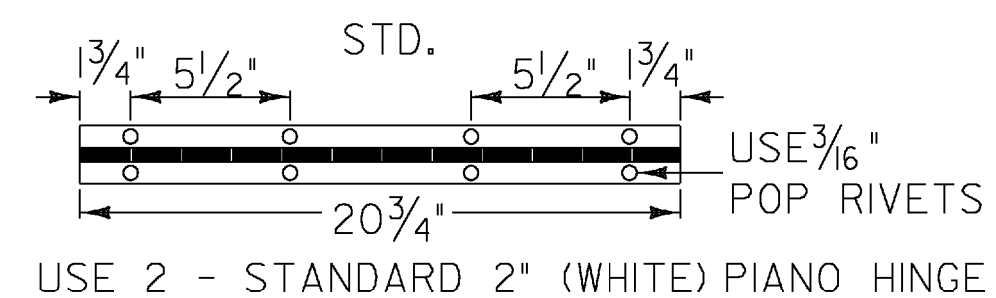

COLORS: LEGEND - BLACK  
BACKGROUND - WHITE

**VR-615**

PROJECT NAME: MORETOWN - NEWPORT TOWN  
PROJECT NUMBER: STPG SIGN (28)

FILE NAME: 09B060\_TS.DGN  
PROJECT LEADER: N. AVERY  
DESIGNED BY: N. AVERY  
GUIDE SIGN ASSEMBLY


PLOT DATE: 30-SEP-2009  
DRAWN BY: N. AVERY  
CHECKED BY: A. GAMBLE  
SHEET 7 OF 166



1.5" RADIUS, 0.375" BORDER, 0.375" INDENT  
 COLORS: LEGEND - BLACK  
 BACKGROUND - YELLOW  
 TEXT STYLE: B

\* LATERAL SPACING TO OUTSIDE OF PANEL SHALL BE A MINIMUM OF 1.5"


**W16-8**

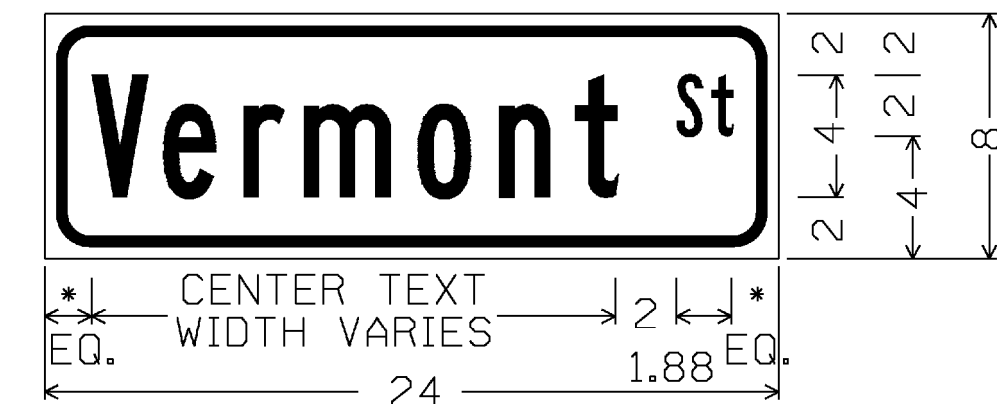

1.5" RADIUS, 0.375" BORDER, 0.375" INDENT  
 COLORS: LEGEND - BLACK  
 BACKGROUND - YELLOW  
 TEXT STYLE: B


\* LATERAL SPACING TO OUTSIDE OF PANEL SHALL BE A MINIMUM OF 1.5"

**W16-8**

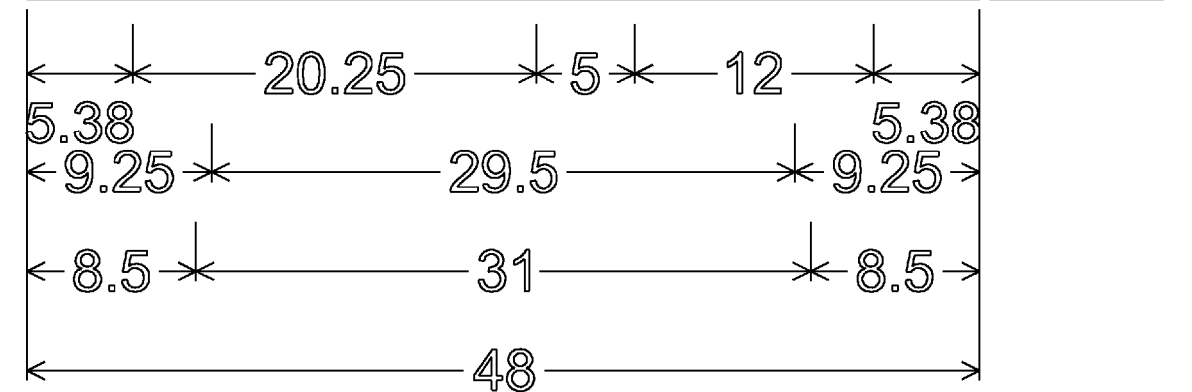

3.00" Radius, 1.00" Border, Black on White;  
 "ROUTE FOR" D; "TRACTOR" D;  
 "TRAILERS" D;

**SIDE A**

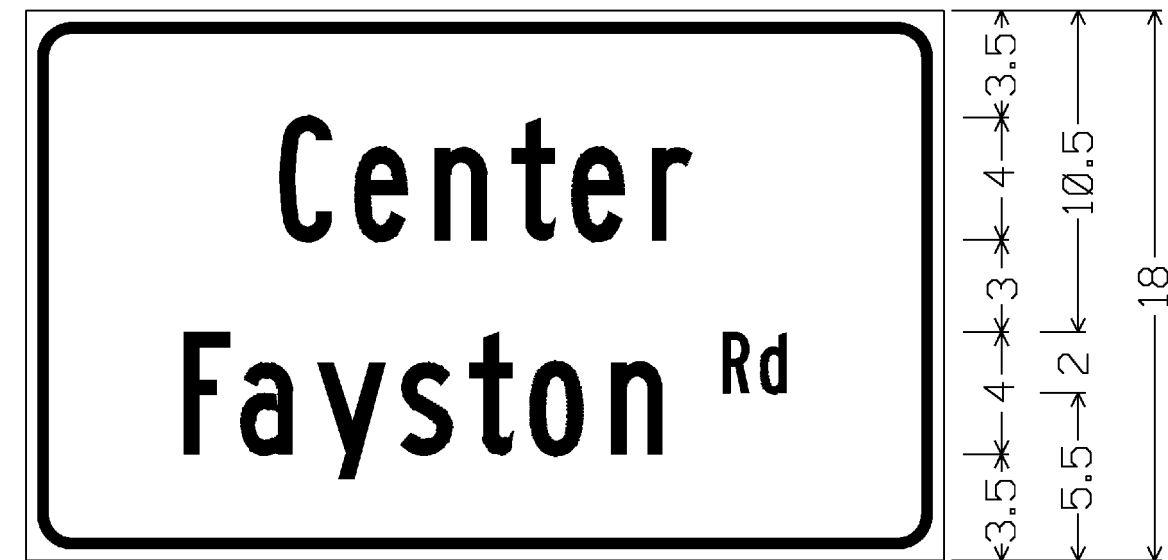


1.5" RADIUS, 0.375" BORDER, 0.375" INDENT  
 COLORS: LEGEND - BLACK  
 BACKGROUND - YELLOW  
 TEXT STYLE: B

\* LATERAL SPACING TO OUTSIDE OF PANEL SHALL BE A MINIMUM OF 1.5"

**W16-8**

**ADVANCE STREET NAME WARNING SIGN PLAQUE NOTES:**

- ALL ADVANCE STREET NAME PLAQUE SIGNS (W16-8 AND W16-8d) USED TO IDENTIFY THE NAME OF THE INTERSECTING STREETS SHALL HAVE INITIAL UPPER CASE LETTERS AND USED IN CONJUNCTION WITH LOWERCASE LETTERS (I.E. Main St, Foster Rd, East Ave, West Ln).

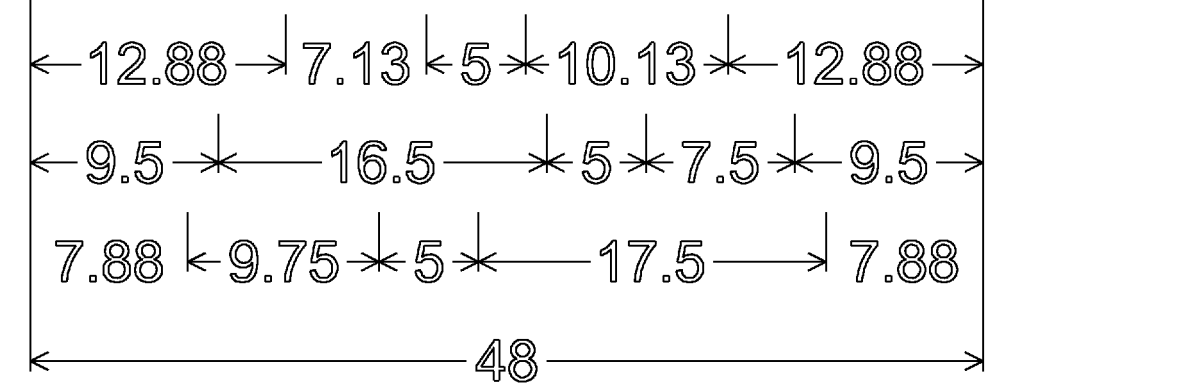

3.00" Radius, 1.00" Border, Black on White;  
 "VT 108" D; "OPEN TO" D;  
 "SKI AREA" D;



**SIDE B**





3" RADIUS, 0.75" BORDER, 0.50" INDENT  
 COLORS: LEGEND - BLACK  
 BACKGROUND - YELLOW  
 TEXT STYLE: D STANDARD ARROW CUSTOM 6" WIDE X 4" HIGH

\* LATERAL SPACING TO OUTSIDE OF PANEL SHALL BE A MINIMUM OF 3"

**W16-8a**

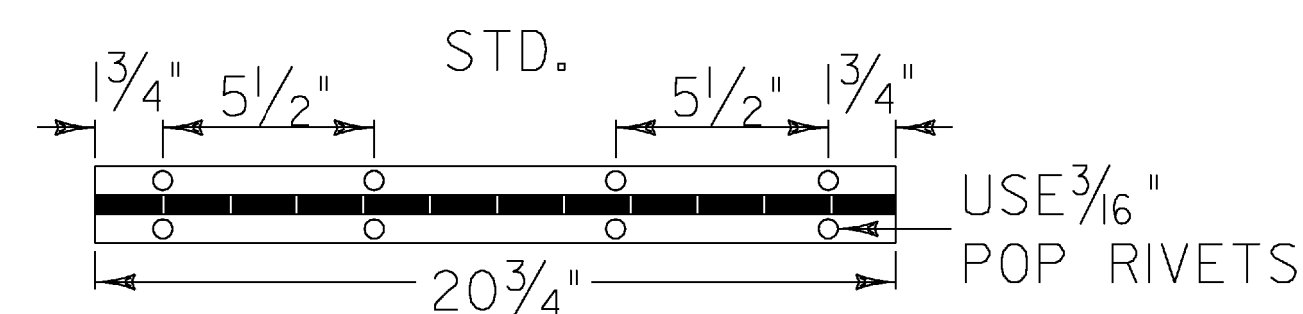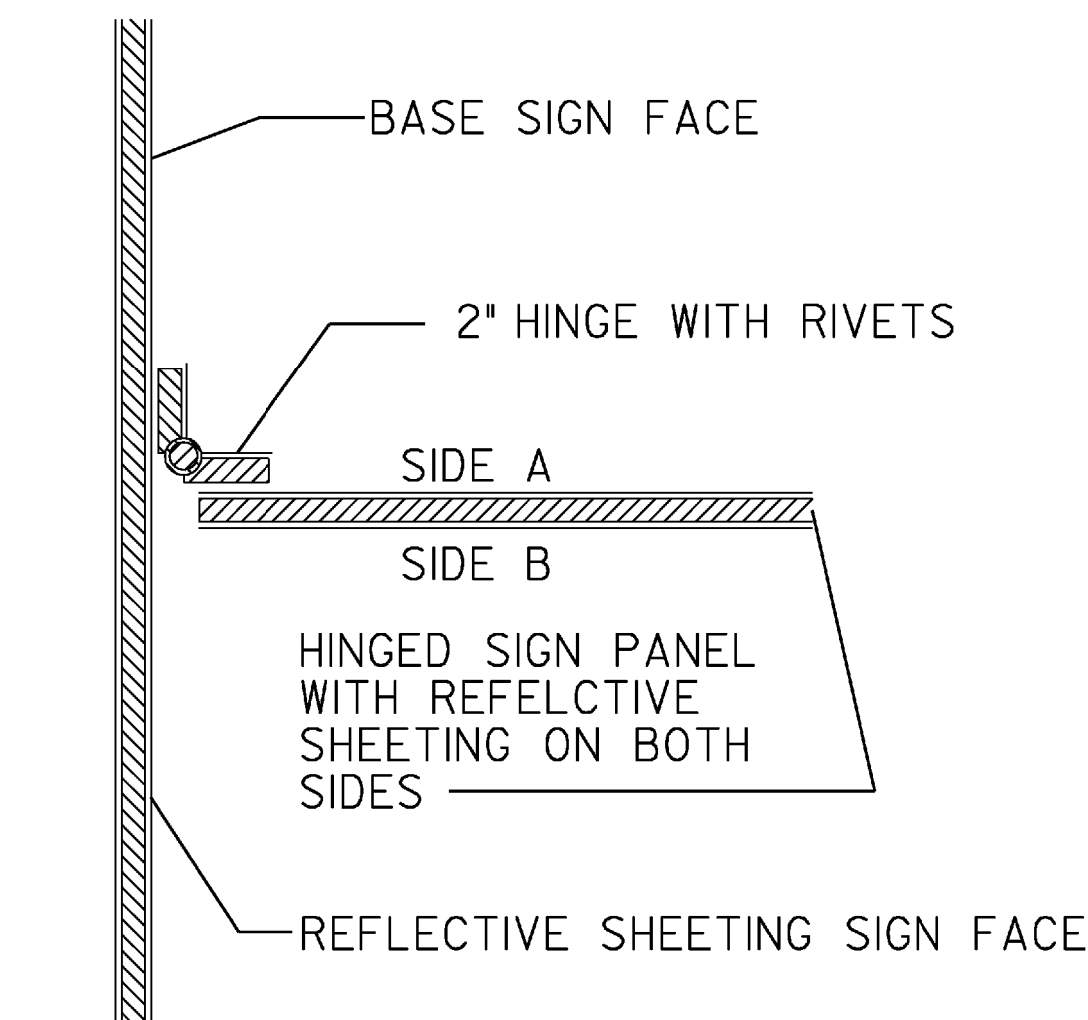

USE 2 - STANDARD 2" (WHITE) PIANO HINGE

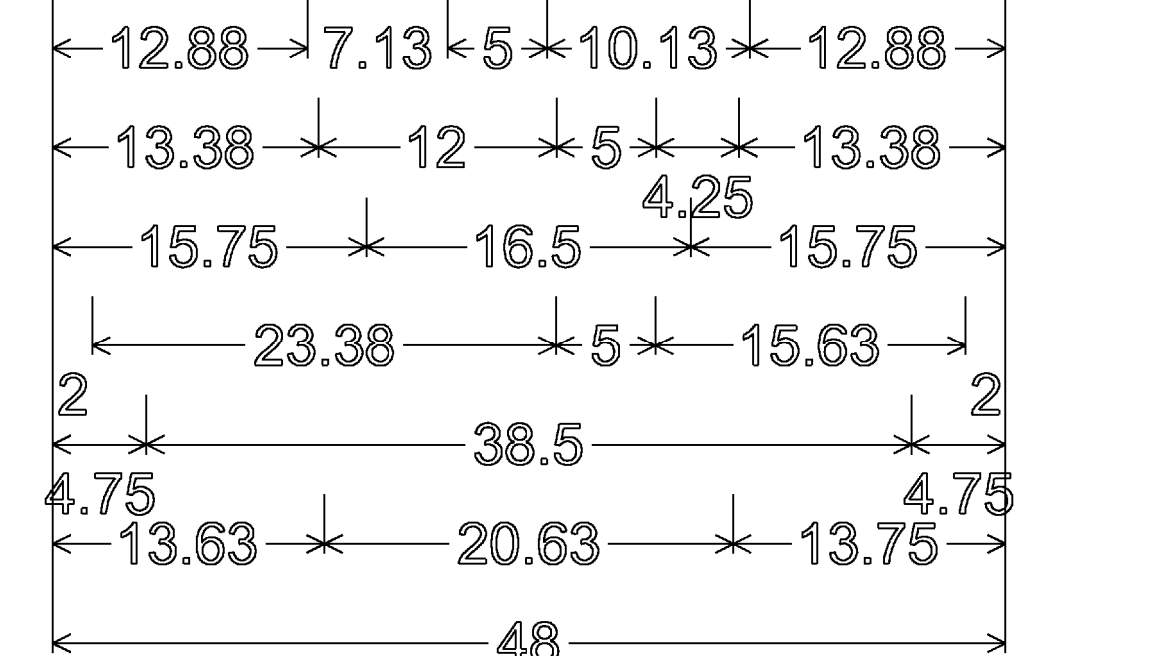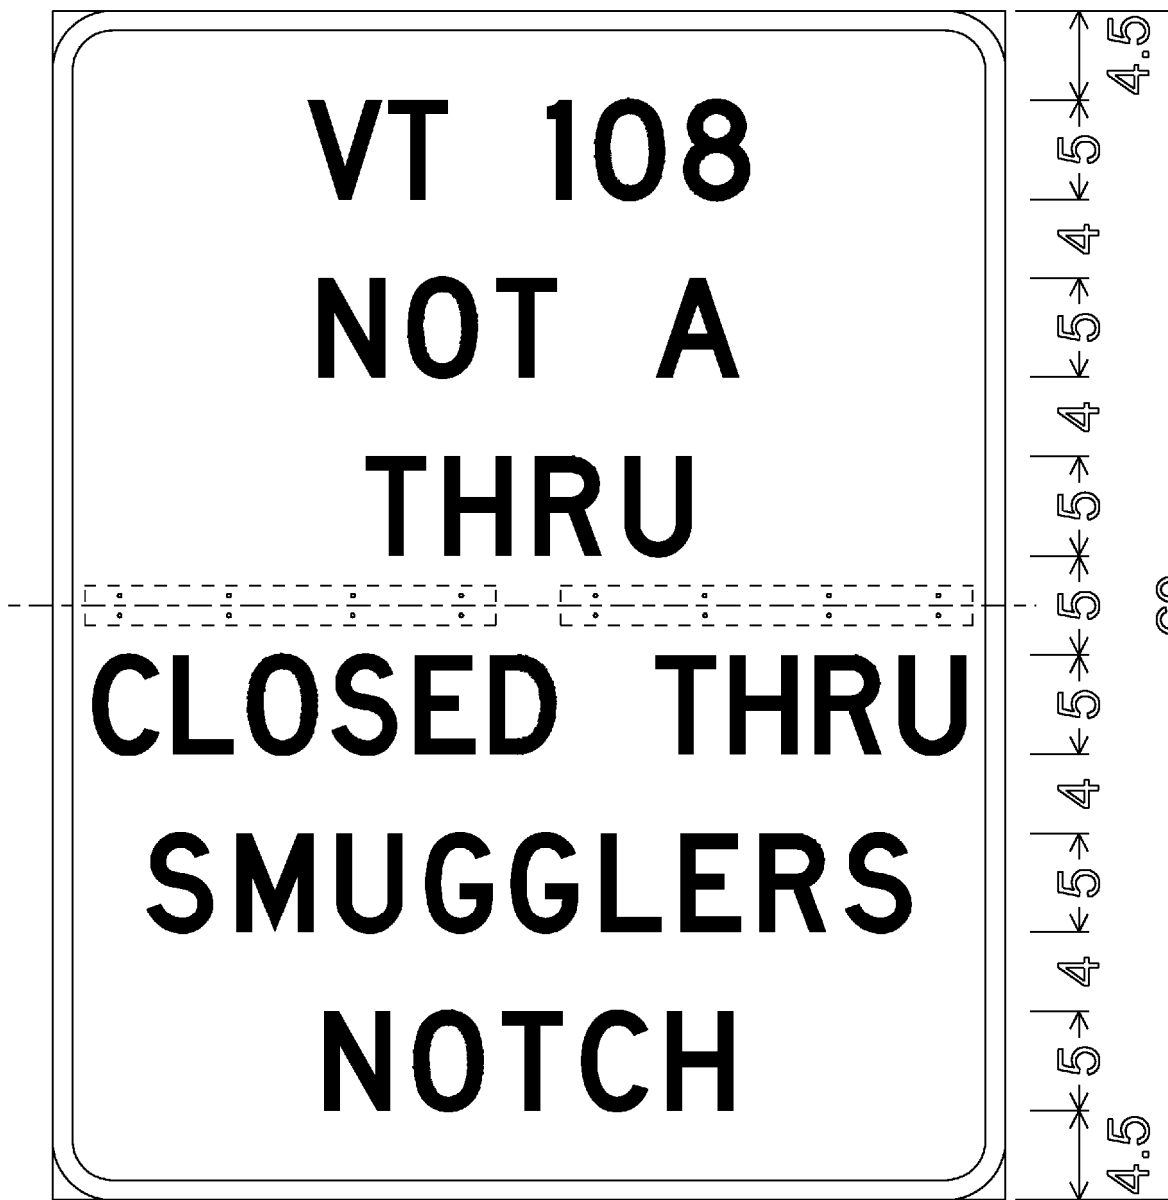








3.00" Radius, 1.00" Border, Black on White;  
 "VT 108" D; "NOT A" D;  
 "THRU" D;  
 "CLOSED THRU" D specified length;  
 "SMUGGLERS" D; "NOTCH" D;

**VR-493 H  
 BASE SIGN**

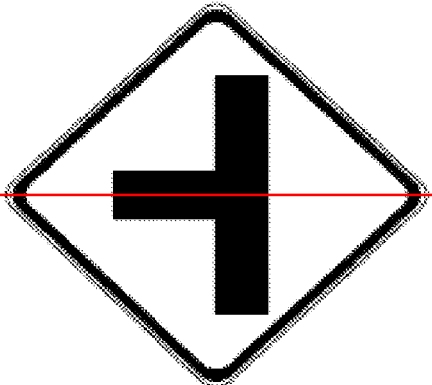PROJECT NAME: MORETOWN - NEWPORT TOWN	PLOT DATE: 30-SEP-2009
PROJECT NUMBER: STPG SIGN (28)	DRAWN BY: N. AVERY
FILE NAME: 09b060_TS.DGN	CHECKED BY: A. GAMBLE
DESIGNED BY: N. AVERY	WARNING STREET NAME PLAQUE DETAIL
	SHEET 8 OF 166



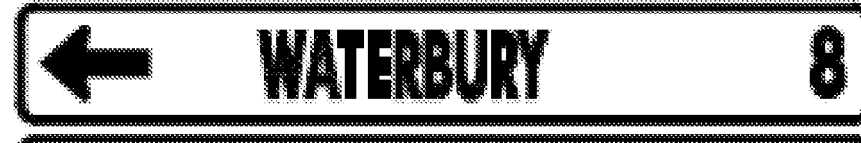


DIRECTION	MILEPOINT	LOCATION CODE (SHEET 2)	SIGN CODE	WIDTH (IN)	HEIGHT (IN)	SHEETING REMARKS	SIGN LEGEND	NEW SIGNS		EXISTING SIGNS				EXIST POST		NUMBER OF NEW POSTS	SQUARE STEEL (IN)			TUBULAR STEEL Ø (IN)				SIGN FRAME REQUIRED	REMARKS	SIGN DETAIL		
								"A"	"B"	RETAIN	SALVAGE FROM	SALVAGE TO	REMOVE	RETAIN	REMOVE		1.75	2.00	2.50	3.00	3.50	4.00	5.00			DETAIL IN SHS	DETAIL ON SHEET NUMBER	DETAIL ON STD SHEET NUMBER
																	(LB / FT)			(LB / FT)								
																	1.88	2.42	3.35	FOUNDATION	7.60	9.00	10.80					
<b>MORETOWN VT 100</b>							FY-FLUORESCENT YELLOW FYG-FLUORESCENT YELLOW GREEN															"SHS"-STANDARD HIGHWAY SIGNS						
NB	0.000	C	VD-024	60	7.5																							
		C	VD-024	72	10																						4	
		C	VD-700	6	10																							
		C	VD-700	6	10																							
NB	0.187	A	VD-062B	72	16	BUSINESS SIGN			1																			
		A	VD-062A	72	16	BUSINESS SIGN			1																			
NB	0.230	A	M2-1S	21	15	JCT																						
		A	M1-5	30	24	VT 100B																						
NB	0.310	A	W2-2L	36	36	LEFT SIDE ROAD																						
		A	W13-1	24	24	40 MPH PLAQUE																						
		A	M2-1S	21	15																							
		A	M1-5	30	24																						E-136B	
NB	0.350	A	M3-1S	24	12	NORTH																						
		A	M1-5	30	24	VERMONT 100																						
		A	M5-1S	21	15	<--- LEFT (90 DEG)																						
<b>SIGN SUMMARY SHEET</b>							<b>SHEET TOTALS</b>	13.03	0.00	2	0	0	7	0	0	3	45											
							SF	SF	EA	EA	EA	EA	EA	EA	EA	EA	FT											
VERMONT AGENCY OF TRANSPORTATION							<b>TOWN TOTALS</b>	228.6	0.0	22.0	0.0	0.0	60	0.0	0.0	27	405.0											
													PROJECT NAME:	<b>Mortown-Newport Town VT100</b>														
													PROJECT NUMBER:	<b>STPG SIGN(28)</b>														
													FILE NAME:	<b>Moretown.xls</b>					PLOT DATE: <b>9/16/2009</b>									
													PROJECT MANAGER:	<b>N. Avery</b>					DRAWN BY: <b>I. Shea</b>									
													DESIGNED BY:	<b>D. Crosslev</b>					CHECKED BY: <b>J. Kelly</b>									
													MORETOWN SHEET 1						SHEET <b>9</b> OF <b>166</b>									

DIRECTION	MILEPOINT	LOCATION CODE (SHEET 2)	SIGN CODE	WIDTH (IN)	HEIGHT (IN)	SHEETING REMARKS	SIGN LEGEND	NEW SIGNS		EXISTING SIGNS				EXIST POST		NUMBER OF NEW POSTS	SQUARE STEEL (IN)			TUBULAR STEEL Ø (IN)				SIGN FRAME REQUIRED	REMARKS	SIGN DETAIL			
								"A"	"B"	RETAIN	SALVAGE FROM	SALVAGE TO	REMOVE	RETAIN	REMOVE		1.75	2.00	2.50	FOUNDATION	3.00	3.50	4.00			5.00	DETAIL IN SHS	DETAIL ON SHEET NUMBER	DETAIL ON STD SHEET NUMBER
																	(LB / FT)				(LB / FT)								
																	1.88	2.42	3.35		7.60	9.00	10.80			14.60			
<b>MORETOWN VT 100</b>							FY-FLUORESCENT YELLOW FYG-FLUORESCENT YELLOW GREEN														"SHS"-STANDARD HIGHWAY SIGNS								
			A	M3-1S	24	12	NORTH																						
			A	M1-5	30	24	VERMONT 100B																						
			A	M6-3S	21	15	UP ARROW																						
			A	W2-2L	36	36	ELIMINATED 	<del>-9.00</del>			28.0						2	<del>X</del>							X				
			A	W16-8	36	12	ELIMINATED 	<del>-3.00</del>																				8	
NB	0.390		A	D2-1	72	10	^ MORETOWN 1																						
			A	D2-1	72	10	^ MIDDLESEX 8																						
			A	D1-1A	72	10	<--- WATERBURY 8																						
			A	D1-1A	72	10	<--- STOWE 18																						
	0.120		A	W3-5	36	36		9.00											X						X				
NB	0.410		A	R2-5A	24	30	REDUCED SPEED AHEAD																						
			A	D1-1A	72	12		6.00											X								5		
			A	D1-1A	72	12		6.00																				5	
			A	D1-1A	72	12		6.00																				5	
			A	D1-1A	72	12		6.00																				5	
<b>SIGN SUMMARY SHEET</b>							SHEET TOTALS	45.00	0.00	0	0	0	8	0	0	6	90												
								SF	SF	EA	EA	EA	EA	EA	EA	EA	EA	FT											
VERMONT AGENCY OF TRANSPORTATION							TOWN TOTALS	228.6	0.0	22.0	0.0	0.0	60	0.0	0.0	27	405.0												
PROJECT NAME: <b>Mortown-Newport Town VT100</b>																				PROJECT NUMBER: <b>STPG SIGN(28)</b>									
FILE NAME: <b>Moretown.xls</b>															PLOT DATE: <b>9/16/2009</b>														
PROJECT MANAGER: <b>N. Avery</b>															DRAWN BY: <b>I. Shea</b>														
DESIGNED BY: <b>D. Crosslev</b>															CHECKED BY: <b>J. Kelly</b>														
MORETOWN SHEET 2															SHEET <b>10</b> OF <b>166</b>														

DIRECTION	MILEPOINT	LOCATION CODE (SHEET 2)	SIGN CODE	WIDTH (IN)	HEIGHT (IN)	SHEETING REMARKS	SIGN LEGEND	NEW SIGNS		EXISTING SIGNS				EXIST POST		NUMBER OF NEW POSTS	SQUARE STEEL (IN)			TUBULAR STEEL Ø (IN)				SIGN FRAME REQUIRED	REMARKS	SIGN DETAIL										
								"A"	"B"	RETAIN	SALVAGE FROM	SALVAGE TO	REMOVE	RETAIN	REMOVE		1.75	2.00	2.50	FOUNDATION	3.00	3.50	4.00			5.00	DETAIL IN SHS	DETAIL ON SHEET NUMBER	DETAIL ON STD SHEET NUMBER							
																	(LB / FT)				(LB / FT)															
<b>MORETOWN VT 100</b>							FY-FLUORESCENT YELLOW FYG-FLUORESCENT YELLOW GREEN															"SHS"-STANDARD HIGHWAY SIGNS														
NB	0.440	A	M3-1	24	12		NORTH						1	X																						
		A	M1-5A	24	24		ROUTE 100						1																							
		A	M6-1	21	15		<--- LEFT						1																							
		A	M4-5	24	12		TO						1																							
		A	M3-1	24	12		NORTH						1																							
		A	M1-1	24	24		INTERSTATE 89						1																							
		A	M6-1	21	15		<--- LEFT						1																							
		A	M3-1	24	12		NORTH						1																							
		A	M1-5A	24	24		ROUTE 100B						1																							
		A	M6-3	21	15		UP ARROW						1																							
		A	M4-5	24	12		TO						1																							
		A	M3-3	24	12		SOUTH						1																							
		A	M1-1	24	24		INTERSTATE 89						1																							
		A	M6-3	21	15		UP ARROW						1																							
		A	M3-1	24	12								2.00												3B											
<b>SIGN SUMMARY SHEET</b>							<b>SHEET TOTALS</b>											2.00	0.00	0	0	0	14	0	0	0	0	0	0	0	0	0	0	0	0	0
							SF	SF	EA	EA	EA	EA	EA	EA	EA	EA	EA	EA	EA	EA	EA	EA	EA	EA	EA	EA	EA	EA	EA							
							<b>TOWN TOTALS</b>											228.6	0.0	22.0	0.0	0.0	60	0.0	0.0	0	0	0	27	405.0						
VERMONT AGENCY OF TRANSPORTATION																		PROJECT NAME: <b>Mortown-Newport Town VT100</b>			PROJECT NUMBER: <b>STPG SIGN(28)</b>			FILE NAME: <b>Moretown.xls</b>			PLOT DATE: <b>9/16/2009</b>									
																		DESIGNED BY: <b>D. Crosslev</b>			DRAWN BY: <b>I. Shea</b>			CHECKED BY: <b>J. Kelly</b>			SHEET <b>11</b> OF <b>166</b>									
																		MORETOWN SHEET 3																		

DIRECTION	MILEPOINT	LOCATION CODE (SHEET 2)	SIGN CODE	WIDTH (IN)	HEIGHT (IN)	SHEETING REMARKS	SIGN LEGEND	NEW SIGNS		EXISTING SIGNS				EXIST POST		NUMBER OF NEW POSTS	SQUARE STEEL (IN)			TUBULAR STEEL Ø (IN)				SIGN FRAME REQUIRED	REMARKS	SIGN DETAIL							
								"A"	"B"	RETAIN	SALVAGE FROM	SALVAGE TO	REMOVE	RETAIN	REMOVE		(LB / FT)			FOUNDATION	(LB / FT)					DETAIL IN SHS	DETAIL ON SHEET NUMBER	DETAIL ON STD SHEET NUMBER					
																	1.75	2.00	2.50		3.00	3.50	4.00						5.00				
<b>MORETOWN VT 100</b>							FY-FLUORESCENT YELLOW FYG-FLUORESCENT YELLOW GREEN																"SHS"-STANDARD HIGHWAY SIGNS										
			A	M1-5	30	24		5.00																				E-136B					
			A	M6-1L	21	15		2.19																					GREEN ON WHITE SHEETING	X			
			A	M4-5	24	12		2.00																					WHITE ON BLUE SHEETING	X			
			A	M3-1	24	12		2.00																					WHITE ON BLUE SHEETING	X			
			A	M1-1	24	24		4.00																						X			
			A	M6-1L	21	15		2.19																					WHITE ON BLUE SHEETING	X			
			A	M3-1	24	12		2.00																					GREEN ON WHITE SHEETING	X			
			A	M1-5	30	24		5.00																									E-136B
			A	M6-3	21	15		2.19																					GREEN ON WHITE SHEETING	X			
			A	M4-5	24	12		2.00																						WHITE ON BLUE SHEETING. INSTALL BESIDE ASSEMBLY AS SHOWN.	X		
			A	M3-3	24	12		2.00																					WHITE ON BLUE SHEETING	X			
			A	M1-1	24	24		4.00																						X			
			A	M6-3	21	15		2.19																					WHITE ON BLUE SHEETING	X			
NB	0.450		C	W1-7	48	24																											
			C	W1-7	48	24		8.00																									
<b>SIGN SUMMARY SHEET</b>							<b>SHEET TOTALS</b>		44.76	0.00	0	0	0	1	0	0	3	45								PROJECT NAME: <b>Mortown-Newport Town VT100</b> PROJECT NUMBER: <b>STPG SIGN(28)</b>							
VERMONT AGENCY OF TRANSPORTATION							<b>TOWN TOTALS</b>		228.6	0.0	22.0	0.0	0.0	60	0.0	0.0	27	405.0								FILE NAME: <b>Moretown.xls</b> PLOT DATE: <b>9/16/2009</b> PROJECT MANAGER: <b>N. Avery</b> DRAWN BY: <b>I. Shea</b> DESIGNED BY: <b>D. Crosslev</b> CHECKED BY: <b>J. Kelly</b> MORETOWN SHEET 4 SHEET <b>12</b> OF <b>166</b>							

DIRECTION	MILEPOINT	LOCATION CODE (SHEET 2)	SIGN CODE	WIDTH (IN)	HEIGHT (IN)	SHEETING REMARKS	SIGN LEGEND	NEW SIGNS		EXISTING SIGNS				EXIST POST		NUMBER OF NEW POSTS	SQUARE STEEL (IN)			TUBULAR STEEL Ø (IN)				SIGN FRAME REQUIRED	REMARKS	SIGN DETAIL			
								"A"	"B"	RETAIN	SALVAGE FROM	SALVAGE TO	REMOVE	RETAIN	REMOVE		1.75	2.00	2.50	FOUNDATION	3.00	3.50	4.00			5.00	DETAIL IN SHS	DETAIL ON SHEET NUMBER	DETAIL ON STD SHEET NUMBER
																	(LB / FT)				(LB / FT)								

<b>MORETOWN VT 100</b>							FY-FLUORESCENT YELLOW FYG-FLUORESCENT YELLOW GREEN															"SHS"-STANDARD HIGHWAY SIGNS						
NB	0.466	B	R1-1	30	30		STOP			1					X													
NB	0.510	A	M3-1	24	12			2.00								1		X							GREEN ON WHITE SHEETING INSTALL 150'+/- SOUTH OF EXISTING 40 MPH SPEED LIMIT	X		
		A	M1-5	24	30			5.00																			E-136B	
NB	0.530	A	R2-1	24	30																							
		A	R2-1	30	36			7.50								1		X									6	
NB	0.610	B	W3-1	36	36		STOP AHEAD																					
NB	0.650	A	W11-3A	30	30		DEER CROSSING 																					
		A	W11-3	30	30			6.25								1		X									X	
NB	0.840	A	R2-1	24	30																							
		A	R2-1	24	30			5.00								1		X									X	
NB	0.980	A	W11-7	30	30		EQUESTRIAN SYMBOL																					
NB	1.059	A	W1-4MR	30	30		MODIFIED RIGHT REVERSE CURVE																					
		A	W13-1	18	18		30 MPH PLAQUE 																					
		A	W11-7	30	30			6.25								1		X								X		




MORETOWN ENDS AT MILEPOINT 1.15 RESUMES AFTER GOING THROUGH DUXBURY



**SIGN SUMMARY SHEET**



		SHEET TOTALS		TOWN TOTALS									
A	B	SF	SF	EA	EA	EA	EA	EA	EA	EA	EA	EA	EA
32.00	0.00	32.00	0.00	1	0	0	7	0	0	5	75		
				228.6	0.0	22.0	0.0	0.0	60	0.0	0.0	27	405.0

PROJECT NAME: <b>Mortown-Newport Town VT100</b>		PLOT DATE: <b>9/16/2009</b>
PROJECT NUMBER: <b>STPG SIGN(28)</b>		DRAWN BY: <b>I. Shea</b>
FILE NAME: <b>Moretown.xls</b>		CHECKED BY: <b>J. Kelly</b>
PROJECT MANAGER: <b>N. Avery</b>		SHEET <b>13</b> OF <b>166</b>
DESIGNED BY: <b>D. Crosslev</b>		
MORETOWN SHEET 5		




DIRECTION	MILEPOINT	LOCATION CODE (SHEET 2)	SIGN CODE	WIDTH (IN)	HEIGHT (IN)	SHEETING REMARKS	SIGN LEGEND	NEW SIGNS		EXISTING SIGNS				EXIST POST		NUMBER OF NEW POSTS	SQUARE STEEL (IN)			TUBULAR STEEL Ø (IN)				SIGN FRAME REQUIRED	REMARKS	SIGN DETAIL					
								"A"	"B"	RETAIN	SALVAGE FROM	SALVAGE TO	REMOVE	RETAIN	REMOVE		1.75	2.00	2.50	FOUNDATION	3.00	3.50	4.00			5.00	DETAIL IN SHS	DETAIL ON SHEET NUMBER	DETAIL ON STD SHEET NUMBER		
																	(LB / FT)				(LB / FT)										
																	1.88	2.42	3.35		7.60	9.00	10.80			14.60					
<b>MORETOWN VT 100</b>							FY-FLUORESCENT YELLOW FYG-FLUORESCENT YELLOW GREEN															"SHS"-STANDARD HIGHWAY SIGNS									
NB	1.220	A	R10-7	24	30		DO NOT BLOCK INTERSECTION			1																					
NB	1.223	C	VR-017	24	30		LEGAL LOAD LIMIT 24000			1																	COBB HILL RD TH 6				
NB	1.231	D	R1-1	30	30		STOP			1																	COBB HILL RD TH 6				
NB	1.208	A	M3-4	24	12		WEST			1																					
		A	M1-4	24	24		US2			1																					
		A	M6-1	21	15		LEFT			1																					
		A	M3-1S	24	12		NORTH			1																					
		A	M1-5	30	24		VERMONT 100			1																					
		A	M6-1S	21	15		LEFT			1																					
		A	M3-2	24	12		EAST			1																					
		A	M1-4	24	24		US 2			1																					
		A	M6-1	21	15		RIGHT			1																					
		A	M4-5I	24	12		TO			1																					
		A	M1-1	24	24		I-89			1																					
		A	M6-1I	21	15		LEFT			1																					
<b>SIGN SUMMARY SHEET</b>							SHEET TOTALS											0											PROJECT NAME: <b>Mortown-Newport Town VT100</b>		
							0.00		0.00		15	0	0	0	0	0	0	0	0			PROJECT NUMBER: <b>STPG SIGN(28)</b>									
VERMONT AGENCY OF TRANSPORTATION							TOWN TOTALS											405.0											FILE NAME: <b>Moretown.xls</b>		
							228.6		0.0		22.0	0.0	0.0	60	0.0	0.0	27	405.0			PLOT DATE: <b>9/16/2009</b>										
																													PROJECT MANAGER: <b>N. Avery</b>		
																													DESIGNED BY: <b>D. Crosslev</b>		
																													DRAWN BY: <b>I. Shea</b>		
																													CHECKED BY: <b>J. Kelly</b>		
																													SHEET <b>14</b> OF <b>166</b>		

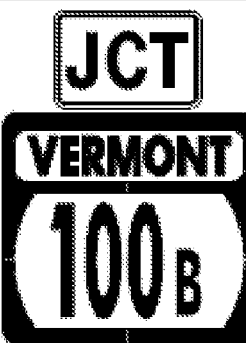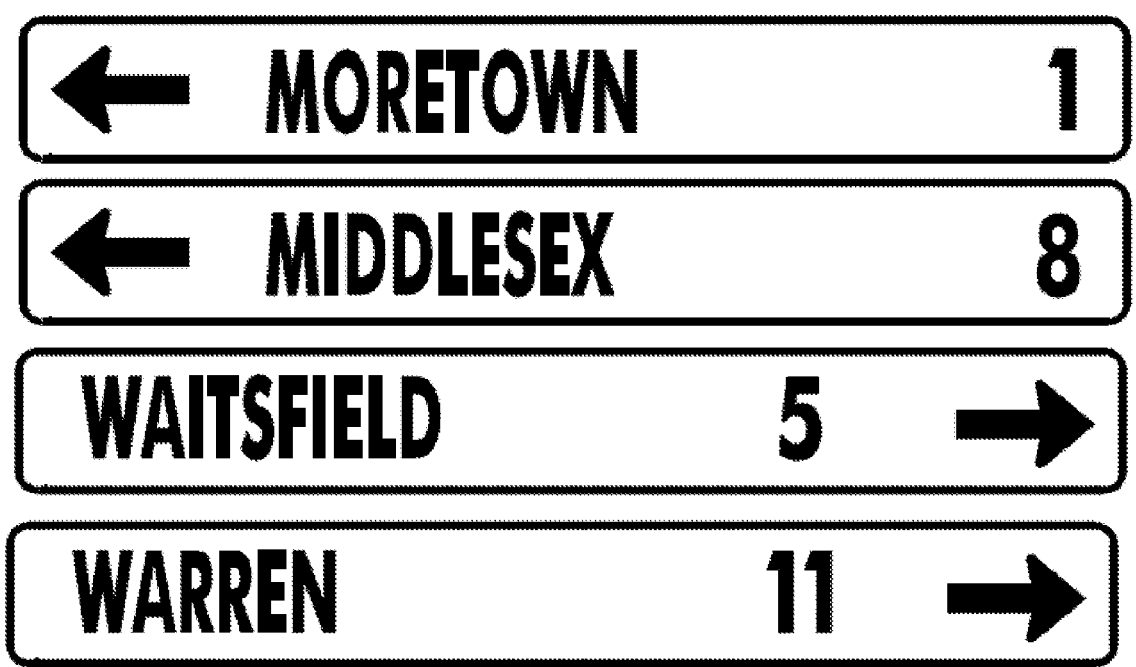DIRECTION	MILEPOINT	LOCATION CODE (SHEET 2)	SIGN CODE	WIDTH (IN)	HEIGHT (IN)	SHEETING REMARKS	SIGN LEGEND	NEW SIGNS		EXISTING SIGNS				EXIST POST		NUMBER OF NEW POSTS	SQUARE STEEL (IN)			TUBULAR STEEL Ø (IN)				SIGN FRAME REQUIRED	REMARKS	SIGN DETAIL			
								"A"	"B"	RETAIN	SALVAGE FROM	SALVAGE TO	REMOVE	RETAIN	REMOVE		1.75	2.00	2.50	FOUNDATION	3.00	3.50	4.00			5.00	DETAIL IN SHS	DETAIL ON SHEET NUMBER	DETAIL ON STD SHEET NUMBER
																	(LB / FT)				(LB / FT)								
<b>MORETOWN VT 100</b>							FY-FLUORESCENT YELLOW FYG-FLUORESCENT YELLOW GREEN															"SHS"-STANDARD HIGHWAY SIGNS							
SB	1.211	F	M3-3S	24	12																								
		F	M1-5	30	24																								
		F	M3-3	24	12			2.00						1			X												
		F	M1-5	30	24			5.00																		E-136B			
SB	1.180	F	R2-1	24	30		SPEED LIMIT 35			1				X															
SB	1.158	F	W1-4L	30	30		LEFT REVERSE CURVE							1			X												
MORETOWN ENDS AT MILEPOINT 1.15 RESUMES AFTER GOING THROUGH DUXBURY																													
SB	0.950	F	W11-3A	30	30		DEER CROSSING 							1			X												
		F	W11-3	30	30			6.25										1		X						X			
SB	0.880	F	R2-1	24	30									1			X												
		F	R2-1	24	30			5.00										1		X						X			
SB	0.640	F	VD-062A	72	16		BUSINESS SIGN			1				X															
SB	0.610	F	W3-1	30	30		STOP AHEAD			1				X															
SB	0.560	F	M2-1	21	15									1			X												
		F	M1-5A	24	24									1															
<b>SIGN SUMMARY SHEET</b>							SHEET TOTALS	18.25	0.00	3	0	0	7	0	0	3	45								PROJECT NAME: <b>Mortown-Newport Town VT100</b>				
								SF	SF	EA	EA	EA	EA	EA	EA	EA	EA	EA	EA	EA	EA	FT							PROJECT NUMBER: <b>STPG SIGN(28)</b>
VERMONT AGENCY OF TRANSPORTATION							TOWN TOTALS	228.6	0.0	22.0	0.0	0.0	60	0.0	0.0	27	405.0							FILE NAME: <b>Moretown.xls</b> PLOT DATE: <b>9/16/2009</b>					
																							PROJECT MANAGER: <b>N. Avery</b> DRAWN BY: <b>I. Shea</b>						
																							DESIGNED BY: <b>D. Crosslev</b> CHECKED BY: <b>J. Kelly</b>						
																							MORETOWN SHEET 7 SHEET <b>15</b> OF <b>166</b>						

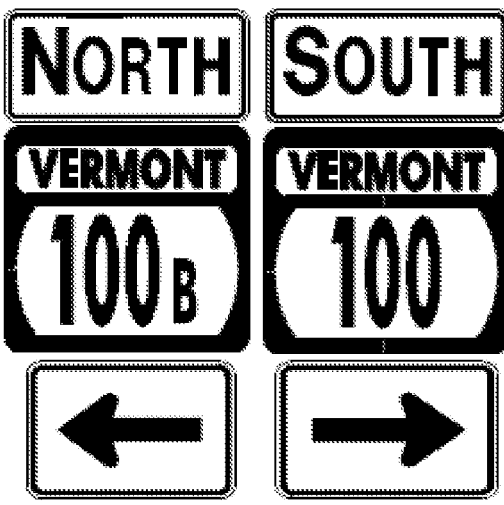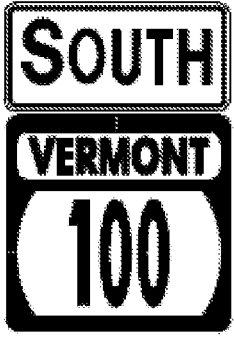
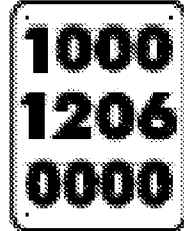
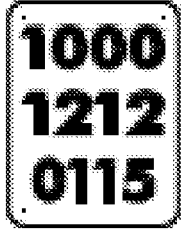
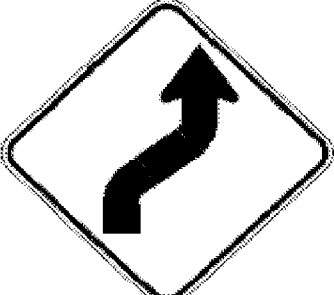


DIRECTION	MILEPOINT	LOCATION CODE (SHEET 2)	SIGN CODE	WIDTH (IN)	HEIGHT (IN)	SHEETING REMARKS	SIGN LEGEND	NEW SIGNS		EXISTING SIGNS				EXIST POST		NUMBER OF NEW POSTS	SQUARE STEEL (IN)			TUBULAR STEEL Ø (IN)				SIGN FRAME REQUIRED	REMARKS	SIGN DETAIL			
								"A"	"B"	RETAIN	SALVAGE FROM	SALVAGE TO	REMOVE	RETAIN	REMOVE		1.75	2.00	2.50	FOUNDATION	3.00	3.50	4.00			5.00	DETAIL IN SHS	DETAIL ON SHEET NUMBER	DETAIL ON STD SHEET NUMBER
																	(LB / FT)				(LB / FT)								
<b>MORETOWN VT 100</b>							FY-FLUORESCENT YELLOW FYG-FLUORESCENT YELLOW GREEN															"SHS"-STANDARD HIGHWAY SIGNS							
		F	M2-1	21	15			2.19						1		X								GREEN ON WHITE SHEETING	X				
		F	M1-5	30	24			5.00																	E-136B				
SB	0.530	F	D2-1	72	10																								
		F	D2-1	72	10																								
		F	D2-1	72	10																								
		F	D2-1	72	10																								
		F	D1-1A	72	12			6.00							2		X								5				
		F	D1-1A	72	12			6.00																	5				
		F	D1-1A	72	12			6.00																	5				
		F	D1-1A	72	12			6.00																	5				
SB	0.490	F	M3-1	24	12												X												
		F	M1-5	30	24																								
		F	M6-1	21	15																								
		F	M3-3	24	12																								
		F	M1-5	30	24																								
<b>SIGN SUMMARY SHEET</b>							SHEET TOTALS	31.19	0.00	0	0	0	9	0	0	3	45												
								SF	SF	EA	EA	EA	EA	EA	EA	EA	EA	EA	EA	EA	EA	EA	EA	EA	EA	EA	EA	EA	EA
VERMONT AGENCY OF TRANSPORTATION							TOWN TOTALS	228.6	0.0	22.0	0.0	0.0	60	0.0	0.0	27	405.0												
							PROJECT NAME: <b>Mortown-Newport Town VT100</b>															PROJECT NUMBER: <b>STPG SIGN(28)</b>							
							FILE NAME: <b>Moretown.xls</b>															PLOT DATE: <b>9/16/2009</b>							
							PROJECT MANAGER: <b>N. Avery</b>															DRAWN BY: <b>I. Shea</b>							
							DESIGNED BY: <b>D. Crosslev</b>															CHECKED BY: <b>J. Kelly</b>							
							MORETOWN SHEET 8															SHEET <b>16</b> OF <b>166</b>							


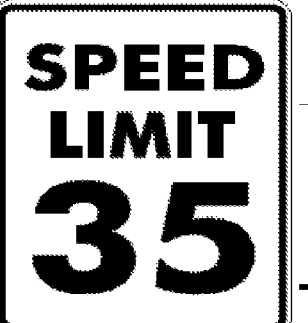

DIRECTION	MILEPOINT	LOCATION CODE (SHEET 2)	SIGN CODE	WIDTH (IN)	HEIGHT (IN)	SHEETING REMARKS	SIGN LEGEND	NEW SIGNS		EXISTING SIGNS				EXIST POST		NUMBER OF NEW POSTS	SQUARE STEEL (IN)			TUBULAR STEEL Ø (IN)				SIGN FRAME REQUIRED	REMARKS	SIGN DETAIL		
								"A"	"B"	RETAIN	SALVAGE FROM	SALVAGE TO	REMOVE	RETAIN	REMOVE		1.75	2.00	2.50	3.00	3.50	4.00	5.00			DETAIL IN SHS	DETAIL ON SHEET NUMBER	DETAIL ON STD SHEET NUMBER
																	(LB / FT)			(LB / FT)								
							FY-FLUORESCENT YELLOW FYG-FLUORESCENT YELLOW GREEN															"SHS"-STANDARD HIGHWAY SIGNS						
		F	M6-1	21	15								1															
		F	M3-1	24	12			2.00												1B		GREEN ON WHITE SHEETING	X					
		F	M1-5	30	24			5.00																E-136B				
		F	M6-1L	21	15			2.19														GREEN ON WHITE SHEETING	X					
		F	M3-3	24	12			2.00														GREEN ON WHITE SHEETING	X					
		F	M1-5	30	24			5.00																	E-136B			
		F	M6-1R	21	15			2.19														GREEN ON WHITE SHEETING	X					
SB	0.460	F	R1-1	30	30		STOP		1						X													
SB	0.440	F	M3-3	24	12								1															
		F	M1-5	24	24								1															
		F	M3-3	24	12			2.00						1		X							GREEN ON WHITE SHEETING	X				
		F	M1-5	30	24			5.00																	E-136B			
SB	0.400	F	D1-1A	72	10								1			X												
		F	D1-1A	72	10								1															
		F	D2-1	72	12			6.00						2		X									5			
<b>SIGN SUMMARY SHEET</b>							SHEET TOTALS	31.38	0.00	1	0	0	5	0	0	3	45							PROJECT NAME: <b>Mortown-Newport Town VT100</b>				
								SF	SF	EA	EA	EA	EA	EA	EA	EA	EA	EA	EA	EA	EA	FT					PROJECT NUMBER: <b>STPG SIGN(28)</b>	
VERMONT AGENCY OF TRANSPORTATION							TOWN TOTALS	228.6	0.0	22.0	0.0	0.0	60	0.0	0.0	27	405.0					FILE NAME: <b>Moretown.xls</b> PLOT DATE: <b>9/16/2009</b>						
																					PROJECT MANAGER: <b>N. Avery</b> DRAWN BY: <b>I. Shea</b>							
																					DESIGNED BY: <b>D. Crosslev</b> CHECKED BY: <b>J. Kelly</b>							
																					MORETOWN SHEET 9 SHEET <b>17</b> OF <b>166</b>							


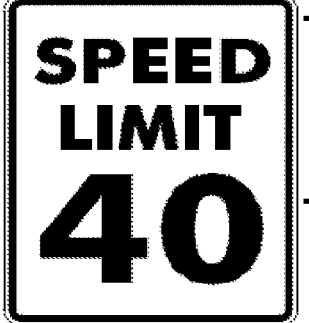


DIRECTION	MILEPOINT	LOCATION CODE (SHEET 2)	SIGN CODE	WIDTH (IN)	HEIGHT (IN)	SHEETING REMARKS	SIGN LEGEND	NEW SIGNS		EXISTING SIGNS			EXIST POST		NUMBER OF NEW POSTS	SQUARE STEEL (IN)			TUBULAR STEEL Ø (IN)				SIGN FRAME REQUIRED	REMARKS	SIGN DETAIL				
								"A"	"B"	RETAIN	SALVAGE FROM	SALVAGE TO	REMOVE	RETAIN		REMOVE	1.75	2.00	2.50	FOUNDATION	3.00	3.50			4.00	5.00	DETAIL IN SHS	DETAIL ON SHEET NUMBER	DETAIL ON STD SHEET NUMBER
																	(LB / FT)				(LB / FT)								





<b>MORETOWN VT 100</b>							FY-FLUORESCENT YELLOW FYG-FLUORESCENT YELLOW GREEN															"SHS"-STANDARD HIGHWAY SIGNS			
			F	D2-1	72	12		6.00																	5
			F	R2-1	24	30						1													
SB	0.360		F	R2-1	24	30								1											
			F	R2-1	24	30		5.00																	X
SB	0.080		F	W11-6H	30	30	HINGED SNOWMOBILE SYMBOL																		

<b>SIGN SUMMARY SHEET</b>							SHEET TOTALS							11.00	0.00	0	0	0	2	0	0	1	15					PROJECT NAME: <b>Mortown-Newport Town VT100</b>			
							SF	SF	EA	EA	EA	EA	EA	EA	EA	EA	EA	EA	EA	EA	EA	EA	EA	EA	EA	EA	FT				
VERMONT AGENCY OF TRANSPORTATION							TOWN TOTALS							228.6	0.0	22.0	0.0	0.0	60	0.0	0.0	27	405.0					FILE NAME: <b>Moretown.xls</b> PLOT DATE: <b>9/16/2009</b>			
																												PROJECT MANAGER: <b>N. Avery</b> DRAWN BY: <b>I. Shea</b>			
																												DESIGNED BY: <b>D. Crosslev</b> CHECKED BY: <b>J. Kelly</b>			
																												MORETOWN SHEET 10 SHEET <b>18</b> OF <b>166</b>			

DIRECTION	MILEPOINT	LOCATION CODE (SHEET 2)	SIGN CODE	WIDTH (IN)	HEIGHT (IN)	SHEETING REMARKS	SIGN LEGEND	NEW SIGNS		EXISTING SIGNS				EXIST POST		NUMBER OF NEW POSTS	SQUARE STEEL (IN)			TUBULAR STEEL Ø (IN)				SIGN FRAME REQUIRED	REMARKS	SIGN DETAIL												
								"A"	"B"	RETAIN	SALVAGE FROM	SALVAGE TO	REMOVE	RETAIN	REMOVE		1.75	2.00	2.50	FOUNDATION	3.00	3.50	4.00			5.00	DETAIL IN SHS	DETAIL ON SHEET NUMBER	DETAIL ON STD SHEET NUMBER									
																	(LB / FT)				(LB / FT)																	
<b>DUXBURY VT 100</b>							FY-FLUORESCENT YELLOW FYG-FLUORESCENT YELLOW GREEN															"SHS"-STANDARD HIGHWAY SIGNS																
NB	0.000	C	VD-024	60	7.5																																	
		C	VD-024	72	10			5.00								2		X																			4	
		C	VD-700	6	10			0.42																														
		C	VD-700	6	10			0.42																														
NB	0.010	A	S3-1	30	30		SCHOOL BUS STOP AHEAD						1																									
		A	W1-4R	30	30			6.25							1			X																			X	
		A	W13-1	18	18			2.25																													X	
								6.25							1			X																				INSTALL 200' +/- NORTH OF ORIGINAL SIGN LOCATION
NB	0.050	A	S3-1	30	30																																X	
NB	0.218	C	VR-017	24	30		LEGAL LOAD LIMIT 24,000 LBS				1							X																			DELONG RD TH 15	
NB	0.224	D	R1-1	30	30		STOP				1							X																			DELONG RD TH 15	
NB	0.320	A	S1-1	36	36	FYG	SCHOOL				1							X																				
		A	W16-9	36	24	FYG	AHEAD				1																											
NB	0.360	A	S4-3	24	8	FYG	SCHOOL				1							X																				
		A	R2-1	24	30		SPEED LIMIT 35				1																											
		A	S4-2	24	10		WHEN CHILDREN ARE PRESENT				1																											
<b>SIGN SUMMARY SHEET</b>							<b>SHEET TOTALS</b>	20.59	0.00	7	0	0	2	0	0	4	60																					
							SF	SF	EA	EA	EA	EA	EA	EA	EA	EA	FT																					
							<b>TOWN TOTALS</b>	345.2	0.0	68.0	1.0	1.0	65	0.0	0.0	62	930.0																					
VERMONT AGENCY OF TRANSPORTATION							PROJECT NAME: <b>Moretown-Newport Town VT100</b>															PROJECT NUMBER: <b>STPG SIGN(28)</b>			FILE NAME: <b>Duxburv.xls</b>			PLOT DATE: <b>9/16/2009</b>										
																						PROJECT MANAGER: <b>N. Avery</b>			DRAWN BY: <b>I. Shea</b>													
																						DESIGNED BY: <b>D. Crosslev</b>			CHECKED BY: <b>J. Kelly</b>													
																						DUXBURY SHEET 1			SHEET <b>19</b> OF <b>166</b>													

DIRECTION	MILEPOINT	LOCATION CODE (SHEET 2)	SIGN CODE	WIDTH (IN)	HEIGHT (IN)	SHEETING REMARKS	SIGN LEGEND	NEW SIGNS		EXISTING SIGNS				EXIST POST		NUMBER OF NEW POSTS	SQUARE STEEL (IN)			TUBULAR STEEL Ø (IN)				SIGN FRAME REQUIRED	REMARKS	SIGN DETAIL			
								"A"	"B"	RETAIN	SALVAGE FROM	SALVAGE TO	REMOVE	RETAIN	REMOVE		1.75	2.00	2.50	FOUNDATION	3.00	3.50	4.00			5.00	DETAIL IN SHS	DETAIL ON SHEET NUMBER	DETAIL ON STD SHEET NUMBER
																	(LB / FT)				(LB / FT)								
<b>DUXBURY VT 100</b>							FY-FLUORESCENT YELLOW FYG-FLUORESCENT YELLOW GREEN																"SHS"-STANDARD HIGHWAY SIGNS						
NB	0.432	A	D1-1E	72	20																								
		A	D1-2R	72	20			10.00																		5			
		A	S4-3	24	8	FYG	SCHOOL			1																			
		A	R2-1	24	30		SPEED LIMIT 35																						
		A	S4-2	24	10		WHEN CHILDREN ARE PRESENT			1																			
		A	R2-1	24	30																					X			
		A	R2-1	24	30			5.00																					
NB	0.500	A	S1-1	36	36	FYG	SCHOOL			1																			
		A	W16-7	30	18	FYG	DIAGONAL ARROW			1																			
NB	0.510	D	R1-1	30	30		STOP			1																			
NB	0.527	A	S4-3YG	24	8		SCHOOL			1																			
		A	R2-1	24	30																								
		A	S4-2	24	10																								
		A	R2-1	24	30			5.00																			X		
		A	S4-2	24	10		1.67																			X			
NB	0.570	A	W11-3	30	30		DEER CROSSING																						
<b>SIGN SUMMARY SHEET</b>							SHEET TOTALS		21.67	0.00	6	0	0	5	0	0	3	45									PROJECT NAME: <b>Moretown-Newport Town VT100</b>		
							SF	SF	EA	EA	EA	EA	EA	EA	EA	EA	EA	EA	EA	EA	EA	EA	EA	EA	EA	EA	EA	EA	EA
VERMONT AGENCY OF TRANSPORTATION							TOWN TOTALS		345.2	0.0	68.0	1.0	1.0	65	0.0	0.0	62	930.0						FILE NAME: <b>Duxburv.xls</b>	PLOT DATE: <b>9/16/2009</b>				
																								PROJECT MANAGER: <b>N. Avery</b>	DRAWN BY: <b>I. Shea</b>				
																								DESIGNED BY: <b>D. Crosslev</b>	CHECKED BY: <b>J. Kelly</b>				
																								DUXBURY SHEET 2	SHEET <b>20</b> OF <b>166</b>				

DIRECTION	MILEPOINT	LOCATION CODE (SHEET 2)	SIGN CODE	WIDTH (IN)	HEIGHT (IN)	SHEETING REMARKS	SIGN LEGEND	NEW SIGNS		EXISTING SIGNS				EXIST POST		NUMBER OF NEW POSTS	SQUARE STEEL (IN)			TUBULAR STEEL Ø (IN)				SIGN FRAME REQUIRED	REMARKS	SIGN DETAIL					
								"A"	"B"	RETAIN	SALVAGE FROM	SALVAGE TO	REMOVE	RETAIN	REMOVE		1.75	2.00	2.50	FOUNDATION	3.00	3.50	4.00			5.00	DETAIL IN SHS	DETAIL ON SHEET NUMBER	DETAIL ON STD SHEET NUMBER		
																	(LB / FT)				(LB / FT)										
<b>DUXBURY VT 100</b>							FY-FLUORESCENT YELLOW FYG-FLUORESCENT YELLOW GREEN																"SHS"-STANDARD HIGHWAY SIGNS								
		A	W11-3	30	30			6.25							1		X								X						
NB	0.620	A	R2-1	24	30			5.00							1		X									INSTALL OPPOSITE SCHOOL 35 MPH SIGN	X				
NB	0.810	A	R2-1	24	30		SPEED LIMIT 50				1																				
NB	0.895	A	VW-000	30	30		MOOSE CROSSING				1																				
		A	W7-3A	24	18		NEXT 4 MILES				1																				
NB	2.581	C	VR-017	24	24		LEGAL LOAD LIMIT 24,000 LBS				1																WILDER RD TH-29				
NB	2.588	D	R1-1	24	24		STOP				1																WILDER RD TH-29				
NB	2.765	A	S3-1	30	30							1																			
		A	S3-1	30	30			6.25							1		X									X					
NB	3.150	A	S3-1	30	30								1																		
		A	S3-1	30	30			6.25							1		X									X					
NB	3.258	C	VR-017	24	24		LEGAL LOAD LIMIT 24,000 LBS				1																STEVENS BROOK RD TH-27				
NB	3.260	D	R1-1	24	24		STOP				1																STEVENS BROOK RD TH-27				
NB	4.390	A	VW-054L	30	30		HIDDEN DRIVE LEFT						1																		
NB	4.817	C	VR-017	24	24		LEGAL LOAD LIMIT 24,000 LBS				1																ATWOOD RD TH-25				
<b>SIGN SUMMARY SHEET</b>							SHEET TOTALS	23.75	0.00	8	0	0	3	0	0	4		60													
								SF	SF	EA	EA	EA	EA	EA	EA	EA	EA	EA	EA	EA	EA	EA	EA	EA	EA	EA	EA	EA	EA	EA	EA
VERMONT AGENCY OF TRANSPORTATION							TOWN TOTALS	345.2	0.0	68.0	1.0	1.0	65	0.0	0.0	62		930.0													
							PROJECT NAME: <b>Moretown-Newport Town VT100</b>																								
							PROJECT NUMBER: <b>STPG SIGN(28)</b>																								
							FILE NAME: <b>Duxburv.xls</b>																PLOT DATE: <b>9/16/2009</b>								
							PROJECT MANAGER: <b>N. Avery</b>																DRAWN BY: <b>I. Shea</b>								
							DESIGNED BY: <b>D. Crosslev</b>																CHECKED BY: <b>J. Kelly</b>								
							DUXBURY SHEET 3																SHEET <b>21</b> OF <b>166</b>								

DIRECTION	MILEPOINT	LOCATION CODE (SHEET 2)	SIGN CODE	WIDTH (IN)	HEIGHT (IN)	SHEETING REMARKS	SIGN LEGEND	NEW SIGNS		EXISTING SIGNS				EXIST POST		NUMBER OF NEW POSTS	SQUARE STEEL (IN)			TUBULAR STEEL Ø (IN)				SIGN FRAME REQUIRED	REMARKS	SIGN DETAIL																	
								"A"	"B"	RETAIN	SALVAGE FROM	SALVAGE TO	REMOVE	RETAIN	REMOVE		1.75	2.00	2.50	FOUNDATION	3.00	3.50	4.00			5.00	DETAIL IN SHS	DETAIL ON SHEET NUMBER	DETAIL ON STD SHEET NUMBER														
																	(LB / FT)				(LB / FT)																						
<b>DUXBURY VT 100</b>							FY-FLUORESCENT YELLOW FYG-FLUORESCENT YELLOW GREEN																"SHS"-STANDARD HIGHWAY SIGNS																				
NB	4.815	D	R1-1	24	24		STOP			1				X													ATWOOD RD TH-25																
NB	5.060	C	VM-607	24	30		43RD INF DIV MEMORIAL HIGHWAY			1				X																													
NB	5.060	C	VR-278	24	30		PROHIBITED DUMPING GARBAGE ...																																				
NB	5.085	A	W3-5	36	36		SPEED REDUCTION 40 MPH			1				X																													
NB	5.200	A	VW-054R	30	30																																						
		A	VW-054R	30	30				6.25																																		
NB	5.232	A	R2-1	24	30																																						
		A	R2-1	30	36				7.50																																		
NB	5.390	A	R2-1	24	30																																						
		A	R2-1	24	30				5.00																																		
NB	5.510	A	S1-1	36	36																																						
		A	W16-9	36	20																																						
		A	S1-1	36	36	F-Y-G			9.00																																		
		A	W16-9	36	20	F-Y-G			5.00																																		
NB	5.549	A	S4-3YG	24	8		SCHOOL			1					X																												
<b>SIGN SUMMARY SHEET</b>							SHEET TOTALS											32.75	0.00	4	0	0	6	0	0	6	90																
							SF	SF	EA	EA	EA	EA	EA	EA	EA	EA	EA	EA	EA	EA	EA	EA	EA	EA	EA	EA	EA	EA	EA	EA	EA	EA	EA	EA	EA	EA	EA						
VERMONT AGENCY OF TRANSPORTATION							TOWN TOTALS											345.2	0.0	68.0	1.0	1.0	65	0.0	0.0	62	930.0																
																		PROJECT NAME: <b>Moretown-Newport Town VT100</b> PROJECT NUMBER: <b>STPG SIGN(28)</b> FILE NAME: <b>Duxburv.xls</b> PLOT DATE: <b>9/16/2009</b> PROJECT MANAGER: <b>N. Avery</b> DRAWN BY: <b>I. Shea</b> DESIGNED BY: <b>D. Crosslev</b> CHECKED BY: <b>J. Kelly</b> DUXBURY SHEET 4 SHEET <b>22</b> OF <b>166</b>																									

DIRECTION	MILEPOINT	LOCATION CODE (SHEET 2)	SIGN CODE	WIDTH (IN)	HEIGHT (IN)	SHEETING REMARKS	SIGN LEGEND	NEW SIGNS		EXISTING SIGNS				EXIST POST		NUMBER OF NEW POSTS	SQUARE STEEL (IN)			TUBULAR STEEL Ø (IN)				SIGN FRAME REQUIRED	REMARKS	SIGN DETAIL			
								"A"	"B"	RETAIN	SALVAGE FROM	SALVAGE TO	REMOVE	RETAIN	REMOVE		1.75	2.00	2.50	FOUNDATION	3.00	3.50	4.00			5.00	DETAIL IN SHS	DETAIL ON SHEET NUMBER	DETAIL ON STD SHEET NUMBER
																	(LB / FT)				(LB / FT)								

<b>DUXBURY VT 100</b>							FY-FLUORESCENT YELLOW FYG-FLUORESCENT YELLOW GREEN																"SHS"-STANDARD HIGHWAY SIGNS			
-----------------------	--	--	--	--	--	--	---	--	--	--	--	--	--	--	--	--	--	--	--	--	--	--	------------------------------	--	--	--

		A	S4-4	24	10		WHEN FLASHING			1																		
--	--	---	------	----	----	--	---------------	--	--	---	--	--	--	--	--	--	--	--	--	--	--	--	--	--	--	--	--	--

		A	R2-1	24	30		SPEED LIMIT 35			1																		
--	--	---	------	----	----	--	----------------	--	--	---	--	--	--	--	--	--	--	--	--	--	--	--	--	--	--	--	--	--

NB	5.610	A	D1-1E	72	10																							
----	-------	---	-------	----	----	--	--	--	--	--	--	--	--	--	--	--	--	--	--	--	--	--	--	--	--	--	--	--



		A	D1-2 R	72	20			10.00							2		X											5
--	--	---	--------	----	----	--	--	-------	--	--	--	--	--	--	---	--	---	--	--	--	--	--	--	--	--	--	--	---

NB	5.670	D	R1-1	30	30		STOP			1							X											
----	-------	---	------	----	----	--	------	--	--	---	--	--	--	--	--	--	---	--	--	--	--	--	--	--	--	--	--	--

NB	5.719	A	R2-1	24	30																							
----	-------	---	------	----	----	--	--	--	--	--	--	--	--	--	--	--	--	--	--	--	--	--	--	--	--	--	--	--




		A	R2-1	24	30			5.00							1		X											X
--	--	---	------	----	----	--	--	------	--	--	--	--	--	--	---	--	---	--	--	--	--	--	--	--	--	--	--	---

NB	5.760	A	W1-4L	30	30		LEFT REVERSE CURVE																					
----	-------	---	-------	----	----	--	--------------------	--	--	--	--	--	--	--	--	--	--	--	--	--	--	--	--	--	--	--	--	--




NB	5.820	A	W1-4L	30	30			6.25							1		X											INSTALL 300'+/- NORTH OF ORIGINAL SIGN LOCATION
----	-------	---	-------	----	----	--	--	------	--	--	--	--	--	--	---	--	---	--	--	--	--	--	--	--	--	--	--	---

NB	5.871	A	W1-8	18	24																							
----	-------	---	------	----	----	--	--	--	--	--	--	--	--	--	--	--	--	--	--	--	--	--	--	--	--	--	--	--

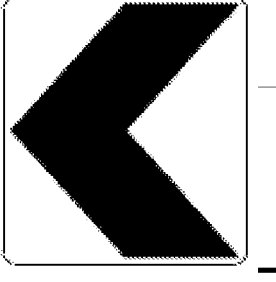


		A	W1-8	18	24			3.00							1		X											X
--	--	---	------	----	----	--	--	------	--	--	--	--	--	--	---	--	---	--	--	--	--	--	--	--	--	--	--	---

NB	5.896	A	W1-8	18	24																							
----	-------	---	------	----	----	--	--	--	--	--	--	--	--	--	--	--	--	--	--	--	--	--	--	--	--	--	--	--

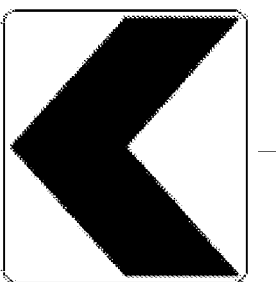





		A	W1-8	18	24			3.00							1		X											X
--	--	---	------	----	----	--	--	------	--	--	--	--	--	--	---	--	---	--	--	--	--	--	--	--	--	--	--	---

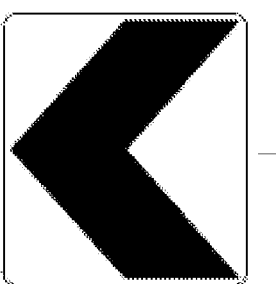NB	5.916	A	W1-8	18	24																							
----	-------	---	------	----	----	--	--	--	--	--	--	--	--	--	--	--	--	--	--	--	--	--	--	--	--	--	--	--








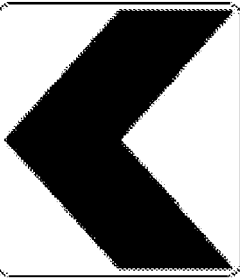


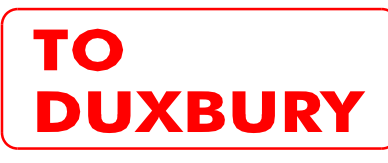


		A	W1-8	18	24			3.00							1		X											X
--	--	---	------	----	----	--	--	------	--	--	--	--	--	--	---	--	---	--	--	--	--	--	--	--	--	--	--	---


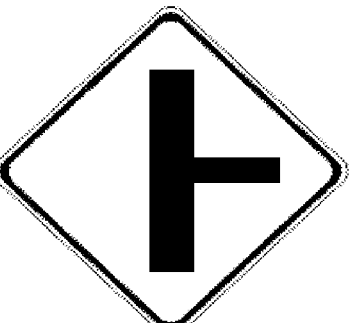
<b>SIGN SUMMARY SHEET</b>							SHEET TOTALS										PROJECT NAME: <b>Moretown-Newport Town VT100</b>											
							30.25	0.00	3	0	0	6	0	0	7	105										PROJECT NUMBER: <b>STPG SIGN(28)</b>		
VERMONT AGENCY OF TRANSPORTATION							TOWN TOTALS										FILE NAME: <b>Duxburv.xls</b>											
							345.2	0.0	68.0	1.0	1.0	65	0.0	0.0	62	930.0										PLOT DATE: <b>9/16/2009</b>		
																	PROJECT MANAGER: <b>N. Avery</b>											
																	DESIGNED BY: <b>D. Crosslev</b>											
																	DRAWN BY: <b>I. Shea</b>											
																	CHECKED BY: <b>J. Kelly</b>											
																	SHEET <b>23</b> OF <b>166</b>											

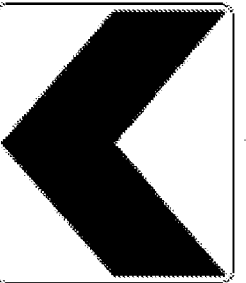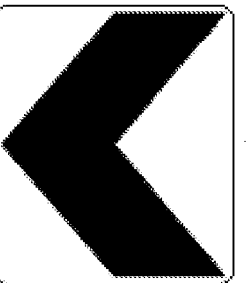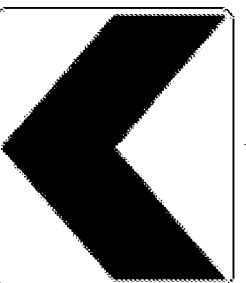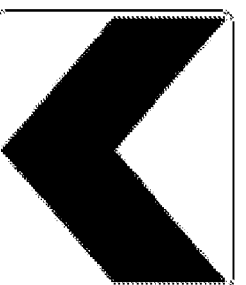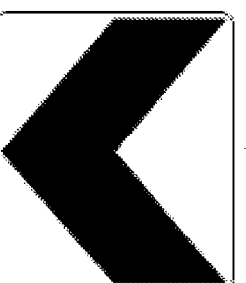



DIRECTION	MILEPOINT	LOCATION CODE (SHEET 2)	SIGN CODE	WIDTH (IN)	HEIGHT (IN)	SHEETING REMARKS	SIGN LEGEND	NEW SIGNS		EXISTING SIGNS				EXIST POST		NUMBER OF NEW POSTS	SQUARE STEEL (IN)			TUBULAR STEEL Ø (IN)				SIGN FRAME REQUIRED	REMARKS	SIGN DETAIL													
								"A"	"B"	RETAIN	SALVAGE FROM	SALVAGE TO	REMOVE	RETAIN	REMOVE		(LB / FT)			(LB / FT)						DETAIL IN SHS	DETAIL ON SHEET NUMBER	DETAIL ON STD SHEET NUMBER											
																	1.75	2.00	2.50	3.00	3.50	4.00	5.00																
<b>DUXBURY VT 100</b>							FY-FLUORESCENT YELLOW FYG-FLUORESCENT YELLOW GREEN																"SHS"-STANDARD HIGHWAY SIGNS																
NB	5.947	A	W1-8	18	24								1		X																								
		A	W1-8	18	24			3.00																			X												
NB	5.981	A	R2-1	24	30								1		X																								
		A	R2-1	24	30			5.00																			X												
NB	6.140	A	R2-1	24	30								1		X																								
		A	R2-1	30	36			7.50																			X												
NB	6.170	A	W3-1	36	36		STOP AHEAD			1				X																									
NB	6.213	A	M2-1	21	15								1		X																								
		A	M1-4	24	24								1																										
		A	M2-1	21	15			2.19																			X												
		A	M1-4	24	24			4.00																			X												
NB	6.220	A	D1-1A	72	10								1		X																								
		A	D1-1A	72	10								1																										
		A	D1-1A	72	10								1																										
		A	D1-1A	72	10								1																										
<b>SIGN SUMMARY SHEET</b>							SHEET TOTALS											21.69	0.00	1	0	0	9	0	0	4	60	PROJECT NAME: <b>Moretown-Newport Town VT100</b>											
							SF	SF	EA	EA	EA	EA	EA	EA	EA	EA	EA	EA	EA	EA	EA	EA	EA	EA	EA	EA	EA	EA	EA	EA	EA	EA	EA	PROJECT NUMBER: <b>STPG SIGN(28)</b>					
VERMONT AGENCY OF TRANSPORTATION							TOWN TOTALS											345.2	0.0	68.0	1.0	1.0	65	0.0	0.0	62	930.0	FILE NAME: <b>Duxburv.xls</b> PLOT DATE: <b>9/16/2009</b>											
																																	PROJECT MANAGER: <b>N. Avery</b> DRAWN BY: <b>I. Shea</b>						
																																		DESIGNED BY: <b>D. Crosslev</b> CHECKED BY: <b>J. Kelly</b>					
																																		DUXBURY SHEET 6 SHEET <b>24</b> OF <b>166</b>					



DIRECTION	MILEPOINT	LOCATION CODE (SHEET 2)	SIGN CODE	WIDTH (IN)	HEIGHT (IN)	SHEETING REMARKS	SIGN LEGEND	NEW SIGNS		EXISTING SIGNS				EXIST POST		NUMBER OF NEW POSTS	SQUARE STEEL (IN)			TUBULAR STEEL Ø (IN)				SIGN FRAME REQUIRED	REMARKS	SIGN DETAIL								
								"A"	"B"	RETAIN	SALVAGE FROM	SALVAGE TO	REMOVE	RETAIN	REMOVE		1.75	2.00	2.50	FOUNDATION	3.00	3.50	4.00			5.00	DETAIL IN SHS	DETAIL ON SHEET NUMBER	DETAIL ON STD SHEET NUMBER					
																	(LB / FT)				(LB / FT)													
<b>DUXBURY VT 100</b>							FY-FLUORESCENT YELLOW FYG-FLUORESCENT YELLOW GREEN															"SHS"-STANDARD HIGHWAY SIGNS												
		A	D1-1A	72	12			6.00							2			X								5								
		A	D1-1A	72	12			6.00																			5							
		A	D1-1A	72	12			6.00																			5							
		A	D1-1A	72	12			6.00																			5							
SB	6.210	F	W1-4L	30	30			6.25							1			X										INSTALL JUST SOUTH OF BRIDGE 194	X					
SB	6.190	F	D2-1	72	10		 																											
		F	D2-1	72	10																													
		F	D2-1	72	12																													
		F	D2-1	72	12																													
SB	6.161	G	VR-017	24	24																													
SB	6.140	G	VR-017	24	30																													
SB	6.154	H	R1-1	30	30																													
SB	6.144	H	R1-1	30	30																													
SB	6.140	F	R2-1	24	30																													
		F	R2-1	24	30																													
<b>SIGN SUMMARY SHEET</b>							SHEET TOTALS	58.50	0.00	0	0	0	5	0	0	8	120																	
							SF	SF	EA	EA	EA	EA	EA	EA	EA	EA	EA	EA	EA	EA	EA	EA	EA	EA	EA	EA	EA	EA	EA	EA	EA	EA	EA	EA
VERMONT AGENCY OF TRANSPORTATION							TOWN TOTALS	345.2	0.0	68.0	1.0	1.0	65	0.0	0.0	62	930.0																	
							PROJECT NAME:	<b>Moretown-Newport Town VT100</b>																										
							PROJECT NUMBER:	<b>STPG SIGN(28)</b>																										
							FILE NAME:	<b>Duxburv.xls</b>										PLOT DATE:	<b>9/16/2009</b>															
							PROJECT MANAGER:	<b>N. Avery</b>										DRAWN BY:	<b>I. Shea</b>															
							DESIGNED BY:	<b>D. Crosslev</b>										CHECKED BY:	<b>J. Kelly</b>															
							DUXBURY SHEET 7																					SHEET	<b>25</b>		OF	<b>166</b>		




DIRECTION	MILEPOINT	LOCATION CODE (SHEET 2)	SIGN CODE	WIDTH (IN)	HEIGHT (IN)	SHEETING REMARKS	SIGN LEGEND	NEW SIGNS		EXISTING SIGNS				EXIST POST		NUMBER OF NEW POSTS	SQUARE STEEL (IN)			TUBULAR STEEL Ø (IN)				SIGN FRAME REQUIRED	REMARKS	SIGN DETAIL		
								"A"	"B"	RETAIN	SALVAGE FROM	SALVAGE TO	REMOVE	RETAIN	REMOVE		1.75	2.00	2.50	3.00	3.50	4.00	5.00			DETAIL IN SHS	DETAIL ON SHEET NUMBER	DETAIL ON STD SHEET NUMBER
																	(LB / FT)			(LB / FT)								
<b>DUXBURY VT 100</b>							FY-FLUORESCENT YELLOW FYG-FLUORESCENT YELLOW GREEN															"SHS"-STANDARD HIGHWAY SIGNS						
SB	6.131	F	W1-8	18	24																							
		F	W1-8	18	24			3.00							1								X					
SB	6.113	F	W1-8	18	24																							
		F	W1-8	18	24			3.00							1								X					
SB	6.094	F	W1-8	18	24																							
		F	W1-8	18	24			3.00							1								X					
SB	6.076	F	W1-8	18	24																							
		F	W1-8	18	24			3.00							1								X					
SB	6.062	F	W1-8	18	24																							
		F	W1-8	18	24			3.00							1								X					
SB	5.973	F	R2-1	24	30																							
		F	R2-1	24	30			5.00							1								X					
SB	5.760	F	S1-1	36	36																							
		F	W16-9	24	10										1								X					
		F	S1-1	36	36	FYG		9.00							2								X					
<b>SIGN SUMMARY SHEET</b>							SHEET TOTALS	29.00	0.00	0	0	0	8	0	0	8	120							PROJECT NAME: <b>Moretown-Newport Town VT100</b>				
								SF	SF	EA	EA	EA	EA	EA	EA	EA	FT							PROJECT NUMBER: <b>STPG SIGN(28)</b>				
VERMONT AGENCY OF TRANSPORTATION							TOWN TOTALS	345.2	0.0	68.0	1.0	1.0	65	0.0	0.0	62	930.0							FILE NAME: <b>Duxburv.xls</b>	PLOT DATE: <b>9/16/2009</b>			
																								PROJECT MANAGER: <b>N. Avery</b>	DRAWN BY: <b>I. Shea</b>			
																								DESIGNED BY: <b>D. Crosslev</b>	CHECKED BY: <b>J. Kelly</b>			
																								DUXBURY SHEET 8	SHEET <b>26</b> OF <b>166</b>			

DIRECTION	MILEPOINT	LOCATION CODE (SHEET 2)	SIGN CODE	WIDTH (IN)	HEIGHT (IN)	SHEETING REMARKS	SIGN LEGEND	NEW SIGNS		EXISTING SIGNS				EXIST POST		NUMBER OF NEW POSTS	SQUARE STEEL (IN)			TUBULAR STEEL Ø (IN)				SIGN FRAME REQUIRED	REMARKS	SIGN DETAIL					
								"A"	"B"	RETAIN	SALVAGE FROM	SALVAGE TO	REMOVE	RETAIN	REMOVE		1.75	2.00	2.50	FOUNDATION	3.00	3.50	4.00			5.00	DETAIL IN SHS	DETAIL ON SHEET NUMBER	DETAIL ON STD SHEET NUMBER		
																	(LB / FT)				(LB / FT)										
<b>DUXBURY VT 100</b>							FY-FLUORESCENT YELLOW FYG-FLUORESCENT YELLOW GREEN																"SHS"-STANDARD HIGHWAY SIGNS								
		F	W16-9	36	24	FYG		5.00																		X					
SB	5.719	F	S4-3YG	24	8		SCHOOL			1				X																	
		F	R2-1	24	30		SPEED LIMIT 35			1																					
		F	S4-4	24	10		WHEN FLASHING			1																					
SB	5.690	F	D1-1E	72	20		<--- CROSSETT BROOK MIDDLE SCHOOL			1				X																	
SB	5.669	G	VR-017	24	24		LEGAL LOAD LIMIT 24,000 LBS			1				X														MAIN ST TH-41			
SB	5.658	H	R1-1	30	30		STOP			1				X														MAIN ST TH-41			
SB	5.594	F	VW-619	30	30		 	4.00							X																
		F	VW-619	36	36			7.50							1												6				
SB	5.560	F	R2-1	24	30		SPEED LIMIT 40			1				X																	
SB	5.508	G	VR-017	24	24		LEGAL LOAD LIMIT 24,000 LBS				1	1			X													CROSSETT HILL RD TH-4(NORTH) MOVE SIGN CLOSER TO RT 100			
SB	5.496	H	R1-1	24	24		STOP			1				X														CROSSETT HILL RD TH-4(NORTH)			
SB	5.390	F	R2-1	24	30																										
		F	R2-1	24	30			5.00																			X				
SB	5.232	F	R2-1	24	30																										
<b>SIGN SUMMARY SHEET</b>							SHEET TOTALS	17.50	0.00	8	1	1	3	0	0	3	45														PROJECT NAME: <b>Moretown-Newport Town VT100</b>
								SF	SF	EA	EA	EA	EA	EA	EA	EA	EA	EA	EA	EA	EA	EA	EA	EA	EA	EA	EA	EA	EA	EA	EA
VERMONT AGENCY OF TRANSPORTATION							TOWN TOTALS	345.2	0.0	68.0	1.0	1.0	65	0.0	0.0	62	930.0												FILE NAME: <b>Duxburv.xls</b>		
																													PLOT DATE: <b>9/16/2009</b>		
																														DRAWN BY: <b>I. Shea</b>	
																														CHECKED BY: <b>J. Kelly</b>	
																														SHEET <b>27</b> OF <b>166</b>	

DIRECTION	MILEPOINT	LOCATION CODE (SHEET 2)	SIGN CODE	WIDTH (IN)	HEIGHT (IN)	SHEETING REMARKS	SIGN LEGEND	NEW SIGNS		EXISTING SIGNS				EXIST POST		NUMBER OF NEW POSTS	SQUARE STEEL (IN)			TUBULAR STEEL Ø (IN)				SIGN FRAME REQUIRED	REMARKS	SIGN DETAIL			
								"A"	"B"	RETAIN	SALVAGE FROM	SALVAGE TO	REMOVE	RETAIN	REMOVE		1.75	2.00	2.50	FOUNDATION	3.00	3.50	4.00			5.00	DETAIL IN SHS	DETAIL ON SHEET NUMBER	DETAIL ON STD SHEET NUMBER
																	(LB / FT)				(LB / FT)								
<b>DUXBURY VT 100</b>							FY-FLUORESCENT YELLOW FYG-FLUORESCENT YELLOW GREEN															"SHS"-STANDARD HIGHWAY SIGNS							
		F R2-1		24	30			5.00							1		X							X					
SB	5.091	F VD-062B		72	16		BUSINESS SIGN			1																			
SB	4.648	G VR-017		24	24		LEGAL LOAD LIMIT 24,000 LBS			1															GROUT RD TH-23				
SB	4.641	H R1-1		24	24		STOP			1															GROUT RD TH-23				
SB	4.584	F VW-000		30	30		MOOSE CROSSING			1																			
		F W7-3A		24	18		NEXT 4 MILES			1																			
SB	4.320	F W2-2R		30	30		RIGHT SIDE ROAD						1				X												
SB	4.266	F S3-1		30	30		SCHOOL BUS STOP AHEAD						1				X												
		F W2-2MaR		30	30			6.25							1		X								6				
SB	4.192	C R6-1 L		36	12		ONE WAY			1							X												
		D R6-1 L		36	12		ONE WAY			1																			
SB	4.180	C R6-1 L		36	12		ONE WAY			1							X												
		D R6-1 L		36	12		ONE WAY			1																			
SB	4.170	G VR-017		24	30		LEGAL LOAD LIMIT 24,000 LBS			1							X								CROSSETT HILL RD TH-4(NORTH)				
SB	4.130	H R1-1		30	30		STOP			1							X								CROSSETT HILL RD TH-4(SOUTH)				
<b>SIGN SUMMARY SHEET</b>							SHEET TOTALS	11.25	0.00	11	0	0	2	0	0	2	30										PROJECT NAME: <b>Moretown-Newport Town VT100</b>		
								SF	SF	EA	EA	EA	EA	EA	EA	EA	EA	EA	EA	EA	EA	EA	EA	EA	EA	EA	EA	EA	EA
VERMONT AGENCY OF TRANSPORTATION							TOWN TOTALS	345.2	0.0	68.0	1.0	1.0	65	0.0	0.0	62	930.0								FILE NAME: <b>Duxburv.xls</b>				
																									PLOT DATE: <b>9/16/2009</b>				
																										DRAWN BY: <b>I. Shea</b>			
																										CHECKED BY: <b>J. Kelly</b>			
																										SHEET <b>28</b> OF <b>166</b>			




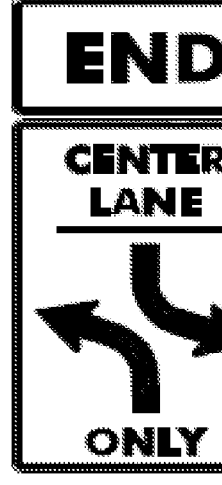
DIRECTION	MILEPOINT	LOCATION CODE (SHEET 2)	SIGN CODE	WIDTH (IN)	HEIGHT (IN)	SHEETING REMARKS	SIGN LEGEND	NEW SIGNS		EXISTING SIGNS				EXIST POST		NUMBER OF NEW POSTS	SQUARE STEEL (IN)			TUBULAR STEEL Ø (IN)				SIGN FRAME REQUIRED	REMARKS	SIGN DETAIL						
								"A"	"B"	RETAIN	SALVAGE FROM	SALVAGE TO	REMOVE	RETAIN	REMOVE		1.75	2.00	2.50	FOUNDATION	3.00	3.50	4.00			5.00	DETAIL IN SHS	DETAIL ON SHEET NUMBER	DETAIL ON STD SHEET NUMBER			
																	(LB / FT)				(LB / FT)											
<b>DUXBURY VT 100</b>							FY-FLUORESCENT YELLOW FYG-FLUORESCENT YELLOW GREEN																"SHS"-STANDARD HIGHWAY SIGNS									
SB	3.895	F	VW-054L	30	30		HIDDEN DRIVE LEFT																									
								6.25																					E-154			
SB	2.855	F	W11-6 H	30	30		SNOWMOBILE SYMBOL HINGED			1																						
SB	2.726	G	VR-017	24	30		LEGAL LOAD LIMIT 24,000 LBS			1																			RYAN RD TH-26			
SB	2.715	H	R1-1	30	30		STOP			1																			RYAN RD TH-26			
SB	1.948	G	VR-017	24	30		LEGAL LOAD LIMIT 24,000 LBS			1																			TURNER HILL RD TH-31 (NORTH) REMOVE SLOW CHILDREN SIGN			
SB	1.942	H	R1-1	30	30		STOP			1																			TURNER HILL RD TH-31 (NORTH)			
SB	1.750	F	S3-1	30	30			6.25																								
		F	S3-1	30	30																					X						
SB	1.410	F	S3-1	30	30			6.25																								
		F	S3-1	30	30																					X						
SB	0.940	F	W11-3	30	30			6.25																					INSTALL 250' +/- NORTH OF SPEED REDUCTION 40 MPH SIGN			
SB	0.905	F	W3-5	36	36		SPEED REDUCTION 40 MPH			1																						
SB	0.858	G	VR-017	24	24		LEGAL LOAD LIMIT 24,000 LBS			1																			TURNER HILL RD TH-31 (SOUTH)			
SB	0.846	H	R1-1	30	30		STOP			1																			TURNER HILL RD TH-31 (SOUTH)			
<b>SIGN SUMMARY SHEET</b>							SHEET TOTALS	25.00	0.00	8	0	0	3	0	0	4	60									PROJECT NAME: <b>Moretown-Newport Town VT100</b>						
								SF	SF	EA	EA	EA	EA	EA	EA	EA	EA	EA	EA	EA	EA	FT							PROJECT NUMBER: <b>STPG SIGN(28)</b>			
VERMONT AGENCY OF TRANSPORTATION							TOWN TOTALS	345.2	0.0	68.0	1.0	1.0	65	0.0	0.0	62	930.0								FILE NAME: <b>Duxburv.xls</b> PLOT DATE: <b>9/16/2009</b>							
																									PROJECT MANAGER: <b>N. Avery</b> DRAWN BY: <b>I. Shea</b>							
																										DESIGNED BY: <b>D. Crosslev</b> CHECKED BY: <b>J. Kelly</b>						
																											DUXBURY SHEET 11 SHEET <b>29</b> OF <b>166</b>					

DIRECTION	MILEPOINT	LOCATION CODE (SHEET 2)	SIGN CODE	WIDTH (IN)	HEIGHT (IN)	SHEETING REMARKS	SIGN LEGEND	NEW SIGNS		EXISTING SIGNS				EXIST POST		NUMBER OF NEW POSTS	SQUARE STEEL (IN)			TUBULAR STEEL Ø (IN)				SIGN FRAME REQUIRED	REMARKS	SIGN DETAIL																				
								"A"	"B"	RETAIN	SALVAGE FROM	SALVAGE TO	REMOVE	RETAIN	REMOVE		1.75	2.00	2.50	FOUNDATION	3.00	3.50	4.00			5.00	DETAIL IN SHS	DETAIL ON SHEET NUMBER	DETAIL ON STD SHEET NUMBER																	
																	(LB / FT)				(LB / FT)																									
<b>DUXBURY VT 100</b>							FY-FLUORESCENT YELLOW FYG-FLUORESCENT YELLOW GREEN																"SHS"-STANDARD HIGHWAY SIGNS																							
SB	0.806	F	R2-1	24	30																																									
		F	R2-1	30	36			7.50							1												6																			
SB	0.720	G	VR-017	24	30		LEGAL LOAD LIMIT 24,000 LBS			1																	SUNRISE AVE TH-44																			
SB	0.711	H	R1-1	30	30		STOP			1																																				
SB	0.678	F	S1-1	36	36	FYG	SCHOOL			1																																				
		F	W16-9	36	20	FYG	AHEAD			1																																				
SB	0.609	F	S4-3	24	8																																									
		F	R2-1	24	30			1.33																																						
		F	S4-2	24	10			5.00																																						
		F	S4-3	24	8	FYG		1.67																																						
		F	R2-1	24	30																																									
SB	0.501	F	S1-1YG	36	36		SCHOOL			1																																				
		F	W16-7YG	30	18		DIAGONAL ARROW			1																																				
SB	0.480	F	D1-2 L	72	20																																									
<b>SIGN SUMMARY SHEET</b>							SHEET TOTALS	15.50	0.00	6	0	0	5	0	0	3	45																													
								SF	SF	EA	EA	EA	EA	EA	EA	EA	EA	EA	EA	EA	EA	FT																								
VERMONT AGENCY OF TRANSPORTATION							TOWN TOTALS	345.2	0.0	68.0	1.0	1.0	65	0.0	0.0	62	930.0																													
																					PROJECT NAME:	<b>Moretown-Newport Town VT100</b>																								
																					PROJECT NUMBER:	<b>STPG SIGN(28)</b>																								
																					FILE NAME:	<b>Duxburv.xls</b>					PLOT DATE:					<b>9/16/2009</b>														
																					PROJECT MANAGER:	<b>N. Avery</b>					DRAWN BY:					<b>I. Shea</b>														
																					DESIGNED BY:	<b>D. Crosslev</b>					CHECKED BY:					<b>J. Kelly</b>														
																					DUXBURY SHEET 12						SHEET					<b>30</b>					OF					<b>166</b>				

DIRECTION	MILEPOINT	LOCATION CODE (SHEET 2)	SIGN CODE	WIDTH (IN)	HEIGHT (IN)	SHEETING REMARKS	SIGN LEGEND	NEW SIGNS		EXISTING SIGNS				EXIST POST		NUMBER OF NEW POSTS	SQUARE STEEL (IN)			TUBULAR STEEL Ø (IN)				SIGN FRAME REQUIRED	REMARKS	SIGN DETAIL			
								"A"	"B"	RETAIN	SALVAGE FROM	SALVAGE TO	REMOVE	RETAIN	REMOVE		1.75	2.00	2.50	FOUNDATION	3.00	3.50	4.00			5.00	DETAIL IN SHS	DETAIL ON SHEET NUMBER	DETAIL ON STD SHEET NUMBER
																	(LB / FT)				(LB / FT)								
<b>DUXBURY VT 100</b>							FY-FLUORESCENT YELLOW FYG-FLUORESCENT YELLOW GREEN																"SHS"-STANDARD HIGHWAY SIGNS						
		F	D1-2 L	72	20			10.00							2		X									5			
SB	0.430	F	W2-2R	30	30		RIGHT SIDE ROAD																						
SB	0.420	G	VR-017	24	30		LEGAL LOAD LIMIT 24,000 LBS			1																DOWSVILLE RD TH-35			
SB	0.407	H	R1-1	30	30		STOP			1																DOWSVILLE RD TH-35			
SB	0.395	F	S4-3	24	8																								
		F	R2-1	24	30																								
		F	S4-2	24	10																								
		F	S4-3	24	8	FYG			1.33						1		X									X			
		F	R2-1	24	30				5.00																	X			
		F	S4-2	24	10				1.67																	X			
SB	0.357	F	R2-1	24	30																								
		F	R2-1	24	30			5.00						1		X									X				
SB	0.306	G	VR-017	24	30		LEGAL LOAD LIMIT 24,000 LBS			1																CLARK RD TH-42			
SB	0.298	H	R1-1	30	30		STOP			1																CLARK RD TH-42			
SB	0.217	F	W1-4MR	30	30		MODIFIED RIGHT REVERSE CURVE																						
<b>SIGN SUMMARY SHEET</b>							SHEET TOTALS		23.00	0.00	4	0	0	6	0	0	4		60									PROJECT NAME: <b>Moretown-Newport Town VT100</b>	
									SF	SF	EA	EA	EA	EA	EA	EA	EA	EA	EA	EA	EA		FT						
VERMONT AGENCY OF TRANSPORTATION							TOWN TOTALS		345.2	0.0	68.0	1.0	1.0	65	0.0	0.0	62		930.0							FILE NAME: <b>Duxburv.xls</b>			
																										PLOT DATE: <b>9/16/2009</b>			
																											DRAWN BY: <b>I. Shea</b>		
																											CHECKED BY: <b>J. Kelly</b>		
																											SHEET <b>31</b> OF <b>166</b>		





DIRECTION	MILEPOINT	LOCATION CODE (SHEET 2)	SIGN CODE	WIDTH (IN)	HEIGHT (IN)	SHEETING REMARKS	SIGN LEGEND	NEW SIGNS		EXISTING SIGNS				EXIST POST		NUMBER OF NEW POSTS	SQUARE STEEL (IN)			TUBULAR STEEL Ø (IN)				SIGN FRAME REQUIRED	REMARKS	SIGN DETAIL							
								"A"	"B"	RETAIN	SALVAGE FROM	SALVAGE TO	REMOVE	RETAIN	REMOVE		(LB / FT)			(LB / FT)						DETAIL IN SHS	DETAIL ON SHEET NUMBER	DETAIL ON STD SHEET NUMBER					
																	1.75	2.00	2.50	FOUNDATION	3.00	3.50	4.00						5.00				
<b>WATERBURY VT 100</b>							FY-FLUORESCENT YELLOW FYG-FLUORESCENT YELLOW GREEN																"SHS"-STANDARD HIGHWAY SIGNS										
			A	M1-5	30	24																											
			A	M3-1	24	12		2.00							1			X								X							
			A	M1-5	30	24		5.00																				E-136B					
NB	0.714		A	VR-644	24	12																											
			A	R3-9B	24	36																											
			A	VR-644p	24	12		2.00							1			X															
			A	R3-9B	24	36		6.00																	X								
NB	0.720		A	VD-062C	74.75	16	TRAVEL INFORMATION				1						X																
			A	VD-062BC	74.75	16	TRAVEL INFORMATION				1																						
NB	0.759		A	R2-1	24	30																											
			A	R2-1	24	30		5.00							1			X							X								
NB	0.770		A	M4-6	24	12																											
			A	R3-9B	24	36																											
			A	M4-6	24	12		2.00							1			X								X							
			A	R3-9B	24	36		6.00																	X								
<b>SIGN SUMMARY SHEET</b>							SHEET TOTALS	28.00	0.00	2	0	0	6	0	0	4		60															
								SF	SF	EA	EA	EA	EA	EA	EA	EA		FT															
VERMONT AGENCY OF TRANSPORTATION							TOWN TOTALS	622.8	0.0	89.0	5.0	5.0	115	2.0	0.0	105		1575.0															
																					PROJECT NAME:	<b>Moretown-Newport Town VT100</b>											
																					PROJECT NUMBER:	<b>STPG SIGN(28)</b>											
																					FILE NAME:	<b>Waterburv.xls</b>						PLOT DATE: <b>9/17/2009</b>					
																					PROJECT MANAGER:	<b>N. Avery</b>						DRAWN BY: <b>I. Shea</b>					
																					DESIGNED BY:	<b>D. Crosslev</b>						CHECKED BY: <b>N. Avery</b>					
																					WATERBURY SHEET 2						SHEET <b>34</b> OF <b>166</b>						

DIRECTION	MILEPOINT	LOCATION CODE (SHEET 2)	SIGN CODE	WIDTH (IN)	HEIGHT (IN)	SHEETING REMARKS	SIGN LEGEND	NEW SIGNS		EXISTING SIGNS				EXIST POST		NUMBER OF NEW POSTS	SQUARE STEEL (IN)			TUBULAR STEEL Ø (IN)				SIGN FRAME REQUIRED	REMARKS	SIGN DETAIL			
								"A"	"B"	RETAIN	SALVAGE FROM	SALVAGE TO	REMOVE	RETAIN	REMOVE		1.75	2.00	2.50	FOUNDATION	3.00	3.50	4.00			5.00	DETAIL IN SHS	DETAIL ON SHEET NUMBER	DETAIL ON STD SHEET NUMBER
																	(LB / FT)				(LB / FT)								
																	1.88	2.42	3.35		7.60	9.00	10.80			14.60			

**WATERBURY VT 100**

FY-FLUORESCENT YELLOW  
FYG-FLUORESCENT YELLOW GREEN

NB	0.790	A	VR-921	30	30																				
		A	VR-921	30	30				6.25					1		X									

NB	0.820	C	R4-7	24	30		RIGHT BULL NOSE			1					X										
		C	OM1-1	18	18		YELLOW CLUSTER			1															

NB	0.900	A	VD-062B	72	16		BUSINESS SIGN			1					X										
		A	VD-062AS	72	16		BUSINESS SIGN			1															

NB	0.930	A	S3-1	30	30		SCHOOL BUS STOP AHEAD			1					X										
----	-------	---	------	----	----	--	-----------------------	--	--	---	--	--	--	--	---	--	--	--	--	--	--	--	--	--	--

NB	0.980	A	R2-1	24	30										1		X								
		A	R2-1	24	30				5.00						1		X								X






NB	1.022	C	VR-017	24	24										1		X								
		C	VR-017	24	30				5.00						1		X								






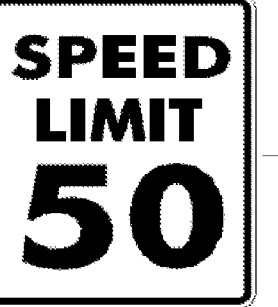
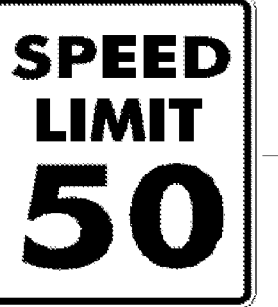




NB	1.028	D	R1-1	24	24										1		X								
		D	R1-1	30	30				6.25						1		X								X

NB	1.128	C	VR-017	24	24											X									
		C	VR-017	24	30				5.00						1		X								






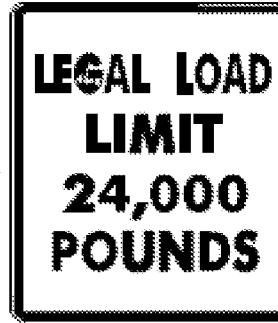

VERMONT AGENCY OF TRANSPORTATION							<b>SIGN SUMMARY SHEET</b>													PROJECT NAME: <b>Moretown-Newport Town VT100</b> PROJECT NUMBER: <b>STPG SIGN(28)</b> FILE NAME: <b>Waterburv.xls</b> PLOT DATE: <b>9/17/2009</b> PROJECT MANAGER: <b>N. Avery</b> DRAWN BY: <b>I. Shea</b> DESIGNED BY: <b>D. Crosslev</b> CHECKED BY: <b>N. Avery</b> WATERBURY SHEET 3 SHEET <b>35</b> OF <b>166</b>					
							SHEET TOTALS																		
							27.50	0.00	5	0	0	5	0	0	5										






VERMONT AGENCY OF TRANSPORTATION							<b>SIGN SUMMARY SHEET</b>													PROJECT NAME: <b>Moretown-Newport Town VT100</b> PROJECT NUMBER: <b>STPG SIGN(28)</b> FILE NAME: <b>Waterburv.xls</b> PLOT DATE: <b>9/17/2009</b> PROJECT MANAGER: <b>N. Avery</b> DRAWN BY: <b>I. Shea</b> DESIGNED BY: <b>D. Crosslev</b> CHECKED BY: <b>N. Avery</b> WATERBURY SHEET 3 SHEET <b>35</b> OF <b>166</b>					
							TOWN TOTALS																		
							622.8	0.0	89.0	5.0	5.0	115	2.0	0.0	105										




DIRECTION	MILEPOINT	LOCATION CODE (SHEET 2)	SIGN CODE	WIDTH (IN)	HEIGHT (IN)	SHEETING REMARKS	SIGN LEGEND	NEW SIGNS		EXISTING SIGNS				EXIST POST		NUMBER OF NEW POSTS	SQUARE STEEL (IN)			TUBULAR STEEL Ø (IN)				SIGN FRAME REQUIRED	REMARKS	SIGN DETAIL			
								"A"	"B"	RETAIN	SALVAGE FROM	SALVAGE TO	REMOVE	RETAIN	REMOVE		1.75	2.00	2.50	FOUNDATION	3.00	3.50	4.00			5.00	DETAIL IN SHS	DETAIL ON SHEET NUMBER	DETAIL ON STD SHEET NUMBER
																	(LB / FT)				(LB / FT)								
<b>WATERBURY VT 100</b>							FY-FLUORESCENT YELLOW FYG-FLUORESCENT YELLOW GREEN															"SHS"-STANDARD HIGHWAY SIGNS							
NB	1.133	D	R1-1	24	24																								
		D	R1-1	30	30			6.25							1		X							X					
NB	1.180	A	R2-1	24	30																								
		A	R2-1	24	30			5.00							1		X							X					
NB	1.258	A	VR-921 L	30	30																								
		A	VR-921 L	30	30			6.25							1		X								E-145A				
NB	1.358	A	M3-1S	24	12																								
		A	M1-5	30	24																								
		A	M3-1	24	12																								
		A	M1-5	30	24			2.00							1		X							X					
		A	M1-5	30	24			5.00																	E-136B				
NB	1.420	A	R2-1	24	30																								
		A	R2-1	24	30			5.00							1		X							X					
NB	1.540	A	VD-062AS	72	16		BUSINESS SIGN			1																			
		A	VD-062AS	72	16		BUSINESS SIGN			1																			
		A	VD-062B	72	16		BUSINESS SIGN			1																			
<b>SIGN SUMMARY SHEET</b>							SHEET TOTALS	29.50	0.00	3	0	0	6	0	0	5	75					PROJECT NAME: <b>Moretown-Newport Town VT100</b>							
								SF	SF	EA	EA	EA	EA	EA	EA	EA	FT					PROJECT NUMBER: <b>STPG SIGN(28)</b>							
VERMONT AGENCY OF TRANSPORTATION							TOWN TOTALS	622.8	0.0	89.0	5.0	5.0	115	2.0	0.0	105	1575.0					FILE NAME: <b>Waterburv.xls</b>	PLOT DATE: <b>9/17/2009</b>						
																						PROJECT MANAGER: <b>N. Avery</b>	DRAWN BY: <b>I. Shea</b>						
																						DESIGNED BY: <b>D. Crosslev</b>	CHECKED BY: <b>N. Avery</b>						
																						WATERBURY SHEET 4	SHEET <b>36</b> OF <b>166</b>						

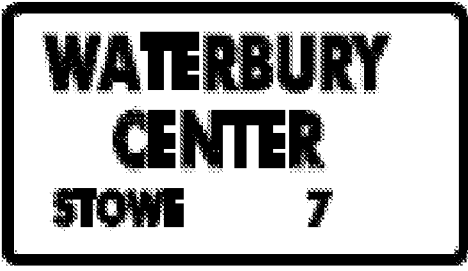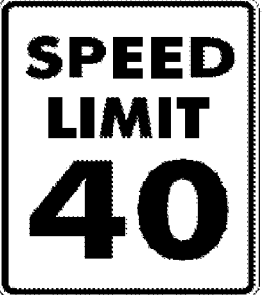
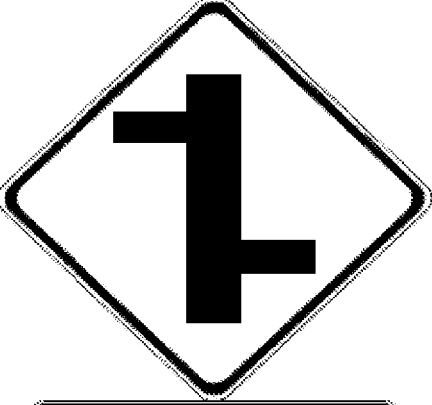



DIRECTION	MILEPOINT	LOCATION CODE (SHEET 2)	SIGN CODE	WIDTH (IN)	HEIGHT (IN)	SHEETING REMARKS	SIGN LEGEND	NEW SIGNS		EXISTING SIGNS				EXIST POST		NUMBER OF NEW POSTS	SQUARE STEEL (IN)			TUBULAR STEEL Ø (IN)				SIGN FRAME REQUIRED	REMARKS	SIGN DETAIL												
								"A"	"B"	RETAIN	SALVAGE FROM	SALVAGE TO	REMOVE	RETAIN	REMOVE		1.75	2.00	2.50	FOUNDATION	3.00	3.50	4.00			5.00	DETAIL IN SHS	DETAIL ON SHEET NUMBER	DETAIL ON STD SHEET NUMBER									
																	(LB / FT)				(LB / FT)																	
<b>WATERBURY VT 100</b>							FY-FLUORESCENT YELLOW FYG-FLUORESCENT YELLOW GREEN															"SHS"-STANDARD HIGHWAY SIGNS																
NB	1.575	A	VD-062AS	72	16		BUSINESS SIGN			1			X																									
		A	VD-062B	72	16		BUSINESS SIGN			1																												
NB	1.606	A	R2-1	24	30																																	
		A	R2-1	24	30			5.00							1		X																					
NB	1.636	C	VR-017	24	24			5.00							1		X																					
NB	1.644	D	R1-1	24	24																																	
		D	R1-1	30	30			6.25							1		X																					
NB	1.750	A	R2-1	24	30																																	
		A	R2-1	24	30			5.00							1		X																					
NB	2.050	A	VD-062B	72	16		BUSINESS SIGN			1			X																									
		A	VD-062B	72	16		BUSINESS SIGN			1																												
NB	2.360	C	VR-017	24	24																																	
		C	VR-017	24	30			5.00							1		X																					
NB	2.360	D	R1-1	24	24																																	
		D	R1-1	30	30			6.25							1		X																					
<b>SIGN SUMMARY SHEET</b>							SHEET TOTALS	32.50	0.00	4	0	0	5	0	0	6	90																					
								SF	SF	EA	EA	EA	EA	EA	EA	EA	FT																					
VERMONT AGENCY OF TRANSPORTATION							TOWN TOTALS	622.8	0.0	89.0	5.0	5.0	115	2.0	0.0	105	1575.0																					


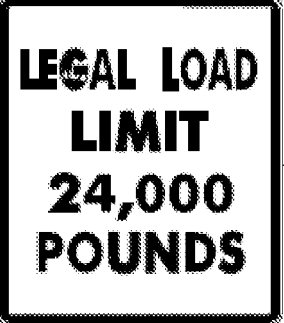

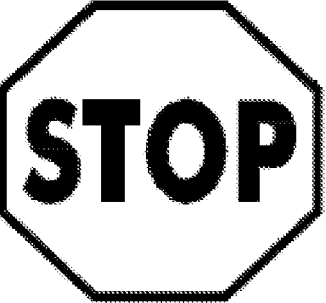
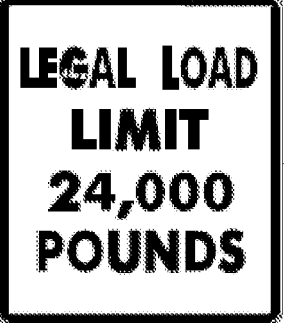

PROJECT NAME: **Moretown-Newport Town VT100**  
PROJECT NUMBER: **STPG SIGN(28)**  
FILE NAME: **Waterburv.xls** PLOT DATE: **9/17/2009**  
PROJECT MANAGER: **N. Avery** DRAWN BY: **I. Shea**  
DESIGNED BY: **D. Crosslev** CHECKED BY: **N. Avery**  
WATERBURY SHEET 5 SHEET **37** OF **166**

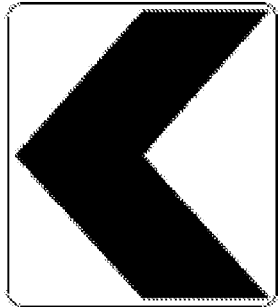




DIRECTION	MILEPOINT	LOCATION CODE (SHEET 2)	SIGN CODE	WIDTH (IN)	HEIGHT (IN)	SHEETING REMARKS	SIGN LEGEND	NEW SIGNS		EXISTING SIGNS			EXIST POST		NUMBER OF NEW POSTS	SQUARE STEEL (IN)			TUBULAR STEEL Ø (IN)				SIGN FRAME REQUIRED	REMARKS	SIGN DETAIL				
								"A"	"B"	RETAIN	SALVAGE FROM	SALVAGE TO	REMOVE	RETAIN		REMOVE	1.75	2.00	2.50	FOUNDATION	3.00	3.50			4.00	5.00	DETAIL IN SHS	DETAIL ON SHEET NUMBER	DETAIL ON STD SHEET NUMBER
																	(LB / FT)				(LB / FT)								
<b>WATERBURY VT 100</b>							FY-FLUORESCENT YELLOW FYG-FLUORESCENT YELLOW GREEN															"SHS"-STANDARD HIGHWAY SIGNS							
NB	2.477	A	W3-5	36	36																								
		A	W3-5	36	36			9.00							2		X							X					
NB	2.515	A	VD-062B	72	16		BUSINESS SIGN			1																			
		A	VD-062B	72	16		BUSINESS SIGN			1																			
NB	2.562	A	R2-1	24	30		SPEED LIMIT 40 					1																	
		A	R2-1	30	36			7.50							1		X								6				
		A	R4-1	24	30		DO NOT PASS 	6.25			1	1																	
NB	2.640	C	VR-017	24	24		LEGAL LOAD LIMIT 24,000 POUNDS 					1																	
		C	VR-017	24	30			5.00							1		X									E-141			
NB	2.650	D	R1-1	24	24		STOP 					1																	
		D	R1-1	30	30			6.25							1		X							X					
NB	2.756	C	VR-017	24	24		LEGAL LOAD LIMIT 24,000 POUNDS 					1																	
		C	VR-017	24	30			5.00							1		X									E-141			
NB	2.764	D	R1-1	24	24		STOP 					1																	
		D	R1-1	30	30			6.25							1		X							X					
<b>SIGN SUMMARY SHEET</b>							SHEET TOTALS	39.00	0.00	2	1	1	6	0	0	8	120							PROJECT NAME: <b>Moretown-Newport Town VT100</b>					
								SF	SF	EA	EA	EA	EA	EA	EA	EA	EA	EA	EA	EA	EA	EA	EA	EA	EA	EA	EA	PROJECT NUMBER: <b>STPG SIGN(28)</b>	
VERMONT AGENCY OF TRANSPORTATION							TOWN TOTALS	622.8	0.0	89.0	5.0	5.0	115	2.0	0.0	105	1575.0							FILE NAME: <b>Waterburv.xls</b>					
																												PLOT DATE: <b>9/17/2009</b>	
																						DRAWN BY: <b>I. Shea</b>							
																							CHECKED BY: <b>N. Avery</b>						
																							SHEET <b>38</b> OF <b>166</b>						

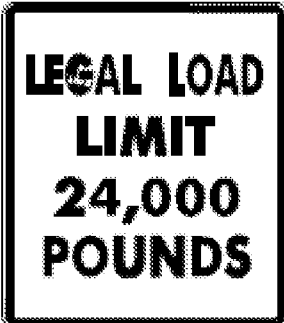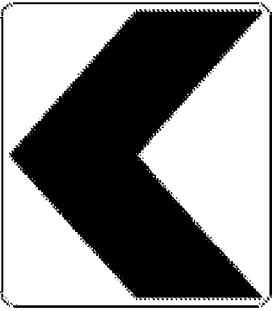



DIRECTION	MILEPOINT	LOCATION CODE (SHEET 2)	SIGN CODE	WIDTH (IN)	HEIGHT (IN)	SHEETING REMARKS	SIGN LEGEND	NEW SIGNS		EXISTING SIGNS				EXIST POST		NUMBER OF NEW POSTS	SQUARE STEEL (IN)			TUBULAR STEEL Ø (IN)				SIGN FRAME REQUIRED	REMARKS	SIGN DETAIL			
								"A"	"B"	RETAIN	SALVAGE FROM	SALVAGE TO	REMOVE	RETAIN	REMOVE		1.75	2.00	2.50	FOUNDATION	3.00	3.50	4.00			5.00	DETAIL IN SHS	DETAIL ON SHEET NUMBER	DETAIL ON STD SHEET NUMBER
																	(LB / FT)				(LB / FT)								
<b>WATERBURY VT 100</b>							FY-FLUORESCENT YELLOW FYG-FLUORESCENT YELLOW GREEN															"SHS"-STANDARD HIGHWAY SIGNS							
NB	2.858	A	R2-1	24	30		SPEED LIMIT 40			1				X															
	<b>NEW</b>			<b>30</b>	<b>30</b>		<b>END NO PASSING</b>	<b>6.25</b>																					
		B	W14-3	48	36		NO PASSING ZONE			1																			
NB	3.088	A	VD-018	30	18					1				X															
		A	VD-018	30	18			3.75							1	X												E-128B	
NB	3.120	A	VD-062BRN	72	16		BUSINESS SIGN			1				X															
		A	VD-062B	72	16		BUSINESS SIGN			1																			
		A	VD-062B	72	16		BUSINESS SIGN			1																			
NB	3.138	A	R2-1	24	30									1															
		A	R2-1	24	30			5.00							1	X										X			
NB	3.160	A	W2-1M f	36	36		MODIFIED CROSSROAD																						
		A	W16-8A	48	15		<--- RESERVOIR RD HOWARD RD ---->																						
																													
																													
NB	3.210	A	W2-1M f	36	36			9.00							2	X												INSTALL 260' +/- NORTH OF ORIGINAL SIGN LOCATION	
								5.00																				6	
			W16-8A	48	15																							8	
NB	3.324	C	VR-017	24	24									1															
		C	VR-017	24	30			5.00							1	X												E-141	
<b>SIGN SUMMARY SHEET</b>							SHEET TOTALS	27.75	0.00	6	0	0	3	1	0	5	75						PROJECT NAME: <b>Moretown-Newport Town VT100</b>						
								SF	SF	EA	EA	EA	EA	EA	EA	EA	FT						PROJECT NUMBER: <b>STPG SIGN(28)</b>						
VERMONT AGENCY OF TRANSPORTATION							TOWN TOTALS	622.8	0.0	89.0	5.0	5.0	115	2.0	0.0	105	1575.0						FILE NAME: <b>Waterburv.xls</b>	PLOT DATE: <b>9/17/2009</b>					
																							PROJECT MANAGER: <b>N. Avery</b>	DRAWN BY: <b>I. Shea</b>					
																							DESIGNED BY: <b>D. Crosslev</b>	CHECKED BY: <b>N. Avery</b>					
																							WATERBURY SHEET 7	SHEET <b>39</b> OF <b>166</b>					

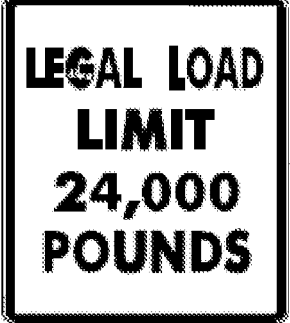
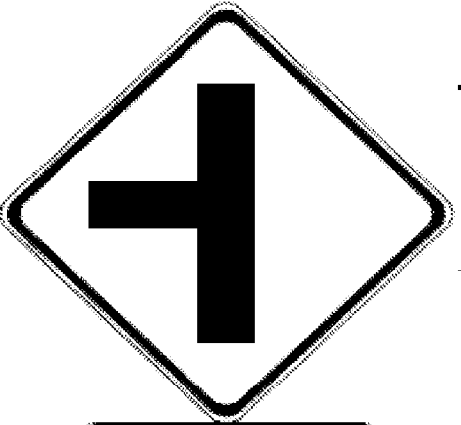
DIRECTION	MILEPOINT	LOCATION CODE (SHEET 2)	SIGN CODE	WIDTH (IN)	HEIGHT (IN)	SHEETING REMARKS	SIGN LEGEND	NEW SIGNS		EXISTING SIGNS				EXIST POST		NUMBER OF NEW POSTS	SQUARE STEEL (IN)			TUBULAR STEEL Ø (IN)				SIGN FRAME REQUIRED	REMARKS	SIGN DETAIL			
								"A"	"B"	RETAIN	SALVAGE FROM	SALVAGE TO	REMOVE	RETAIN	REMOVE		1.75	2.00	2.50	FOUNDATION	3.00	3.50	4.00			5.00	DETAIL IN SHS	DETAIL ON SHEET NUMBER	DETAIL ON STD SHEET NUMBER
																	(LB / FT)				(LB / FT)								
<b>WATERBURY VT 100</b>							FY-FLUORESCENT YELLOW FYG-FLUORESCENT YELLOW GREEN																"SHS"-STANDARD HIGHWAY SIGNS						
NB	3.332	D	R1-1	24	24									1	X														
		D	R1-1	30	30			6.25																	X				
NB	3.320	A	W3-5	36	36					1				X															
NB	3.360	A	VD-062B	72	16		BUSINESS SIGN							X															
		A	VD-062B	72	16		BUSINESS SIGN																						
NB	3.400	A	W1-1L	30	30																								
		A	W16-8A	24	8																								
		A	W1-2 McL	30	30			6.25								1											6		
		A	W16-8A	30	8			1.33																			8		
NB	3.430	A	R2-1	24	30					1				X															
NB	3.477	A	VW-205	36	36					1				X															
NB	3.504	B	W1-8	18	24		CHEVRON			1				X															
NB	3.524	A	W1-8	18	24	FY																							
		B	W1-8	18	24						1																		
NB	3.550	C	VR-017	24	24																								
<b>SIGN SUMMARY SHEET</b>							SHEET TOTALS	16.83	0.00	5	0	0	3	1	0	3	45						PROJECT NAME: <b>Moretown-Newport Town VT100</b> PROJECT NUMBER: <b>STPG SIGN(28)</b>						
								SF	SF	EA	EA	EA	EA	EA	EA	EA	FT						FILE NAME: <b>Waterburv.xls</b> PLOT DATE: <b>9/17/2009</b> PROJECT MANAGER: <b>N. Avery</b> DRAWN BY: <b>I. Shea</b> DESIGNED BY: <b>D. Crosslev</b> CHECKED BY: <b>N. Avery</b> WATERBURY SHEET 8 SHEET <b>40</b> OF <b>166</b>						
VERMONT AGENCY OF TRANSPORTATION							TOWN TOTALS	622.8	0.0	89.0	5.0	5.0	115	2.0	0.0	105	1575.0												

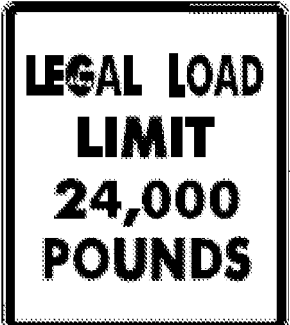



DIRECTION	MILEPOINT	LOCATION CODE (SHEET 2)	SIGN CODE	WIDTH (IN)	HEIGHT (IN)	SHEETING REMARKS	SIGN LEGEND	NEW SIGNS		EXISTING SIGNS				EXIST POST		NUMBER OF NEW POSTS	SQUARE STEEL (IN)			TUBULAR STEEL Ø (IN)				SIGN FRAME REQUIRED	REMARKS	SIGN DETAIL											
								"A"	"B"	RETAIN	SALVAGE FROM	SALVAGE TO	REMOVE	RETAIN	REMOVE		1.75	2.00	2.50	FOUNDATION	3.00	3.50	4.00			5.00	DETAIL IN SHS	DETAIL ON SHEET NUMBER	DETAIL ON STD SHEET NUMBER								
																	(LB / FT)				(LB / FT)																
<b>WATERBURY VT 100</b>							FY-FLUORESCENT YELLOW FYG-FLUORESCENT YELLOW GREEN																"SHS"-STANDARD HIGHWAY SIGNS														
		C	VR-017	24	30			5.00						1	X												E-141										
NB	3.552	A	W1-8	18	24	FY		3.00																			X										
		B	W1-8	18	24		CHEVRON			1																											
NB	3.552	D	R1-1	30	30									1	X																						
		D	R1-1	30	30			6.25						1	X												X										
NB	3.558	D	R1-1	30	30									1	X																						
		D	R1-1	30	30			6.25						1	X												X										
NB	3.598	A	R2-1	24	30		SPEED LIMIT 35			1				X																							
NB	3.825	A	R2-1	24	30									1	X																						
		A	R2-1	24	30			5.00						1	X												X										
NB	4.072	A	W2-2L	30	30		LEFT SIDE ROAD			1				X																							
		A	W16-8A	30	8		GREG HILL RD			1																											
NB	4.108	A	VD-062B	72	16		BUSINESS SIGN			1																											
		A	VD-062B	72	16		BUSINESS SIGN			1				X																							
NB	4.150	A	W11-3	30	30		DEER CROSSING							1	X																						
<b>SIGN SUMMARY SHEET</b>							SHEET TOTALS	25.50	0.00	6	0	0	4	0	0	5	75																				
								SF	SF	EA	EA	EA	EA	EA	EA	EA	EA	EA	EA	EA	EA	EA	EA	EA	EA	EA	EA	EA	EA	EA	EA	EA					
VERMONT AGENCY OF TRANSPORTATION							TOWN TOTALS	622.8	0.0	89.0	5.0	5.0	115	2.0	0.0	105	1575.0																				
							PROJECT NAME:	<b>Moretown-Newport Town VT100</b>																													
							PROJECT NUMBER:	<b>STPG SIGN(28)</b>																													
							FILE NAME:	<b>Waterburv.xls</b>										PLOT DATE:	<b>9/17/2009</b>																		
							PROJECT MANAGER:	<b>N. Avery</b>										DRAWN BY:	<b>I. Shea</b>																		
							DESIGNED BY:	<b>D. Crosslev</b>										CHECKED BY:	<b>N. Avery</b>																		
							WATERBURY SHEET	<b>9</b>										SHEET	<b>41</b>									OF	<b>166</b>								






DIRECTION	MILEPOINT	LOCATION CODE (SHEET 2)	SIGN CODE	WIDTH (IN)	HEIGHT (IN)	SHEETING REMARKS	SIGN LEGEND	NEW SIGNS		EXISTING SIGNS				EXIST POST		NUMBER OF NEW POSTS	SQUARE STEEL (IN)			TUBULAR STEEL Ø (IN)				SIGN FRAME REQUIRED	REMARKS	SIGN DETAIL													
								"A"	"B"	RETAIN	SALVAGE FROM	SALVAGE TO	REMOVE	RETAIN	REMOVE		1.75	2.00	2.50	FOUNDATION	3.00	3.50	4.00			5.00	DETAIL IN SHS	DETAIL ON SHEET NUMBER	DETAIL ON STD SHEET NUMBER										
																	(LB / FT)				(LB / FT)																		
<b>WATERBURY VT 100</b>							FY-FLUORESCENT YELLOW FYG-FLUORESCENT YELLOW GREEN																"SHS"-STANDARD HIGHWAY SIGNS																
		A	W11-3	30	30			6.25						1		X									X														
NB	4.440	C	VR-017	24	24								1			X												GUILD HILL RD TH 5											
		C	VR-017	24	30			5.00						1		X												E-141											
NB	4.440	D	R1-1	24	24								1			X												GUILD HILL RD TH 5											
		D	R1-1	30	30			6.25						1		X									X														
NB	5.158	D	R1-1	24	24								1			X												BEAVER POND RD TH-14											
		D	R1-1	30	30			6.25						1		X									X														
NB	5.160	C	VR-017	24	30								1			X												BEAVER POND RD TH-14											
		C	VR-017	24	30			5.00						1		X												E-141											
NB	5.170	D	R1-1	30	30								1			X												BEAVER POND RD TH-14											
		D	R1-1	30	30			6.25						1		X									X														
NB	5.280	A	R8-3A	24	24		NO PARKING SYMBOL						1			X																							
NB	5.300	C	VM-607	24	30		43RD INF DIV				1					X																							
NB	5.365	A	VW-000	30	30		MOOSE CROSSING				1					X																							
		A	W7-3A	24	18		NEXT 1 MILE				1																												
<b>SIGN SUMMARY SHEET</b>							SHEET TOTALS	35.00	0.00	3	0	0	6	0	0	6		90																					
								SF	SF	EA	EA	EA	EA	EA	EA	EA	EA	EA	EA	EA	EA	EA	EA	EA	EA	EA	EA	EA	EA	EA	EA	EA	EA	EA					
VERMONT AGENCY OF TRANSPORTATION							TOWN TOTALS	622.8	0.0	89.0	5.0	5.0	115	2.0	0.0	105		1575.0																					
							PROJECT NAME:	<b>Moretown-Newport Town VT100</b>																															
							PROJECT NUMBER:	<b>STPG SIGN(28)</b>																															
							FILE NAME:	<b>Waterburv.xls</b>										PLOT DATE:	<b>9/17/2009</b>																				
							PROJECT MANAGER:	<b>N. Avery</b>										DRAWN BY:	<b>I. Shea</b>																				
							DESIGNED BY:	<b>D. Crosslev</b>										CHECKED BY:	<b>N. Avery</b>																				
							WATERBURY SHEET 10											SHEET	<b>42</b>										OF	<b>166</b>									



DIRECTION	MILEPOINT	LOCATION CODE (SHEET 2)	SIGN CODE	WIDTH (IN)	HEIGHT (IN)	SHEETING REMARKS	SIGN LEGEND	NEW SIGNS		EXISTING SIGNS				EXIST POST		NUMBER OF NEW POSTS	SQUARE STEEL (IN)			TUBULAR STEEL Ø (IN)				SIGN FRAME REQUIRED	REMARKS	SIGN DETAIL												
								"A"	"B"	RETAIN	SALVAGE FROM	SALVAGE TO	REMOVE	RETAIN	REMOVE		1.75	2.00	2.50	FOUNDATION	3.00	3.50	4.00			5.00	DETAIL IN SHS	DETAIL ON SHEET NUMBER	DETAIL ON STD SHEET NUMBER									
																	(LB / FT)				(LB / FT)																	
<b>WATERBURY VT 100</b>							FY-FLUORESCENT YELLOW FYG-FLUORESCENT YELLOW GREEN															"SHS"-STANDARD HIGHWAY SIGNS																
NB	5.560	A	W2-2MR	30	30		RIGHT SIDE ROAD			1				X																								
		A	W16-8A	24	18		SPRUCE HAVEN RD			1																												
NB	5.606	A	S3-1	30	30		SCHOOL BUS STOP AHEAD			1				X																								
NB	5.664	C	VR-017	24	24							1		X																								
		C	VR-017	24	30				5.00					1		X																		E-141				
NB	5.652	D	R1-1	24	24							1		X																								
		D	R1-1	30	30				6.25					1		X																		X				
NB	6.055	C	VR-017	24	30																																	
NB	6.062	D	R1-1	24	24								1		X																							
		D	R1-1	30	30			6.25																										X				
NB	6.269	C	VR-017	24	24							1		X																								
		C	VR-017	24	30				5.00					1		X																					E-141	
NB	6.277	D	R1-1	24	24							1		X																								
		D	R1-1	30	30				6.25																										X			
NB	6.285	A	W7-1	30	30																																	
<b>SIGN SUMMARY SHEET</b>							SHEET TOTALS	33.75	0.00	3	0	0	6	0	0	6	90																					
								SF	SF	EA	EA	EA	EA	EA	EA	EA	EA																					
VERMONT AGENCY OF TRANSPORTATION							TOWN TOTALS	622.8	0.0	89.0	5.0	5.0	115	2.0	0.0	105	1575.0																					
							PROJECT NAME:	Moretown-Newport Town VT100																														
							PROJECT NUMBER:	STPG SIGN(28)																														
							FILE NAME:	Waterburv.xls										PLOT DATE:	9/17/2009																			
							PROJECT MANAGER:	N. Avery										DRAWN BY:	I. Shea																			
							DESIGNED BY:	D. Crosslev										CHECKED BY:	N. Avery																			
							WATERBURY SHEET 11							SHEET 43 OF 166																								



DIRECTION	MILEPOINT	LOCATION CODE (SHEET 2)	SIGN CODE	WIDTH (IN)	HEIGHT (IN)	SHEETING REMARKS	SIGN LEGEND	NEW SIGNS		EXISTING SIGNS				EXIST POST		NUMBER OF NEW POSTS	SQUARE STEEL (IN)			TUBULAR STEEL Ø (IN)				SIGN FRAME REQUIRED	REMARKS	SIGN DETAIL				
								"A"	"B"	RETAIN	SALVAGE FROM	SALVAGE TO	REMOVE	RETAIN	REMOVE		1.75	2.00	2.50	FOUNDATION	3.00	3.50	4.00			5.00	DETAIL IN SHS	DETAIL ON SHEET NUMBER	DETAIL ON STD SHEET NUMBER	
																	(LB / FT)				(LB / FT)									
<b>WATERBURY VT 100</b>							FY-FLUORESCENT YELLOW FYG-FLUORESCENT YELLOW GREEN																"SHS"-STANDARD HIGHWAY SIGNS							
		A	W7-1b	30	30			6.25							1		X								X					
NB	6.390	A	VW-205	30	30		WATCH FOR TURNING VEHICLES			1				X																
SB	6.574	G	VR-017	24	24							1		X																
		G	VR-017	24	30			5.00							1		X											E-141		
SB	6.573	H	R1-1	30	30							1		X																
		H	R1-1	30	30			6.25							1		X								X					
SB	6.550	H	R1-1	24	24							1		X																
		H	R1-1	30	30			6.25							1		X								X					
SB	6.394	F	VW-000	30	30		MOOSE CROSSING			1				X																
		F	W7-3A	24	18		NEXT 1 MILE			1																				
SB	6.155	F	W2-2ML	30	30		LEFT SIDE ROAD			1				X																
		F	W16-8A	24	18		RUBY RAYMOND RD			1																				
SB	5.845	F	VW-133R	30	30		HIDDEN DRIVES RIGHT				1	1			X		2		X											
		F	S3-1	30	30		SCHOOL BUS STOP AHEAD				1	1																		
SB	5.772	F	W2-2ML	30	30		MODIFIED LEFT SIDE ROAD			1					X															
<b>SIGN SUMMARY SHEET</b>							SHEET TOTALS	23.75	0.00	6	2	2	3	0	0	6		90												
								SF	SF	EA	EA	EA	EA	EA	EA	EA	EA	EA	EA	EA	EA	EA	EA	EA	EA	EA	EA	EA	EA	EA
VERMONT AGENCY OF TRANSPORTATION							TOWN TOTALS	622.8	0.0	89.0	5.0	5.0	115	2.0	0.0	105		1575.0												
							PROJECT NAME:	<b>Moretown-Newport Town VT100</b>																						
							PROJECT NUMBER:	<b>STPG SIGN(28)</b>																						
							FILE NAME:	<b>Waterburv.xls</b>											PLOT DATE:	<b>9/17/2009</b>										
							PROJECT MANAGER:	<b>N. Avery</b>											DRAWN BY:	<b>I. Shea</b>										
							DESIGNED BY:	<b>D. Crosslev</b>											CHECKED BY:	<b>N. Avery</b>										
							WATERBURY SHEET 12	SHEET <b>44</b> OF <b>166</b>																						

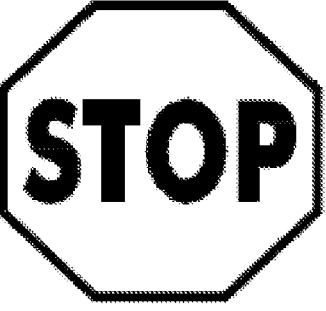


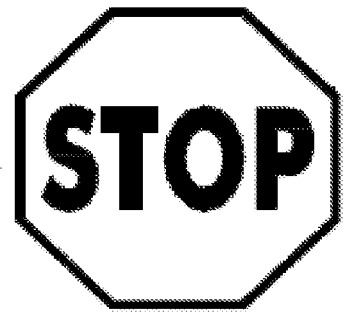


DIRECTION	MILEPOINT	LOCATION CODE (SHEET 2)	SIGN CODE	WIDTH (IN)	HEIGHT (IN)	SHEETING REMARKS	SIGN LEGEND	NEW SIGNS		EXISTING SIGNS				EXIST POST		NUMBER OF NEW POSTS	SQUARE STEEL (IN)			TUBULAR STEEL Ø (IN)				SIGN FRAME REQUIRED	REMARKS	SIGN DETAIL							
								"A"	"B"	RETAIN	SALVAGE FROM	SALVAGE TO	REMOVE	RETAIN	REMOVE		1.75	2.00	2.50	FOUNDATION	3.00	3.50	4.00			5.00	DETAIL IN SHS	DETAIL ON SHEET NUMBER	DETAIL ON STD SHEET NUMBER				
																	(LB / FT)				(LB / FT)												
<b>WATERBURY VT 100</b>							FY-FLUORESCENT YELLOW FYG-FLUORESCENT YELLOW GREEN																"SHS"-STANDARD HIGHWAY SIGNS										
		F	W16-8A	24	18		SPRUCE HAVEN RD			1					1	X																	
SB	5.283	F	W11-3	30	30		DEER CROSSING TEXT 						1		X																		
		F	W11-3	30	30			6.25							1	X										X							
SB	4.900	F	VW-205	30	30		WATCH FOR TURNING VEHICLES							1	X																		
SB	4.844	F	VD-062AS	72	16		BUSINESS SIGN			1				X																			
		F	VD-062AS	72	16		BUSINESS SIGN			1																							
		F	VD-062B	72	16		BUSINESS SIGN			1																							
SB	4.600	F	W2-2L	30	30		LEFT SIDE ROAD 							1	X																		
SB	4.540	F	W2-2MaL	30	30			6.25							1	X													INSTALL 300' +/- SOUTH OF ORIGINAL SIGN LOCATION		6		
			W16-8	30	8			1.67																						6			
SB	4.386	F	VD-062B	72	16		BUSINESS SIGN			1				X																			
		F	VD-062B	72	16		BUSINESS SIGN			1																							
SB	4.266	E	VR-072	24	30		THINK NO DRINK			1				X																			
		F	VR-072	24	30		THINK NO DRINK			1																							
SB	4.188	G	VR-017	24	24									1	X														GREGG HILL RD TH-11				
<b>SIGN SUMMARY SHEET</b>							SHEET TOTALS											14.17	0.00	8	0	0	4	0	0	3	45	PROJECT NAME: <b>Moretown-Newport Town VT100</b>					
							SF	SF	EA	EA	EA	EA	EA	EA	EA	EA	EA	EA	EA	EA	EA	EA	EA	EA	EA	EA	EA	PROJECT NUMBER: <b>STPG SIGN(28)</b>					
VERMONT AGENCY OF TRANSPORTATION							TOWN TOTALS											622.8	0.0	89.0	5.0	5.0	115	2.0	0.0	105	1575.0	FILE NAME: <b>Waterburv.xls</b> PLOT DATE: <b>9/17/2009</b>					
																												PROJECT MANAGER: <b>N. Avery</b> DRAWN BY: <b>I. Shea</b>					
																												DESIGNED BY: <b>D. Crosslev</b> CHECKED BY: <b>N. Avery</b>					
																												WATERBURY SHEET 13 SHEET <b>45</b> OF <b>166</b>					



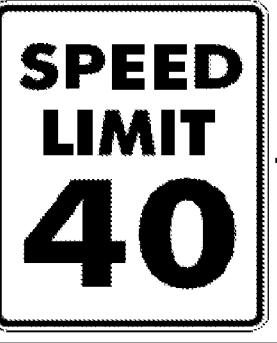


DIRECTION	MILEPOINT	LOCATION CODE (SHEET 2)	SIGN CODE	WIDTH (IN)	HEIGHT (IN)	SHEETING REMARKS	SIGN LEGEND	NEW SIGNS		EXISTING SIGNS				EXIST POST		NUMBER OF NEW POSTS	SQUARE STEEL (IN)			TUBULAR STEEL Ø (IN)				SIGN FRAME REQUIRED	REMARKS	SIGN DETAIL											
								"A"	"B"	RETAIN	SALVAGE FROM	SALVAGE TO	REMOVE	RETAIN	REMOVE		(LB / FT)			(LB / FT)						DETAIL IN SHS	DETAIL ON SHEET NUMBER	DETAIL ON STD SHEET NUMBER									
																	1.75	2.00	2.50	3.00	3.50	4.00	5.00														
<b>WATERBURY VT 100</b>							FY-FLUORESCENT YELLOW FYG-FLUORESCENT YELLOW GREEN															"SHS"-STANDARD HIGHWAY SIGNS															
		G	VR-017	24	30			5.00							1		X								E-141												
SB	4.180	H	R1-1	24	24																			GREGG HILL RD TH-11													
		H	R1-1	30	30			6.25							1		X							X													
SB	3.945	F	W3-5	36	36		SPEED REDUCTION SPEED LIMIT 35			1							X																				
SB	3.905	F	VD-018	30	18		WATERBURY CENTER WATERBURY 2			1							X																				
SB	3.883	F	VW-054R	30	30		HIDDEN DRIVE RIGHT										1		X																		
SB	3.856	F	R2-1	24	30																																
		F	R2-1	30	36			7.50							1		X								6												
SB	3.811	F	VW-205	36	36		WATCH FOR TURNING VEHICLES			1							X																				
SB	3.708	F	W1-10R	30	30		MODIFIED RIGHT CURVE			1							X																				
		F	W16-8A	24	8		HOLLOW RD			1																											
SB	3.684	F	S3-1	30	30		SCHOOL BUS STOP AHEAD			1							X																				
SB	3.676	G	VR-017	24	24																																
		G	VR-017	24	30			5.00							1		X								E-141												
SB	3.670	H	R1-1	24	24												1		X						SUNSET DR TH-39												
<b>SIGN SUMMARY SHEET</b>							SHEET TOTALS	23.75	0.00	6	0	0	5	0	0	4		60																			
								SF	SF	EA	EA	EA	EA	EA	EA	EA		FT																			
VERMONT AGENCY OF TRANSPORTATION							TOWN TOTALS	622.8	0.0	89.0	5.0	5.0	115	2.0	0.0	105		1575.0																			
																					PROJECT NAME:	<b>Moretown-Newport Town VT100</b>										PROJECT NUMBER:	<b>STPG SIGN(28)</b>				
																					FILE NAME:	<b>Waterburv.xls</b>										PLOT DATE:	<b>9/17/2009</b>				
																					PROJECT MANAGER:	<b>N. Avery</b>										DRAWN BY:	<b>I. Shea</b>				
																					DESIGNED BY:	<b>D. Crosslev</b>										CHECKED BY:	<b>N. Avery</b>				
																					WATERBURY SHEET 14										SHEET <b>46</b> OF <b>166</b>						


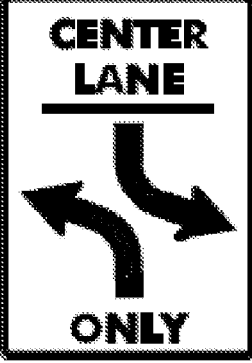





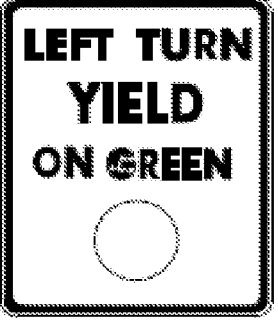
DIRECTION	MILEPOINT	LOCATION CODE (SHEET 2)	SIGN CODE	WIDTH (IN)	HEIGHT (IN)	SHEETING REMARKS	SIGN LEGEND	NEW SIGNS		EXISTING SIGNS				EXIST POST		NUMBER OF NEW POSTS	SQUARE STEEL (IN)			TUBULAR STEEL Ø (IN)				SIGN FRAME REQUIRED	REMARKS	SIGN DETAIL			
								"A"	"B"	RETAIN	SALVAGE FROM	SALVAGE TO	REMOVE	RETAIN	REMOVE		1.75	2.00	2.50	FOUNDATION	3.00	3.50	4.00			5.00	DETAIL IN SHS	DETAIL ON SHEET NUMBER	DETAIL ON STD SHEET NUMBER
																	(LB / FT)				(LB / FT)								
<b>WATERBURY VT 100</b>							FY-FLUORESCENT YELLOW FYG-FLUORESCENT YELLOW GREEN																"SHS"-STANDARD HIGHWAY SIGNS						
		H	R1-1	30	30			6.25							1		X								X				
SB	3.540	F	R2-1	24	30		SPEED LIMIT 35			1				X															
SB	3.475	G	VR-017	24	24		LEGAL LOAD LIMIT 24,000 LBS						1		X														
		H	R1-1	24	24		STOP						1		X														
		G	VR-017	24	30			<del>5.00</del>							1		X									E-141			
SB	3.468	H	R1-1	24	24								1		X														
		H	R1-1	30	30			6.25							1		X							X					
SB	3.456	F	W1-10 L	36	36		MODIFIED CROSSROAD			1				X															
		F	W16-8A	48	15		<--- RESERVOIR RD HOWARD AVE ==>			1																			
																													
SB	3.436	F	R2-1	24	30			5.00					I		X		X												
SB	3.414	F	VD-062B	72	16		BUSINESS SIGN			1				X															
		F	VD-062AL	72	16		BUSINESS SIGN			1																			
		F	VD-062B	72	16		BUSINESS SIGN			1																			
SB	3.335	G	VR-017	24	24									1		X													
		G	VR-017	24	30			5.00							1		X									E-141			
<b>SIGN SUMMARY SHEET</b>							SHEET TOTALS	27.50	0.00	6	0	0	4	0	0	5	75												
								SF	SF	EA	EA	EA	EA	EA	EA	EA	EA	EA	EA	EA	EA	EA	EA	EA	EA	EA	EA	EA	EA
VERMONT AGENCY OF TRANSPORTATION							TOWN TOTALS	622.8	0.0	89.0	5.0	5.0	115	2.0	0.0	105	1575.0												
							PROJECT NAME:	Moretown-Newport Town VT100																					
							PROJECT NUMBER:	STPG SIGN(28)																					
							FILE NAME:	Waterburv.xls											PLOT DATE:	9/17/2009									
							PROJECT MANAGER:	N. Avery											DRAWN BY:	I. Shea									
							DESIGNED BY:	D. Crosslev											CHECKED BY:	N. Avery									
							WATERBURY SHEET 15	SHEET 47 OF 166																					

DIRECTION	MILEPOINT	LOCATION CODE (SHEET 2)	SIGN CODE	WIDTH (IN)	HEIGHT (IN)	SHEETING REMARKS	SIGN LEGEND	NEW SIGNS		EXISTING SIGNS				EXIST POST		NUMBER OF NEW POSTS	SQUARE STEEL (IN)			TUBULAR STEEL Ø (IN)				SIGN FRAME REQUIRED	REMARKS	SIGN DETAIL			
								"A"	"B"	RETAIN	SALVAGE FROM	SALVAGE TO	REMOVE	RETAIN	REMOVE		1.75	2.00	2.50	FOUNDATION	3.00	3.50	4.00			5.00	DETAIL IN SHS	DETAIL ON SHEET NUMBER	DETAIL ON STD SHEET NUMBER
																	(LB / FT)				(LB / FT)								
<b>WATERBURY VT 100</b>							FY-FLUORESCENT YELLOW FYG-FLUORESCENT YELLOW GREEN															"SHS"-STANDARD HIGHWAY SIGNS							
SB	3.344	H	R1-1	24	24																								
		H	R1-1	30	30			6.25																X					
SB	3.266	F	M4-5I	24	12		TO			1																			
		F	M1-1	24	24		INTERSTATE 89			1																			
		F	M6-3I	21	15		UP ARROW			1																			
SB	3.199	F	S3-1	30	30		SCHOOL BUS STOP AHEAD			1																			
SB	3.161	F	R2-1	24	30		SPEED LIMIT 40			1																			
SB	3.118	F	VW-054L	30	30		HIDDEN DRIVE LEFT																						
SB	3.098	F	VW-054L	30	30			6.25																	E-154				
SB	2.915	F	VD-062B	72	16		BUSINESS SIGN			1																			
		F	VD-062B	72	16		BUSINESS SIGN			1																			
SB	2.876	F	R4-1	24	30		DO NOT PASS			1																			
SB	2.581	F	R2-1	24	30		SPEED LIMIT 50				1	1																	
		E	W14-3	48	36		NO PASSING ZONE				1	1																	
SB	2.326	F	VW-054R	30	30		HIDDEN DRIVE RIGHT																						
<b>SIGN SUMMARY SHEET</b>							SHEET TOTALS	12.50	0.00	8	2	2	3	0	0	4	60								PROJECT NAME: <b>Moretown-Newport Town VT100</b>				
								SF	SF	EA	EA	EA	EA	EA	EA	EA	EA	EA	EA	EA	EA	FT						PROJECT NUMBER: <b>STPG SIGN(28)</b>	
VERMONT AGENCY OF TRANSPORTATION							TOWN TOTALS	622.8	0.0	89.0	5.0	5.0	115	2.0	0.0	105	1575.0						FILE NAME: <b>Waterburv.xls</b>	PLOT DATE: <b>9/17/2009</b>					
																						PROJECT MANAGER: <b>N. Avery</b>	DRAWN BY: <b>I. Shea</b>						
																						DESIGNED BY: <b>D. Crosslev</b>	CHECKED BY: <b>N. Avery</b>						
																						WATERBURY SHEET 16	SHEET <b>48</b> OF <b>166</b>						

DIRECTION	MILEPOINT	LOCATION CODE (SHEET 2)	SIGN CODE	WIDTH (IN)	HEIGHT (IN)	SHEETING REMARKS	SIGN LEGEND	NEW SIGNS		EXISTING SIGNS				EXIST POST		NUMBER OF NEW POSTS	SQUARE STEEL (IN)			TUBULAR STEEL Ø (IN)				SIGN FRAME REQUIRED	REMARKS	SIGN DETAIL										
								"A"	"B"	RETAIN	SALVAGE FROM	SALVAGE TO	REMOVE	RETAIN	REMOVE		1.75	2.00	2.50	FOUNDATION	3.00	3.50	4.00			5.00	DETAIL IN SHS	DETAIL ON SHEET NUMBER	DETAIL ON STD SHEET NUMBER							
																	(LB / FT)				(LB / FT)															
																	1.88	2.42	3.35		7.60	9.00	10.80			14.60										
<b>WATERBURY VT 100</b>							FY-FLUORESCENT YELLOW FYG-FLUORESCENT YELLOW GREEN															"SHS"-STANDARD HIGHWAY SIGNS														
SB	2.223	F	VW-205	36	36		WATCH FOR TURNING VEHICLES	9.00							X	2																				
		F	W13-1	18	18		40 MPH PLAQUE																													
SB	2.143	F	VW-205	36	36			9.00								X	2												INSTALL 400' +/- SOUTH OF ORIGINAL SIGN LOCATION			E-154				
		F	W13-1	24	24				4.00																X											
SB	1.949	F	W3-5	36	36		SPEED REDUCTION SPEED LIMIT 40	9.00								X	2													X						
SB	1.906	F	VD-062AS	72	16		BUSINESS SIGN			1				X																						
		F	VD-062AS	72	16		BUSINESS SIGN			1																										
		F	VD-062B	72	16		BUSINESS SIGN			1																										
SB	1.812	F	VD-062B	72	16		BUSINESS SIGN			1				X																						
		F	VD-062AS	72	16		BUSINESS SIGN			1																										
SB	1.775	F	R2-1	24	30																															
		F	R2-1	30	36				7.50								1			X																
SB	1.736	F	VD-062C	74.75	16		BUSINESS SIGN			1				X																						
		F	VD-062BC	74.75	16		BUSINESS SIGN			1																										
SB	1.612	F	R2-1	24	30											1			X																	
<b>SIGN SUMMARY SHEET</b>							SHEET TOTALS											29.50	0.00	7	0	0	4	0	0	5	75									
							SF	SF	EA	EA	EA	EA	EA	EA	EA	EA	EA																			
VERMONT AGENCY OF TRANSPORTATION							TOWN TOTALS											622.8	0.0	89.0	5.0	5.0	115	2.0	0.0	105	1575.0									
																		PROJECT NAME: <b>Moretown-Newport Town VT100</b>				PROJECT NUMBER: <b>STPG SIGN(28)</b>														
																		FILE NAME: <b>Waterburv.xls</b>				PLOT DATE: <b>9/17/2009</b>														
																		PROJECT MANAGER: <b>N. Avery</b>				DRAWN BY: <b>I. Shea</b>														
																		DESIGNED BY: <b>D. Crosslev</b>				CHECKED BY: <b>N. Avery</b>														
																		WATERBURY SHEET 17				SHEET <b>49</b> OF <b>166</b>														

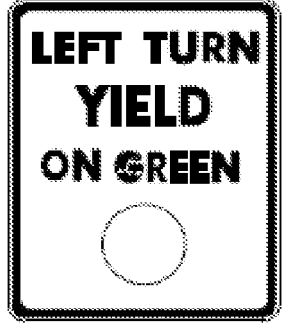
DIRECTION	MILEPOINT	LOCATION CODE (SHEET 2)	SIGN CODE	WIDTH (IN)	HEIGHT (IN)	SHEETING REMARKS	SIGN LEGEND	NEW SIGNS		EXISTING SIGNS				EXIST POST		NUMBER OF NEW POSTS	SQUARE STEEL (IN)			TUBULAR STEEL Ø (IN)				SIGN FRAME REQUIRED	REMARKS	SIGN DETAIL			
								"A"	"B"	RETAIN	SALVAGE FROM	SALVAGE TO	REMOVE	RETAIN	REMOVE		1.75	2.00	2.50	FOUNDATION	3.00	3.50	4.00			5.00	DETAIL IN SHS	DETAIL ON SHEET NUMBER	DETAIL ON STD SHEET NUMBER
																	(LB / FT)				(LB / FT)								
<b>WATERBURY VT 100</b>							FY-FLUORESCENT YELLOW FYG-FLUORESCENT YELLOW GREEN															"SHS"-STANDARD HIGHWAY SIGNS							
			F R2-1	24	30			5.00							1		X							X					
SB	1.526		F VW-054R	30	30																								
			F VW-054R	30	30			6.25							1		X								E-154				
SB	1.425		F R2-1	24	30																								
			F R2-1	24	30			5.00							1		X						X						
SB	1.374		F VD-062AS	72	16		BUSINESS SIGN			1							X												
			F VD-062B	72	16		BUSINESS SIGN			1																			
SB	1.269		F VW-205	36	36																								
			F S3-1	30	30																								
			F VW-205	36	36			9.00							2			X							INSTALL SIGNS ON SAME SIGN POSTS	E-154			
			F S3-1	36	36			9.00															X						
SB	1.248		F R2-1	24	30																								
			F R2-1	30	36			7.50							1		X							6	INSTALL ACROSS FROM NORTHBOUND SPEED LIMIT 40				
SB	1.143		G VR-017	24	30		LEGAL LOAD LIMIT 24,000 LBS			1							X								CROSSROAD TH-15				
SB	1.135		H R1-1	24	24												X								CROSSROAD TH-15				
<b>SIGN SUMMARY SHEET</b>							SHEET TOTALS	41.75	0.00	3	0	0	6	0	0	6		90											
								SF	SF	EA	EA	EA	EA	EA	EA	EA	EA	EA	EA	EA	EA	FT							
VERMONT AGENCY OF TRANSPORTATION							TOWN TOTALS	622.8	0.0	89.0	5.0	5.0	115	2.0	0.0	105		1575.0											
							PROJECT NAME: <b>Moretown-Newport Town VT100</b>															PROJECT NUMBER: <b>STPG SIGN(28)</b>							
							FILE NAME: <b>Waterburv.xls</b>															PLOT DATE: <b>9/17/2009</b>							
							PROJECT MANAGER: <b>N. Avery</b>															DRAWN BY: <b>I. Shea</b>							
							DESIGNED BY: <b>D. Crosslev</b>															CHECKED BY: <b>N. Avery</b>							
							WATERBURY SHEET 18															SHEET <b>50</b> OF <b>166</b>							

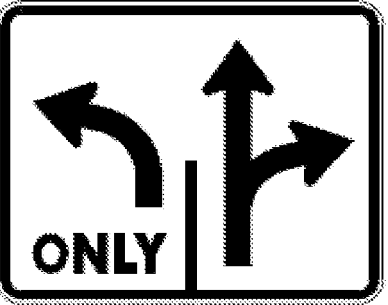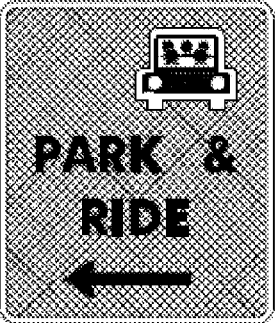

DIRECTION	MILEPOINT	LOCATION CODE (SHEET 2)	SIGN CODE	WIDTH (IN)	HEIGHT (IN)	SHEETING REMARKS	SIGN LEGEND	NEW SIGNS		EXISTING SIGNS				EXIST POST		NUMBER OF NEW POSTS	SQUARE STEEL (IN)			TUBULAR STEEL Ø (IN)				SIGN FRAME REQUIRED	REMARKS	SIGN DETAIL		
								"A"	"B"	RETAIN	SALVAGE FROM	SALVAGE TO	REMOVE	RETAIN	REMOVE		(LB / FT)			(LB / FT)						DETAIL IN SHS	DETAIL ON SHEET NUMBER	DETAIL ON STD SHEET NUMBER
																	1.75	2.00	2.50	3.00	3.50	4.00	5.00					
<b>WATERBURY VT 100</b>							FY-FLUORESCENT YELLOW FYG-FLUORESCENT YELLOW GREEN																"SHS"-STANDARD HIGHWAY SIGNS					
		H	R1-1	30	30			6.25							1		X								X			
SB	1.113	F	R2-1	24	30								1			X												
		F	R2-1	24	30			5.00							1		X								X			
SB	0.980	F	VD-062B	72	16		BUSINESS SIGN			1				X														
		F	VD-062B	72	16		BUSINESS SIGN			1																		
		F	VD-062AS	72	16		BUSINESS SIGN			1																		
SB	0.943	F	W3-3	36	36		SIGNAL AHEAD			1				X														
SB	0.914	F	R2-1	24	30								1			X												
		F	R2-1	24	30			5.00							1		X								X			
SB	0.887	F	VR-921L	30	30																							
		F	VR-921L	30	30			6.25							1		X									E-145A		
SB	0.847	N	R10-12	24	30																							
		N	R10-12	24	30			5.00																	X	INSTALL ON SIGNAL LIGHT CANTILEVER		
SB	0.824	F	VR-644	24	12																							
		F	R3-9B	24	36																							
<b>SIGN SUMMARY SHEET</b>							SHEET TOTALS	27.50	0.00	4	0	0	6	0	0	4		60										
								SF	SF	EA	EA	EA	EA	EA	EA	EA	EA	EA	EA	EA	EA	FT						
VERMONT AGENCY OF TRANSPORTATION							TOWN TOTALS	622.8	0.0	89.0	5.0	5.0	115	2.0	0.0	105		1575.0										
							PROJECT NAME:	<b>Moretown-Newport Town VT100</b>																				
							PROJECT NUMBER:	<b>STPG SIGN(28)</b>																				
							FILE NAME:	<b>Waterburv.xls</b>										PLOT DATE:	<b>9/17/2009</b>									
							PROJECT MANAGER:	<b>N. Avery</b>										DRAWN BY:	<b>I. Shea</b>									
							DESIGNED BY:	<b>D. Crosslev</b>										CHECKED BY:	<b>N. Avery</b>									
							WATERBURY SHEET 19	SHEET <b>51</b> OF <b>166</b>																				




DIRECTION	MILEPOINT	LOCATION CODE (SHEET 2)	SIGN CODE	WIDTH (IN)	HEIGHT (IN)	SHEETING REMARKS	SIGN LEGEND	NEW SIGNS		EXISTING SIGNS				EXIST POST		NUMBER OF NEW POSTS	SQUARE STEEL (IN)			TUBULAR STEEL Ø (IN)				SIGN FRAME REQUIRED	REMARKS	SIGN DETAIL		
								"A"	"B"	RETAIN	SALVAGE FROM	SALVAGE TO	REMOVE	RETAIN	REMOVE		(LB / FT)			(LB / FT)						DETAIL IN SHS	DETAIL ON SHEET NUMBER	DETAIL ON STD SHEET NUMBER
																	1.75	2.00	2.50	3.00	3.50	4.00	5.00					
<b>WATERBURY VT 100</b>							FY-FLUORESCENT YELLOW FYG-FLUORESCENT YELLOW GREEN																"SHS"-STANDARD HIGHWAY SIGNS					
		F	VR-644	24	12			2.00							1		X							BLACK ON WHITE SHEETING		6		
		F	R3-9B	24	36			6.00																	X			
SB	0.744	F	M4-6	24	12																							
		F	R3-9B	24	36																							
		F	M4-6	24	12			2.00							1		X								BLACK ON WHITE SHEETING		X	
		F	R3-9B	24	36			6.00																	X			
SB	0.740																											
SB	0.729	F	VR-922MR	36	30																							
		F	D4-2	30	36																							
		F	VR-922R	36	30			7.50							2		X										E-145A	
		F	D4-2	24	30			5.00																	X			
SB	0.710	G	VR-017	24	30																							
		G	VR-017	24	30			5.00							1		X										E-141	
SB	0.696	N	R10-12	30	30																							
		N	R10-12	30	30			6.25																	X			
SIGNS FROM MP 0.697 TO SB MP 0.130 PART OF INTERSTATE SIGN PROJECT																												
<b>SIGN SUMMARY SHEET</b>							SHEET TOTALS				39.75	0.00	0	0	0	6	0	0	5	75					PROJECT NAME: <b>Moretown-Newport Town VT100</b>			
							SF	SF	EA	EA	EA	EA	EA	EA	EA	EA	EA	EA	EA	EA	EA	EA	FT				PROJECT NUMBER: <b>STPG SIGN(28)</b>	
VERMONT AGENCY OF TRANSPORTATION							TOWN TOTALS				622.8	0.0	89.0	5.0	5.0	115	2.0	0.0	105	1575.0					FILE NAME: <b>Waterburv.xls</b> PLOT DATE: <b>9/17/2009</b>			
																									PROJECT MANAGER: <b>N. Avery</b> DRAWN BY: <b>I. Shea</b>			
																									DESIGNED BY: <b>D. Crosslev</b> CHECKED BY: <b>N. Avery</b>			
																									WATERBURY SHEET 20 SHEET <b>52</b> OF <b>166</b>			

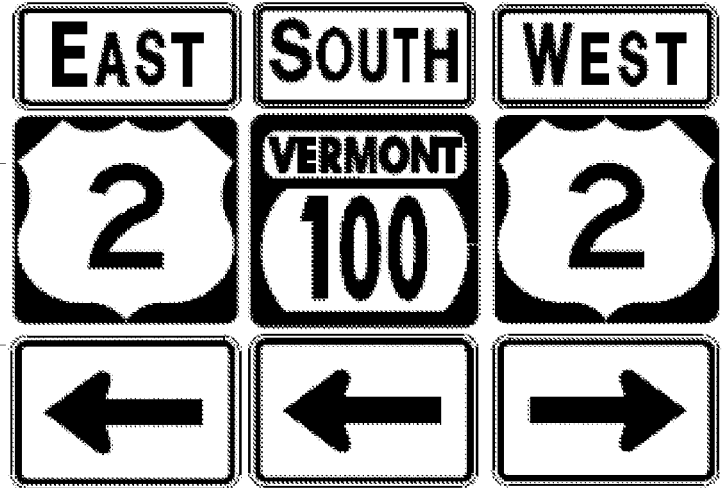


DIRECTION	MILEPOINT	LOCATION CODE (SHEET 2)	SIGN CODE	WIDTH (IN)	HEIGHT (IN)	SHEETING REMARKS	SIGN LEGEND	NEW SIGNS		EXISTING SIGNS				EXIST POST		NUMBER OF NEW POSTS	SQUARE STEEL (IN)			TUBULAR STEEL Ø (IN)				SIGN FRAME REQUIRED	REMARKS	SIGN DETAIL			
								"A"	"B"	RETAIN	SALVAGE FROM	SALVAGE TO	REMOVE	RETAIN	REMOVE		1.75	2.00	2.50	FOUNDATION	3.00	3.50	4.00			5.00	DETAIL IN SHS	DETAIL ON SHEET NUMBER	DETAIL ON STD SHEET NUMBER
																	(LB / FT)				(LB / FT)								
<b>WATERBURY VT 100</b>							FY-FLUORESCENT YELLOW FYG-FLUORESCENT YELLOW GREEN															"SHS"-STANDARD HIGHWAY SIGNS							
SB	0.134	F	W12-2	30	30																								
		F	W16-5	24	12																								
		F	W12-2	30	30																				X				
		F	W16-5	24	12																				X				
SB	0.111	F	VD-062BC	72	16		BUSINESS SIGN			1																			
		F	VD-062C	72	16		BUSINESS SIGN			1																			
SB	0.069	F	VR-925	36	30																								
		F	VR-925	36	30																					E-145A			
SB	0.062	F	M3-2	24	12																								
		F	M1-4	24	24																								
		F	M6-1S	21	15																								
		F	M3-3S	24	12																								
		F	M1-5	30	24																								
		F	M6-1	21	15																								
		F	M3-4	24	12																								
<b>SIGN SUMMARY SHEET</b>							SHEET TOTALS	15.75	0.00	2	0	0	10	0	0	3	45					PROJECT NAME: <b>Moretown-Newport Town VT100</b>							
								SF	SF	EA	EA	EA	EA	EA	EA	EA	FT					PROJECT NUMBER: <b>STPG SIGN(28)</b>							
VERMONT AGENCY OF TRANSPORTATION							TOWN TOTALS	622.8	0.0	89.0	5.0	5.0	115	2.0	0.0	105	1575.0					FILE NAME: <b>Waterburv.xls</b>							
																						PLOT DATE: <b>9/17/2009</b>							
																					PROJECT MANAGER: <b>N. Avery</b>								
																						DESIGNED BY: <b>D. Crosslev</b>							
																						CHECKED BY: <b>N. Avery</b>							
																						WATERBURY SHEET 21							
																						SHEET <b>53</b> OF <b>166</b>							





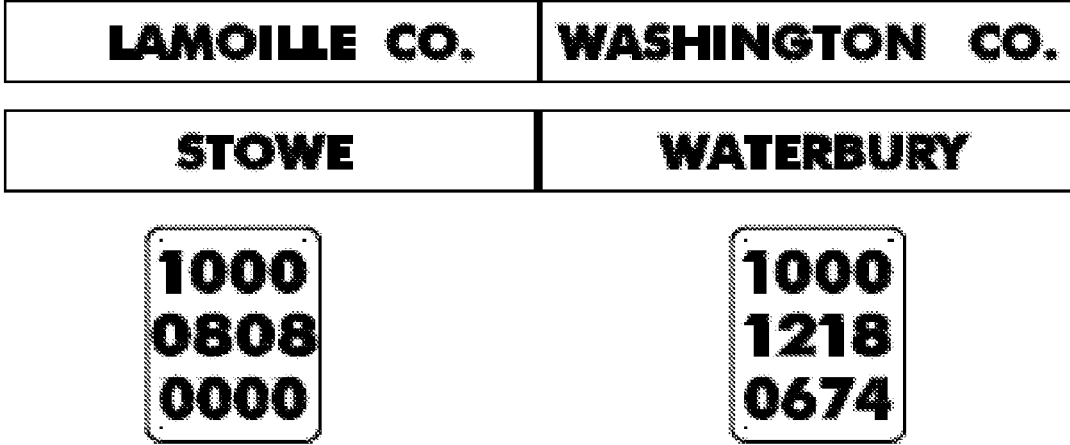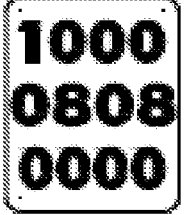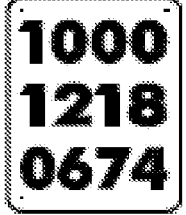




DIRECTION	MILEPOINT	LOCATION CODE (SHEET 2)	SIGN CODE	WIDTH (IN)	HEIGHT (IN)	SHEETING REMARKS	SIGN LEGEND	NEW SIGNS		EXISTING SIGNS				EXIST POST		NUMBER OF NEW POSTS	SQUARE STEEL (IN)			TUBULAR STEEL Ø (IN)				SIGN FRAME REQUIRED	REMARKS	SIGN DETAIL		
								"A"	"B"	RETAIN	SALVAGE FROM	SALVAGE TO	REMOVE	RETAIN	REMOVE		(LB / FT)			(LB / FT)						DETAIL IN SHS	DETAIL ON SHEET NUMBER	DETAIL ON STD SHEET NUMBER
																	1.75	2.00	2.50	3.00	3.50	4.00	5.00					
<b>WATERBURY VT 100</b>							FY-FLUORESCENT YELLOW FYG-FLUORESCENT YELLOW GREEN															"SHS"-STANDARD HIGHWAY SIGNS						
			F M1-4	24	24																							
			F M6-1	21	15																							
			F M3-2	24	12			2.00							2			X				3B		X				
			F M1-4	24	24			4.00															X					
			F M6-1L	21	15			2.19															X					
			F M3-3	24	12			2.00															X					
			F M1-5	30	24			5.00																	E-136B			
			F M6-1L	21	15			2.19															X					
			F M3-4	24	12			2.00															X					
			F M1-4	24	24			4.00															X					
			F M6-1R	21	15			2.19															X					
	SB 0.035		F VR-040	24	24		THROUGH WAY ENDS HERE																					
			F N/A				TOWN PARKING ORDNANCE																		RETURN SIGN TO TOWN			
	SB 0.006		F R1-1	30	30																							
			E R5-1	30	30																							
<b>SIGN SUMMARY SHEET</b>							SHEET TOTALS		25.57	0.00	0	0	0	6	0	0	2	30						PROJECT NAME: <b>Moretown-Newport Town VT100</b>				
							SF	SF	EA	EA	EA	EA	EA	EA	EA	EA	EA	EA	EA	EA	EA	FT					PROJECT NUMBER: <b>STPG SIGN(28)</b>	
VERMONT AGENCY OF TRANSPORTATION							TOWN TOTALS		622.8	0.0	89.0	5.0	5.0	115	2.0	0.0	105	1575.0					FILE NAME: <b>Waterburv.xls</b> PLOT DATE: <b>9/17/2009</b>					
																						PROJECT MANAGER: <b>N. Avery</b> DRAWN BY: <b>I. Shea</b>						
																						DESIGNED BY: <b>D. Crosslev</b> CHECKED BY: <b>N. Avery</b>						
																						WATERBURY SHEET 22 SHEET <b>54</b> OF <b>166</b>						





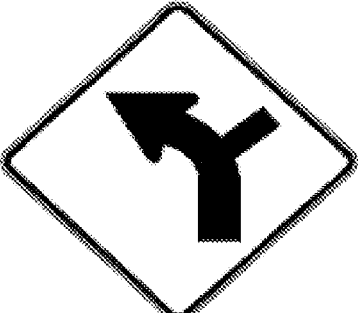






DIRECTION	MILEPOINT	LOCATION CODE (SHEET 2)	SIGN CODE	WIDTH (IN)	HEIGHT (IN)	SHEETING REMARKS	SIGN LEGEND	NEW SIGNS		EXISTING SIGNS			EXIST POST		NUMBER OF NEW POSTS	SQUARE STEEL (IN)			TUBULAR STEEL Ø (IN)				SIGN FRAME REQUIRED	REMARKS	SIGN DETAIL				
								"A"	"B"	RETAIN	SALVAGE FROM	SALVAGE TO	REMOVE	RETAIN		REMOVE	1.75	2.00	2.50	FOUNDATION	3.00	3.50			4.00	5.00	DETAIL IN SHS	DETAIL ON SHEET NUMBER	DETAIL ON STD SHEET NUMBER
																	(LB / FT)				(LB / FT)								
																	1.88	2.42	3.35		7.60	9.00			10.80	14.60			
<b>WATERBURY VT 100</b>							FY-FLUORESCENT YELLOW FYG-FLUORESCENT YELLOW GREEN														"SHS"-STANDARD HIGHWAY SIGNS								
		F	R1-1	30	30		 	6.25						1		X						INSTALL SIGNS BACK TO BACK	X						
		E	R5-1	30	30				6.25														X						
<b>SIGN SUMMARY SHEET</b>							SHEET TOTALS	12.50	0.00	0	0	0	0	0	0	1	15						PROJECT NAME: <b>Moretown-Newport Town VT100</b>						
								SF	SF	EA	EA	EA	EA	EA	EA	EA	EA	EA	EA	FT						PROJECT NUMBER: <b>STPG SIGN(28)</b>			
																										FILE NAME: <b>Waterburv.xls</b>	PLOT DATE: <b>9/17/2009</b>		
VERMONT AGENCY OF TRANSPORTATION							TOWN TOTALS	622.8	0.0	89.0	5.0	5.0	115	2.0	0.0	105	1575.0					PROJECT MANAGER: <b>N. Avery</b>	DRAWN BY: <b>I. Shea</b>						
																				DESIGNED BY: <b>D. Crosslev</b>	CHECKED BY: <b>N. Avery</b>								
																				WATERBURY SHEET 23	SHEET <b>55</b> OF <b>166</b>								








DIRECTION	MILEPOINT	LOCATION CODE (SHEET 2)	SIGN CODE	WIDTH (IN)	HEIGHT (IN)	SHEETING REMARKS	SIGN LEGEND	NEW SIGNS		EXISTING SIGNS				EXIST POST		NUMBER OF NEW POSTS	SQUARE STEEL (IN)			TUBULAR STEEL Ø (IN)				SIGN FRAME REQUIRED	REMARKS	SIGN DETAIL			
								"A"	"B"	RETAIN	SALVAGE FROM	SALVAGE TO	REMOVE	RETAIN	REMOVE		1.75	2.00	2.50	FOUNDATION	3.00	3.50	4.00			5.00	DETAIL IN SHS	DETAIL ON SHEET NUMBER	DETAIL ON STD SHEET NUMBER
																	(LB / FT)				(LB / FT)								
																	1.88	2.42	3.35		7.60	9.00	10.80			14.60			
<b>STOWE VT 100</b>							FY-FLUORESCENT YELLOW FYG-FLUORESCENT YELLOW GREEN															"SHS"-STANDARD HIGHWAY SIGNS							
NB	0.000	C	VD-024	60	7.5																								
		C	VD-025	60	7.5																								
		C	VD-025	72	12			6.00																			4		
		C	VD-024	72	12			6.00																			4		
		C	VD-700	6	10			0.42																				E-138	
		C	VD-700	6	10			0.42																				E-138	
NB	0.220	A	VD-062B	72	16		BUSINESS SIGN			1																			
		A	VD-062AL	72	16		BUSINESS SIGN			1																			
		A	VD-062AL	72	16		BUSINESS SIGN			1																			
NB	0.420	A	VD-062B	72	16		BUSINESS SIGN			1																			
		A	VD-062AL	72	16		BUSINESS SIGN			1																			
		A	VD-062AL	72	16		BUSINESS SIGN			1																			
NB	0.510	A	VD-062B	72	16		BUSINESS SIGN			1																			
		A	VD-062AL	72	16		BUSINESS SIGN			1																			
NB	0.720	A	VD-062B	72	16		BUSINESS SIGN			1																			
<b>SIGN SUMMARY SHEET</b>							<b>SHEET TOTALS</b>	12.84	0.00	9	0	0	2	0	0	2	30							PROJECT NAME: <b>Moretown-Newport Town VT100</b>					
								SF	SF	EA	EA	EA	EA	EA	EA	EA	FT							PROJECT NUMBER: <b>STPG SIGN(28)</b>					
VERMONT AGENCY OF TRANSPORTATION							<b>TOWN TOTALS</b>	582.8	0.0	65.0	6.0	6.0	105	0.0	0.0	103	1545.0							FILE NAME: <b>Stowe.xls</b> PLOT DATE: <b>9/29/2009</b>					
																								PROJECT MANAGER: <b>N. Avery</b> DRAWN BY: <b>I. Shea</b>					
																								DESIGNED BY: <b>D. Crosslev</b> CHECKED BY: <b>N. Avery</b>					
																								STOWE SHEET 1 SHEET <b>56</b> OF <b>166</b>					

DIRECTION	MILEPOINT	LOCATION CODE (SHEET 2)	SIGN CODE	WIDTH (IN)	HEIGHT (IN)	SHEETING REMARKS	SIGN LEGEND	NEW SIGNS		EXISTING SIGNS				EXIST POST		NUMBER OF NEW POSTS	SQUARE STEEL (IN)			TUBULAR STEEL Ø (IN)				SIGN FRAME REQUIRED	REMARKS	SIGN DETAIL			
								"A"	"B"	RETAIN	SALVAGE FROM	SALVAGE TO	REMOVE	RETAIN	REMOVE		1.75	2.00	2.50	FOUNDATION	3.00	3.50	4.00			5.00	DETAIL IN SHS	DETAIL ON SHEET NUMBER	DETAIL ON STD SHEET NUMBER
																	(LB / FT)				(LB / FT)								
<b>STOWE VT 100</b>							FY-FLUORESCENT YELLOW FYG-FLUORESCENT YELLOW GREEN															"SHS"-STANDARD HIGHWAY SIGNS							
		A	VD-062AL	72	16		BUSINESS SIGN			1																			
		A	VD-062AL	72	16		BUSINESS SIGN			1																			
NB	0.822	A	D1-1A	72	10																								
		A	D1-1	72	10																								
		A	VR-474H	30	42		VT 108 THROUGH THE NOTCH - HINGED- CLOSED FOR THE SEASON																						
		A	D1-1A	72	12			6.00																	5				
		A	D1-1	72	12			6.00																		5			
NB	0.885	A	M3-1S	24	12																								
		A	M1-5	30	24																								
		A	M3-1	24	12			2.00																					
		A	M1-5	30	24			5.00																		E-136B			
NB	1.063	A	VD-062C	74.75	16		TRAVEL INFORMATION			1																			
		A	VD-062BC	74.75	16		TRAVEL INFORMATION			1																			
NB	1.133	A	W3-5	36	36		SPEED REDUCTION SPEED LIMIT 40			1																			
NB	1.192	A	R2-1	24	30																								
<b>SIGN SUMMARY SHEET</b>							SHEET TOTALS	19.00	0.00	5	1	1	5	0	0	3	45												
								SF	SF	EA	EA	EA	EA	EA	EA	EA	EA												
VERMONT AGENCY OF TRANSPORTATION							TOWN TOTALS	582.8	0.0	65.0	6.0	6.0	105	0.0	0.0	103	1545.0												
							PROJECT NAME: <b>Moretown-Newport Town VT100</b>																						
							PROJECT NUMBER: <b>STPG SIGN(28)</b>																						
							FILE NAME: <b>Stowe.xls</b> PLOT DATE: <b>9/29/2009</b>																						
							PROJECT MANAGER: <b>N. Avery</b> DRAWN BY: <b>I. Shea</b>																						
							DESIGNED BY: <b>D. Crosslev</b> CHECKED BY: <b>N. Avery</b>																						
							STOWE SHEET 2 SHEET <b>57</b> OF <b>166</b>																						

DIRECTION	MILEPOINT	LOCATION CODE (SHEET 2)	SIGN CODE	WIDTH (IN)	HEIGHT (IN)	SHEETING REMARKS	SIGN LEGEND	NEW SIGNS		EXISTING SIGNS				EXIST POST		NUMBER OF NEW POSTS	SQUARE STEEL (IN)			TUBULAR STEEL Ø (IN)				SIGN FRAME REQUIRED	REMARKS	SIGN DETAIL			
								"A"	"B"	RETAIN	SALVAGE FROM	SALVAGE TO	REMOVE	RETAIN	REMOVE		1.75	2.00	2.50	FOUNDATION	3.00	3.50	4.00			5.00	DETAIL IN SHS	DETAIL ON SHEET NUMBER	DETAIL ON STD SHEET NUMBER
																	(LB / FT)				(LB / FT)								
<b>STOWE VT 100</b>							FY-FLUORESCENT YELLOW FYG-FLUORESCENT YELLOW GREEN															"SHS"-STANDARD HIGHWAY SIGNS							
		A	R2-1	30	36			7.50							1		X									6			
NB	1.243	A	VW-205	30	30		WATCH FOR TURNING VEHICLES 			1							X												
NB	1.264	C	VR-017	24	24																								
		C	VR-017	24	30			5.00							1		X										E-141		
NB	1.270	D	R1-1	24	24																								
		D	R1-1	30	30			6.25							1		X								X				
NB	1.342	A	W11-1	30	30		BICYCLE SYMBOL			1							X												
		A	W16-1	18	24		SHARE THE ROAD			1																			
NB	1.444	A	R2-1	24	30		SPEED LIMIT 40			1							X												
NB	1.470	A	W1-10L	30	30			6.25							1		X												
		A	W16-8A	30	8			1.67																			8		
NB	1.505	A	W1-6	48	24		<=== LEFT LARGE ARROW 			1							X												
NB	1.520	F	OM-3R	12	36			3.00							1		X									X			
NB	1.525	F	OM-3L	12	36																								
		E	OM-3L	12	36			3.00							1		X								X				
<b>SIGN SUMMARY SHEET</b>							SHEET TOTALS	32.67	0.00	5	0	0	3	0	0	6	90												
							SF SF EA EA EA EA EA EA EA EA																						
VERMONT AGENCY OF TRANSPORTATION							TOWN TOTALS	582.8	0.0	65.0	6.0	6.0	105	0.0	0.0	103	1545.0												
							PROJECT NAME:	<b>Moretown-Newport Town VT100</b>																					
							PROJECT NUMBER:	<b>STPG SIGN(28)</b>																					
							FILE NAME:	<b>Stowe.xls</b>											PLOT DATE:	<b>9/29/2009</b>									
							PROJECT MANAGER:	<b>N. Avery</b>											DRAWN BY:	<b>I. Shea</b>									
							DESIGNED BY:	<b>D. Crosslev</b>											CHECKED BY:	<b>N. Avery</b>									
							STOWE SHEET 3																						
							SHEET	<b>58</b>											OF	<b>166</b>									

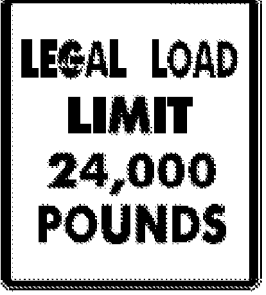DIRECTION	MILEPOINT	LOCATION CODE (SHEET 2)	SIGN CODE	WIDTH (IN)	HEIGHT (IN)	SHEETING REMARKS	SIGN LEGEND	NEW SIGNS		EXISTING SIGNS				EXIST POST		NUMBER OF NEW POSTS	SQUARE STEEL (IN)			TUBULAR STEEL Ø (IN)				SIGN FRAME REQUIRED	REMARKS	SIGN DETAIL															
								"A"	"B"	RETAIN	SALVAGE FROM	SALVAGE TO	REMOVE	RETAIN	REMOVE		1.75	2.00	2.50	FOUNDATION	3.00	3.50	4.00			5.00	DETAIL IN SHS	DETAIL ON SHEET NUMBER	DETAIL ON STD SHEET NUMBER												
																	(LB / FT)				(LB / FT)																				
<b>STOWE VT 100</b>							FY-FLUORESCENT YELLOW FYG-FLUORESCENT YELLOW GREEN															"SHS"-STANDARD HIGHWAY SIGNS																			
NB	1.532	B	W1-6	48	24		RIGHT ==>> LARGE ARROW			1				X																											
NB	1.544	C	VR-017	24	30																																				
		C	VR-017	24	30			5.00								1		X														E-141									
NB	1.552	D	R1-1	24	24																																				
		D	R1-1	30	30			6.25								1		X														X									
NB	1.646	A	W1-2R	30	30		RIGHT CURVE			1				X																											
NB	1.794	A	R2-1	24	30																																				
		A	R2-1	24	30			5.00								1		X															X								
NB	1.933	A	W11-1	30	30		BICYCLE SYMBOL			1				X																											
		A	W16-1	18	24		SHARE THE ROAD			1																															
NB	1.989	A	R2-1	24	30																																				
		A	R2-1	24	30			5.00								1		X															X								
NB	2.067	A	W11-6	30	30																																				
		A	W11-6	30	30			6.25								1		X															X								
NB	2.117	A	W3-5	36	36		SPEED REDUCTION SPEED LIMIT 30			1				X																											
<b>SIGN SUMMARY SHEET</b>							SHEET TOTALS											27.50	0.00	5	0	0	5	0	0	5	75	PROJECT NAME: <b>Moretown-Newport Town VT100</b>													
							SF	SF	EA	EA	EA	EA	EA	EA	EA	EA	EA	EA	EA	EA	EA	EA	EA	EA	EA	EA	EA	EA	EA	EA	EA	EA	EA	EA	EA	EA	EA	EA	EA	EA	PLOT DATE: <b>9/29/2009</b>
							TOWN TOTALS											582.8	0.0	65.0	6.0	6.0	105	0.0	0.0	103	1545.0	PROJECT NUMBER: <b>STPG SIGN(28)</b>													
VERMONT AGENCY OF TRANSPORTATION																		FILE NAME: <b>Stowe.xls</b>											DRAWN BY: <b>I. Shea</b>												
																		DESIGNED BY: <b>D. Crosslev</b>											CHECKED BY: <b>N. Avery</b>												
																		STOWE SHEET 4											SHEET <b>59</b> OF <b>166</b>												



DIRECTION	MILEPOINT	LOCATION CODE (SHEET 2)	SIGN CODE	WIDTH (IN)	HEIGHT (IN)	SHEETING REMARKS	SIGN LEGEND	NEW SIGNS		EXISTING SIGNS				EXIST POST		NUMBER OF NEW POSTS	SQUARE STEEL (IN)			TUBULAR STEEL Ø (IN)				SIGN FRAME REQUIRED	REMARKS	SIGN DETAIL					
								"A"	"B"	RETAIN	SALVAGE FROM	SALVAGE TO	REMOVE	RETAIN	REMOVE		1.75	2.00	2.50	FOUNDATION	3.00	3.50	4.00			5.00	DETAIL IN SHS	DETAIL ON SHEET NUMBER	DETAIL ON STD SHEET NUMBER		
																	(LB / FT)				(LB / FT)										
<b>STOWE VT 100</b>							FY-FLUORESCENT YELLOW FYG-FLUORESCENT YELLOW GREEN															"SHS"-STANDARD HIGHWAY SIGNS									
NB	2.180	A	VD-018	30	18																										
		A	VD-018	30	18			3.75							1		X								E-128A						
NB	2.274	A	R2-1	24	30		SPEED LIMIT 30  																								
		A	R4-1	24	30																										
		A	R2-1	30	36			7.50							1		X								6						
NB	2.350	A	R4-1	24	30																										
		A	R4-1	24	30			5.00							1		X								INSTALL 80' +/- SOUTH THE 4 BUSINESS SIGNS	X					
NB	2.365	A	VD-062B	72	16		BUSINESS SIGN			1						X															
		A	VD-062B	72	16					1																					
		A	VD-062B	72	16					1																					
		A	VD-062B	72	16					1																					
NB	2.373	C	R5-1	30	30		DO NOT ENTER																								
NB	2.382	B	R5-1	30	30		DO NOT ENTER																								
NB	2.431	C	VR-017	24	24																										
		C	VR-017	24	30			5.00							1		X										E-141				
NB	2.439	D	R1-1	24	24																										
<b>SIGN SUMMARY SHEET</b>							SHEET TOTALS	21.25	0.00	4	0	0	7	0	0	4	60								PROJECT NAME: <b>Moretown-Newport Town VT100</b>						
								SF	SF	EA	EA	EA	EA	EA	EA	EA	EA	EA	EA	EA	EA	EA	EA	EA	EA	EA	EA	EA	EA	PROJECT NUMBER: <b>STPG SIGN(28)</b>	
VERMONT AGENCY OF TRANSPORTATION							TOWN TOTALS	582.8	0.0	65.0	6.0	6.0	105	0.0	0.0	103	1545.0								FILE NAME: <b>Stowe.xls</b> PLOT DATE: <b>9/29/2009</b>						
																														PROJECT MANAGER: <b>N. Avery</b> DRAWN BY: <b>I. Shea</b>	
																								DESIGNED BY: <b>D. Crosslev</b> CHECKED BY: <b>N. Avery</b>							
																										STOWE SHEET 5 SHEET <b>60</b> OF <b>166</b>					

DIRECTION	MILEPOINT	LOCATION CODE (SHEET 2)	SIGN CODE	WIDTH (IN)	HEIGHT (IN)	SHEETING REMARKS	SIGN LEGEND	NEW SIGNS		EXISTING SIGNS				EXIST POST		NUMBER OF NEW POSTS	SQUARE STEEL (IN)			TUBULAR STEEL Ø (IN)				SIGN FRAME REQUIRED	REMARKS	SIGN DETAIL			
								"A"	"B"	RETAIN	SALVAGE FROM	SALVAGE TO	REMOVE	RETAIN	REMOVE		1.75	2.00	2.50	FOUNDATION	3.00	3.50	4.00			5.00	DETAIL IN SHS	DETAIL ON SHEET NUMBER	DETAIL ON STD SHEET NUMBER
																	(LB / FT)				(LB / FT)								
<b>STOWE VT 100</b>							FY-FLUORESCENT YELLOW FYG-FLUORESCENT YELLOW GREEN																"SHS"-STANDARD HIGHWAY SIGNS						
		D	R1-1	30	30			6.25									1		X										
NB	2.508	A	R2-1	24	30		SPEED LIMIT 30			1									X										
		A	R4-1	24	30								2 +																
		A	R4-1	24	30			5.00									1		X							X			
NB	2.533	C	VR-017	24	24																								
		C	VR-017	24	30			5.00									1		X								E-141		
NB	2.540	D	R1-1	24	24																								
		D	R1-1	30	30			7.50									1		X							X			
NB	2.668	A	R2-1	24	30		SPEED LIMIT 30				1	1							X										
		A	R4-1	24	30			6.25																			X		
NB	2.726	C	VR-017	24	24																								
		C	VR-017	24	24			5.00									1		X								E-141		
NB	2.733	D	R1-1	24	24																								
		D	R1-1	24	24			6.25									1		X							X			
NB	2.791	C	VR-017	24	24																						CLIFF STREETH-60 (SOUTH)		
<b>SIGN SUMMARY SHEET</b>							SHEET TOTALS	41.25	0.00	1	1	1	6	0	0	7	105									PROJECT NAME: <b>Moretown-Newport Town VT100</b>			
								SF	SF	EA	EA	EA	EA	EA	EA	EA	EA	EA		FT									PROJECT NUMBER: <b>STPG SIGN(28)</b>
VERMONT AGENCY OF TRANSPORTATION							TOWN TOTALS	582.8	0.0	65.0	6.0	6.0	105	0.0	0.0	103	1545.0								FILE NAME: <b>Stowe.xls</b>	PLOT DATE: <b>9/29/2009</b>			
																								PROJECT MANAGER: <b>N. Avery</b>	DRAWN BY: <b>I. Shea</b>				
																									DESIGNED BY: <b>D. Crosslev</b>	CHECKED BY: <b>N. Avery</b>			
																									STOWE SHEET <b>6</b>	SHEET <b>61</b> OF <b>166</b>			


DIRECTION	MILEPOINT	LOCATION CODE (SHEET 2)	SIGN CODE	WIDTH (IN)	HEIGHT (IN)	SHEETING REMARKS	SIGN LEGEND	NEW SIGNS		EXISTING SIGNS				EXIST POST		NUMBER OF NEW POSTS	SQUARE STEEL (IN)			TUBULAR STEEL Ø (IN)				SIGN FRAME REQUIRED	REMARKS	SIGN DETAIL			
								"A"	"B"	RETAIN	SALVAGE FROM	SALVAGE TO	REMOVE	RETAIN	REMOVE		1.75	2.00	2.50	FOUNDATION	3.00	3.50	4.00			5.00	DETAIL IN SHS	DETAIL ON SHEET NUMBER	DETAIL ON STD SHEET NUMBER
																	(LB / FT)				(LB / FT)								
<b>STOWE VT 100</b>							FY-FLUORESCENT YELLOW FYG-FLUORESCENT YELLOW GREEN															"SHS"-STANDARD HIGHWAY SIGNS							
		C	VR-017	24	30			6.25						1				X								E-141			
NB	2.794	A	VR-417	30	30			6.25						1				X								INSTALL 5' NORTH OF STOP SIGN		6	
		B	W14-3	36	24			5.00															X						
NB	2.795	D	R1-1	24	24								1					X								CLIFF STREETH-60 (SOUTH)			
		D	R1-1	30	30			5.00						1				X					X						
NB	2.843	A	S3-1	30	30		SCHOOL BUS STOP AHEAD			1				X															
NB	2.863	A	VD-018	30	18							1						X											
		A	VD-018	30	18			3.75						1				X								E-128B			
NB	2.938	A	R2-1	24	30								1					X											
		B	VR-038	24	18		STATE HIGHWAY ENDS			1	1															INSTALL ABOVE NEW SPEED LIMIT 25 SIGN			
		A	R2-1	30	36			7.50						1				X											
TOWN OF STOWE CLASS 1																													
NB	3.979	A	R2-1	24	30		SPEED LIMIT 40						1					X											
		A	VR-041	24	24		THROUGH WAY BEGINS HERE						1																
		B	VR-038	24	18		STATE HIGHWAY ENDS						1																
<b>SIGN SUMMARY SHEET</b>							<b>SHEET TOTALS</b>			33.75	0.00	1	1	1	6	0	0	5		75					PROJECT NAME: <b>Moretown-Newport Town VT100</b>				
																								PROJECT NUMBER: <b>STPG SIGN(28)</b>					
							SF	SF	EA	EA	EA	EA	EA	EA	EA	EA	EA								FILE NAME: <b>Stowe.xls</b>				
							<b>TOWN TOTALS</b>			582.8	0.0	65.0	6.0	6.0	105	0.0	0.0	103		1545.0					PLOT DATE: <b>9/29/2009</b>				
VERMONT AGENCY OF TRANSPORTATION																									DRAWN BY: <b>I. Shea</b>				
																									CHECKED BY: <b>N. Avery</b>				
																									SHEET <b>62</b> OF <b>166</b>				
																									STOWE SHEET 7				


DIRECTION	MILEPOINT	LOCATION CODE (SHEET 2)	SIGN CODE	WIDTH (IN)	HEIGHT (IN)	SHEETING REMARKS	SIGN LEGEND	NEW SIGNS		EXISTING SIGNS				EXIST POST		NUMBER OF NEW POSTS	SQUARE STEEL (IN)			TUBULAR STEEL Ø (IN)				SIGN FRAME REQUIRED	REMARKS	SIGN DETAIL		
								"A"	"B"	RETAIN	SALVAGE FROM	SALVAGE TO	REMOVE	RETAIN	REMOVE		(LB / FT)			(LB / FT)						DETAIL IN SHS	DETAIL ON SHEET NUMBER	DETAIL ON STD SHEET NUMBER
																	1.75	2.00	2.50	FOUNDATION	3.00	3.50	4.00					


<b>STOWE VT 100</b>							FY-FLUORESCENT YELLOW FYG-FLUORESCENT YELLOW GREEN															"SHS"-STANDARD HIGHWAY SIGNS			
---------------------	--	--	--	--	--	--	---	--	--	--	--	--	--	--	--	--	--	--	--	--	--	------------------------------	--	--	--


		A	VR-039	24	18		 	3.00																				
		A	R2-1	24	30			5.00						1	X									X			7	

NB	4.136	A	W11-7	30	30	SIGN MISSING																					
----	-------	---	-------	----	----	--------------	--	--	--	--	--	--	--	--	--	--	--	--	--	--	--	--	--	--	--	--	--

NB	4.288	C	VR-017	24	30							1															
		C	VR-017	24	30			5.00						1	X												






NB	4.298	D	R1-1	30	30							1															
		D	R1-1	30	30			6.25						1	X									X			

NB	4.302	A	R2-1	24	30							1															
		A	R2-1	24	30			5.00						1	X									X			



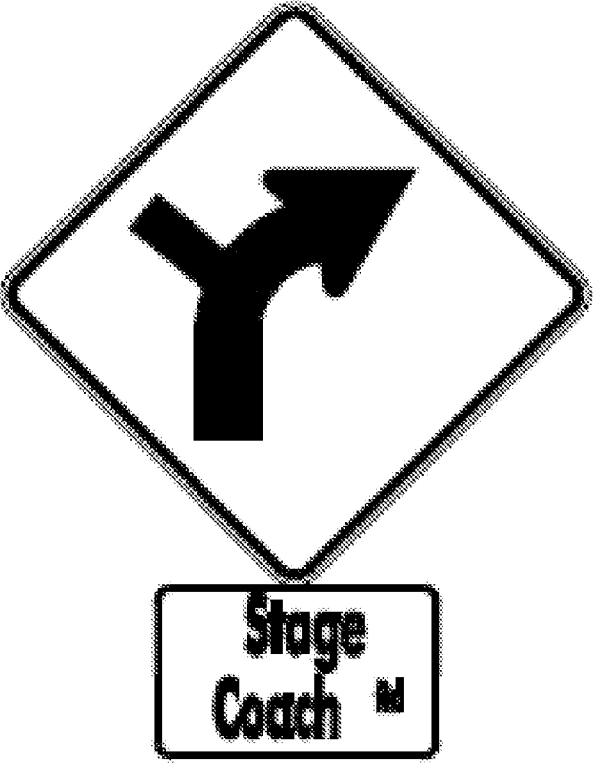


NB	4.605	A	R2-1	24	30							1															
		A	R2-1	24	30			5.00						1	X									X			

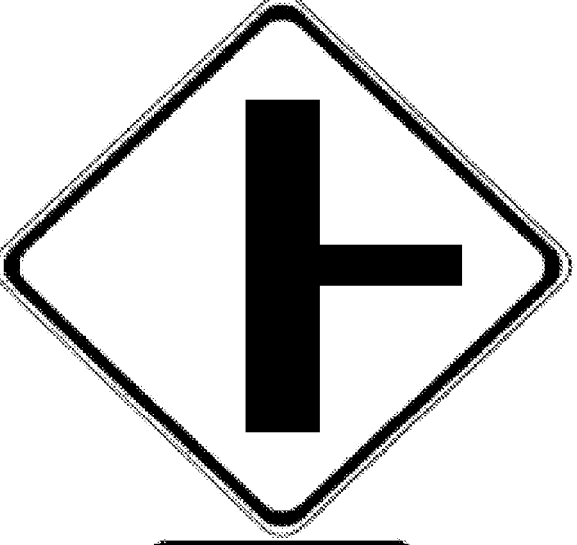



NB	4.838	A	VD-062B	72	16	BUSINESS SIGN				1																	
		A	VD-062B	72	16	BUSINESS SIGN				1																	
		A	VD-062B	72	16	BUSINESS SIGN				1																	

<b>SIGN SUMMARY SHEET</b>							SHEET TOTALS										PROJECT NAME: <b>Moretown-Newport Town VT100</b>									
							29.25	0.00	3	0	0	5	0	0	5	75	PROJECT NUMBER: <b>STPG SIGN(28)</b>									
							SF	SF	EA	EA	EA	EA	EA	EA	EA	EA	FT	FILE NAME: <b>Stowe.xls</b> PLOT DATE: <b>9/29/2009</b>								
VERMONT AGENCY OF TRANSPORTATION							TOWN TOTALS										PROJECT MANAGER: <b>N. Avery</b> DRAWN BY: <b>I. Shea</b>									
							582.8	0.0	65.0	6.0	6.0	105	0.0	0.0	103	1545.0	DESIGNED BY: <b>D. Crosslev</b> CHECKED BY: <b>N. Avery</b>									
																	STOWE SHEET <b>8</b> SHEET <b>63</b> OF <b>166</b>									



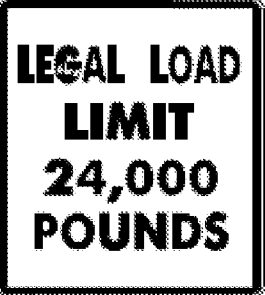




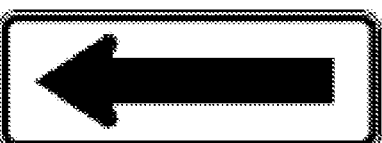
DIRECTION	MILEPOINT	LOCATION CODE (SHEET 2)	SIGN CODE	WIDTH (IN)	HEIGHT (IN)	SHEETING REMARKS	SIGN LEGEND	NEW SIGNS		EXISTING SIGNS				EXIST POST		NUMBER OF NEW POSTS	SQUARE STEEL (IN)			TUBULAR STEEL Ø (IN)				SIGN FRAME REQUIRED	REMARKS	SIGN DETAIL			
								"A"	"B"	RETAIN	SALVAGE FROM	SALVAGE TO	REMOVE	RETAIN	REMOVE		1.75	2.00	2.50	FOUNDATION	3.00	3.50	4.00			5.00	DETAIL IN SHS	DETAIL ON SHEET NUMBER	DETAIL ON STD SHEET NUMBER
																	(LB / FT)				(LB / FT)								
<b>STOWE VT 100</b>							FY-FLUORESCENT YELLOW FYG-FLUORESCENT YELLOW GREEN															"SHS"-STANDARD HIGHWAY SIGNS							
NB	4.920	A	W1-10R	30	30		MODIFIED RIGHT CURVE																						
		A	VD-062B	72	16		BUSINESS SIGN																			SALVAGE FROM NB 4.96			
		A	VD-062B	72	16		BUSINESS SIGN																						
		A	VD-062B	72	16		BUSINESS SIGN																						
NB	4.960	A	VD-062B	72	16		BUSINESS SIGN																						
		A	VD-062B	72	16		BUSINESS SIGN																						
		A	VD-062B	72	16		BUSINESS SIGN																						
		A	W1-10 R	30	30	FY		6.25																		X			
		A	W16-8	30	18	FY		3.75																		8			
NB	5.005	A	VR-615	30	36																								
		A	VR-615	30	36			7.50																			7		
NB	5.208	A	R2-1	24	30																								
		A	R2-1	24	30			5.00																			X		
NB	5.499	A	W2-2R	30	30		RIGHT SIDE ROAD																						
NB	5.520	A	W2-2MaR	30	30			6.25																			INSTALL 100' +/- NOTTH OF ORIGINAL SIGN LOCATION 6		
<b>SIGN SUMMARY SHEET</b>							SHEET TOTALS	28.75	0.00	0	3	3	4	0	0	6	90												
VERMONT AGENCY OF TRANSPORTATION							TOWN TOTALS	582.8	0.0	65.0	6.0	6.0	105	0.0	0.0	103	1545.0												
								SF	SF	EA	EA	EA	EA	EA	EA	EA	FT												






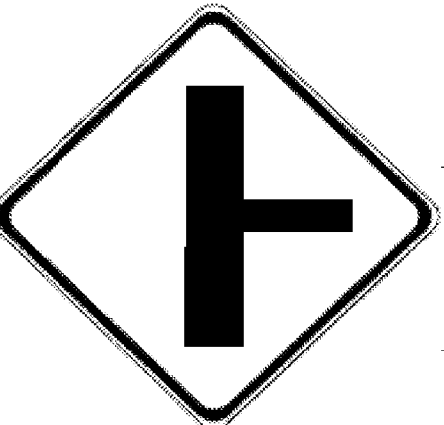

PROJECT NAME: **Moretown-Newport Town VT100**  
PROJECT NUMBER: **STPG SIGN(28)**  
FILE NAME: **Stowe.xls** PLOT DATE: **9/29/2009**  
PROJECT MANAGER: **N. Avery** DRAWN BY: **I. Shea**  
DESIGNED BY: **D. Crosslev** CHECKED BY: **N. Avery**  
STOWE SHEET **9** SHEET **64** OF **166**

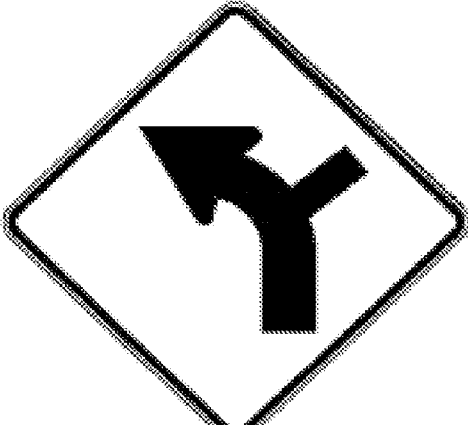DIRECTION	MILEPOINT	LOCATION CODE (SHEET 2)	SIGN CODE	WIDTH (IN)	HEIGHT (IN)	SHEETING REMARKS	SIGN LEGEND	NEW SIGNS		EXISTING SIGNS				EXIST POST		NUMBER OF NEW POSTS	SQUARE STEEL (IN)			TUBULAR STEEL Ø (IN)				SIGN FRAME REQUIRED	REMARKS	SIGN DETAIL									
								"A"	"B"	RETAIN	SALVAGE FROM	SALVAGE TO	REMOVE	RETAIN	REMOVE		1.75	2.00	2.50	FOUNDATION	3.00	3.50	4.00			5.00	DETAIL IN SHS	DETAIL ON SHEET NUMBER	DETAIL ON STD SHEET NUMBER						
																	(LB / FT)				(LB / FT)														
<b>STOWE VT 100</b>							FY-FLUORESCENT YELLOW FYG-FLUORESCENT YELLOW GREEN																"SHS"-STANDARD HIGHWAY SIGNS												
		A	W16-8	30	18			3.75																		8									
NB	5.593	C	VR-017	24	30								1		X																				
		C	VR-017	24	30			5.00						1		X											E-141								
NB	5.603	D	R1-1	30	30																														
		D	R1-1	30	30			6.25																	X										
NB	5.632	A	R2-1	24	30									1		X																			
		A	R2-1	24	30			5.00																	X										
NB	6.269	A	W1-10L	30	30		MODIFIED LEFT CURVE						1		X																				
		A	W16-8A	30	18		RANDOLPH RD						1																						
NB	6.374	C	VR-017	24	30																														
		C	VR-017	24	30			6.25																			E-141								
NB	6.375	A	W1-6	48	24		<=== LEFT LARGE ARROW						1		X																				
NB	6.376	D	R1-1	30	30																														
		D	R1-1	30	30			5.00																	X										
NB	6.471	A	M3-1S	24	12		NORTH						1		X																				
<b>SIGN SUMMARY SHEET</b>							SHEET TOTALS	31.25	0.00	4	0	0	5	0	0	5	75																		
								SF	SF	EA	EA	EA	EA	EA	EA	EA	EA	EA	EA	EA	EA	EA	EA	EA	EA	EA	EA	EA	EA	EA	EA	EA	EA		
VERMONT AGENCY OF TRANSPORTATION							TOWN TOTALS	582.8	0.0	65.0	6.0	6.0	105	0.0	0.0	103	1545.0																		
PROJECT NAME: <b>Moretown-Newport Town VT100</b>																					PROJECT NUMBER: <b>STPG SIGN(28)</b>					FILE NAME: <b>Stowe.xls</b>					PLOT DATE: <b>9/29/2009</b>				
PROJECT MANAGER: <b>N. Avery</b>																					DRAWN BY: <b>I. Shea</b>					DESIGNED BY: <b>D. Crosslev</b>					CHECKED BY: <b>N. Avery</b>				
STOWE SHEET 10																					SHEET <b>65</b> OF <b>166</b>														


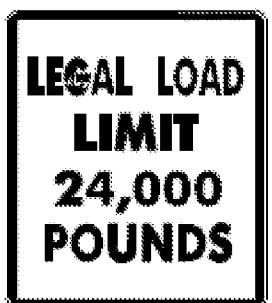
DIRECTION	MILEPOINT	LOCATION CODE (SHEET 2)	SIGN CODE	WIDTH (IN)	HEIGHT (IN)	SHEETING REMARKS	SIGN LEGEND	NEW SIGNS		EXISTING SIGNS				EXIST POST		NUMBER OF NEW POSTS	SQUARE STEEL (IN)			TUBULAR STEEL Ø (IN)				SIGN FRAME REQUIRED	REMARKS	SIGN DETAIL			
								"A"	"B"	RETAIN	SALVAGE FROM	SALVAGE TO	REMOVE	RETAIN	REMOVE		1.75	2.00	2.50	FOUNDATION	3.00	3.50	4.00			5.00	DETAIL IN SHS	DETAIL ON SHEET NUMBER	DETAIL ON STD SHEET NUMBER
																	(LB / FT)				(LB / FT)								
<b>STOWE VT 100</b>							FY-FLUORESCENT YELLOW FYG-FLUORESCENT YELLOW GREEN														"SHS"-STANDARD HIGHWAY SIGNS								
		A	M1-5	30	24		VERMONT 100			1																			
NB	6.549	C	VR-017	24	30																			TINKER LN TH-13					
		C	VR-017	24	30			5.00							1	X									E-141				
NB	6.552	B	W1-6	48	24		RIGHT ==>> LARGE ARROW			1			X																
NB	6.561	D	R1-1	30	30																			TINKER LN TH-13					
		D	R1-1	30	30			6.25							1	X								X					
SB	6.671	F	W1-10R	30	30		MODIFIED RIGHT CURVE			1			X																
		F	W16-8A	30	18		TINKER LANE			1																			
SB	6.470	F	M3-3S	24	12		SOUTH			1			X																
		F	M1-5	30	24		VERMONT 100			1																			
SB	5.906	G	VM-607	24	30		43RD INF DIV MEMORIAL HIGHWAY			1			X																
SB	5.904	G	VR-023B	24	30																								
		G	VR-023B	24	30			5.00							1	X											6		
SB	5.786	F	R2-5A	24	30		REDUCED SPEED AHEAD																						
		F	W3-5	36	36																								
<b>SIGN SUMMARY SHEET</b>							SHEET TOTALS	25.25	0.00	7	0	0	4	0	0	5	75												
								SF	SF	EA	EA	EA	EA	EA	EA	EA	EA	EA	EA	EA	EA	EA							
VERMONT AGENCY OF TRANSPORTATION							TOWN TOTALS	582.8	0.0	65.0	6.0	6.0	105	0.0	0.0	103	1545.0												






PROJECT NAME: **Moretown-Newport Town VT100**  
PROJECT NUMBER: **STPG SIGN(28)**  
FILE NAME: **Stowe.xls** PLOT DATE: **9/29/2009**  
PROJECT MANAGER: **N. Avery** DRAWN BY: **I. Shea**  
DESIGNED BY: **D. Crosslev** CHECKED BY: **N. Avery**  
STOWE SHEET **11** SHEET **66** OF **166**





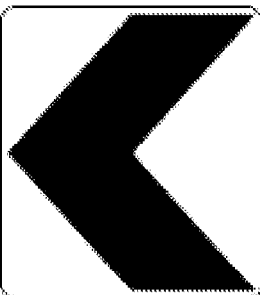
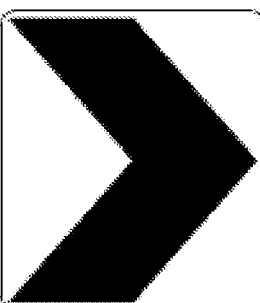
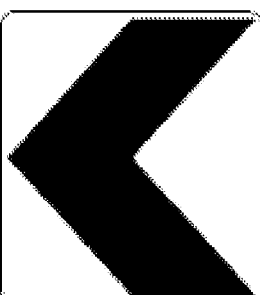
DIRECTION	MILEPOINT	LOCATION CODE (SHEET 2)	SIGN CODE	WIDTH (IN)	HEIGHT (IN)	SHEETING REMARKS	SIGN LEGEND	NEW SIGNS		EXISTING SIGNS				EXIST POST		NUMBER OF NEW POSTS	SQUARE STEEL (IN)			TUBULAR STEEL Ø (IN)				SIGN FRAME REQUIRED	REMARKS	SIGN DETAIL			
								"A"	"B"	RETAIN	SALVAGE FROM	SALVAGE TO	REMOVE	RETAIN	REMOVE		1.75	2.00	2.50	FOUNDATION	3.00	3.50	4.00			5.00	DETAIL IN SHS	DETAIL ON SHEET NUMBER	DETAIL ON STD SHEET NUMBER
																	(LB / FT)				(LB / FT)								
<b>STOWE VT 100</b>							FY-FLUORESCENT YELLOW FYG-FLUORESCENT YELLOW GREEN																"SHS"-STANDARD HIGHWAY SIGNS						
SB	5.634	F	R2-1	24	30																								
		F	R2-1	30	36				7.50																	6			
SB	5.280	F	R2-1	24	30																								
		F	R2-1	24	30				5.00																				
SB	5.155	F	W1-10L	30	30		 																						
		F	W1-10L	30	30				6.25																X				
		F	W16-8A	30	18				3.75																	8			
SB	5.084	F	W1-6	48	24																								
		F	W1-6	48	24				8.00																X				
SB	5.064	G	VR-017	24	30																								
		G	VR-017	24	30				5.00																	E-141			
SB	5.055	H	R1-1	30	30																								
		H	R1-1	30	30				6.25																X				
SB	5.043	F	W1-6	48	24																								
		F	W1-6	48	24				8.00																X				
SB	5.042	E	W1-6	48	24																								
<b>SIGN SUMMARY SHEET</b>							SHEET TOTALS	49.75	0.00	0	0	0	7	0	0	9	135									PROJECT NAME: <b>Moretown-Newport Town VT100</b>			
								SF	SF	EA	EA	EA	EA	EA	EA	EA	EA	EA	EA	EA	EA	EA	EA	EA	EA	EA	EA	EA	PROJECT NUMBER: <b>STPG SIGN(28)</b>
VERMONT AGENCY OF TRANSPORTATION							TOWN TOTALS	582.8	0.0	65.0	6.0	6.0	105	0.0	0.0	103	1545.0							FILE NAME: <b>Stowe.xls</b>	PLOT DATE: <b>9/29/2009</b>				
																							PROJECT MANAGER: <b>N. Avery</b>	DRAWN BY: <b>I. Shea</b>					
																							DESIGNED BY: <b>D. Crosslev</b>	CHECKED BY: <b>N. Avery</b>					
																							STOWE SHEET 12	SHEET <b>67</b> OF <b>166</b>					

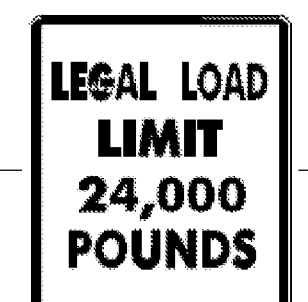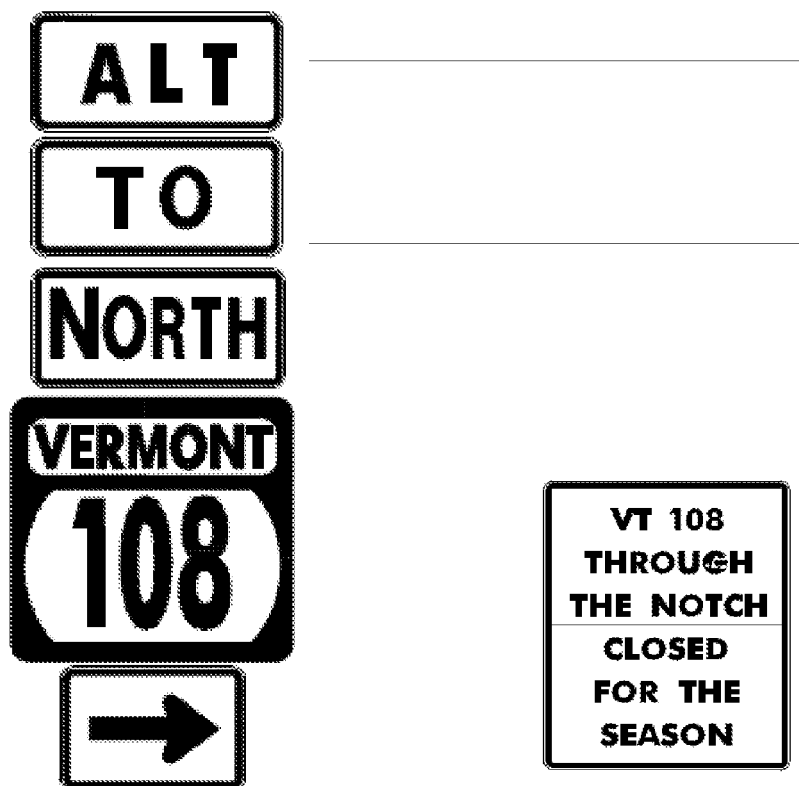




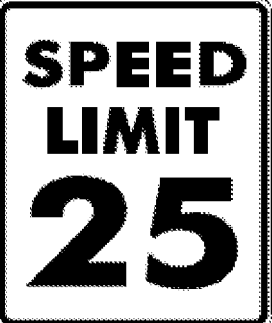


DIRECTION	MILEPOINT	LOCATION CODE (SHEET 2)	SIGN CODE	WIDTH (IN)	HEIGHT (IN)	SHEETING REMARKS	SIGN LEGEND	NEW SIGNS		EXISTING SIGNS				EXIST POST		NUMBER OF NEW POSTS	SQUARE STEEL (IN)			TUBULAR STEEL Ø (IN)				SIGN FRAME REQUIRED	REMARKS	SIGN DETAIL			
								"A"	"B"	RETAIN	SALVAGE FROM	SALVAGE TO	REMOVE	RETAIN	REMOVE		1.75	2.00	2.50	FOUNDATION	3.00	3.50	4.00			5.00	DETAIL IN SHS	DETAIL ON SHEET NUMBER	DETAIL ON STD SHEET NUMBER
																	(LB / FT)				(LB / FT)								
<b>STOWE VT 100</b>							FY-FLUORESCENT YELLOW FYG-FLUORESCENT YELLOW GREEN																"SHS"-STANDARD HIGHWAY SIGNS						
		E	W1-6	48	24			8.00							2		X								X				
SB	5.034	H	R1-1	24	24								1		X											STAGE COACH RD TH-4			
		H	R1-1	36	36			9.00						2		X									X				
SB	4.872	F	R2-1	24	30								1		X														
		F	R2-1	24	30			5.00						1		X									X				
SB	4.630	F	R2-1	24	30								1		X														
		F	R2-1	24	30			5.00						1		X									X				
SB	4.310	F	R2-1	24	30								1		X														
		F	R2-1	24	30			5.00						1		X									X				
SB	4.281	F	VW-205	30	30		WATCH FOR TURNING VEHICLES				1				X														
SB	4.224	F	VW-054R	30	30		HIDDEN DRIVE RIGHT						1		X														
		F	W2-2MaR	30	30	FY		6.25							1		X										6		
		F	W16-8A	30	8	FY		1.67																			8		
SB	4.194	F	M4-1AS	24	12								1		X														
		F	M4-5S	24	12								1																
<b>SIGN SUMMARY SHEET</b>							SHEET TOTALS	39.92	0.00	1	0	0	7	0	0	8	120												
								SF	SF	EA	EA	EA	EA	EA	EA	EA	EA	EA	EA	EA	EA	EA	EA	EA	EA	EA	EA	EA	EA
VERMONT AGENCY OF TRANSPORTATION							TOWN TOTALS	582.8	0.0	65.0	6.0	6.0	105	0.0	0.0	103	1545.0												
							PROJECT NAME: <b>Moretown-Newport Town VT100</b>																						
							PROJECT NUMBER: <b>STPG SIGN(28)</b>																						
							FILE NAME: <b>Stowe.xls</b>																PLOT DATE: <b>9/29/2009</b>						
							PROJECT MANAGER: <b>N. Avery</b>																DRAWN BY: <b>I. Shea</b>						
							DESIGNED BY: <b>D. Crosslev</b>																CHECKED BY: <b>N. Avery</b>						
							STOWE SHEET 13																SHEET <b>68</b> OF <b>166</b>						

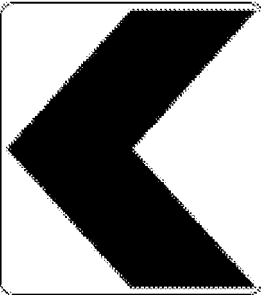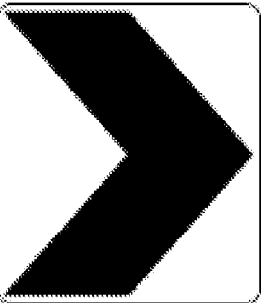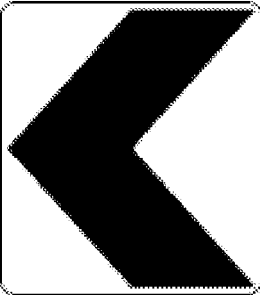

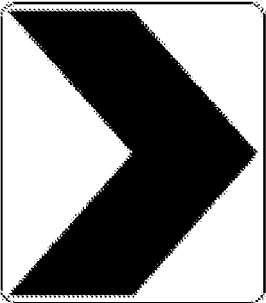




DIRECTION	MILEPOINT	LOCATION CODE (SHEET 2)	SIGN CODE	WIDTH (IN)	HEIGHT (IN)	SHEETING REMARKS	SIGN LEGEND	NEW SIGNS		EXISTING SIGNS				EXIST POST		NUMBER OF NEW POSTS	SQUARE STEEL (IN)			TUBULAR STEEL Ø (IN)				SIGN FRAME REQUIRED	REMARKS	SIGN DETAIL																							
								"A"	"B"	RETAIN	SALVAGE FROM	SALVAGE TO	REMOVE	RETAIN	REMOVE		1.75	2.00	2.50	FOUNDATION	3.00	3.50	4.00			5.00	DETAIL IN SHS	DETAIL ON SHEET NUMBER	DETAIL ON STD SHEET NUMBER																				
																	(LB / FT)				(LB / FT)																												
<b>STOWE VT 100</b>							FY-FLUORESCENT YELLOW FYG-FLUORESCENT YELLOW GREEN																"SHS"-STANDARD HIGHWAY SIGNS																										
			F	M3-1S	24	12																																											
			F	M1-5	30	24																																											
			F	M6-1S	21	15																																											
			F	VR-474H	30	42																																											
			F	M4-1A	24	12																																											
			F	M4-5	24	12																																											
			F	M3-1	24	12																																											
			F	M1-5	30	24																																											
			F	M6-1R	21	15																																											
			F	VR-474H	30	42																																											
SB	4.161	G	VR-017	24	30																																												
		G	VR-017	24	30																																												
SB	4.153	H	R1-1	30	30																																												
		H	R1-1	30	30																																												
SB	4.113	F	W3-5	36	36																																												
<b>SIGN SUMMARY SHEET</b>							SHEET TOTALS											4	60					PROJECT NAME: <b>Moretown-Newport Town VT100</b>																									
							33.19	0.00	1	0	0	6	0	0	4	60					PROJECT NUMBER: <b>STPG SIGN(28)</b>																												
							SF	SF	EA	EA	EA	EA	EA	EA	EA	FT					FILE NAME: <b>Stowe.xls</b>																												
VERMONT AGENCY OF TRANSPORTATION							TOWN TOTALS											103	1545.0					PLOT DATE: <b>9/29/2009</b>																									
							582.8	0.0	65.0	6.0	6.0	105	0.0	0.0	103	1545.0					DRAWN BY: <b>I. Shea</b>																												
																						DESIGNED BY: <b>D. Crosslev</b>																											
																						CHECKED BY: <b>N. Avery</b>																											
																						SHEET <b>69</b> OF <b>166</b>																											











DIRECTION	MILEPOINT	LOCATION CODE (SHEET 2)	SIGN CODE	WIDTH (IN)	HEIGHT (IN)	SHEETING REMARKS	SIGN LEGEND	NEW SIGNS		EXISTING SIGNS				EXIST POST		NUMBER OF NEW POSTS	SQUARE STEEL (IN)			TUBULAR STEEL Ø (IN)				SIGN FRAME REQUIRED	REMARKS	SIGN DETAIL			
								"A"	"B"	RETAIN	SALVAGE FROM	SALVAGE TO	REMOVE	RETAIN	REMOVE		1.75	2.00	2.50	FOUNDATION	3.00	3.50	4.00			5.00	DETAIL IN SHS	DETAIL ON SHEET NUMBER	DETAIL ON STD SHEET NUMBER
																	(LB / FT)				(LB / FT)								
<b>STOWE VT 100</b>							FY-FLUORESCENT YELLOW FYG-FLUORESCENT YELLOW GREEN																"SHS"-STANDARD HIGHWAY SIGNS						
SB	4.038	F	VD-062C	74.75	16		TRAVEL INFORMATION			1			X																
		F	VD-062BC	74.75	16		TRAVEL INFORMATION		1																				
SB	4.018	A	VD-018	30	18							1	X																
		A	VD-018	30	18				3.75						1	X												E-128B	
SB	3.980	F	R2-1	24	30		DO NOT PASS  																						
		F	VR-038	24	18																								
		F	R4-1	24	30																								
		F	VR-038	24	18				3.00						1	X												7	
		F	R2-1	30	36				7.50																			6	
			BEGIN CLASS 1																										
SB	2.941	F	R2-1	24	30		 																						
		F	VR-039	24	18																								
		F	VR-039	24	18				3.00						1	X													
		F	R2-1	24	30				5.00																			X	
SB	2.900	F	W1-8	18	24																								
<b>SIGN SUMMARY SHEET</b>							SHEET TOTALS				22.25	0.00	2	0	0	7	0	0	3	45					PROJECT NAME: <b>Moretown-Newport Town VT100</b>				
							SF	SF	EA	EA	EA	EA	EA	EA	EA	EA	EA	EA	EA	EA	EA	EA	FT					PROJECT NUMBER: <b>STPG SIGN(28)</b>	
VERMONT AGENCY OF TRANSPORTATION							TOWN TOTALS				582.8	0.0	65.0	6.0	6.0	105	0.0	0.0	103	1545.0					FILE NAME: <b>Stowe.xls</b> PLOT DATE: <b>9/29/2009</b>				
																							PROJECT MANAGER: <b>N. Avery</b> DRAWN BY: <b>I. Shea</b>						
																				DESIGNED BY: <b>D. Crosslev</b> CHECKED BY: <b>N. Avery</b>									
																				STOWE SHEET 15 SHEET <b>70</b> OF <b>166</b>									

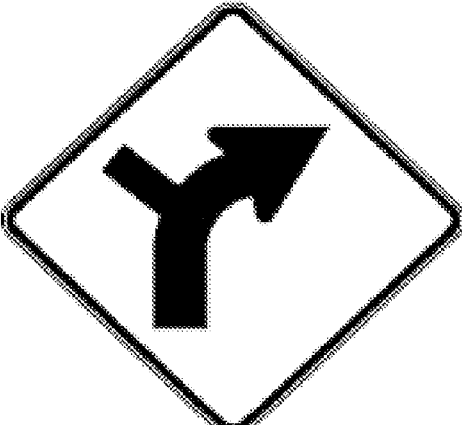

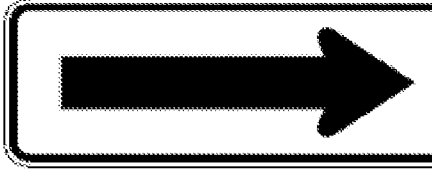
DIRECTION	MILEPOINT	LOCATION CODE (SHEET 2)	SIGN CODE	WIDTH (IN)	HEIGHT (IN)	SHEETING REMARKS	SIGN LEGEND	NEW SIGNS		EXISTING SIGNS				EXIST POST		NUMBER OF NEW POSTS	SQUARE STEEL (IN)			TUBULAR STEEL Ø (IN)				SIGN FRAME REQUIRED	REMARKS	SIGN DETAIL			
								"A"	"B"	RETAIN	SALVAGE FROM	SALVAGE TO	REMOVE	RETAIN	REMOVE		1.75	2.00	2.50	FOUNDATION	3.00	3.50	4.00			5.00	DETAIL IN SHS	DETAIL ON SHEET NUMBER	DETAIL ON STD SHEET NUMBER
																	(LB / FT)				(LB / FT)								
<b>STOWE VT 100</b>							FY-FLUORESCENT YELLOW FYG-FLUORESCENT YELLOW GREEN																"SHS"-STANDARD HIGHWAY SIGNS						
			F	W1-8	18	24		3.00							1		X								X				
SB	2.899		E	W1-8	18	24							1																
			E	W1-8	18	24		3.00						1		X									X				
SB	2.890		F	W1-8	18	24							1		X														
			F	W1-8	18	24		3.00						1		X									X				
SB	2.889		E	W1-8	18	24							1		X														
			E	W1-8	18	24		3.00						1		X									X				
SB	2.880		F	S3-1	30	30	SCHOOL BUS STOP AHEAD			1				X															
SB	2.870		F	W1-8	18	24							1		X														
			F	W1-8	18	24		3.00						1		X									X				
SB	2.869		E	W1-8	18	24							1		X														
			E	W1-8	18	24		3.00						1		X									X				
SB	2.860		F	W1-8	18	24							1		X														
			F	W1-8	18	24		3.00						1		X									X				
SB	2.859		E	W1-8	18	24								1		X													
<b>SIGN SUMMARY SHEET</b>							<b>SHEET TOTALS</b>		21.00	0.00	1	0	0	7	0	0	7	105							PROJECT NAME: <b>Moretown-Newport Town VT100</b>				
									SF	SF	EA	EA	EA	EA	EA	EA	EA	FT							PROJECT NUMBER: <b>STPG SIGN(28)</b>				
							<b>TOWN TOTALS</b>		582.8	0.0	65.0	6.0	6.0	105	0.0	0.0	103	1545.0							FILE NAME: <b>Stowe.xls</b> PLOT DATE: <b>9/29/2009</b>				
VERMONT AGENCY OF TRANSPORTATION																							PROJECT MANAGER: <b>N. Avery</b> DRAWN BY: <b>I. Shea</b>						
																							DESIGNED BY: <b>D. Crosslev</b> CHECKED BY: <b>N. Avery</b>						
																							STOWE SHEET 16 SHEET <b>71</b> OF <b>166</b>						




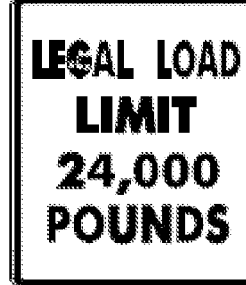


DIRECTION	MILEPOINT	LOCATION CODE (SHEET 2)	SIGN CODE	WIDTH (IN)	HEIGHT (IN)	SHEETING REMARKS	SIGN LEGEND	NEW SIGNS		EXISTING SIGNS				EXIST POST		NUMBER OF NEW POSTS	SQUARE STEEL (IN)			TUBULAR STEEL Ø (IN)				SIGN FRAME REQUIRED	REMARKS	SIGN DETAIL			
								"A"	"B"	RETAIN	SALVAGE FROM	SALVAGE TO	REMOVE	RETAIN	REMOVE		1.75	2.00	2.50	FOUNDATION	3.00	3.50	4.00			5.00	DETAIL IN SHS	DETAIL ON SHEET NUMBER	DETAIL ON STD SHEET NUMBER
																	(LB / FT)				(LB / FT)								
<b>STOWE VT 100</b>							FY-FLUORESCENT YELLOW FYG-FLUORESCENT YELLOW GREEN																"SHS"-STANDARD HIGHWAY SIGNS						
		E	W1-8	18	24			3.00						1		X									X				
SB	2.850	F	VD-018	30	18								1		X														
			VD-018	30	18			3.75						1		X										E-128A			
SB	2.792	F	R2-1	24	30		SPEED LIMIT 30			1				X															
		F	R4-1	24	30								1		X														
		F	R4-1	24	30			5.00						1		X								X					
SB	2.754	G	VR-017	24	30								1		X											RIVER RD TH- 95			
		G	VR-017	24	30			5.00						1		X										E-141			
SB	2.752	H	R1-1	24	24									1		X										RIVER RD TH- 95 ISLAND			
		H	R1-1	30	30			6.25						1		X								X					
SB	2.740	H	R1-1	24	24									1		X										RIVER RD TH- 95			
		H	R1-1	30	30			6.25						1		X								X					
SB	2.490	F	R2-1	24	30									1		X													
		F	R2-1	24	30			5.00						1		X								X					
		F	R4-1	24	30			5.00																	X				
<b>SIGN SUMMARY SHEET</b>							SHEET TOTALS	39.25	0.00	1	0	0	6	0	0	7		105									PROJECT NAME: <b>Moretown-Newport Town VT100</b>		
								SF	SF	EA	EA	EA	EA	EA	EA	EA		FT									PROJECT NUMBER: <b>STPG SIGN(28)</b>		
VERMONT AGENCY OF TRANSPORTATION							TOWN TOTALS	582.8	0.0	65.0	6.0	6.0	105	0.0	0.0	103		1545.0									FILE NAME: <b>Stowe.xls</b>		
																											PLOT DATE: <b>9/29/2009</b>		
																											PROJECT MANAGER: <b>N. Avery</b>		
																											DRAWN BY: <b>I. Shea</b>		
																											DESIGNED BY: <b>D. Crosslev</b>		
																											CHECKED BY: <b>N. Avery</b>		
																											SHEET <b>72</b> OF <b>166</b>		



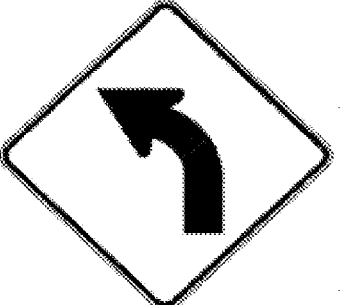


DIRECTION	MILEPOINT	LOCATION CODE (SHEET 2)	SIGN CODE	WIDTH (IN)	HEIGHT (IN)	SHEETING REMARKS	SIGN LEGEND	NEW SIGNS		EXISTING SIGNS				EXIST POST		NUMBER OF NEW POSTS	SQUARE STEEL (IN)			TUBULAR STEEL Ø (IN)				SIGN FRAME REQUIRED	REMARKS	SIGN DETAIL							
								"A"	"B"	RETAIN	SALVAGE FROM	SALVAGE TO	REMOVE	RETAIN	REMOVE		1.75	2.00	2.50	FOUNDATION	3.00	3.50	4.00			5.00	DETAIL IN SHS	DETAIL ON SHEET NUMBER	DETAIL ON STD SHEET NUMBER				
																	(LB / FT)				(LB / FT)												
<b>STOWE VT 100</b>							FY-FLUORESCENT YELLOW FYG-FLUORESCENT YELLOW GREEN																"SHS"-STANDARD HIGHWAY SIGNS										
SB	2.440	F	W11-1	30	30		BICYCLE SYMBOL			1			X																				
		F	W16-1	18	24		SHARE THE ROAD		1																								
SB	2.350	F	VR-417	30	30			6.25							1		X															X	
		E	W14-3	36	24			6.00																								X	
SB	2.330	F	W11-6 H	30	30							1		X																			
		F	W11-6H	30	30			6.25							1		X															E-153	
SB	2.280	F	R2-1	24	30							1		X																			
		E	W14-3	48	36		NO PASSING ZONE 					1																					
		F	R2-1	24	30			5.00							1		X															X	
SB	2.020	F	R2-1	24	30							1		X																			
		F	R2-1	24	30			5.00							1		X															X	
SB	1.796	F	R2-1	24	30																												
		F	R2-1	24	30		 MISSING DUPLICATE, DO NOT PLACE	<del>5.00</del>																									X
SB	1.720	F	W11-1	30	30		BICYCLE SYMBOL			1			X																				
		F	W16-1	18	24		SHARE THE ROAD		1																								
<b>SIGN SUMMARY SHEET</b>							SHEET TOTALS			33.50	0.00	4	0	0	5	0	0	5	75										PROJECT NAME: <b>Moretown-Newport Town VT100</b>				
										SF	SF	EA	EA	EA	EA	EA	EA	EA	FT									PROJECT NUMBER: <b>STPG SIGN(28)</b>					
VERMONT AGENCY OF TRANSPORTATION							TOWN TOTALS			582.8	0.0	65.0	6.0	6.0	105	0.0	0.0	103	1545.0									FILE NAME: <b>Stowe.xls</b>	PLOT DATE: <b>9/29/2009</b>				
																											PROJECT MANAGER: <b>N. Avery</b>	DRAWN BY: <b>I. Shea</b>					
																											DESIGNED BY: <b>D. Crosslev</b>	CHECKED BY: <b>N. Avery</b>					
																											STOWE SHEET 18	SHEET <b>73</b> OF <b>166</b>					




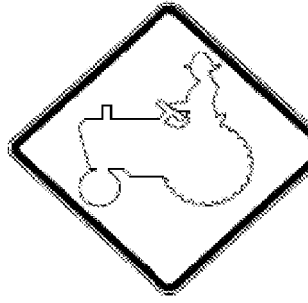
DIRECTION	MILEPOINT	LOCATION CODE (SHEET 2)	SIGN CODE	WIDTH (IN)	HEIGHT (IN)	SHEETING REMARKS	SIGN LEGEND	NEW SIGNS		EXISTING SIGNS				EXIST POST		NUMBER OF NEW POSTS	SQUARE STEEL (IN)			TUBULAR STEEL Ø (IN)				SIGN FRAME REQUIRED	REMARKS	SIGN DETAIL			
								"A"	"B"	RETAIN	SALVAGE FROM	SALVAGE TO	REMOVE	RETAIN	REMOVE		1.75	2.00	2.50	FOUNDATION	3.00	3.50	4.00			5.00	DETAIL IN SHS	DETAIL ON SHEET NUMBER	DETAIL ON STD SHEET NUMBER
																	(LB / FT)				(LB / FT)								
<b>STOWE VT 100</b>							FY-FLUORESCENT YELLOW FYG-FLUORESCENT YELLOW GREEN															"SHS"-STANDARD HIGHWAY SIGNS							
SB	1.620	F	VW-205	30	30		 WATCH FOR TURNING VEHICLES																						
		F	W1-10 R	30	30																						X		
		F	W16-8	30	8																							8	
SB	1.470	F	R2-1	24	30																								
		F	R2-1	24	30																							X	
SB	1.370	F	S3-1	30	30		SCHOOL BUS STOP			1																			
SB	1.200	F	R2-1	24	30																								
		F	R2-1	24	30																							X	
SB	1.140	A	VD-062B	72	16		BUSINESS SIGN			1																			
		A	VD-062B	72	16		BUSINESS SIGN			1																			
		A	VD-062B	72	16		BUSINESS SIGN			1																			
SB	0.983	F	W2-2R	30	30		RIGHT SIDE ROAD			1																			
		F	W16-8A	30	10		MOSCOW RD			1																			
SB	0.940	A	VD-062B	72	16		BUSINESS SIGN			1																			
		A	VD-062B	72	16		BUSINESS SIGN			1																			
<b>SIGN SUMMARY SHEET</b>							SHEET TOTALS	17.92	0.00	8	0	0	3	0	0	3	45								PROJECT NAME: <b>Moretown-Newport Town VT100</b>				
								SF	SF	EA	EA	EA	EA	EA	EA	EA	FT											PROJECT NUMBER: <b>STPG SIGN(28)</b>	
VERMONT AGENCY OF TRANSPORTATION							TOWN TOTALS	582.8	0.0	65.0	6.0	6.0	105	0.0	0.0	103	1545.0							FILE NAME: <b>Stowe.xls</b> PLOT DATE: <b>9/29/2009</b>					
																								PROJECT MANAGER: <b>N. Avery</b> DRAWN BY: <b>I. Shea</b>					
																								DESIGNED BY: <b>D. Crosslev</b> CHECKED BY: <b>N. Avery</b>					
																								STOWE SHEET 19 SHEET <b>74</b> OF <b>166</b>					











DIRECTION	MILEPOINT	LOCATION CODE (SHEET 2)	SIGN CODE	WIDTH (IN)	HEIGHT (IN)	SHEETING REMARKS	SIGN LEGEND	NEW SIGNS		EXISTING SIGNS				EXIST POST		NUMBER OF NEW POSTS	SQUARE STEEL (IN)			TUBULAR STEEL Ø (IN)				SIGN FRAME REQUIRED	REMARKS	SIGN DETAIL			
								"A"	"B"	RETAIN	SALVAGE FROM	SALVAGE TO	REMOVE	RETAIN	REMOVE		1.75	2.00	2.50	FOUNDATION	3.00	3.50	4.00			5.00	DETAIL IN SHS	DETAIL ON SHEET NUMBER	DETAIL ON STD SHEET NUMBER
																	(LB / FT)				(LB / FT)								
																	1.88	2.42	3.35		7.60	9.00	10.80			14.60			
<b>STOWE VT 100</b>							FY-FLUORESCENT YELLOW FYG-FLUORESCENT YELLOW GREEN														"SHS"-STANDARD HIGHWAY SIGNS								
		A	VD-062B	72	16		BUSINESS SIGN		1																				
SB	0.861	G	VR-017	24	24						1		X										MOSCOW RD TH-1						
		G	VR-017	24	30				5.00				1	X											E-141				
SB	0.849	H	R1-1	24	24								1	X										MOSCOW RD TH-1					
		H	R1-1	30	30				6.25				1	X									X						
SB	0.800	F	R2-1	24	30								1	X															
		F	R2-1	24	30				5.00				1	X									X						
SB	0.770	F	M3-3S	24	12									1	X														
		F	M1-5	30	24										1														
		F	M3-3	24	12				2.00						1	X								GREEN ON WHITE SHEETING	X				
		F	M1-5	30	24				5.00																E-136B				
SB	0.166	G	VR-017	24	30		LEGAL LOAD LIMIT 24,000 LBS			1			X											BLACK BEAR RUN TH-111					
SB	0.156	H	R1-1	30	30		STOP			1			X											BLACK BEAR RUN TH-111					
<b>SIGN SUMMARY SHEET</b>							SHEET TOTALS	23.25	0.00	3	0	0	5	0	0	4	60				PROJECT NAME: <b>Moretown-Newport Town VT100</b>								
								SF	SF	EA	EA	EA	EA	EA	EA	EA	FT				PROJECT NUMBER: <b>STPG SIGN(28)</b>								
VERMONT AGENCY OF TRANSPORTATION							TOWN TOTALS	582.8	0.0	65.0	6.0	6.0	105	0.0	0.0	103	1545.0				FILE NAME: <b>Stowe.xls</b> PLOT DATE: <b>9/29/2009</b>								
																					PROJECT MANAGER: <b>N. Avery</b> DRAWN BY: <b>I. Shea</b>								
																					DESIGNED BY: <b>D. Crosslev</b> CHECKED BY: <b>N. Avery</b>								
																					STOWE SHEET 20 SHEET <b>75</b> OF <b>166</b>								



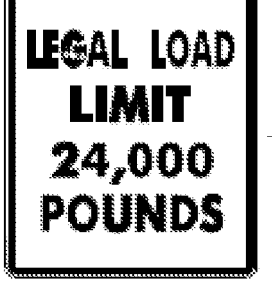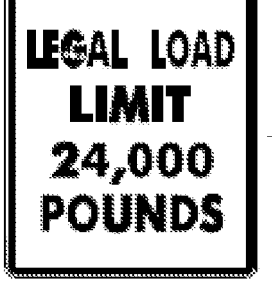


DIRECTION	MILEPOINT	LOCATION CODE (SHEET 2)	SIGN CODE	WIDTH (IN)	HEIGHT (IN)	SHEETING REMARKS	SIGN LEGEND	NEW SIGNS		EXISTING SIGNS				EXIST POST		NUMBER OF NEW POSTS	SQUARE STEEL (IN)			TUBULAR STEEL Ø (IN)				SIGN FRAME REQUIRED	REMARKS	SIGN DETAIL			
								"A"	"B"	RETAIN	SALVAGE FROM	SALVAGE TO	REMOVE	RETAIN	REMOVE		1.75	2.00	2.50	FOUNDATION	3.00	3.50	4.00			5.00	DETAIL IN SHS	DETAIL ON SHEET NUMBER	DETAIL ON STD SHEET NUMBER
																	(LB / FT)				(LB / FT)								
<b>MORRISTOWN VT 100</b>							FY-FLUORESCENT YELLOW FYG-FLUORESCENT YELLOW GREEN															"SHS"-STANDARD HIGHWAY SIGNS							
NB	0.000	C	VD-024	72	10		<b>MORRISTOWN</b>   <b>STOWE</b>	5.00						2		X							INSTALL OPPOSITE EXISTING SB TOWNLINER SIGN		4				
		C	VD-700	6	10		<b>1000</b> <b>0807</b> <b>0000</b>	0.42																					
		C	VD-700	6	10		<b>1000</b> <b>0808</b> <b>0682</b>	0.42																					
NB	0.370	A	R2-1	24	30		<b>SPEED LIMIT</b> <b>50</b>					1				X													
		A	R2-1	24	30			5.00						1		X								X					
NB	0.910	A	W1-2L	30	30		LEFT CURVE					1				X													
		A	W13-1	24	24		40 MPH PLAQUE					1																	
NB	0.980	B	W1-8	18	24		CHEVRON					1				X													
		A	W1-2L	30	30			6.25						1		X								X					
		A	W13-1	24	24		<b>40</b> M.P.H.	4.00																X					
NB	1.000	A	W1-8	18	24		CHEVRON					1				X													
		B	W1-8	18	24		CHEVRON					1																	
		A	W1-6	48	24			8.00						2		X								X					
NB	1.020	A	W1-8	18	24		CHEVRON					1				X													
		B	W1-6	48	24			8.00						2		X								X					
<b>SIGN SUMMARY SHEET</b>							SHEET TOTALS	37.09	0.00	0	0	0	7	0	0	8	120								PROJECT NAME: <b>Moretown-Newport Town VT100</b>				
								SF	SF	EA	EA	EA	EA	EA	EA	EA	EA	EA	EA	EA	EA	EA	EA	EA	EA	EA	EA	PROJECT NUMBER: <b>STPG SIGN(28)</b>	
VERMONT AGENCY OF TRANSPORTATION							TOWN TOTALS	369.7	0.0	77.0	5.0	5.0	65	0.0	0.0	68	1020.0						FILE NAME: <b>Morristown.xls</b>	PLOT DATE: <b>9/29/2009</b>					
																						PROJECT MANAGER: <b>N. Avery</b>	DRAWN BY: <b>I. Shea</b>						
																						DESIGNED BY: <b>D. Crosslev</b>	CHECKED BY: <b>J. Kelly</b>						
																						MORRISTOWN SHEET 1	SHEET <b>76</b> OF <b>166</b>						

DIRECTION	MILEPOINT	LOCATION CODE (SHEET 2)	SIGN CODE	WIDTH (IN)	HEIGHT (IN)	SHEETING REMARKS	SIGN LEGEND	NEW SIGNS		EXISTING SIGNS				EXIST POST		NUMBER OF NEW POSTS	SQUARE STEEL (IN)			TUBULAR STEEL Ø (IN)				SIGN FRAME REQUIRED	REMARKS	SIGN DETAIL						
								"A"	"B"	RETAIN	SALVAGE FROM	SALVAGE TO	REMOVE	RETAIN	REMOVE		1.75	2.00	2.50	FOUNDATION	3.00	3.50	4.00			5.00	DETAIL IN SHS	DETAIL ON SHEET NUMBER	DETAIL ON STD SHEET NUMBER			
																	(LB / FT)				(LB / FT)											
<b>MORRISTOWN VT 100</b>							FY-FLUORESCENT YELLOW FYG-FLUORESCENT YELLOW GREEN																"SHS"-STANDARD HIGHWAY SIGNS									
NB	1.075	C	VR-017	24	30																			JOE'S POND RD TH-100								
		C	VR-017	24	30			5.00											X								E-141					
NB	1.083	D	R1-1	30	30																			JOE'S POND RD TH-100								
		D	R1-1	30	30			6.25											X				X									
NB	1.399	D	R1-1	30	30																			TAMARACK HILL RD TH-86								
		D	R1-1	30	30			6.25											X				X									
NB	1.407	C	VR-017	24	30																			TAMARACK HILL RD TH-86								
		C	VR-017	24	30			5.00											X								E-141					
NB	1.560	A	VD-062B	72	16		BUSINESS SIGN			1				X																		
		A	VD-062B	72	16		BUSINESS SIGN			1																						
NB	1.602	A	W11-7	30	30		EQUESTRIAN			1				X																		
NB	1.645	A	W2-2MR	30	30		RIGHT SIDE ROAD			1				X																		
		A	W16-8A	30	8																					X						
NB	1.694	C	VR-017	24	30																			STANCLIFF RD TH-72								
		C	VR-017	24	30			5.00											X								E-141					
<b>SIGN SUMMARY SHEET</b>							SHEET TOTALS											29.17	0.00	4	0	0	5	0	0	5	75					PROJECT NAME: <b>Moretown-Newport Town VT100</b>
							SF	SF	EA	EA	EA	EA	EA	EA	EA	EA	EA	EA	EA	EA	EA	EA	EA	EA	EA	EA	EA	EA	PROJECT NUMBER: <b>STPG SIGN(28)</b>			
							TOWN TOTALS											369.7	0.0	77.0	5.0	5.0	65	0.0	0.0	68	1020.0					FILE NAME: <b>Morristown.xls</b>
VERMONT AGENCY OF TRANSPORTATION																													PLOT DATE: <b>9/29/2009</b>			
																													DRAWN BY: <b>I. Shea</b>			
																													CHECKED BY: <b>J. Kelly</b>			
																													SHEET <b>77</b> OF <b>166</b>			

DIRECTION	MILEPOINT	LOCATION CODE (SHEET 2)	SIGN CODE	WIDTH (IN)	HEIGHT (IN)	SHEETING REMARKS	SIGN LEGEND	NEW SIGNS		EXISTING SIGNS				EXIST POST		NUMBER OF NEW POSTS	SQUARE STEEL (IN)			TUBULAR STEEL Ø (IN)				SIGN FRAME REQUIRED	REMARKS	SIGN DETAIL			
								"A"	"B"	RETAIN	SALVAGE FROM	SALVAGE TO	REMOVE	RETAIN	REMOVE		1.75	2.00	2.50	FOUNDATION	3.00	3.50	4.00			5.00	DETAIL IN SHS	DETAIL ON SHEET NUMBER	DETAIL ON STD SHEET NUMBER
																	(LB / FT)				(LB / FT)								
<b>MORRISTOWN VT 100</b>							FY-FLUORESCENT YELLOW FYG-FLUORESCENT YELLOW GREEN															"SHS"-STANDARD HIGHWAY SIGNS							
NB	1.688	D	R1-1	30	30																			STANCLIFF RD TH-72					
		D	R1-1	30	30			6.25																		X			
NB	1.840	C	VR-017	24	30																			BROOK N PINE RD TH-113					
		C	VR-017	24	30			5.00																				E-141	
NB	1.834	D	R1-1	30	30																			BROOK N PINE RD TH-113					
		D	R1-1	30	30			6.25																		X			
NB	2.200	A	VD-062B	72	16		BUSINESS SIGN			1				X															
NB	2.231	C	VR-017	24	30																			GOELTZ RD TH-56					
		C	VR-017	24	30			5.00																				E-141	
NB	2.239	D	R1-1	30	30																			GOELTZ RD TH-56					
		D	R1-1	30	30			6.25																		X			
NB	2.396	A	W2-2ML	30	30		LEFT SIDE ROAD			1				X															
		A	VW-054R	30	30		HIDDEN DRIVE RIGHT			1																			
NB	2.430	A	S3-1	30	30		SCHOOL BUS STOP AHEAD			1				X															
NB	3.010	A	D1-1M	72	10																								
<b>SIGN SUMMARY SHEET</b>							SHEET TOTALS	28.75	0.00	4	0	0	6	0	0	5	75									PROJECT NAME: <b>Moretown-Newport Town VT100</b>			
								SF	SF	EA	EA	EA	EA	EA	EA	EA	EA	EA	EA	EA	EA	EA	EA	EA	EA	EA	EA	EA	EA
VERMONT AGENCY OF TRANSPORTATION							TOWN TOTALS	369.7	0.0	77.0	5.0	5.0	65	0.0	0.0	68	1020.0								FILE NAME: <b>Morristown.xls</b>				
																									PLOT DATE: <b>9/29/2009</b>				
																										PROJECT MANAGER: <b>N. Avery</b>			
																										DRAWN BY: <b>I. Shea</b>			
																										DESIGNED BY: <b>D. Crosslev</b>			
																										CHECKED BY: <b>J. Kelly</b>			
																										MORRISTOWN SHEET 3			
																										SHEET <b>78</b> OF <b>166</b>			




DIRECTION	MILEPOINT	LOCATION CODE (SHEET 2)	SIGN CODE	WIDTH (IN)	HEIGHT (IN)	SHEETING REMARKS	SIGN LEGEND	NEW SIGNS		EXISTING SIGNS				EXIST POST		NUMBER OF NEW POSTS	SQUARE STEEL (IN)			TUBULAR STEEL Ø (IN)				SIGN FRAME REQUIRED	REMARKS	SIGN DETAIL				
								"A"	"B"	RETAIN	SALVAGE FROM	SALVAGE TO	REMOVE	RETAIN	REMOVE		1.75	2.00	2.50	FOUNDATION	3.00	3.50	4.00			5.00	DETAIL IN SHS	DETAIL ON SHEET NUMBER	DETAIL ON STD SHEET NUMBER	
																	(LB / FT)				(LB / FT)									
<b>MORRISTOWN VT 100</b>							FY-FLUORESCENT YELLOW FYG-FLUORESCENT YELLOW GREEN																"SHS"-STANDARD HIGHWAY SIGNS							
		A	D1-1	72	12			6.00							2		X										5			
NB	3.044	A	D4-2	30	36		PARK & RIDE			1				X																
		A	VD-365	30	6		1-800-685-RIDE						1																	
NB	3.051	D	R1-1	24	24								1		X															
		D	R1-1	30	30			6.25							1		X								X					
NB	3.880	A	S3-1	30	30								1		X															
		A	S3-1	30	30			6.25							1		X								X					
NB	4.000	A	W11-5	30	30								1		X															
		A	W11-5	30	30			6.25							1		X								X					
NB	4.096	C	VR-017	24	30		LEGAL LOAD LIMIT 24,000 LBS			1				X																
NB	4.104	D	R1-1	30	30		STOP			1				X																
NB	4.126	A	W3-5	36	36		SPEED REDUCTION SPEED LIMIT 40			1				X																
NB	4.161	A	VW-205	30	30		WATCH FOR TURNING VEHICLES						1		X															
		A	VD-062B	72	16		BUSINESS SIGN					1			2		X													
		A	VD-062B	72	16		BUSINESS SIGN					1																		
<b>SIGN SUMMARY SHEET</b>							SHEET TOTALS	24.75	0.00	4	0	2	5	0	0	7		105												
								SF	SF	EA	EA	EA	EA	EA	EA	EA	EA	EA	EA	EA	EA	EA	EA	EA	EA	EA	EA	EA	EA	EA
VERMONT AGENCY OF TRANSPORTATION							TOWN TOTALS	369.7	0.0	77.0	5.0	5.0	65	0.0	0.0	68		1020.0												
PROJECT NAME: <b>Moretown-Newport Town VT100</b>																						PROJECT NUMBER: <b>STPG SIGN(28)</b>								
FILE NAME: <b>Morristown.xls</b>															PLOT DATE: <b>9/29/2009</b>															
PROJECT MANAGER: <b>N. Avery</b>															DRAWN BY: <b>I. Shea</b>															
DESIGNED BY: <b>D. Crosslev</b>															CHECKED BY: <b>J. Kelly</b>															
MORRISTOWN SHEET 4															SHEET <b>79</b> OF <b>166</b>															




DIRECTION	MILEPOINT	LOCATION CODE (SHEET 2)	SIGN CODE	WIDTH (IN)	HEIGHT (IN)	SHEETING REMARKS	SIGN LEGEND	NEW SIGNS		EXISTING SIGNS				EXIST POST		NUMBER OF NEW POSTS	SQUARE STEEL (IN)			TUBULAR STEEL Ø (IN)				SIGN FRAME REQUIRED	REMARKS	SIGN DETAIL													
								"A"	"B"	RETAIN	SALVAGE FROM	SALVAGE TO	REMOVE	RETAIN	REMOVE		1.75	2.00	2.50	FOUNDATION	3.00	3.50	4.00			5.00	DETAIL IN SHS	DETAIL ON SHEET NUMBER	DETAIL ON STD SHEET NUMBER										
																	(LB / FT)				(LB / FT)																		
<b>MORRISTOWN VT 100</b>							FY-FLUORESCENT YELLOW FYG-FLUORESCENT YELLOW GREEN																"SHS"-STANDARD HIGHWAY SIGNS																
		A	VD-062AL	72	16		BUSINESS SIGN				1																												
NB	4.210	A	VD-062B	72	16		BUSINESS SIGN				1																												
		A	VD-062B	72	16		BUSINESS SIGN				1																												
		A	VD-062AL	72	16		BUSINESS SIGN				1																												
		A	W2-3MaL	30	30			6.25							1													6											
		A	W16-8A	30	18			3.75																				8											
NB	4.240	A	R2-1	24	30							1																											
		A	R2-1	30	36			7.50							1													6											
NB	4.361	C	VR-017	24	30																																		
		C	VR-017	24	30			5.00							1																								
NB	4.369	D	R1-1	30	30							1																											
		D	R1-1	30	30			6.25							1																								
NB	4.410	A	R2-1	24	30		SPEED LIMIT 40 					1																											
NB	4.425	A	R2-1	24	30			5.00							1																								
NB	4.460	A	VD-062B	72	16		BUSINESS SIGN				1																												
<b>SIGN SUMMARY SHEET</b>							SHEET TOTALS	33.75	0.00	1	3	1	3	0	0	5	75																						
								SF	SF	EA	EA	EA	EA	EA	EA	EA	EA	EA	EA	EA	EA	EA	EA	EA	EA	EA	EA	EA	EA	EA	EA	EA	EA	EA					
VERMONT AGENCY OF TRANSPORTATION							TOWN TOTALS	369.7	0.0	77.0	5.0	5.0	65	0.0	0.0	68	1020.0																						
							PROJECT NAME:	<b>Moretown-Newport Town VT100</b>																															
							PROJECT NUMBER:	<b>STPG SIGN(28)</b>																															
							FILE NAME:	<b>Morristown.xls</b>										PLOT DATE:	<b>9/29/2009</b>																				
							PROJECT MANAGER:	<b>N. Avery</b>										DRAWN BY:	<b>I. Shea</b>																				
							DESIGNED BY:	<b>D. Crosslev</b>										CHECKED BY:	<b>J. Kelly</b>																				
							MORRISTOWN SHEET 5											SHEET	<b>80</b>										OF	<b>166</b>									





DIRECTION	MILEPOINT	LOCATION CODE (SHEET 2)	SIGN CODE	WIDTH (IN)	HEIGHT (IN)	SHEETING REMARKS	SIGN LEGEND	NEW SIGNS		EXISTING SIGNS				EXIST POST		NUMBER OF NEW POSTS	SQUARE STEEL (IN)			TUBULAR STEEL Ø (IN)				SIGN FRAME REQUIRED	REMARKS	SIGN DETAIL		
								"A"	"B"	RETAIN	SALVAGE FROM	SALVAGE TO	REMOVE	RETAIN	REMOVE		(LB / FT)			(LB / FT)						DETAIL IN SHS	DETAIL ON SHEET NUMBER	DETAIL ON STD SHEET NUMBER
																	1.75	2.00	2.50	FOUNDATION								
							FY-FLUORESCENT YELLOW FYG-FLUORESCENT YELLOW GREEN															"SHS"-STANDARD HIGHWAY SIGNS						
		A	VD-062B	72	16		BUSINESS SIGN			1																		
		A	VD-062B	72	16		BUSINESS SIGN			1																		
NB	4.524	A	S1-1YG	36	36		SCHOOL SYMBOL			1			X															
		A	W16-9YG	30	18		AHEAD			1																		
NB	4.556	A	R2-1	30	36		SPEED LIMIT 35			1			X															
NB	4.640	A	D1-1E	72	20							1		X														
		A	D1-1	72	20			10.00						2		X								5				
NB	4.670	A	W11-9	30	30							1		X														
		A	W11-9	30	30			6.25						1		X							X					
NB	4.785	A	W3-5	36	36			9.00						2		X												
NB	4.850	A	R2-1	24	30							1		X														
		A	VR-038	24	18							1																
		A	R2-1	30	36			3.00						1		X								6				
		A	VR-038	24	18			7.50																6				
							CLASS 1 PORTION OF HIGHWAY																					
<b>SIGN SUMMARY SHEET</b>							SHEET TOTALS	35.75	0.00	5	0	0	4	0	0	6	90							PROJECT NAME: <b>Moretown-Newport Town VT100</b>				
								SF	SF	EA	EA	EA	EA	EA	EA	EA	FT						PROJECT NUMBER: <b>STPG SIGN(28)</b>					
VERMONT AGENCY OF TRANSPORTATION							TOWN TOTALS	369.7	0.0	77.0	5.0	5.0	65	0.0	0.0	68	1020.0						FILE NAME: <b>Morristown.xls</b>	PLOT DATE: <b>9/29/2009</b>				
																						PROJECT MANAGER: <b>N. Avery</b>	DRAWN BY: <b>I. Shea</b>					
																					DESIGNED BY: <b>D. Crosslev</b>	CHECKED BY: <b>J. Kelly</b>						
																					MORRISTOWN SHEET <b>6</b>	SHEET <b>81</b> OF <b>166</b>						





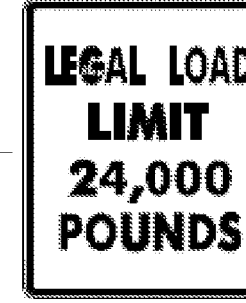

DIRECTION	MILEPOINT	LOCATION CODE (SHEET 2)	SIGN CODE	WIDTH (IN)	HEIGHT (IN)	SHEETING REMARKS	SIGN LEGEND	NEW SIGNS		EXISTING SIGNS				EXIST POST		NUMBER OF NEW POSTS	SQUARE STEEL (IN)			TUBULAR STEEL Ø (IN)				SIGN FRAME REQUIRED	REMARKS	SIGN DETAIL			
								"A"	"B"	RETAIN	SALVAGE FROM	SALVAGE TO	REMOVE	RETAIN	REMOVE		1.75	2.00	2.50	FOUNDATION	3.00	3.50	4.00			5.00	DETAIL IN SHS	DETAIL ON SHEET NUMBER	DETAIL ON STD SHEET NUMBER
																	(LB / FT)				(LB / FT)								
<b>MORRISTOWN VT 100</b>							FY-FLUORESCENT YELLOW FYG-FLUORESCENT YELLOW GREEN																"SHS"-STANDARD HIGHWAY SIGNS						
NB	6.170	A	VD-062B	72	16		BUSINESS SIGN			1				X															
		A	VD-062AS	72	16		BUSINESS SIGN			1																			
		A	VD-062AL	72	16		BUSINESS SIGN			1																			
NB	6.188	A	VR-039	24	18		STATE HIGHWAY BEGINS				1	1			1		X												
		A	R2-1	24	30		SPEED LIMIT 40				1	1																	
NB	6.302	A	VR-932	48	30		LEFT "ONLY"/THRU/RIGHT "ONLY"			1				X															
NB	6.376	C	VR-017	24	30		LEGAL LOAD LIMIT 24,000 LBS			1				X											NORTHGATE AVE. TH-101				
NB	6.384	D	R1-1	30	30		STOP			1				X											NORTHGATE AVE. TH-101				
NB	6.465	A	M2-1S	21	15		JCT			1				X															
		A	M1-5	24	24		VERMONT 15			1																			
NB	6.495	A	VR-921MR	30	30		THRU/MODIFIED RIGHT "ONLY"			1				X															
NB	6.532	A	D1-1A	72	12		<--- JOHNSON 7			1				X															
		A	D1-1A	72	12		<--- JEFFERSONVILLE 16			1																			
		A	D1-1A	72	12		WOLCOTT 8 --->			1																			
		A	D1-1A	72	12		HARDWICK 13 --->			1																			
<b>SIGN SUMMARY SHEET</b>							SHEET TOTALS	0.00	0.00	13	2	2	0	0	0	1	15							PROJECT NAME: <b>Moretown-Newport Town VT100</b>					
								SF	SF	EA	EA	EA	EA	EA	EA	EA	FT							PROJECT NUMBER: <b>STPG SIGN(28)</b>					
VERMONT AGENCY OF TRANSPORTATION							TOWN TOTALS	369.7	0.0	77.0	5.0	5.0	65	0.0	0.0	68	1020.0							FILE NAME: <b>Morristown.xls</b> PLOT DATE: <b>9/29/2009</b>					
																				PROJECT MANAGER: <b>N. Avery</b> DRAWN BY: <b>I. Shea</b>									
																				DESIGNED BY: <b>D. Crosslev</b> CHECKED BY: <b>J. Kelly</b>									
																				MORRISTOWN SHEET 7 SHEET <b>82</b> OF <b>166</b>									






DIRECTION	MILEPOINT	LOCATION CODE (SHEET 2)	SIGN CODE	WIDTH (IN)	HEIGHT (IN)	SHEETING REMARKS	SIGN LEGEND	NEW SIGNS		EXISTING SIGNS				EXIST POST		NUMBER OF NEW POSTS	SQUARE STEEL (IN)			TUBULAR STEEL Ø (IN)				SIGN FRAME REQUIRED	REMARKS	SIGN DETAIL			
								"A"	"B"	RETAIN	SALVAGE FROM	SALVAGE TO	REMOVE	RETAIN	REMOVE		1.75	2.00	2.50	FOUNDATION	3.00	3.50	4.00			5.00	DETAIL IN SHS	DETAIL ON SHEET NUMBER	DETAIL ON STD SHEET NUMBER
																	(LB / FT)				(LB / FT)								
<b>MORRISTOWN VT 100</b>							FY-FLUORESCENT YELLOW FYG-FLUORESCENT YELLOW GREEN															"SHS"-STANDARD HIGHWAY SIGNS							
NB	6.568	A	VR-922L	36	30		LEFT "ONLY"/THRU & RIGHT			1																			
NB	6.582	J	R4-7	24	30		RIGHT BULLNOSE			1																			
		J	OM1-1	18	18		YELLOW CLUSTER			1																			
		K	OM1-1	18	18		YELLOW CLUSTER			1																			
NB	6.589	A	M3-4S	24	12		WEST			1																			
		A	M1-5	24	24		VERMONT 15			1																			
		A	M4-5S	21	15		TO			1																			
		A	M3-1S	24	12		NORTH			1																			
		A	M1-5	30	24		VERMONT 100			1																			
		A	M6-1S	21	15		<--- LEFT			1																			
		A	M3-2S	24	12		EAST			1																			
		A	M1-5	24	24		VERMONT 15			1																			
		A	M6-1S	21	15		RIGHT --->			1																			
SB	6.592	K	R4-7	24	30		RIGHT BULLNOSE			1																			
		J	OM1-1	18	18		YELLOW CLUSTER			1																			
<b>SIGN SUMMARY SHEET</b>							<b>SHEET TOTALS</b>	0.00	0.00	15	0	0	0	0	0	0	0	0	0	0	0	0	0	0	0	0	0	0	
								SF	SF	EA	EA	EA	EA	EA	EA	EA	EA	EA	EA	EA	EA	EA	EA	EA	EA	EA	EA	EA	
VERMONT AGENCY OF TRANSPORTATION							<b>TOWN TOTALS</b>	369.7	0.0	77.0	5.0	5.0	65	0.0	0.0	68	1020.0												
								PROJECT NAME: <b>Moretown-Newport Town VT100</b>																					
								PROJECT NUMBER: <b>STPG SIGN(28)</b>																					
								FILE NAME: <b>Morristown.xls</b>																					
								PROJECT MANAGER: <b>N. Avery</b>																					
								DESIGNED BY: <b>D. Crosslev</b>																					
								MORRISTOWN SHEET 8																					
								PLOT DATE: <b>9/29/2009</b>																					
								DRAWN BY: <b>I. Shea</b>																					
								CHECKED BY: <b>J. Kelly</b>																					
								SHEET <b>83</b> OF <b>166</b>																					




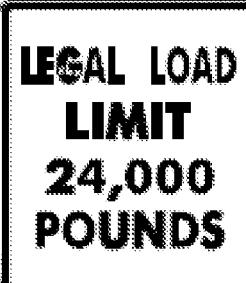


DIRECTION	MILEPOINT	LOCATION CODE (SHEET 2)	SIGN CODE	WIDTH (IN)	HEIGHT (IN)	SHEETING REMARKS	SIGN LEGEND	NEW SIGNS		EXISTING SIGNS				EXIST POST		NUMBER OF NEW POSTS	SQUARE STEEL (IN)			TUBULAR STEEL Ø (IN)				SIGN FRAME REQUIRED	REMARKS	SIGN DETAIL							
								"A"	"B"	RETAIN	SALVAGE FROM	SALVAGE TO	REMOVE	RETAIN	REMOVE		1.75	2.00	2.50	FOUNDATION	3.00	3.50	4.00			5.00	DETAIL IN SHS	DETAIL ON SHEET NUMBER	DETAIL ON STD SHEET NUMBER				
																	(LB / FT)				(LB / FT)												
																	1.88	2.42	3.35		7.60	9.00	10.80			14.60							
<b>MORRISTOWN VT 100</b>							FY-FLUORESCENT YELLOW FYG-FLUORESCENT YELLOW GREEN															"SHS"-STANDARD HIGHWAY SIGNS											
		K	OM1-1	18	18		YELLOW CLUSTER			1																							
SB	6.564	F	R3-7 L	30	30		LEFT LANE MUST TURN LEFT			1				X																			
SB	6.554	F	M3-3S	24	12		SOUTH			1				X																			
		F	M1-5	30	24		VERMONT 100			1																							
SB	6.523	F	D2-1	72	12		MORRISVILLE 1			1				X																			
		F	D2-1	72	12		STOWE 10			1																							
		F	D9-2	24	24		HOSPITAL SYMBOL			1														X									
SB	6.500	F	R2-1	24	30			5.00							1		X									INSTALL 125' +/- SOUTH OF PREVIOUS SIGN	X						
SB	6.470	G	VR-017	24	30		LEGAL LOAD LIMIT 24,000 LBS			1				X												GOODELL AVE. TH-84							
SB	6.462	H	R1-1	30	30		STOP			1				X												GOODELL AVE. TH-84							
SB	6.418	G	VR-017	24	24																						STRAFFORD AVE. TH-83						
		G	VR-017	24	30			5.00							1		X													E-141			
SB	6.411	H	R1-1	24	24																						STRAFFORD AVE. TH-83						
		H	R1-1	30	30			6.25							1		X								X								
SB	6.367	F	VR-932	48	30		LEFT "ONLY"/THRU/RIGHT "ONLY"			1				X																			
<b>SIGN SUMMARY SHEET</b>							SHEET TOTALS	16.25	0.00	10	0	0	2	0	0	3	45												PROJECT NAME: <b>Moretown-Newport Town VT100</b>				
								SF	SF	EA	EA	EA	EA	EA	EA	EA	EA	EA	EA	EA	EA	EA	EA	EA	EA	EA	EA	EA	EA	EA	EA	PROJECT NUMBER: <b>STPG SIGN(28)</b>	
VERMONT AGENCY OF TRANSPORTATION							TOWN TOTALS	369.7	0.0	77.0	5.0	5.0	65	0.0	0.0	68	1020.0									FILE NAME: <b>Morristown.xls</b>	PLOT DATE: <b>9/29/2009</b>						
																									PROJECT MANAGER: <b>N. Avery</b>	DRAWN BY: <b>I. Shea</b>							
																									DESIGNED BY: <b>D. Crosslev</b>	CHECKED BY: <b>J. Kelly</b>							
																										MORRISTOWN SHEET 9	SHEET <b>84</b> OF <b>166</b>						

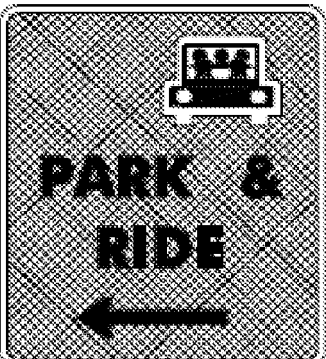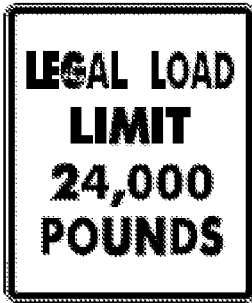




DIRECTION	MILEPOINT	LOCATION CODE (SHEET 2)	SIGN CODE	WIDTH (IN)	HEIGHT (IN)	SHEETING REMARKS	SIGN LEGEND	NEW SIGNS		EXISTING SIGNS				EXIST POST		NUMBER OF NEW POSTS	SQUARE STEEL (IN)			TUBULAR STEEL Ø (IN)				SIGN FRAME REQUIRED	REMARKS	SIGN DETAIL			
								"A"	"B"	RETAIN	SALVAGE FROM	SALVAGE TO	REMOVE	RETAIN	REMOVE		1.75	2.00	2.50	FOUNDATION	3.00	3.50	4.00			5.00	DETAIL IN SHS	DETAIL ON SHEET NUMBER	DETAIL ON STD SHEET NUMBER
																	(LB / FT)				(LB / FT)								
																	1.88	2.42	3.35		7.60	9.00	10.80			14.60			
<b>MORRISTOWN VT 100</b>							FY-FLUORESCENT YELLOW FYG-FLUORESCENT YELLOW GREEN														"SHS"-STANDARD HIGHWAY SIGNS								
SB	6.277	F	VD-062B	72	16		BUSINESS SIGN			1					X		2												
		F	VD-062B	72	16		BUSINESS SIGN			1																			
		F	VD-062B	72	16		BUSINESS SIGN			1																			
SB	6.252	G	VR-017	24	30		LEGAL LOAD LIMIT 24,000 LBS			1					X														
SB	6.246	H	R1-1	30	30		STOP			1					X														
SB	6.245	F	W3-5	36	36		SPEED REDUCTION SPEED LIMIT 25			1					X														
SB	6.194	F	VR-038	24	18		STATE HIGHWAY ENDS			1					X														
		F	R2-1	24	30								1		X														
		F	R2-1	30	36			7.50								1		X										6	
VILLAGE OF MORRISTOWN																													
SB	4.872	F	VR-039	24	18								1		X														
		F	R2-1	24	30								1																
		F	VR-039	24	18			3.00								1		X										6	
		F	R2-1	24	30			5.00																		X			
SB	4.790	F	R2-1	24	30		SPEED LIMIT 35			1					X														
<b>SIGN SUMMARY SHEET</b>							SHEET TOTALS			15.50	0.00	8	0	0	3	0	0	2	30					PROJECT NAME: <b>Moretown-Newport Town VT100</b>					
										SF	SF	EA	EA	EA	EA	EA	EA	EA	FT					PROJECT NUMBER: <b>STPG SIGN(28)</b>					
VERMONT AGENCY OF TRANSPORTATION							TOWN TOTALS			369.7	0.0	77.0	5.0	5.0	65	0.0	0.0	68	1020.0					FILE NAME: <b>Morristown.xls</b> PLOT DATE: <b>9/29/2009</b>					
																							PROJECT MANAGER: <b>N. Avery</b> DRAWN BY: <b>I. Shea</b>						
																							DESIGNED BY: <b>D. Crosslev</b> CHECKED BY: <b>J. Kelly</b>						
																							MORRISTOWN SHEET 10 SHEET <b>85</b> OF <b>166</b>						

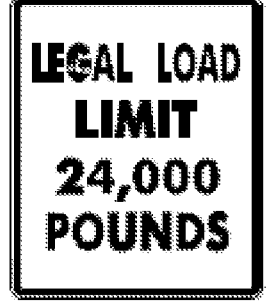
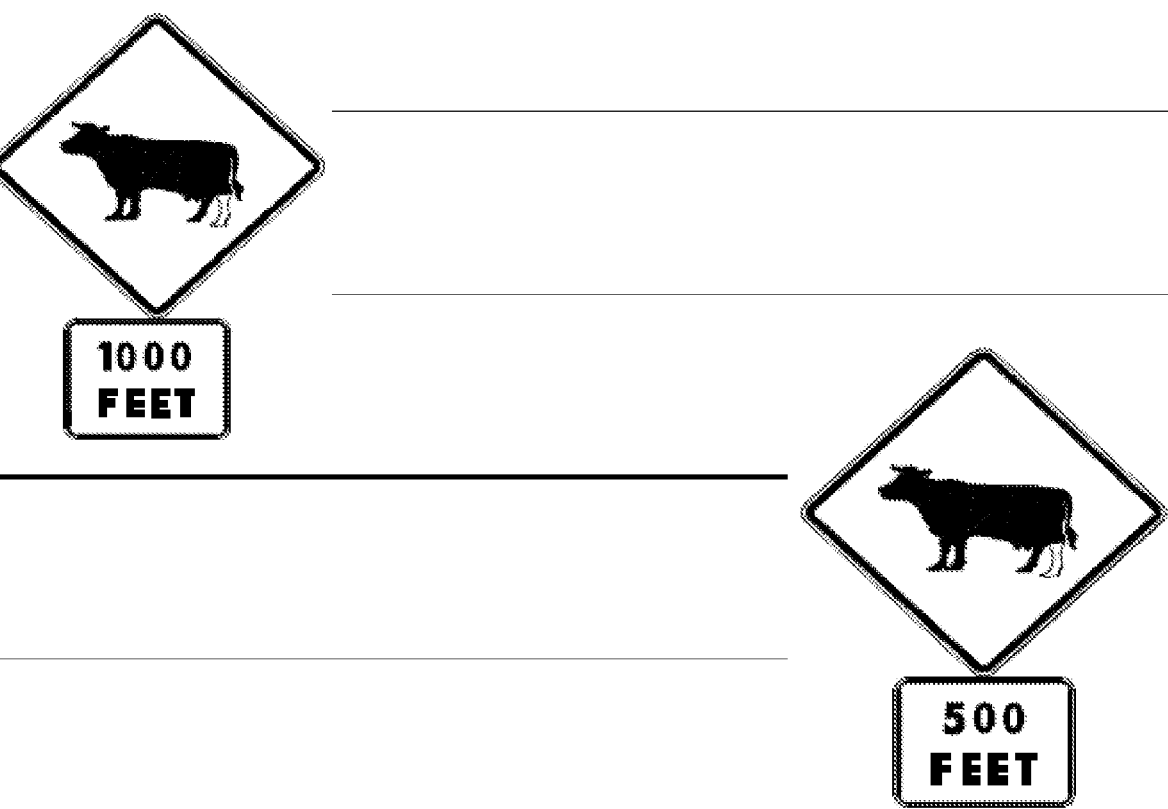
DIRECTION	MILEPOINT	LOCATION CODE (SHEET 2)	SIGN CODE	WIDTH (IN)	HEIGHT (IN)	SHEETING REMARKS	SIGN LEGEND	NEW SIGNS		EXISTING SIGNS				EXIST POST		NUMBER OF NEW POSTS	SQUARE STEEL (IN)			TUBULAR STEEL Ø (IN)				SIGN FRAME REQUIRED	REMARKS	SIGN DETAIL													
								"A"	"B"	RETAIN	SALVAGE FROM	SALVAGE TO	REMOVE	RETAIN	REMOVE		(LB / FT)			(LB / FT)						DETAIL IN SHS	DETAIL ON SHEET NUMBER	DETAIL ON STD SHEET NUMBER											
																	1.75	2.00	2.50	FOUNDATION	3.00	3.50	4.00						5.00										
<b>MORRISTOWN VT 100</b>							FY-FLUORESCENT YELLOW FYG-FLUORESCENT YELLOW GREEN															"SHS"-STANDARD HIGHWAY SIGNS																	
SB	4.771	F	S1-1YG	36	36		SCHOOL			1				X																									
		F	W16-9YG	30	18		AHEAD			1																													
SB	4.724	F	D1-1 E	72	20																																		
		F	D1-1	72	20				10.00							2		X										5											
SB	4.666	F	W1-2L	30	30		LEFT CURVE																																
		F	M3-3	24	12																																		
		F	M1-5	30	24				2.00						1		X																						
SB	4.617	F	M3-3S	24	12		SOUTH																																
		F	M1-5	30	24		VT 100																																
		F	W1-2L	30	30																																		
		F	W1-2L	30	30				6.25							1		X										X											
SB	4.600	F	VD-062B	72	16		BUSINESS SIGN			1				X																									
		F	VD-062AL	72	16		BUSINESS SIGN			1																													
		F	VD-062B	72	16		BUSINESS SIGN			1																													
SB	4.544	F	R2-1	24	30																																		
		F	R2-1	24	30				5.00							1		X																					
<b>SIGN SUMMARY SHEET</b>							SHEET TOTALS	28.25	0.00	5	0	0	5	0	0	5		75																					
								SF	SF	EA	EA	EA	EA	EA	EA	EA	EA	EA	EA	EA	EA	EA	EA	EA	EA	EA	EA	EA	EA	EA	EA	EA	EA	EA	EA				
VERMONT AGENCY OF TRANSPORTATION							TOWN TOTALS	369.7	0.0	77.0	5.0	5.0	65	0.0	0.0	68		1020.0																					
							PROJECT NAME:	<b>Moretown-Newport Town VT100</b>																															
							PROJECT NUMBER:	<b>STPG SIGN(28)</b>																															
							FILE NAME:	<b>Morristown.xls</b>										PLOT DATE:	<b>9/29/2009</b>																				
							PROJECT MANAGER:	<b>N. Avery</b>										DRAWN BY:	<b>I. Shea</b>																				
							DESIGNED BY:	<b>D. Crosslev</b>										CHECKED BY:	<b>J. Kelly</b>																				
							MORRISTOWN SHEET	<b>11</b>										SHEET	<b>86</b>										OF	<b>166</b>									

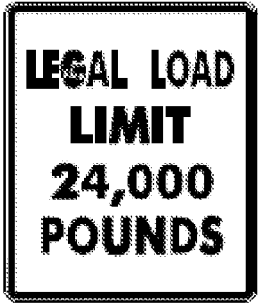DIRECTION	MILEPOINT	LOCATION CODE (SHEET 2)	SIGN CODE	WIDTH (IN)	HEIGHT (IN)	SHEETING REMARKS	SIGN LEGEND	NEW SIGNS		EXISTING SIGNS				EXIST POST		NUMBER OF NEW POSTS	SQUARE STEEL (IN)			TUBULAR STEEL Ø (IN)				SIGN FRAME REQUIRED	REMARKS	SIGN DETAIL			
								"A"	"B"	RETAIN	SALVAGE FROM	SALVAGE TO	REMOVE	RETAIN	REMOVE		1.75	2.00	2.50	FOUNDATION	3.00	3.50	4.00			5.00	DETAIL IN SHS	DETAIL ON SHEET NUMBER	DETAIL ON STD SHEET NUMBER
																	(LB / FT)				(LB / FT)								
<b>MORRISTOWN VT 100</b>							FY-FLUORESCENT YELLOW FYG-FLUORESCENT YELLOW GREEN																"SHS"-STANDARD HIGHWAY SIGNS						
SB	4.406	G	VR-017	24	30																			MORRISTOWN CORNERS RD TH-2					
		G	VR-017	24	30			5.00							1		X										E-141		
SB	4.398	H	R1-1	30	30																				MORRISTOWN CORNERS RD TH-2				
		H	R1-1	30	30			6.25							1		X									X			
SB	4.374	F	R2-1	24	30		SPEED LIMIT 40			1							X												
SB	4.340	G	VR-017	24	30			5.00							1		X								MILLER BRIDGE RD TH-42			E-141	
SB	4.334	H	R1-1	30	30																				MILLER BRIDGE RD TH-42				
		H	R1-1	30	30			6.25							1		X									X			
SB	4.242	F	R2-1	24	30		SPEED LIMIT 50			1							X												
SB	3.912	F	VW-054R	30	30		HIDDEN DRIVE RIGHT																						
SB	3.492	F	W2-2MR	30	30		RIGHT SIDE ROAD			1							X												
SB	3.411	G	VR-017	24	30																								
		G	VR-017	24	30			5.00							1		X											E-141	
SB	3.401	H	R1-1	30	30																								
		H	R1-1	30	30			6.25							1		X										X		
<b>SIGN SUMMARY SHEET</b>							SHEET TOTALS	33.75	0.00	3	0	0	6	0	0	6		90								PROJECT NAME: <b>Moretown-Newport Town VT100</b>			
								SF	SF	EA	EA	EA	EA	EA	EA	EA		FT								PROJECT NUMBER: <b>STPG SIGN(28)</b>			
VERMONT AGENCY OF TRANSPORTATION							TOWN TOTALS	369.7	0.0	77.0	5.0	5.0	65	0.0	0.0	68		1020.0								FILE NAME: <b>Morristown.xls</b> PLOT DATE: <b>9/29/2009</b>			
																									PROJECT MANAGER: <b>N. Avery</b> DRAWN BY: <b>I. Shea</b>				
																									DESIGNED BY: <b>D. Crosslev</b> CHECKED BY: <b>J. Kelly</b>				
																									MORRISTOWN SHEET 12 SHEET <b>87</b> OF <b>166</b>				





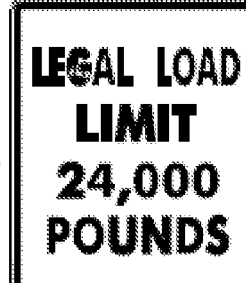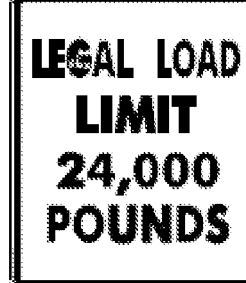


DIRECTION	MILEPOINT	LOCATION CODE (SHEET 2)	SIGN CODE	WIDTH (IN)	HEIGHT (IN)	SHEETING REMARKS	SIGN LEGEND	NEW SIGNS		EXISTING SIGNS				EXIST POST		NUMBER OF NEW POSTS	SQUARE STEEL (IN)			TUBULAR STEEL Ø (IN)				SIGN FRAME REQUIRED	REMARKS	SIGN DETAIL			
								"A"	"B"	RETAIN	SALVAGE FROM	SALVAGE TO	REMOVE	RETAIN	REMOVE		1.75	2.00	2.50	FOUNDATION	3.00	3.50	4.00			5.00	DETAIL IN SHS	DETAIL ON SHEET NUMBER	DETAIL ON STD SHEET NUMBER
																	(LB / FT)				(LB / FT)								
<b>MORRISTOWN VT 100</b>							FY-FLUORESCENT YELLOW FYG-FLUORESCENT YELLOW GREEN																"SHS"-STANDARD HIGHWAY SIGNS						
SB	3.363	F	R2-1	24	30																								
		F	R2-1	24	30			5.00																	X				
SB	3.148	F	D1-1M	72	10																								
		F	D1-1	72	12			6.00																			5		
SB	3.072	F	D4-2	30	36																								
		F	D4-2	30	36			7.50																	X				
SB	2.655	F	W2-2MR	30	30		RIGHT SIDE ROAD																						
		F	VW-054L	30	30		HIDDEN DRIVE LEFT																						
SB	2.620	F	S3-1	30	30		SCHOOL BUS STOP AHEAD																						
SB	2.532	G	VR-017	30	30																								
		G	VR-017	24	30			5.00																			E-141		
SB	2.524	H	R1-1	30	30																								
		H	R1-1	30	30			6.25																	X				
SB	2.286	F	VD-062B	72	16		BUSINESS SIGN			1																			
SB	2.244	G	VR-017	24	30																								
<b>SIGN SUMMARY SHEET</b>							SHEET TOTALS	29.75	0.00	1	0	0	9	0	0	6	90									PROJECT NAME: <b>Moretown-Newport Town VT100</b>			
								SF	SF	EA	EA	EA	EA	EA	EA	EA	EA	EA	EA	EA	EA	FT							PROJECT NUMBER: <b>STPG SIGN(28)</b>
VERMONT AGENCY OF TRANSPORTATION							TOWN TOTALS	369.7	0.0	77.0	5.0	5.0	65	0.0	0.0	68	1020.0							FILE NAME: <b>Morristown.xls</b>					
																							PLOT DATE: <b>9/29/2009</b>						
																								DRAWN BY: <b>I. Shea</b>					
																								CHECKED BY: <b>J. Kelly</b>					
																								SHEET <b>88</b> OF <b>166</b>					

DIRECTION	MILEPOINT	LOCATION CODE (SHEET 2)	SIGN CODE	WIDTH (IN)	HEIGHT (IN)	SHEETING REMARKS	SIGN LEGEND	NEW SIGNS		EXISTING SIGNS				EXIST POST		NUMBER OF NEW POSTS	SQUARE STEEL (IN)			TUBULAR STEEL Ø (IN)				SIGN FRAME REQUIRED	REMARKS	SIGN DETAIL			
								"A"	"B"	RETAIN	SALVAGE FROM	SALVAGE TO	REMOVE	RETAIN	REMOVE		1.75	2.00	2.50	FOUNDATION	3.00	3.50	4.00			5.00	DETAIL IN SHS	DETAIL ON SHEET NUMBER	DETAIL ON STD SHEET NUMBER
																	(LB / FT)				(LB / FT)								
<b>MORRISTOWN VT 100</b>							FY-FLUORESCENT YELLOW FYG-FLUORESCENT YELLOW GREEN																"SHS"-STANDARD HIGHWAY SIGNS						
		G	VR-017	24	30			5.00							1		X										E-141		
SB	2.238	H	R1-1	30	30																						GOLF COURSE RD TH-55		
		H	R1-1	30	30			6.25							1		X										X		
SB	1.957	F	VD-062B	72	16		BUSINESS SIGN				1						X												
SB	1.780	F	W11-7	30	30		EQUESTRIAN				1						X												
SB	1.760	F	W2-2ML	30	30		MODIFIED LEFT SIDE ROAD				1						X												
			W16-8A	30	8			1.67																			8		
SB	1.529	G	VR-017	24	30																						RYDER BROOK RD TH-115		
		G	VR-017	24	30			5.00							1		X										E-141		
SB	1.523	H	R1-1	30	30																						RYDER BROOK RD TH-115		
		H	R1-1	30	30			6.25							1		X									X			
SB	1.183	F	W1-2R	30	30		RIGHT CURVE MODIFIED																						
		F	W13-1	18	18		40 MPH PLAQUE																						
SB	1.122	F	VW-054R	30	30		HIDDEN DRIVE RIGHT																						
																													
SB	1.085	F	VW-054R	30	30			6.25							1		X										INSTALL 200 +/- SOUTH OF ORIGINAL SIGN LOCATION		
<b>SIGN SUMMARY SHEET</b>							SHEET TOTALS	30.42	0.00	3	0	0	6	0	0	5		75										PROJECT NAME: <b>Moretown-Newport Town VT100</b>	
								SF	SF	EA	EA	EA	EA	EA	EA	EA		FT										PROJECT NUMBER: <b>STPG SIGN(28)</b>	
VERMONT AGENCY OF TRANSPORTATION							TOWN TOTALS	369.7	0.0	77.0	5.0	5.0	65	0.0	0.0	68		1020.0										FILE NAME: <b>Morristown.xls</b>	
																												PLOT DATE: <b>9/29/2009</b>	
																												PROJECT MANAGER: <b>N. Avery</b>	
																												DRAWN BY: <b>I. Shea</b>	
																												DESIGNED BY: <b>D. Crosslev</b>	
																												CHECKED BY: <b>J. Kelly</b>	
																												SHEET <b>89</b> OF <b>166</b>	


DIRECTION	MILEPOINT	LOCATION CODE (SHEET 2)	SIGN CODE	WIDTH (IN)	HEIGHT (IN)	SHEETING REMARKS	SIGN LEGEND	NEW SIGNS		EXISTING SIGNS				EXIST POST		NUMBER OF NEW POSTS	SQUARE STEEL (IN)			TUBULAR STEEL Ø (IN)				SIGN FRAME REQUIRED	REMARKS	SIGN DETAIL			
								"A"	"B"	RETAIN	SALVAGE FROM	SALVAGE TO	REMOVE	RETAIN	REMOVE		1.75	2.00	2.50	FOUNDATION	3.00	3.50	4.00			5.00	DETAIL IN SHS	DETAIL ON SHEET NUMBER	DETAIL ON STD SHEET NUMBER
																	(LB / FT)				(LB / FT)								
<b>MORRISTOWN VT 100</b>							FY-FLUORESCENT YELLOW FYG-FLUORESCENT YELLOW GREEN																"SHS"-STANDARD HIGHWAY SIGNS						
SB	1.057	F	W1-2R	30	30			6.25						1		X								INSTALL 150' +/- SOUTH OF NEW HIDDEN DRIVE RIGHT SIGN	X				
		F	W13-1	24	24			4.00																	X				
SB	0.760	G	VR-017	24	30																			VANASSE RD TH-87					
		G	VR-017	24	30			5.00						1		X											E-141		
SB	0.754	H	R1-1	30	30		STOP			1														VANASSE RD TH-87					
SB	0.634	G	VR-017	24	30																			LAWRENCE RD TH-71					
		G	VR-017	24	30			5.00						1		X											E-141		
SB	0.627	H	R1-1	30	30																			LAWRENCE RD TH-71					
		H	R1-1	30	30			6.25						1		X										X			
SB	0.000	G	VD-024	60	7.5		STOWE/MORRISTOWN																						
<b>SIGN SUMMARY SHEET</b>								SHEET TOTALS				26.50	0.00	1	0	0	4	0	0	4	60					PROJECT NAME: <b>Moretown-Newport Town VT100</b>			
								SF	SF	EA	EA	EA	EA	EA	EA	EA	EA	EA	EA	EA	EA	EA	EA	EA	FT				
VERMONT AGENCY OF TRANSPORTATION								TOWN TOTALS				369.7	0.0	77.0	5.0	5.0	65	0.0	0.0	68	1020.0					FILE NAME: <b>Morristown.xls</b> PLOT DATE: <b>9/29/2009</b>			
																				PROJECT MANAGER: <b>N. Avery</b> DRAWN BY: <b>I. Shea</b>									
																				DESIGNED BY: <b>D. Crosslev</b> CHECKED BY: <b>J. Kelly</b>									
																				MORRISTOWN SHEET 15 SHEET <b>90</b> OF <b>166</b>									



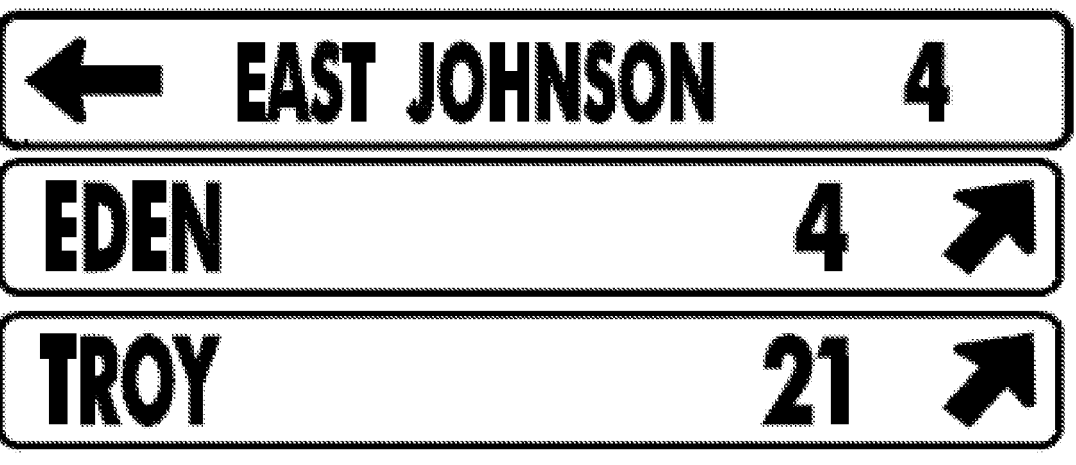
DIRECTION	MILEPOINT	LOCATION CODE (SHEET 2)	SIGN CODE	WIDTH (IN)	HEIGHT (IN)	SHEETING REMARKS	SIGN LEGEND	NEW SIGNS		EXISTING SIGNS				EXIST POST		NUMBER OF NEW POSTS	SQUARE STEEL (IN)			TUBULAR STEEL Ø (IN)				SIGN FRAME REQUIRED	REMARKS	SIGN DETAIL		
								"A"	"B"	RETAIN	SALVAGE FROM	SALVAGE TO	REMOVE	RETAIN	REMOVE		(LB / FT)			(LB / FT)						DETAIL IN SHS	DETAIL ON SHEET NUMBER	DETAIL ON STD SHEET NUMBER
																	1.75	2.00	2.50	3.00	3.50	4.00	5.00					
<b>HYDE PARK VT 100</b>							FY-FLUORESCENT YELLOW FYG-FLUORESCENT YELLOW GREEN															"SHS"-STANDARD HIGHWAY SIGNS						
NB	0.017	B	R1-1	36	36		STOP			1				X														
NB	0.062	A	M3-1S	24	12		NORTH			1				X														
		A	M1-5	30	24		VERMONT 100			1																		
NB	0.098	A	D2-1	72	10							1		X														
		A	D2-1	72	10								1															
		A	D2-1	72	12				6.00							2		X									5	
		A	D2-1	72	12				6.00																		5	
NB	0.140	A	R2-1	24	30		SPEED LIMIT 50			1				X														
NB	0.234	B	W3-1	36	36		STOP AHEAD			1				X														
NB	0.810	A	W11-4	30	30							1		X														
		A	W16-2	24	18								1															
		A	W11-4	30	30	FY			6.25							1		X								X		
		A	W16-2	24	18	FY			3.00																	X		
NB	0.897	A	W11-4	30	30	FY		6.25							1		X								X			
		A	W16-2	24	18	FY		3.00																	X			
<b>SIGN SUMMARY SHEET</b>							SHEET TOTALS	30.50	0.00	5	0	0	4	0	0	4	60									PROJECT NAME: <b>Moretown-Newport Town VT100</b>		
								SF	SF	EA	EA	EA	EA	EA	EA	EA	EA	EA	EA	EA	EA	FT						
VERMONT AGENCY OF TRANSPORTATION							TOWN TOTALS	287.3	0.0	80.0	0.0	0.0	54	0.0	0.0	42	630.0								FILE NAME: <b>Hyde Park.xls</b>	PLOT DATE: <b>9/29/2009</b>		
																								PROJECT MANAGER: <b>N. Avery</b>	DRAWN BY: <b>I. Shea</b>			
																									DESIGNED BY: <b>D. Crosslev</b>	CHECKED BY: <b>J. Kelly</b>		
																									HYDE PARK SHEET 1	SHEET <b>91</b> OF <b>166</b>		

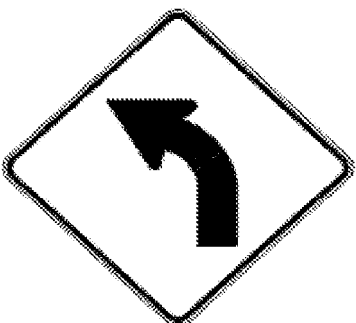



DIRECTION	MILEPOINT	LOCATION CODE (SHEET 2)	SIGN CODE	WIDTH (IN)	HEIGHT (IN)	SHEETING REMARKS	SIGN LEGEND	NEW SIGNS		EXISTING SIGNS				EXIST POST		NUMBER OF NEW POSTS	SQUARE STEEL (IN)			TUBULAR STEEL Ø (IN)				SIGN FRAME REQUIRED	REMARKS	SIGN DETAIL			
								"A"	"B"	RETAIN	SALVAGE FROM	SALVAGE TO	REMOVE	RETAIN	REMOVE		1.75	2.00	2.50	FOUNDATION	3.00	3.50	4.00			5.00	DETAIL IN SHS	DETAIL ON SHEET NUMBER	DETAIL ON STD SHEET NUMBER
																	(LB / FT)				(LB / FT)								

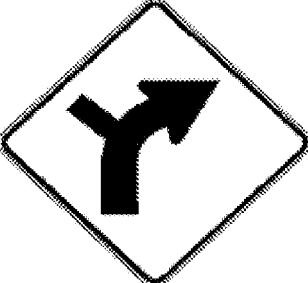

<b>HYDE PARK VT 100</b>							FY-FLUORESCENT YELLOW FYG-FLUORESCENT YELLOW GREEN																"SHS"-STANDARD HIGHWAY SIGNS							
NB	1.660	A	VW-202	30	30		TRUCKS ENTERING																							
NB	1.750	A	VW-202	30	30				6.25																		INSTALL 475' +/- NORTH OF ORIGINAL SIGN LOCATION			E-154
NB	2.590	A	VD-062B	72	16		BUSINESS SIGN				1																			
NB	2.730	C	VR-017	24	30																									
		C	VR-017	24	30				5.00																				E-141	
NB	2.738	D	R1-1	30	30																									
		D	R1-1	30	30				6.25																				X	
NB	2.860	A	W1-2L	30	30		LEFT CURVE																							
NB	2.890	A	VW-054L	30	30		HIDDEN DRIVE LEFT																							
NB	2.920	A	W1-2L	30	30																									
																														
NB	2.950	A	VW-054L	30	30				6.25																					
NB	3.756	C	VR-017	24	30																									
		C	VR-017	24	30				5.00																					E-141
NB	3.750	D	R1-1	30	30																									
		D	R1-1	30	30				6.25																					X




<b>SIGN SUMMARY SHEET</b>							SHEET TOTALS										PROJECT NAME: <b>Moretown-Newport Town VT100</b>												
							41.25	0.00	1	0	0	7	0	0	7	105	PROJECT NUMBER: <b>STPG SIGN(28)</b>												
VERMONT AGENCY OF TRANSPORTATION							SF	SF	EA	EA	EA	EA	EA	EA	EA	FT	FILE NAME: <b>Hyde Park.xls</b> PLOT DATE: <b>9/29/2009</b>												
							TOWN TOTALS										287.3	0.0	80.0	0.0	0.0	54	0.0	0.0	42	630.0	PROJECT MANAGER: <b>N. Avery</b> DRAWN BY: <b>I. Shea</b>		
																	DESIGNED BY: <b>D. Crosslev</b> CHECKED BY: <b>J. Kelly</b>												
																	HYDE PARK SHEET 2 SHEET <b>92</b> OF <b>166</b>												

DIRECTION	MILEPOINT	LOCATION CODE (SHEET 2)	SIGN CODE	WIDTH (IN)	HEIGHT (IN)	SHEETING REMARKS	SIGN LEGEND	NEW SIGNS		EXISTING SIGNS				EXIST POST		NUMBER OF NEW POSTS	SQUARE STEEL (IN)			TUBULAR STEEL Ø (IN)				SIGN FRAME REQUIRED	REMARKS	SIGN DETAIL			
								"A"	"B"	RETAIN	SALVAGE FROM	SALVAGE TO	REMOVE	RETAIN	REMOVE		1.75	2.00	2.50	FOUNDATION	3.00	3.50	4.00			5.00	DETAIL IN SHS	DETAIL ON SHEET NUMBER	DETAIL ON STD SHEET NUMBER
																	(LB / FT)				(LB / FT)								
																	1.88	2.42	3.35		7.60	9.00	10.80			14.60			
<b>HYDE PARK VT 100</b>							FY-FLUORESCENT YELLOW FYG-FLUORESCENT YELLOW GREEN															"SHS"-STANDARD HIGHWAY SIGNS							
NB	3.875	A	W2-2MaL	30	30		LEFT SIDE ROAD			1				X															
		A	W16-8	24	8		WHITAKER RD			1				X															
NB	4.747	A	VD-018	30	18																								
		A	VD-018	30	18			3.75								1			X									E-128B	
NB	4.783	A	W3-5	36	36		SPEED REDUCTION SPEED LIMIT 40			1				X															
NB	4.822	A	W2-2MaL	30	30		LEFT SIDE ROAD			1				X															
		A	W16-8	24	8		WILSON RD			1																			
NB	4.861	A	R2-1	30	36		SPEED LIMIT 40			1				X															
NB	4.894	A	M2-1S	21	15		JCT			1				X															
		A	M1-5	30	24		ROUTE 100C			1																			
NB	4.933	A	W11-2YG	30	30		PEDESTRIAN			1				X															
		A	W11-2PBYG	24	18		BLIND PERSON			1																			
NB	4.970	A	W1-1MaR	30	30		MODIFIED RIGHT TURN																						
		A	W13-1	18	18		30 MPH PLAQUE																						
NB	5.020	A	VW-054R	30	30		HIDDEN DRIVE RIGHT																						
<b>SIGN SUMMARY SHEET</b>							SHEET TOTALS				3.75	0.00	10	0	0	4	0	0	1	15	PROJECT NAME: <b>Moretown-Newport Town VT100</b>								
											SF	SF	EA	EA	EA	EA	EA	EA	EA	FT	PROJECT NUMBER: <b>STPG SIGN(28)</b>								
VERMONT AGENCY OF TRANSPORTATION							TOWN TOTALS				287.3	0.0	80.0	0.0	0.0	54	0.0	0.0	42	630.0	FILE NAME: <b>Hyde Park.xls</b> PLOT DATE: <b>9/29/2009</b>								
																					PROJECT MANAGER: <b>N. Avery</b> DRAWN BY: <b>I. Shea</b>								
																					DESIGNED BY: <b>D. Crosslev</b> CHECKED BY: <b>J. Kelly</b>								
																					HYDE PARK SHEET 3 SHEET <b>93</b> OF <b>166</b>								




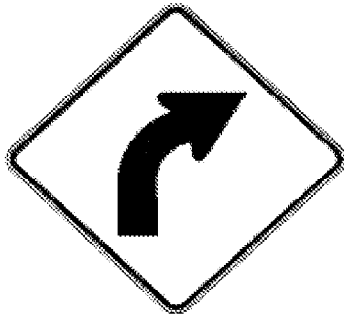


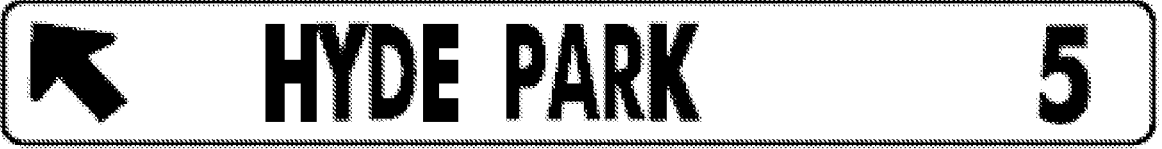DIRECTION	MILEPOINT	LOCATION CODE (SHEET 2)	SIGN CODE	WIDTH (IN)	HEIGHT (IN)	SHEETING REMARKS	SIGN LEGEND	NEW SIGNS		EXISTING SIGNS				EXIST POST		NUMBER OF NEW POSTS	SQUARE STEEL (IN)			TUBULAR STEEL Ø (IN)				SIGN FRAME REQUIRED	REMARKS	SIGN DETAIL			
								"A"	"B"	RETAIN	SALVAGE FROM	SALVAGE TO	REMOVE	RETAIN	REMOVE		1.75	2.00	2.50	FOUNDATION	3.00	3.50	4.00			5.00	DETAIL IN SHS	DETAIL ON SHEET NUMBER	DETAIL ON STD SHEET NUMBER
																	(LB / FT)				(LB / FT)								
<b>HYDE PARK VT 100</b>							FY-FLUORESCENT YELLOW FYG-FLUORESCENT YELLOW GREEN															"SHS"-STANDARD HIGHWAY SIGNS							
NB	5.040	A	W1-10 R	30	30		 	6.25							1		X							INSTALL 100' +/- NORTH OF REMOVED HIDDEN DRIVE RIGHT SIGN	X				
			W13-1	24	24			4.00																	X				
NB	5.067	A	D1-1A	72	10							1																	
		A	D1-1A	72	10							1																	
		A	D1-1	72	10							1																	
		A	D1-1	72	12				6.00						2		X											5	
		A	D1-1	72	12				6.00																			5	
		A	D1-1	72	12			6.00																			5		
NB	5.086	A	R2-1	30	36		SPEED LIMIT 35			1																			
NB	5.120	A	M3-3S	24	12		SOUTH			1																			
		A	M1-5	30	24		VERMONT 100C			1																			
		A	M6-1S	21	15		<--- LEFT			1																			
		A	M3-1S	24	12		NORTH			1																			
		A	M1-5	30	24		VERMONT 100			1																			
		A	M6-2S	21	15		RIGHT ---> (45 DEG)			1																			
<b>SIGN SUMMARY SHEET</b>							SHEET TOTALS	28.25	0.00	7	0	0	3	0	0	3	45						PROJECT NAME: <b>Moretown-Newport Town VT100</b>						
								SF	SF	EA	EA	EA	EA	EA	EA	EA	EA	EA	EA	EA	EA	EA	EA	EA	EA	EA	PROJECT NUMBER: <b>STPG SIGN(28)</b>		
VERMONT AGENCY OF TRANSPORTATION							TOWN TOTALS	287.3	0.0	80.0	0.0	0.0	54	0.0	0.0	42	630.0						FILE NAME: <b>Hyde Park.xls</b>	PLOT DATE: <b>9/29/2009</b>					
																					PROJECT MANAGER: <b>N. Avery</b>	DRAWN BY: <b>I. Shea</b>							
																					DESIGNED BY: <b>D. Crosslev</b>	CHECKED BY: <b>J. Kelly</b>							
																					HYDE PARK SHEET 4	SHEET <b>94</b> OF <b>166</b>							







DIRECTION	MILEPOINT	LOCATION CODE (SHEET 2)	SIGN CODE	WIDTH (IN)	HEIGHT (IN)	SHEETING REMARKS	SIGN LEGEND	NEW SIGNS		EXISTING SIGNS				EXIST POST		NUMBER OF NEW POSTS	SQUARE STEEL (IN)			TUBULAR STEEL Ø (IN)				SIGN FRAME REQUIRED	REMARKS	SIGN DETAIL												
								"A"	"B"	RETAIN	SALVAGE FROM	SALVAGE TO	REMOVE	RETAIN	REMOVE		1.75	2.00	2.50	FOUNDATION	3.00	3.50	4.00			5.00	DETAIL IN SHS	DETAIL ON SHEET NUMBER	DETAIL ON STD SHEET NUMBER									
																	(LB / FT)				(LB / FT)																	
<b>HYDE PARK VT 100</b>							FY-FLUORESCENT YELLOW FYG-FLUORESCENT YELLOW GREEN															"SHS"-STANDARD HIGHWAY SIGNS																
NB	5.139	C	W1-7	48	24		<====> DOUBLE ARROW	8.00		+				X		2		X																				
NB	5.177	A	M3-1S	24	12		NORTH			1				X																								
		A	M1-5	30	24		VERMONT 100			1																												
NB	5.196	A	D2-1	72	10								1		X																							
		A	D2-1	72	10								1																									
		A	D2-1	72	12			6.00								2		X									5											
		A	D2-1	72	12			6.00																				5										
NB	5.232	A	R2-1	24	30		SPEED LIMIT 35			1				X																								
NB	5.330	A	VD-062B	72	16		BUSINESS SIGNS			1				X																								
		A	VD-062B	72	16		BUSINESS SIGNS			1																												
NB	5.551	C	VR-017	24	30																																	
		C	VR-017	24	30			5.00								1		X										E-141										
		D	R1-1	30	30			6.25								1		X																				
NB	5.605	A	R2-1	24	30		SPEED LIMIT 35			1				X																								
NB	5.789	A	R2-1	24	30		SPEED LIMIT 50			1				X																								
<b>SIGN SUMMARY SHEET</b>							SHEET TOTALS	23.25	0.00	8	0	0	3	0	0	4	60																					
								SF	SF	EA	EA	EA	EA	EA	EA	EA	EA	EA	EA	EA	EA	EA	EA	EA	EA	EA	EA	EA	EA	EA	EA	EA	EA	EA				
VERMONT AGENCY OF TRANSPORTATION							TOWN TOTALS	287.3	0.0	80.0	0.0	0.0	54	0.0	0.0	42	630.0																					
PROJECT NAME: <b>Moretown-Newport Town VT100</b>																					PROJECT NUMBER: <b>STPG SIGN(28)</b>						FILE NAME: <b>Hyde Park.xls</b>						PLOT DATE: <b>9/29/2009</b>					
PROJECT MANAGER: <b>N. Avery</b>																					DRAWN BY: <b>I. Shea</b>						DESIGNED BY: <b>D. Crosslev</b>						CHECKED BY: <b>J. Kelly</b>					
HYDE PARK SHEET 5																					SHEET <b>95</b> OF <b>166</b>																	




DIRECTION	MILEPOINT	LOCATION CODE (SHEET 2)	SIGN CODE	WIDTH (IN)	HEIGHT (IN)	SHEETING REMARKS	SIGN LEGEND	NEW SIGNS		EXISTING SIGNS				EXIST POST		NUMBER OF NEW POSTS	SQUARE STEEL (IN)			TUBULAR STEEL Ø (IN)				SIGN FRAME REQUIRED	REMARKS	SIGN DETAIL																									
								"A"	"B"	RETAIN	SALVAGE FROM	SALVAGE TO	REMOVE	RETAIN	REMOVE		1.75	2.00	2.50	FOUNDATION	3.00	3.50	4.00			5.00	DETAIL IN SHS	DETAIL ON SHEET NUMBER	DETAIL ON STD SHEET NUMBER																						
																	(LB / FT)				(LB / FT)																														
<b>HYDE PARK VT 100</b>							FY-FLUORESCENT YELLOW FYG-FLUORESCENT YELLOW GREEN																"SHS"-STANDARD HIGHWAY SIGNS																												
SB	5.956	F	VD-062B	72	16		BUSINESS SIGN			1				X																																					
		F	VD-062B	72	16		BUSINESS SIGN			1																																									
SB	5.899	F	W3-5	36	36		SPEED REDUCTION SPEED LIMIT 35			1				X																																					
SB	5.844	E	VD-018	30	18																																														
		E	VD-018	30	18				3.75							1				X																															
SB	5.790	F	R2-1	30	36		SPEED LIMIT 35			1				X																																					
SB	5.758	G	VR-017	24	30																																														
		G	VR-017	24	30				5.00							1				X										E-141																					
SB	5.750	H	R1-1	30	30		STOP			1				X																																					
SB	5.680	F	R2-1	24	30		SPEED LIMIT 35			1				X																																					
SB	5.605	F	W11-2YG	30	30		PEDESTRIAN			1				X																																					
		F	W11-2PBYG	24	18		BLIND PERSON			1																																									
SB	5.408	F	R2-1	24	30		SPEED LIMIT 35			1				X																																					
SB	5.274	F	W1-10L	30	30		MODIFIED LEFT CURVE																																												
		F	W13-1	18	18		30 MPH PLAQUE																																												
<b>SIGN SUMMARY SHEET</b>							SHEET TOTALS											8.75	0.00	9	0	0	4	0	0	2	30																								
							SF	SF	EA	EA	EA	EA	EA	EA	EA	EA	EA																																		
VERMONT AGENCY OF TRANSPORTATION							TOWN TOTALS											287.3	0.0	80.0	0.0	0.0	54	0.0	0.0	42	630.0																								
																						PROJECT NAME: <b>Moretown-Newport Town VT100</b>						PROJECT NUMBER: <b>STPG SIGN(28)</b>						FILE NAME: <b>Hyde Park.xls</b>						PLOT DATE: <b>9/29/2009</b>											
																						PROJECT MANAGER: <b>N. Avery</b>						DESIGNED BY: <b>D. Crosslev</b>						HYDE PARK SHEET <b>6</b>						DRAWN BY: <b>I. Shea</b>						CHECKED BY: <b>J. Kelly</b>					
																																								SHEET <b>96</b> OF <b>166</b>											





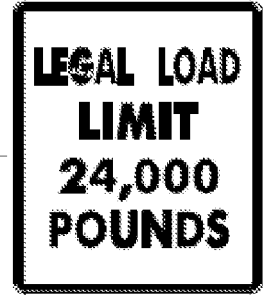

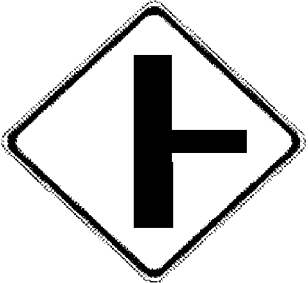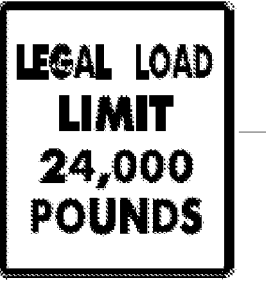DIRECTION	MILEPOINT	LOCATION CODE (SHEET 2)	SIGN CODE	WIDTH (IN)	HEIGHT (IN)	SHEETING REMARKS	SIGN LEGEND	NEW SIGNS		EXISTING SIGNS				EXIST POST		NUMBER OF NEW POSTS	SQUARE STEEL (IN)			TUBULAR STEEL Ø (IN)				SIGN FRAME REQUIRED	REMARKS	SIGN DETAIL																	
								"A"	"B"	RETAIN	SALVAGE FROM	SALVAGE TO	REMOVE	RETAIN	REMOVE		1.75	2.00	2.50	FOUNDATION	3.00	3.50	4.00			5.00	DETAIL IN SHS	DETAIL ON SHEET NUMBER	DETAIL ON STD SHEET NUMBER														
																	(LB / FT)				(LB / FT)																						
<b>HYDE PARK VT 100</b>							FY-FLUORESCENT YELLOW FYG-FLUORESCENT YELLOW GREEN																"SHS"-STANDARD HIGHWAY SIGNS																				
SB	5.234	F	M2-1S	21	15		JCT			1				X																													
		F	M1-5	30	24		VERMONT 100C			1																																	
SB	5.205	F	D1-1A	72	10																																						
		F	D1-1A	72	10																																						
		F	D1-1A	72	10																																						
		F	D1-1A	72	12			6.00								2		X																			5						
		F	D1-1A	72	12			6.00																													5						
		F	D1-1A	72	12			6.00																													5						
SB	5.143	F	M3-3S	24	12		SOUTH			1				X																													
		F	M1-5	30	24		VERMONT 100			1																																	
		F	M6-2 L	21	15		<--- LEFT (45 DEG)			1																																	
		F	M4-5S	24	12		TO			1																																	
		F	M3-2S	24	12		EAST			1																																	
		F	M1-5	24	24		VERMONT 15			1																																	
		F	M6-2S	21	15		<--- LEFT (45 DEG)			1																																	
<b>SIGN SUMMARY SHEET</b>							SHEET TOTALS	18.00	0.00	9	0	0	3	0	0	2	30																										
								SF	SF	EA	EA	EA	EA	EA	EA	EA	EA	EA	EA	EA	EA	FT																					
VERMONT AGENCY OF TRANSPORTATION							TOWN TOTALS	287.3	0.0	80.0	0.0	0.0	54	0.0	0.0	42	630.0																										
																							PROJECT NAME:	<b>Moretown-Newport Town VT100</b>																			
																							PROJECT NUMBER:	<b>STPG SIGN(28)</b>																			
																							FILE NAME:	<b>Hyde Park.xls</b>						PLOT DATE:	<b>9/29/2009</b>												
																							PROJECT MANAGER:	<b>N. Avery</b>						DRAWN BY:	<b>I. Shea</b>												
																							DESIGNED BY:	<b>D. Crosslev</b>						CHECKED BY:	<b>J. Kelly</b>												
																							HYDE PARK SHEET 7							SHEET	<b>97</b>						OF	<b>166</b>					

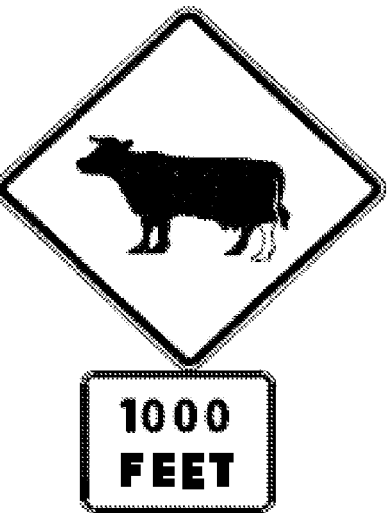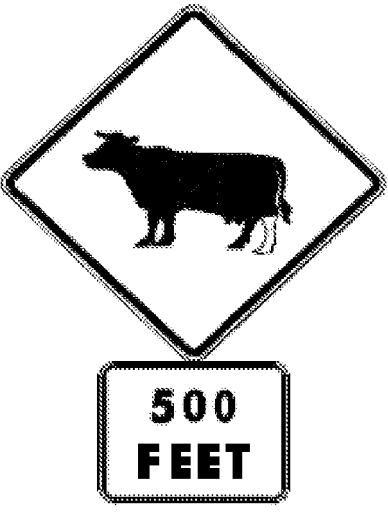

DIRECTION	MILEPOINT	LOCATION CODE (SHEET 2)	SIGN CODE	WIDTH (IN)	HEIGHT (IN)	SHEETING REMARKS	SIGN LEGEND	NEW SIGNS		EXISTING SIGNS				EXIST POST		NUMBER OF NEW POSTS	SQUARE STEEL (IN)			TUBULAR STEEL Ø (IN)				SIGN FRAME REQUIRED	REMARKS	SIGN DETAIL			
								"A"	"B"	RETAIN	SALVAGE FROM	SALVAGE TO	REMOVE	RETAIN	REMOVE		1.75	2.00	2.50	FOUNDATION	3.00	3.50	4.00			5.00	DETAIL IN SHS	DETAIL ON SHEET NUMBER	DETAIL ON STD SHEET NUMBER
																	(LB / FT)				(LB / FT)								
								1.88	2.42	3.35	7.60	9.00	10.80	14.60															
<b>HYDE PARK VT 100</b>							FY-FLUORESCENT YELLOW FYG-FLUORESCENT YELLOW GREEN															"SHS"-STANDARD HIGHWAY SIGNS							
SB	4.861	F	R2-1	24	30		SPEED LIMIT 50			1				X															
SB	4.370	G	VR-017	24	30																								
		G	VR-017	24	30			5.00							1		X									E-141			
SB	4.361	H	R1-1	30	30		STOP			1				X															
SB	3.967	G	VR-017	24	30																								
		G	VR-017	24	30			5.00							1		X									E-141			
SB	3.959	H	R1-1	30	30																								
		H	R1-1	30	30			6.25							1		X						X						
SB	3.158	F	W1-2R	30	30		RIGHT CURVE																						
SB	3.078	F	W1-2R	30	30																								
SB	2.645	G	VR-017	24	30																								
		G	VR-017	24	30			5.00							1		X									E-141			
SB	2.630	H	R1-1	24	24																								
		H	R1-1	30	30			6.25							1		X						X						
SB	2.177	G	VR-017	24	30																								
<b>SIGN SUMMARY SHEET</b>							SHEET TOTALS	33.75	0.00	2	0	0	7	0	0	6	90								PROJECT NAME: <b>Moretown-Newport Town VT100</b>				
								SF	SF	EA	EA	EA	EA	EA	EA	EA	EA	EA	EA	EA	EA	EA	EA	EA	EA	EA	EA	PROJECT NUMBER: <b>STPG SIGN(28)</b>	
VERMONT AGENCY OF TRANSPORTATION							TOWN TOTALS	287.3	0.0	80.0	0.0	0.0	54	0.0	0.0	42	630.0								FILE NAME: <b>Hyde Park.xls</b> PLOT DATE: <b>9/29/2009</b>				
																												PROJECT MANAGER: <b>N. Avery</b> DRAWN BY: <b>I. Shea</b>	
																						DESIGNED BY: <b>D. Crosslev</b> CHECKED BY: <b>J. Kelly</b>							
																							HYDE PARK SHEET 9 SHEET <b>99</b> OF <b>166</b>						


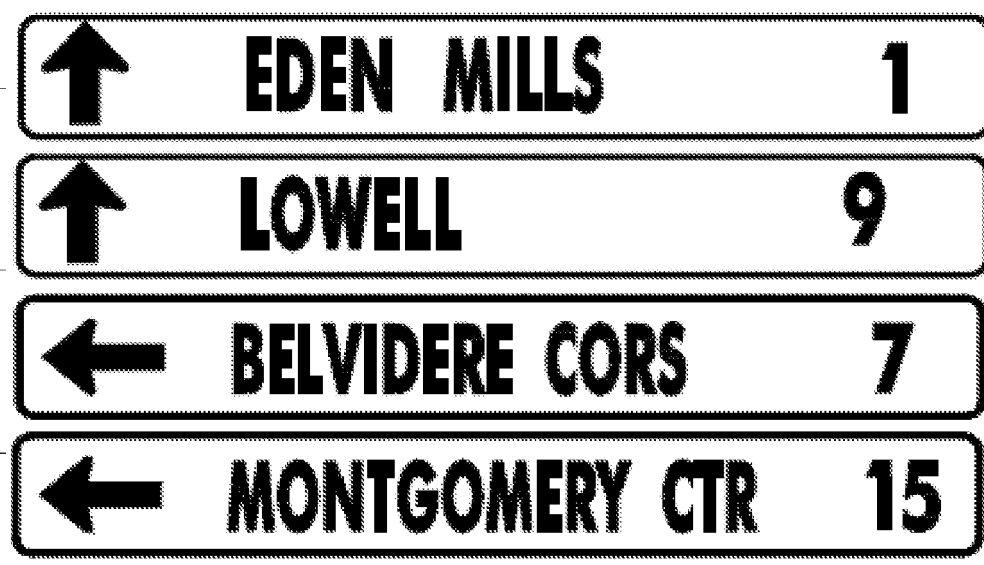
DIRECTION	MILEPOINT	LOCATION CODE (SHEET 2)	SIGN CODE	WIDTH (IN)	HEIGHT (IN)	SHEETING REMARKS	SIGN LEGEND	NEW SIGNS		EXISTING SIGNS				EXIST POST		NUMBER OF NEW POSTS	SQUARE STEEL (IN)			TUBULAR STEEL Ø (IN)				SIGN FRAME REQUIRED	REMARKS	SIGN DETAIL																	
								"A"	"B"	RETAIN	SALVAGE FROM	SALVAGE TO	REMOVE	RETAIN	REMOVE		1.75	2.00	2.50	FOUNDATION	3.00	3.50	4.00			5.00	DETAIL IN SHS	DETAIL ON SHEET NUMBER	DETAIL ON STD SHEET NUMBER														
																	(LB / FT)				(LB / FT)																						
<b>HYDE PARK VT 100</b>							FY-FLUORESCENT YELLOW FYG-FLUORESCENT YELLOW GREEN															"SHS"-STANDARD HIGHWAY SIGNS																					
			H R1-1	24	24																																						
			G VR-017	24	30			5.00							1		X									E-141																	
SB	2.170		H R1-1	30	30																					MANNING RD TH-37																	
			H R1-1	30	30			6.25							1		X							X																			
SB	2.040		F VW-202	30	30		TRUCKS ENTERING 																																				
SB	1.974		F VW-202	30	30			6.25							1		X									INSTALL 350' +/- SOUTH OF ORIGINAL SIGN LOCATION																	
SB	1.557		F W2-2RM	30	30		RIGHT SIDE ROAD (MOD.)																																				
SB	1.514		F W11-6	30	30		SNOWMOBILE 																																				
SB	1.484		F W2-2MaR	30	30			6.25							1		X									INSTALL 150' +/- SOUTH OF REMOVED SNOWMOBILE SIGN																	
SB	1.397		G VR-017	24	30																																						
			G VR-017	24	30			5.00							1		X									E-141																	
SB	1.390		H R1-1	30	30																																						
			H R1-1	30	30			6.25							1		X							X																			
SB	1.181		F W11-4	30	30																																						
			F W16-2	24	18																																						
<b>SIGN SUMMARY SHEET</b>							SHEET TOTALS											35.00	0.00	0	0	0	9	0	0	6	90	PROJECT NAME: <b>Moretown-Newport Town VT100</b>															
							SF	SF	EA	EA	EA	EA	EA	EA	EA	EA	EA	EA	EA	EA	EA	EA	EA	EA	EA	EA	EA	EA	EA	EA	EA	EA	PROJECT NUMBER: <b>STPG SIGN(28)</b>										
VERMONT AGENCY OF TRANSPORTATION							TOWN TOTALS											287.3	0.0	80.0	0.0	0.0	54	0.0	0.0	42	630.0	FILE NAME: <b>Hyde Park.xls</b> PLOT DATE: <b>9/29/2009</b>															
																																	PROJECT MANAGER: <b>N. Avery</b> DRAWN BY: <b>I. Shea</b>										
																																	DESIGNED BY: <b>D. Crosslev</b> CHECKED BY: <b>J. Kelly</b>										
																																	HYDE PARK SHEET 10 SHEET <b>100</b> OF <b>166</b>										

DIRECTION	MILEPOINT	LOCATION CODE (SHEET 2)	SIGN CODE	WIDTH (IN)	HEIGHT (IN)	SHEETING REMARKS	SIGN LEGEND	NEW SIGNS		EXISTING SIGNS				EXIST POST		NUMBER OF NEW POSTS	SQUARE STEEL (IN)			TUBULAR STEEL Ø (IN)				SIGN FRAME REQUIRED	REMARKS	SIGN DETAIL			
								"A"	"B"	RETAIN	SALVAGE FROM	SALVAGE TO	REMOVE	RETAIN	REMOVE		1.75	2.00	2.50	FOUNDATION	3.00	3.50	4.00			5.00	DETAIL IN SHS	DETAIL ON SHEET NUMBER	DETAIL ON STD SHEET NUMBER
																	(LB / FT)				(LB / FT)								
<b>HYDE PARK VT 100</b>							FY-FLUORESCENT YELLOW FYG-FLUORESCENT YELLOW GREEN																"SHS"-STANDARD HIGHWAY SIGNS						
		F	W11-4	30	30	FY		6.25							1		X								X				
		F	W16-2	24	18	FY		3.00																	X				
SB	1.087	F	W11-4	30	30																								
		F	W16-2	24	18																								
		F	W11-4	30	30	FY		6.25							1		X								X				
		F	W16-2	24	18	FY		3.00																	X				
SB	0.317	F	VD-062B	72	16		BUSINESS SIGN				1																		
SB	0.276	F	W2-2MR	30	30		MODIFIED RIGHT SIDE ROAD				1																		
SB	0.241	F	W3-1	36	36		STOP AHEAD SYMBOL				1																		
SB	0.213	F	VD-018	30	18		HYDE PARK MORRISVILLE 2				1																		
SB	0.157	F	M2-1S	21	15		JCT				1																		
		F	M1-5	24	24		VERMONT 15				1																		
SB	0.145	G	VR-017	24	30																								
		G	VR-017	24	30			5.00							1		X									E-141			
SB	0.132	H	R1-1	30	30																					BATTLE HILL RD TH-6			
<b>SIGN SUMMARY SHEET</b>							SHEET TOTALS	23.50	0.00	6	0	0	4	0	0	3	45												
								SF	SF	EA	EA	EA	EA	EA	EA	EA	EA	EA	EA	EA	EA	EA	EA	EA	EA	EA	EA	EA	EA
VERMONT AGENCY OF TRANSPORTATION							TOWN TOTALS	287.3	0.0	80.0	0.0	0.0	54	0.0	0.0	42	630.0												
							PROJECT NAME:	<b>Moretown-Newport Town VT100</b>																					
							PROJECT NUMBER:	<b>STPG SIGN(28)</b>																					
							FILE NAME:	<b>Hyde Park.xls</b>										PLOT DATE:	<b>9/29/2009</b>										
							PROJECT MANAGER:	<b>N. Avery</b>										DRAWN BY:	<b>I. Shea</b>										
							DESIGNED BY:	<b>D. Crosslev</b>										CHECKED BY:	<b>J. Kelly</b>										
							HYDE PARK SHEET 11	SHEET <b>101</b> OF <b>166</b>																					



DIRECTION	MILEPOINT	LOCATION CODE (SHEET 2)	SIGN CODE	WIDTH (IN)	HEIGHT (IN)	SHEETING REMARKS	SIGN LEGEND	NEW SIGNS		EXISTING SIGNS				EXIST POST		NUMBER OF NEW POSTS	SQUARE STEEL (IN)			TUBULAR STEEL Ø (IN)				SIGN FRAME REQUIRED	REMARKS	SIGN DETAIL				
								"A"	"B"	RETAIN	SALVAGE FROM	SALVAGE TO	REMOVE	RETAIN	REMOVE		1.75	2.00	2.50	FOUNDATION	3.00	3.50	4.00			5.00	DETAIL IN SHS	DETAIL ON SHEET NUMBER	DETAIL ON STD SHEET NUMBER	
																	(LB / FT)				(LB / FT)									
<b>HYDE PARK VT 100</b>							FY-FLUORESCENT YELLOW FYG-FLUORESCENT YELLOW GREEN																"SHS"-STANDARD HIGHWAY SIGNS							
			H R1-1	30	30			6.25							1	X										X				
SB	0.105		F D1-1	72	10							1																		
			F D1-1A	72	10							1																		
			F D1-1A	72	10							1																		
			F D1-1A	72	10							1																		
			F D1-1A	72	10							1																		
			F D1-1	72	12			6.00							2		X												5	
			F D1-1A	72	12			6.00																					5	
			F D1-1A	72	12			6.00																						5
			F D1-1A	72	12			6.00																						5
			F D1-1A	72	12			6.00																						5
SB	0.050		F M3-2S	24	12		EAST			1																				
			F M1-5	24	24		VERMONT 15			1																				
			F M6-1S	21	15		<--- LEFT			1																				
			F M3-3S	24	12		SOUTH			1																				
<b>SIGN SUMMARY SHEET</b>							SHEET TOTALS	36.25	0.00	4	0	0	5	0	0	3	45					PROJECT NAME: <b>Moretown-Newport Town VT100</b>	PROJECT NUMBER: <b>STPG SIGN(28)</b>							
								SF	SF	EA	EA	EA	EA	EA	EA	EA	FT					FILE NAME: <b>Hyde Park.xls</b>	PLOT DATE: <b>9/29/2009</b>							
VERMONT AGENCY OF TRANSPORTATION							TOWN TOTALS	287.3	0.0	80.0	0.0	0.0	54	0.0	0.0	42	630.0					PROJECT MANAGER: <b>N. Avery</b>	DRAWN BY: <b>I. Shea</b>							
																					DESIGNED BY: <b>D. Crosslev</b>	CHECKED BY: <b>J. Kelly</b>								
																					HYDE PARK SHEET 12	SHEET <b>102</b> OF <b>166</b>								




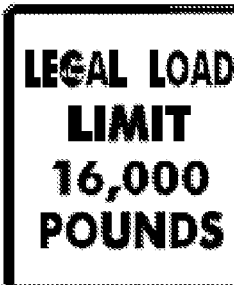






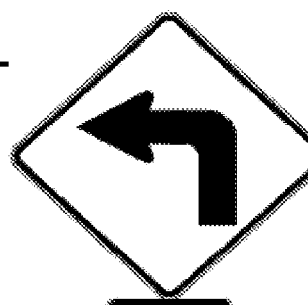

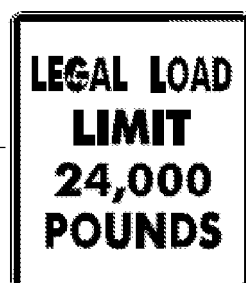

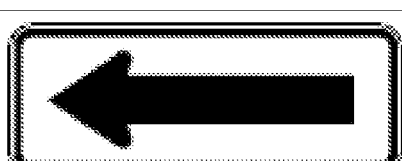
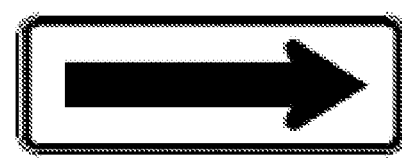
DIRECTION	MILEPOINT	LOCATION CODE (SHEET 2)	SIGN CODE	WIDTH (IN)	HEIGHT (IN)	SHEETING REMARKS	SIGN LEGEND	NEW SIGNS		EXISTING SIGNS				EXIST POST		NUMBER OF NEW POSTS	SQUARE STEEL (IN)			TUBULAR STEEL Ø (IN)				SIGN FRAME REQUIRED	REMARKS	SIGN DETAIL			
								"A"	"B"	RETAIN	SALVAGE FROM	SALVAGE TO	REMOVE	RETAIN	REMOVE		1.75	2.00	2.50	FOUNDATION	3.00	3.50	4.00			5.00	DETAIL IN SHS	DETAIL ON SHEET NUMBER	DETAIL ON STD SHEET NUMBER
																	(LB / FT)				(LB / FT)								
<b>EDEN VT 100</b>							FY-FLUORESCENT YELLOW FYG-FLUORESCENT YELLOW GREEN															"SHS"-STANDARD HIGHWAY SIGNS							
NB	0.000	C	VD-024	72	12			5.00							2		X							INSTALL OPPOSITE EXISTING TOWNLINER SIGN		4			
		C	VD-700	6	10			<del>0.42</del>																					
		C	VD-700	6	10			0.42																					
NB	0.190	A	VW-001A	30	30		MOOSE SYMBOL						1				X												
		A	W7-3A	24	18								1																
		A	VW-001A	30	30			6.25							1		X									6			
		A	W7-3A	24	18			3.00															X						
NB	0.210	C	VM-607	24	30		43RD INF DIV MEMORIAL HIGHWAY			1							X												
NB	1.785	A	S1-1YG	36	36		SCHOOL			1							X												
		A	W16-9YG	36	20		AHEAD			1																			
NB	1.872	A	D1-1E	72	12		<--- EDEN CENTRAL SCHOOL			1							X												
NB	2.090	C	VR-017	24	30								1				X							BLAKEVILLE RD TH-17 (SOUTH)					
		C	VR-017	24	30			5.00							1		X										E-141		
NB	2.100	D	R1-1	24	24								1				X							BLAKEVILLE RD TH-17 (SOUTH)					
		D	R1-1	30	30			6.25							1		X						X						
<b>SIGN SUMMARY SHEET</b>							SHEET TOTALS	26.34	0.00	4	0	0	4	0	0	5	75						PROJECT NAME: <b>Moretown-Newport Town VT100</b>						
								SF	SF	EA	EA	EA	EA	EA	EA	EA	EA	EA	EA	EA	EA	EA	EA	EA	EA	EA	EA	EA	PROJECT NUMBER: <b>STPG SIGN(28)</b>
VERMONT AGENCY OF TRANSPORTATION							TOWN TOTALS	462.5	0.0	40.0	2.0	2.0	86	0.0	0.0	77	1155.0						FILE NAME: <b>Eden.xls</b>						
																												PLOT DATE: <b>9/30/2009</b>	
																						PROJECT MANAGER: <b>N. Avery</b>							
																							DRAWN BY: <b>I. Shea</b>						
																							DESIGNED BY: <b>D. Crosslev</b>						
																							CHECKED BY: <b>J. Kelly</b>						
																							SHEET <b>104</b> OF <b>166</b>						

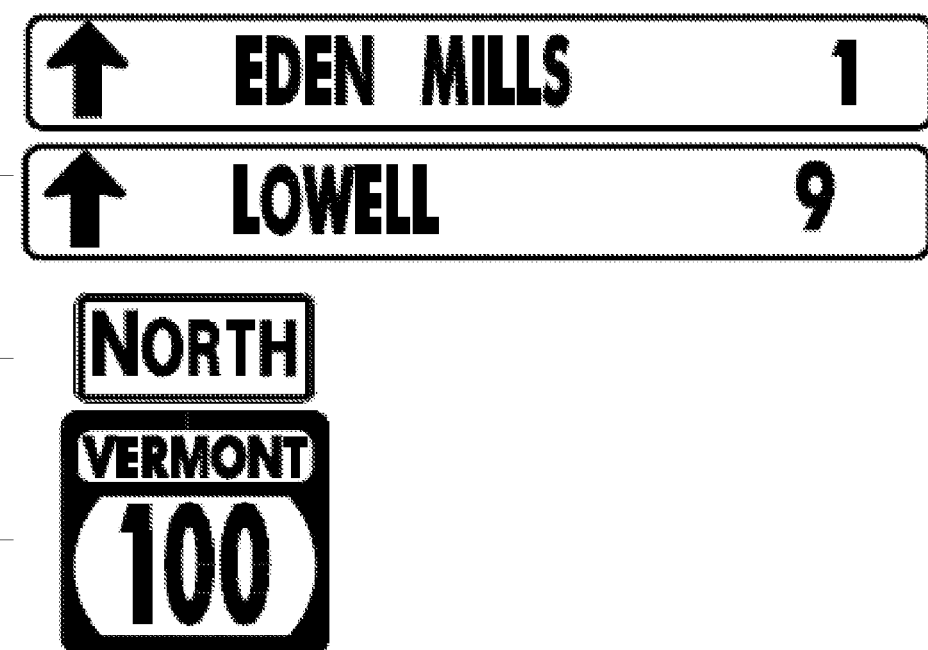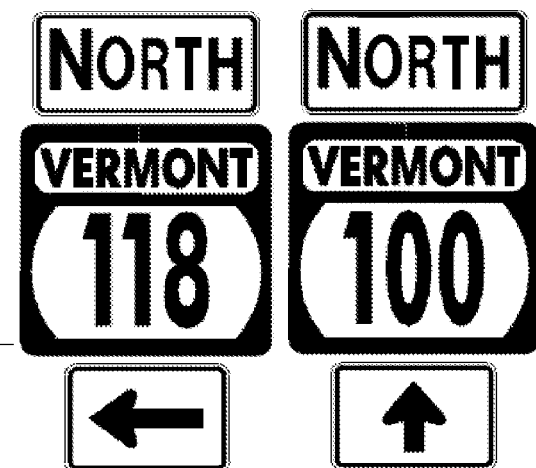
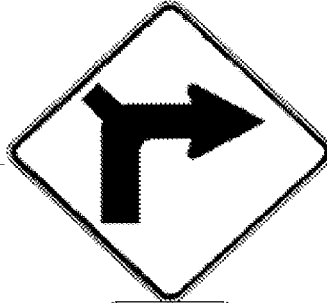



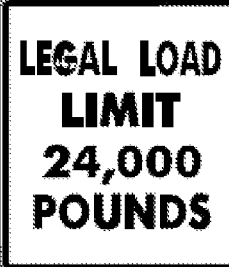
DIRECTION	MILEPOINT	LOCATION CODE (SHEET 2)	SIGN CODE	WIDTH (IN)	HEIGHT (IN)	SHEETING REMARKS	SIGN LEGEND	NEW SIGNS		EXISTING SIGNS				EXIST POST		NUMBER OF NEW POSTS	SQUARE STEEL (IN)			TUBULAR STEEL Ø (IN)				SIGN FRAME REQUIRED	REMARKS	SIGN DETAIL									
								"A"	"B"	RETAIN	SALVAGE FROM	SALVAGE TO	REMOVE	RETAIN	REMOVE		1.75	2.00	2.50	FOUNDATION	3.00	3.50	4.00			5.00	DETAIL IN SHS	DETAIL ON SHEET NUMBER	DETAIL ON STD SHEET NUMBER						
																	(LB / FT)				(LB / FT)														
<b>EDEN VT 100</b>							FY-FLUORESCENT YELLOW FYG-FLUORESCENT YELLOW GREEN															"SHS"-STANDARD HIGHWAY SIGNS													
NB	2.770	A	M2-1S	21	15																														
		A	M1-5	30	24																														
		A	M2-1	21	15				2.19							1		X												X					
		A	M1-5	30	24				5.00																								E-136B		
NB	2.820	A	D1-1A	72	10																														
		A	D1-1A	72	10																														
		A	D1-1A	72	10																														
		A	D1-1A	72	10																														
		A	D1-1A	72	12												2		X															5	
		A	D1-1A	72	12																													5	
		A	D1-1A	72	12																													5	
		A	D1-1A	72	12																													5	
NB	2.870	A	M3-1S	24	12																														
		A	M1-5	30	24																														
		A	M6-1S	21	15																														
<b>SIGN SUMMARY SHEET</b>							SHEET TOTALS		31.19	0.00	0	0	0	9	0	0	3	45																	
							SF	SF	EA	EA	EA	EA	EA	EA	EA	EA	EA			FT															
VERMONT AGENCY OF TRANSPORTATION							TOWN TOTALS		462.5	0.0	40.0	2.0	2.0	86	0.0	0.0	77	1155.0																	
							PROJECT NAME: <b>Moretown-Newport Town VT100</b>															PROJECT NUMBER: <b>STPG SIGN(28)</b>		FILE NAME: <b>Eden.xls</b>		PLOT DATE: <b>9/30/2009</b>									
																						PROJECT MANAGER: <b>N. Avery</b>		DESIGNED BY: <b>D. Crosslev</b>		DRAWN BY: <b>I. Shea</b>									
																						EDEN SHEET 2		CHECKED BY: <b>J. Kelly</b>		SHEET <b>105</b> OF <b>166</b>									



DIRECTION	MILEPOINT	LOCATION CODE (SHEET 2)	SIGN CODE	WIDTH (IN)	HEIGHT (IN)	SHEETING REMARKS	SIGN LEGEND	NEW SIGNS		EXISTING SIGNS				EXIST POST		NUMBER OF NEW POSTS	SQUARE STEEL (IN)			TUBULAR STEEL Ø (IN)				SIGN FRAME REQUIRED	REMARKS	SIGN DETAIL														
								"A"	"B"	RETAIN	SALVAGE FROM	SALVAGE TO	REMOVE	RETAIN	REMOVE		(LB / FT)			(LB / FT)						DETAIL IN SHS	DETAIL ON SHEET NUMBER	DETAIL ON STD SHEET NUMBER												
																	1.75	2.00	2.50	FOUNDATION	3.00	3.50	4.00						5.00											
<b>EDEN VT 100</b>							FY-FLUORESCENT YELLOW FYG-FLUORESCENT YELLOW GREEN																		"SHS"-STANDARD HIGHWAY SIGNS															
		A	M3-1S	24	12																																			
		A	M1-5	30	24																																			
		A	M6-3S	21	15																																			
		A	M3-1	24	12								2.00												2B	GREEN ON WHITE SHEETING				X										
		A	M1-5	30	24								5.00																									E-136B		
		A	M6-1L	21	15								2.19														GREEN ON WHITE SHEETING					X								
		A	M3-1	24	12								2.00														GREEN ON WHITE SHEETING					X								
		A	M1-5	30	24								5.00																										E-136B	
		A	M6-3	21	15								2.19														GREEN ON WHITE SHEETING					X								
		NB 2.950	A	M3-1S	24	12																																		
		A	M1-5	30	24																																			
		A	D1-1A	72	12								6.00																										5	
		A	D1-1A	72	12								6.00																										5	
		A	M3-1	24	12								2.00														GREEN ON WHITE SHEETING					X								
		A	M1-5	30	24								5.00																											E-136B
<b>SIGN SUMMARY SHEET</b>							<b>SHEET TOTALS</b>	37.38	0.00	0	0	0	5	0	0	4	60									PROJECT NAME: <b>Moretown-Newport Town VT100</b> PROJECT NUMBER: <b>STPG SIGN(28)</b>														
VERMONT AGENCY OF TRANSPORTATION							<b>TOWN TOTALS</b>	462.5	0.0	40.0	2.0	2.0	86	0.0	0.0	77	1155.0									FILE NAME: <b>Eden.xls</b> PLOT DATE: <b>9/30/2009</b> PROJECT MANAGER: <b>N. Avery</b> DRAWN BY: <b>I. Shea</b> DESIGNED BY: <b>D. Crosslev</b> CHECKED BY: <b>J. Kelly</b> EDEN SHEET 3 SHEET <b>106</b> OF <b>166</b>														

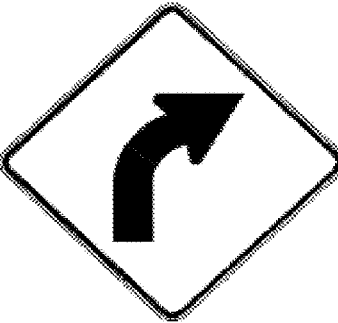
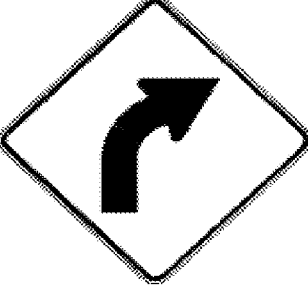






DIRECTION	MILEPOINT	LOCATION CODE (SHEET 2)	SIGN CODE	WIDTH (IN)	HEIGHT (IN)	SHEETING REMARKS	SIGN LEGEND	NEW SIGNS		EXISTING SIGNS				EXIST POST		NUMBER OF NEW POSTS	SQUARE STEEL (IN)			TUBULAR STEEL Ø (IN)				SIGN FRAME REQUIRED	REMARKS	SIGN DETAIL					
								"A"	"B"	RETAIN	SALVAGE FROM	SALVAGE TO	REMOVE	RETAIN	REMOVE		1.75	2.00	2.50	FOUNDATION	3.00	3.50	4.00			5.00	DETAIL IN SHS	DETAIL ON SHEET NUMBER	DETAIL ON STD SHEET NUMBER		
																	(LB / FT)				(LB / FT)										
<b>EDEN VT 100</b>							FY-FLUORESCENT YELLOW FYG-FLUORESCENT YELLOW GREEN															"SHS"-STANDARD HIGHWAY SIGNS									
NB	2.950	C	VR-017	24	30																			PARSONAGE RD TH-18							
		C	VR-017	24	30				5.00							1			X								E-141				
NB	2.960	D	R1-1	30	30																			PARSONAGE RD TH-18							
		D	R1-1	30	30				6.25							1			X					X							
NB	2.980	A	R2-1	24	30																										
		A	R2-1	24	30				5.00							1			X					X							
NB	3.510	C	VR-017	24	24																			BLAKEVILLE RD TH-17 (NORTH)							
		C	VR-017	24	30				5.00							1			X								E-141				
NB	3.520	D	R1-1	24	24																			BLAKEVILLE RD TH-17 (NORTH)							
		D	R1-1	30	30				6.25							1			X					X							
NB	3.615	A	W3-5	36	36		SPEED REDUCTION SPEED LIMIT 40			1																					
NB	3.650	A	VD-018	30	18		EDEN MILLS LOWELL 8			1																					
NB	3.690	A	W1-4R	30	30		RIGHT REVERSE CURVE								1																
NB	3.715	A	R2-1	24	30																										
		A	R2-1	30	36				7.50							1			X								6				
<b>SIGN SUMMARY SHEET</b>							SHEET TOTALS	35.00	0.00	2	0	0	7	0	0	6	90														
								SF	SF	EA	EA	EA	EA	EA	EA	EA	EA	EA	EA	EA	EA	EA	EA	EA	EA	EA	EA	EA			
VERMONT AGENCY OF TRANSPORTATION							TOWN TOTALS	462.5	0.0	40.0	2.0	2.0	86	0.0	0.0	77	1155.0														
																	PROJECT NAME:	<b>Moretown-Newport Town VT100</b>													
																	PROJECT NUMBER:	<b>STPG SIGN(28)</b>													
																	FILE NAME:	<b>Eden.xls</b>					PLOT DATE:	<b>9/30/2009</b>							
																	PROJECT MANAGER:	<b>N. Avery</b>					DRAWN BY:	<b>I. Shea</b>							
																	DESIGNED BY:	<b>D. Crosslev</b>					CHECKED BY:	<b>J. Kelly</b>							
																	EDEN SHEET 4						SHEET	<b>107</b> OF <b>166</b>							







DIRECTION	MILEPOINT	LOCATION CODE (SHEET 2)	SIGN CODE	WIDTH (IN)	HEIGHT (IN)	SHEETING REMARKS	SIGN LEGEND	NEW SIGNS		EXISTING SIGNS				EXIST POST		NUMBER OF NEW POSTS	SQUARE STEEL (IN)			TUBULAR STEEL Ø (IN)				SIGN FRAME REQUIRED	REMARKS	SIGN DETAIL			
								"A"	"B"	RETAIN	SALVAGE FROM	SALVAGE TO	REMOVE	RETAIN	REMOVE		1.75	2.00	2.50	FOUNDATION	3.00	3.50	4.00			5.00	DETAIL IN SHS	DETAIL ON SHEET NUMBER	DETAIL ON STD SHEET NUMBER
																	(LB / FT)				(LB / FT)								
<b>EDEN VT 100</b>							FY-FLUORESCENT YELLOW FYG-FLUORESCENT YELLOW GREEN															"SHS"-STANDARD HIGHWAY SIGNS							
NB	3.770	A	W1-2 R	30	30			6.25											X					INSTALL OPPOSITE BEGINNING OF SB GUARD RAIL	X				
NB	3.920	A	R2-1	24	30																								
		A	R2-1	30	36			7.50											X								6		
NB	3.950	A	W1-1L	30	30		LEFT TURN																						
		A	W13-1	18	18		30 MPH PLAQUE																						
NB	3.970	A	W1-1L	30	30			6.25																INSTALL 100' +/- NORTH OF ORIGINAL SIGN LOCATION	X				
		A	W13-1	24	24			4.00																	X				
NB	4.014	C	VR-017	24	30																			EARLE LN TH-40					
		C	VR-017	24	30			5.00											X								E-141		
NB	4.014	D	R1-1	30	30																			EARLE LN TH-40					
		D	R1-1	30	30			6.25											X						X				
NB	4.017	A	W1-6	48	24																								
		A	W1-6	48	24			8.00											X						X				
NB	4.020	B	W1-6	48	24																								
		B	W1-6	48	24			8.00											X						X				
<b>SIGN SUMMARY SHEET</b>							SHEET TOTALS	51.25	0.00	0	0	0	7	0	0	9	135									PROJECT NAME: <b>Moretown-Newport Town VT100</b>			
								SF	SF	EA	EA	EA	EA	EA	EA	EA	EA	EA	EA	EA	EA	EA	EA	EA	EA	EA	EA	EA	PROJECT NUMBER: <b>STPG SIGN(28)</b>
VERMONT AGENCY OF TRANSPORTATION							TOWN TOTALS	462.5	0.0	40.0	2.0	2.0	86	0.0	0.0	77	1155.0								FILE NAME: <b>Eden.xls</b>				
																								PROJECT MANAGER: <b>N. Avery</b>					
																									DESIGNED BY: <b>D. Crosslev</b>				
																										CHECKED BY: <b>J. Kelly</b>			
																										EDEN SHEET 5			
																										PLOT DATE: <b>9/30/2009</b>			
																										DRAWN BY: <b>I. Shea</b>			
																										CHECKED BY: <b>J. Kelly</b>			
																										SHEET <b>108</b> OF <b>166</b>			






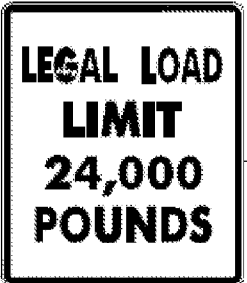






DIRECTION	MILEPOINT	LOCATION CODE (SHEET 2)	SIGN CODE	WIDTH (IN)	HEIGHT (IN)	SHEETING REMARKS	SIGN LEGEND	NEW SIGNS		EXISTING SIGNS				EXIST POST		NUMBER OF NEW POSTS	SQUARE STEEL (IN)			TUBULAR STEEL Ø (IN)				SIGN FRAME REQUIRED	REMARKS	SIGN DETAIL			
								"A"	"B"	RETAIN	SALVAGE FROM	SALVAGE TO	REMOVE	RETAIN	REMOVE		1.75	2.00	2.50	FOUNDATION	3.00	3.50	4.00			5.00	DETAIL IN SHS	DETAIL ON SHEET NUMBER	DETAIL ON STD SHEET NUMBER
																	(LB / FT)				(LB / FT)								
<b>EDEN VT 100</b>							FY-FLUORESCENT YELLOW FYG-FLUORESCENT YELLOW GREEN															"SHS"-STANDARD HIGHWAY SIGNS							
NB	4.030	A	W11-6H	30	30																								
		A	W11-6H	30	30			6.25																		E-152			
NB	4.120	A	W1-1MR	30	30																								
		A	W13-1	18	18																								
		A	W1-1MdR	30	30			6.25																		6			
		A	W13-1	24	24			4.00																	X				
NB	4.180	A	M3-1S	24	12		NORTH																						
		A	M1-5	30	24		VERMONT 100																						
NB	4.210	A	M3-1	24	12			2.00																					
		A	M1-5	30	24			5.00																		E-136B			
NB	4.260	A	VD-062B	72	16		BUSINESS SIGN			1																			
NB	4.290	A	W1-6	48	24																								
		A	W1-6	48	24			8.00																	X				
NB	4.320	C	VR-017	24	30			5.00																		E-141			
NB	4.300	D	R1-1	30	30																					EAST HILL RD TH-2			
<b>SIGN SUMMARY SHEET</b>							SHEET TOTALS	36.50	0.00	1	0	0	7	0	0	6	90						PROJECT NAME: <b>Moretown-Newport Town VT100</b>						
								SF	SF	EA	EA	EA	EA	EA	EA	EA	FT						PROJECT NUMBER: <b>STPG SIGN(28)</b>						
VERMONT AGENCY OF TRANSPORTATION							TOWN TOTALS	462.5	0.0	40.0	2.0	2.0	86	0.0	0.0	77	1155.0						FILE NAME: <b>Eden.xls</b>	PLOT DATE: <b>9/30/2009</b>					
																							PROJECT MANAGER: <b>N. Avery</b>	DRAWN BY: <b>I. Shea</b>					
																							DESIGNED BY: <b>D. Crosslev</b>	CHECKED BY: <b>J. Kelly</b>					
																							EDEN SHEET <b>6</b>	SHEET <b>109</b> OF <b>166</b>					

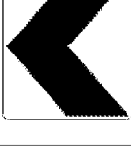





DIRECTION	MILEPOINT	LOCATION CODE (SHEET 2)	SIGN CODE	WIDTH (IN)	HEIGHT (IN)	SHEETING REMARKS	SIGN LEGEND	NEW SIGNS		EXISTING SIGNS				EXIST POST		NUMBER OF NEW POSTS	SQUARE STEEL (IN)			TUBULAR STEEL Ø (IN)				SIGN FRAME REQUIRED	REMARKS	SIGN DETAIL			
								"A"	"B"	RETAIN	SALVAGE FROM	SALVAGE TO	REMOVE	RETAIN	REMOVE		1.75	2.00	2.50	FOUNDATION	3.00	3.50	4.00			5.00	DETAIL IN SHS	DETAIL ON SHEET NUMBER	DETAIL ON STD SHEET NUMBER
																	(LB / FT)				(LB / FT)								
<b>EDEN VT 100</b>							FY-FLUORESCENT YELLOW FYG-FLUORESCENT YELLOW GREEN																"SHS"-STANDARD HIGHWAY SIGNS						
		D	R1-1	30	30			6.25							1		X								X				
NB	4.350	A	R2-1	24	30								1			X													
		A	R2-1	24	30			5.00							1		X								X				
NB	4.530	C	VR-017	24	30		LEGAL LOAD LIMIT 24,000 LBS				1						X									LAKESHORE RD TH-30 CLASS 4			
NB	4.540	D	R1-1	30	30		STOP				1						X									LAKESHORE RD TH-30 CLASS 4			
NB	4.575	A	R2-1	24	30		SPEED LIMIT 40				1						X												
NB	4.683	C	VR-017	24	30		LEGAL LOAD LIMIT 24,000 LBS				1						X									BARROWS LN TH-41			
NB	4.683	D	R1-1	30	30		STOP				1						X									BARROWS LN TH-41			
NB	4.795	A	W11-2YG	30	30		PEDESTRIAN				1						X												
		A	W16-4YG	30	24		NEXT 2000 FEET				1																		
NB	5.230	A	R2-1	24	30		SPEED LIMIT 50				1						X												
NB	5.565	A	VW-202	30	30		TRUCKS ENTERING				1						X												
NB	5.914	A	R2-1	24	30		SPEED LIMIT 50				1						X												
NB	6.118	C	VR-017	24	30		LEGAL LOAD LIMIT 16,000 LBS				1						X									BOY SCOUT CAMP RD TH-32			
NB	6.126	D	R1-1	30	30		STOP				1						X									BOY SCOUT CAMP RD TH-32			
<b>SIGN SUMMARY SHEET</b>							SHEET TOTALS	11.25	0.00	12	0	0	1	0	0	2	30											PROJECT NAME: <b>Moretown-Newport Town VT100</b>	
								SF	SF	EA	EA	EA	EA	EA	EA	EA	EA	EA	EA	EA	EA	EA	EA	EA	EA	EA	EA	EA	EA
VERMONT AGENCY OF TRANSPORTATION							TOWN TOTALS	462.5	0.0	40.0	2.0	2.0	86	0.0	0.0	77	1155.0									FILE NAME: <b>Eden.xls</b>			
																										PLOT DATE: <b>9/30/2009</b>			
																										PROJECT MANAGER: <b>N. Avery</b>			
																										DRAWN BY: <b>I. Shea</b>			
																											DESIGNED BY: <b>D. Crosslev</b>		
																											CHECKED BY: <b>J. Kelly</b>		
																											SHEET <b>110</b> OF <b>166</b>		

DIRECTION	MILEPOINT	LOCATION CODE (SHEET 2)	SIGN CODE	WIDTH (IN)	HEIGHT (IN)	SHEETING REMARKS	SIGN LEGEND	NEW SIGNS		EXISTING SIGNS				EXIST POST		NUMBER OF NEW POSTS	SQUARE STEEL (IN)			TUBULAR STEEL Ø (IN)				SIGN FRAME REQUIRED	REMARKS	SIGN DETAIL						
								"A"	"B"	RETAIN	SALVAGE FROM	SALVAGE TO	REMOVE	RETAIN	REMOVE		1.75	2.00	2.50	FOUNDATION	3.00	3.50	4.00			5.00	DETAIL IN SHS	DETAIL ON SHEET NUMBER	DETAIL ON STD SHEET NUMBER			
																	(LB / FT)				(LB / FT)											
<b>EDEN VT 100</b>							FY-FLUORESCENT YELLOW FYG-FLUORESCENT YELLOW GREEN																"SHS"-STANDARD HIGHWAY SIGNS									
NB	6.805	A	W1-4R	30	30		RIGHT REVERSE CURVE			1				X																		
NB	7.003	A	W1-6	48	24		<=== LEFT			1				X																		
NB	7.003	B	W1-6	48	24		RIGHT ===>			1				X																		
NB	7.030	A	W1-6	48	24		<=== LEFT			1			X		2		X															
NB	7.030	B	W1-6	48	24		RIGHT ===>			1			X		2		X															
NB	7.292 <del>7.190</del>	B	W1-6	48	24			8.00							2		X										INSTALL SOUTH OF WOODS ROAD	X				
SB	7.292	F	W1-4R	30	30		RIGHT REVERSE CURVE					1		X																		
		F	W1-2 R	30	30			6.25							1		X												X			
SB	5.336	F	W3-5	36	36							1		X																		
		F	W3-5	36	36			9.00							2		X												X			
SB	5.254	F	R2-1	24	30							1		X																		
		F	R2-1	30	36			7.50							1		X													6		
SB	5.197	F	W11-2	30	30	FYG	PEDESTRIAN			1				X																		
		F	W16-4	30	24	FYG	NEXT 2000 FEET			1																						
SB	5.154	F	VW-060	30	30		HIDDEN DRIVES			1				X																		
<b>SIGN SUMMARY SHEET</b>							SHEET TOTALS	30.75	0.00	8	0	0	3	0	0	8	120															
								SF	SF	EA	EA	EA	EA	EA	EA	EA	EA	EA	EA	EA	EA	EA	EA	EA	EA	EA	EA	EA	EA	EA	EA	EA
VERMONT AGENCY OF TRANSPORTATION							TOWN TOTALS	462.5	0.0	40.0	2.0	2.0	86	0.0	0.0	77	1155.0															
PROJECT NAME: <b>Moretown-Newport Town VT100</b>																						PROJECT NUMBER: <b>STPG SIGN(28)</b>										
FILE NAME: <b>Eden.xls</b>										PLOT DATE: <b>9/30/2009</b>																						
PROJECT MANAGER: <b>N. Avery</b>										DRAWN BY: <b>I. Shea</b>																						
DESIGNED BY: <b>D. Crosslev</b>										CHECKED BY: <b>J. Kelly</b>																						
EDEN SHEET 8										SHEET <b>111</b> OF <b>166</b>																						



DIRECTION	MILEPOINT	LOCATION CODE (SHEET 2)	SIGN CODE	WIDTH (IN)	HEIGHT (IN)	SHEETING REMARKS	SIGN LEGEND	NEW SIGNS		EXISTING SIGNS				EXIST POST		NUMBER OF NEW POSTS	SQUARE STEEL (IN)			TUBULAR STEEL Ø (IN)				SIGN FRAME REQUIRED	REMARKS	SIGN DETAIL											
								"A"	"B"	RETAIN	SALVAGE FROM	SALVAGE TO	REMOVE	RETAIN	REMOVE		1.75	2.00	2.50	FOUNDATION	3.00	3.50	4.00			5.00	DETAIL IN SHS	DETAIL ON SHEET NUMBER	DETAIL ON STD SHEET NUMBER								
																	(LB / FT)				(LB / FT)																
<b>EDEN VT 100</b>							FY-FLUORESCENT YELLOW FYG-FLUORESCENT YELLOW GREEN															"SHS"-STANDARD HIGHWAY SIGNS															
SB	4.906	F	R2-1	24	30		SPEED LIMIT 40			1																											
SB	4.800	F	VW-060	30	30		HIDDEN DRIVES			1																											
SB	4.714	G	VR-017	24	30		LEGAL LOAD LIMIT 24,000 LBS			1																	CAMP RD TH-27										
SB	4.708	H	R1-1	30	30		STOP			1																	CAMP RD TH-27										
SB	4.470	F	W3-5	36	36		SPEED REDUCTION SPEED LIMIT 35						1																								
SB	4.437	F	W2-3ML	30	30		MODIFIED LEFT ANGLE SIDE ROAD			1																											
		F	W16-8A	30	8		EAST HILL RD			1																											
SB	4.375	F	R2-1	24	30		SPEED LIMIT 35																														
SB	4.350	F	R2-1	30	36								7.50					1			X							INSTALL ACROSS FROM NORTHBOUND SPEED LIMIT 40		6							
SB	4.341	F	VD-018	30	18		EDEN MILLS EDEN 1			1																											
SB	4.300	F	W1-1MdL	30	30		MODIFIED LEFT TURN																														
		F	W13-1	18	18		30 MPH PLAQUE				1																										
SB	4.257	F	M3-3S	24	12		SOUTH																														
		F	M1-5	30	24		VERMONT 100																														
		F	W1-1MdL	30	30		MODIFIED LEFT TURN												1			X							SALVAGED FROM SB MP 4.30								
<b>SIGN SUMMARY SHEET</b>							SHEET TOTALS										7.50	0.00	7	2	1	4	0	0	2	30											
							SF	SF	EA	EA	EA	EA	EA	EA	EA	EA	EA	EA																			
VERMONT AGENCY OF TRANSPORTATION							TOWN TOTALS										462.5	0.0	40.0	2.0	2.0	86	0.0	0.0	77	1155.0											
																		PROJECT NAME: <b>Moretown-Newport Town VT100</b> PROJECT NUMBER: <b>STPG SIGN(28)</b> FILE NAME: <b>Eden.xls</b> PROJECT MANAGER: <b>N. Avery</b> DESIGNED BY: <b>D. Crosslev</b> EDEN SHEET 9										PLOT DATE: <b>9/30/2009</b> DRAWN BY: <b>I. Shea</b> CHECKED BY: <b>J. Kelly</b> SHEET <b>112</b> OF <b>166</b>									

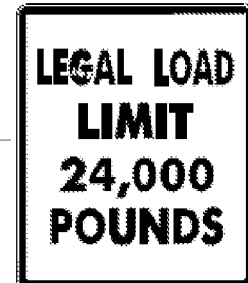



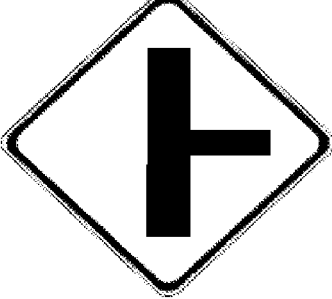
DIRECTION	MILEPOINT	LOCATION CODE (SHEET 2)	SIGN CODE	WIDTH (IN)	HEIGHT (IN)	SHEETING REMARKS	SIGN LEGEND	NEW SIGNS		EXISTING SIGNS				EXIST POST		NUMBER OF NEW POSTS	SQUARE STEEL (IN)			TUBULAR STEEL Ø (IN)				SIGN FRAME REQUIRED	REMARKS	SIGN DETAIL			
								"A"	"B"	RETAIN	SALVAGE FROM	SALVAGE TO	REMOVE	RETAIN	REMOVE		1.75	2.00	2.50	FOUNDATION	3.00	3.50	4.00			5.00	DETAIL IN SHS	DETAIL ON SHEET NUMBER	DETAIL ON STD SHEET NUMBER
																	(LB / FT)				(LB / FT)								
<b>EDEN VT 100</b>							FY-FLUORESCENT YELLOW FYG-FLUORESCENT YELLOW GREEN															"SHS"-STANDARD HIGHWAY SIGNS							
		F	W13-1	18	18		30 MPH PLAQUE				1												SALVAGED FROM SB MP 4.30						
SB	4.210	G	VR-017	24	24							1		X									NORTH RD TH-1						
		G	VR-017	24	30			5.00							1		X								E-141				
SB	4.215	F	W1-6	48	24		<=== LEFT LARGE ARROW				1			X															
		H	R1-1	30	30		STOP				1			X										NORTH RD TH-1 ISLAND					
		E	W1-6	48	24		RIGHT ==> LARGE ARROW				1			X															
SB	4.209	H	R1-1	24	24							1		X										NORTH RD TH-1					
		H	R1-1	30	30			6.25							1		X								X				
SB	4.102	F	S3-1	30	30							1		X															
		F	S3-1	30	30			6.25							1		X								X				
SB	3.945	F	R2-1	24	30		SPEED LIMIT 40					1		X															
																													
SB	3.920	F	R2-1	24	30			5.00							1		X							INSTALL ACROSS FROM NORTHBOUND SPEED LIMIT 35	X				
																													
SB	3.927	G	VR-017	24	30			5.00							1		X							WHITNEY LN TH -25			E-141		
												1		X															
		H	R1-1	24	24			6.25							1		X							WHITNEY LN TH -25					
		H	R1-1	30	30																				X				
<b>SIGN SUMMARY SHEET</b>							SHEET TOTALS	33.75	0.00	3	0	1	5	0	0	6	90							PROJECT NAME: <b>Moretown-Newport Town VT100</b>					
								SF	SF	EA	EA	EA	EA	EA	EA	EA	FT							PROJECT NUMBER: <b>STPG SIGN(28)</b>					
VERMONT AGENCY OF TRANSPORTATION							TOWN TOTALS	462.5	0.0	40.0	2.0	2.0	86	0.0	0.0	77	1155.0							FILE NAME: <b>Eden.xls</b>	PLOT DATE: <b>9/30/2009</b>				
																							PROJECT MANAGER: <b>N. Avery</b>	DRAWN BY: <b>I. Shea</b>					
																							DESIGNED BY: <b>D. Crosslev</b>	CHECKED BY: <b>J. Kelly</b>					
																							EDEN SHEET 10	SHEET <b>113</b> OF <b>166</b>					



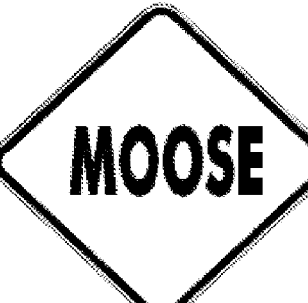

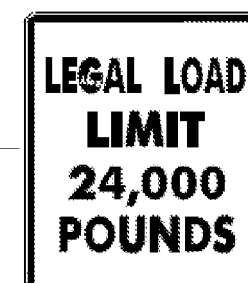

DIRECTION	MILEPOINT	LOCATION CODE (SHEET 2)	SIGN CODE	WIDTH (IN)	HEIGHT (IN)	SHEETING REMARKS	SIGN LEGEND	NEW SIGNS		EXISTING SIGNS				EXIST POST		NUMBER OF NEW POSTS	SQUARE STEEL (IN)			TUBULAR STEEL Ø (IN)				SIGN FRAME REQUIRED	REMARKS	SIGN DETAIL			
								"A"	"B"	RETAIN	SALVAGE FROM	SALVAGE TO	REMOVE	RETAIN	REMOVE		1.75	2.00	2.50	FOUNDATION	3.00	3.50	4.00			5.00	DETAIL IN SHS	DETAIL ON SHEET NUMBER	DETAIL ON STD SHEET NUMBER
																	(LB / FT)				(LB / FT)								
<b>EDEN VT 100</b>							FY-FLUORESCENT YELLOW FYG-FLUORESCENT YELLOW GREEN															"SHS"-STANDARD HIGHWAY SIGNS							
SB	3.907	A	W1-8L	18	24			3.00							1		X						INSTALL 50'+/- SOUTH OF WHITNEY LANE TH	X					
		B	W1-8R	18	24			3.00							1		X						INSTALL 51 '+/- SOUTH OF WHITNEY LANE TH	X					
SB	3.867	A	W1-8L	18	24			3.00							1		X						INSTALL 200' +/- SOUTH OF PREVIOUS CHEVRON	X					
		B	W1-8R	18	24			3.00							1		X							X					
SB	3.730	F	R2-1	24	30																								
SB	3.720	F	R2-1	24	30			5.00							1		X						INSTALL ACROSS FROM NORTHBOUND SPEED LIMIT 40						
SB	3.707	G	N/A	24	30		NO DUMPING																						
SB	3.320	G	VR-017	24	30																								
		G	VR-017	24	30			5.00							1		X									E-141			
SB	3.309	H	R1-1	30	30																								
		H	R1-1	30	30			6.25							1		X								X				
SB	3.051	F	M2-1S	21	15																								
		F	M1-5	30	24																								
		F	M2-1	21	15			2.19							1		X						GREEN ON WHITE SHEETING	X					
		F	M1-5	30	24			5.00																		E-136B			
<b>SIGN SUMMARY SHEET</b>							SHEET TOTALS	35.44	0.00	0	0	0	6	0	0	8	120								PROJECT NAME: <b>Moretown-Newport Town VT100</b>				
								SF	SF	EA	EA	EA	EA	EA	EA	EA	EA	EA	EA	EA	EA	EA	EA	EA	EA	EA	EA	PROJECT NUMBER: <b>STPG SIGN(28)</b>	FILE NAME: <b>Eden.xls</b>
VERMONT AGENCY OF TRANSPORTATION							TOWN TOTALS	462.5	0.0	40.0	2.0	2.0	86	0.0	0.0	77	1155.0						PROJECT MANAGER: <b>N. Avery</b>	DRAWN BY: <b>I. Shea</b>					
																						DESIGNED BY: <b>D. Crosslev</b>	CHECKED BY: <b>J. Kelly</b>	SHEET <b>114</b> OF <b>166</b>					







DIRECTION	MILEPOINT	LOCATION CODE (SHEET 2)	SIGN CODE	WIDTH (IN)	HEIGHT (IN)	SHEETING REMARKS	SIGN LEGEND	NEW SIGNS		EXISTING SIGNS				EXIST POST		NUMBER OF NEW POSTS	SQUARE STEEL (IN)			TUBULAR STEEL Ø (IN)				SIGN FRAME REQUIRED	REMARKS	SIGN DETAIL			
								"A"	"B"	RETAIN	SALVAGE FROM	SALVAGE TO	REMOVE	RETAIN	REMOVE		1.75	2.00	2.50	FOUNDATION	3.00	3.50	4.00			5.00	DETAIL IN SHS	DETAIL ON SHEET NUMBER	DETAIL ON STD SHEET NUMBER
																	(LB / FT)				(LB / FT)								
<b>EDEN VT 100</b>							FY-FLUORESCENT YELLOW FYG-FLUORESCENT YELLOW GREEN															"SHS"-STANDARD HIGHWAY SIGNS							
SB	2.995	G	VR-017	24	30																			SHOVER RD TH-21					
		G	VR-017	24	30			5.00																		E-141			
SB	2.985	H	R1-1	30	30																			SHOVER RD TH-21					
		H	R1-1	30	30			6.25																	X				
SB	2.969	F	D1-1A	72	10																								
		F	D1-1A	72	10																								
		F	D1-1A	72	10																								
		F	D1-1A	72	10																								
		F	D1-1A	72	12			6.00																		5			
		F	D1-1A	72	12			6.00																		5			
		F	D1-1A	72	12			6.00																		5			
		F	D1-1A	72	12			6.00																		5			
SB	2.945	F	M3-3S	24	12																								
		F	M1-5	30	24																								
		F	M6-3S	21	15																								
<b>SIGN SUMMARY SHEET</b>							SHEET TOTALS	35.25	0.00	0	0	0	9	0	0	4	60							PROJECT NAME: <b>Moretown-Newport Town VT100</b>					
								SF	SF	EA	EA	EA	EA	EA	EA	EA	EA	EA	EA	EA	EA	EA	EA	EA	EA	EA	EA	PROJECT NUMBER: <b>STPG SIGN(28)</b>	
VERMONT AGENCY OF TRANSPORTATION							TOWN TOTALS	462.5	0.0	40.0	2.0	2.0	86	0.0	0.0	77	1155.0						FILE NAME: <b>Eden.xls</b>	PLOT DATE: <b>9/30/2009</b>					
																						PROJECT MANAGER: <b>N. Avery</b>	DRAWN BY: <b>I. Shea</b>						
																						DESIGNED BY: <b>D. Crosslev</b>	CHECKED BY: <b>J. Kelly</b>						
																						EDEN SHEET 12	SHEET <b>115</b> OF <b>166</b>						

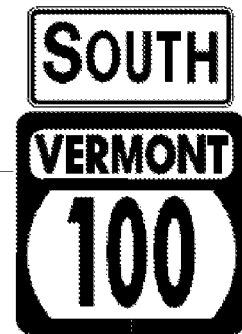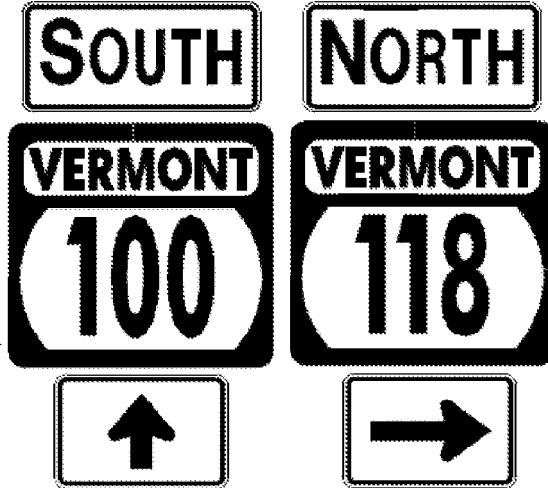
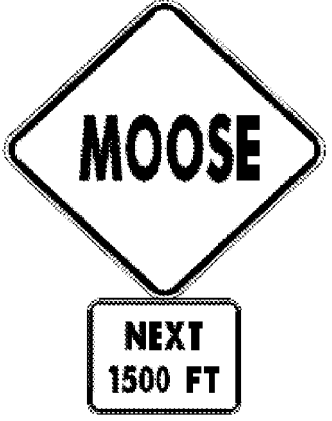


DIRECTION	MILEPOINT	LOCATION CODE (SHEET 2)	SIGN CODE	WIDTH (IN)	HEIGHT (IN)	SHEETING REMARKS	SIGN LEGEND	NEW SIGNS		EXISTING SIGNS				EXIST POST		NUMBER OF NEW POSTS	SQUARE STEEL (IN)			TUBULAR STEEL Ø (IN)				SIGN FRAME REQUIRED	REMARKS	SIGN DETAIL			
								"A"	"B"	RETAIN	SALVAGE FROM	SALVAGE TO	REMOVE	RETAIN	REMOVE		1.75	2.00	2.50	FOUNDATION	3.00	3.50	4.00			5.00	DETAIL IN SHS	DETAIL ON SHEET NUMBER	DETAIL ON STD SHEET NUMBER
																	(LB / FT)				(LB / FT)								
<b>EDEN VT 100</b>							FY-FLUORESCENT YELLOW FYG-FLUORESCENT YELLOW GREEN															"SHS"-STANDARD HIGHWAY SIGNS							
			F M3-1S	24	12																								
			F M1-5	30	24																								
			F M6-1S	21	15																								
			F M3-3	24	12						2.00								X		2B	GREEN ON WHITE SHEETING	X		7				
			F M1-5	30	24						5.00															E-136B			
			F M6-3	21	15						2.19																		
			F M3-1	24	12						2.00																		
			F M1-5	30	24						5.00																E-136B		
			F M6-1R	21	15						2.19																		
			F M3-3S	24	12																								
			F M1-5	30	24																								
			F M3-3	24	12						2.00																		
			F M1-5	30	24						5.00																E-136B		
			F R2-1	24	30																								
			F R2-1	24	30						5.00																		
<b>SIGN SUMMARY SHEET</b>							SHEET TOTALS	30.38	0.00	0	0	0	6	0	0	4	60												
								SF	SF	EA	EA	EA	EA	EA	EA	EA	EA	FT											
VERMONT AGENCY OF TRANSPORTATION							TOWN TOTALS	462.5	0.0	40.0	2.0	2.0	86	0.0	0.0	77	1155.0												
PROJECT NAME: <b>Moretown-Newport Town VT100</b>																					PROJECT NUMBER: <b>STPG SIGN(28)</b>			FILE NAME: <b>Eden.xls</b>			PLOT DATE: <b>9/30/2009</b>		
DESIGNED BY: <b>D. Crosslev</b>																					CHECKED BY: <b>J. Kelly</b>			DRAWN BY: <b>I. Shea</b>			SHEET <b>116</b> OF <b>166</b>		

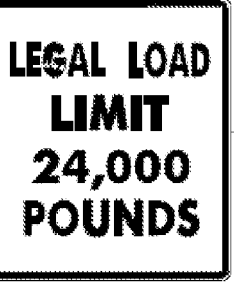


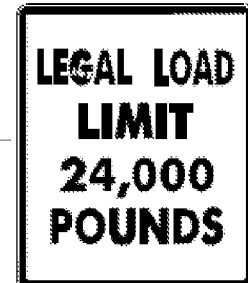


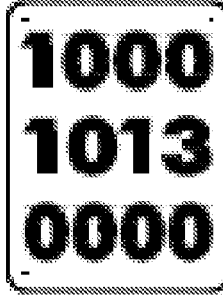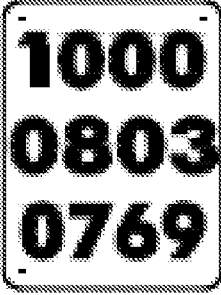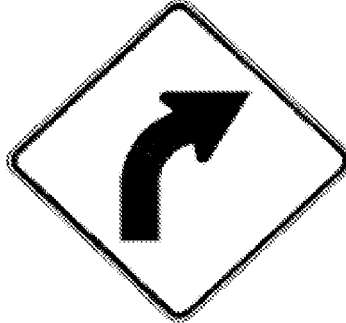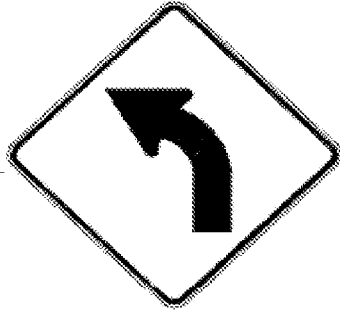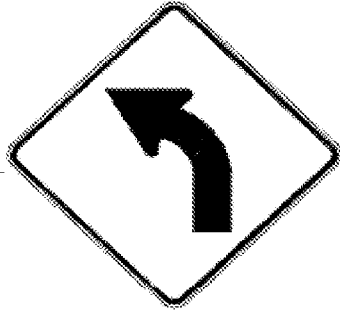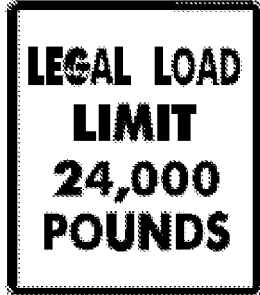DIRECTION	MILEPOINT	LOCATION CODE (SHEET 2)	SIGN CODE	WIDTH (IN)	HEIGHT (IN)	SHEETING REMARKS	SIGN LEGEND	NEW SIGNS		EXISTING SIGNS				EXIST POST		NUMBER OF NEW POSTS	SQUARE STEEL (IN)			TUBULAR STEEL Ø (IN)				SIGN FRAME REQUIRED	REMARKS	SIGN DETAIL			
								"A"	"B"	RETAIN	SALVAGE FROM	SALVAGE TO	REMOVE	RETAIN	REMOVE		1.75	2.00	2.50	FOUNDATION	3.00	3.50	4.00			5.00	DETAIL IN SHS	DETAIL ON SHEET NUMBER	DETAIL ON STD SHEET NUMBER
																	(LB / FT)				(LB / FT)								
																	1.88	2.42	3.35		7.60	9.00	10.80			14.60			
<b>EDEN VT 100</b>							FY-FLUORESCENT YELLOW FYG-FLUORESCENT YELLOW GREEN															"SHS"-STANDARD HIGHWAY SIGNS							
SB	2.808	F	W7-1	30	30		HILL																						
SB	2.160	G	VR-017	24	30																				DEUSO RD TH-15				
		G	VR-017	24	30				5.00																			E-141	
SB	2.151	H	R1-1	24	24																				DEUSO RD TH-15				
		H	R1-1	30	30				6.25																	X			
SB	2.070	F	S1-1YG	36	36		SCHOOL			1			X																
		F	W16-9YG	36	20		AHEAD			1																			
SB	1.985	F	D1-1E	72	12					1			X																
SB	1.941	G	VR-017	24	30																				KNOWLES FLAT RD TH-13				
		G	VR-017	24	30				5.00																			E-141	
SB	1.932	H	R1-1	30	30																				KNOWLES FLAT RD TH-13				
		H	R1-1	30	30				6.25																	X			
SB	1.360	F	W2-2R	30	30		RIGHT SIDE ROAD (MOD.)																						
SB	1.322	F	W2-2MaR	30	30																				INSTALL 200' +/- SOUTH OF ORIGINAL SIGN LOCATION		6		
<b>SIGN SUMMARY SHEET</b>							SHEET TOTALS	28.75	0.00	3	0	0	6	0	0	5	75							PROJECT NAME: <b>Moretown-Newport Town VT100</b>					
								SF	SF	EA	EA	EA	EA	EA	EA	EA	FT							PROJECT NUMBER: <b>STPG SIGN(28)</b>					
							TOWN TOTALS	462.5	0.0	40.0	2.0	2.0	86	0.0	0.0	77	1155.0							FILE NAME: <b>Eden.xls</b>					
																								PLOT DATE: <b>9/30/2009</b>					
																									PROJECT MANAGER: <b>N. Avery</b>				
																									DRAWN BY: <b>I. Shea</b>				
																									CHECKED BY: <b>J. Kelly</b>				
																										SHEET <b>117</b> OF <b>166</b>			
VERMONT AGENCY OF TRANSPORTATION																													

DIRECTION	MILEPOINT	LOCATION CODE (SHEET 2)	SIGN CODE	WIDTH (IN)	HEIGHT (IN)	SHEETING REMARKS	SIGN LEGEND	NEW SIGNS		EXISTING SIGNS				EXIST POST		NUMBER OF NEW POSTS	SQUARE STEEL (IN)			TUBULAR STEEL Ø (IN)				SIGN FRAME REQUIRED	REMARKS	SIGN DETAIL				
								"A"	"B"	RETAIN	SALVAGE FROM	SALVAGE TO	REMOVE	RETAIN	REMOVE		1.75	2.00	2.50	FOUNDATION	3.00	3.50	4.00			5.00	DETAIL IN SHS	DETAIL ON SHEET NUMBER	DETAIL ON STD SHEET NUMBER	
																	(LB / FT)				(LB / FT)									
<b>EDEN VT 100</b>							FY-FLUORESCENT YELLOW FYG-FLUORESCENT YELLOW GREEN															"SHS"-STANDARD HIGHWAY SIGNS								
SB	1.273	G	VR-017	24	30																									
		G	VR-017	24	30			5.00																					E-141	
SB	1.265	H	R1-1	24	24																									
		H	R1-1	30	30			6.25																		X				
SB	0.657	F	VW-001A	30	30		MOOSE SYMBOL																							
		F	W7-3A	24	18																									
		F	VW-001	30	30			6.25																					6	
		F	W7-3A	24	18			3.00																		X				
SB	0.207	G	VR-017	24	30																									
		G	VR-017	24	30			5.00																					E-141	
SB	0.196	H	R1-1	30	30																									
		H	R1-1	30	30			6.25																			X			
SB	0.000	G	VD-024	60	7.5		TOWNLIN SIGN																							
<b>SIGN SUMMARY SHEET</b>							SHEET TOTALS	31.75	0.00	0	0	0	7	0	0	5	75							PROJECT NAME: <b>Moretown-Newport Town VT100</b>						
								SF	SF	EA	EA	EA	EA	EA	EA	EA	FT							PROJECT NUMBER: <b>STPG SIGN(28)</b>						
VERMONT AGENCY OF TRANSPORTATION							TOWN TOTALS	462.5	0.0	40.0	2.0	2.0	86	0.0	0.0	77	1155.0							FILE NAME: <b>Eden.xls</b> PLOT DATE: <b>9/30/2009</b>						
																							PROJECT MANAGER: <b>N. Avery</b> DRAWN BY: <b>I. Shea</b>							
																							DESIGNED BY: <b>D. Crosslev</b> CHECKED BY: <b>J. Kelly</b>							
																							EDEN SHEET 15 SHEET <b>118</b> OF <b>166</b>							


DIRECTION	MILEPOINT	LOCATION CODE (SHEET 2)	SIGN CODE	WIDTH (IN)	HEIGHT (IN)	SHEETING REMARKS	SIGN LEGEND	NEW SIGNS		EXISTING SIGNS				EXIST POST		NUMBER OF NEW POSTS	SQUARE STEEL (IN)			TUBULAR STEEL Ø (IN)				SIGN FRAME REQUIRED	REMARKS	SIGN DETAIL													
								"A"	"B"	RETAIN	SALVAGE FROM	SALVAGE TO	REMOVE	RETAIN	REMOVE		(LB / FT)			(LB / FT)						DETAIL IN SHS	DETAIL ON SHEET NUMBER	DETAIL ON STD SHEET NUMBER											
																	1.75	2.00	2.50	3.00	3.50	4.00	5.00																
<b>LOWELL VT 100</b>							FY-FLUORESCENT YELLOW FYG-FLUORESCENT YELLOW GREEN																"SHS"-STANDARD HIGHWAY SIGNS																
NB	-0.025	C	VD-024	72	12		LOWELL / EDEN				1					X																							
		C	VD-025	72	12		ORLEANS CO. / LAMOILLE CO.				1																												
NB	0.000	C	VD-024	72	12		LOWELL/EDEN					1					2		X													INSTALL OPPOSITE BROKEN CONCRETE BOUND JUST SOUTH OF VT 100 SOUTH SIGN							
		C	VD-025	72	12		ORLEANS CO/LAMOILLE CO					1																											
		C	VD-700	6	10			0.42																										INSTALL ON LEFT POST					
		C	VD-700	6	10			0.42																										INSTALL ON RIGHT POST					
NB	0.880	A	W1-3 R	30	30		RIGHT REVERSE TURN 						1																										
NB	0.940	A	W1-2 R	30	30			6.25									1		X															INSTALL 300' +/- NORTH OF REMOVED RIGHT REVERSE TURN SIGN					
NB	1.123	A	W1-2L	30	30								1																										
		A	W1-2L	30	30			6.25									1		X																				
NB	1.638	C	VR-017	24	24		LEGAL LOAD LIMIT 24,000 LBS																											STEWART RD TH-55 (SOUTH)					
		D	R1-1	24	24		STOP																																
NB	1.800	C	VR-017	24	24																																		
		C	VR-017	24	30			5.00																															
NB	1.810	D	R1-1	24	24																														STEWART RD TH-55 (NORTH) W/STREET SIGN				
<b>SIGN SUMMARY SHEET</b>							SHEET TOTALS	18.34	0.00	0	2	2	6	0	0	5	75										PROJECT NAME: <b>Moretown-Newport Town VT100</b>												
								SF	SF	EA	EA	EA	EA	EA	EA	EA	EA	EA	EA	EA	EA	EA	EA	EA	EA	EA	EA	EA	EA	PROJECT NUMBER: <b>STPG SIGN(28)</b>									
							VERMONT AGENCY OF TRANSPORTATION	TOWN TOTALS	489.3	0.0	8.0	2.0	2.0	100	0.0	0.0	74	1110.0												FILE NAME: <b>Lowell.xls</b> PLOT DATE: <b>9/30/2009</b>									
																												PROJECT MANAGER: <b>N. Avery</b> DRAWN BY: <b>I. Shea</b>						DESIGNED BY: <b>D. Crosslev</b> CHECKED BY: <b>J. Kelly</b>					
																												LOWELL SHEET 1						SHEET <b>119</b> OF <b>166</b>					

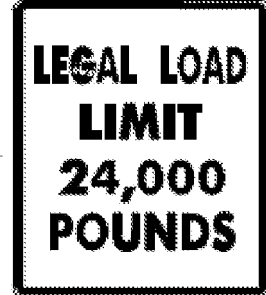DIRECTION	MILEPOINT	LOCATION CODE (SHEET 2)	SIGN CODE	WIDTH (IN)	HEIGHT (IN)	SHEETING REMARKS	SIGN LEGEND	NEW SIGNS		EXISTING SIGNS				EXIST POST		NUMBER OF NEW POSTS	SQUARE STEEL (IN)			TUBULAR STEEL Ø (IN)				SIGN FRAME REQUIRED	REMARKS	SIGN DETAIL			
								"A"	"B"	RETAIN	SALVAGE FROM	SALVAGE TO	REMOVE	RETAIN	REMOVE		1.75	2.00	2.50	FOUNDATION	3.00	3.50	4.00			5.00	DETAIL IN SHS	DETAIL ON SHEET NUMBER	DETAIL ON STD SHEET NUMBER
																	(LB / FT)				(LB / FT)								
<b>LOWELL VT 100</b>							FY-FLUORESCENT YELLOW FYG-FLUORESCENT YELLOW GREEN																"SHS"-STANDARD HIGHWAY SIGNS						
		D	R1-1	30	30			6.25							1		X								X				
NB	2.302	A	W2-3ML	30	30		MODIFIED LEFT ANGLE SIDE ROAD			1				X															
		A	W16-8A	24	8		MINK FARM RD			1																			
NB	2.350	A	S3-1	30	30		SCHOOL BUS STOP AHEAD			1			X																
NB	2.895	A	OM-3R	12	36		RIGHT OBJECT MARKER					1		X															
NB	2.905	B	OM-3L	12	36		LEFT OBJECT MARKER					1		X										X					
NB	3.130	A	VW-001	30	30							1		X															
		A	W16-4	24	18							1																	
		A	VW-001	30	30				6.25						1		X									6			
		A	W16-4	24	18				3.00															X					
NB	3.791	A	VD-062A	72	16		BUSINESS SIGN			1			X																
NB	4.050	A	R2-5C	24	30		SPEED ZONE AHEAD 					1		X															
		A	W3-5	36	36			9.00						2		X								X					
NB	4.160	A	VD-018	30	18							1		X															
		A	VD-018	30	18				3.75						1		X									E-128B			
<b>SIGN SUMMARY SHEET</b>							SHEET TOTALS	28.25	0.00	4	0	0	6	0	0	5		75											
								SF	SF	EA	EA	EA	EA	EA	EA	EA	EA					FT							
VERMONT AGENCY OF TRANSPORTATION							TOWN TOTALS	489.3	0.0	8.0	2.0	2.0	100	0.0	0.0	74		1110.0											
PROJECT NAME: <b>Moretown-Newport Town VT100</b>																						PROJECT NUMBER: <b>STPG SIGN(28)</b>							
FILE NAME: <b>Lowell.xls</b>												PLOT DATE: <b>9/30/2009</b>																	
PROJECT MANAGER: <b>N. Avery</b>												DRAWN BY: <b>I. Shea</b>																	
DESIGNED BY: <b>D. Crosslev</b>												CHECKED BY: <b>J. Kelly</b>																	
LOWELL SHEET 2												SHEET <b>120</b> OF <b>166</b>																	

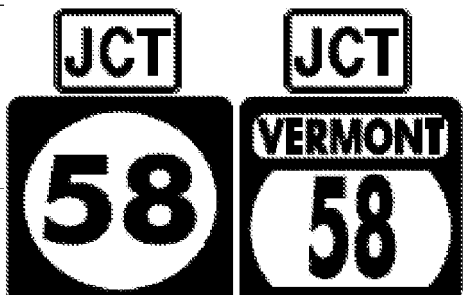




DIRECTION	MILEPOINT	LOCATION CODE (SHEET 2)	SIGN CODE	WIDTH (IN)	HEIGHT (IN)	SHEETING REMARKS	SIGN LEGEND	NEW SIGNS		EXISTING SIGNS				EXIST POST		NUMBER OF NEW POSTS	SQUARE STEEL (IN)			TUBULAR STEEL Ø (IN)				SIGN FRAME REQUIRED	REMARKS	SIGN DETAIL			
								"A"	"B"	RETAIN	SALVAGE FROM	SALVAGE TO	REMOVE	RETAIN	REMOVE		1.75	2.00	2.50	FOUNDATION	3.00	3.50	4.00			5.00	DETAIL IN SHS	DETAIL ON SHEET NUMBER	DETAIL ON STD SHEET NUMBER
																	(LB / FT)				(LB / FT)								
<b>LOWELL VT 100</b>							FY-FLUORESCENT YELLOW FYG-FLUORESCENT YELLOW GREEN															"SHS"-STANDARD HIGHWAY SIGNS							
NB	4.213	C	VR-017	24	24																		IRISH HILL RD TH-29						
		C	VR-017	24	30			5.00							1		X									E-141			
NB	4.218	D	R1-1	24	24																			IRISH HILL RD TH-29					
		D	R1-1	30	30			6.25							1		X							X					
NB	4.222	A	VD-370	24	24		BAYLEY HAZEN MILITARY ROAD				1			X															
NB	4.240	A	R2-1	24	30																								
		A	R2-1	30	36			7.50							1		X									6			
NB	4.263	A	M2-1	21	15																								
		A	M1-6	24	24																								
		A	M2-1	21	15																								
		A	M1-5	24	24																								
		A	M2-1	21	15																								
		A	M1-6	24	24			4.00																		E-136B			
NB	4.283	A	D1-1A	72	10																								
		A	D1-1A	72	10																								
<b>SIGN SUMMARY SHEET</b>							<b>SHEET TOTALS</b>	31.13	0.00	1	0	0	7	0	0	5	75							PROJECT NAME: <b>Moretown-Newport Town VT100</b>					
								SF	SF	EA	EA	EA	EA	EA	EA	EA	FT							PROJECT NUMBER: <b>STPG SIGN(28)</b>					
																								FILE NAME: <b>Lowell.xls</b>	PLOT DATE: <b>9/30/2009</b>				
VERMONT AGENCY OF TRANSPORTATION							<b>TOWN TOTALS</b>	489.3	0.0	8.0	2.0	2.0	100	0.0	0.0	74	1110.0							PROJECT MANAGER: <b>N. Avery</b>	DRAWN BY: <b>I. Shea</b>				
																							DESIGNED BY: <b>D. Crosslev</b>	CHECKED BY: <b>J. Kelly</b>					
																							LOWELL SHEET 3	SHEET <b>121</b> OF <b>166</b>					

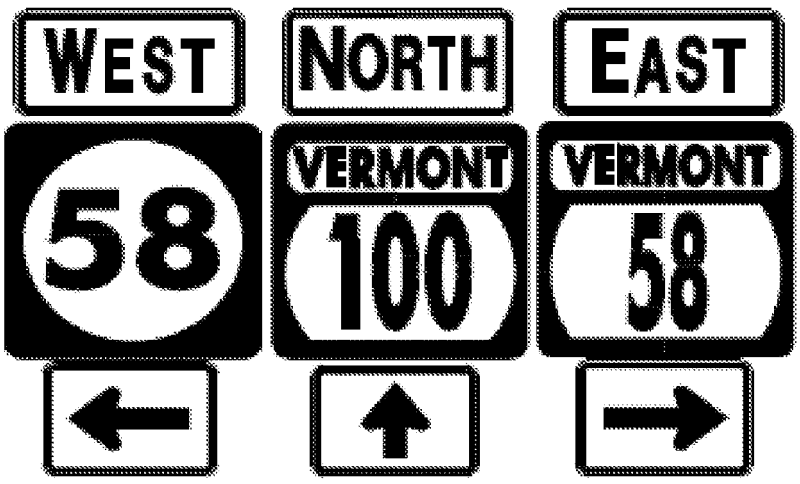DIRECTION	MILEPOINT	LOCATION CODE (SHEET 2)	SIGN CODE	WIDTH (IN)	HEIGHT (IN)	SHEETING REMARKS	SIGN LEGEND	NEW SIGNS		EXISTING SIGNS				EXIST POST		NUMBER OF NEW POSTS	SQUARE STEEL (IN)			TUBULAR STEEL Ø (IN)				SIGN FRAME REQUIRED	REMARKS	SIGN DETAIL																		
								"A"	"B"	RETAIN	SALVAGE FROM	SALVAGE TO	REMOVE	RETAIN	REMOVE		1.75	2.00	2.50	FOUNDATION	3.00	3.50	4.00			5.00	DETAIL IN SHS	DETAIL ON SHEET NUMBER	DETAIL ON STD SHEET NUMBER															
																	(LB / FT)				(LB / FT)																							
<b>LOWELL VT 100</b>							FY-FLUORESCENT YELLOW FYG-FLUORESCENT YELLOW GREEN															"SHS"-STANDARD HIGHWAY SIGNS																						
			A	D1-1A	72	10																																						
			A	D1-1A	72	10																																						
			A	D1-1A	72	12		6.00							2				X																	5								
			A	D1-1A	72	12		6.00																														5						
			A	D1-1A	72	12		6.00																															5					
			A	D1-1A	72	12		6.00																															5					
			A	D1-1A	72	12		6.00																															5					
NB	4.348		A	M3-4	24	12																																						
			A	M1-6	24	24																																						
			A	M6-1 L	21	15																																						
			A	M3-1	24	12																																						
			A	M1-6	30	24																																						
			A	M6-3	21	15																																						
			A	M3-2	24	12																																						
			A	M1-6	24	24																																						
			A	M6-1 R	21	15																																						
<b>SIGN SUMMARY SHEET</b>							SHEET TOTALS	24.00	0.00	0	0	0	11	0	0	2	30																											
								SF	SF	EA	EA	EA	EA	EA	EA	EA	FT																											
VERMONT AGENCY OF TRANSPORTATION							TOWN TOTALS	489.3	0.0	8.0	2.0	2.0	100	0.0	0.0	74	1110.0																											



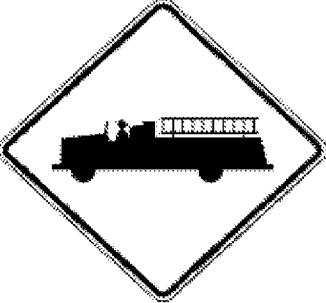



DIRECTION	MILEPOINT	LOCATION CODE (SHEET 2)	SIGN CODE	WIDTH (IN)	HEIGHT (IN)	SHEETING REMARKS	SIGN LEGEND	NEW SIGNS		EXISTING SIGNS				EXIST POST		NUMBER OF NEW POSTS	SQUARE STEEL (IN)			TUBULAR STEEL Ø (IN)				SIGN FRAME REQUIRED	REMARKS	SIGN DETAIL		
								"A"	"B"	RETAIN	SALVAGE FROM	SALVAGE TO	REMOVE	RETAIN	REMOVE		(LB / FT)			(LB / FT)						DETAIL IN SHS	DETAIL ON SHEET NUMBER	DETAIL ON STD SHEET NUMBER
																	1.75	2.00	2.50	FOUNDATION	3.00	3.50	4.00					
<b>LOWELL VT 100</b>							FY-FLUORESCENT YELLOW FYG-FLUORESCENT YELLOW GREEN																"SHS"-STANDARD HIGHWAY SIGNS					
		A	M3-4	24	12			2.00							2			X					3B	BLACK ON WHITE SHEETING	X	7		
		A	M1-6	24	24			4.00																X				
		A	M6-1 L	21	15			2.19																BLACK ON WHITE SHEETING	X			
		A	M3-1	24	12			2.00																GREEN ON WHITE SHEETING	X			
		A	M1-5	30	24			5.00																		E-136B		
		A	M6-3	21	15			2.19																GREEN ON WHITE SHEETING	X			
		A	M3-2	24	12			2.00																GREEN ON WHITE SHEETING	X			
		A	M1-5	24	24			4.00																		E-136B		
		A	M6-1 R	21	15			2.19																GREEN ON WHITE SHEETING	X			
NB	4.385	C	D1-1	72	12																							
		C	D1-1	72	12																							
		C	D1-1	72	12																							
		C	M3-1	24	12																							
		C	M1-5	30	24																							
		C	M6-1 L	21	15																							
<b>SIGN SUMMARY SHEET</b>							SHEET TOTALS	25.57	0.00	0	0	0	6	0	0	2	30							PROJECT NAME: <b>Moretown-Newport Town VT100</b>				
								SF	SF	EA	EA	EA	EA	EA	EA	EA	FT						PROJECT NUMBER: <b>STPG SIGN(28)</b>					
VERMONT AGENCY OF TRANSPORTATION							TOWN TOTALS	489.3	0.0	8.0	2.0	2.0	100	0.0	0.0	74	1110.0						FILE NAME: <b>Lowell.xls</b>	PLOT DATE: <b>9/30/2009</b>				
																						PROJECT MANAGER: <b>N. Avery</b>	DRAWN BY: <b>I. Shea</b>					
																						DESIGNED BY: <b>D. Crosslev</b>	CHECKED BY: <b>J. Kelly</b>					
																						LOWELL SHEET 5	SHEET <b>123</b> OF <b>166</b>					




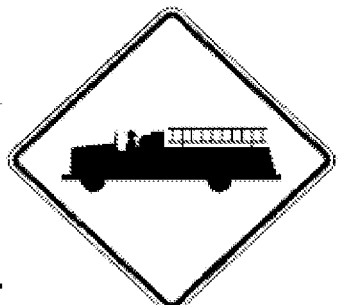
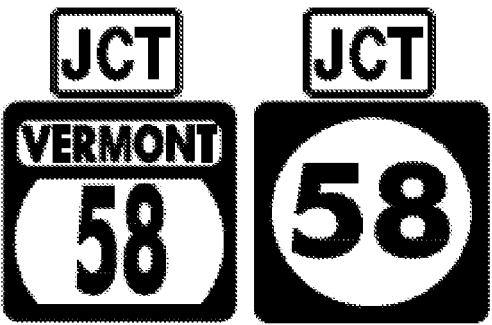




DIRECTION	MILEPOINT	LOCATION CODE (SHEET 2)	SIGN CODE	WIDTH (IN)	HEIGHT (IN)	SHEETING REMARKS	SIGN LEGEND	NEW SIGNS		EXISTING SIGNS				EXIST POST		NUMBER OF NEW POSTS	SQUARE STEEL (IN)			TUBULAR STEEL Ø (IN)				SIGN FRAME REQUIRED	REMARKS	SIGN DETAIL			
								"A"	"B"	RETAIN	SALVAGE FROM	SALVAGE TO	REMOVE	RETAIN	REMOVE		1.75	2.00	2.50	FOUNDATION	3.00	3.50	4.00			5.00	DETAIL IN SHS	DETAIL ON SHEET NUMBER	DETAIL ON STD SHEET NUMBER
																	(LB / FT)				(LB / FT)								
<b>LOWELL VT 100</b>							FY-FLUORESCENT YELLOW FYG-FLUORESCENT YELLOW GREEN																"SHS"-STANDARD HIGHWAY SIGNS						
		C	M3-3	24	12			2.00																GREEN ON WHITE SHEETING	X				
		C	M1-5	30	24			5.00																		E-136B			
		C	M6-1 R	21	15			2.19																GREEN ON WHITE SHEETING	X				
NB	4.395	F	W11-8	30	30							1	X																
		F	W11-8	30	30			6.25						1	X											X			
NB	4.410	A	M3-1	24	12							1	X																
		A	M1-6	30	24							1																	
		A	M3-1	24	12			2.00						1	X										GREEN ON WHITE SHEETING	X			
		A	M1-5	30	24			5.00																		E-136B			
NB	4.443	A	D2-1	72	10		TROY 10					1	X																
		A	D2-1	72	12			6.00						2	X												5		
		A	D2-1	72	12			6.00																					
NB	4.478	A	R2-1	24	30							1	X																
		A	R2-1	24	30			5.00						1	X											X			
NB	4.670	A	S1-1	36	36							1	X																
<b>SIGN SUMMARY SHEET</b>							SHEET TOTALS	34.44	0.00	0	0	0	6	0	0	5	75												
								SF	SF	EA	EA	EA	EA	EA	EA	EA	FT												
VERMONT AGENCY OF TRANSPORTATION							TOWN TOTALS	489.3	0.0	8.0	2.0	2.0	100	0.0	0.0	74	1110.0												
PROJECT NAME: <b>Moretown-Newport Town VT100</b>																					PROJECT NUMBER: <b>STPG SIGN(28)</b>								
FILE NAME: <b>Lowell.xls</b>														PLOT DATE: <b>9/30/2009</b>															
PROJECT MANAGER: <b>N. Avery</b>														DRAWN BY: <b>I. Shea</b>															
DESIGNED BY: <b>D. Crosslev</b>														CHECKED BY: <b>J. Kelly</b>															
LOWELL SHEET 7														SHEET <b>125</b> OF <b>166</b>															

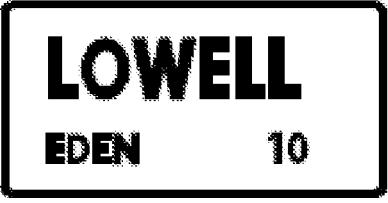





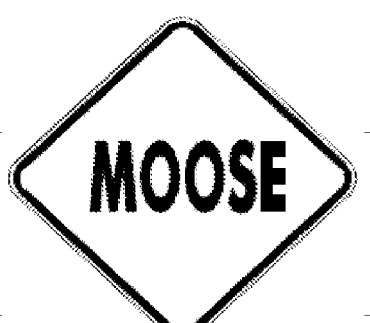
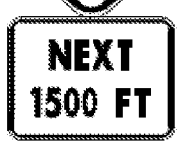







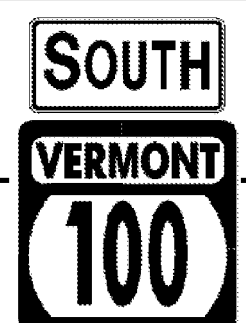

DIRECTION	MILEPOINT	LOCATION CODE (SHEET 2)	SIGN CODE	WIDTH (IN)	HEIGHT (IN)	SHEETING REMARKS	SIGN LEGEND	NEW SIGNS		EXISTING SIGNS				EXIST POST		NUMBER OF NEW POSTS	SQUARE STEEL (IN)			TUBULAR STEEL Ø (IN)				SIGN FRAME REQUIRED	REMARKS	SIGN DETAIL								
								"A"	"B"	RETAIN	SALVAGE FROM	SALVAGE TO	REMOVE	RETAIN	REMOVE		1.75	2.00	2.50	FOUNDATION	3.00	3.50	4.00			5.00	DETAIL IN SHS	DETAIL ON SHEET NUMBER	DETAIL ON STD SHEET NUMBER					
																	(LB / FT)				(LB / FT)													
<b>LOWELL VT 100</b>							FY-FLUORESCENT YELLOW FYG-FLUORESCENT YELLOW GREEN															"SHS"-STANDARD HIGHWAY SIGNS												
SB	5.600	G	VM-607	24	30		43RD INF DIV MEMORIAL HIGHWAY			1			X																					
SB	5.553	G	VR-017	24	24								1		X																			
		G	VR-017	24	30				5.00						1		X													E-141				
SB	5.546	H	R1-1	24	24																													
		H	R1-1	30	30				6.25						1		X										X							
SB	5.390	F	W11-6 H	30	30																													
		F	W11-6 H	30	30				6.25						1		X														E-153			
SB	5.350	F	W11-6 H	30	30		SNOWMOBILE - HINGED							1		X																		
SB	5.037	F	R2-5C	24	30		SPEED ZONE AHEAD 																											
		F	W3-5	36	36				9.00						2		X										X							
SB	4.959	F	VD-018	30	18																													
		F	VD-018	30	18				3.75						1		X														E-128B			
SB	4.904	F	W11-6 H	30	30		SNOWMOBILE - HINGED							1		X																		
SB	4.880	F	R2-1	24	30																													
		F	R2-1	30	36				7.50						1		X												6					
SB	4.871	F	S1-1	36	36									1		X																		
<b>SIGN SUMMARY SHEET</b>							SHEET TOTALS	37.75	0.00	1	0	0	8	0	0	7	105																	
								SF	SF	EA	EA	EA	EA	EA	EA	EA	EA	EA	EA	EA	EA	EA	EA	EA	EA	EA	EA	EA	EA	EA	EA	EA	EA	EA
VERMONT AGENCY OF TRANSPORTATION							TOWN TOTALS	489.3	0.0	8.0	2.0	2.0	100	0.0	0.0	74	1110.0																	
							PROJECT NAME: <b>Moretown-Newport Town VT100</b>																											
							PROJECT NUMBER: <b>STPG SIGN(28)</b>																											
							FILE NAME: <b>Lowell.xls</b>																PLOT DATE: <b>9/30/2009</b>											
							PROJECT MANAGER: <b>N. Avery</b>																DRAWN BY: <b>I. Shea</b>											
							DESIGNED BY: <b>D. Crosslev</b>																CHECKED BY: <b>J. Kelly</b>											
							LOWELL SHEET 9																SHEET <b>127</b> OF <b>166</b>											

DIRECTION	MILEPOINT	LOCATION CODE (SHEET 2)	SIGN CODE	WIDTH (IN)	HEIGHT (IN)	SHEETING REMARKS	SIGN LEGEND	NEW SIGNS		EXISTING SIGNS				EXIST POST		NUMBER OF NEW POSTS	SQUARE STEEL (IN)			TUBULAR STEEL Ø (IN)				SIGN FRAME REQUIRED	REMARKS	SIGN DETAIL			
								"A"	"B"	RETAIN	SALVAGE FROM	SALVAGE TO	REMOVE	RETAIN	REMOVE		1.75	2.00	2.50	FOUNDATION	3.00	3.50	4.00			5.00	DETAIL IN SHS	DETAIL ON SHEET NUMBER	DETAIL ON STD SHEET NUMBER
																	(LB / FT)				(LB / FT)								
<b>LOWELL VT 100</b>							FY-FLUORESCENT YELLOW FYG-FLUORESCENT YELLOW GREEN															"SHS"-STANDARD HIGHWAY SIGNS							
			S1-1	36	36	FYG		6.25							2		X								X				
			W16-9	24	12	FYG		2.00																	X				
SB	4.820	F	D1-1	72	20			10.00							2		X									5	INSTALL 250'+/- NORTH OF SCHOOL DRIVE.		
SB	4.602	F	W11-8	30	30							1																	
		F	W11-8	30	30			6.25							1		X								X				
SB	4.505	F	M2-1	21	15							1																	
		F	M1-6	24	24							1																	
		F	M2-1	21	15			2.19							2		X						1		7	GREEN ON WHITE SHEETING			
		F	M1-5	24	24			4.00																					
		F	M2-1	21	15			2.19																					
		F	M1-6	24	24			4.00																					
SB	4.460	F	D1-1	72	10							1																	
		F	D1-1	72	10							1																	
		F	D1-1	72	10							1																	
		F	D1-1	72	12			6.00							2			X								5			
<b>SIGN SUMMARY SHEET</b>							SHEET TOTALS	42.88	0.00	0	0	0	6	0	0	9	135												
								SF	SF	EA	EA	EA	EA	EA	EA	EA	EA	EA	EA	EA	EA	EA	EA	EA	EA	EA	EA	EA	EA
VERMONT AGENCY OF TRANSPORTATION							TOWN TOTALS	489.3	0.0	8.0	2.0	2.0	100	0.0	0.0	74	1110.0												
							PROJECT NAME:	<b>Moretown-Newport Town VT100</b>																					
							PROJECT NUMBER:	<b>STPG SIGN(28)</b>																					
							FILE NAME:	<b>Lowell.xls</b>											PLOT DATE:	<b>9/30/2009</b>									
							PROJECT MANAGER:	<b>N. Avery</b>											DRAWN BY:	<b>I. Shea</b>									
							DESIGNED BY:	<b>D. Crosslev</b>											CHECKED BY:	<b>J. Kelly</b>									
							LOWELL SHEET 10												SHEET	<b>128</b> OF <b>166</b>									




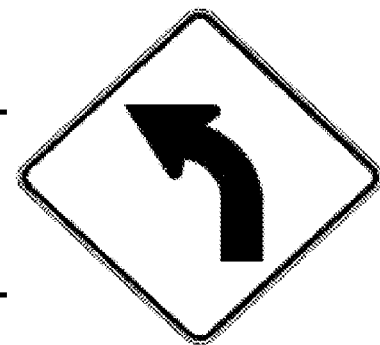
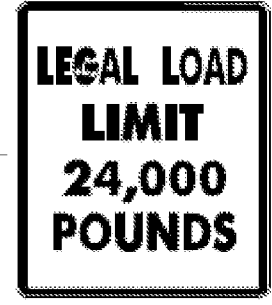
DIRECTION	MILEPOINT	LOCATION CODE (SHEET 2)	SIGN CODE	WIDTH (IN)	HEIGHT (IN)	SHEETING REMARKS	SIGN LEGEND	NEW SIGNS		EXISTING SIGNS				EXIST POST		NUMBER OF NEW POSTS	SQUARE STEEL (IN)			TUBULAR STEEL Ø (IN)				SIGN FRAME REQUIRED	REMARKS	SIGN DETAIL		
								"A"	"B"	RETAIN	SALVAGE FROM	SALVAGE TO	REMOVE	RETAIN	REMOVE		(LB / FT)			(LB / FT)						DETAIL IN SHS	DETAIL ON SHEET NUMBER	DETAIL ON STD SHEET NUMBER
																	1.75	2.00	2.50	3.00	3.50	4.00	5.00					
<b>LOWELL VT 100</b>							FY-FLUORESCENT YELLOW FYG-FLUORESCENT YELLOW GREEN																"SHS"-STANDARD HIGHWAY SIGNS					
		F	D1-1	72	12																							
		F	D1-1	72	12			6.00																		5		
		F	D1-1	72	12			6.00																		5		
		F	D1-1	72	12			6.00																		5		
SB	4.400	F	M3-2	24	12																							
		F	M1-6	24	24																							
		F	M6-1 L	21	15																							
		F	M3-3	24	12																							
		F	M1-6	30	24																							
		F	M6-3	21	15																							
		F	M3-3	24	12																							
		F	M1-6	24	24																							
		F	M6-1	21	15																							
		F	M3-2	24	12			2.00																				
		F	M1-5	24	24			4.00																	E-136B			
		F	M6-1 L	21	15			2.19																				
<b>SIGN SUMMARY SHEET</b>							SHEET TOTALS	26.19	0.00	0	0	0	9	0	0	2	30											
							SF	SF	EA	EA	EA	EA	EA	EA	EA	EA	FT											
VERMONT AGENCY OF TRANSPORTATION							TOWN TOTALS	489.3	0.0	8.0	2.0	2.0	100	0.0	0.0	74	1110.0											
							PROJECT NAME:	<b>Moretown-Newport Town VT100</b>																				
							PROJECT NUMBER:	<b>STPG SIGN(28)</b>																				
							FILE NAME:	<b>Lowell.xls</b>										PLOT DATE:	<b>9/30/2009</b>									
							PROJECT MANAGER:	<b>N. Avery</b>										DRAWN BY:	<b>I. Shea</b>									
							DESIGNED BY:	<b>D. Crosslev</b>										CHECKED BY:	<b>J. Kelly</b>									
							LOWELL SHEET 11	SHEET <b>129</b> OF <b>166</b>																				

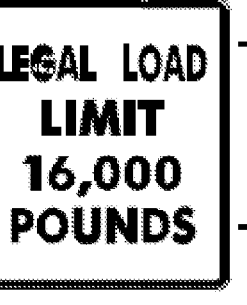







DIRECTION	MILEPOINT	LOCATION CODE (SHEET 2)	SIGN CODE	WIDTH (IN)	HEIGHT (IN)	SHEETING REMARKS	SIGN LEGEND	NEW SIGNS		EXISTING SIGNS				EXIST POST		NUMBER OF NEW POSTS	SQUARE STEEL (IN)			TUBULAR STEEL Ø (IN)				SIGN FRAME REQUIRED	REMARKS	SIGN DETAIL			
								"A"	"B"	RETAIN	SALVAGE FROM	SALVAGE TO	REMOVE	RETAIN	REMOVE		1.75	2.00	2.50	FOUNDATION	3.00	3.50	4.00			5.00	DETAIL IN SHS	DETAIL ON SHEET NUMBER	DETAIL ON STD SHEET NUMBER
																	(LB / FT)				(LB / FT)								
<b>LOWELL VT 100</b>							FY-FLUORESCENT YELLOW FYG-FLUORESCENT YELLOW GREEN															"SHS"-STANDARD HIGHWAY SIGNS							
		F	M3-3	24	12			2.00																GREEN ON WHITE SHEETING	X				
		F	M1-5	30	24			5.00																		E-136B			
		F	M6-3	21	15			2.19																GREEN ON WHITE SHEETING	X				
		F	M3-3	24	12			2.00																BLACK ON WHITE SHEETING					
		F	M1-6	24	24			4.00																		E-136B			
		F	M6-1R	21	15			2.19																BLACK ON WHITE SHEETING	X				
SB	4.391	G	VR-017	24	24																			HAZEN NOTCH RD TH-1 SNR					
		H	R1-1	24	24	STOP		5.00																		E-141			
		G	VR-017	24	30			5.00																		E-141			
SB	4.477	H	R1-1	24	24																				HAZEN NOTCH RD TH-1 SNR				
		H	R1-1	36	36			9.00																	X				
SB	4.481	F	VD-370	24	24		BAYLEY HAZEN MILITARY ROAD																						
SB	4.357	F	M3-3	24	12																								
		F	M1-6	24	24																								
		F	M3-3	24	12			2.00																GREEN ON WHITE SHEETING	X				
<b>SIGN SUMMARY SHEET</b>							SHEET TOTALS	33.38	0.00	0	0	0	6	0	0	4	60							PROJECT NAME: <b>Moretown-Newport Town VT100</b>					
								SF	SF	EA	EA	EA	EA	EA	EA	EA	EA	EA	EA	EA	EA	EA	EA		PROJECT NUMBER: <b>STPG SIGN(28)</b>				
VERMONT AGENCY OF TRANSPORTATION							TOWN TOTALS	489.3	0.0	8.0	2.0	2.0	100	0.0	0.0	74	1110.0							FILE NAME: <b>Lowell.xls</b>					
																								PLOT DATE: <b>9/30/2009</b>					
																									DRAWN BY: <b>I. Shea</b>				
																									CHECKED BY: <b>J. Kelly</b>				
																									SHEET <b>130</b> OF <b>166</b>				

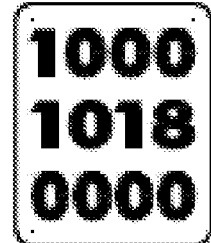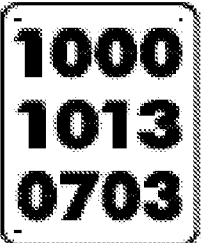
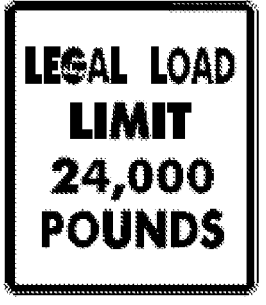





DIRECTION	MILEPOINT	LOCATION CODE (SHEET 2)	SIGN CODE	WIDTH (IN)	HEIGHT (IN)	SHEETING REMARKS	SIGN LEGEND	NEW SIGNS		EXISTING SIGNS				EXIST POST		NUMBER OF NEW POSTS	SQUARE STEEL (IN)			TUBULAR STEEL Ø (IN)				SIGN FRAME REQUIRED	REMARKS	SIGN DETAIL			
								"A"	"B"	RETAIN	SALVAGE FROM	SALVAGE TO	REMOVE	RETAIN	REMOVE		1.75	2.00	2.50	FOUNDATION	3.00	3.50	4.00			5.00	DETAIL IN SHS	DETAIL ON SHEET NUMBER	DETAIL ON STD SHEET NUMBER
																	(LB / FT)				(LB / FT)								
<b>LOWELL VT 100</b>							FY-FLUORESCENT YELLOW FYG-FLUORESCENT YELLOW GREEN															"SHS"-STANDARD HIGHWAY SIGNS							
		F	M1-5	30	24			5.00																		E-136B			
SB	4.317	F	D2-1	72	10								1		X														
		F	D2-1	72	12			6.00									2		X								5		
		F	D2-1	72	12			6.00																			5		
SB	4.240	F	R2-1	24	30									1		X													
		F	R2-1	24	30			5.00									1		X						X		INSTALL ACROSS FROM NORTHBOUND SPEED LIMIT 35		
SB	4.180	G	VR-017	24	30			5.00									1		X							LOWER VILLAGE RD TH-2			
SB	4.173	H	R1-1	24	24									1		X											LOWER VILLAGE RD TH-2		
		H	R1-1	30	30			6.25									1		X					X					
SB	4.160	F	R2-1	24	30		SPEED LIMIT 50							1		X													
SB	3.500	F	VW-001	30	30									1		X													
		F	W16-4	24	18									1															
		F	VW-001	30	30			6.25									1		X							6			
		F	W16-4	24	18			3.00																					
SB	3.269	G	VR-017	24	24									1		X										FINNEGAN RD TH-57			
<b>SIGN SUMMARY SHEET</b>							SHEET TOTALS	42.50	0.00	0	0	0	7	0	0	6	90												PROJECT NAME: <b>Moretown-Newport Town VT100</b>
								SF	SF	EA	EA	EA	EA	EA	EA	EA	EA	EA	EA	EA	EA	EA	EA	EA	EA	EA	EA	EA	EA
VERMONT AGENCY OF TRANSPORTATION							TOWN TOTALS	489.3	0.0	8.0	2.0	2.0	100	0.0	0.0	74	1110.0										FILE NAME: <b>Lowell.xls</b>		
																											PLOT DATE: <b>9/30/2009</b>		
																												DRAWN BY: <b>I. Shea</b>	
																												CHECKED BY: <b>J. Kelly</b>	
																												SHEET <b>131</b> OF <b>166</b>	




DIRECTION	MILEPOINT	LOCATION CODE (SHEET 2)	SIGN CODE	WIDTH (IN)	HEIGHT (IN)	SHEETING REMARKS	SIGN LEGEND	NEW SIGNS		EXISTING SIGNS				EXIST POST		NUMBER OF NEW POSTS	SQUARE STEEL (IN)			TUBULAR STEEL Ø (IN)				SIGN FRAME REQUIRED	REMARKS	SIGN DETAIL			
								"A"	"B"	RETAIN	SALVAGE FROM	SALVAGE TO	REMOVE	RETAIN	REMOVE		1.75	2.00	2.50	FOUNDATION	3.00	3.50	4.00			5.00	DETAIL IN SHS	DETAIL ON SHEET NUMBER	DETAIL ON STD SHEET NUMBER
																	(LB / FT)				(LB / FT)								
<b>LOWELL VT 100</b>							FY-FLUORESCENT YELLOW FYG-FLUORESCENT YELLOW GREEN															"SHS"-STANDARD HIGHWAY SIGNS							
			G	VR-017	24	30		5.00							1		X										E-141		
SB	3.261		H	R1-1	24	24																					FINNEGAN RD TH-57		
			H	R1-1	30	30		6.25							1		X							X					
SB	2.905		F	OM-3R	12	36	RIGHT OBJECT MARKER																						
SB	2.895		E	OM-3L	12	36	LEFT OBJECT MARKER																						
SB	2.554		G	VR-017	24	30		5.00							1		X										RICABY RD TH-21		
SB	2.546		H	R1-1	24	24																					RICABY RD TH-21		
			G	VR-017	24	24	LEGAL LOAD LIMIT 16,000 LBS																						
			H	R1-1	30	30		6.25							1		X							X					
SB	2.400		G	VR-017	24	30		5.00							1		X										MINK FARM RD TH-15 (NORTH)		
SB	2.390		H	R1-1	24	24																					MINK FARM RD TH-15 (NORTH)		
			G	VR-017	24	24	LEGAL LOAD LIMIT 24,000 LBS																						
			H	R1-1	30	30		6.25							1		X							X					
SB	1.808		G	VR-017	24	30		5.00							1		X										MINK FARM RD TH-15 (SOUTH)		
SB	1.800		H	R1-1	24	24																					MINK FARM RD TH-15 (SOUTH)		
<b>SIGN SUMMARY SHEET</b>							SHEET TOTALS	38.75	0.00	0	0	0	8	0	0	7	105												PROJECT NAME: <b>Moretown-Newport Town VT100</b>
								SF	SF	EA	EA	EA	EA	EA	EA	EA	EA	EA	EA	EA	EA	FT							
VERMONT AGENCY OF TRANSPORTATION							TOWN TOTALS	489.3	0.0	8.0	2.0	2.0	100	0.0	0.0	74	1110.0										FILE NAME: <b>Lowell.xls</b>		
																											PLOT DATE: <b>9/30/2009</b>		
																												PROJECT MANAGER: <b>N. Avery</b>	
																												DRAWN BY: <b>I. Shea</b>	
																													DESIGNED BY: <b>D. Crosslev</b>
																													CHECKED BY: <b>J. Kelly</b>
																													SHEET <b>132</b> OF <b>166</b>

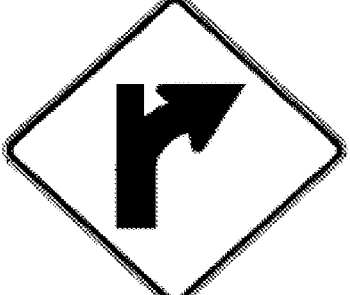


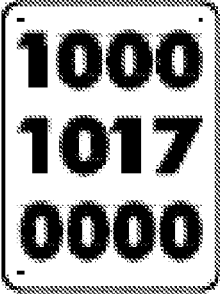
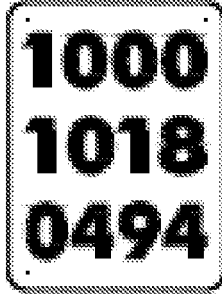



DIRECTION	MILEPOINT	LOCATION CODE (SHEET 2)	SIGN CODE	WIDTH (IN)	HEIGHT (IN)	SHEETING REMARKS	SIGN LEGEND	NEW SIGNS		EXISTING SIGNS				EXIST POST		NUMBER OF NEW POSTS	SQUARE STEEL (IN)			TUBULAR STEEL Ø (IN)				SIGN FRAME REQUIRED	REMARKS	SIGN DETAIL			
								"A"	"B"	RETAIN	SALVAGE FROM	SALVAGE TO	REMOVE	RETAIN	REMOVE		1.75	2.00	2.50	FOUNDATION	3.00	3.50	4.00			5.00	DETAIL IN SHS	DETAIL ON SHEET NUMBER	DETAIL ON STD SHEET NUMBER
																	(LB / FT)				(LB / FT)								
<b>WESTFIELD VT 100</b>							FY-FLUORESCENT YELLOW FYG-FLUORESCENT YELLOW GREEN															"SHS"-STANDARD HIGHWAY SIGNS							
NB	0.000	C	VD-024	72	10		<b>WESTFIELD</b>	5.00						2		X							INSTALL OPPOSITE EXISTING SB TOWNLINER SIGN		4				
		C	VD-700	6	10			0.42																					
		C	VD-700	6	10			0.42																					
NB	0.120	A	OM-3R	12	36		RIGHT OBJECT MARKER						1		X											X			
NB	0.142	B	OM-3L	12	36		LEFT OBJECT MARKER						1		X														
NB	0.570	A	W11-6	30	30		 MISSING						+		*														
		A	W11-6H	30	30			6.25						1		X							INSTALL IN CLOSED POSITION			E-152			
NB	1.130	A	W11-6	30	30		SNOWMOBILE - HINGED						1		X														
NB	1.153	D	R1-1	24	24		STOP						1		X								TH-23 CLASS 4						
NB	1.917	A	W1-2L	30	30		LEFT CURVE						1		X														
NB	1.974	A	W1-2L	30	30			6.25						1		X							INSTALL 300'+/- NORTH OF ORIGINAL SIGN LOCATION	X					
NB	3.135	C	VR-017	24	30								1		X								CEMETERY RD TH- 15						
		C	VR-017	24	30			5.00						1		X										E-141			
<b>SIGN SUMMARY SHEET</b>							SHEET TOTALS	23.34	0.00	0	0	0	7	0	0	5	75								PROJECT NAME: <b>Moretown-Newport Town VT100</b>				
								SF	SF	EA	EA	EA	EA	EA	EA	EA	EA	EA	EA	EA	EA	EA	EA	EA	EA	EA	EA	PROJECT NUMBER: <b>STPG SIGN(28)</b>	FILE NAME: <b>Westfield.xls</b>
VERMONT AGENCY OF TRANSPORTATION							TOWN TOTALS	149.5	0.0	15.0	0.0	0.0	28	0.0	0.0	26	390.0							PROJECT MANAGER: <b>N. Avery</b>	DRAWN BY: <b>I. Shea</b>				
																						DESIGNED BY: <b>D. Crosslev</b>	CHECKED BY: <b>J. Kelly</b>	SHEET <b>134</b> OF <b>166</b>					





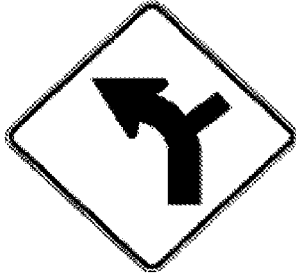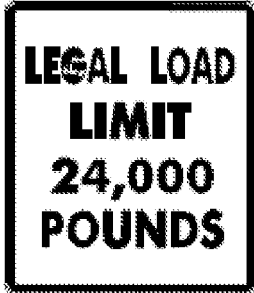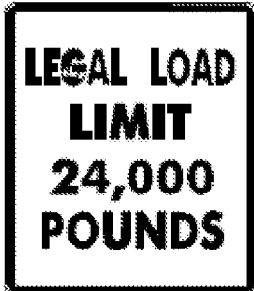

DIRECTION	MILEPOINT	LOCATION CODE (SHEET 2)	SIGN CODE	WIDTH (IN)	HEIGHT (IN)	SHEETING REMARKS	SIGN LEGEND	NEW SIGNS		EXISTING SIGNS				EXIST POST		NUMBER OF NEW POSTS	SQUARE STEEL (IN)			TUBULAR STEEL Ø (IN)				SIGN FRAME REQUIRED	REMARKS	SIGN DETAIL			
								"A"	"B"	RETAIN	SALVAGE FROM	SALVAGE TO	REMOVE	RETAIN	REMOVE		1.75	2.00	2.50	FOUNDATION	3.00	3.50	4.00			5.00	DETAIL IN SHS	DETAIL ON SHEET NUMBER	DETAIL ON STD SHEET NUMBER
																	(LB / FT)				(LB / FT)								
<b>WESTFIELD VT 100</b>							FY-FLUORESCENT YELLOW FYG-FLUORESCENT YELLOW GREEN															"SHS"-STANDARD HIGHWAY SIGNS							
NB	3.145	D	R1-1	24	24																								
		D	R1-1	30	30			6.25															X						
NB	3.360	A	R2-5A	24	30		REDUCED SPEED AHEAD 																						
		A	W3-5	36	36			9.00															X						
NB	3.430	A	VD-018	30	18		WESTFIELD TROY 2			1																			
NB	3.500	A	R2-1	24	30																								
		A	R2-1	30	36			7.50																	6				
NB	3.700	A	W1-2R	30	30		RIGHT CURVE																						
NB	3.740	A	D1-1A	72	10		<--- (45 DEG) JAY 5																						
		A	D1-1GA	72	10		<--- (45 DEG) JAY PEAK 9																						
		A	D1-1A	72	12			6.00																	5				
		A	D1-1A	72	12			6.00																	5				
		A	D1-1A	72	12			6.00																	5				
NB	3.770	A	W1-2MgR	30	30			6.25																	7				
		A	W16-8	30	8			1.67																	8				
<b>SIGN SUMMARY SHEET</b>							SHEET TOTALS	48.67	0.00	1	0	0	6	0	0	7	105								PROJECT NAME: <b>Moretown-Newport Town VT100</b>				
								SF	SF	EA	EA	EA	EA	EA	EA	EA	EA	EA	EA	EA	FT							PROJECT NUMBER: <b>STPG SIGN(28)</b>	
VERMONT AGENCY OF TRANSPORTATION							TOWN TOTALS	149.5	0.0	15.0	0.0	0.0	28	0.0	0.0	26	390.0						FILE NAME: <b>Westfield.xls</b>	PLOT DATE: <b>9/30/2009</b>					
																						PROJECT MANAGER: <b>N. Avery</b>	DRAWN BY: <b>I. Shea</b>						
																						DESIGNED BY: <b>D. Crosslev</b>	CHECKED BY: <b>J. Kelly</b>						
																						WESTFIELD SHEET 2	SHEET <b>135</b> OF <b>166</b>						

DIRECTION	MILEPOINT	LOCATION CODE (SHEET 2)	SIGN CODE	WIDTH (IN)	HEIGHT (IN)	SHEETING REMARKS	SIGN LEGEND	NEW SIGNS		EXISTING SIGNS				EXIST POST		NUMBER OF NEW POSTS	SQUARE STEEL (IN)			TUBULAR STEEL Ø (IN)				SIGN FRAME REQUIRED	REMARKS	SIGN DETAIL			
								"A"	"B"	RETAIN	SALVAGE FROM	SALVAGE TO	REMOVE	RETAIN	REMOVE		1.75	2.00	2.50	FOUNDATION	3.00	3.50	4.00			5.00	DETAIL IN SHS	DETAIL ON SHEET NUMBER	DETAIL ON STD SHEET NUMBER
																	(LB / FT)				(LB / FT)								
<b>WESTFIELD VT 100</b>							FY-FLUORESCENT YELLOW FYG-FLUORESCENT YELLOW GREEN															"SHS"-STANDARD HIGHWAY SIGNS							
NB	3.870	A	R2-1	24	30			5.00							1		X							INSTALL 20' SOUTH OF UTILITY POLE 42/A	X				
NB	4.220	A	R2-1	24	30		SPEED LIMIT 50			1				X															
NB	4.402	C	VR-017	24	24																			LOOP RD TH-4					
		C	VR-017	24	30			5.00							1		X									E-1471			
NB	4.410	D	R1-1	24	24																			LOOP RD TH-4					
		D	R1-1	30	30			6.25							1		X									X			
SB	4.340	F	R2-5A	24	30		REDUCED SPEED AHEAD																						
		F	W3-5	36	36			9.00																			X		
SB	4.300	F	VD-018	30	18		WESTFIELD LOWELL 7			1							X												
SB	4.260	F	VW-060	30	30		HIDDEN DRIVES			1							X												
SB	4.220	F	R2-1	24	30																								
		F	R2-1	30	36			7.50							1		X										6		
SB	4.005	F	R2-1	24	30			5.00																	INSTALL SOUTH OF DRIVE TO CAR DEALER AND 10' NORTH OF POLE.	X			
SB	3.930	F	W1-2L	30	30		LEFT CURVE																						
		F	D1-1A	72	12			6.00																			5		
<b>SIGN SUMMARY SHEET</b>							SHEET TOTALS	43.75	0.00	3	0	0	5	0	0	8	120												
								SF	SF	EA	EA	EA	EA	EA	EA	EA	EA	EA	EA	EA	EA	EA	EA	EA	EA	EA	EA	EA	EA
VERMONT AGENCY OF TRANSPORTATION							TOWN TOTALS	149.5	0.0	15.0	0.0	0.0	28	0.0	0.0	26	390.0												
							PROJECT NAME:	<b>Moretown-Newport Town VT100</b>																					
							PROJECT NUMBER:	<b>STPG SIGN(28)</b>																					
							FILE NAME:	<b>Westfield.xls</b>											PLOT DATE:	<b>9/30/2009</b>									
							PROJECT MANAGER:	<b>N. Avery</b>											DRAWN BY:	<b>I. Shea</b>									
							DESIGNED BY:	<b>D. Crosslev</b>											CHECKED BY:	<b>J. Kelly</b>									
							WESTFIELD SHEET 3	SHEET <b>136</b> OF <b>166</b>																					

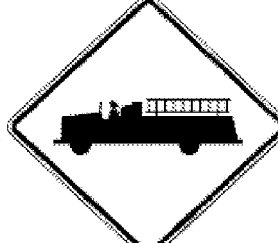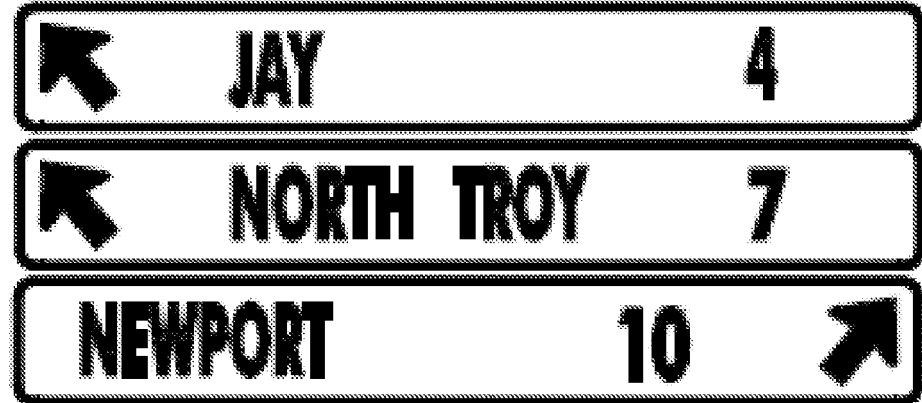



DIRECTION	MILEPOINT	LOCATION CODE (SHEET 2)	SIGN CODE	WIDTH (IN)	HEIGHT (IN)	SHEETING REMARKS	SIGN LEGEND	NEW SIGNS		EXISTING SIGNS				EXIST POST		NUMBER OF NEW POSTS	SQUARE STEEL (IN)			TUBULAR STEEL Ø (IN)				SIGN FRAME REQUIRED	REMARKS	SIGN DETAIL							
								"A"	"B"	RETAIN	SALVAGE FROM	SALVAGE TO	REMOVE	RETAIN	REMOVE		1.75	2.00	2.50	FOUNDATION	3.00	3.50	4.00			5.00	DETAIL IN SHS	DETAIL ON SHEET NUMBER	DETAIL ON STD SHEET NUMBER				
																	(LB / FT)				(LB / FT)												
<b>WESTFIELD VT 100</b>							FY-FLUORESCENT YELLOW FYG-FLUORESCENT YELLOW GREEN																"SHS"-STANDARD HIGHWAY SIGNS										
SB	3.890	F	D1-1A	72	10		JAY 5 --->																										
		F	W1-10L	30	30			6.25																	X								
SB	3.849	G	VR-017	24	24																												
		G	VR-017	24	30			5.00																			E-141						
SB	3.840	H	R1-1	30	30		STOP			1																	TH-31						
SB	3.840	F	M3-3S	24	12		SOUTH			1																							
		F	M1-5	30	24		VERMONT 100			1																							
		F	M6-2S	21	15		<--- LEFT (45 DEG)			1																							
SB	3.810	H	R1-1	30	30		STOP			1																	NORTH HILL RD TH-1						
SB	3.801	G	VR-017	24	24																												
		G	VR-017	24	30			5.00																			E-141						
SB	3.800	E	M3-1S	24	12		NORTH			1																							
		E	M1-5	30	24		VERMONT 100			1																							
		E	M6-2S	21	15		RIGHT ---> (45 DEG)			1																							
SB	3.740	F	M3-3S	24	12		SOUTH			1																							
<b>SIGN SUMMARY SHEET</b>							SHEET TOTALS											16.25	0.00	9	0	0	3	0	0	3	45	PROJECT NAME: <b>Moretown-Newport Town VT100</b>					
							SF	SF	EA	EA	EA	EA	EA	EA	EA	EA	EA	EA	EA	EA	EA	EA	EA	EA	EA	EA	EA	PROJECT NUMBER: <b>STPG SIGN(28)</b>					
VERMONT AGENCY OF TRANSPORTATION							TOWN TOTALS											149.5	0.0	15.0	0.0	0.0	28	0.0	0.0	26	390.0	FILE NAME: <b>Westfield.xls</b> PLOT DATE: <b>9/30/2009</b>					
																									PROJECT MANAGER: <b>N. Avery</b> DRAWN BY: <b>I. Shea</b>								
																		DESIGNED BY: <b>D. Crosslev</b> CHECKED BY: <b>J. Kelly</b>															
																		WESTFIELD SHEET 4 SHEET <b>137</b> OF <b>166</b>															








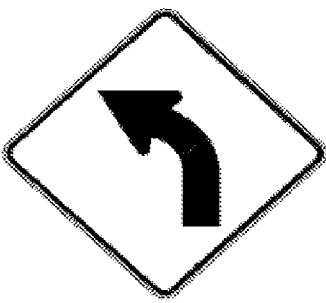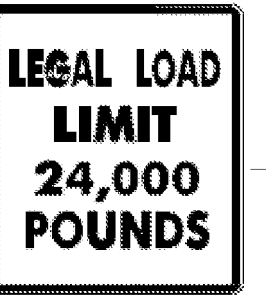



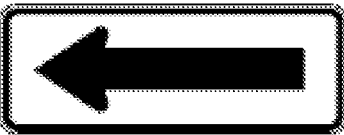


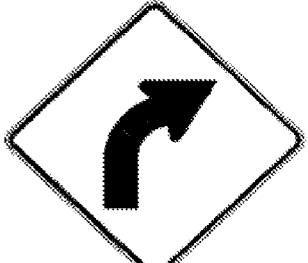


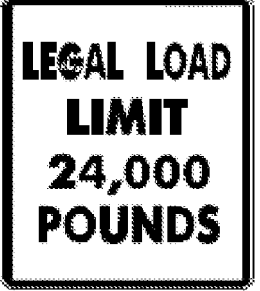
DIRECTION	MILEPOINT	LOCATION CODE (SHEET 2)	SIGN CODE	WIDTH (IN)	HEIGHT (IN)	SHEETING REMARKS	SIGN LEGEND	NEW SIGNS		EXISTING SIGNS				EXIST POST		NUMBER OF NEW POSTS	SQUARE STEEL (IN)			TUBULAR STEEL Ø (IN)				SIGN FRAME REQUIRED	REMARKS	SIGN DETAIL					
								"A"	"B"	RETAIN	SALVAGE FROM	SALVAGE TO	REMOVE	RETAIN	REMOVE		(LB / FT)			(LB / FT)						DETAIL IN SHS	DETAIL ON SHEET NUMBER	DETAIL ON STD SHEET NUMBER			
																	1.75	2.00	2.50	3.00	3.50	4.00	5.00								
<b>TROY VT 100</b>							FY-FLUORESCENT YELLOW FYG-FLUORESCENT YELLOW GREEN															"SHS"-STANDARD HIGHWAY SIGNS									
NB	0.000	C	VD-024	60	7.5																										
		C	VD-024	72	10			5.00							2					X				4							
		C	VD-700	6	10			0.42																	E-138						
		C	VD-700	6	10			0.42																	E-138						
NB	0.004	A	VD-062AL	72	16	BUSINESS SIGN				1				X																	
		A	VD-062AS	72	16	BUSINESS SIGN				1																					
		A	VD-062AL	72	16	BUSINESS SIGN				1																					
NB	0.110	A	R2-5A	24	30	REDUCED SPEED AHEAD 									1																
		A	W3-5	36	36			9.00							2					X			X								
NB	0.150	A	VD-018	30	18																										
		A	VD-018	30	18			3.75							1					X					E-128B						
NB	0.190	A	M2-1	21	15																										
		A	M1-5	30	24																										
		A	M2-1	21	15																										
		A	M1-5	30	24			2.19							1					X											
								5.00																	E-136B						
<b>SIGN SUMMARY SHEET</b>							SHEET TOTALS											25.78	0.00	3	0	0	5	0	0	5	75	PROJECT NAME: <b>Moretown-Newport Town VT100</b>			
							SF	SF	EA	EA	EA	EA	EA	EA	EA	EA	EA	EA	EA	EA	EA	EA	EA	EA	EA	EA	EA	PROJECT NUMBER: <b>STPG SIGN(28)</b>			
VERMONT AGENCY OF TRANSPORTATION							TOWN TOTALS											334.5	0.0	7.0	2.0	2.0	60	0.0	0.0	55	825.0	FILE NAME: <b>Trov.xls</b> PLOT DATE: <b>9/30/2009</b>			
																												PROJECT MANAGER: <b>N. Avery</b> DRAWN BY: <b>I. Shea</b>			
																													DESIGNED BY: <b>D. Crosslev</b> CHECKED BY: <b>J. Kelly</b>		
																													TROY SHEET 1 SHEET <b>139</b> OF <b>166</b>		

DIRECTION	MILEPOINT	LOCATION CODE (SHEET 2)	SIGN CODE	WIDTH (IN)	HEIGHT (IN)	SHEETING REMARKS	SIGN LEGEND	NEW SIGNS		EXISTING SIGNS				EXIST POST		NUMBER OF NEW POSTS	SQUARE STEEL (IN)			TUBULAR STEEL Ø (IN)				SIGN FRAME REQUIRED	REMARKS	SIGN DETAIL							
								"A"	"B"	RETAIN	SALVAGE FROM	SALVAGE TO	REMOVE	RETAIN	REMOVE		1.75	2.00	2.50	FOUNDATION	3.00	3.50	4.00			5.00	DETAIL IN SHS	DETAIL ON SHEET NUMBER	DETAIL ON STD SHEET NUMBER				
																	(LB / FT)				(LB / FT)												
<b>TROY VT 100</b>							FY-FLUORESCENT YELLOW FYG-FLUORESCENT YELLOW GREEN															"SHS"-STANDARD HIGHWAY SIGNS											
NB	0.230	A	W11-8	30	30																												
		A	W11-8	30	30			6.25																	X								
NB	0.270	A	D1-1	72	12																					5							
			D1-1	72	12			6.00																		5							
			D1-1	72	12			6.00																		5							
NB	0.310	A	R2-1	24	30																												
		A	R2-1	30	36			7.50																		6							
NB	0.440	A	R2-1	24	30																												
		A	R2-1	24	30			5.00																	X								
NB	0.495	A	S1-1	36	36		SCHOOL 																										
		A	W11-2	30	30	FYG		6.25																	X								
NB	0.560	A	M3-1S	24	12																												
		A	M1-5	30	24																												
		A	M3-1	24	12																												
		A	M1-5	30	24			5.00																									
<b>SIGN SUMMARY SHEET</b>							SHEET TOTALS											50.00	0.00	0	0	0	6	0	0	7	105	PROJECT NAME: <b>Moretown-Newport Town VT100</b>					
							SF	SF	EA	EA	EA	EA	EA	EA	EA	EA	EA	EA	EA	EA	EA	EA	EA	EA	EA	EA	EA	PROJECT NUMBER: <b>STPG SIGN(28)</b>					
VERMONT AGENCY OF TRANSPORTATION							TOWN TOTALS											334.5	0.0	7.0	2.0	2.0	60	0.0	0.0	55	825.0	FILE NAME: <b>Trov.xls</b> PLOT DATE: <b>9/30/2009</b>					
							VERMONT AGENCY OF TRANSPORTATION						TOWN TOTALS						334.5	0.0	7.0	2.0	2.0	60	0.0	0.0	55	825.0	PROJECT MANAGER: <b>N. Avery</b> DRAWN BY: <b>I. Shea</b>				
																	DESIGNED BY: <b>D. Crosslev</b> CHECKED BY: <b>J. Kelly</b>																
																	TROY SHEET 2 SHEET <b>140</b> OF <b>166</b>																

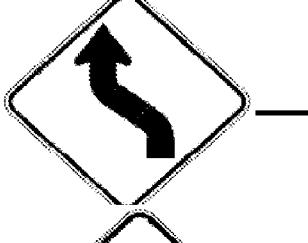









DIRECTION	MILEPOINT	LOCATION CODE (SHEET 2)	SIGN CODE	WIDTH (IN)	HEIGHT (IN)	SHEETING REMARKS	SIGN LEGEND	NEW SIGNS		EXISTING SIGNS				EXIST POST		NUMBER OF NEW POSTS	SQUARE STEEL (IN)			TUBULAR STEEL Ø (IN)				SIGN FRAME REQUIRED	REMARKS	SIGN DETAIL			
								"A"	"B"	RETAIN	SALVAGE FROM	SALVAGE TO	REMOVE	RETAIN	REMOVE		1.75	2.00	2.50	FOUNDATION	3.00	3.50	4.00			5.00	DETAIL IN SHS	DETAIL ON SHEET NUMBER	DETAIL ON STD SHEET NUMBER
																	(LB / FT)				(LB / FT)								
<b>TROY VT 100</b>							FY-FLUORESCENT YELLOW FYG-FLUORESCENT YELLOW GREEN															"SHS"-STANDARD HIGHWAY SIGNS							
NB	1.430	A	W1-2R	30	30		RIGHT CURVE				1				2		X									X			
		A	VW-054L	30	30		HIDDEN DRIVE LEFT				1																		E-154
NB	1.450	A	W11-6H	30	30		HINGED SNOWMOBILE						1																
NB	1.550	A	W11-5	30	30		FARM MACHINERY			1				X															
NB	1.980	A	W11-4	30	30		CATTLE						1																
NB	2.199	C	VR-017	24	30																								
		C	VR-017	24	30				5.00							1		X											
NB	2.040	D	R1-1	30	30																								
		D	R1-1	30	30				6.25							1		X									X		
NB	2.700	A	W1-2L	30	30		LEFT CURVE																						
NB	2.757	A	W1-2L	30	30																								
									6.25							1		X									X		
NB	2.830	A	W11-6H	30	30		HINGED SNOWMOBILE						1																
SB	2.963	G	VR-017	24	30																								
		G	VR-017	24	30				5.00							1		X											
SB	2.958	H	R1-1	30	30																								ROUTHIER RD TH-44
<b>SIGN SUMMARY SHEET</b>							SHEET TOTALS	22.50	0.00	1	0	2	8	0	0	6	90								PROJECT NAME: <b>Moretown-Newport Town VT100</b>				
								SF	SF	EA	EA	EA	EA	EA	EA	EA	FT									PROJECT NUMBER: <b>STPG SIGN(28)</b>			
							VERMONT AGENCY OF TRANSPORTATION	TOWN TOTALS	334.5	0.0	7.0	2.0	2.0	60	0.0	0.0	55	825.0								FILE NAME: <b>Trov.xls</b>	PLOT DATE: <b>9/30/2009</b>		
																							PROJECT MANAGER: <b>N. Avery</b>	DRAWN BY: <b>I. Shea</b>					
																							DESIGNED BY: <b>D. Crosslev</b>	CHECKED BY: <b>J. Kelly</b>					
																							TROY SHEET 4	SHEET <b>142</b> OF <b>166</b>					


DIRECTION	MILEPOINT	LOCATION CODE (SHEET 2)	SIGN CODE	WIDTH (IN)	HEIGHT (IN)	SHEETING REMARKS	SIGN LEGEND	NEW SIGNS		EXISTING SIGNS				EXIST POST		NUMBER OF NEW POSTS	SQUARE STEEL (IN)			TUBULAR STEEL Ø (IN)				SIGN FRAME REQUIRED	REMARKS	SIGN DETAIL						
								"A"	"B"	RETAIN	SALVAGE FROM	SALVAGE TO	REMOVE	RETAIN	REMOVE		1.75	2.00	2.50	FOUNDATION	3.00	3.50	4.00			5.00	DETAIL IN SHS	DETAIL ON SHEET NUMBER	DETAIL ON STD SHEET NUMBER			
																	(LB / FT)				(LB / FT)											
<b>TROY VT 100</b>							FY-FLUORESCENT YELLOW FYG-FLUORESCENT YELLOW GREEN																"SHS"-STANDARD HIGHWAY SIGNS									
		H	R1-1	30	30			6.25							1		X								X							
SB	2.870	F	W1-2R	30	30		RIGHT CURVE										1		X							INSTALL 150' +/- SOUTH OF ORIGINAL SIGN LOCATION						
SB	2.840	F	W1-2R	30	30	FY	 	<del>6.25</del>							<del>+</del>		<del>X</del>								X							
SB	2.112	G	VR-017	24	30			5.00							1		X									EAST HILL RD TH-2			E-141			
SB	2.105	H	R1-1	30	30												1		X							EAST HILL RD TH-2						
		H	R1-1	30	30			6.25							1		X								X							
SB	1.880	F	W11-5	30	30		FARM MACHINERY			1							X															
SB	1.570	F	VW-133	30	30		HIDDEN DRIVE LEFT										1		X													
SB	1.530	F	S3-1	30	30		SCHOOL BUS STOP AHEAD										1		X													
SB	1.510	F	S3-1	30	30			6.25							2		X									INSTALL 100' +/- SOUTH OF ORIGINAL SCHOOL BUS STOP AHEAD SIGN LOCATION	X					
		F	VW-054L	30	30			6.25																			E-154					
SB	1.391	F	W1-4L	30	30		LEFT REVERSE CURVE										1		X													
SB	1.360	F	VW-054	30	30		HIDDEN DRIVE RIGHT										1		X													
SB	1.340	F	W1-4L	30	30			6.25							2		X									INSTALL 100' +/- SOUTH OF ORIGINAL HIDDEN DRIVE RIGHT SIGN LOCATION	X					
		F	VW-054R	30	30			6.25																			E-154					
<b>SIGN SUMMARY SHEET</b>							SHEET TOTALS	48.75	0.00	1	0	0	6	0	0	8	120												PROJECT NAME: <b>Moretown-Newport Town VT100</b>			
								SF	SF	EA	EA	EA	EA	EA	EA	EA	EA	EA	EA	EA	EA	EA	EA	EA	EA	EA	EA	EA	EA	EA	EA	PROJECT NUMBER: <b>STPG SIGN(28)</b>
VERMONT AGENCY OF TRANSPORTATION							TOWN TOTALS	334.5	0.0	7.0	2.0	2.0	60	0.0	0.0	55	825.0										FILE NAME: <b>Trov.xls</b>					
																										PLOT DATE: <b>9/30/2009</b>						
																											PROJECT MANAGER: <b>N. Avery</b>					
																											DESIGNED BY: <b>D. Crosslev</b>					
																											CHECKED BY: <b>J. Kelly</b>					
																											TROY SHEET 5					
																												SHEET <b>143</b> OF <b>166</b>				

DIRECTION	MILEPOINT	LOCATION CODE (SHEET 2)	SIGN CODE	WIDTH (IN)	HEIGHT (IN)	SHEETING REMARKS	SIGN LEGEND	NEW SIGNS		EXISTING SIGNS				EXIST POST		NUMBER OF NEW POSTS	SQUARE STEEL (IN)			TUBULAR STEEL Ø (IN)				SIGN FRAME REQUIRED	REMARKS	SIGN DETAIL							
								"A"	"B"	RETAIN	SALVAGE FROM	SALVAGE TO	REMOVE	RETAIN	REMOVE		1.75	2.00	2.50	FOUNDATION	3.00	3.50	4.00			5.00	DETAIL IN SHS	DETAIL ON SHEET NUMBER	DETAIL ON STD SHEET NUMBER				
																	(LB / FT)				(LB / FT)												
<b>TROY VT 100</b>							FY-FLUORESCENT YELLOW FYG-FLUORESCENT YELLOW GREEN															"SHS"-STANDARD HIGHWAY SIGNS											
SB	1.310	F	W1-6	48	24			8.00										X						INSTALL 150' +/- SOUTH OF LEFT REVERSE CURVE SIGN	X								
		E	W1-6	48	24			8.00										X								X							
SB	1.050	F	VD-062AL	72	16		BUSINESS SIGN			1			X																				
		F	VD-062AS	72	16		BUSINESS SIGN			1																							
SB	0.960	F	R2-5A	24	30		REDUCED SPEED AHEAD 																										
		F	W3-5	36	36			9.00										X								X							
SB	0.850	F	VD-018	30	18																												
		F	VD-018	30	18			3.75										X										E-128B					
SB	0.850	F	OM-3R	12	36		OBJECT MARKER																										
SB	0.820	E	OM-3R	12	36		OBJECT MARKER																										
SB	0.810	F	R2-1	24	30																												
		F	R2-1	30	36		 DO NOT PLACE PER PROPERTY OWNER	<del>7.50</del>										<del>X</del>									6						
SB	0.734	G	VR-017	24	30																				RIVER RD TH-22								
		G	VR-017	24	30			5.00										X										E-141					
SB	0.726	H	R1-1	30	30																				RIVER RD TH-22								
<b>SIGN SUMMARY SHEET</b>							SHEET TOTALS											41.25	0.00	2	0	0	7	0	0	9	135	PROJECT NAME: <b>Moretown-Newport Town VT100</b>					
							SF	SF	EA	EA	EA	EA	EA	EA	EA	EA	EA	EA	EA	EA	EA	EA	EA	EA	EA	EA	PROJECT NUMBER: <b>STPG SIGN(28)</b>						
							TOWN TOTALS											334.5	0.0	7.0	2.0	2.0	60	0.0	0.0	55	825.0	FILE NAME: <b>Trov.xls</b> PLOT DATE: <b>9/30/2009</b>					
VERMONT AGENCY OF TRANSPORTATION																		PROJECT MANAGER: <b>N. Avery</b> DRAWN BY: <b>I. Shea</b>															
																		DESIGNED BY: <b>D. Crosslev</b> CHECKED BY: <b>J. Kelly</b>															
																		TROY SHEET 6 SHEET <b>144</b> OF <b>166</b>															









DIRECTION	MILEPOINT	LOCATION CODE (SHEET 2)	SIGN CODE	WIDTH (IN)	HEIGHT (IN)	SHEETING REMARKS	SIGN LEGEND	NEW SIGNS		EXISTING SIGNS				EXIST POST		NUMBER OF NEW POSTS	SQUARE STEEL (IN)			TUBULAR STEEL Ø (IN)				SIGN FRAME REQUIRED	REMARKS	SIGN DETAIL		
								"A"	"B"	RETAIN	SALVAGE FROM	SALVAGE TO	REMOVE	RETAIN	REMOVE		(LB / FT)			(LB / FT)						DETAIL IN SHS	DETAIL ON SHEET NUMBER	DETAIL ON STD SHEET NUMBER
																	1.75	2.00	2.50	3.00	3.50	4.00	5.00					
<b>TROY VT 100</b>							FY-FLUORESCENT YELLOW FYG-FLUORESCENT YELLOW GREEN															"SHS"-STANDARD HIGHWAY SIGNS						
		F	D1-1	72	12			6.00																5				
SB	0.485	F	W11-8	30	30			6.25						1		X								INSTALL OPPOSITE SLAUGHTERHOUSE SIGN	X			
SB	0.400	F	M3-3S	24	12								1			X												
		F	M1-5	30	24								1															
		F	M6-2S	21	15								1															
		F	M3-1S	24	12								1															
		F	M1-5	30	24								1															
		F	M6-1S	21	15								1															
		F	M3-3	24	12			2.00						2		X						1-B	GREEN ON WHITE SHEETING	X	7			
		F	M1-5	30	24			5.00																		E-136B		
		F	M6-2L	21	15			2.19																GREEN ON WHITE SHEETING	X			
		F	M3-1	24	12			2.00																	GREEN ON WHITE SHEETING	X		
		F	M1-5	30	24			5.00																			E-136B	
		F	M6-1R	21	15			2.19																	GREEN ON WHITE SHEETING	X		
SB	0.380	E	M3-1S	24	12		MISSING						+			X												
<b>SIGN SUMMARY SHEET</b>							SHEET TOTALS	30.63	0.00	0	0	0	7	0	0	3	45							PROJECT NAME: <b>Moretown-Newport Town VT100</b>				
								SF	SF	EA	EA	EA	EA	EA	EA	EA	FT							PROJECT NUMBER: <b>STPG SIGN(28)</b>				
VERMONT AGENCY OF TRANSPORTATION							TOWN TOTALS	334.5	0.0	7.0	2.0	2.0	60	0.0	0.0	55	825.0							FILE NAME: <b>Trov.xls</b>				
																								PLOT DATE: <b>9/30/2009</b>				
																								PROJECT MANAGER: <b>N. Avery</b>				
																								DRAWN BY: <b>I. Shea</b>				
																								DESIGNED BY: <b>D. Crosslev</b>				
																								CHECKED BY: <b>J. Kelly</b>				
																								SHEET <b>146</b> OF <b>166</b>				


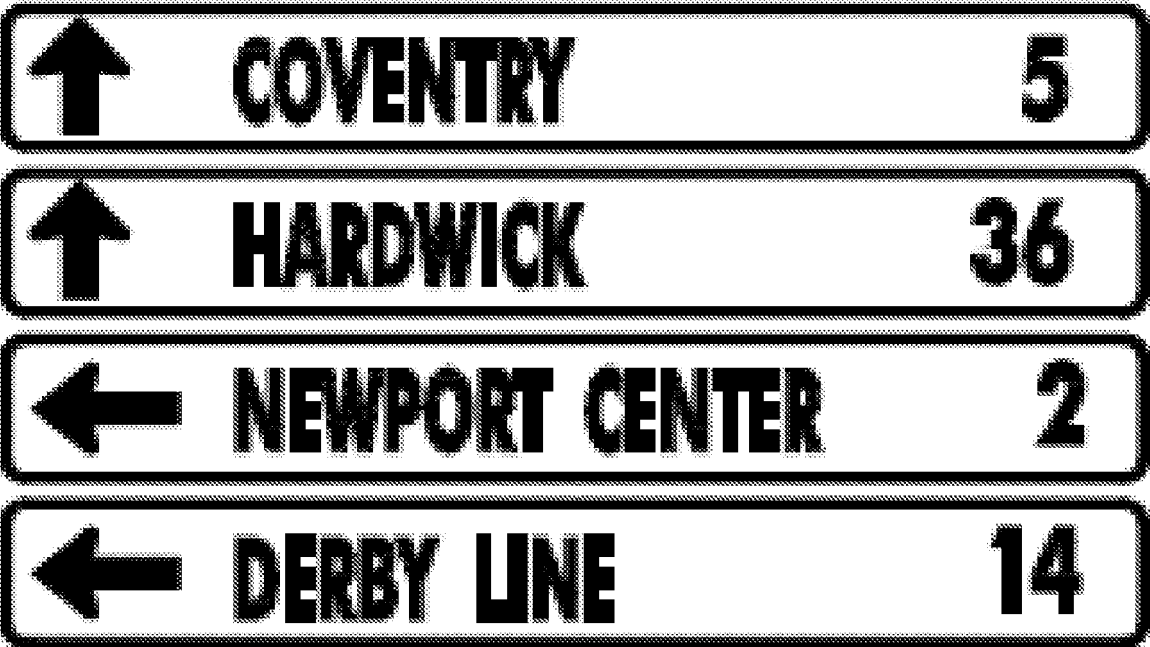
DIRECTION	MILEPOINT	LOCATION CODE (SHEET 2)	SIGN CODE	WIDTH (IN)	HEIGHT (IN)	SHEETING REMARKS	SIGN LEGEND	NEW SIGNS		EXISTING SIGNS				EXIST POST		NUMBER OF NEW POSTS	SQUARE STEEL (IN)			TUBULAR STEEL Ø (IN)				SIGN FRAME REQUIRED	REMARKS	SIGN DETAIL		
								"A"	"B"	RETAIN	SALVAGE FROM	SALVAGE TO	REMOVE	RETAIN	REMOVE		(LB / FT)			(LB / FT)						DETAIL IN SHS	DETAIL ON SHEET NUMBER	DETAIL ON STD SHEET NUMBER
																	1.75	2.00	2.50	FOUNDATION	3.00	3.50	4.00					
<b>TROY VT 100</b>							FY-FLUORESCENT YELLOW FYG-FLUORESCENT YELLOW GREEN															"SHS"-STANDARD HIGHWAY SIGNS						
			E M1-5	24	24																							
			E M6-2S	21	15																							
			E M3-1S	24	12																							
			E M1-5	24	24																							
			E M6-2S	21	15																							
			E M3-1	24	12			2.00													2B	GREEN ON WHITE SHEETING	X	7				
			E M1-5	30	24			5.00																		E-136B		
			E M6-2L	21	15			2.19															GREEN ON WHITE SHEETING	X				
			E M3-1	24	12			2.00															GREEN ON WHITE SHEETING	X				
			E M1-5	30	24			5.00																		E-136B		
			E M6-2R	21	15		PLACED BY DISTRICT	-2.19															GREEN ON WHITE SHEETING	X				
SB	0.340	F	W11-6 H	30	30		SNOWMOBILE HINGED																					
			F M3-3	24	12			2.00															GREEN ON WHITE SHEETING	X				
			F M1-5	30	24			5.00																		E-136B		
SB	0.310	F	R2-1	24	30																							
<b>SIGN SUMMARY SHEET</b>							SHEET TOTALS	25.38	0.00	0	0	0	7	0	0	1	15							PROJECT NAME: <b>Moretown-Newport Town VT100</b>				
								SF	SF	EA	EA	EA	EA	EA	EA	EA	EA	EA	EA	EA	EA	FT					PROJECT NUMBER: <b>STPG SIGN(28)</b>	
VERMONT AGENCY OF TRANSPORTATION							TOWN TOTALS	334.5	0.0	7.0	2.0	2.0	60	0.0	0.0	55	825.0					FILE NAME: <b>Trov.xls</b>	PLOT DATE: <b>9/30/2009</b>					
																					PROJECT MANAGER: <b>N. Avery</b>	DRAWN BY: <b>I. Shea</b>						
																					DESIGNED BY: <b>D. Crosslev</b>	CHECKED BY: <b>J. Kelly</b>						
																					TROY SHEET <b>9</b>	SHEET <b>147</b> OF <b>166</b>						

DIRECTION	MILEPOINT	LOCATION CODE (SHEET 2)	SIGN CODE	WIDTH (IN)	HEIGHT (IN)	SHEETING REMARKS	SIGN LEGEND	NEW SIGNS		EXISTING SIGNS			EXIST POST		NUMBER OF NEW POSTS	SQUARE STEEL (IN)			TUBULAR STEEL Ø (IN)				SIGN FRAME REQUIRED	REMARKS	SIGN DETAIL				
								"A"	"B"	RETAIN	SALVAGE FROM	SALVAGE TO	REMOVE	RETAIN		REMOVE	1.75	2.00	2.50	FOUNDATION	3.00	3.50			4.00	5.00	DETAIL IN SHS	DETAIL ON SHEET NUMBER	DETAIL ON STD SHEET NUMBER
																	(LB / FT)				(LB / FT)								
<b>TROY VT 100</b>							FY-FLUORESCENT YELLOW FYG-FLUORESCENT YELLOW GREEN															"SHS"-STANDARD HIGHWAY SIGNS							
		F	R2-1	24	30			5.00						1		X								X					
<b>SIGN SUMMARY SHEET</b>							SHEET TOTALS	5.00	0.00	0	0	0	0	0	0	1	15												
								SF	SF	EA	EA	EA	EA	EA	EA	EA	FT												
VERMONT AGENCY OF TRANSPORTATION							TOWN TOTALS	334.5	0.0	7.0	2.0	2.0	60	0.0	0.0	55	825.0												

PROJECT NAME: **Moretown-Newport Town VT100**  
PROJECT NUMBER: **STPG SIGN(28)**  
FILE NAME: **Trov.xls** PLOT DATE: **9/30/2009**  
PROJECT MANAGER: **N. Avery** DRAWN BY: **I. Shea**  
DESIGNED BY: **D. Crosslev** CHECKED BY: **J. Kelly**  
TROY SHEET 10 SHEET **148** OF **166**


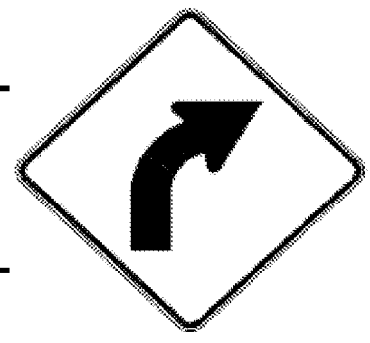


DIRECTION	MILEPOINT	LOCATION CODE (SHEET 2)	SIGN CODE	WIDTH (IN)	HEIGHT (IN)	SHEETING REMARKS	SIGN LEGEND	NEW SIGNS		EXISTING SIGNS				EXIST POST		NUMBER OF NEW POSTS	SQUARE STEEL (IN)			TUBULAR STEEL Ø (IN)				SIGN FRAME REQUIRED	REMARKS	SIGN DETAIL			
								"A"	"B"	RETAIN	SALVAGE FROM	SALVAGE TO	REMOVE	RETAIN	REMOVE		1.75	2.00	2.50	FOUNDATION	3.00	3.50	4.00			5.00	DETAIL IN SHS	DETAIL ON SHEET NUMBER	DETAIL ON STD SHEET NUMBER
																	(LB / FT)				(LB / FT)								
<b>NEWPORT TOWN VT100</b>							FY-FLUORESCENT YELLOW FYG-FLUORESCENT YELLOW GREEN															"SHS"-STANDARD HIGHWAY SIGNS							
NB	1.962	C	VR-017	24	30																			COLLINS MILL RD TH-25					
		C	VR-017	24	30			5.00																			E-141		
NB	1.970	D	R1-1	30	30																			COLLINS MILL RD TH-25					
		D	R1-1	30	30			6.25															X						
NB	2.635	C	VR-017	24	30																			POGINY RD TH-26					
		C	VR-017	24	30			5.00																			E-141		
NB	2.644	D	R1-1	30	30																			POGINY RD TH-26					
		D	R1-1	30	30			6.25															X						
NB	2.890	A	VD-062B	72	16		BUSINESS SIGN			1																			
																													
NB	2.940	A	W1-2R	30	30			6.25																INSTALL JUST NORTH OF WEEPING WILLOW TREE AT POLE #9?/20 W/GUY WIRE	X				
NB	3.069	A	M2-1S	21	15																								
		A	M1-5	24	24																								
		A	M2-1	21	15			2.19																GREEN ON WHITE SHEETING	X				
		A	M1-5	24	24			4.00																			E-136B		
NB	3.106	A	M3-1S	24	12																								
<b>SIGN SUMMARY SHEET</b>							SHEET TOTALS				34.94	0.00	1	0	0	7	0	0	6	90					PROJECT NAME: <b>Moretown-Newport Town VT100</b>				
							SF	SF	EA	EA	EA	EA	EA	EA	EA	EA	EA	EA	EA	EA	EA	EA	FT					PROJECT NUMBER: <b>STPG SIGN(28)</b>	
VERMONT AGENCY OF TRANSPORTATION							TOWN TOTALS				342.4	0.0	29.0	9.0	9.0	83	0.0	0.0	50	750.0					FILE NAME: <b>Newport Town.xls</b> PLOT DATE: <b>9/30/2009</b>				
																							PROJECT MANAGER: <b>N. Avery</b> DRAWN BY: <b>I. Shea</b>						
																DESIGNED BY: <b>D. Crossley</b> CHECKED BY: <b>J. Kelly</b>													
																NEWPORT TOWN SHEET 2 SHEET <b>150</b> OF <b>166</b>													

DIRECTION	MILEPOINT	LOCATION CODE (SHEET 2)	SIGN CODE	WIDTH (IN)	HEIGHT (IN)	SHEETING REMARKS	SIGN LEGEND	NEW SIGNS		EXISTING SIGNS				EXIST POST		NUMBER OF NEW POSTS	SQUARE STEEL (IN)			TUBULAR STEEL Ø (IN)				SIGN FRAME REQUIRED	REMARKS	SIGN DETAIL			
								"A"	"B"	RETAIN	SALVAGE FROM	SALVAGE TO	REMOVE	RETAIN	REMOVE		1.75	2.00	2.50	FOUNDATION	3.00	3.50	4.00			5.00	DETAIL IN SHS	DETAIL ON SHEET NUMBER	DETAIL ON STD SHEET NUMBER
																	(LB / FT)				(LB / FT)								
<b>NEWPORT TOWN VT100</b>							FY-FLUORESCENT YELLOW FYG-FLUORESCENT YELLOW GREEN															"SHS"-STANDARD HIGHWAY SIGNS							
			A	M1-5	30	24																							
			A	M5-1S	21	15																							
			A	M3-1	24	12																							
			A	M1-5	30	24																							
			A	M5-1L	21	15																							
NB	3.171		A	D1-1A	72	10																							
			A	D1-1A	72	10																							
			A	D1-1A	72	10																							
			A	D1-1A	72	10																							
			A	D1-1A	72	12																							
			A	D1-1A	72	12																							
			A	D1-1A	72	12																							
NB	3.193		A	R14-1	24	18																							
			A	M3-2S	24	12																							
<b>SIGN SUMMARY SHEET</b>							SHEET TOTALS	33.19	0.00	0	0	0	8	0	0	3	45												
VERMONT AGENCY OF TRANSPORTATION							TOWN TOTALS	SF	SF	EA	EA	EA	EA	EA	EA	EA	FT												
								342.4	0.0	29.0	9.0	9.0	83	0.0	0.0	50	750.0												
PROJECT NAME: <b>Moretown-Newport Town VT100</b>																					PROJECT NUMBER: <b>STPG SIGN(28)</b>								
FILE NAME: <b>Newport Town.xls</b>																		PLOT DATE: <b>9/30/2009</b>											
PROJECT MANAGER: <b>N. Avery</b>																		DRAWN BY: <b>I. Shea</b>											
DESIGNED BY: <b>D. Crossley</b>																		CHECKED BY: <b>J. Kelly</b>											
NEWPORT TOWN SHEET 3																					SHEET <b>151</b> OF <b>166</b>								





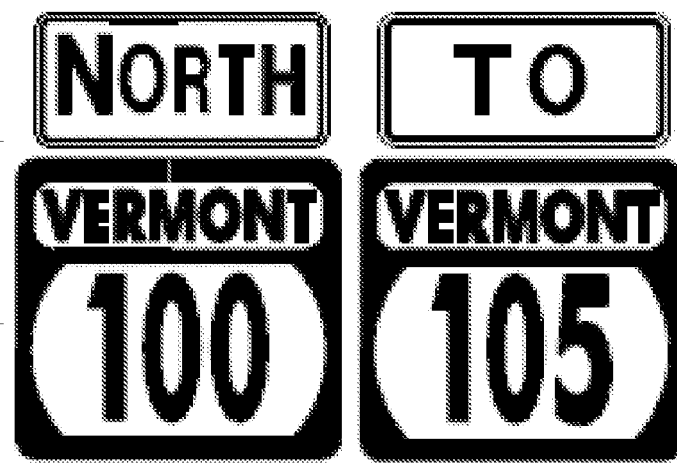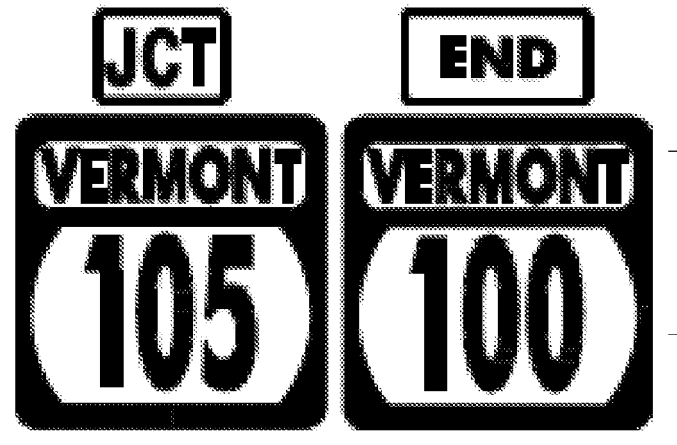



DIRECTION	MILEPOINT	LOCATION CODE (SHEET 2)	SIGN CODE	WIDTH (IN)	HEIGHT (IN)	SHEETING REMARKS	SIGN LEGEND	NEW SIGNS		EXISTING SIGNS				EXIST POST		NUMBER OF NEW POSTS	SQUARE STEEL (IN)			TUBULAR STEEL Ø (IN)				SIGN FRAME REQUIRED	REMARKS	SIGN DETAIL							
								"A"	"B"	RETAIN	SALVAGE FROM	SALVAGE TO	REMOVE	RETAIN	REMOVE		1.75	2.00	2.50	FOUNDATION	3.00	3.50	4.00			5.00	DETAIL IN SHS	DETAIL ON SHEET NUMBER	DETAIL ON STD SHEET NUMBER				
																	(LB / FT)				(LB / FT)												
<b>NEWPORT TOWN VT100</b>							FY-FLUORESCENT YELLOW FYG-FLUORESCENT YELLOW GREEN																"SHS"-STANDARD HIGHWAY SIGNS										
			A	M1-5	30	24																											
			A	M3-1	24	12		2.00								2		X					1B	GREEN ON WHITE SHEETING	X	7							
			A	M1-5	30	24		5.00																						E-136B			
			A	M4-5	24	12		2.00																	GREEN ON WHITE SHEETING	X							
			A	M1-5	30	24		5.00																						E-136B			
NB	3.948		A	M2-1S	21	15																											
			A	M1-5	24	30																											
			A	M4-6S	24	12																											
			A	M1-5	24	30																											
			A	M2-1	21	15		2.19															1B	GREEN ON WHITE SHEETING	X	7							
			A	M1-5	30	24		5.00																						E-136B			
			A	M4-6	24	12		2.00																	GREEN ON WHITE SHEETING	X							
			A	M1-5	30	24		5.00																						E-136B			
NB	3.990		A	D1-1A	72	10																											
			A	D1-1A	72	10																											
<b>SIGN SUMMARY SHEET</b>							<b>SHEET TOTALS</b>				28.19	0.00	0	0	0	7	0	0	4	60					PROJECT NAME: <b>Moretown-Newport Town VT100</b>								
											SF	SF	EA	EA	EA	EA	EA	EA	EA	FT					PROJECT NUMBER: <b>STPG SIGN(28)</b>								
VERMONT AGENCY OF TRANSPORTATION							<b>TOWN TOTALS</b>				342.4	0.0	29.0	9.0	9.0	83	0.0	0.0	50	750.0					FILE NAME: <b>Newport Town.xls</b> PLOT DATE: <b>9/30/2009</b>								
																												PROJECT MANAGER: <b>N. Avery</b> DRAWN BY: <b>I. Shea</b>					
																												DESIGNED BY: <b>D. Crossley</b> CHECKED BY: <b>J. Kelly</b>					
																												NEWPORT TOWN SHEET 6 SHEET <b>154</b> OF <b>166</b>					





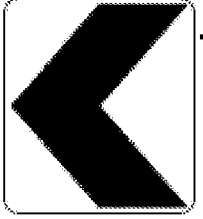
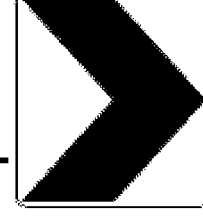
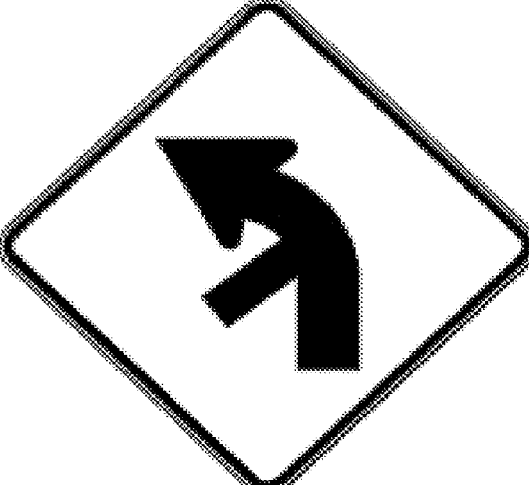

DIRECTION	MILEPOINT	LOCATION CODE (SHEET 2)	SIGN CODE	WIDTH (IN)	HEIGHT (IN)	SHEETING REMARKS	SIGN LEGEND	NEW SIGNS		EXISTING SIGNS				EXIST POST		NUMBER OF NEW POSTS	SQUARE STEEL (IN)			TUBULAR STEEL Ø (IN)				SIGN FRAME REQUIRED	REMARKS	SIGN DETAIL				
								"A"	"B"	RETAIN	SALVAGE FROM	SALVAGE TO	REMOVE	RETAIN	REMOVE		(LB / FT)			(LB / FT)						DETAIL IN SHS	DETAIL ON SHEET NUMBER	DETAIL ON STD SHEET NUMBER		
																	1.75	2.00	2.50	3.00	3.50	4.00	5.00							
<b>NEWPORT TOWN VT100</b>							FY-FLUORESCENT YELLOW FYG-FLUORESCENT YELLOW GREEN															"SHS"-STANDARD HIGHWAY SIGNS								
		A	M6-1L	21	15			2.19																GREEN ON WHITE SHEETING	X					
		A	M3-2	24	12			2.00																GREEN ON WHITE SHEETING	X					
		A	M1-5	30	24			5.00																			E-136B			
		A	M6-3	21	15			2.19																GREEN ON WHITE SHEETING	X					
NB	4.070	A	VR-921L	36	30																									
		A	VR-921L	36	30			7.50																			E-145A			
SB	4.099	F	M3-3S	24	12																									
		F	M1-5	24	30																									
		F	M4-5S	24	12																									
		F	M1-5	24	24																									
		F	M4-4S	24	12																									
		F	M3-2S	24	12																									
		F	M1-5	24	30																									
		F	M3-3	24	12			2.00																						
		F	M1-5	30	24			5.00																			E-136B			
<b>SIGN SUMMARY SHEET</b>							SHEET TOTALS	25.88	0.00	0	0	0	8	0	0	3	45							PROJECT NAME: <b>Moretown-Newport Town VT100</b>						
							SF	SF	EA	EA	EA	EA	EA	EA	EA	EA	FT							PROJECT NUMBER: <b>STPG SIGN(28)</b>						
VERMONT AGENCY OF TRANSPORTATION							TOWN TOTALS	342.4	0.0	29.0	9.0	9.0	83	0.0	0.0	50	750.0							FILE NAME: <b>Newport Town.xls</b>	PLOT DATE: <b>9/30/2009</b>					
																									PROJECT MANAGER: <b>N. Avery</b>	DRAWN BY: <b>I. Shea</b>				
																										DESIGNED BY: <b>D. Crossley</b>	CHECKED BY: <b>J. Kelly</b>			
																										NEWPORT TOWN SHEET <b>8</b>	SHEET <b>156</b> OF <b>166</b>			








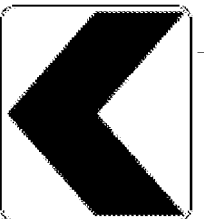


DIRECTION	MILEPOINT	LOCATION CODE (SHEET 2)	SIGN CODE	WIDTH (IN)	HEIGHT (IN)	SHEETING REMARKS	SIGN LEGEND	NEW SIGNS		EXISTING SIGNS				EXIST POST		NUMBER OF NEW POSTS	SQUARE STEEL (IN)			TUBULAR STEEL Ø (IN)				SIGN FRAME REQUIRED	REMARKS	SIGN DETAIL										
								"A"	"B"	RETAIN	SALVAGE FROM	SALVAGE TO	REMOVE	RETAIN	REMOVE		1.75	2.00	2.50	FOUNDATION	3.00	3.50	4.00			5.00	DETAIL IN SHS	DETAIL ON SHEET NUMBER	DETAIL ON STD SHEET NUMBER							
																	(LB / FT)				(LB / FT)															
<b>NEWPORT TOWN VT100</b>							FY-FLUORESCENT YELLOW FYG-FLUORESCENT YELLOW GREEN															"SHS"-STANDARD HIGHWAY SIGNS														
SB	3.367	F	W3-1	36	36		STOP AHEAD			1				X																						
SB	3.335	F	D1-1A	72	10																															
		F	D1-1A	72	10																															
		F	D1-1A	72	10																															
		F	D1-1A	72	10																															
		F	D1-1A	72	10																															
		F	D1-1A	72	12			6.00							2			X											5							
		F	D1-1A	72	12			6.00																					5							
		F	D1-1A	72	12			6.00																					5							
		F	D1-1A	72	12			6.00																					5							
		F	D1-1A	72	12			6.00																					5							
SB	3.292	F	M3-3S	24	12		SOUTH			1				X																						
		F	M1-5	24	24		VT 14			1																										
		F	M6-1S	21	15		LEFT ARROW			1																										
		F	M3-3S	24	12		SOUTH			1																										
<b>SIGN SUMMARY SHEET</b>							SHEET TOTALS	24.00	0.00	1	4	0	5	0	0	2	30																			
								SF	SF	EA	EA	EA	EA	EA	EA	EA	EA	EA	EA	EA	EA	FT														
VERMONT AGENCY OF TRANSPORTATION							TOWN TOTALS	342.4	0.0	29.0	9.0	9.0	83	0.0	0.0	50	750.0																			
PROJECT NAME: <b>Moretown-Newport Town VT100</b>																						PROJECT NUMBER: <b>STPG SIGN(28)</b>					FILE NAME: <b>Newport Town.xls</b>					PLOT DATE: <b>9/30/2009</b>				
PROJECT MANAGER: <b>N. Avery</b>																						DRAWN BY: <b>I. Shea</b>					DESIGNED BY: <b>D. Crosslev</b>					CHECKED BY: <b>J. Kelly</b>				
NEWPORT TOWN SHEET 11																						SHEET <b>159</b> OF <b>166</b>														

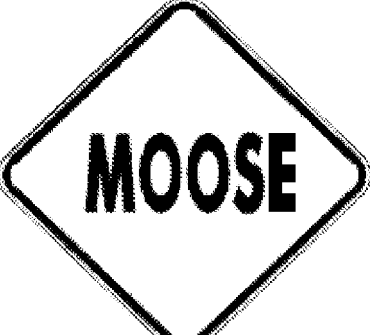

DIRECTION	MILEPOINT	LOCATION CODE (SHEET 2)	SIGN CODE	WIDTH (IN)	HEIGHT (IN)	SHEETING REMARKS	SIGN LEGEND	NEW SIGNS		EXISTING SIGNS			EXIST POST		NUMBER OF NEW POSTS	SQUARE STEEL (IN)			TUBULAR STEEL Ø (IN)				SIGN FRAME REQUIRED	REMARKS	SIGN DETAIL				
								"A"	"B"	RETAIN	SALVAGE FROM	SALVAGE TO	REMOVE	RETAIN		REMOVE	1.75	2.00	2.50	FOUNDATION	3.00	3.50			4.00	5.00	DETAIL IN SHS	DETAIL ON SHEET NUMBER	DETAIL ON STD SHEET NUMBER
																	(LB / FT)				(LB / FT)								
<b>NEWPORT TOWN VT100</b>							FY-FLUORESCENT YELLOW FYG-FLUORESCENT YELLOW GREEN															"SHS"-STANDARD HIGHWAY SIGNS							
	3.176		F M1-5	30	24		VERMONT 100			1																			
SB	3.172		F VR-041	24	24		THROUGH WAY BEGINS HERE																						
			F R2-1	24	30		SPEED LIMIT 50			1	1																		
			E VR-040	24	24		THROUGH WAY ENDS HERE																						
SB	3.021		E W1-8 R	18	24		CHEVRON																						
			F W1-8 L	18	24																								
			E W1-8 R	18	24																								
SB	3.000		F W1-8 L	18	24		 NEW ONES WERE IN PLACE																						
			E W1-8 R	18	24																								
SB	2.936		F M3-3S	24	12		SOUTH																						
			F M1-5	30	24		VERMONT 100																						
SB	2.792		F W2-2ML	30	30		LEFT SIDE ROAD																						
SB	2.732		F W1-2Mb L	30	30																								
			F W16-8A	30	8																								
SB	2.504		G VR-017	24	30		NILES RD TH-16																						
<b>SIGN SUMMARY SHEET</b>							SHEET TOTALS	19.92	0.00	1	1	1	7	0	0	6	90							PROJECT NAME: <b>Moretown-Newport Town VT100</b>					
								SF	SF	EA	EA	EA	EA	EA	EA	EA	FT							PROJECT NUMBER: <b>STPG SIGN(28)</b>					
VERMONT AGENCY OF TRANSPORTATION							TOWN TOTALS	342.4	0.0	29.0	9.0	9.0	83	0.0	0.0	50	750.0							FILE NAME: <b>Newport Town.xls</b>	PLOT DATE: <b>9/30/2009</b>				
																								PROJECT MANAGER: <b>N. Avery</b>	DRAWN BY: <b>I. Shea</b>				
																								DESIGNED BY: <b>D. Crossley</b>	CHECKED BY: <b>J. Kelly</b>				
																								NEWPORT TOWN SHEET 13	SHEET <b>161</b> OF <b>166</b>				

DIRECTION	MILEPOINT	LOCATION CODE (SHEET 2)	SIGN CODE	WIDTH (IN)	HEIGHT (IN)	SHEETING REMARKS	SIGN LEGEND	NEW SIGNS		EXISTING SIGNS				EXIST POST		NUMBER OF NEW POSTS	SQUARE STEEL (IN)			TUBULAR STEEL Ø (IN)				SIGN FRAME REQUIRED	REMARKS	SIGN DETAIL															
								"A"	"B"	RETAIN	SALVAGE FROM	SALVAGE TO	REMOVE	RETAIN	REMOVE		1.75	2.00	2.50	FOUNDATION	3.00	3.50	4.00			5.00	DETAIL IN SHS	DETAIL ON SHEET NUMBER	DETAIL ON STD SHEET NUMBER												
																	(LB / FT)				(LB / FT)																				
<b>NEWPORT TOWN VT100</b>							FY-FLUORESCENT YELLOW FYG-FLUORESCENT YELLOW GREEN															"SHS"-STANDARD HIGHWAY SIGNS																			
		G	VR-017	24	30			5.00							1		X									E-141															
SB	2.493	H	R1-1	24	24																					NILES RD TH-16															
		H	R1-1	30	30			6.25							1		X							X																	
SB	2.125	F	VW-000	30	30		MOOSE CROSSING																																		
		F	W16-4	24	18		NEXT 3500 FT																																		
		F	VW-001	30	30			6.25							1		X									6															
		F	W7-3A	24	18			3.00																X																	
SB	2.050	F	W2-2ML	30	30		MODIFIED LEFT SIDE ROAD			1				X																											
		F	W16-8A	36	8		COLLINS MILL RD			1																															
SB	1.166	G	VR-017	24	30																																				
		G	VR-017	24	30			5.00							1		X									E-141															
SB	1.154	H	R1-1	30	30																																				
		H	R1-1	30	30			6.25							1		X							X																	
SB	1.077	F	30	30			SNOWMOBILE HINGED																																		
SB	0.231	G	VR-017	24	30																					NO. 12 ROAD TH-4															
<b>SIGN SUMMARY SHEET</b>							SHEET TOTALS	31.75	0.00	2	0	0	7	0	0	5		75																							
								SF	SF	EA	EA	EA	EA	EA	EA	EA	EA	EA	EA	EA	EA	FT																			
VERMONT AGENCY OF TRANSPORTATION							TOWN TOTALS	342.4	0.0	29.0	9.0	9.0	83	0.0	0.0	50		750.0																							
																					PROJECT NAME:	<b>Moretown-Newport Town VT100</b>										PROJECT NUMBER:					<b>STPG SIGN(28)</b>				
																					FILE NAME:	<b>Newport Town.xls</b>					PLOT DATE:					<b>9/30/2009</b>									
																					PROJECT MANAGER:	<b>N. Avery</b>					DRAWN BY:					<b>I. Shea</b>									
																					DESIGNED BY:	<b>D. Crossley</b>					CHECKED BY:					<b>J. Kelly</b>									
																					NEWPORT TOWN SHEET 14										SHEET <b>162</b> OF <b>166</b>										



# TOWN TOTAL SIGN SUMMARY SHEET

## VT ROUTE 100 MORETOWN - NEWPORT TOWN STPG SIGN (28)

Townname	County	Town Mileage	NEW SIGNS (SF)		EXISTING SIGNS (EA)			EXIST POST (EA)		NUMBER OF NEW POSTS (EA)			SQUARE STEEL (IN)			TUBULAR STEEL Ø (IN)						
			TYPE A	TYPE B	RETAIN	SALVAGE FROM	SALVAGE TO	REMOVE	RETAIN	REMOVE	1.75"	2"	2.5"	TOTAL POSTS	1.75	2.00	2.50	FOUNDATION	3.00	3.50	4.00	5.00
											(LB / FT)				(LB / FT)				(LB / FT)			(LB / FT)
			1.88	2.42	3.35	1.88	2.42	3.35	7.60	9.00	10.80	14.60										
Moretown	Washington	1.227	228.6	0	22	0	0	60	0	0	0	23	4	27	0	345	60					
Duxbury	Washington	6.234	345.2	0	68	1	1	65	0	0	0	59	3	62	0	885	45					
Waterbury	Washington	6.743	622.8	0	89	5	5	115	0	0	0	101	4	105	0	1515	60					
Stowe	Lamoille	6.819	582.8	0	65	6	6	105	0	0	0	101	2	103	0	1515	30					
Morristown	Lamoille	6.601	369.7	0	77	5	5	65	0	0	0	68	0	68	0	1020	0					
Hyde Park	Lamoille	6.513	287.3	0	80	0	0	54	0	0	0	40	2	42	0	600	30					
Eden	Lamoille	7.689	462.5	0	40	2	2	86	0	0	0	71	6	77	0	1065	90					
Lowell	Orleans	7.031	489.3	0	8	2	2	100	0	0	0	64	10	74	0	960	150					
Westfield	Orleans	4.942	149.5	0	15	0	0	28	0	0	0	26	0	26	0	390	0					
Troy	Orleans	3.122	334.5	0	7	2	2	60	0	0	0	51	4	55	0	765	60					
Newport Town	Orleans	4.211	342.4	0	29	9	9	83	0	0	0	36	14	50	0	540	210					
					<b>Sub-Total</b>			32	32	821			<b>Sub-Total</b>			0	9600	735				
<b>Estimated Salvaged Street Name Signs to be erected onto new posts =</b>								2														
<b>Salvaged From signs to be added to Remove total =</b>								32														
		<b>TOTAL =</b>	4214.6	0	500	32	34	853	0	0	0	640	49	689		10335		0	0	0	0	

PROJECT NAME: MORETOWN - NEWPORT TOWN	
PROJECT NUMBER: STPG SIGN (28)	
FILE NAME: 09b060_TS.DGN	PLOT DATE: 30-SEP-2009
PROJECT LEADER: N. AVERY	DRAWN BY: N. AVERY
DESIGNED BY: N. AVERY	CHECKED BY: A. GAMBLE
TOWN TOTAL SIGN SUMMARY SHEET	SHEET 164 OF 166

Table 6H-2. Meaning of Symbols on Typical Application Diagrams

	Arrow panel
	Arrow panel support or trailer (shown facing down)
	Changeable message sign or support trailer
	Channelizing device
	Crash Cushion
	Direction of temporary traffic detour
	Direction of traffic
	Flagger
	High level warning device (Flag tree)
	Luminaire
	Pavement markings that should be removed for a long term project
	Sign (shown facing left)
	Surveyor
	Temporary barrier
	Temporary barrier with warning lights
	Traffic or Pedestrian signal
	Truck mounted attenuator
	Type III Barricade
	Warning lights
	Work space
	Work vehicle

Figure 6E-1. Use of Hand-Signaling Devices by Flaggers

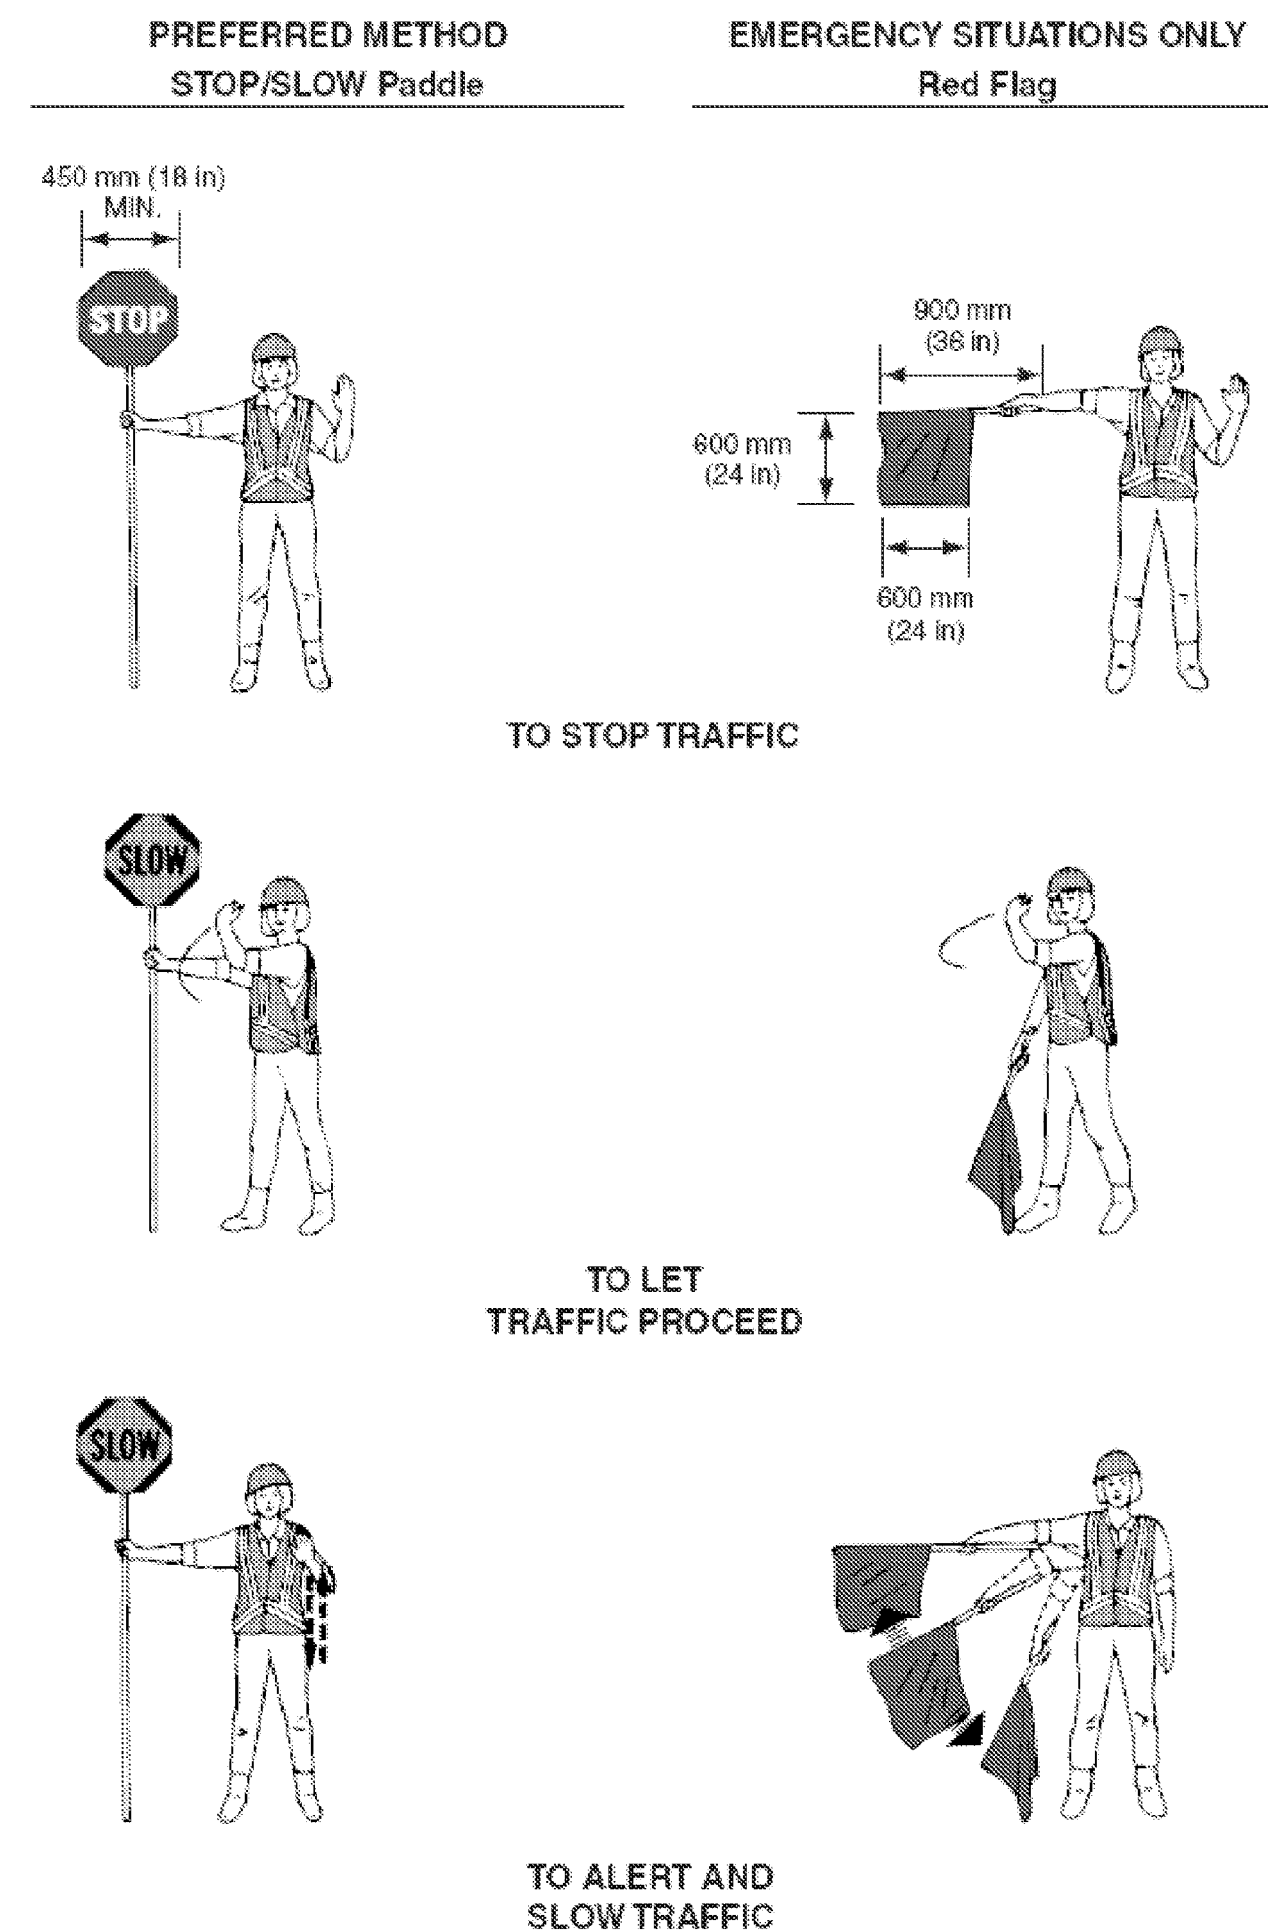


Figure 6C-2. Types of Tapers and Buffer Spaces

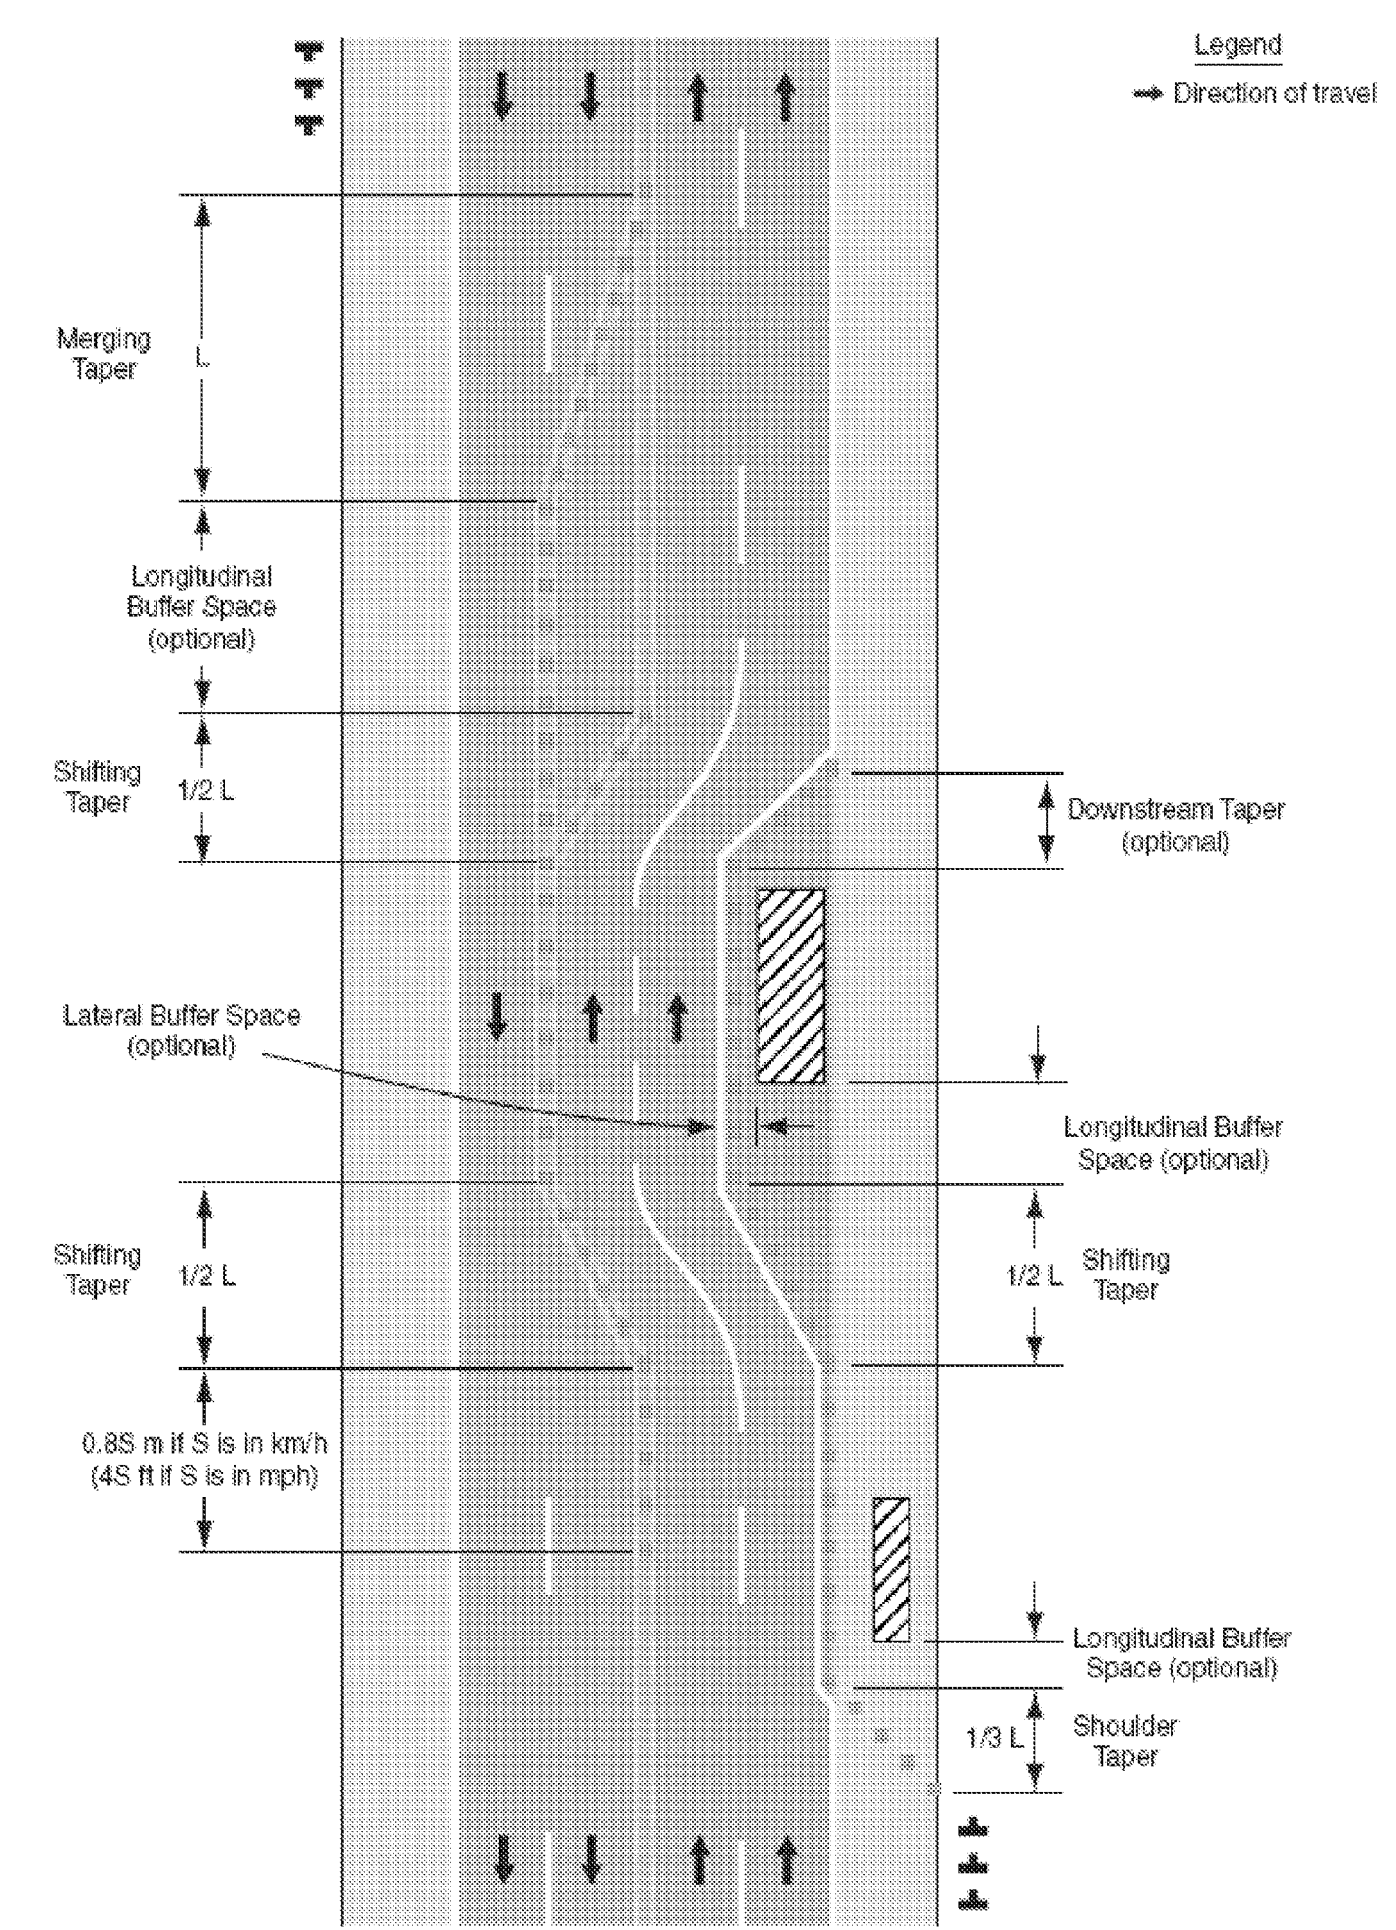


Figure 6H-1. Work Beyond the Shoulder (TA-1)

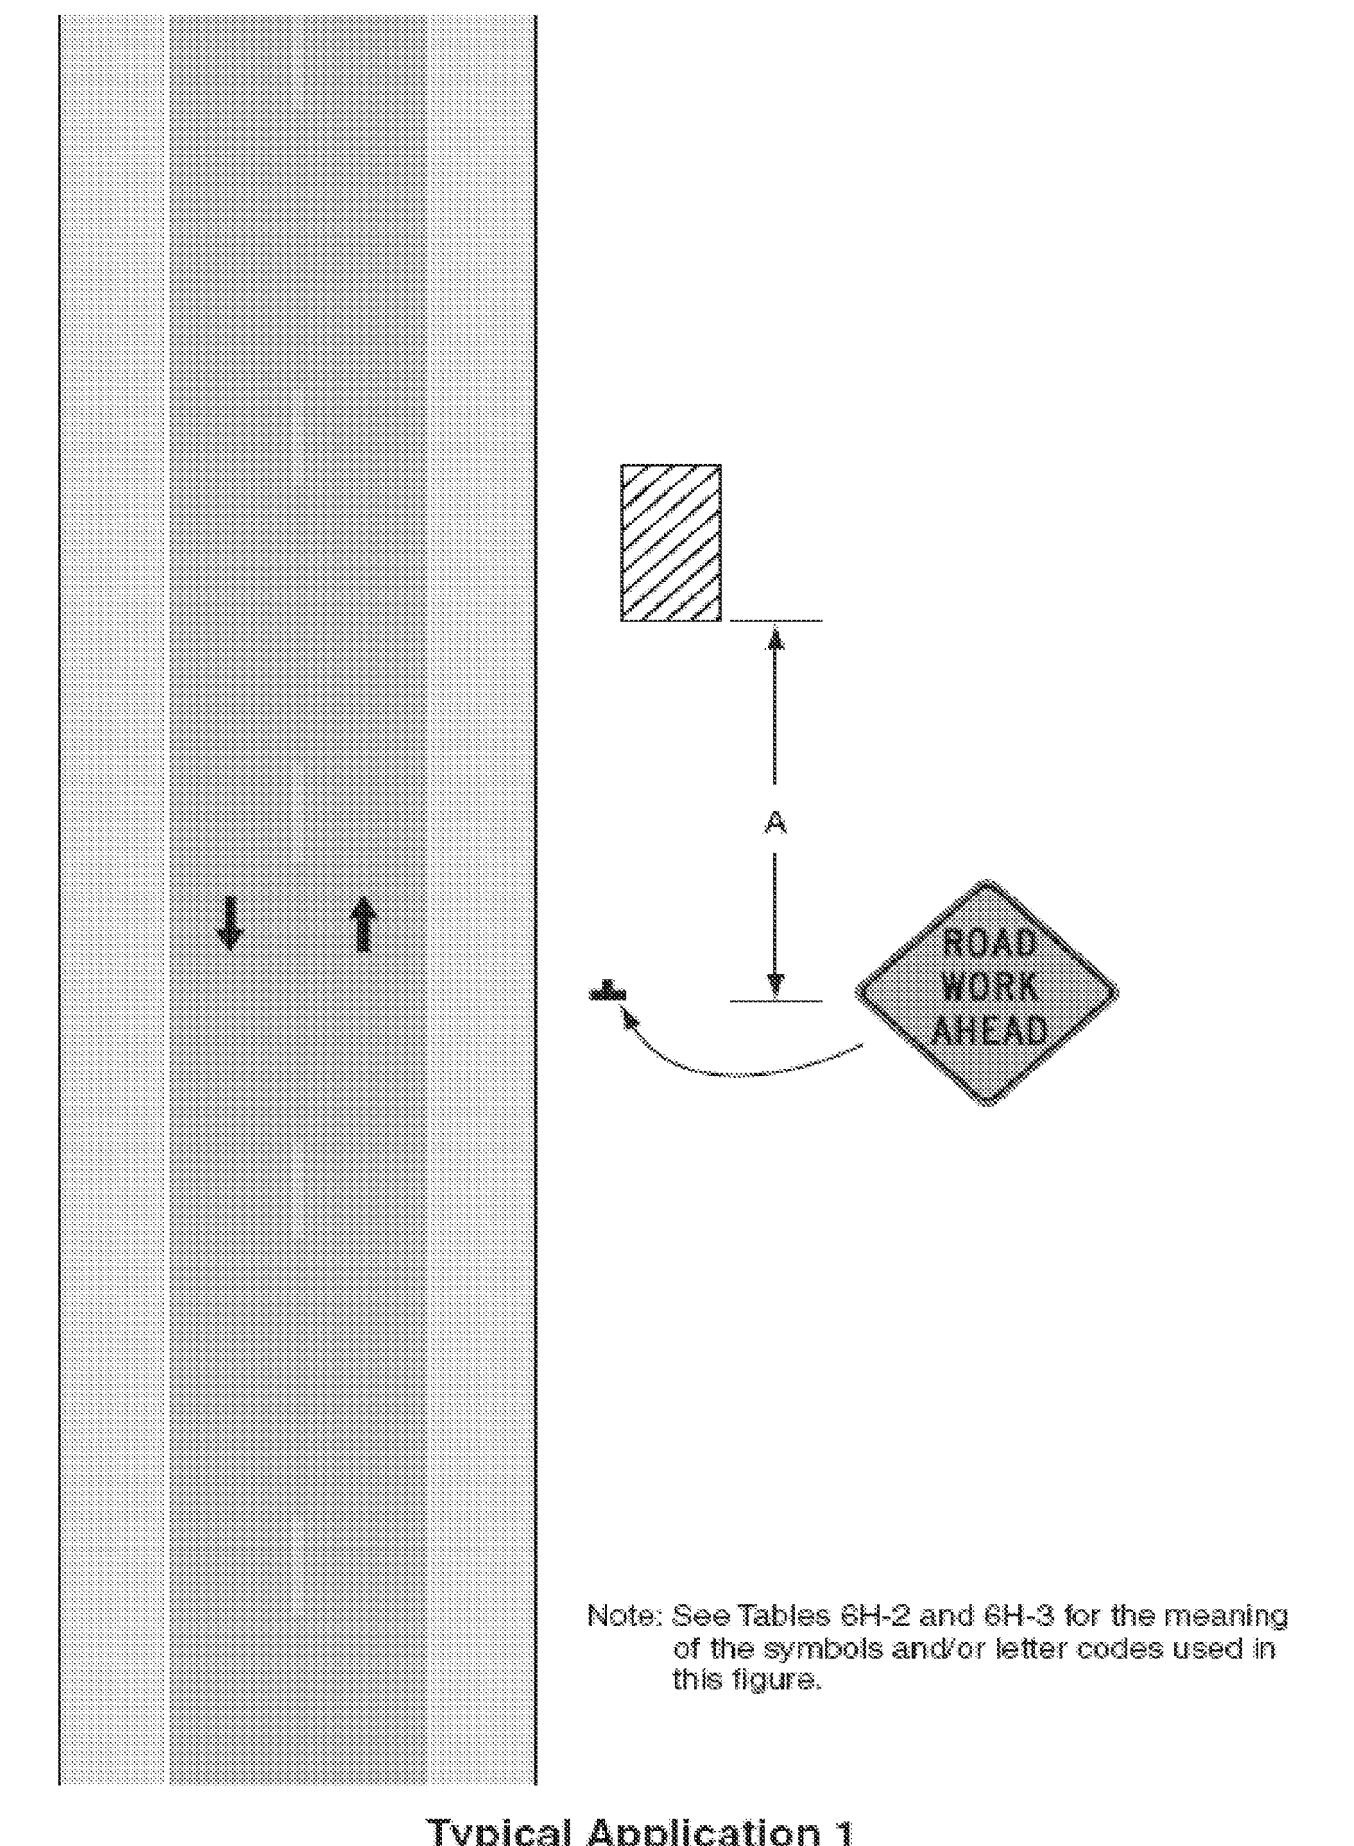


Table 6C-3. Taper Length Criteria for Temporary Traffic Control Zones

Type of Taper	Taper Length (L)*
Merging Taper	at least L
Shifting Taper	at least 0.5L
Shoulder Taper	at least 0.33L
One-Lane, Two-Way Traffic Taper	30 m (100 ft) maximum
Downstream Taper	30 m (100 ft) per lane

Table 6C-4. Formulas for Determining Taper Lengths

Speed Limit (S)	Taper Length (L) Meters	Speed Limit (S)	Taper Length (L) Feet
60 km/h or less	$L = \frac{WS^2}{155}$	40 mph or less	$L = \frac{WS^2}{60}$
70 km/h or more	$L = \frac{WS}{1.6}$	45 mph or more	$L = WS$


Where: L = taper length in meters (feet)  
 W = width of offset in meters (feet)  
 S = posted speed limit, or off-peak 85th-percentile speed prior to work starting, or the anticipated operating speed in km/h (mph)

Table 6H-3. Meaning of Letter Codes on Typical Application Diagrams

Road Type	Distance Between Signs**		
	A	B	C
Urban (low speed)*	30 (100)	30 (100)	30 (100)
Urban (high speed)*	100 (350)	100 (350)	100 (350)
Rural	150 (500)	150 (500)	150 (500)
Expressway / Freeway	300 (1,000)	450 (1,500)	800 (2,640)

\* Speed category to be determined by highway agency  
 \*\* Distances are shown in meters (feet). The column headings A, B, and C are the dimensions shown in Figures shown on the Traffic Control Detail Sheets. The A dimension is the distance from the transition or point of restriction to the first sign. The B dimension is the distance between the first and second signs. The C dimension is the distance between the second and third signs. (The third sign is the first one in a three-sign series encountered by a driver approaching a TTC zone.)

Figure 6F-7. Channelizing Devices (Sheet 1 of 2)

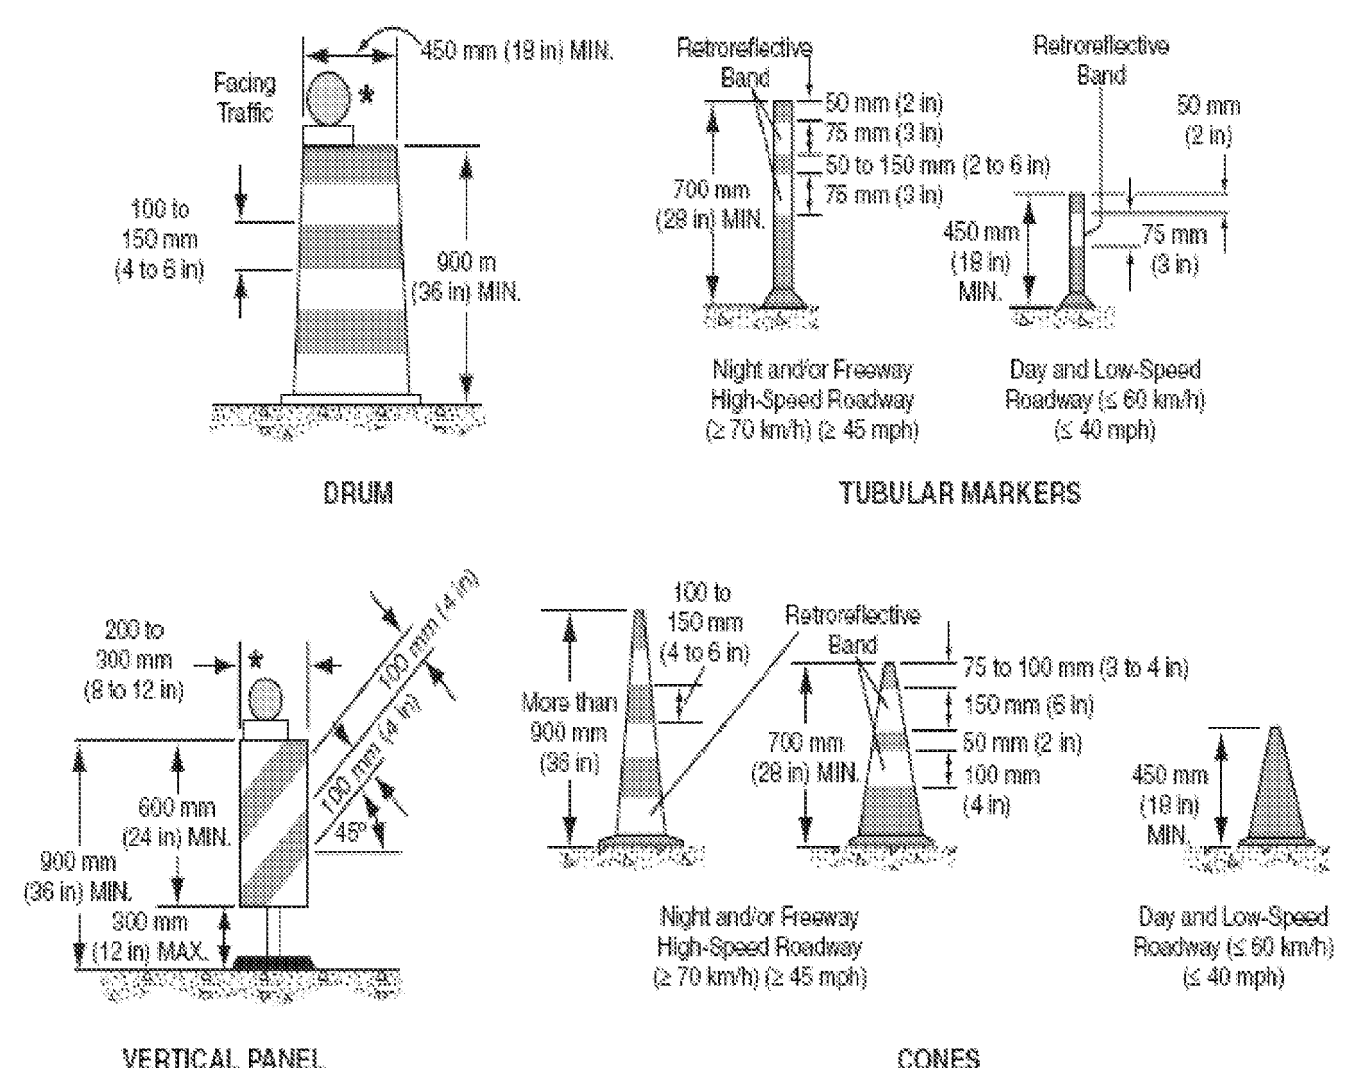

\* Warning lights (optional)  
 Note: If drums, cones, or tubular markers are used to channelize pedestrians, they shall be located such that there are no gaps between the bases of the devices, in order to create a continuous bottom, and the height of each individual drum, cone, or tubular marker shall be no less than 900 mm (36 in) to be detectable to users of long canes.

- TEMPORARY TRAFFIC CONTROL NOTES
- ALL TEMPORARY TRAFFIC CONTROL SHALL BE IN ACCORDANCE WITH THESE PROJECT PLANS, APPLICABLE VTRANS E-SERIES STANDARD DRAWINGS, AND THE MANUAL ON UNIFORM TRAFFIC CONTROL DEVICES (MUTCD), DATED 2003, AND ITS LATEST REVISIONS, OR AS DIRECTED BY THE RESIDENT ENGINEER. IF THE CONTRACTOR DOES NOT WISH TO FOLLOW THE TEMPORARY TRAFFIC CONTROL PROVIDED, HE/SHE MAY SUBMIT AN ALTERNATE PROPOSAL AT THE PRE-CONSTRUCTION MEETING IMPLEMENTING THE PROPOSED CHANGES FOR REVIEW AND APPROVAL BY THE RESIDENT ENGINEER.
  - THE CONTRACTOR MUST PROVIDE ACCESS THROUGH THE WORK ZONE FOR EMERGENCY VEHICLES AT ALL TIMES.
  - THE CONTRACTOR SHALL CONDUCT THE WORK AT ALL TIMES IN SUCH A MANNER AND IN SUCH SEQUENCE SO AS TO ENSURE THE LEAST INTERFERENCE WITH TRAFFIC OCCURS.
  - SIGNS SHALL ONLY BE VISIBLE TO MOTORIST AT THE TIMES WHEN THE MESSAGE IS PERTINENT, I.E. A 'FLAGGER AHEAD' SIGN SHALL ONLY BE VISIBLE TO MOTORIST WHEN THE FLAGGER IS ACTUALLY PRESENT PERFORMING THEIR DUTIES.
  - PAYMENT FOR CONSTRUCTION SIGNING WILL BE MADE UNDER CONTRACT ITEM 641.0.

PROJECT NAME:	MORETOWN - NEWPORT TOWN
PROJECT NUMBER:	STPG SIGN (28)
FILE NAME:	09B060_TS.DGN
PROJECT LEADER:	N. AVERY
DESIGNED BY:	N. AVERY
TRAFFIC CONTROL I	
PLOT DATE:	30-SEP-2009
DRAWN BY:	N. AVERY
CHECKED BY:	A. GAMBLE
SHEET	165 OF 166

Figure 6H-3. Work on Shoulders (TA-3)

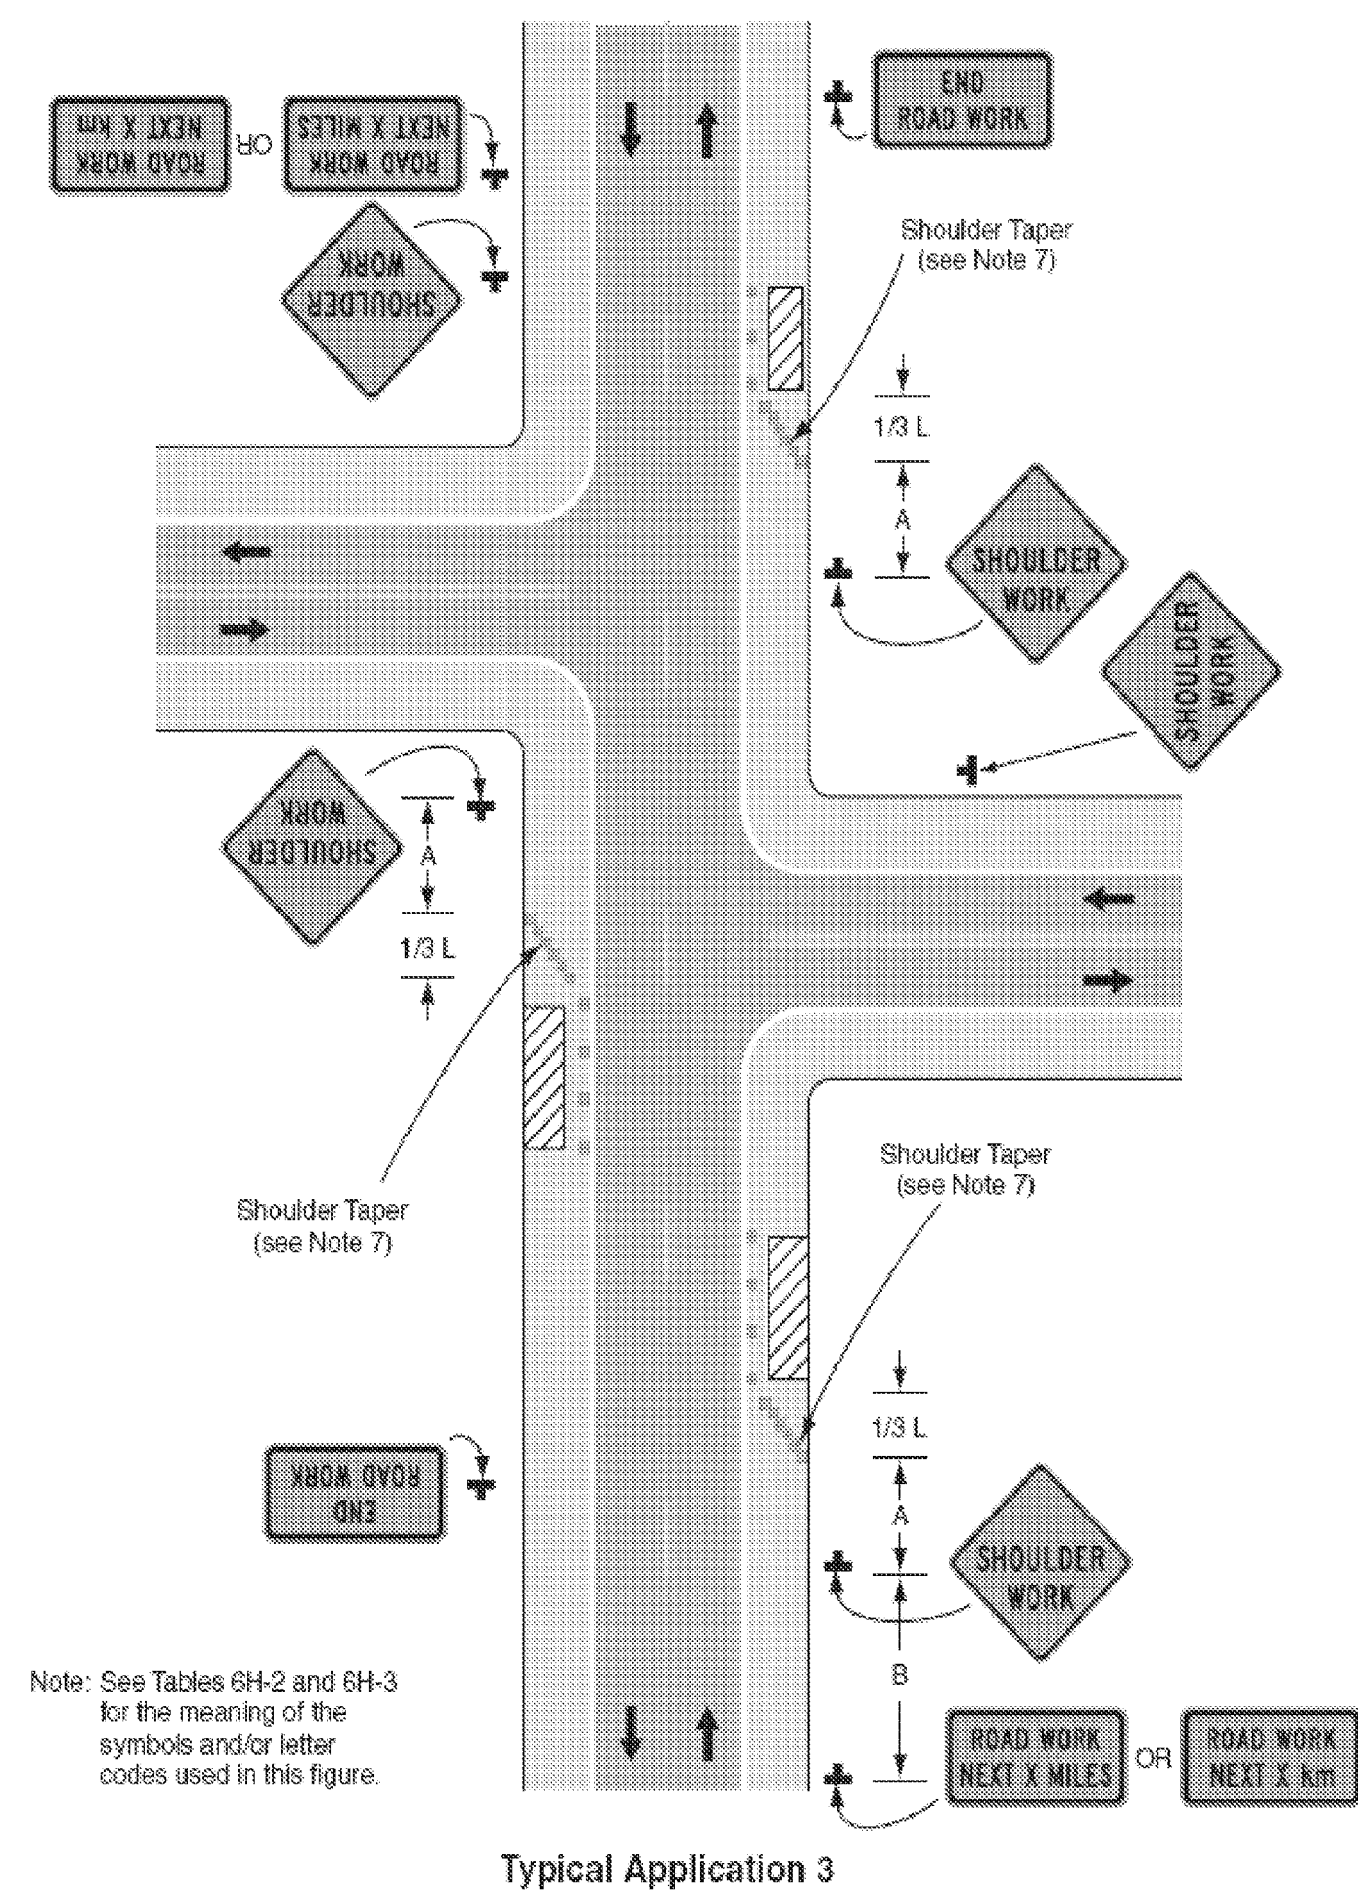


Figure 6H-4. Short-Duration or Mobile Operation on Shoulder (TA-4)

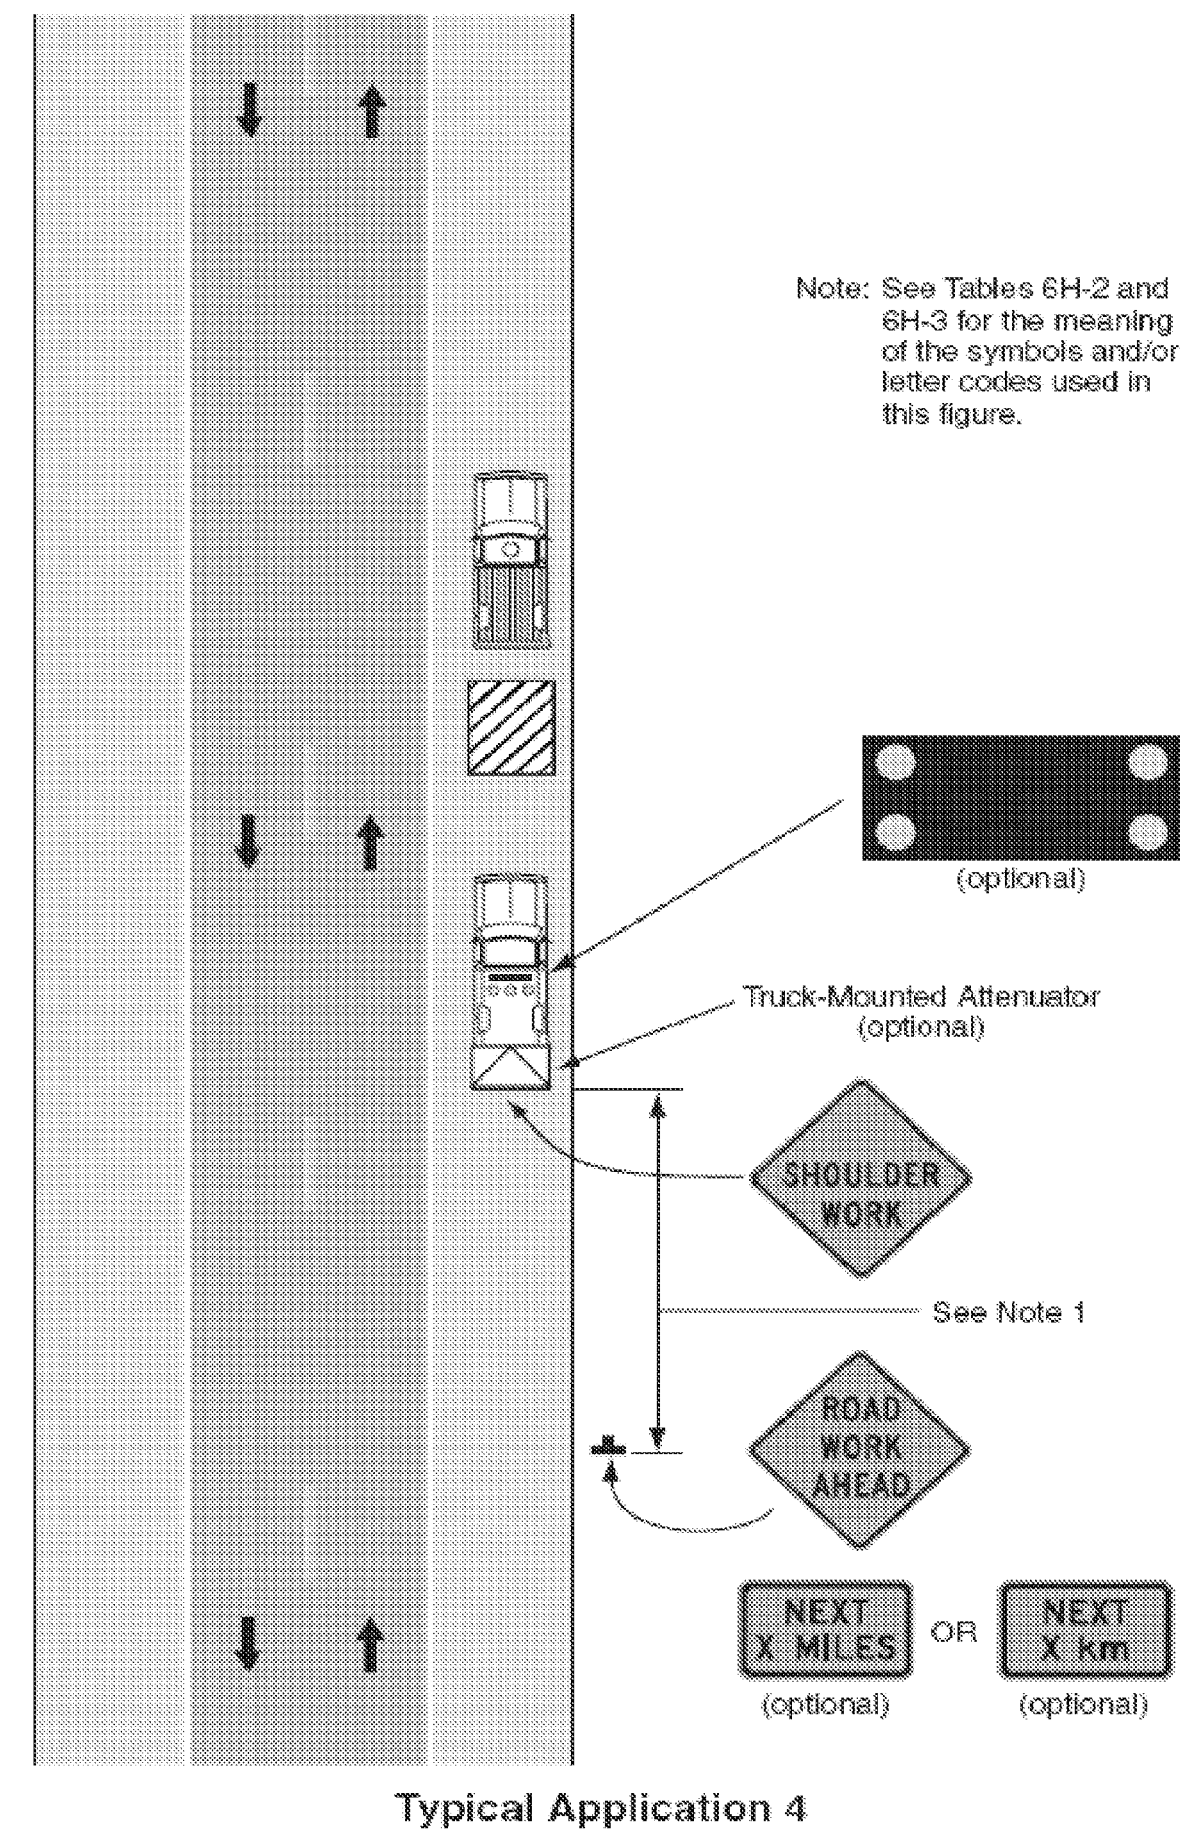


Figure 6H-6. Shoulder Work with Minor Encroachment (TA-6)


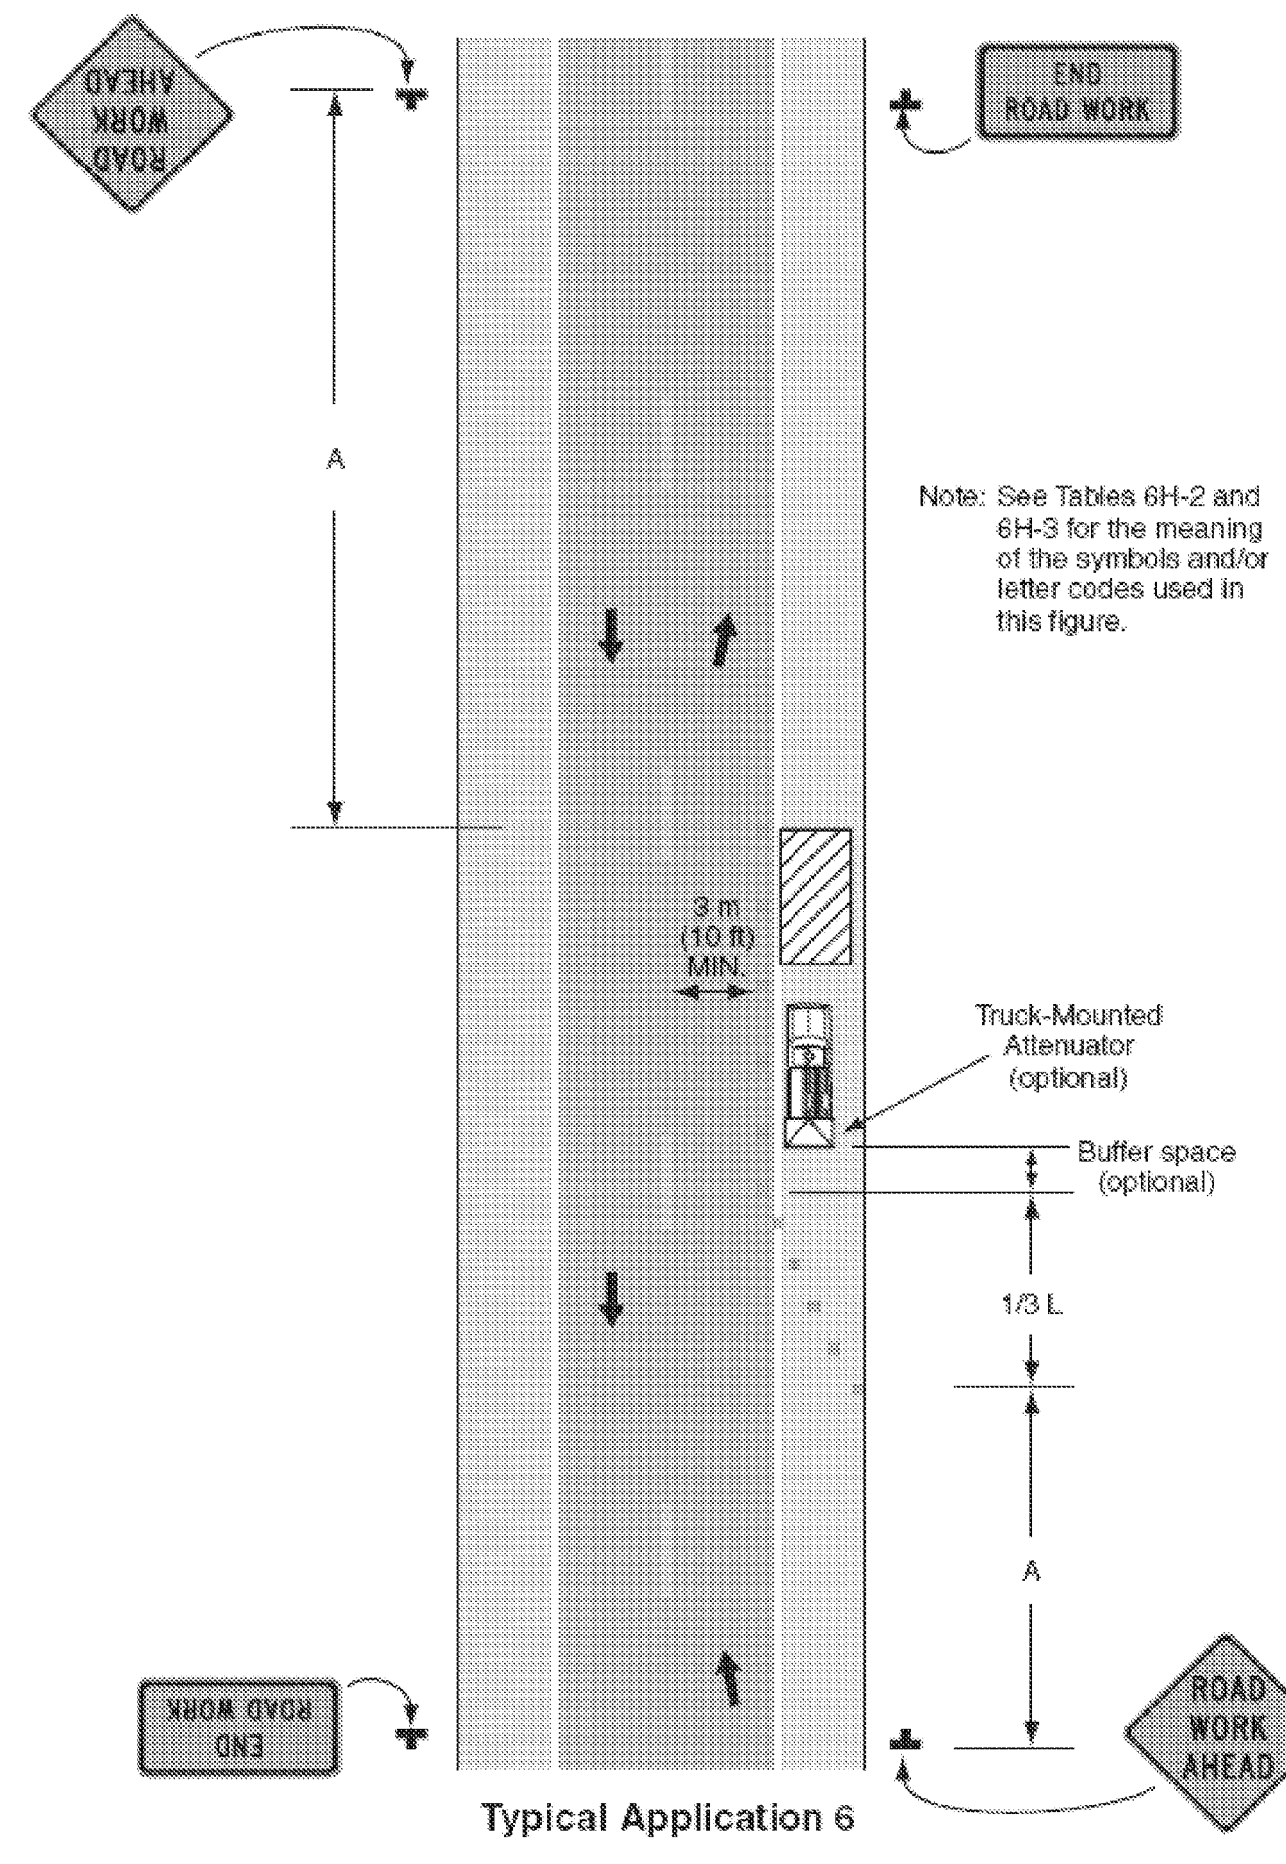


Figure 6H-10. Lane Closure on Two-Lane Road Using Flaggers (TA-10)

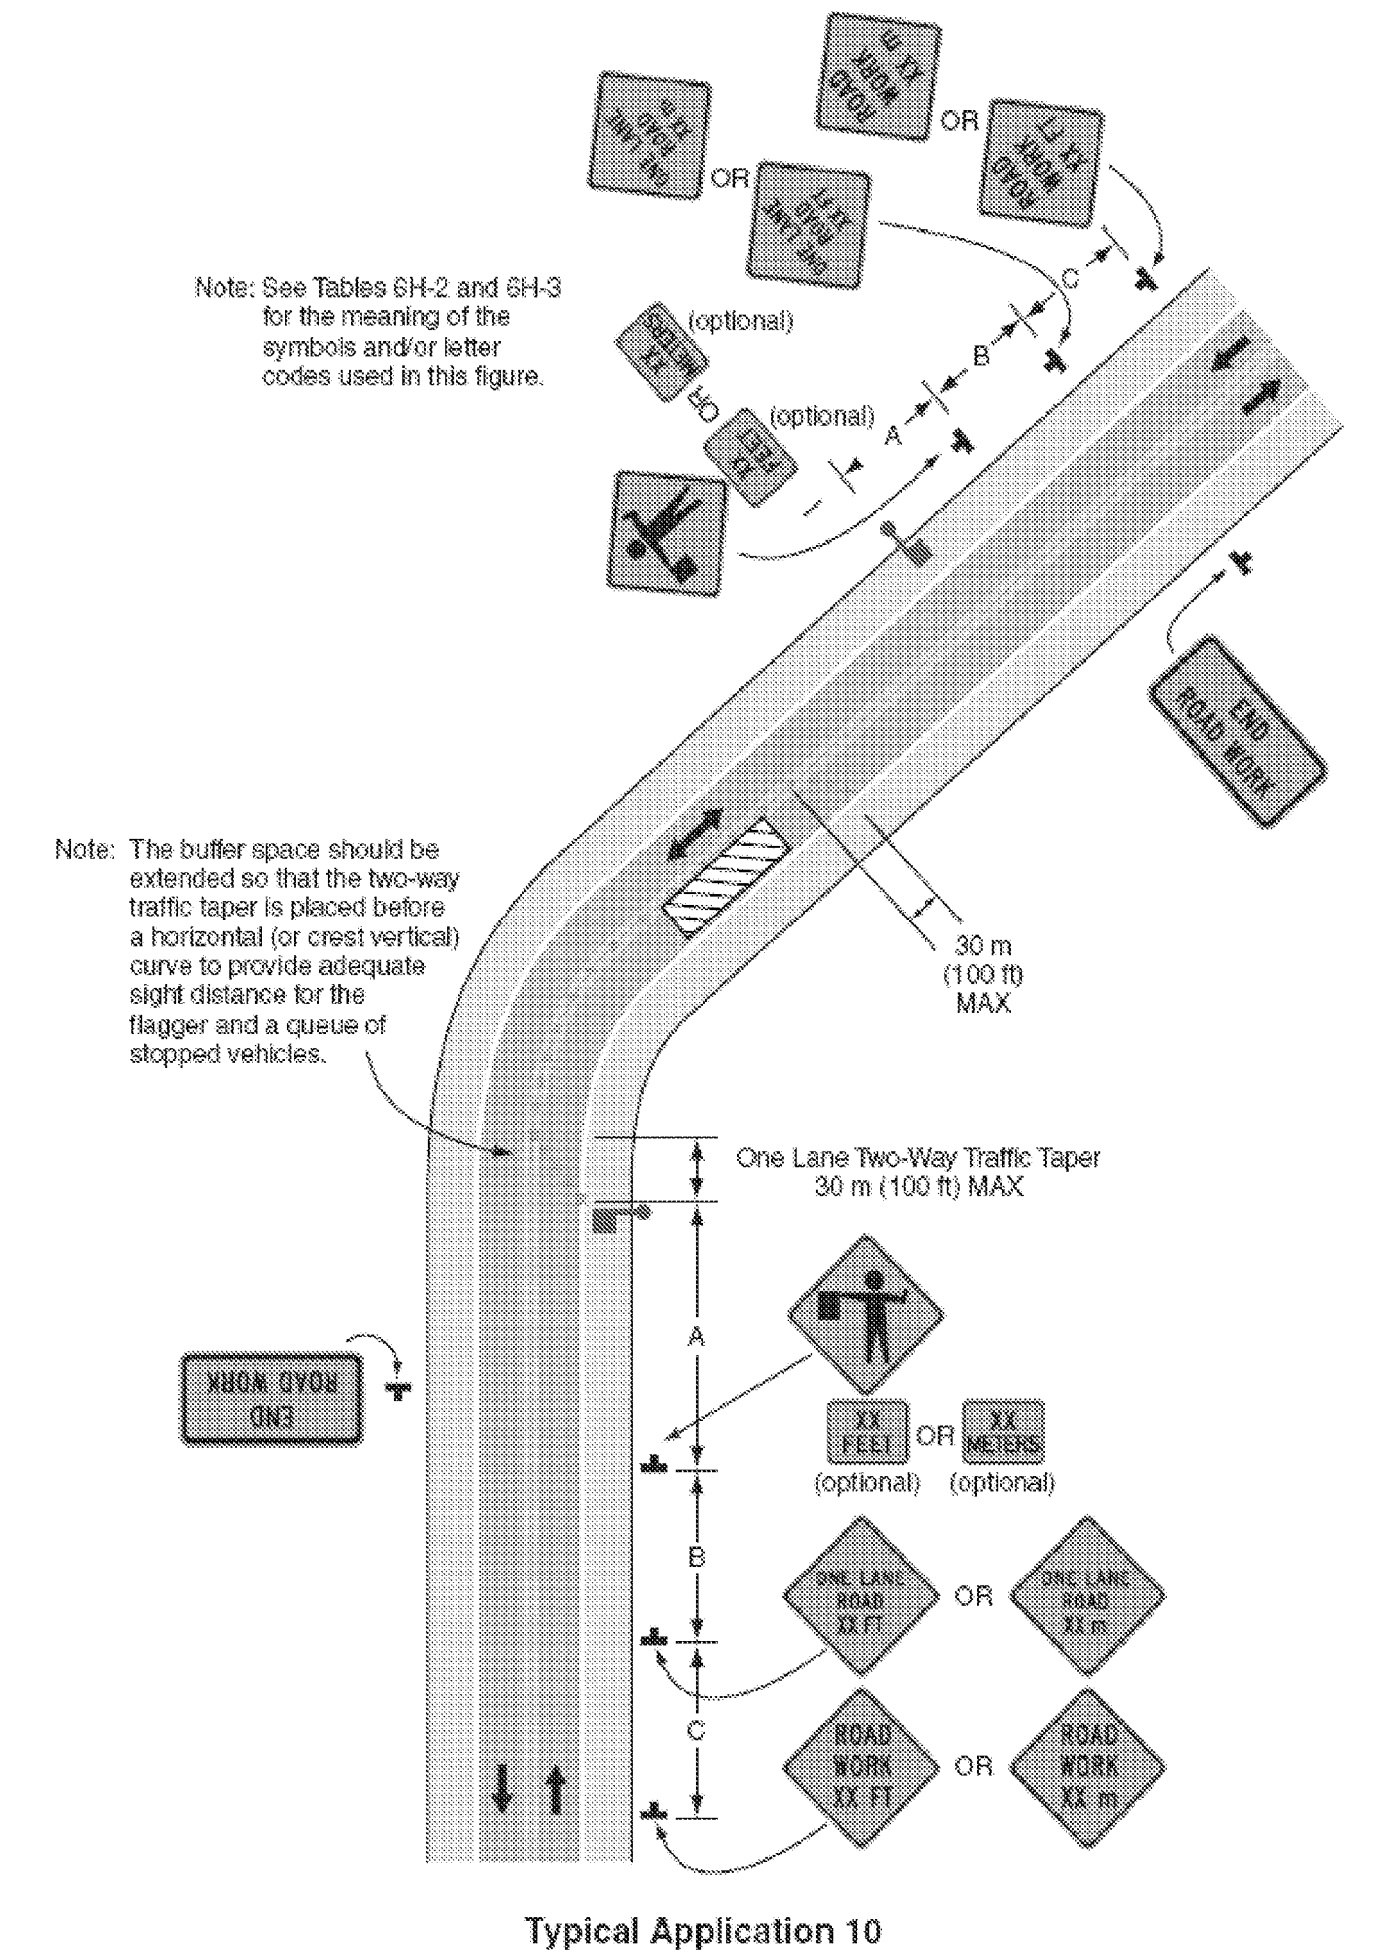

PROJECT NAME: MORETOWN - NEWPORT TOWN  
 PROJECT NUMBER: STPG SIGN (28)

FILE NAME: 09B060\_TS.DGN  
 PROJECT LEADER: N. AVERY  
 DESIGNED BY: N. AVERY  
 TRAFFIC CONTROL 2

PLOT DATE: 30-SEP-2009  
 DRAWN BY: N. AVERY  
 CHECKED BY: A. GAMBLE  
 SHEET 166 OF 166