




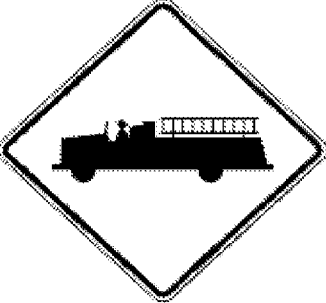

| DIRECTION | MILEPOINT | LOCATION CODE (SHEET 2) | SIGN CODE | WIDTH (IN) | HEIGHT (IN) | SHEETING REMARKS | SIGN LEGEND | NEW SIGNS | | EXISTING SIGNS | | | | EXIST POST | | NUMBER OF NEW POSTS | SQUARE STEEL (IN) | | | TUBULAR STEEL Ø (IN) | | | | SIGN FRAME REQUIRED | REMARKS | SIGN DETAIL | | | |
|--|-----------|-------------------------|-----------|------------|-------------|------------------|--|-----------|------|----------------|--------------|------------|--------|--------------------------------|--------|---------------------|-------------------|------|------|----------------------|--------------------------------------|------|------------------------------|-------------------------|---------|-------------|---------------|------------------------|----------------------------|
| | | | | | | | | "A" | "B" | RETAIN | SALVAGE FROM | SALVAGE TO | REMOVE | RETAIN | REMOVE | | 1.75 | 2.00 | 2.50 | FOUNDATION | 3.00 | 3.50 | 4.00 | | | 5.00 | DETAIL IN SHS | DETAIL ON SHEET NUMBER | DETAIL ON STD SHEET NUMBER |
| | | | | | | | | | | | | | | | | | (LB / FT) | | | | (LB / FT) | | | | | | | | |
| LOWELL VT 100 | | | | | | | FY-FLUORESCENT YELLOW FYG-FLUORESCENT YELLOW GREEN | | | | | | | | | | | | | | | | "SHS"-STANDARD HIGHWAY SIGNS | | | | | | |
| | | C | M3-3 | 24 | 12 | | | 2.00 | | | | | | | | | | | | | | | | GREEN ON WHITE SHEETING | X | | | | |
| | | C | M1-5 | 30 | 24 | | | 5.00 | | | | | | | | | | | | | | | | | | E-136B | | | |
| | | C | M6-1 R | 21 | 15 | | | 2.19 | | | | | | | | | | | | | | | | GREEN ON WHITE SHEETING | X | | | | |
| NB | 4.395 | F | W11-8 | 30 | 30 | |  | | | | | 1 | X | | | | | | | | | | | | | | | | |
| | | F | W11-8 | 30 | 30 | | | 6.25 | | | | | | 1 | X | | | | | | | | | | | X | | | |
| NB | 4.410 | A | M3-1 | 24 | 12 | | | | | | | 1 | X | | | | | | | | | | | | | | | | |
| | | A | M1-6 | 30 | 24 | | | | | | | 1 | | | | | | | | | | | | | | | | | |
| | | A | M3-1 | 24 | 12 | |  | 2.00 | | | | | | 1 | X | | | | | | | | | GREEN ON WHITE SHEETING | X | | | | |
| | | A | M1-5 | 30 | 24 | | | 5.00 | | | | | | | | | | | | | | | | | | E-136B | | | |
| NB | 4.443 | A | D2-1 | 72 | 10 | | TROY 10 | | | | | 1 | X | | | | | | | | | | | | | | | | |
| | | A | D2-1 | 72 | 12 | |  | 6.00 | | | | | | 2 | X | | | | | | | | | | | | 5 | | |
| | | A | D2-1 | 72 | 12 | |  | 6.00 | | | | | | | | | | | | | | | | | | | | | |
| NB | 4.478 | A | R2-1 | 24 | 30 | |  | | | | | 1 | X | | | | | | | | | | | | | | | | |
| | | A | R2-1 | 24 | 30 | | | 5.00 | | | | | | 1 | X | | | | | | | | | | | X | | | |
| NB | 4.670 | A | S1-1 | 36 | 36 | | | | | | | 1 | X | | | | | | | | | | | | | | | | |
| SIGN SUMMARY SHEET | | | | | | | SHEET TOTALS | 34.44 | 0.00 | 0 | 0 | 0 | 6 | 0 | 0 | 5 | 75 | | | | | | | | | | | | |
| | | | | | | | | SF | SF | EA | EA | EA | EA | EA | EA | EA | FT | | | | | | | | | | | | |
| VERMONT AGENCY OF TRANSPORTATION | | | | | | | TOWN TOTALS | 489.3 | 0.0 | 8.0 | 2.0 | 2.0 | 100 | 0.0 | 0.0 | 74 | 1110.0 | | | | | | | | | | | | |
| PROJECT NAME: Moretown-Newport Town VT100 | | | | | | | | | | | | | | | | | | | | | PROJECT NUMBER: STPG SIGN(28) | | | | | | | | |
| FILE NAME: Lowell.xls | | | | | | | | | | | | | | PLOT DATE: 9/30/2009 | | | | | | | | | | | | | | | |
| PROJECT MANAGER: N. Avery | | | | | | | | | | | | | | DRAWN BY: I. Shea | | | | | | | | | | | | | | | |
| DESIGNED BY: D. Crosslev | | | | | | | | | | | | | | CHECKED BY: J. Kelly | | | | | | | | | | | | | | | |
| LOWELL SHEET 7 | | | | | | | | | | | | | | SHEET 125 OF 166 | | | | | | | | | | | | | | | |