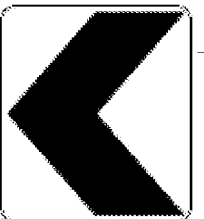

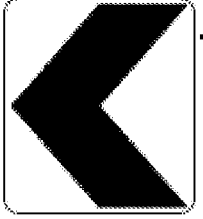
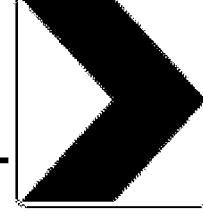
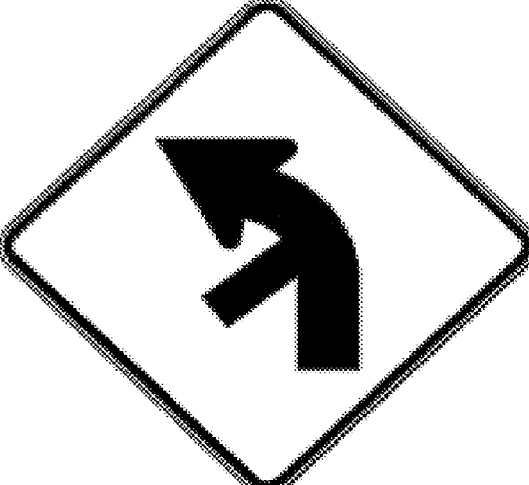



DIRECTION	MILEPOINT	LOCATION CODE (SHEET 2)	SIGN CODE	WIDTH (IN)	HEIGHT (IN)	SHEETING REMARKS	SIGN LEGEND	NEW SIGNS		EXISTING SIGNS				EXIST POST		NUMBER OF NEW POSTS	SQUARE STEEL (IN)			TUBULAR STEEL Ø (IN)				SIGN FRAME REQUIRED	REMARKS	SIGN DETAIL												
								"A"	"B"	RETAIN	SALVAGE FROM	SALVAGE TO	REMOVE	RETAIN	REMOVE		1.75	2.00	2.50	FOUNDATION	3.00	3.50	4.00			5.00	DETAIL IN SHS	DETAIL ON SHEET NUMBER	DETAIL ON STD SHEET NUMBER									
																	(LB / FT)				(LB / FT)																	
NEWPORT TOWN VT100							FY-FLUORESCENT YELLOW FYG-FLUORESCENT YELLOW GREEN																"SHS"-STANDARD HIGHWAY SIGNS															
	3.176		F M1-5	30	24		VERMONT 100			1																												
SB	3.172		F VR-041	24	24		THROUGH WAY BEGINS HERE																															
			F R2-1	24	30		SPEED LIMIT 50				1	1				1		X																				
			E VR-040	24	24		THROUGH WAY ENDS HERE																															
SB	3.021		E W1-8 R	18	24		CHEVRON																															
			F W1-8 L	18	24																																	
			E W1-8 R	18	24																																	
SB	3.000		F W1-8 L	18	24		 NEW ONES WERE IN PLACE																															
			E W1-8 R	18	24																																	
SB	2.936		F M3-3S	24	12		SOUTH																															
			F M1-5	30	24		VERMONT 100																															
SB	2.792		F W2-2ML	30	30		LEFT SIDE ROAD																															
SB	2.732		F W1-2Mb L	30	30																																	
			F W16-8A	30	8																																	
SB	2.504		G VR-017	24	30		NILES RD TH-16																															
SIGN SUMMARY SHEET							SHEET TOTALS											19.92	0.00	1	1	1	7	0	0	6	90											
							SF	SF	EA	EA	EA	EA	EA	EA	EA	EA	EA	EA	EA	EA	EA	EA	EA	EA	EA	EA	EA	EA	EA	EA	EA	EA	EA	EA	EA	EA		
VERMONT AGENCY OF TRANSPORTATION							TOWN TOTALS											342.4	0.0	29.0	9.0	9.0	83	0.0	0.0	50	750.0											
																		PROJECT NAME: Moretown-Newport Town VT100 PROJECT NUMBER: STPG SIGN(28) FILE NAME: Newport Town.xls PLOT DATE: 9/30/2009 PROJECT MANAGER: N. Avery DRAWN BY: I. Shea DESIGNED BY: D. Crossley CHECKED BY: J. Kelly NEWPORT TOWN SHEET 13 SHEET 161 OF 166																				