

# STATE OF VERMONT AGENCY OF TRANSPORTATION



## PROPOSED IMPROVEMENT BRIDGE PROJECT


TOWN OF WALDEN  
COUNTY OF CALEDONIA

ROUTE NO : VT 15 (MINOR ARTERIAL)      BRIDGE NO : 83


PROJECT LOCATION : BEGINNING AT A POINT ON VT 15 APPROXIMATELY 5.15 MILES SOUTHEASTERLY OF  
THE HARDWICK/WALDEN TOWN LINE AND EXTENDING EAST 0.13 MILES

PROJECT DESCRIPTION : REPLACEMENT OF BRIDGE 83 WITH RELATED APPROACH ROADWAY AND CHANNEL WORK

LENGTH OF STRUCTURE :                      57.97 FEET.  
LENGTH OF ROADWAY :                      217.03 FEET.  
LENGTH OF PROJECT :                      275.00 FEET.

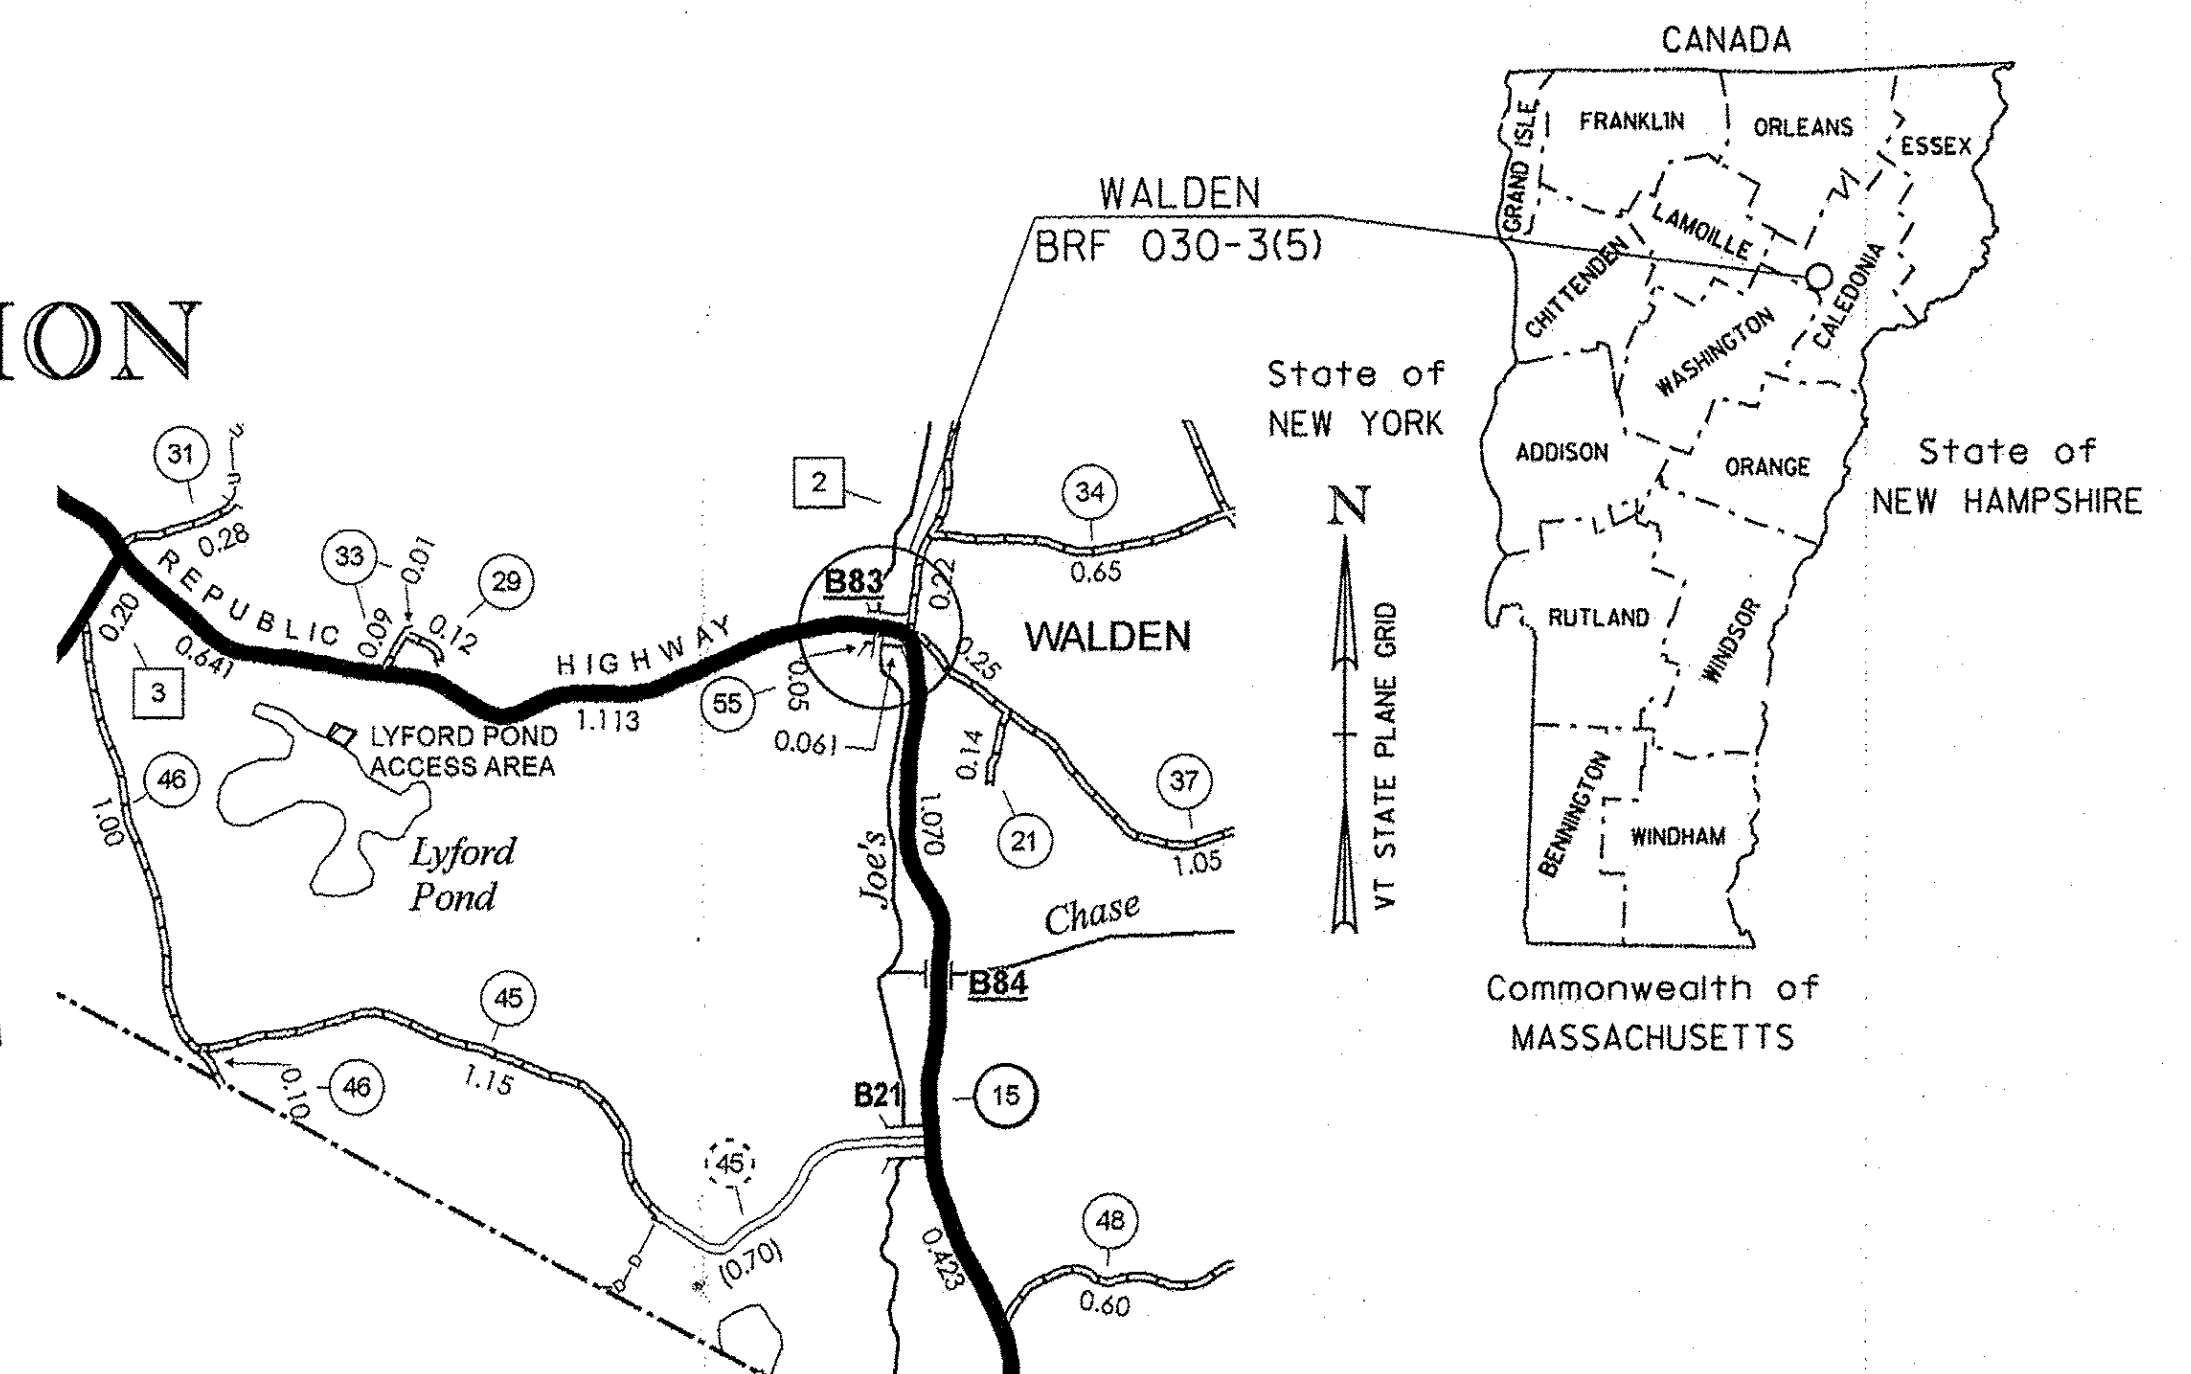

RECORD PLANS	
CONTRACTOR:	J. A. MCDONALD INC. - LYNDON CENTER, VT.
RESIDENT ENGINEER:	KEVIN MCCLURE
CONSTRUCTION BEGAN:	JUNE 29, 2015
CONSTRUCTION COMPLETE:	AUGUST 31, 2015
RECORD PLANS BY:	KEVIN MCCLURE & KEVIN KING
I HEREBY CERTIFY THAT ALL THE CONSTRUCTION REQUIRED BY THIS SET OF DRAWINGS HAS BEEN ACCOMPLISHED AS INDICATED HEREIN.	
BY	<i>Kevin McClure</i> RESIDENT ENGINEER
DATE	8-22-16
NOTE: Any further information concerning final quantities, amounts or other details relative to this project may be found at Central Files in the electronic archives.	

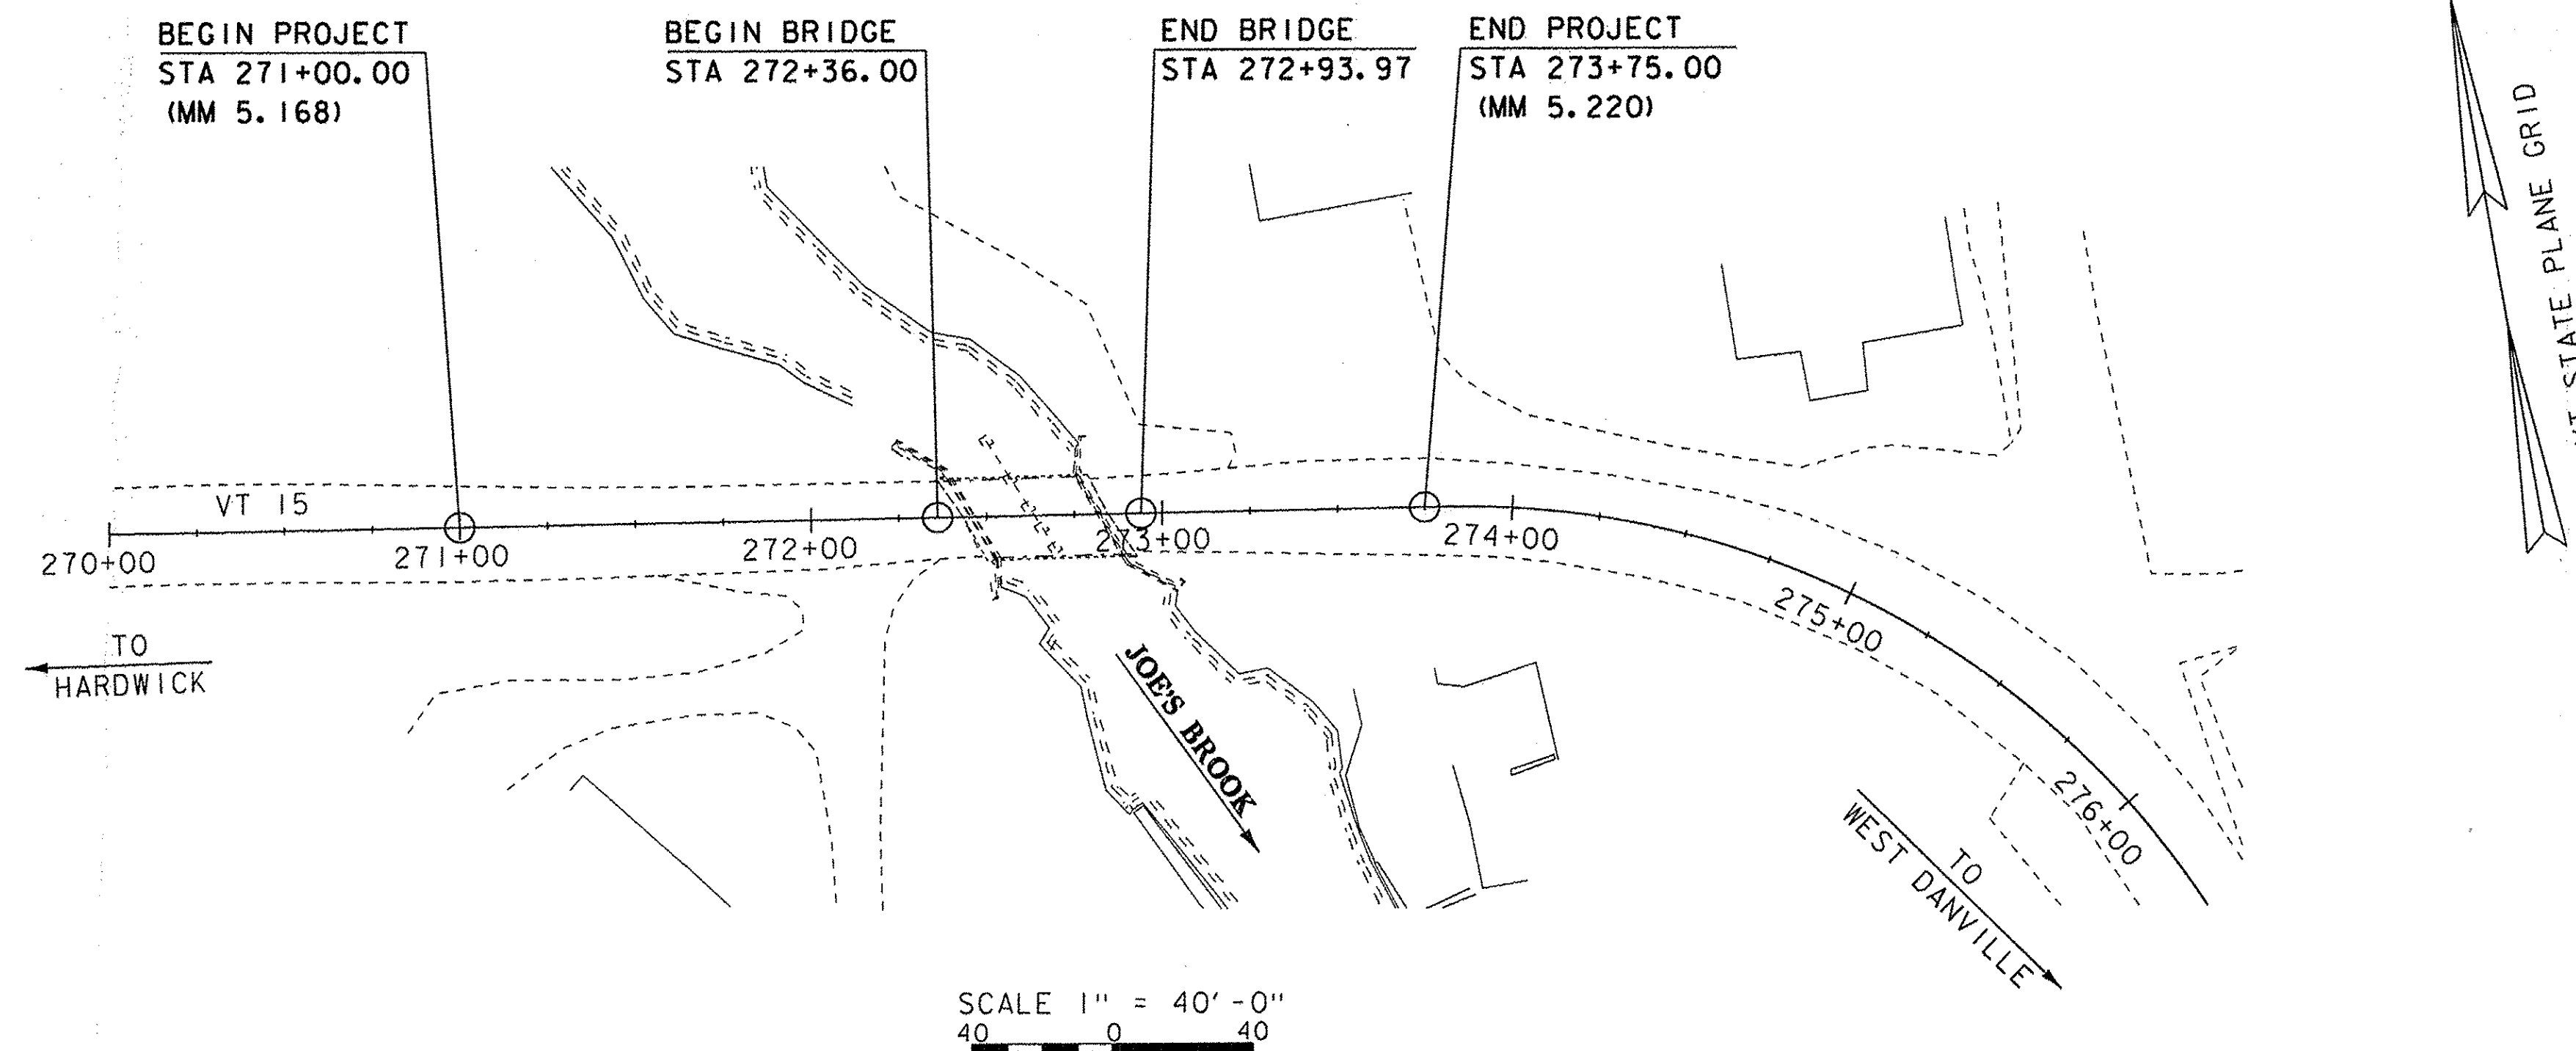

CONSTRUCTION IS TO BE CARRIED ON IN ACCORDANCE WITH THESE PLANS AND THE STANDARD SPECIFICATIONS FOR CONSTRUCTION DATED 2011, AS APPROVED BY THE FEDERAL HIGHWAY ADMINISTRATION ON JULY 20, 2011 FOR USE ON THIS PROJECT, INCLUDING ALL SUBSEQUENT REVISIONS AND SUCH REVISED SPECIFICATIONS AND SPECIAL PROVISIONS AS ARE INCORPORATED IN THESE PLANS.

QUALITY ASSURANCE PROGRAM : LEVEL 2	
SURVEYED BY :	R. GILMAN
SURVEYED DATE :	5/17/2010
DATUM	
VERTICAL	NAVD 88
HORIZONTAL	NAD 83 (07)

SCALE 1" = 40'-0"  
40 0 40

DIRECTOR OF PROJECT DELIVERY	
APPROVED <i>[Signature]</i>	DATE 12/5/2014
PROJECT MANAGER : CAROLYN CARLSON, P.E.	
PROJECT NAME : WALDEN	
PROJECT NUMBER : BRF 030-3(5)	
SHEET 1 OF 56 SHEETS	