



ROADWAY TYPICAL SECTION
SCALE: 1/2" = 1'-0"

** 2 LIFTS OF 1 1/2" BITUM. CONC. PAVEMENT TYPE IVS OVER
2 LIFTS OF 2 1/2" BITUM. CONC. PAVEMENT TYPE IIS
PAID UNDER SPECIAL PROVISION (BITUMINOUS CONCRETE
PAVEMENT, SMALL QUANTITY).

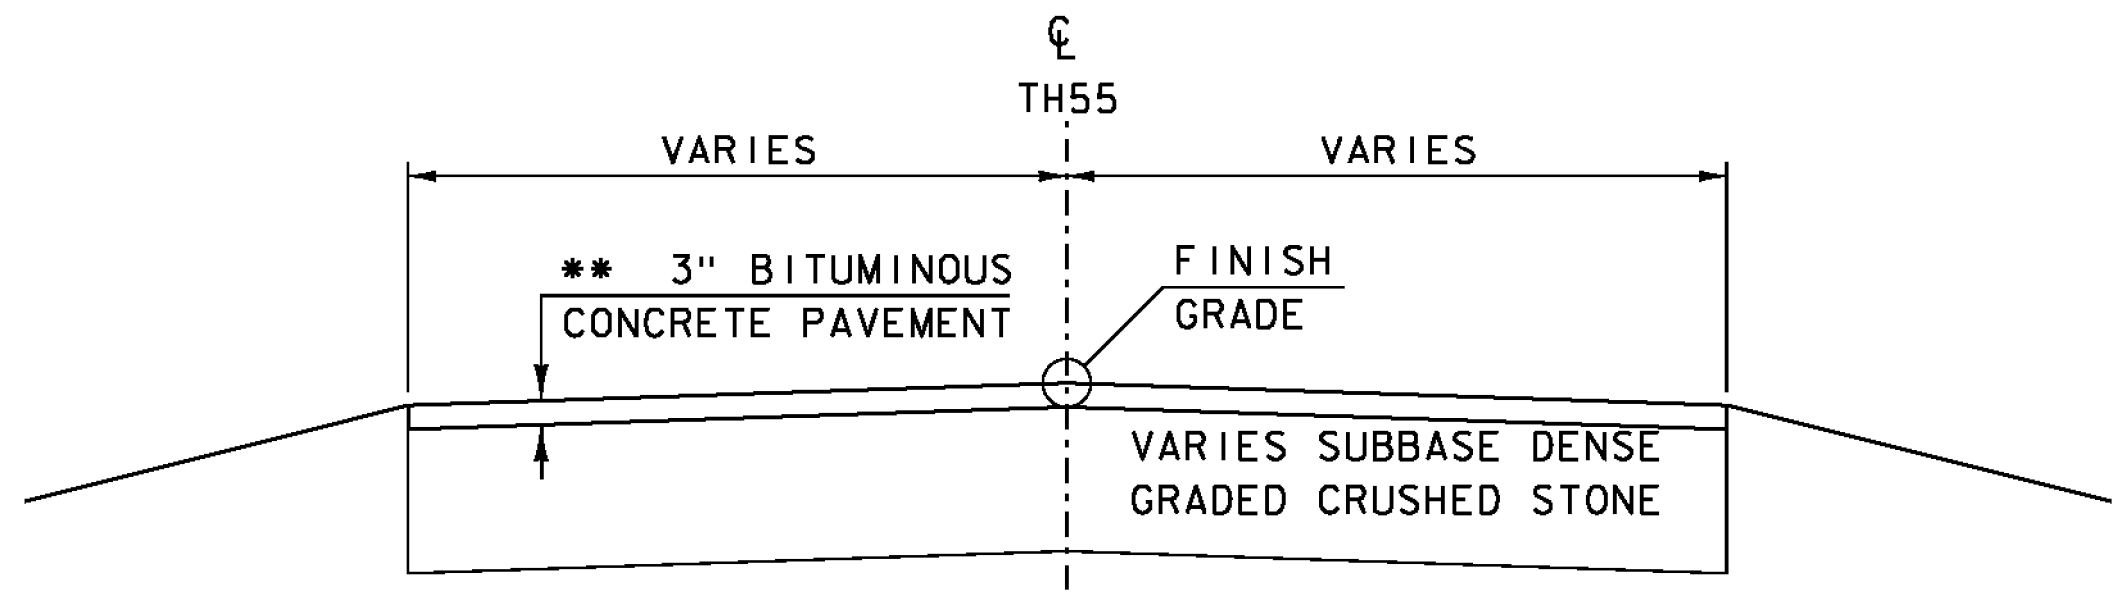

TH 55 TYPICAL SECTION
SCALE: 1/2" = 1'-0"

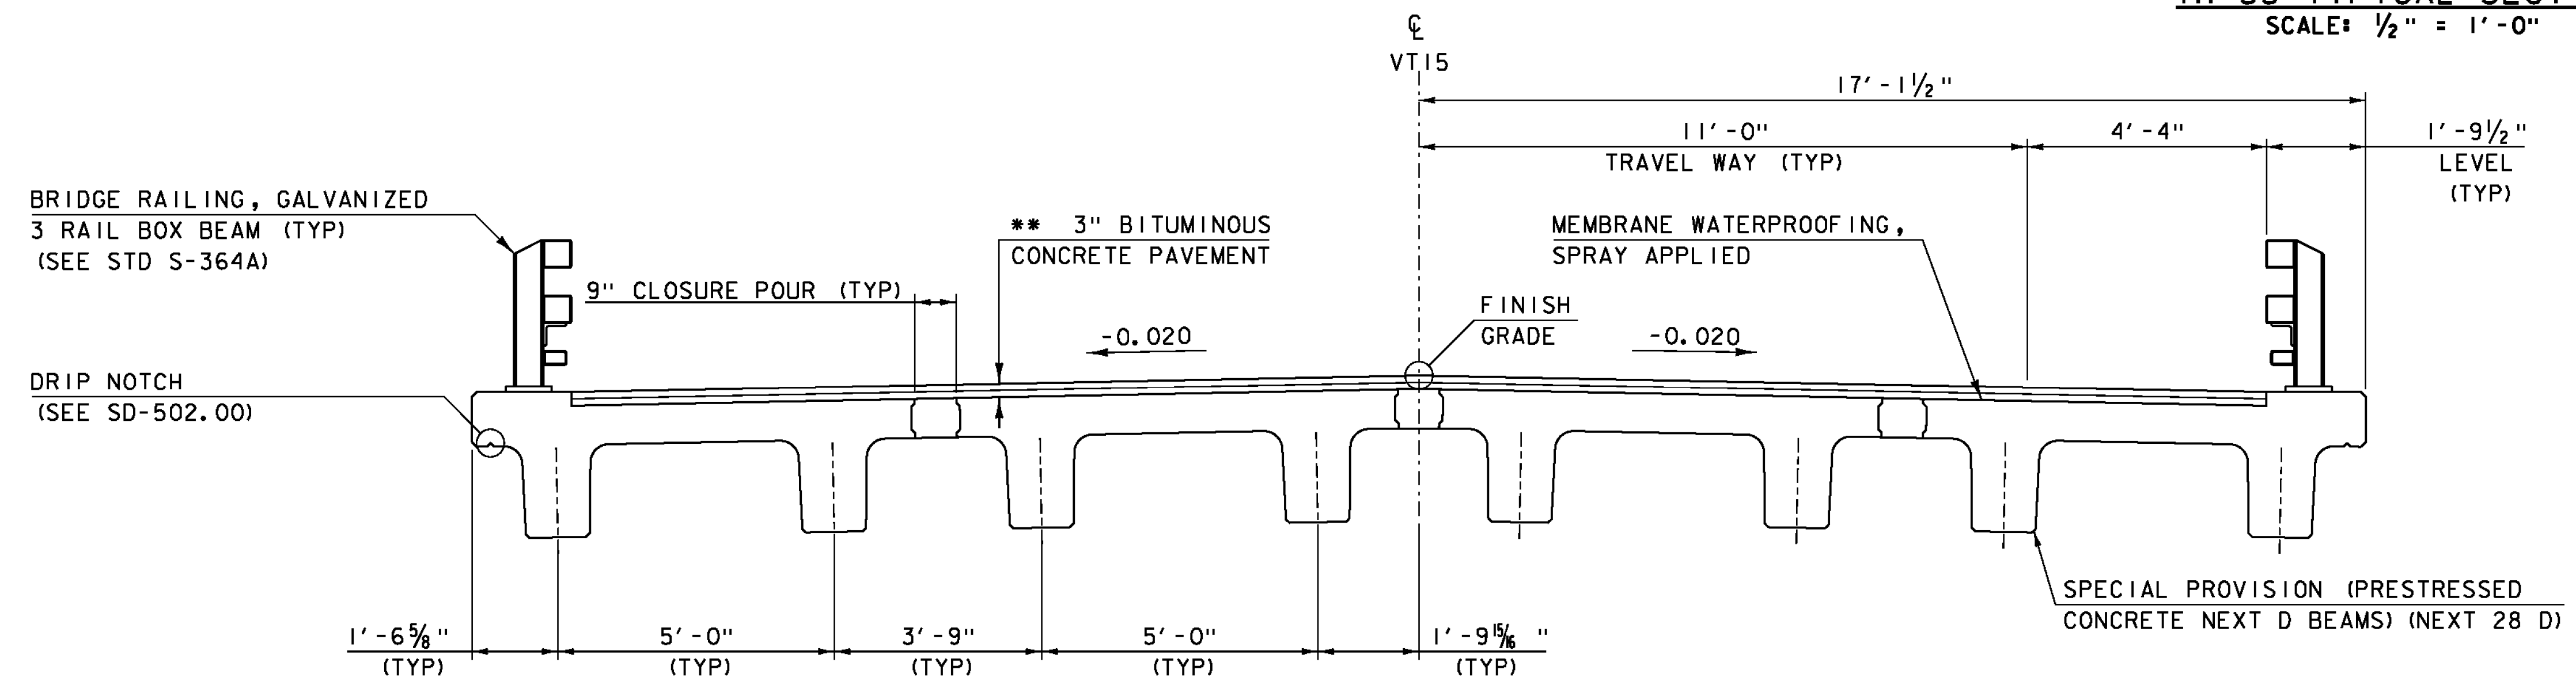

BRIDGE TYPICAL SECTION
SCALE: 1/2" = 1'-0"

** 2 LIFTS OF 1 1/2" BITUM. CONC. PAVEMENT TYPE IVS
PAID UNDER SPECIAL PROVISION (BITUMINOUS CONCRETE
PAVEMENT, SMALL QUANTITY).

MATERIAL TOLERANCES (IF USED ON PROJECT)	
SURFACE	
- PAVEMENT (TOTAL THICKNESS)	+/- 1/4"
- AGGREGATE SURFACE COURSE	+/- 1/2"
SUBBASE	
SAND BORROW	+/- 1"

BUILT AS DESIGNED

PROJECT NAME:	WALDEN	PLOT DATE:	19-DEC-2014
PROJECT NUMBER:	BRF 030-3(5)	DRAWN BY:	R. PELLETT
FILE NAME:	s09b308-1typ.dgn	DESIGNED BY:	H. SALLS
PROJECT LEADER:	C. CARLSON	CHECKED BY:	H. SALLS
TYPICAL SECTIONS 1		SHEET	3 OF 56