



WINGWALL #1 ELEVATION

SCALE: 1/4" = 1'-0"

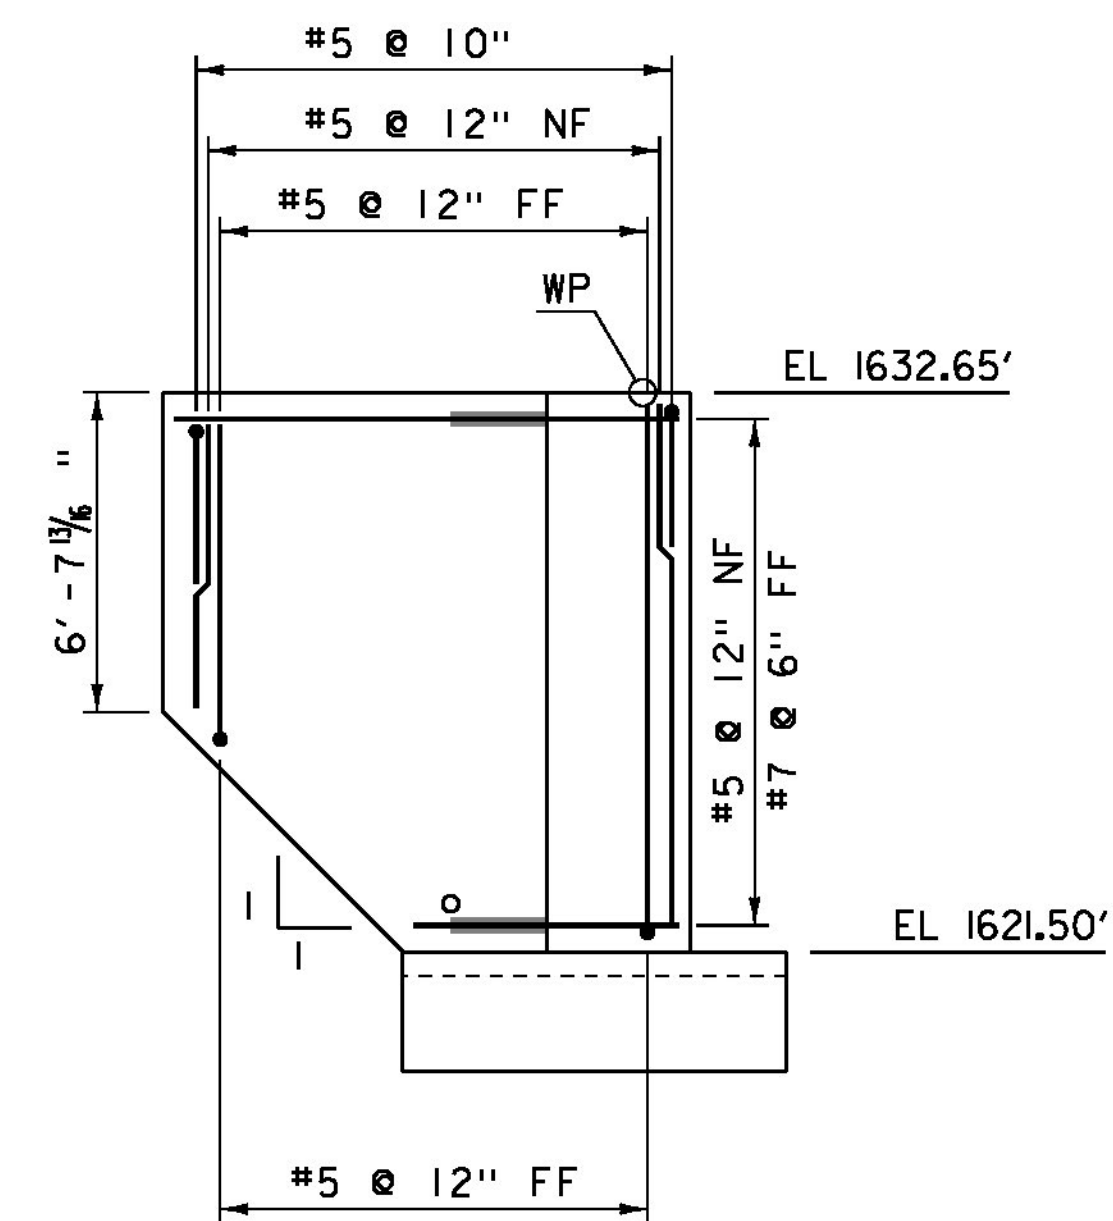


WINGWALL #2 ELEVATION

SCALE: 1/4" = 1'-0"

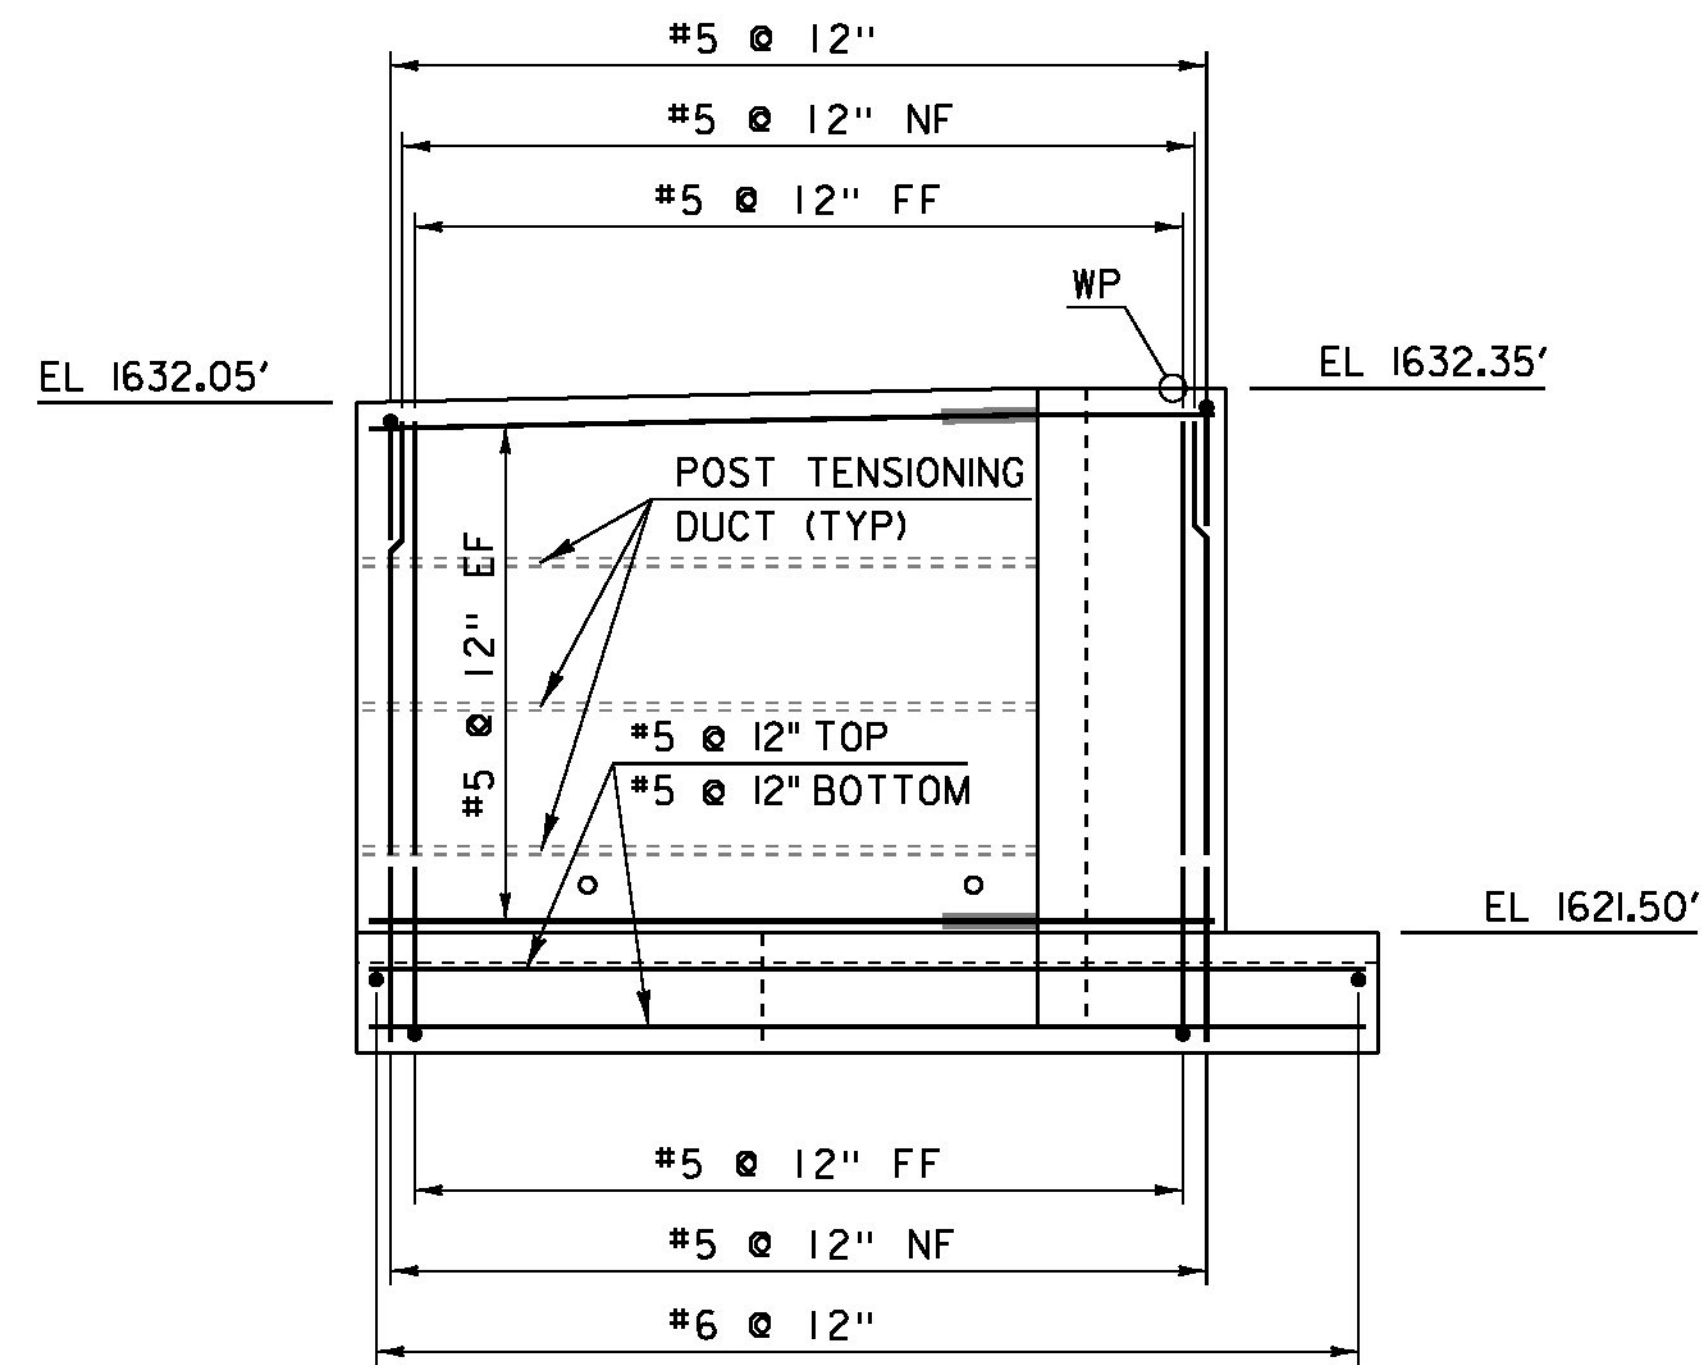

WINGWALL #3 ELEVATION

SCALE: 1/4" = 1'-0"

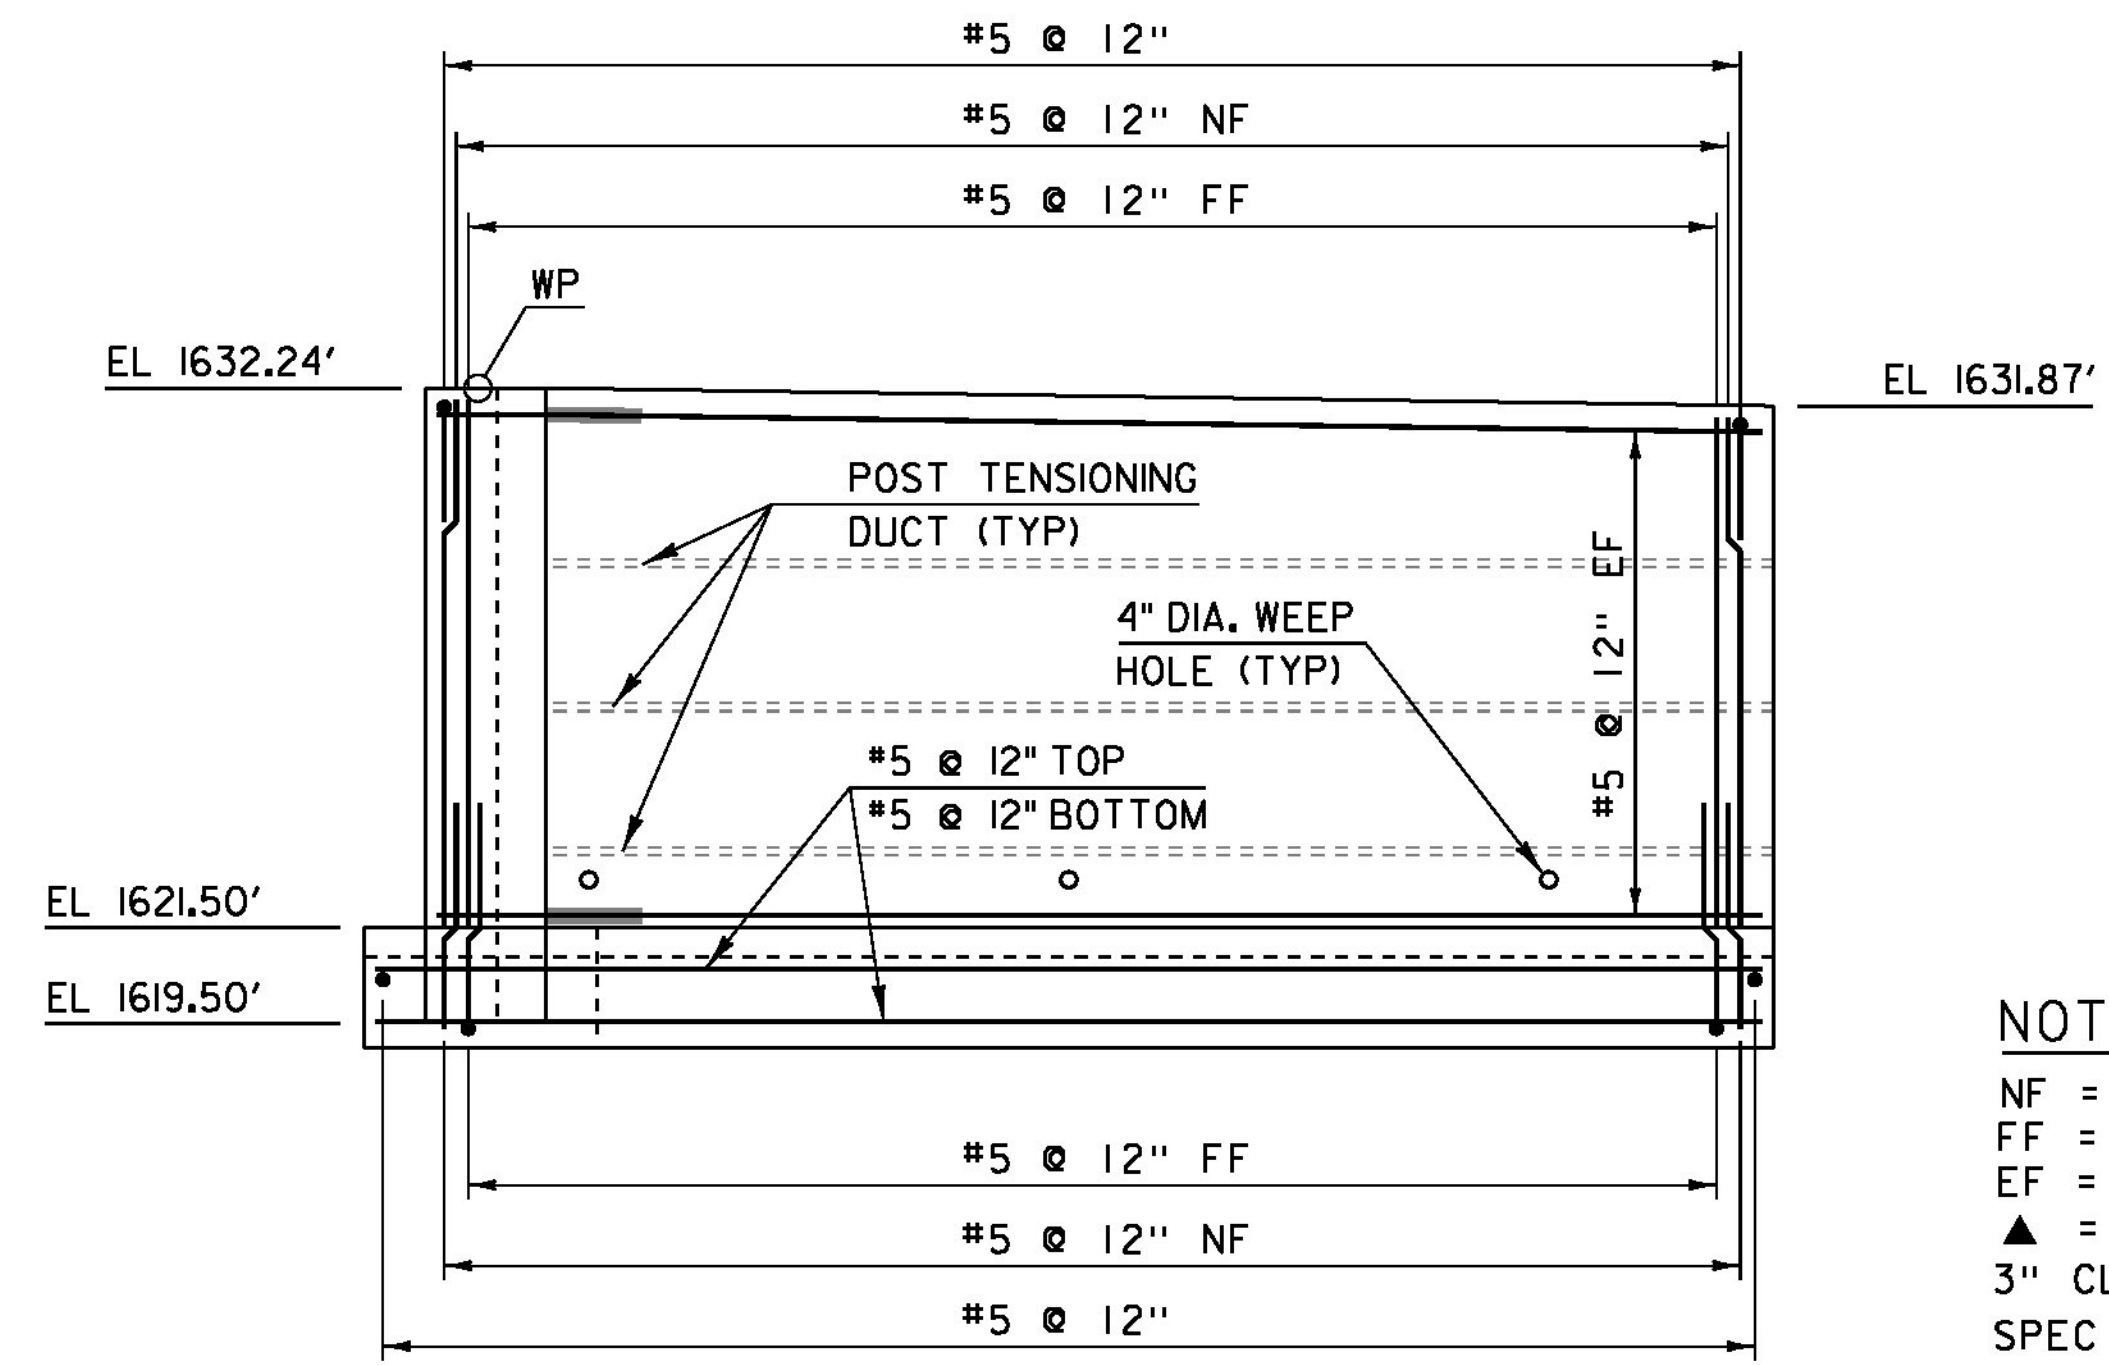

WINGWALL #4 ELEVATION

SCALE: 1/4" = 1'-0"

NOTE:

- NF = NEAR FACE
- FF = FAR FACE
- EF = EACH FACE
- ▲ = CUT TO FIT IN FIELD
- 3" CLEAR, UNLESS OTHERWISE SPECIFIED ON THE PLANS.
- 2' - 2" BAR LAP UNLESS OTHERWISE SPECIFIED ON THE PLANS.

PROJECT NAME: WALDEN
PROJECT NUMBER: BRF 030-3(5)

FILE NAME: s09b308_sub.dgn
PROJECT LEADER: C. CARLSON
DESIGNED BY: H. SALLS
WINGWALL ELEVATIONS

PLOT DATE: 05-DEC-2014
DRAWN BY: R. PELLETT
CHECKED BY: H. SALLS
SHEET 35 OF 56