




270+75

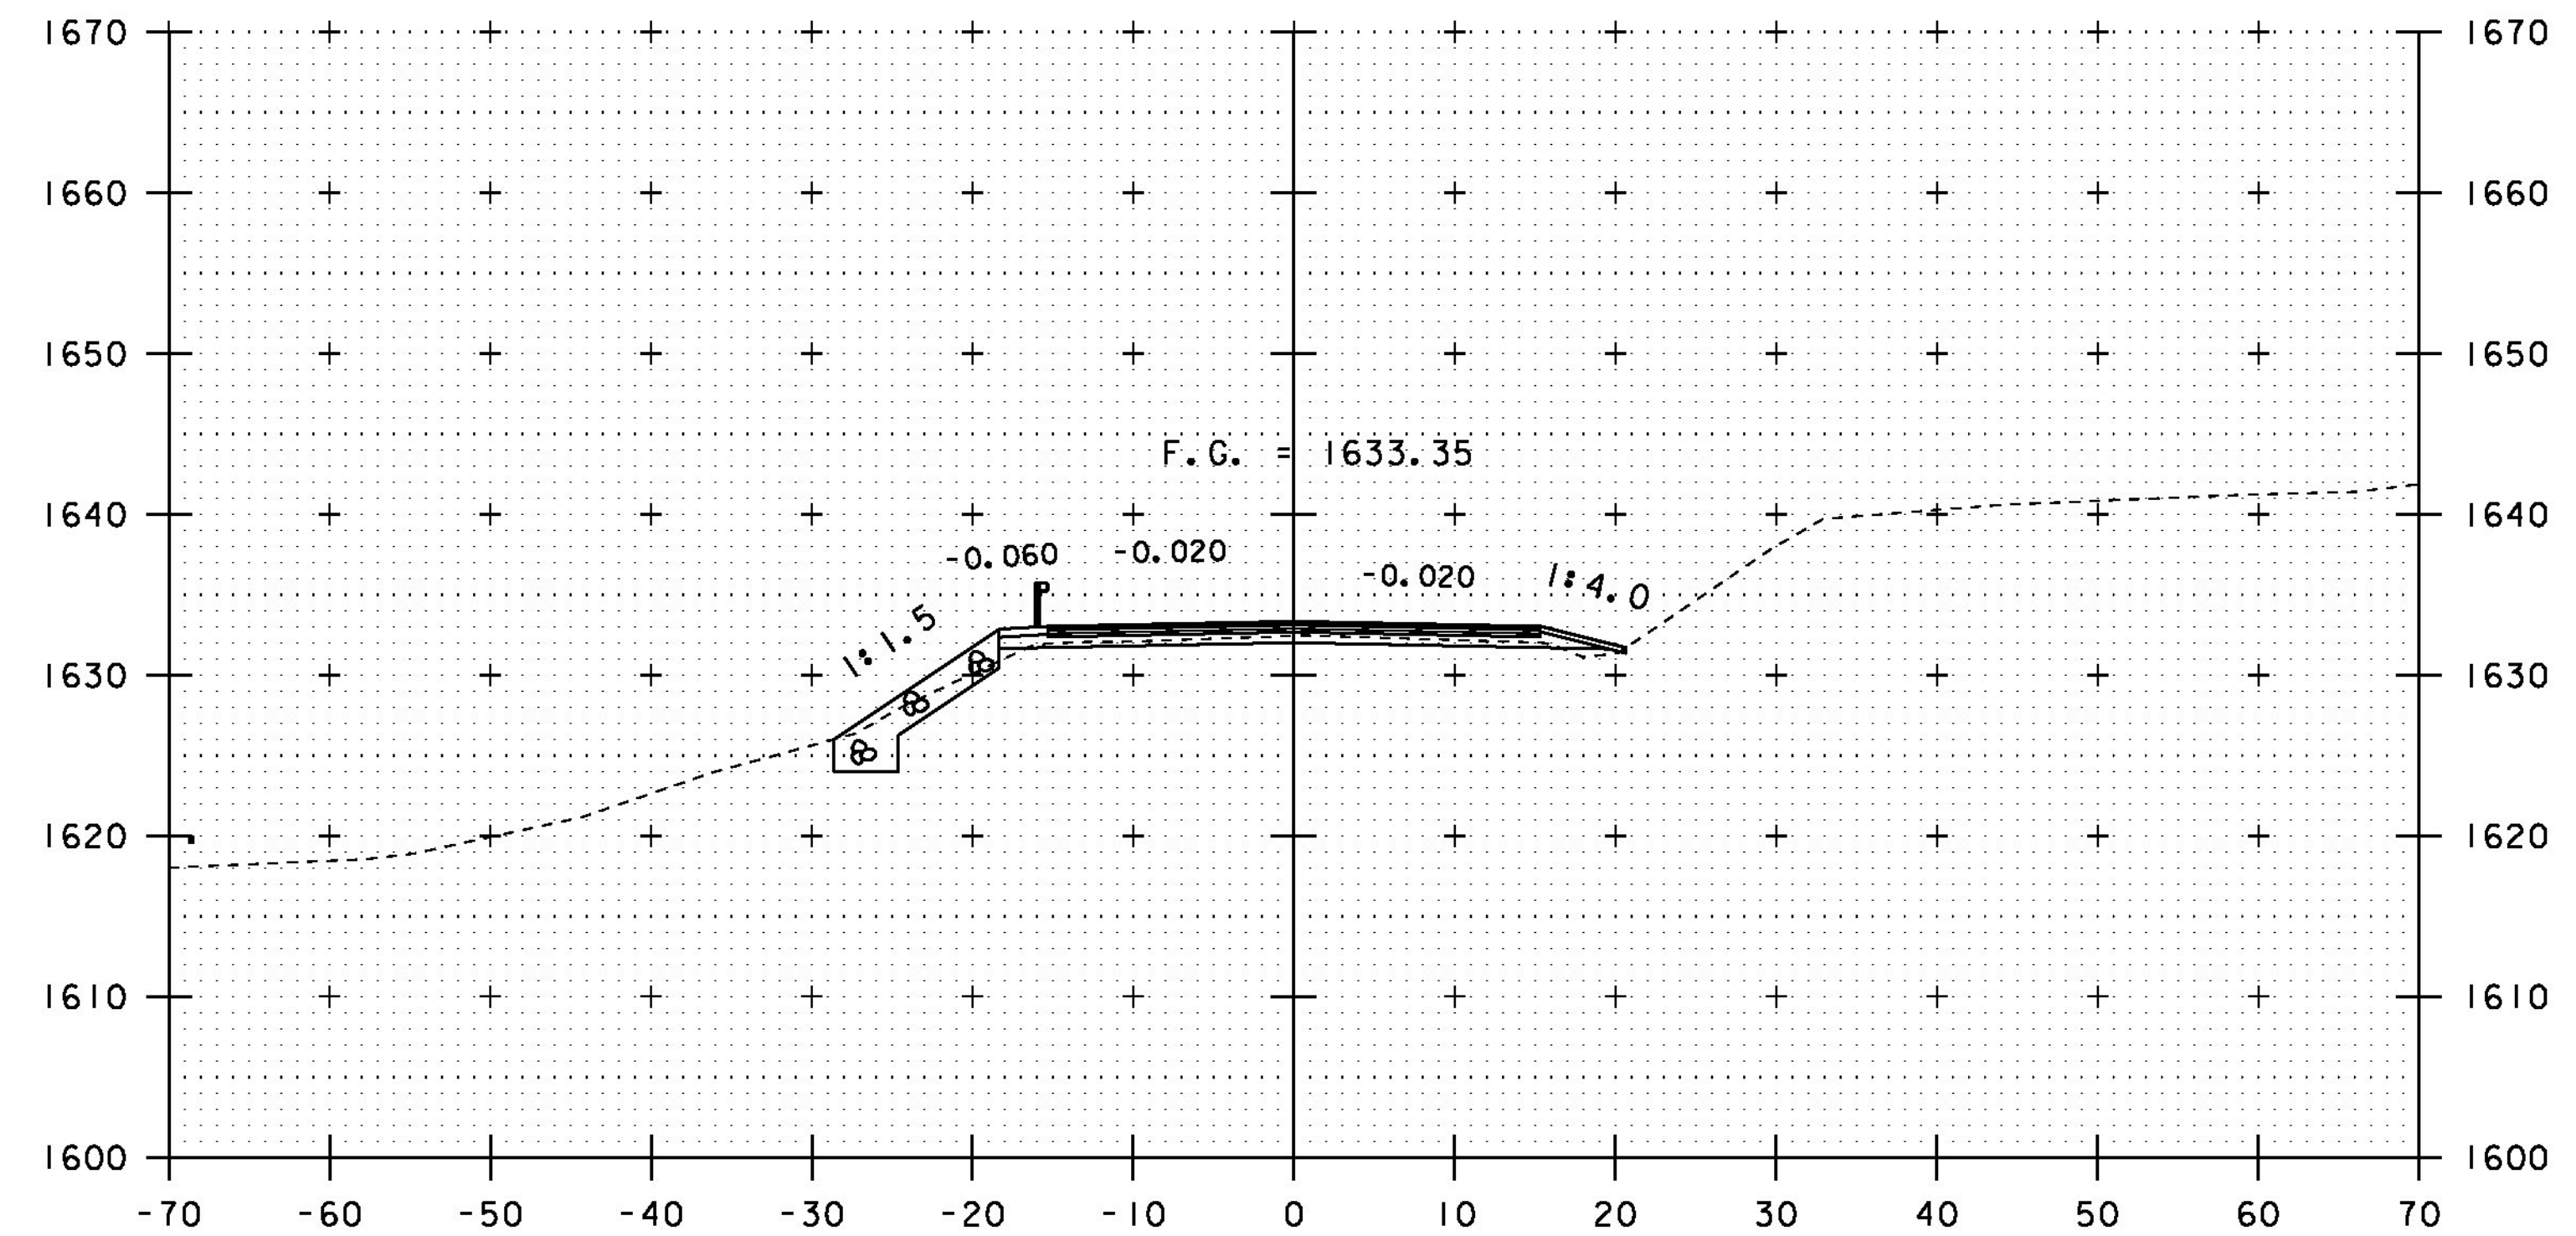

271+25

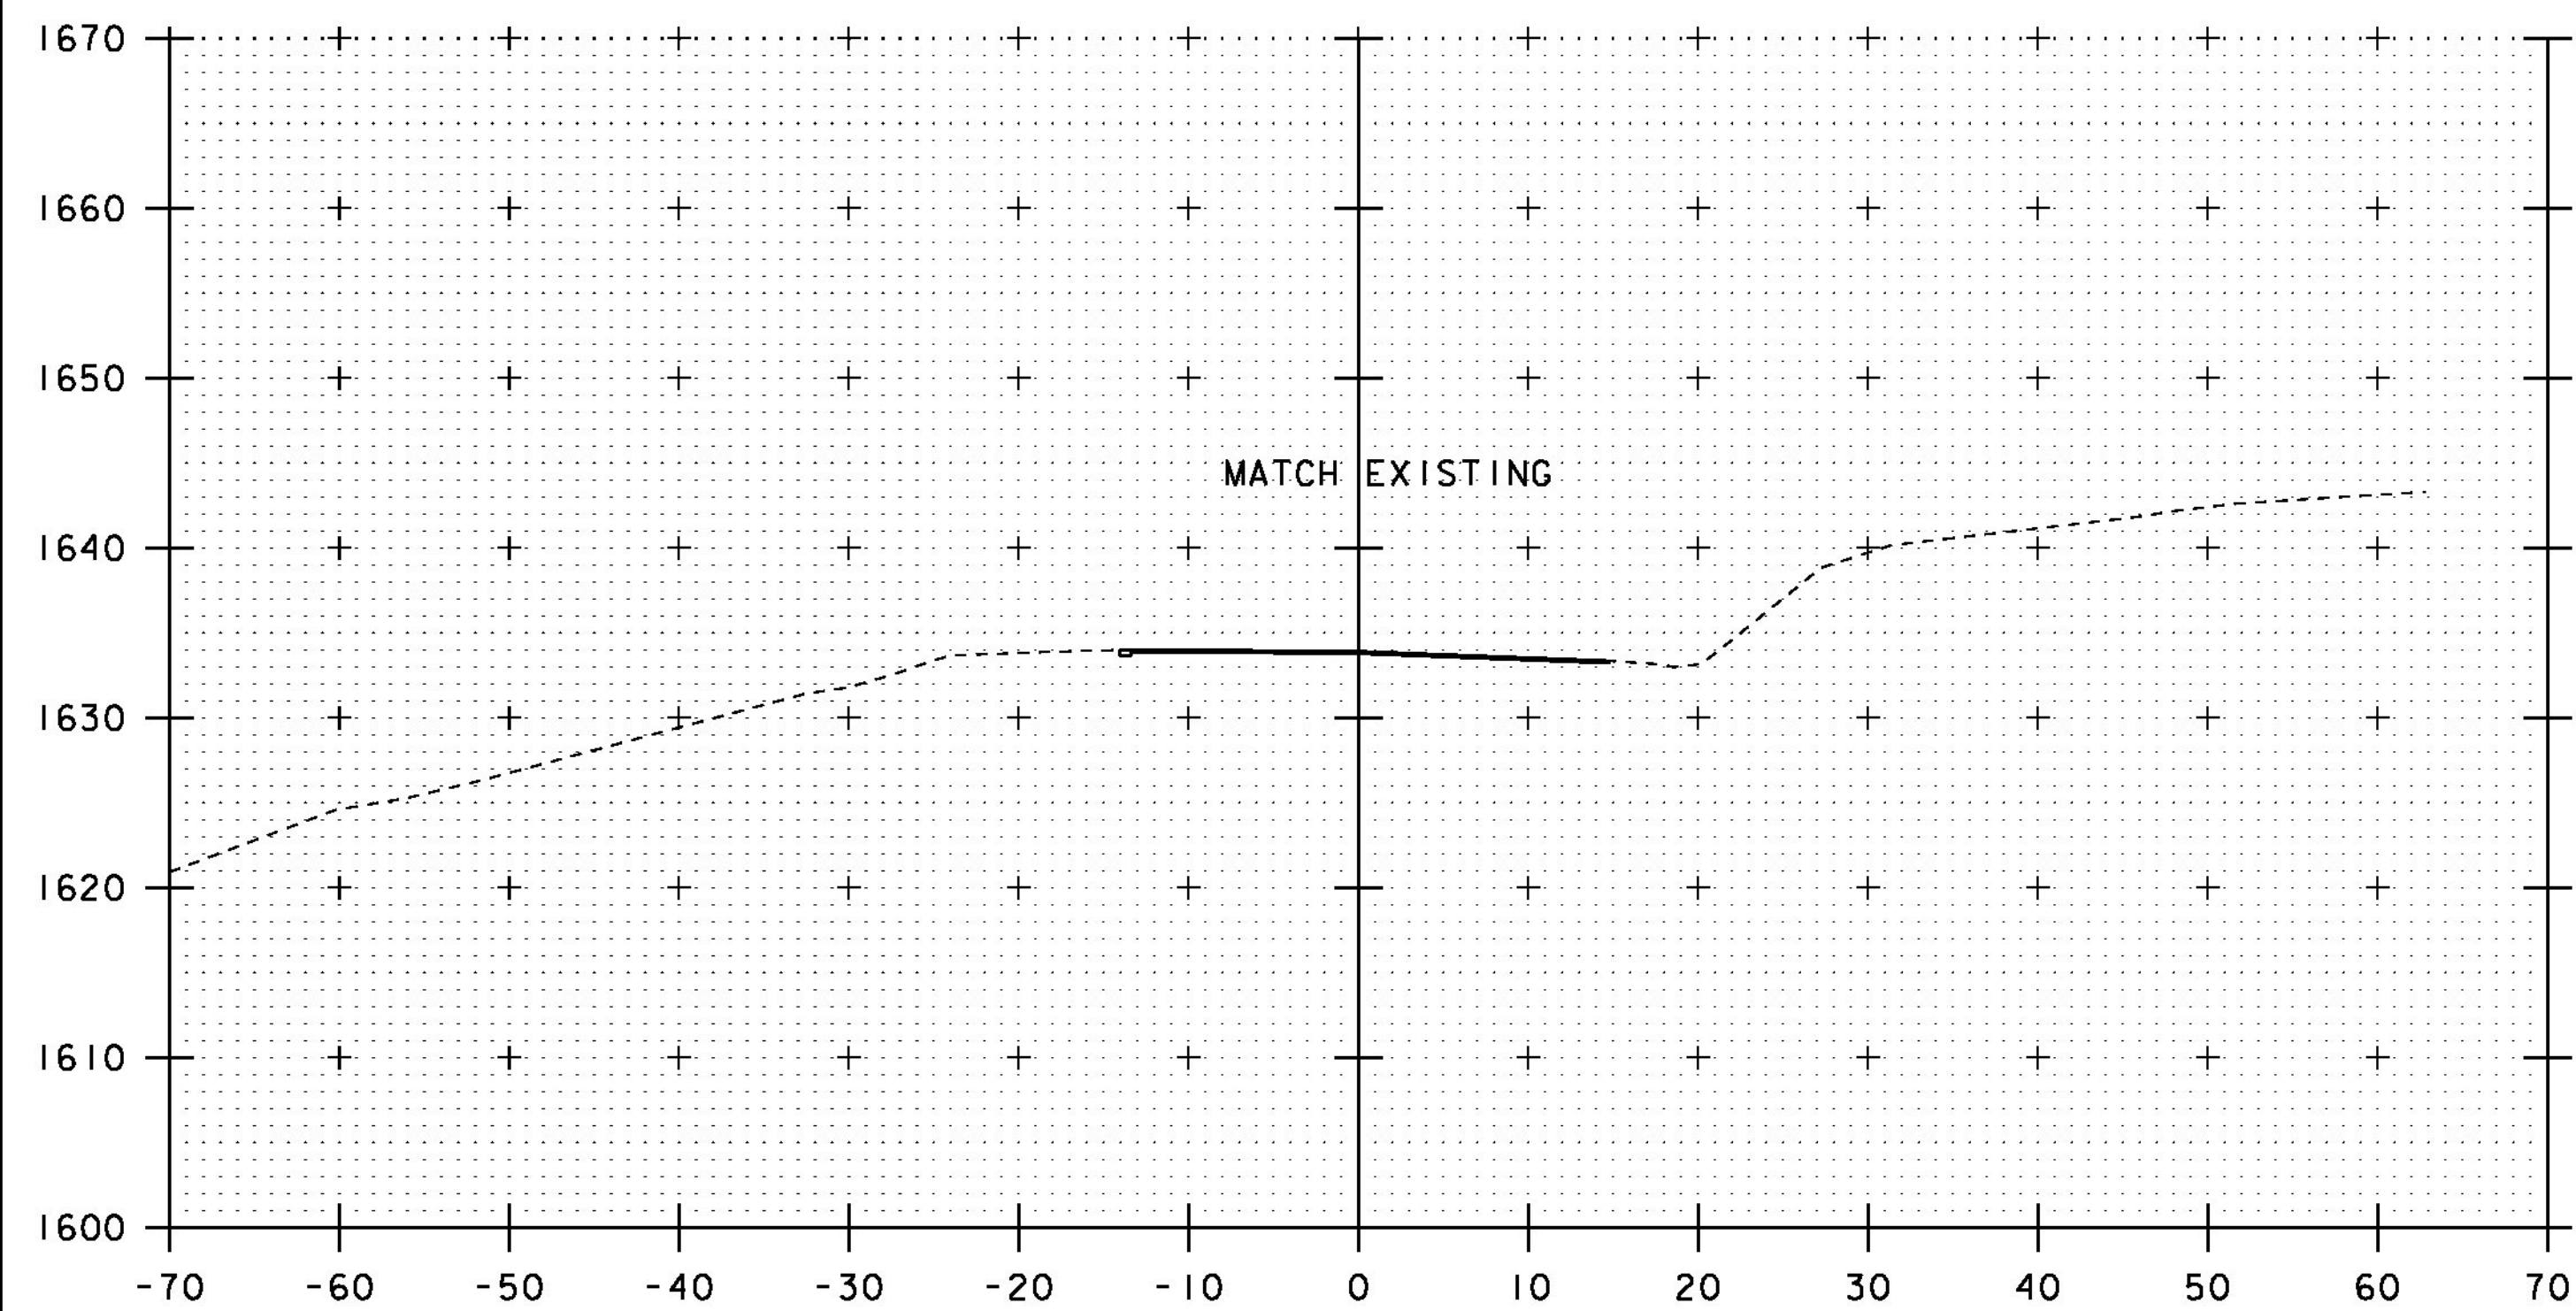

270+50
BEGIN APPROACH

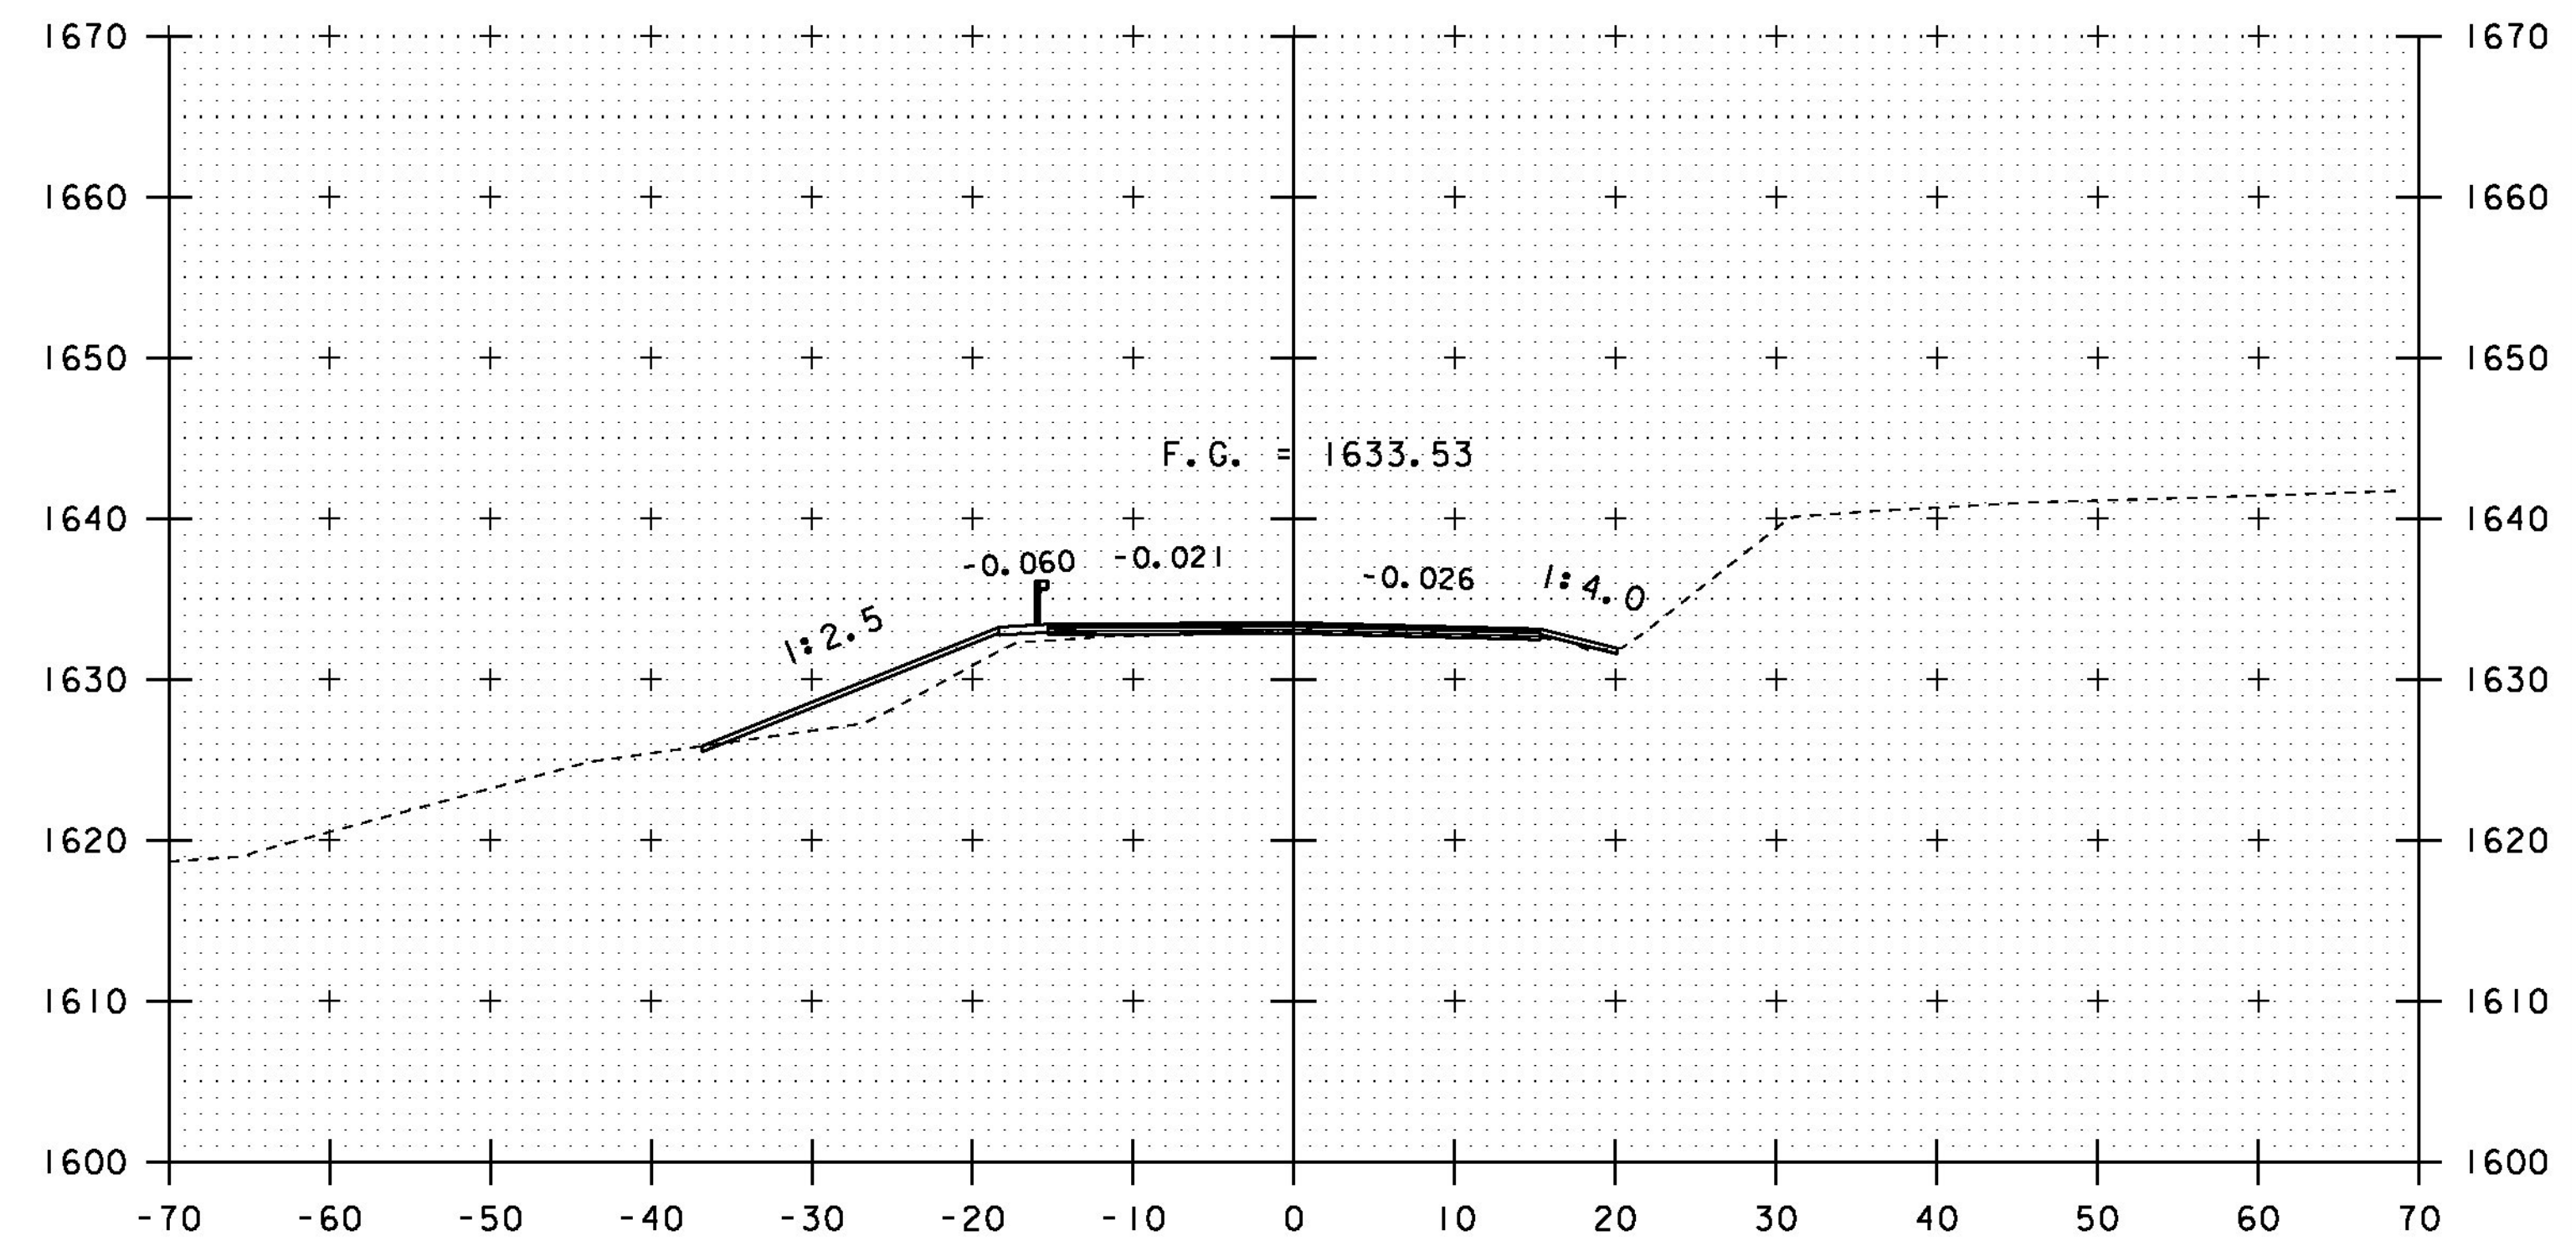

271+00
BEGIN PROJECT

SCALE 1" = 10'-0"
10 0 10

STA. 270+50 TO STA. 271+25

PROJECT NAME: WALDEN	PLOT DATE: 30-DEC-2014
PROJECT NUMBER: BRF 030-3(5)	DRAWN BY: R. PELLET
FILE NAME: s09b308_xsl.dgn	CHECKED BY: H. SALLS
PROJECT LEADER: C. CARLSON	SHEET 37 OF 56
DESIGNED BY: H. SALLS	
ROADWAY CROSS SECTIONS 1	