




750+15.33

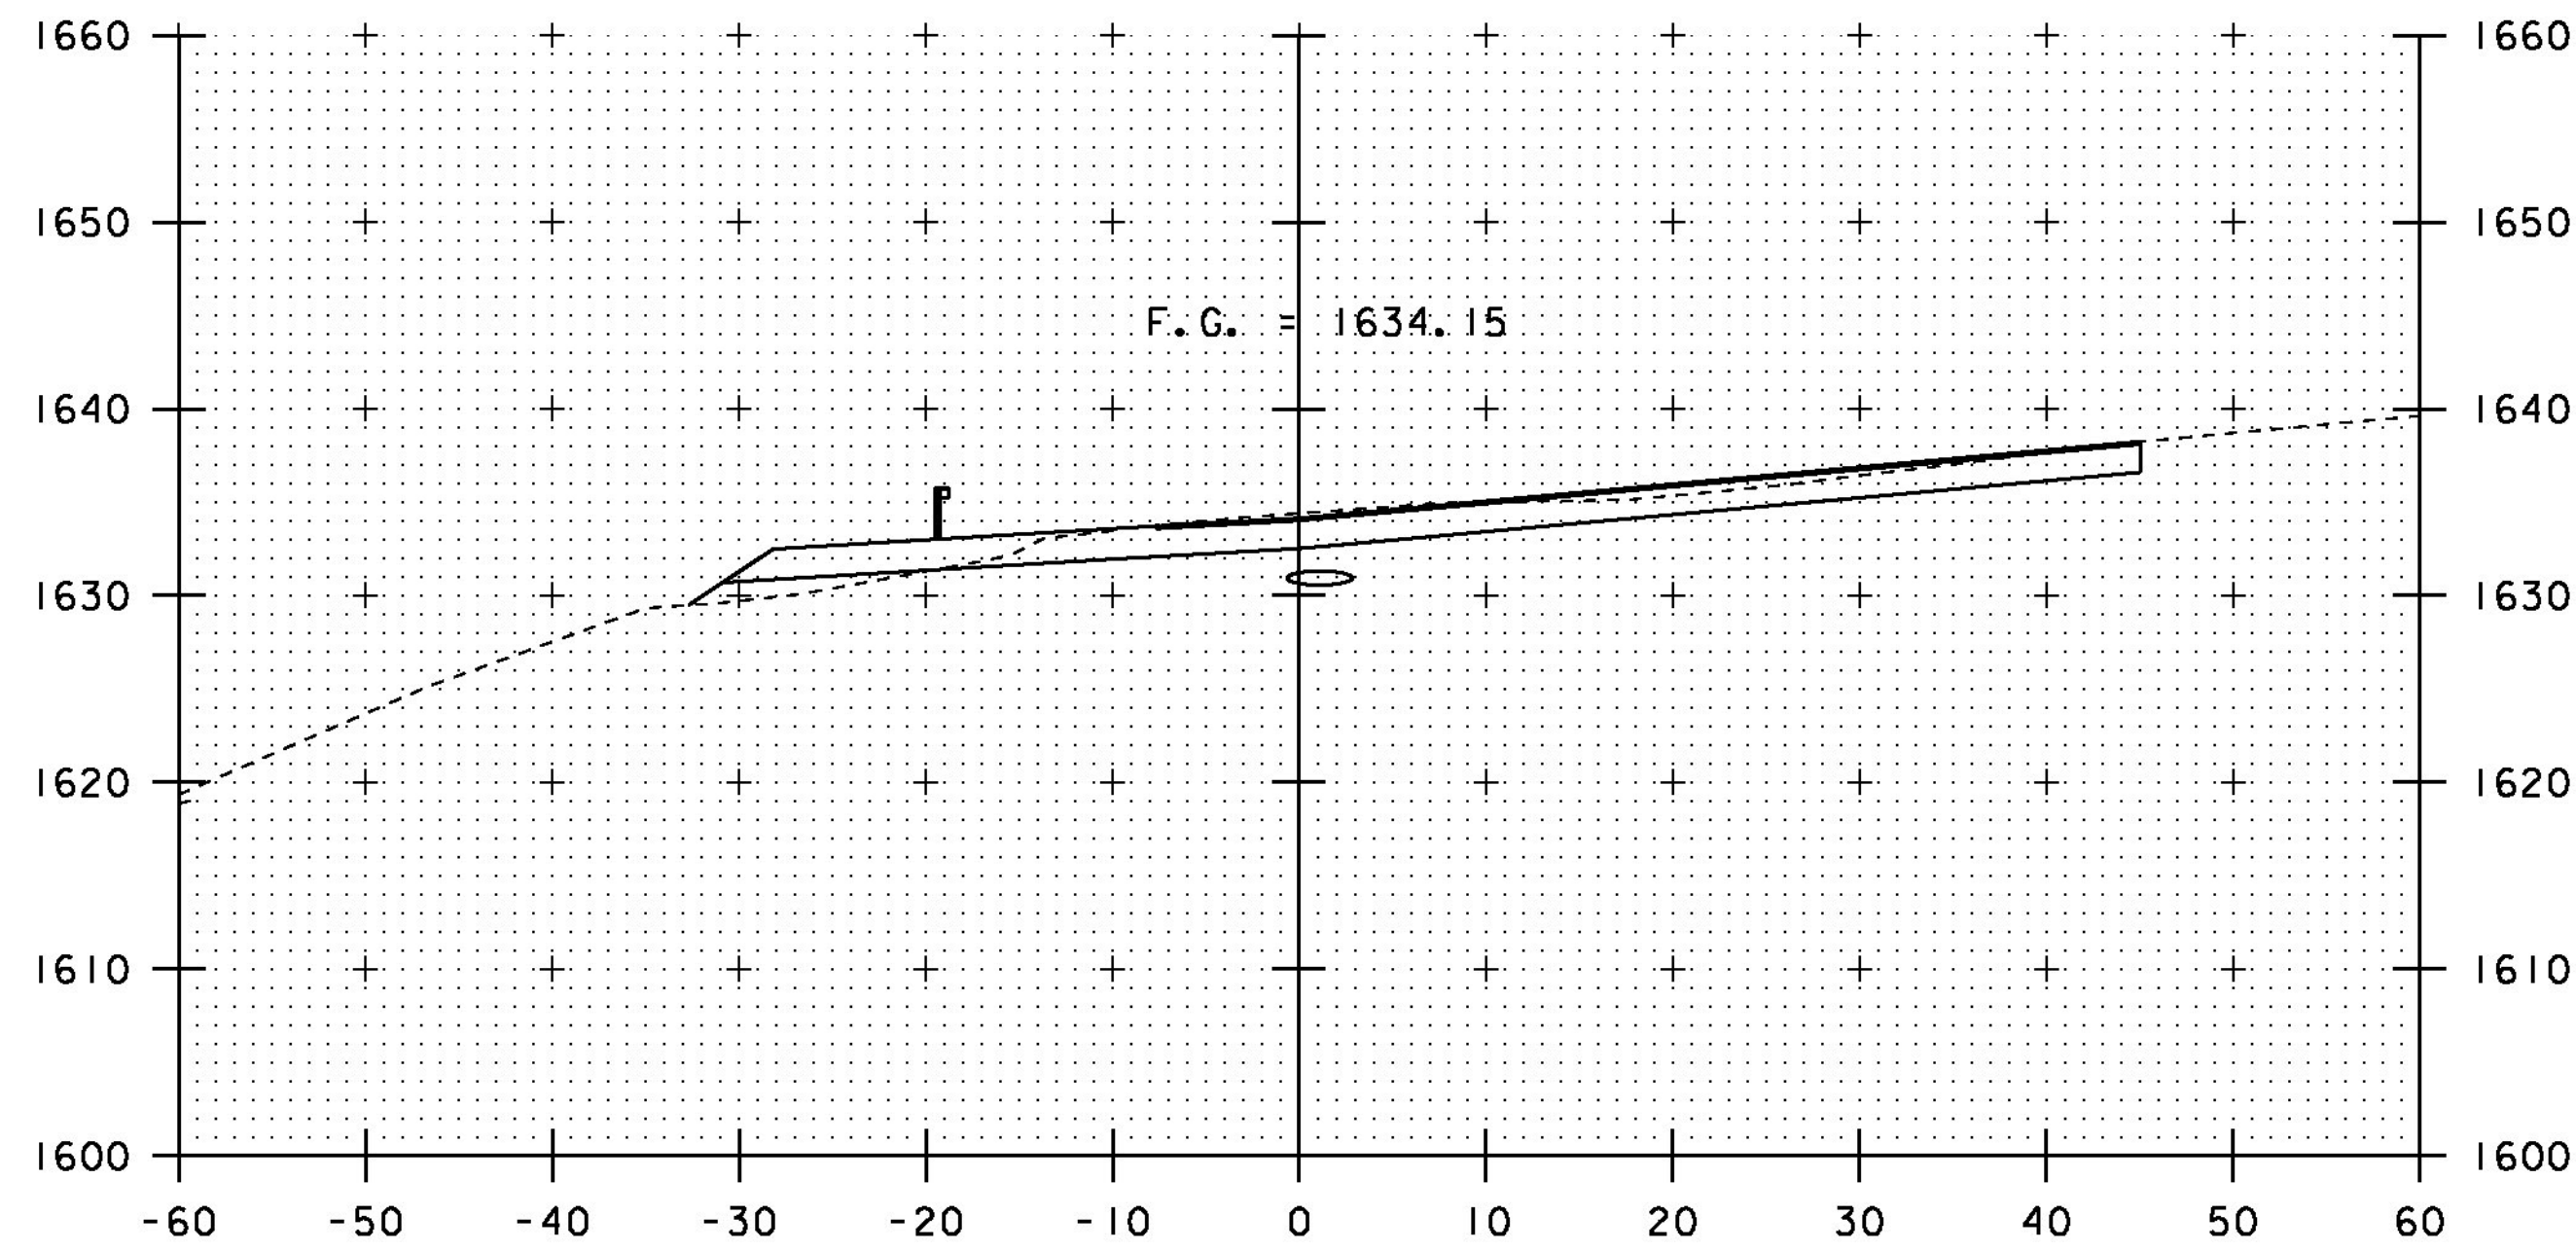

750+50

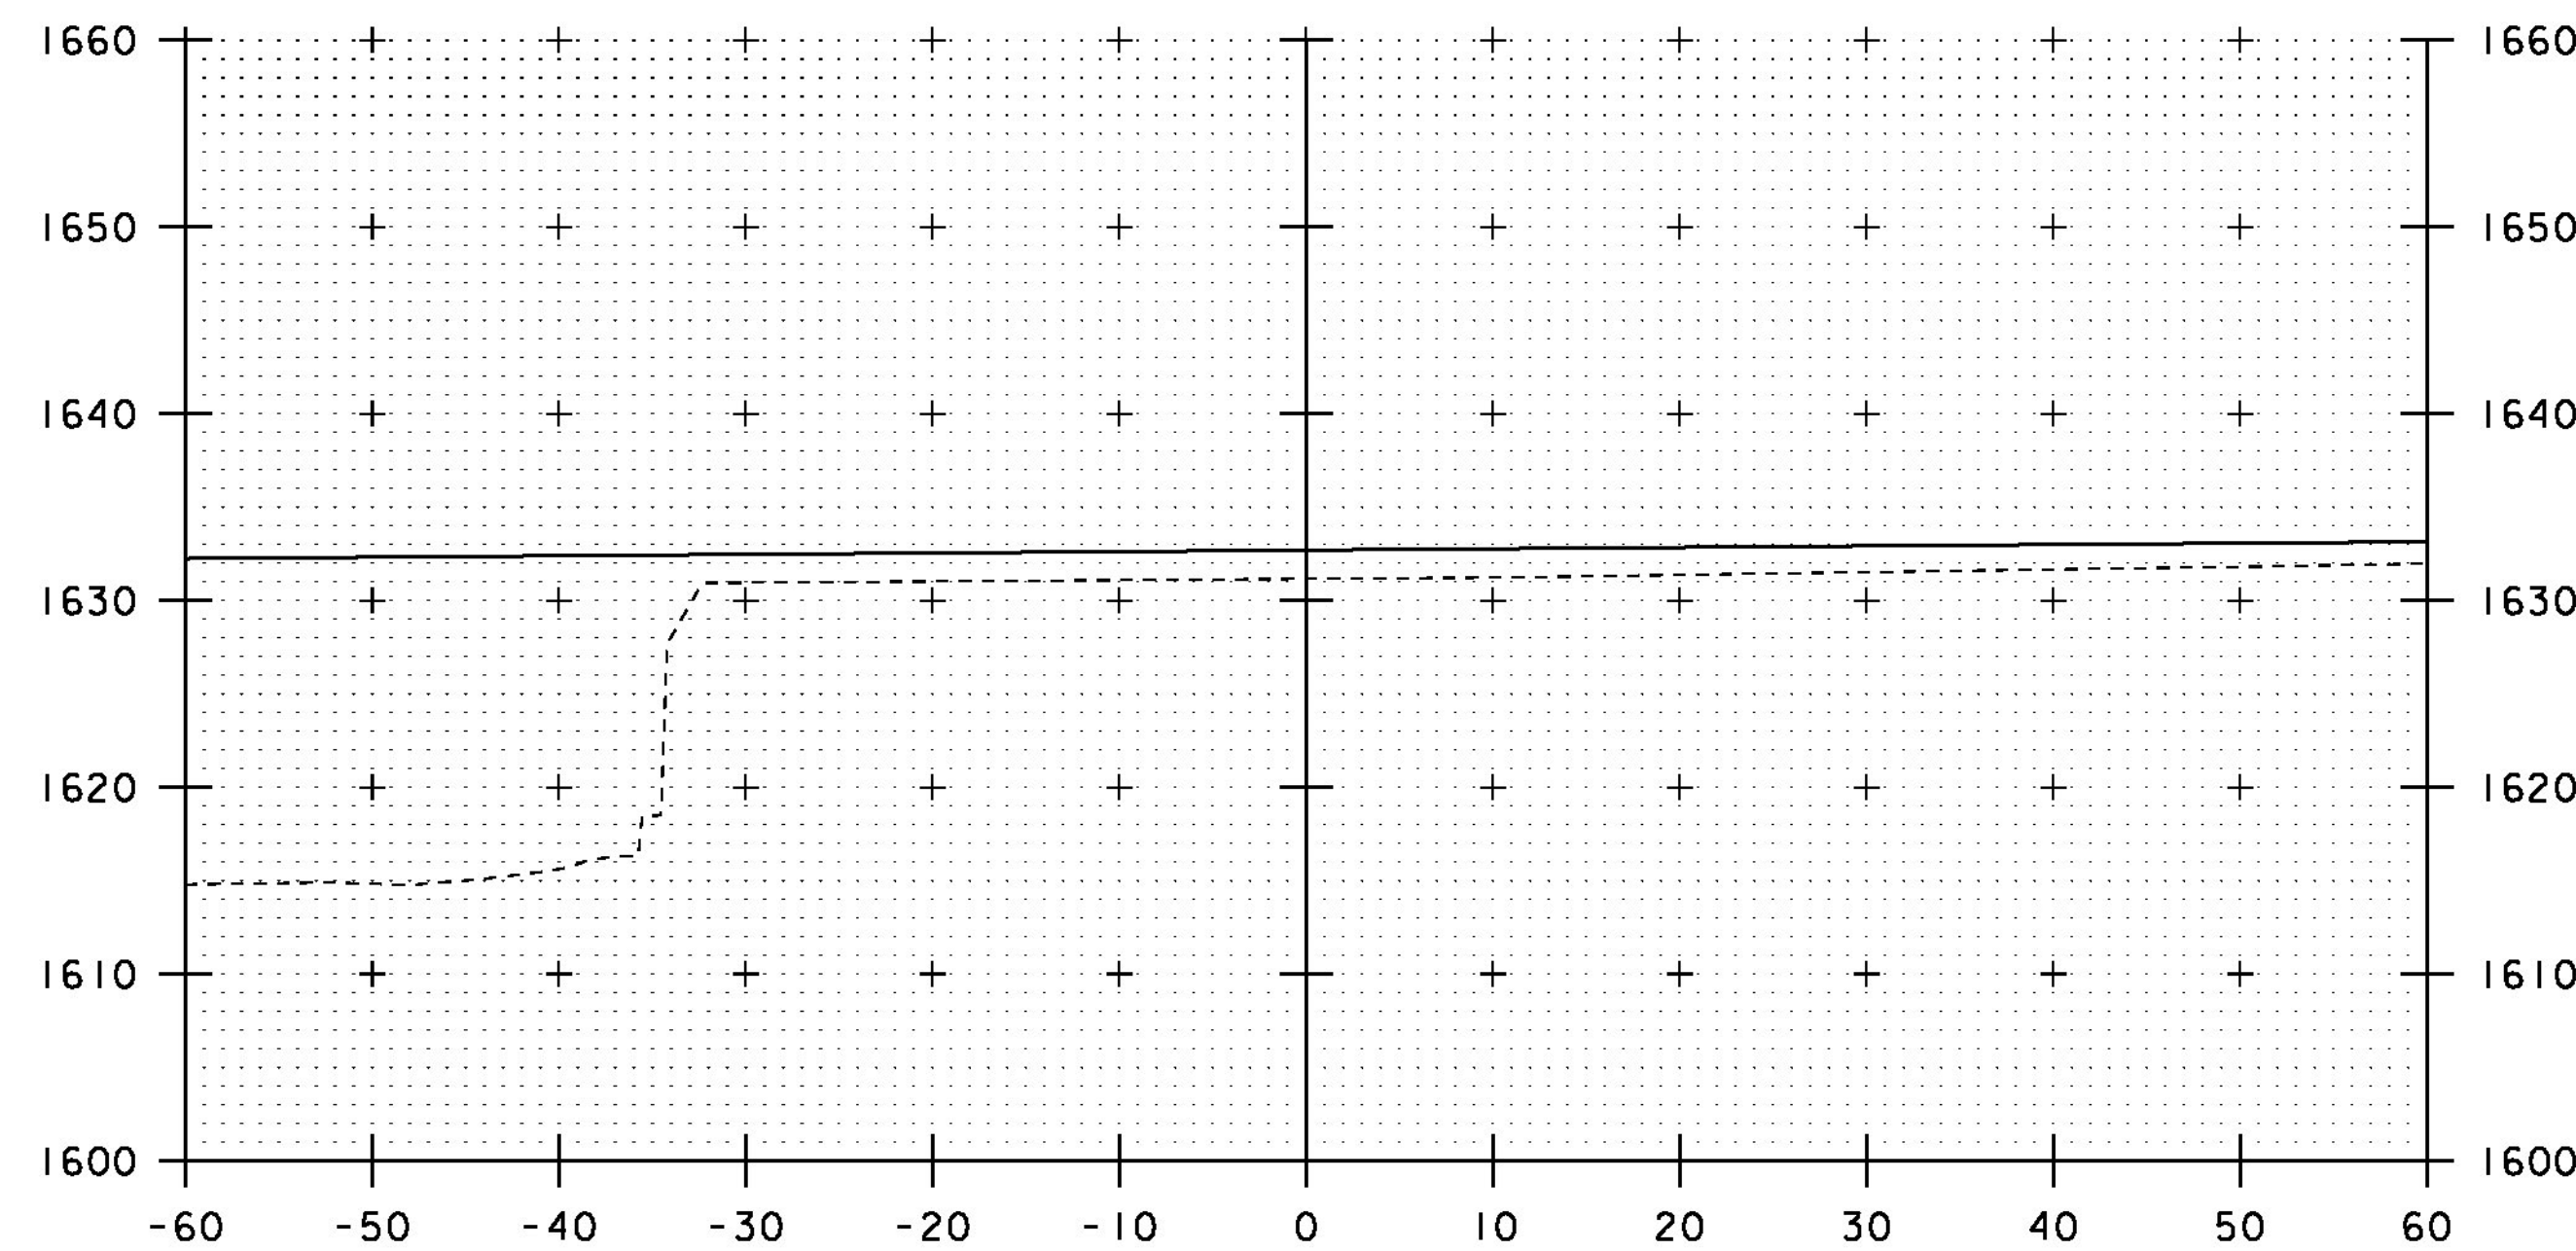

750+00
= VT 15 STA. 272+12.00

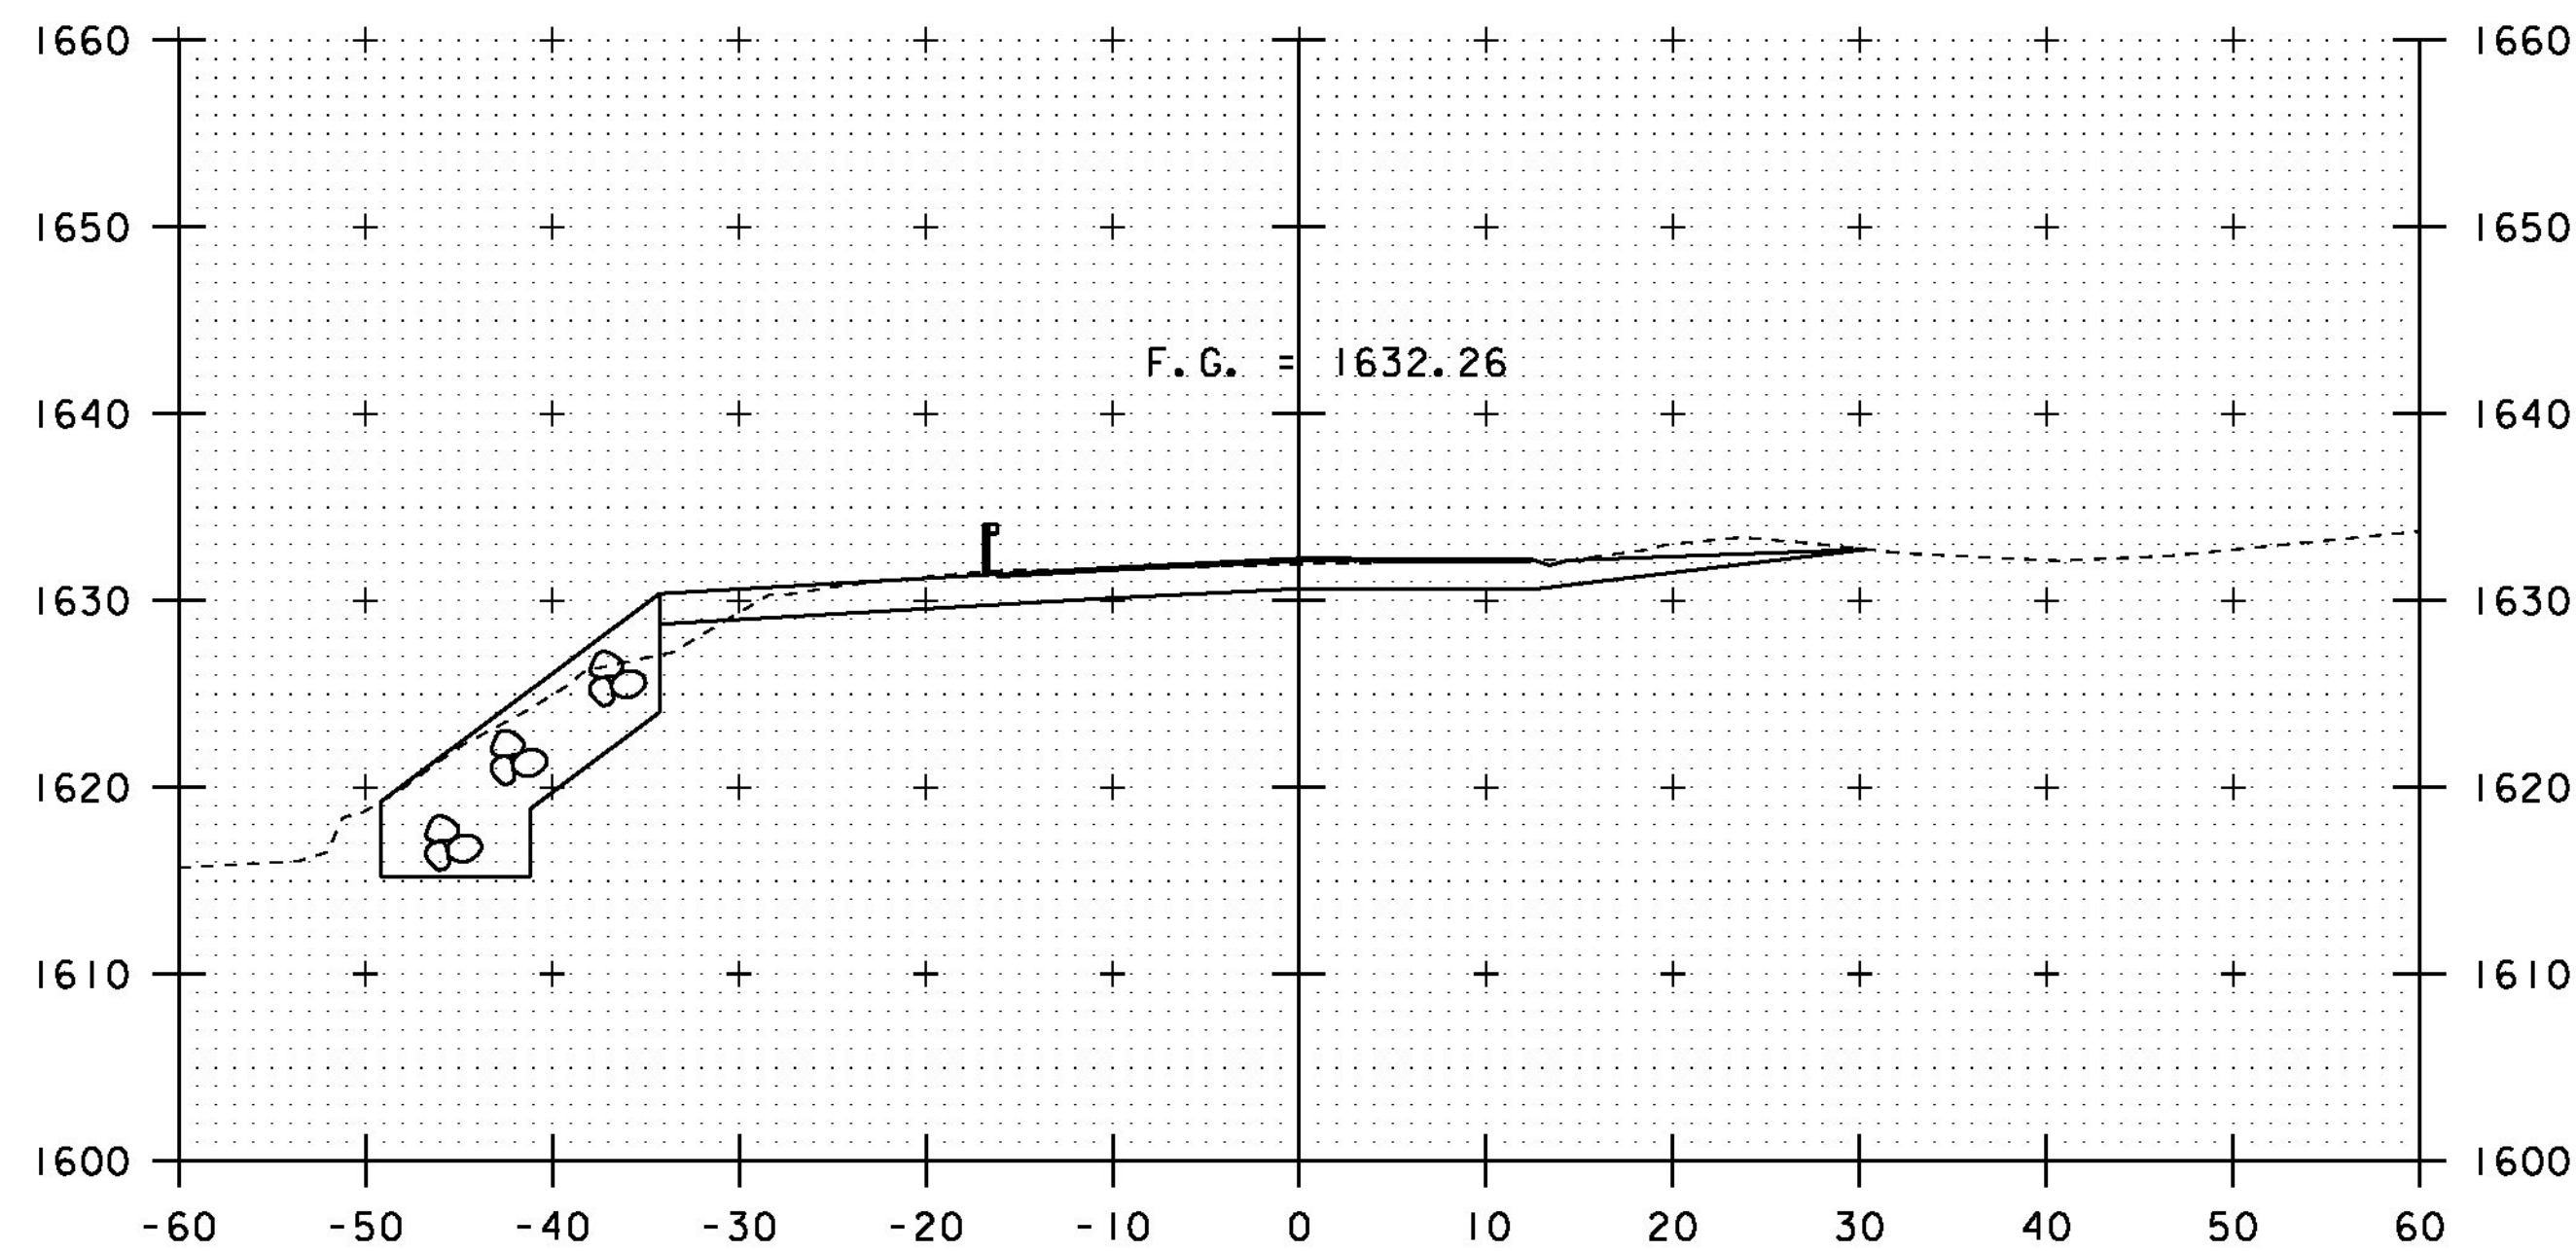

750+25

STA 750+15.33 RT
CONSTRUCT TH 55

SCALE 1" = 10'-0"
10 0 10

STA. 750+00 TO STA. 750+50

PROJECT NAME: WALDEN
PROJECT NUMBER: BRF 030-3(5)

FILE NAME: s09b308_xsl.dgn
PROJECT LEADER: C. CARLSON
DESIGNED BY: H. SALLS
TH CROSS SECTIONS 1

PLOT DATE: 30-DEC-2014
DRAWN BY: R. PELLETT
CHECKED BY: H. SALLS
SHEET 43 OF 56