




501+30

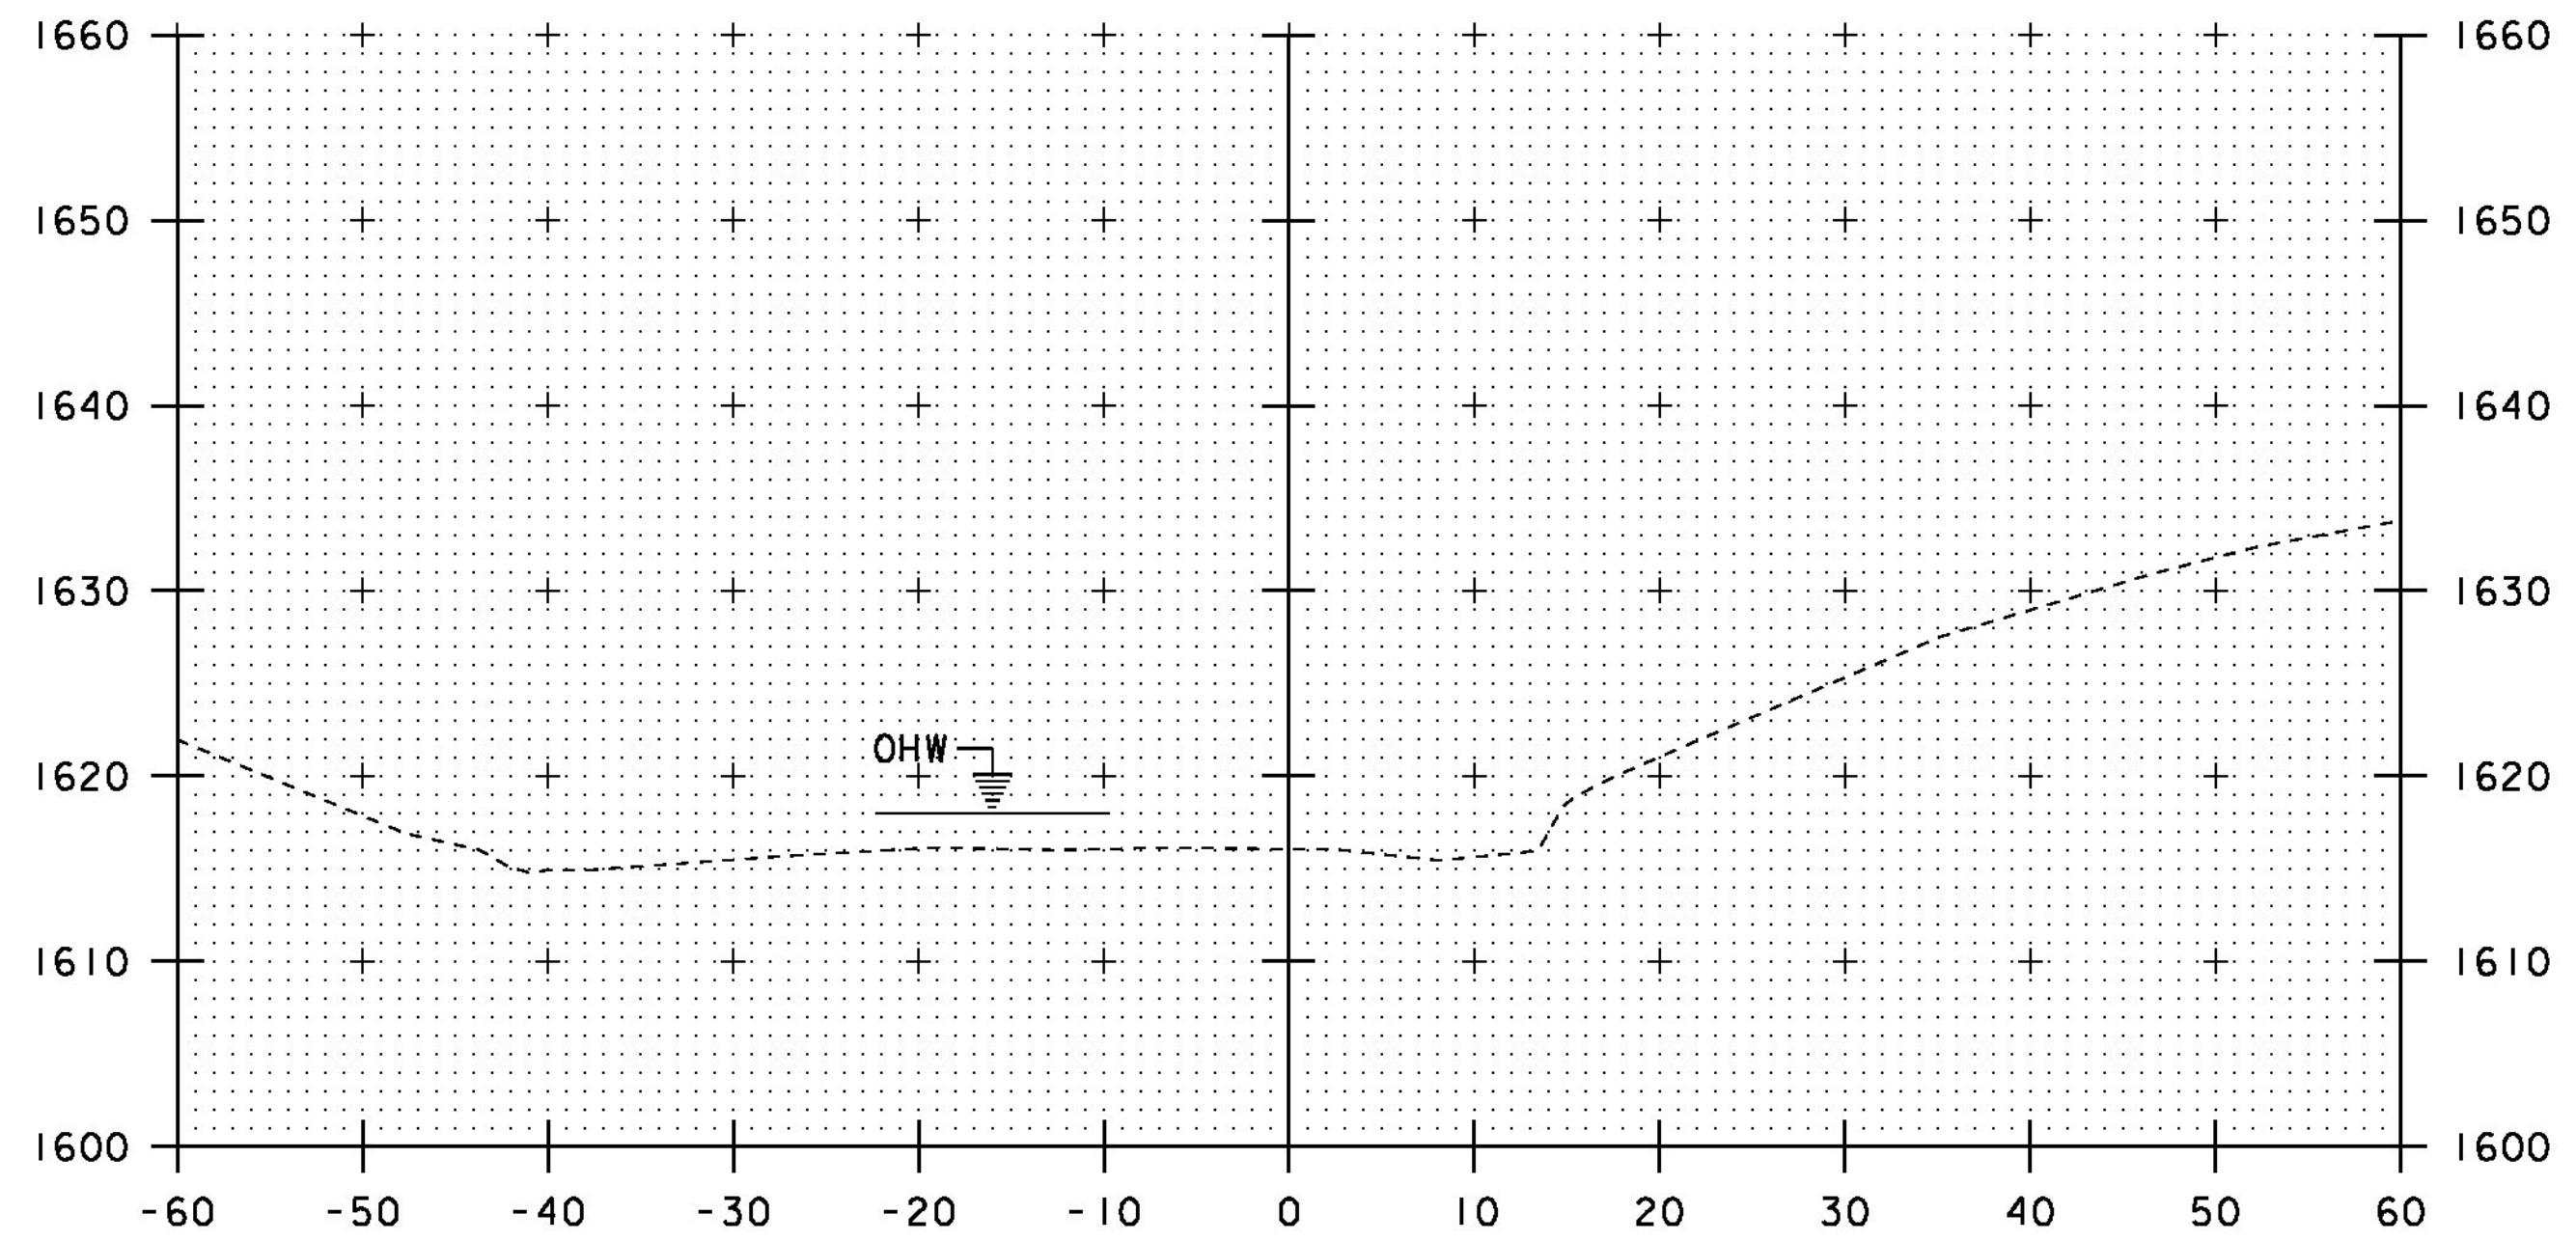

501+50

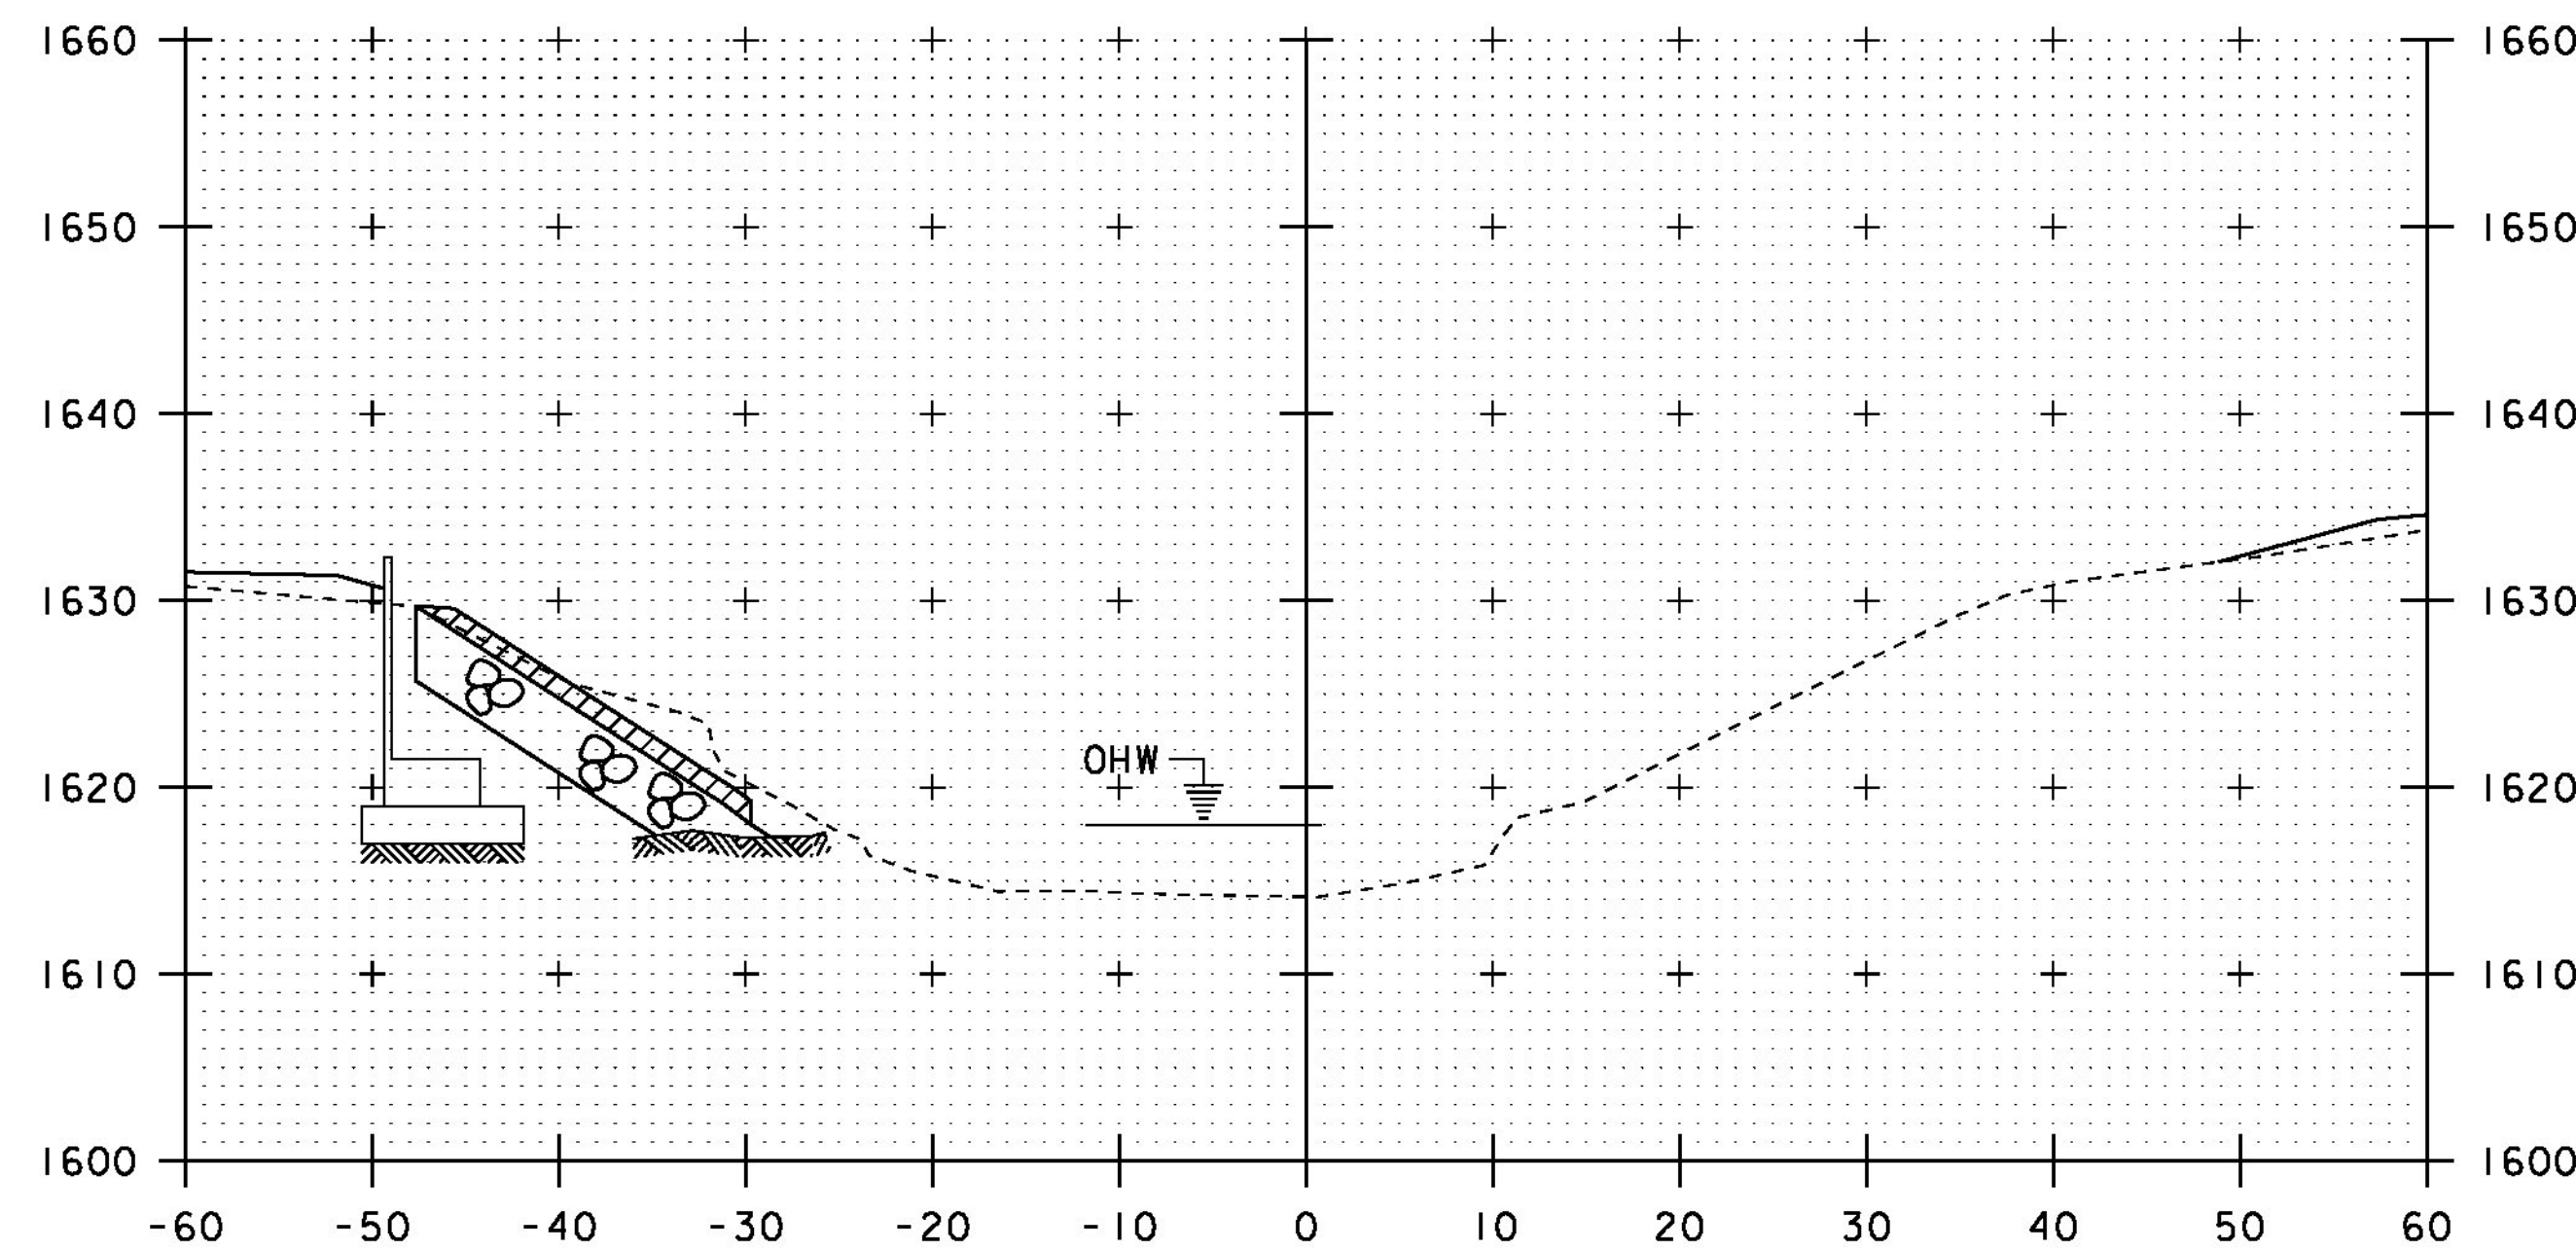

501+20

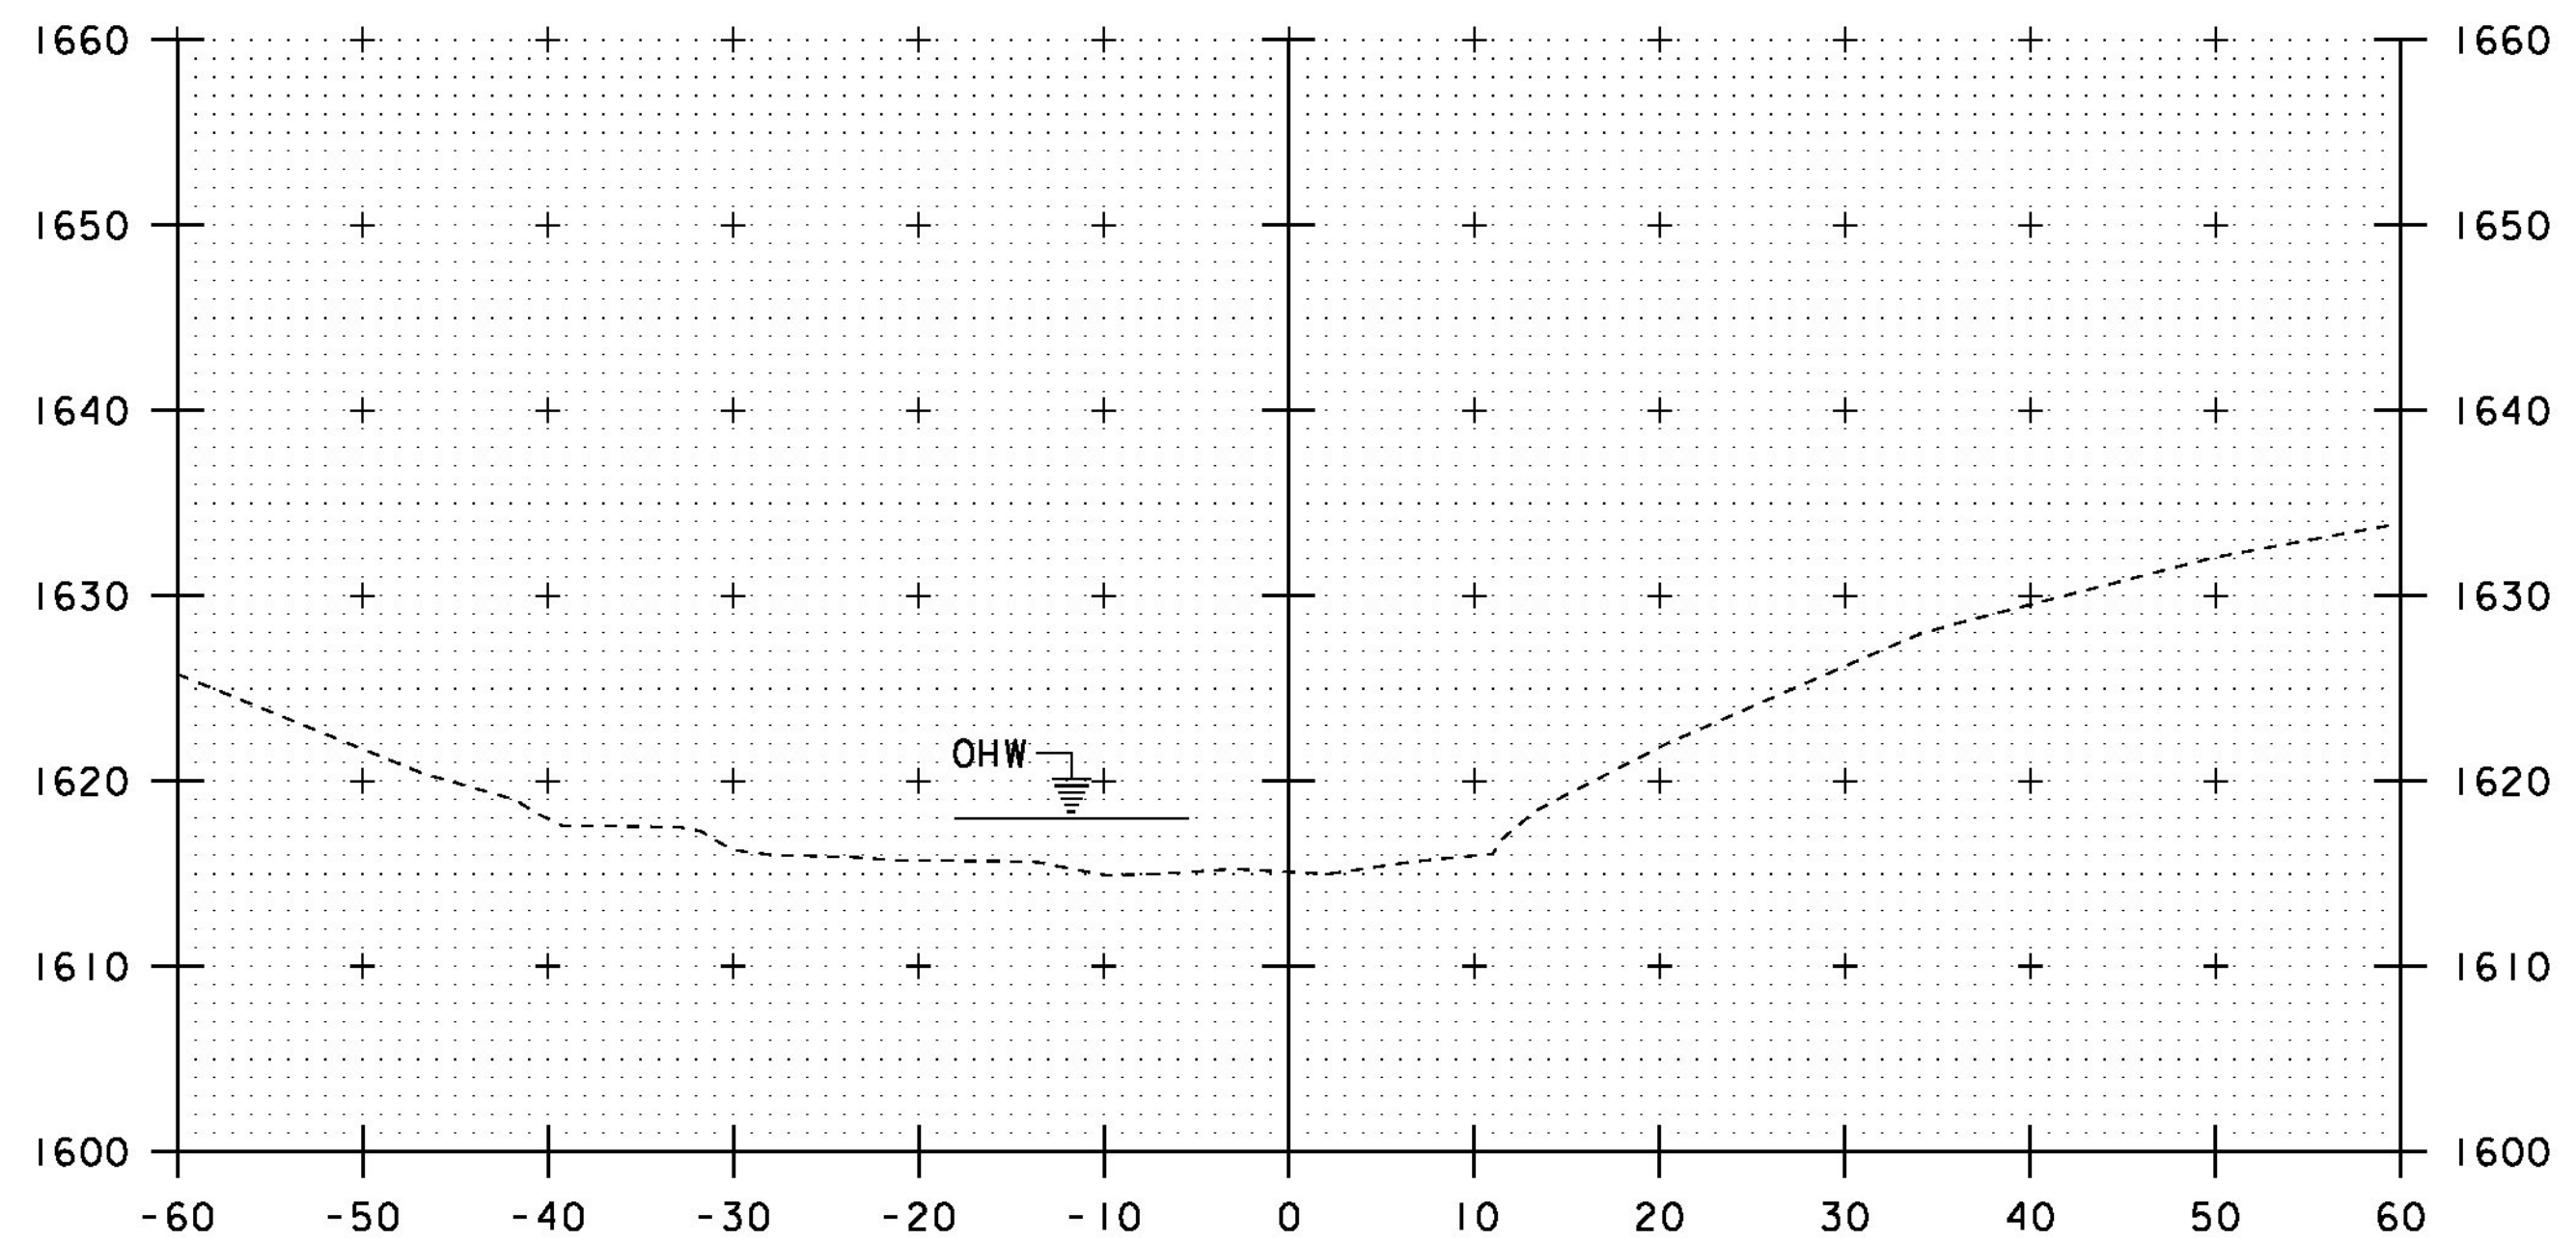

501+40

SCALE 1" = 10'-0"

STA. 501+20 TO STA. 501+50

PROJECT NAME: WALDEN	PLOT DATE: 30-DEC-2014
PROJECT NUMBER: BRF 030-3(5)	DRAWN BY: R. PELLETT
FILE NAME: s09b308_xsl.dgn	CHECKED BY: H. SALLS
PROJECT LEADER: C. CARLSON	SHEET 48 OF 56
DESIGNED BY: H. SALLS	
CHANNEL CROSS SECTIONS 4	