

Abutment 1: Plan View

Vermont Agency of Transportation

RECEIVED


#15801 - Abutment - Rev 2 - 050515.pdf

CK'D BY HIS _____ OK'D BY C. Carlson

May 5, 2015

RESUBMIT NO _____ Approved _____
 BY Carolyn Carlson DATE 5/6/2015

Piece Schedule	
Piece	Weight (lbs)
AB1F1	52,040
AB1F2	52,990
AB1F3	58,520
AB1F4	58,520
WW-2	20,380
AB1S	53,300
AB1N	56,560
WW-1A	44,160
WW-1B	43,750
AB2F1	56,440
AB2F2	41,280
AB2F3	41,280
AB2F4	47,640
AB2F5	46,640
WW-3	38,600
AB2N	54,810
AB2S	53,290
WW-4A	32,700
WW-4B	31,850

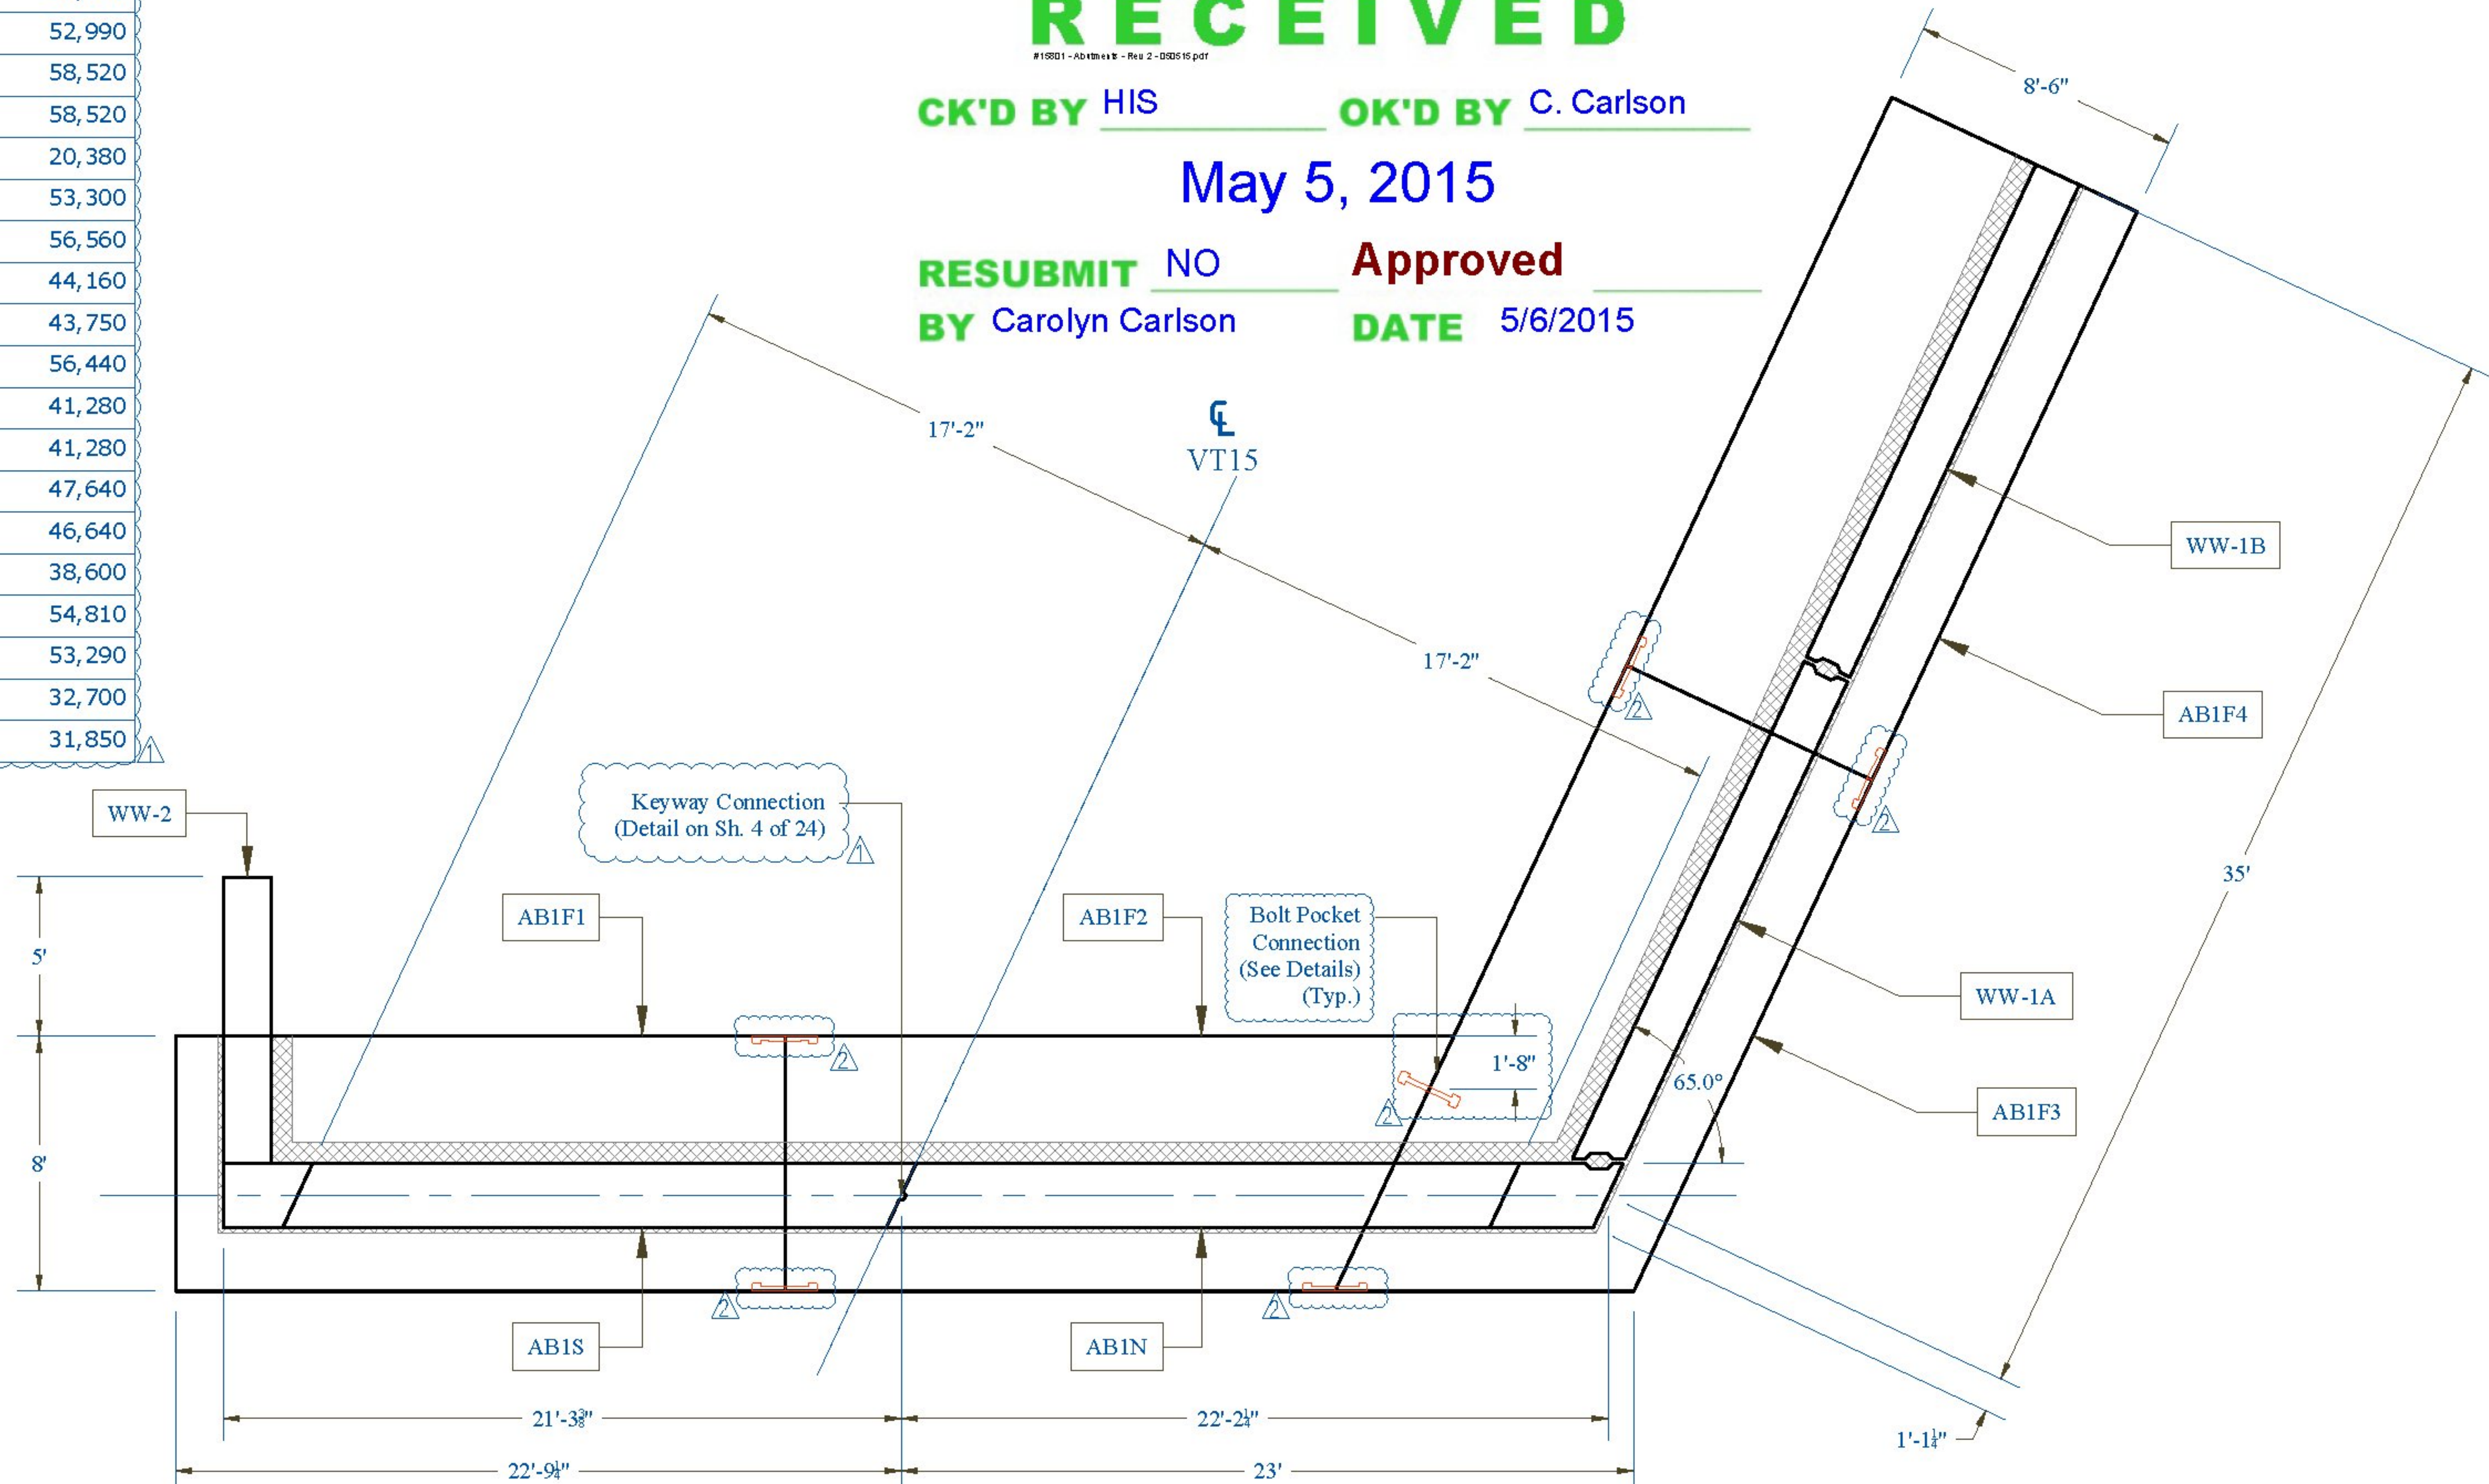

CONTRACTORS VISPE:

Rev.	Date	By	Description
1	04/16/15	IBA	Changes per State Review
2	05/05/15	IBA	Production Changes

PRECAST CONCRETE ABUTMENT SHOP DRAWINGS (SDI JOB #15801)
 SUPERVISOR: E. Barendse
 DETAILER: I. ADAMS
 CHECKER: E. Barendse
 ENGINEER: VTAOT

INSTALLER:
 J.A. McDonald, Inc.
 PO Box 132
 Lyndon Center, VT 05850
 04/08/15

FABRICATOR:
 193 INDUSTRIAL AVE.
 WILLISTON, VT 05495
 Ph: (802) 658-0201
SD Ireland
 PRECAST
 AB1_PLAN 2_OF_25