


Abutment Stem Keyway Detail

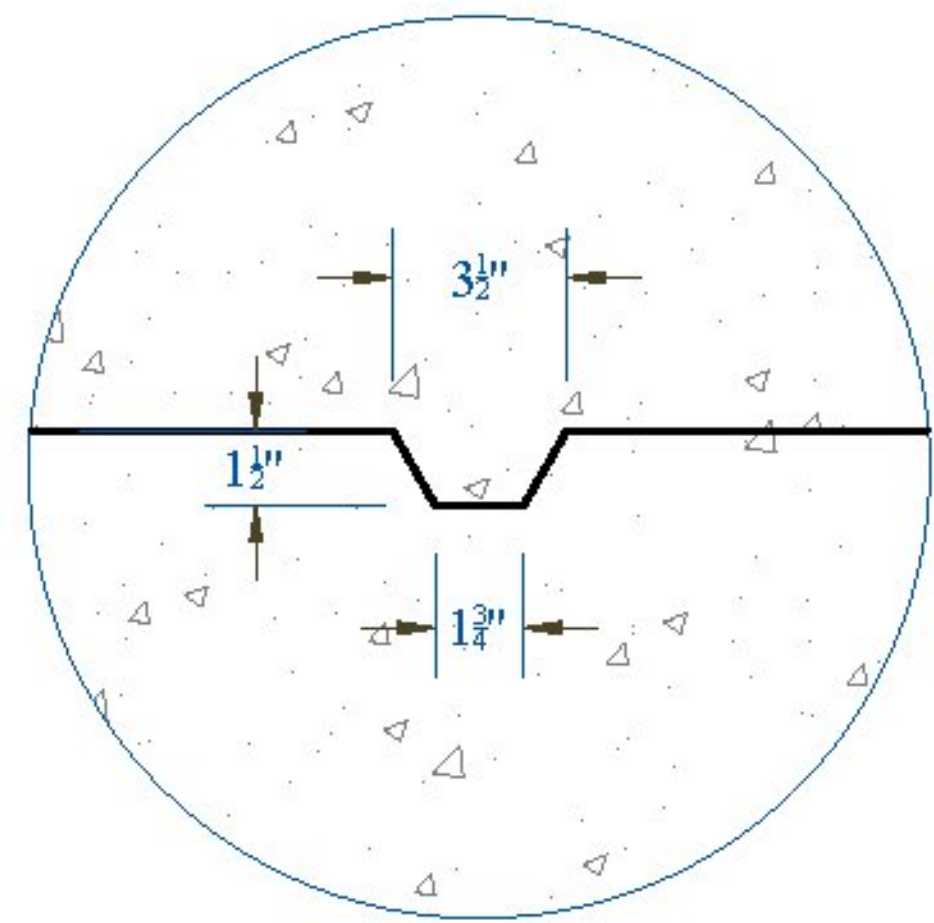

Abutment 2: Plan View

Vermont Agency of Transportation

**RECEIVED**


CK'D BY HIS \_\_\_\_\_ OK'D BY C. Carlson

May 5, 2015

RESUBMIT NO \_\_\_\_\_ Approved

BY Carolyn Carlson DATE 5/6/2015

VT15

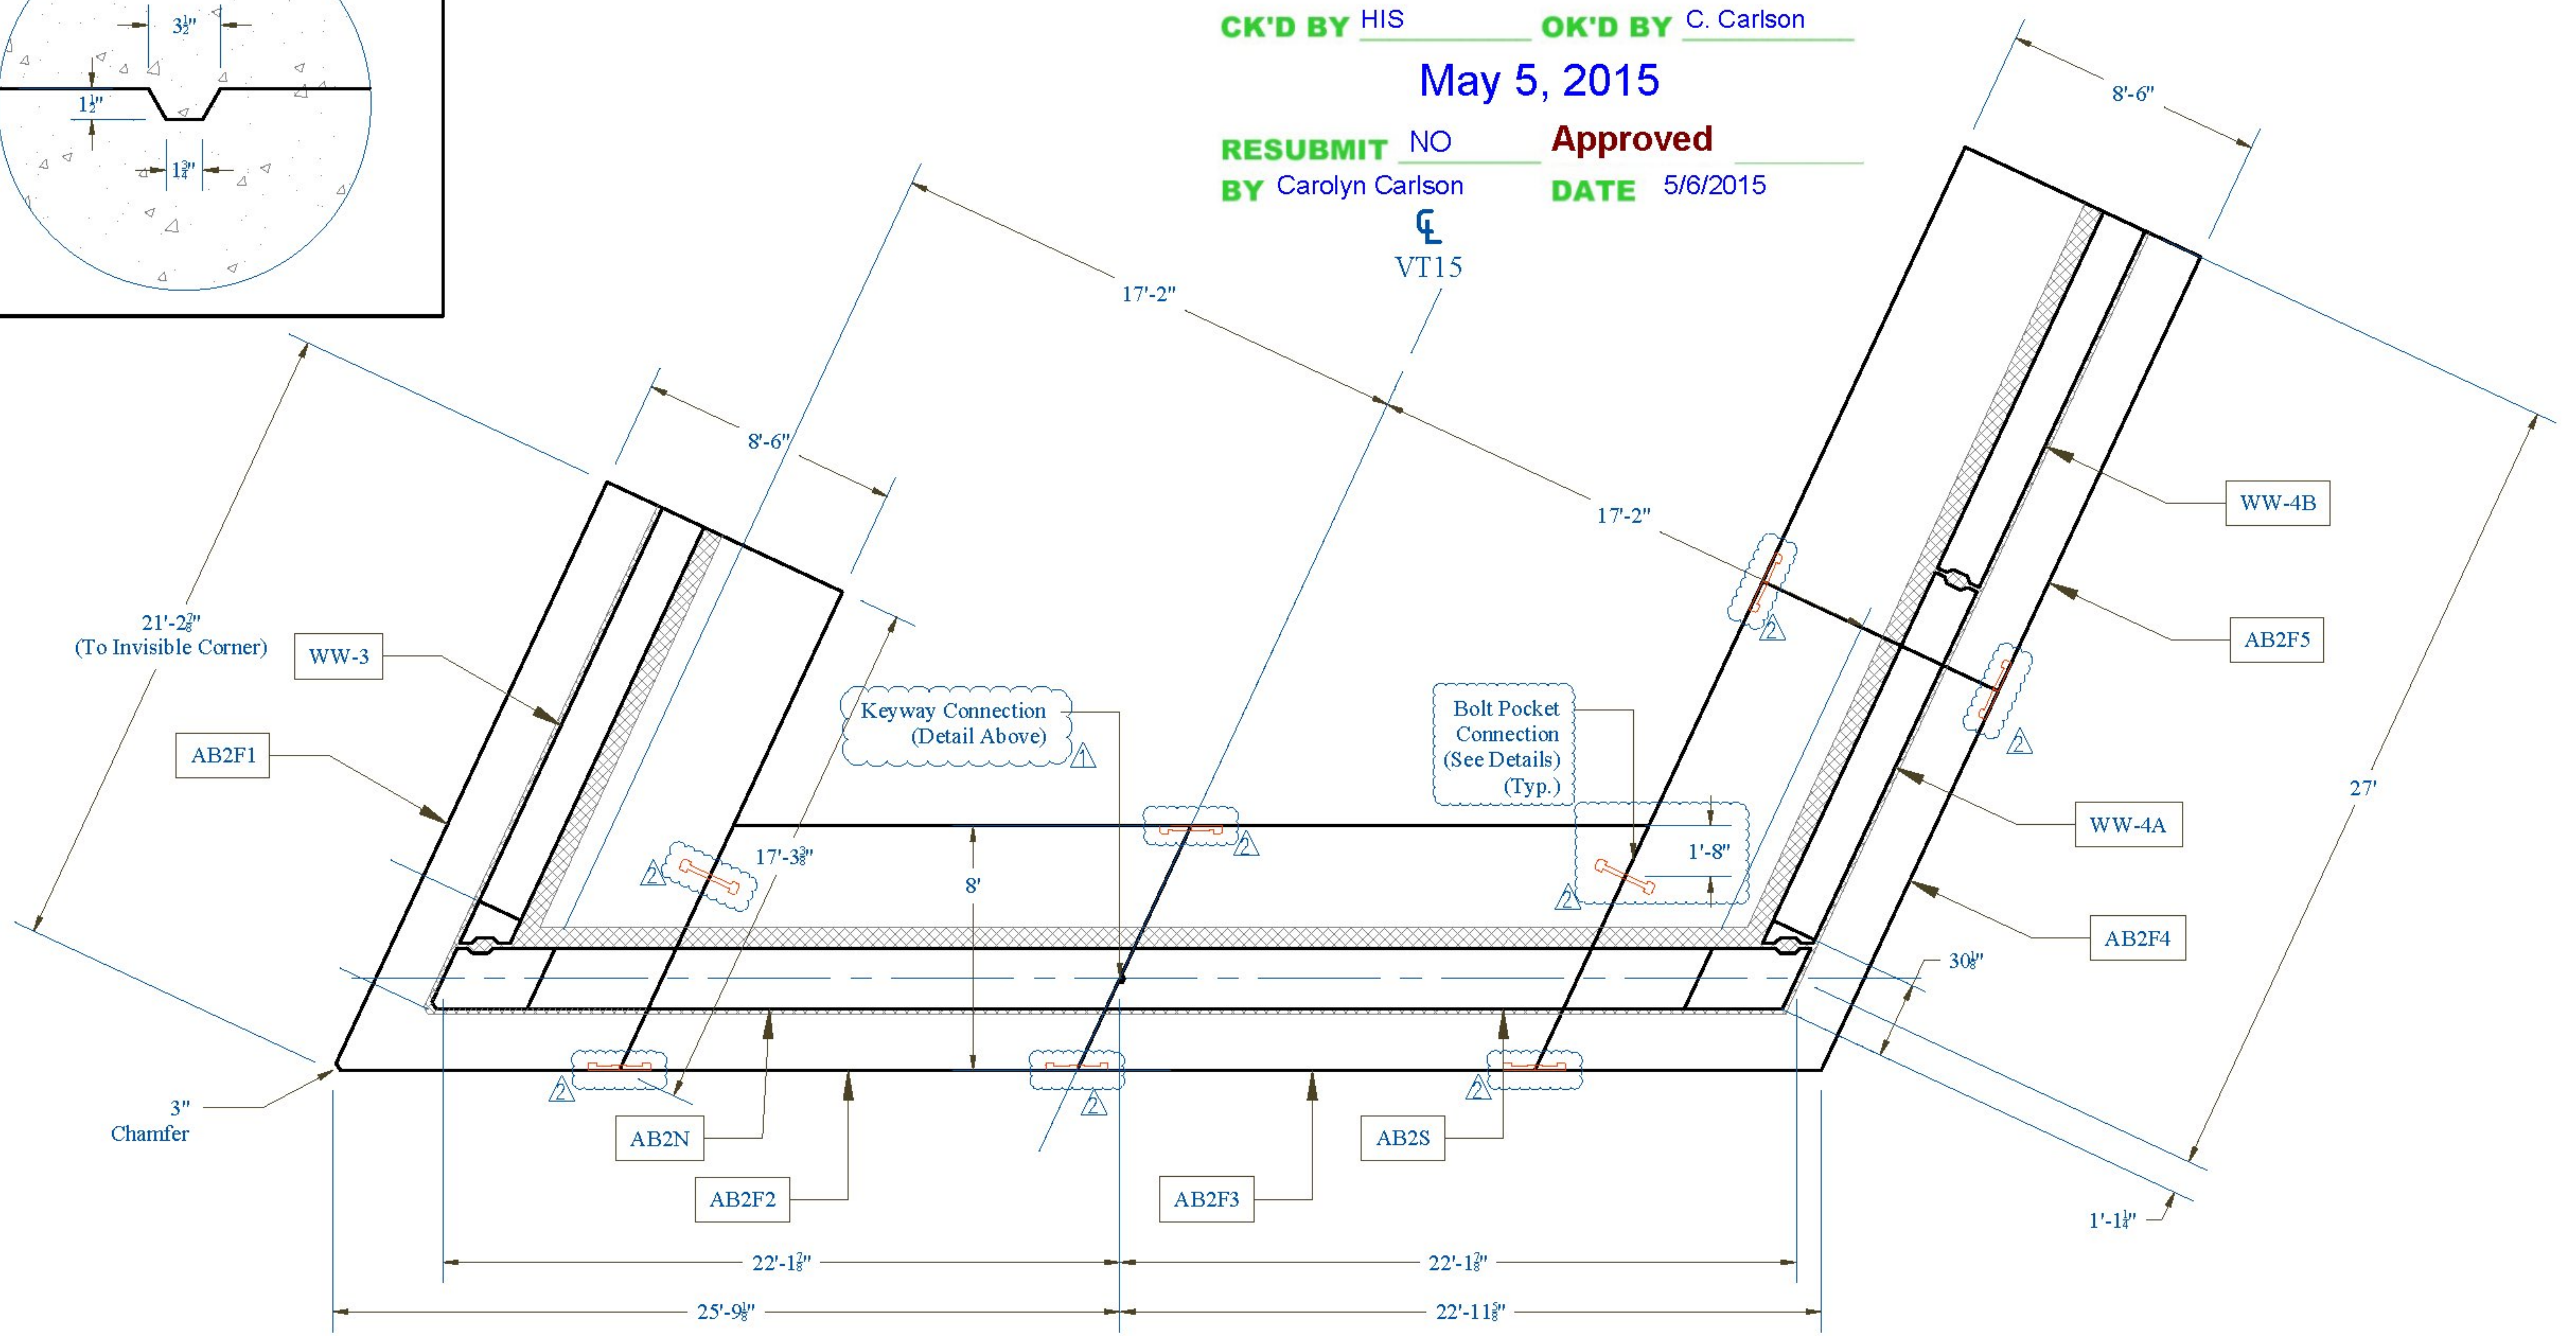

CONTRACTORS VISPE:

Rev.	Date	By	Description
1	04/16/15	IBA	Changes per State Review
2	05/05/15	IBA	Production Changes

PRECAST CONCRETE ABUTMENT SHOP DRAWINGS (SDI JOB #15801)  
 SUPERVISOR: E. Barendse  
 DETAILER: I. ADAMS  
 CHECKER: E. Barendse  
 ENGINEER: VTAOT

INSTALLER:  
 J.A. McDonald, Inc.  
 PO Box 132  
 Lyndon Center, VT 05850  
 04/08/15

FABRICATOR:  
 193 INDUSTRIAL AVE.  
 WILLISTON, VT 05495  
 Ph: (802) 658-0201  
 AB2\_PLAN

