



AS #1 Details

Weight: 27,000 lbs

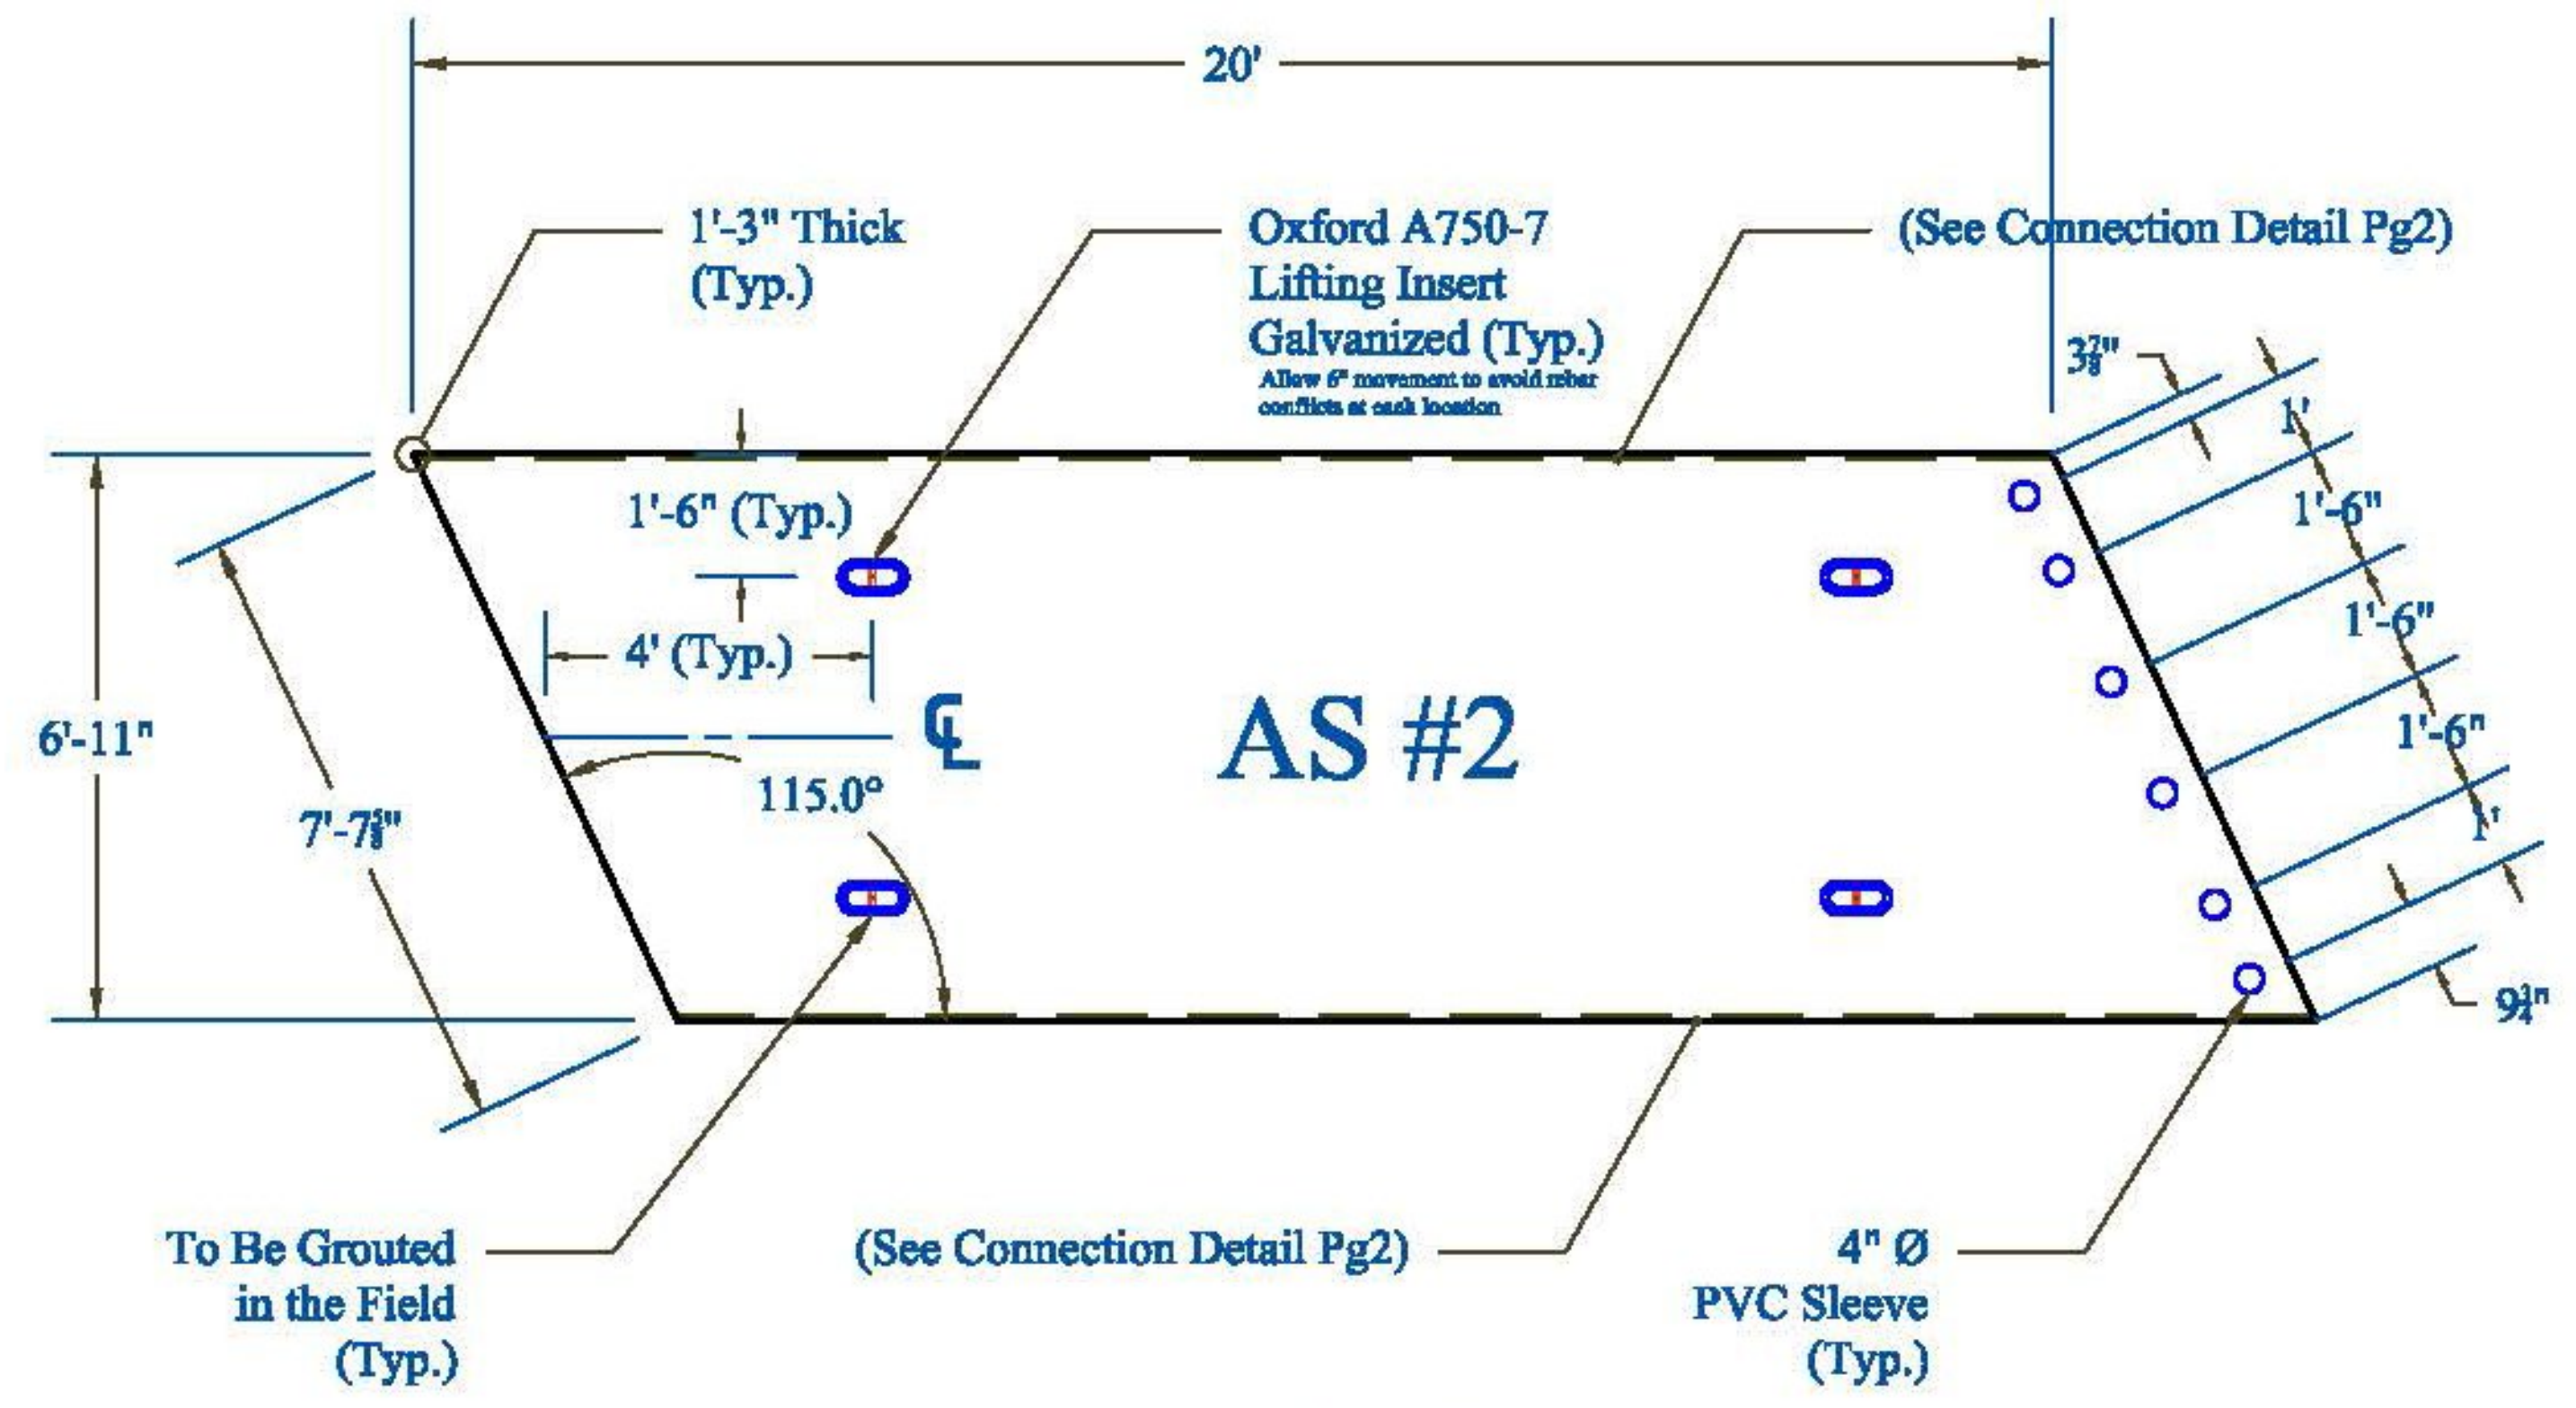


AS #2 Details

Weight: 25,600 lbs

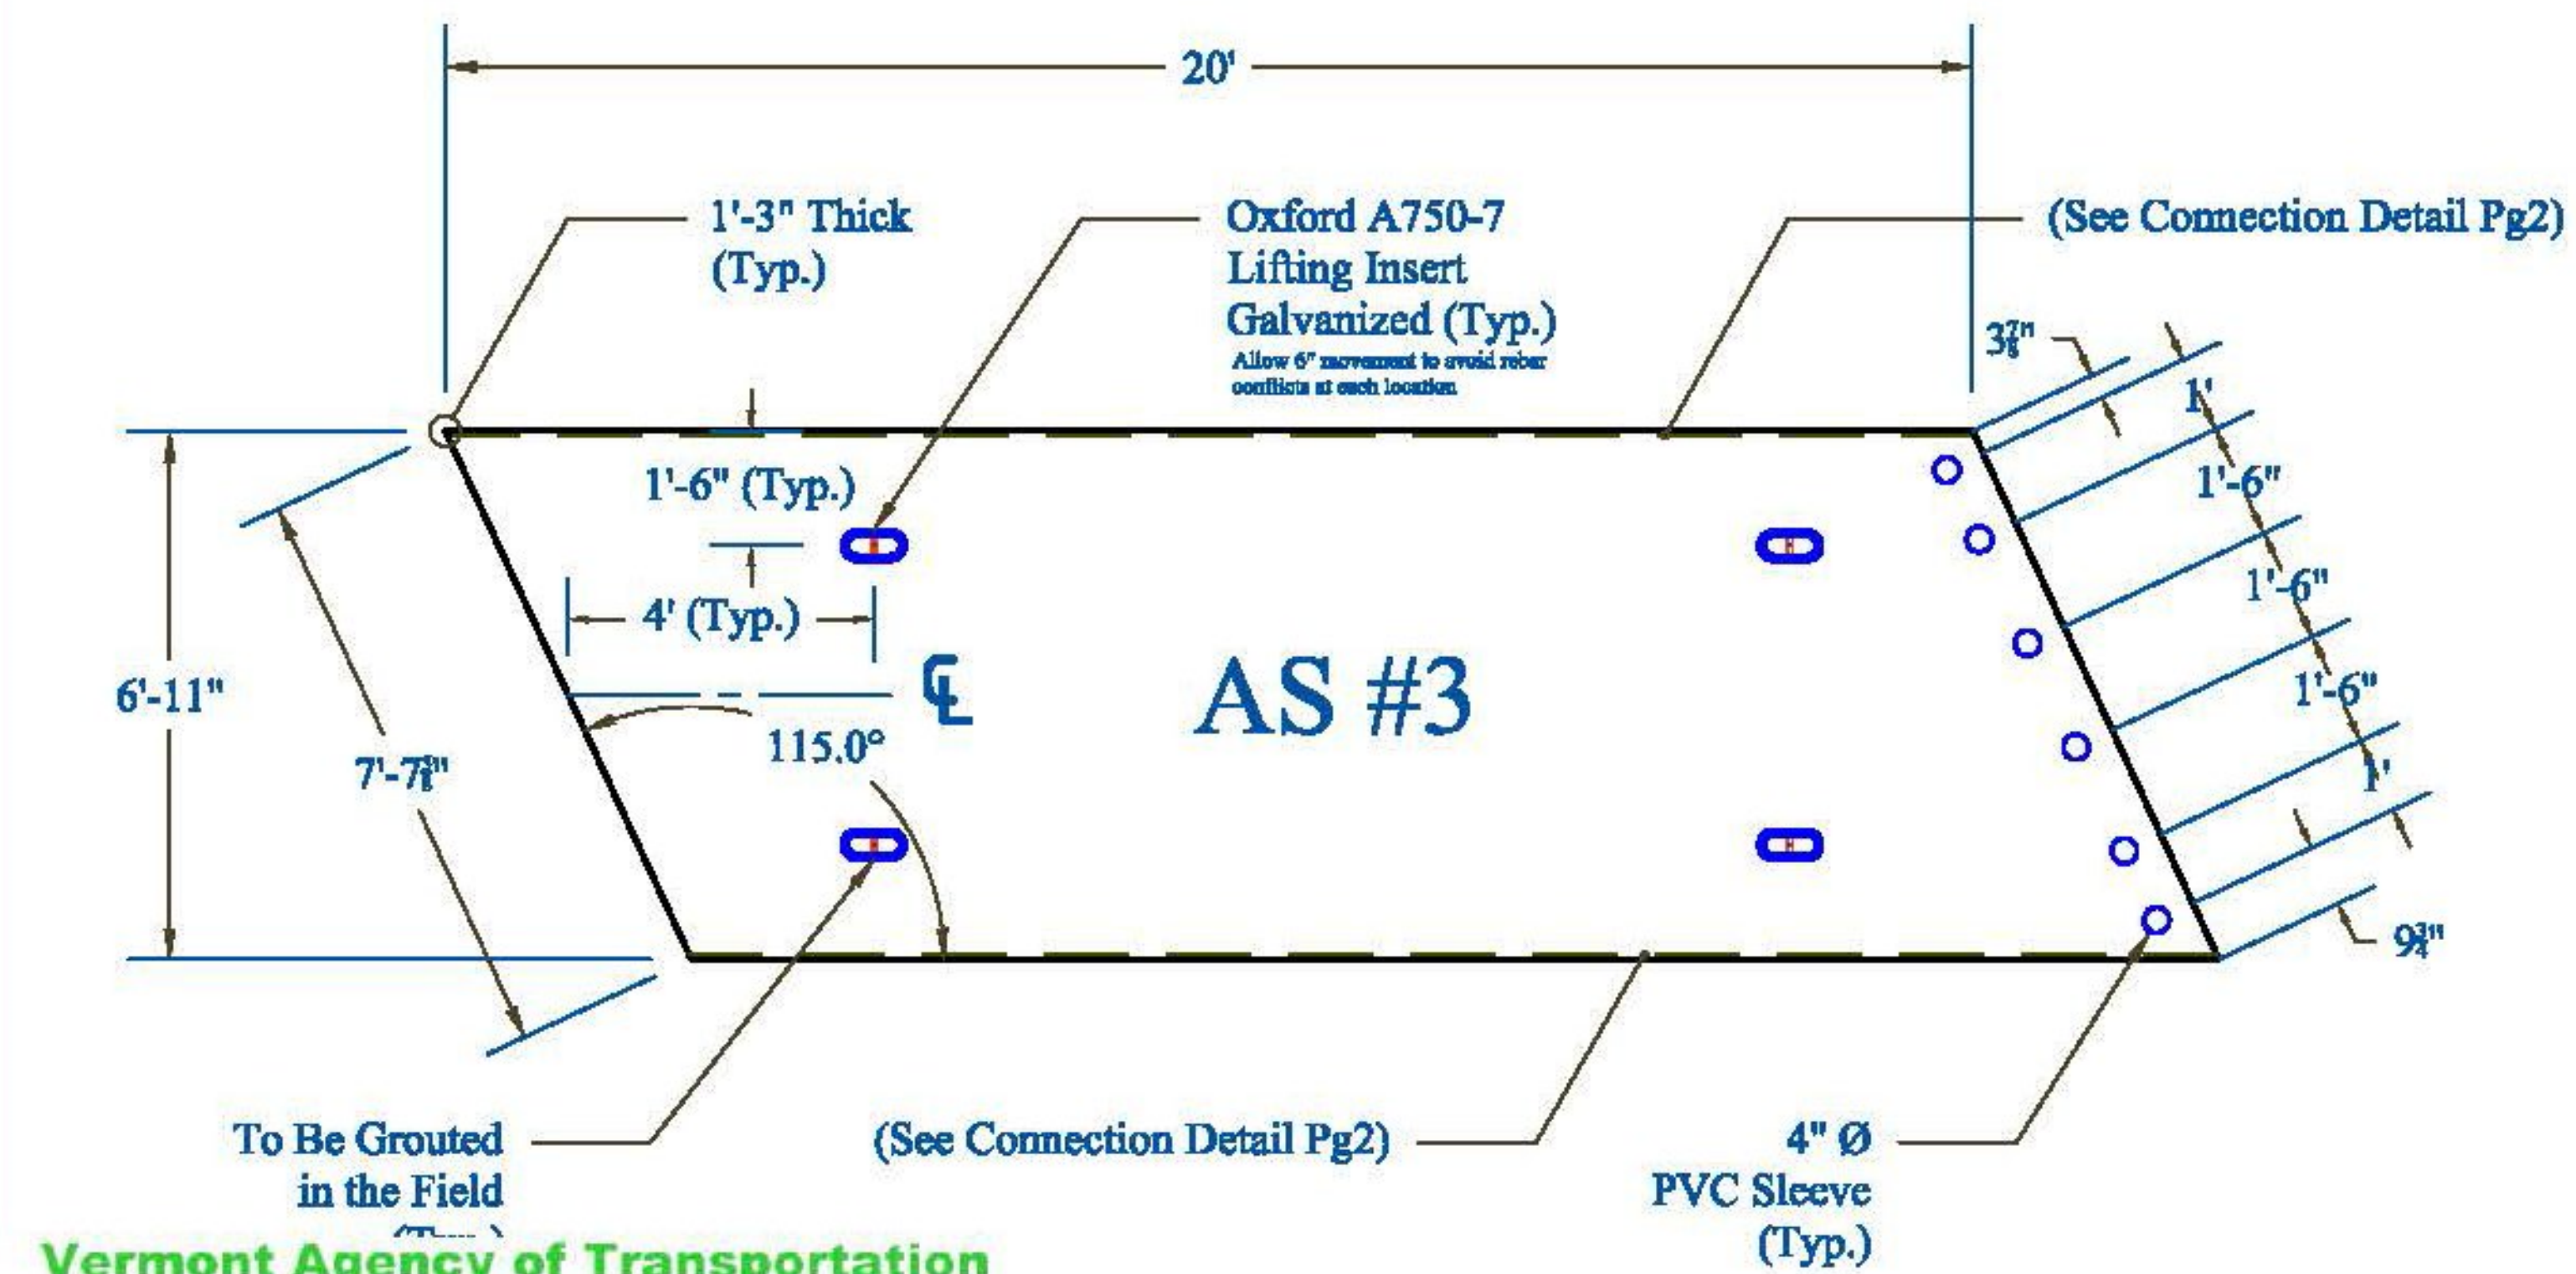

AS #3 Details

Weight: 25,600 lbs

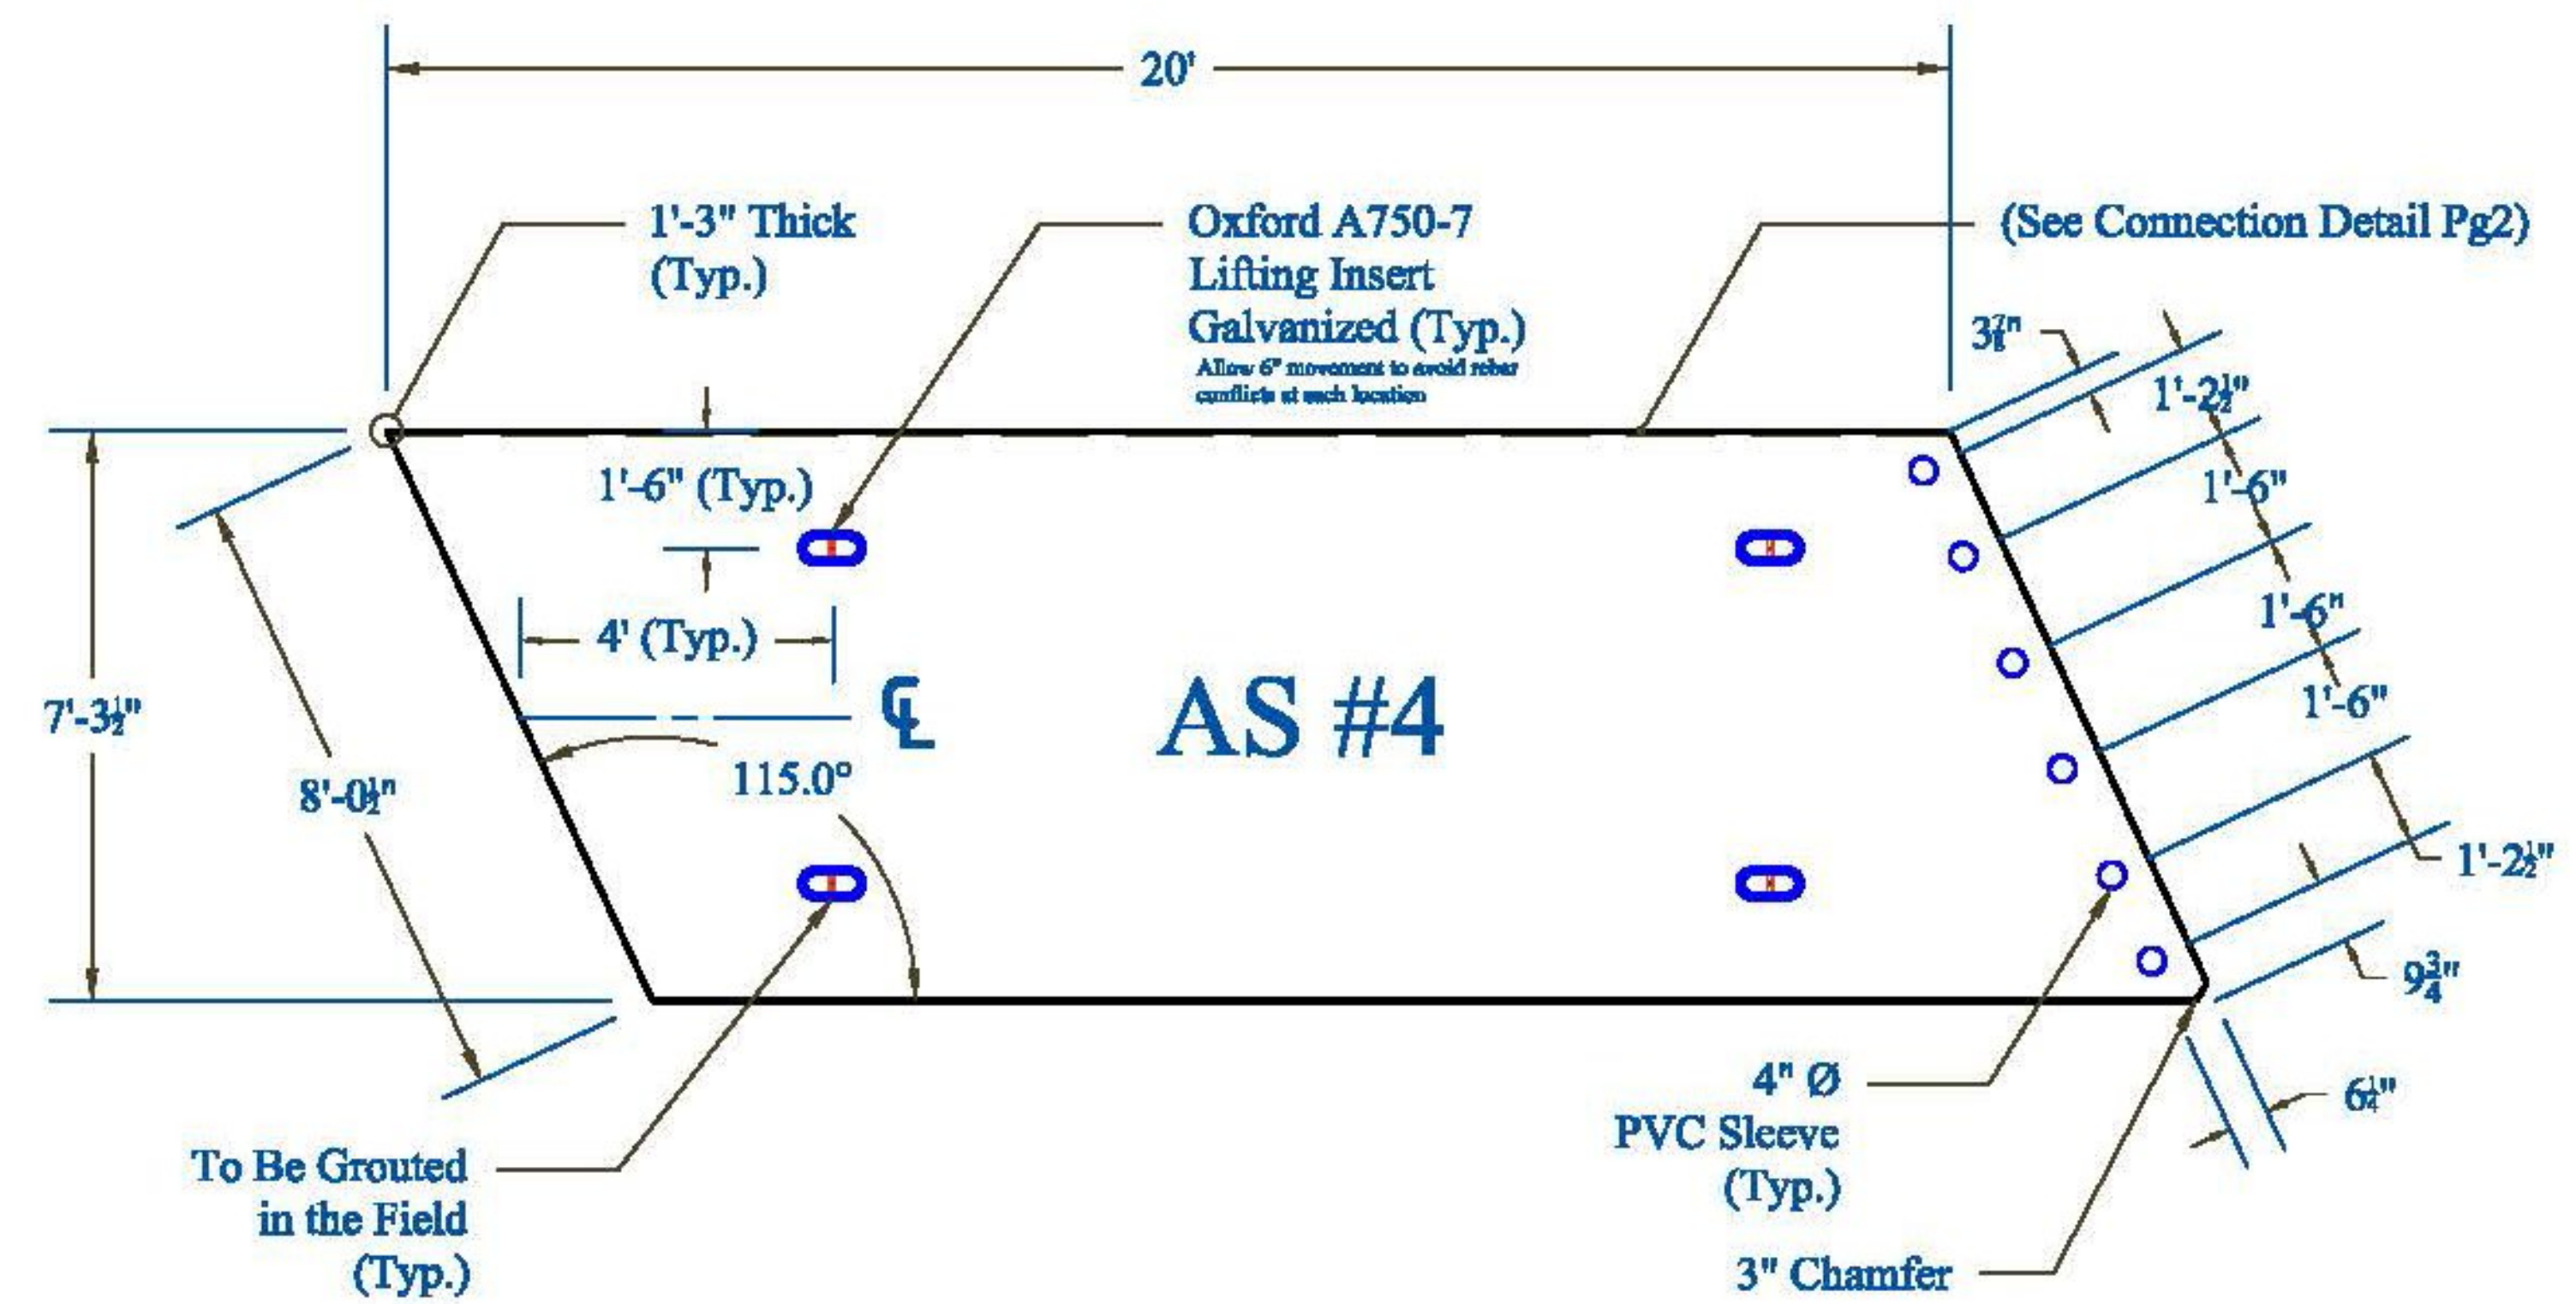

AS #4 Details

Weight: 27,000 lbs

Vermont Agency of Transportation  
**RECEIVED**  
 CK'D BY CLB OK'D BY HIS  
 April 20, 2015  
 RESUBMIT NO Approved  
 BY C. CARLSON DATE 04/22/15

Review

PRECAST CONCRETE APPROACH SLAB SHOP DRAWINGS (SDI JOB #15801) SUPERVISOR: E. Barendse DETAILER: I. ADAMS CHECKER: E. Barendse ENGINEER: VT AOT		INSTALLER: J.A. McDonald, Inc. PO Box 132 Lyndon Center, VT 05850 04/08/2015	FABRICATOR: 193 INDUSTRIAL AVE. WILLISTON, VT 05495 Ph: (802) 658-0201 <b>SD Ireland</b> PRECAST	SLABS_1 3_OF_10
--	--	--	---	--------------------