



AS #5 Details

Weight: 27,000 lbs

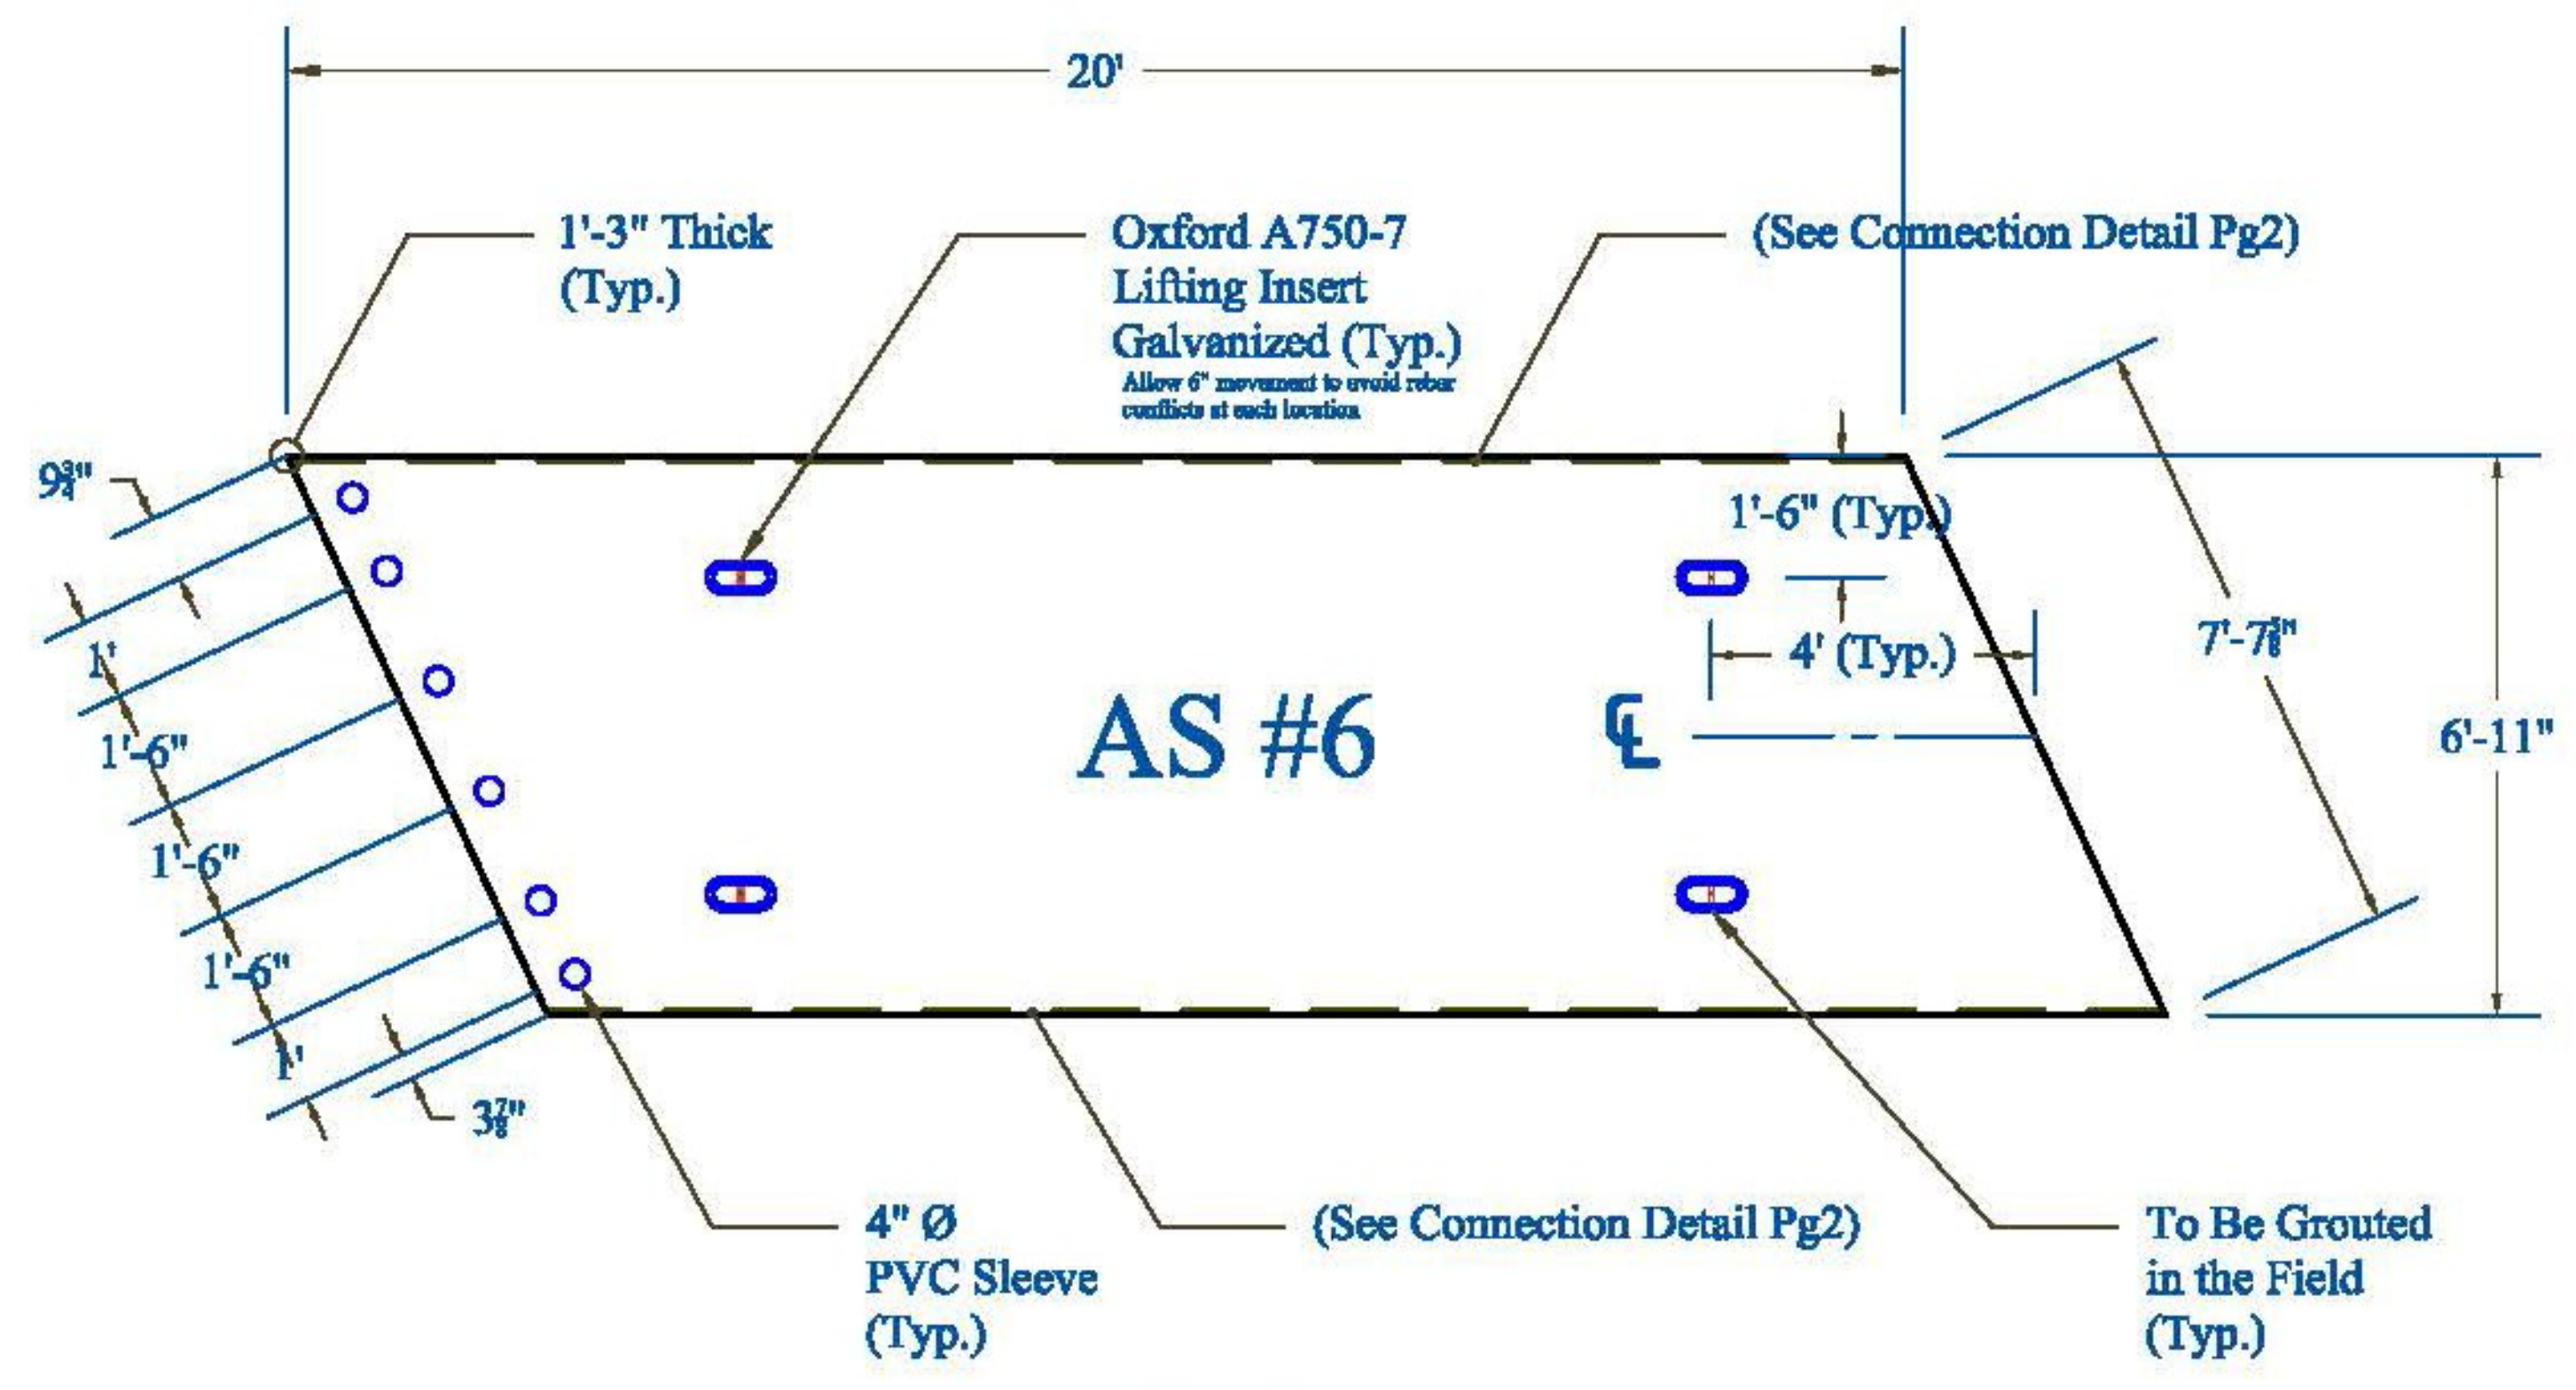


AS #6 Details

Weight: 25,600 lbs

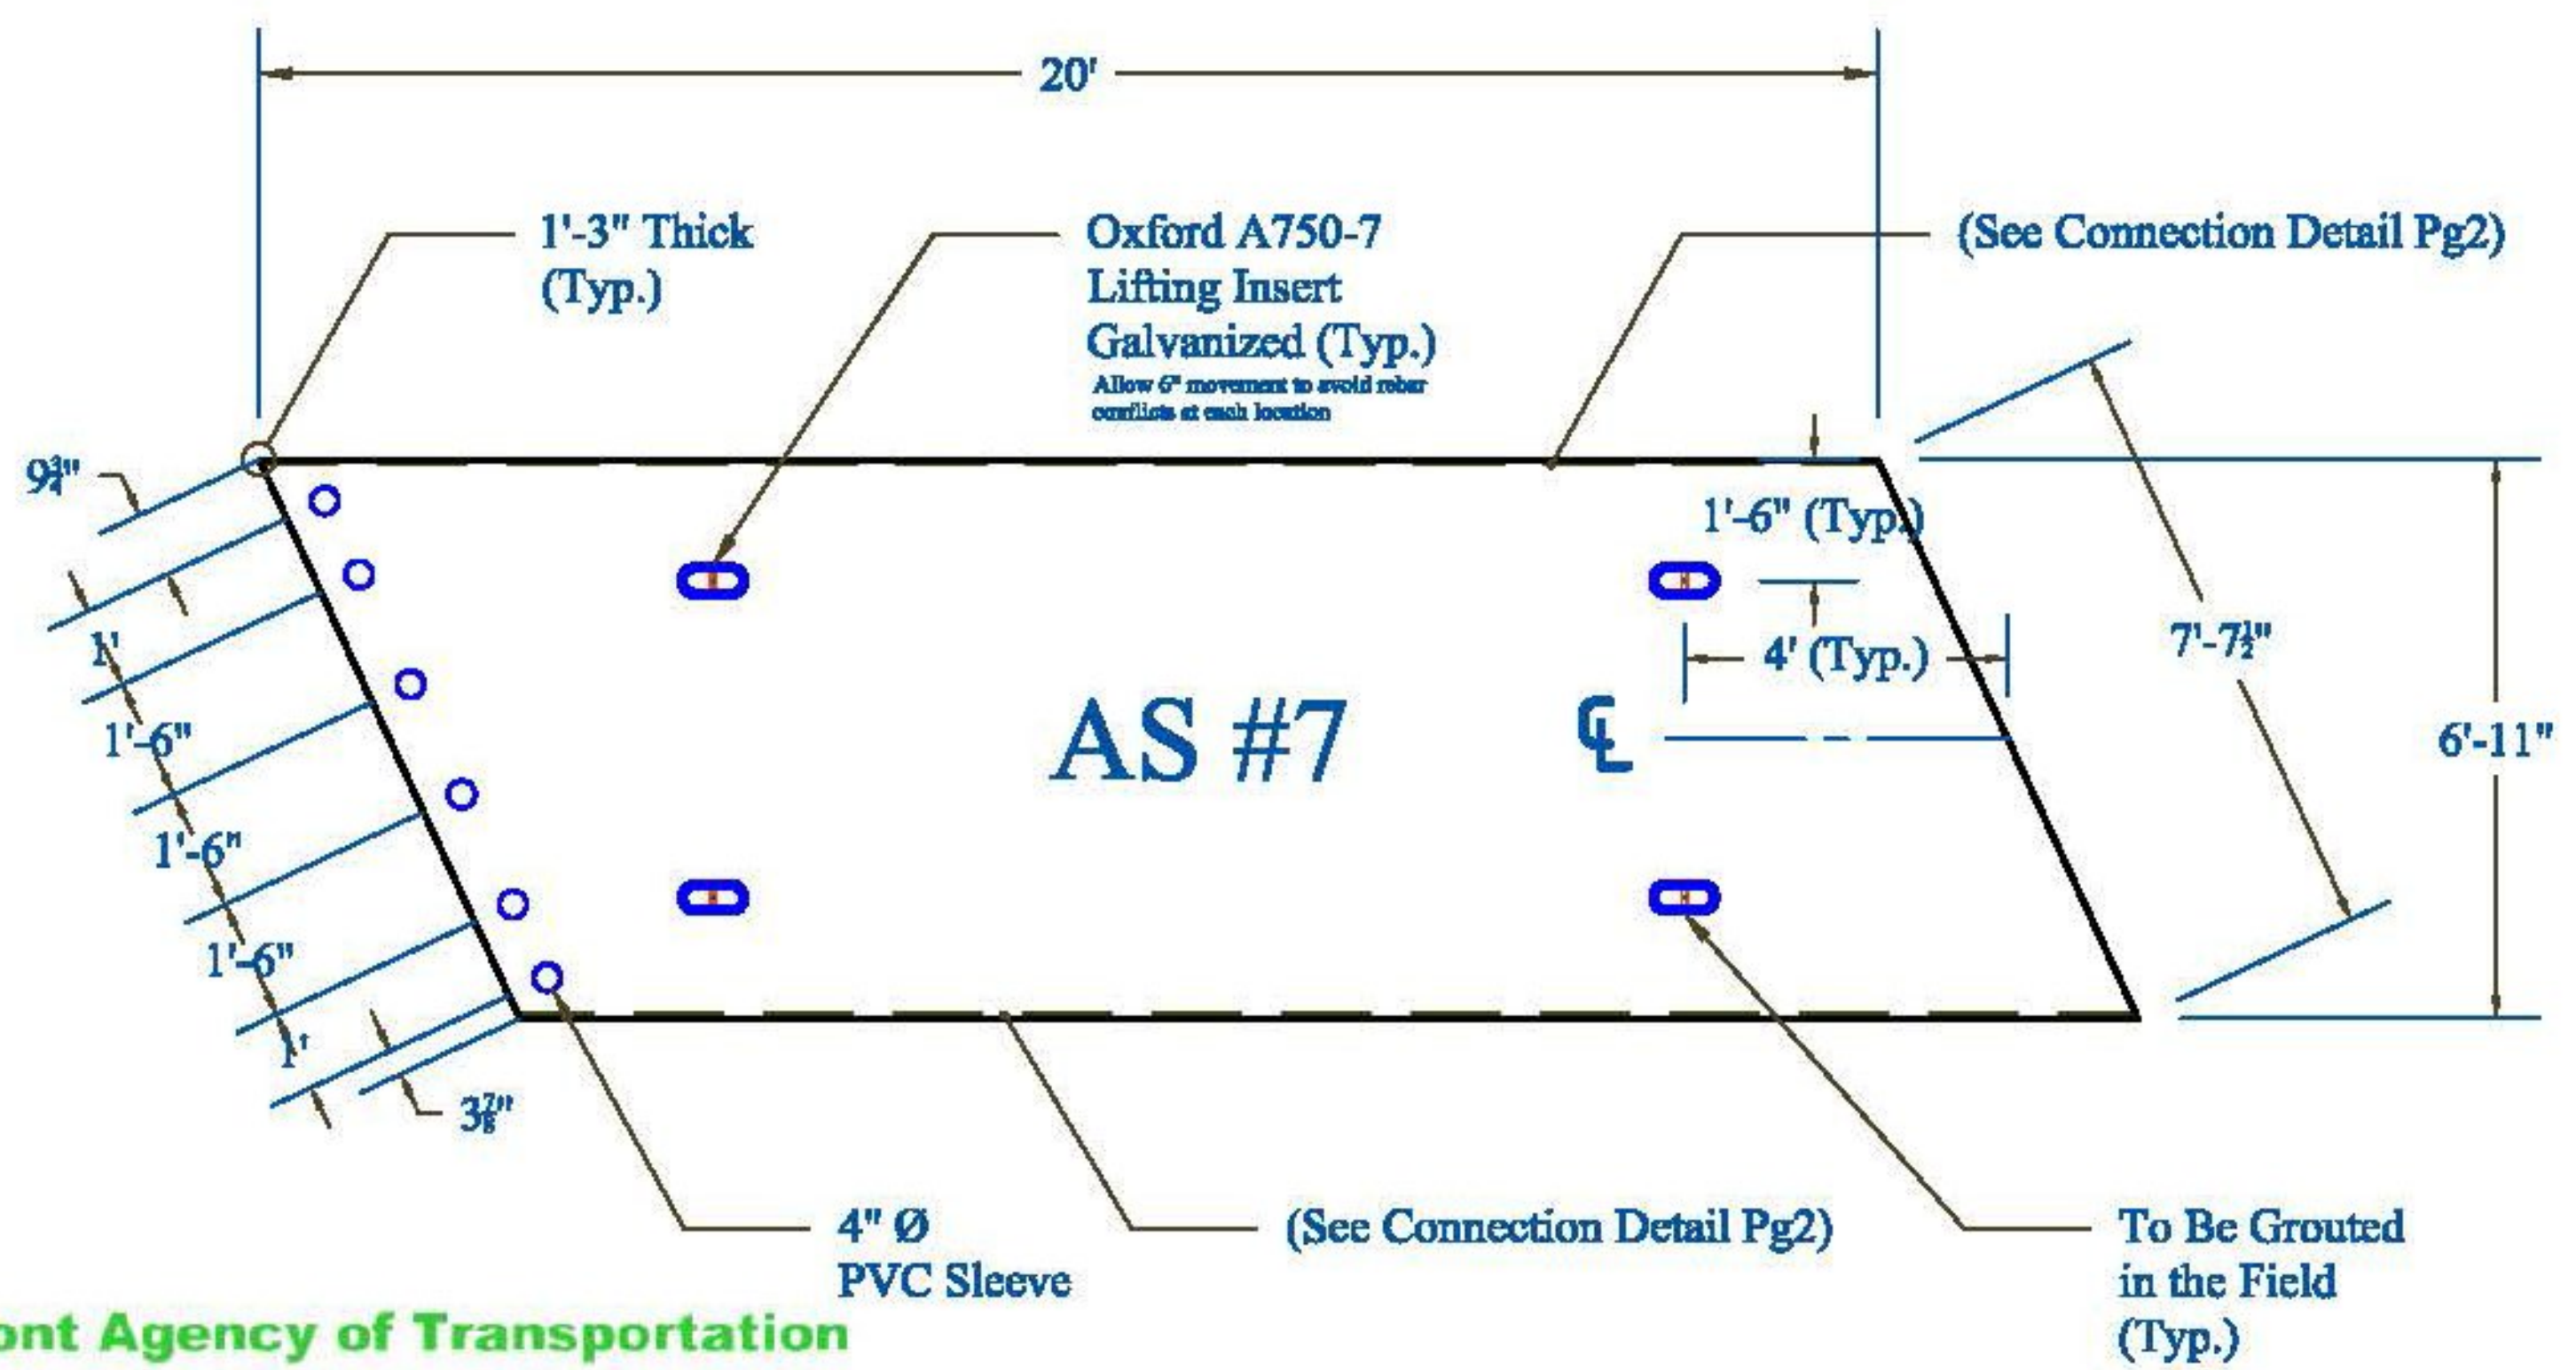

AS #7 Details

Weight: 25,600 lbs

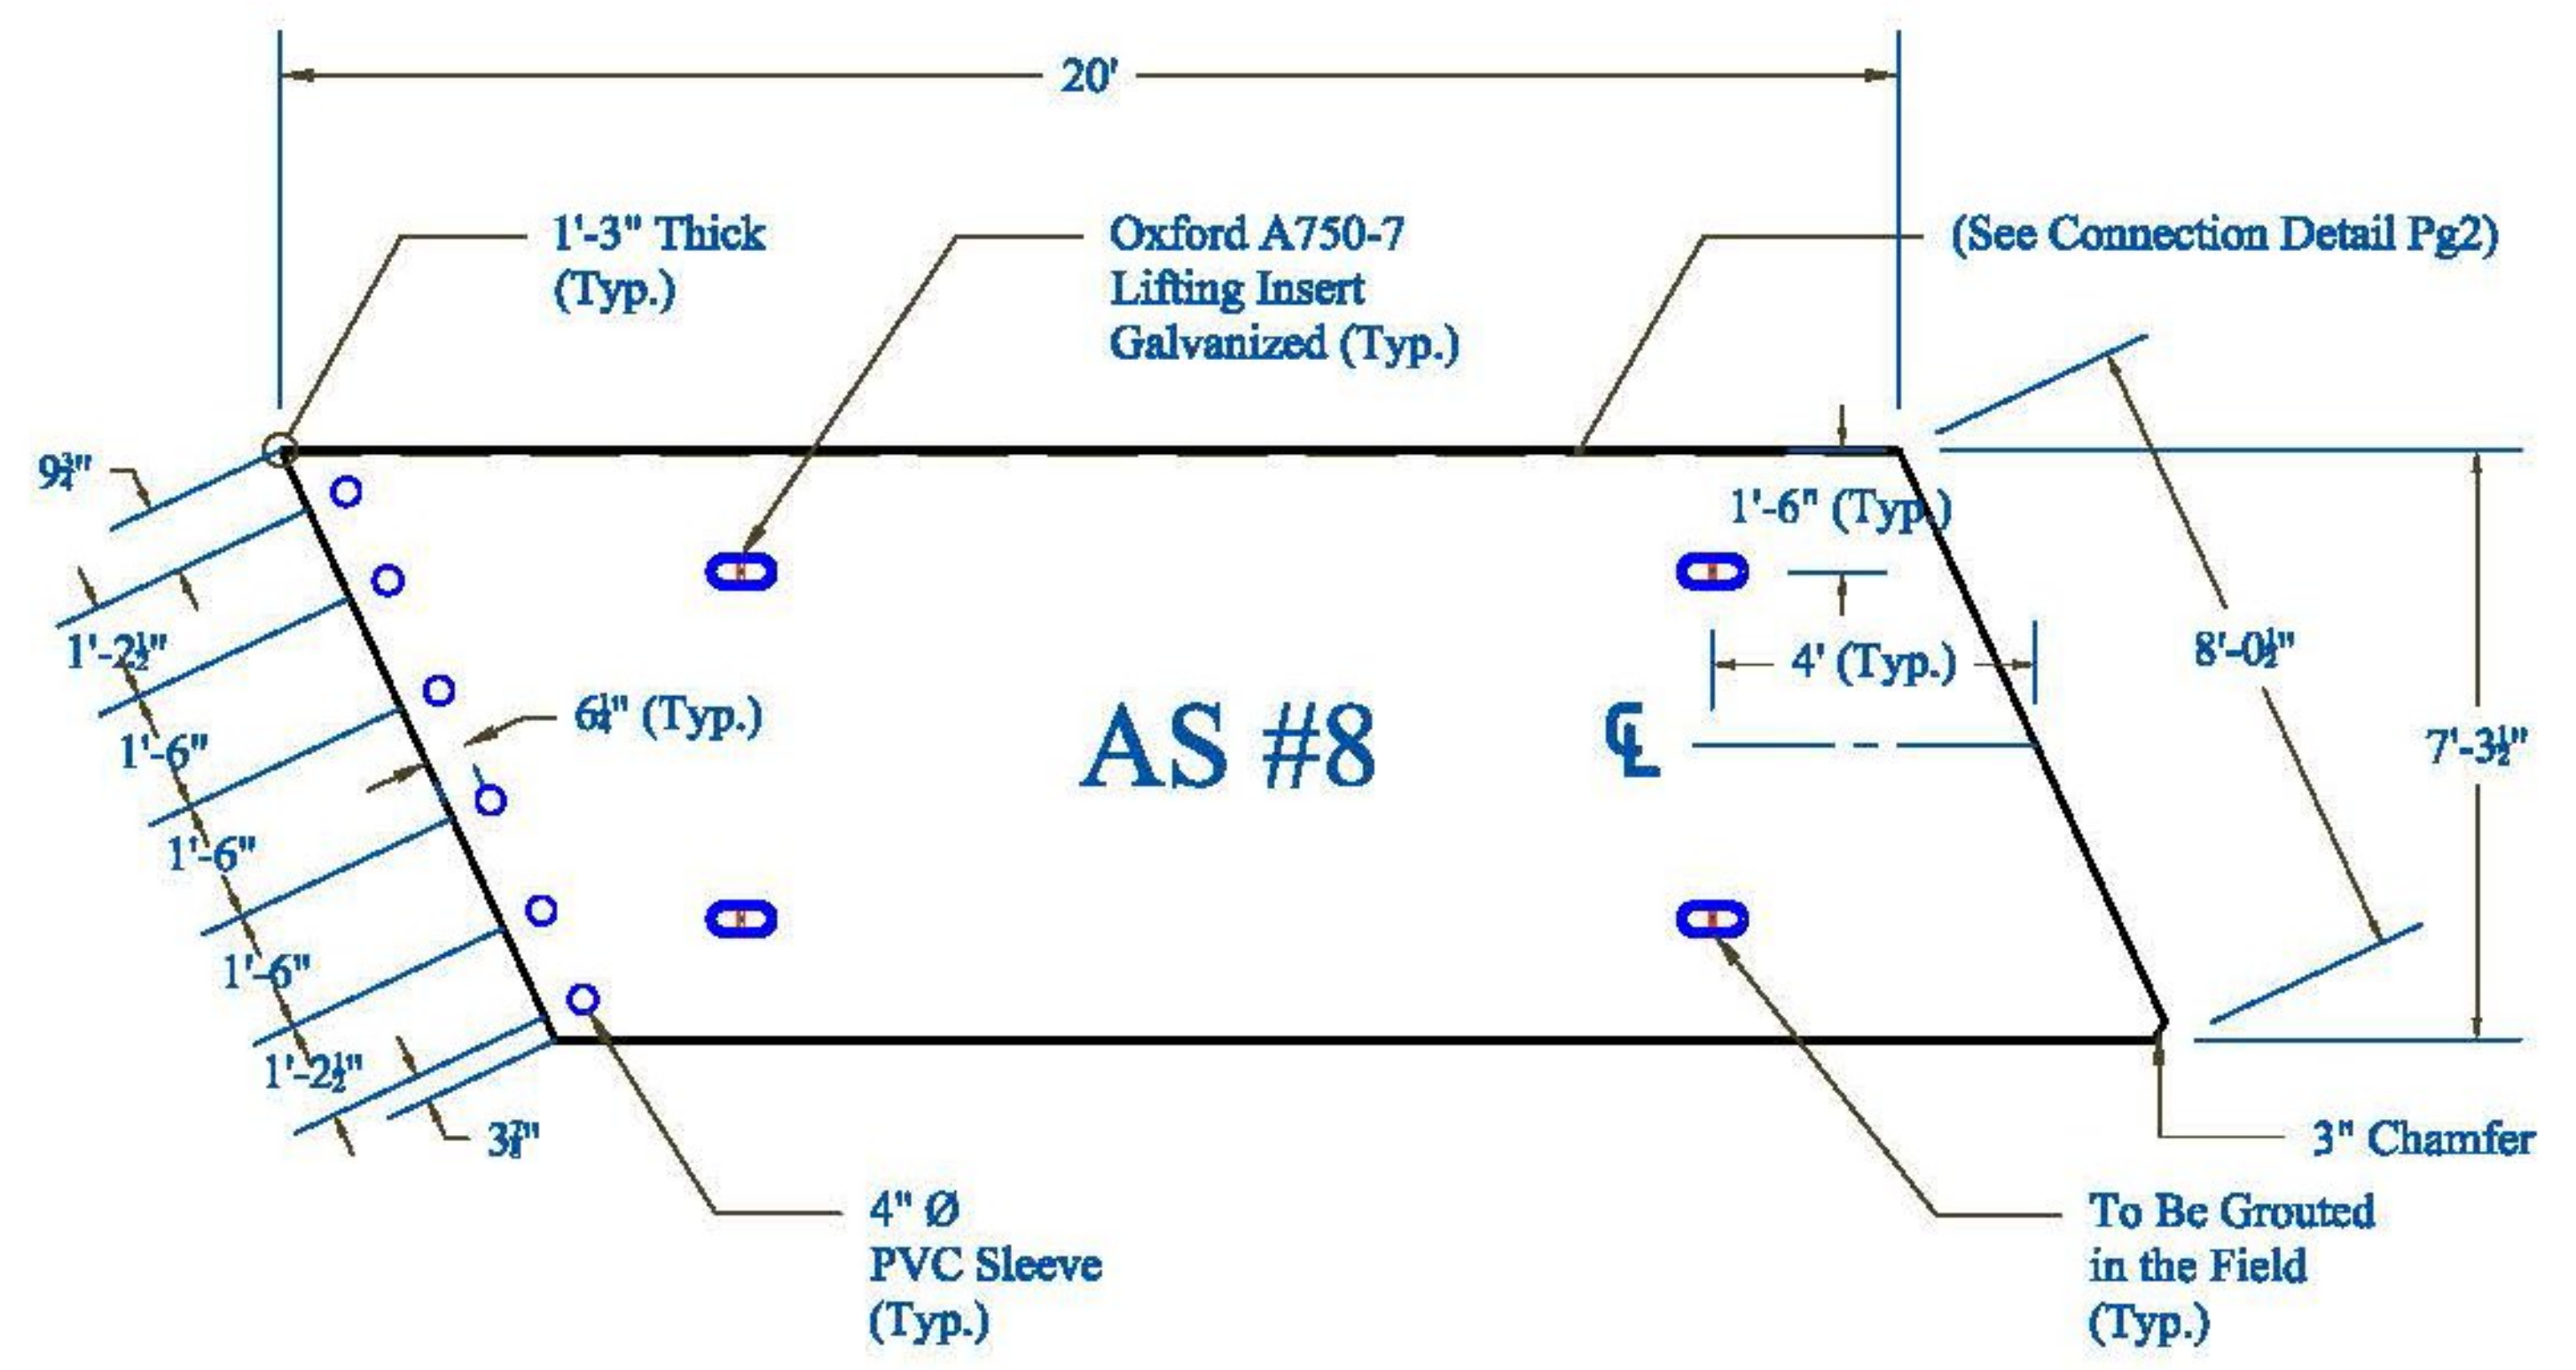

AS #8 Details

Weight: 27,000 lbs

Vermont Agency of Transportation  
**RECEIVED**

CK'D BY CLB OK'D BY HIS

April 20, 2015

RESUBMIT NO Approved

BY C. CARLSON DATE 04/22/15

PRECAST CONCRETE APPROACH SLAB SHOP DRAWINGS (SDI JOB #15801)  
 SUPERVISOR: E. Barendse  
 DETAILER: I. ADAMS  
 CHECKER: E. Barendse  
 ENGINEER: VT AOT

PROJECT NAME:  
 Walden BR# 030-3(5)  
 PROJECT # 030-3(5)  
 LOCATION: Walden, VT

INSTALLER:  
 J.A. McDonald, Inc.  
 PO Box 132  
 Lyndon Center, VT 05850  
 04/08/2015

FABRICATOR:  
 193 INDUSTRIAL AVE.  
 WILLISTON, VT 05495  
 Ph: (802) 658-0201



SLABS\_2

4\_OF\_10