


RECEIVED

Approach Slab Submittal #2, Approved 4-22-15.pdf

CK'D BY CLB OK'D BY HIS


April 20, 2015

RESUBMIT NO Approved
 BY C. CARLSON DATE 04/22/15

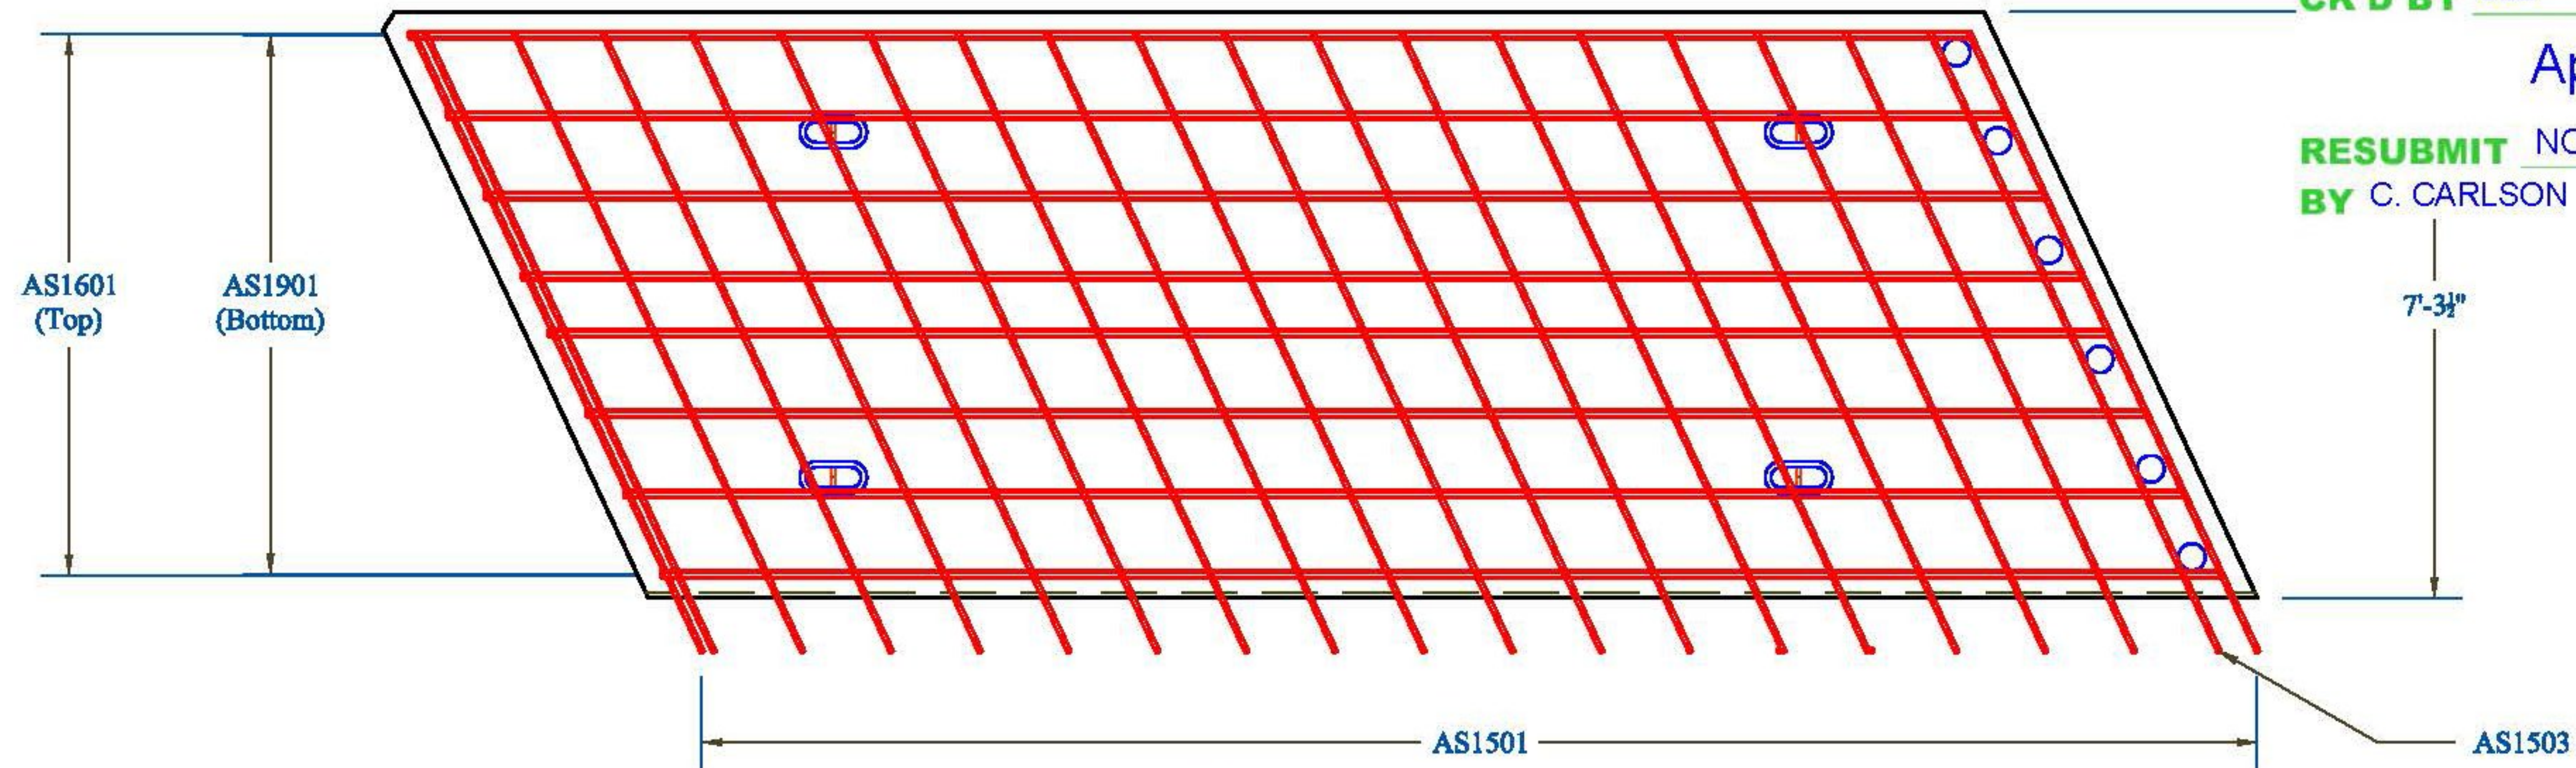

AS #1 Details

3" Clear U.O.N.

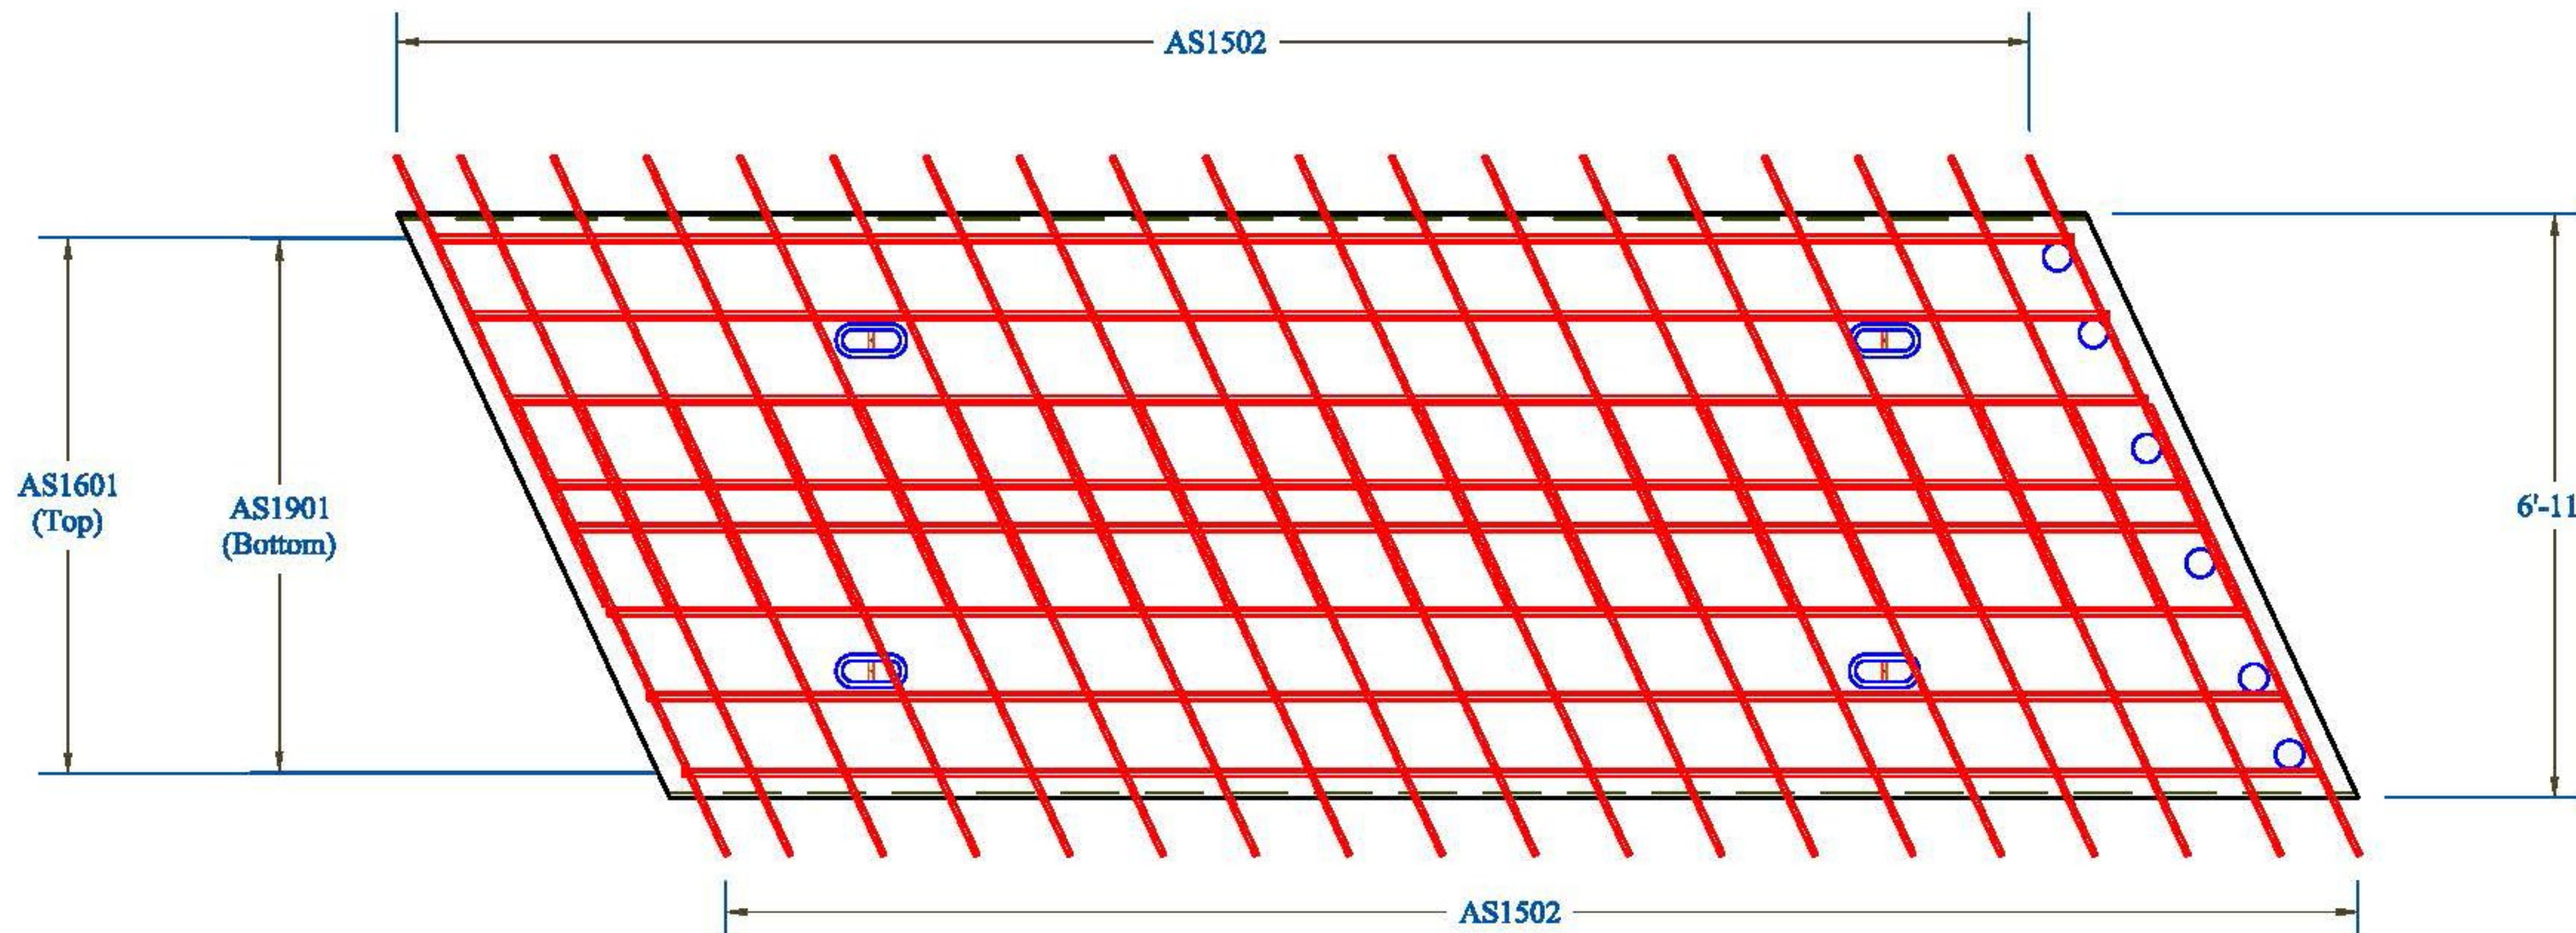

Check depth of lifting inserts to ensure they will not interfere with the rebar

AS #2 Details

3" Clear U.O.N.

CONTRACTORS VISPE	Rev	Date	By	Description	PRECAST CONCRETE APPROACH SLAB SHOP DRAWINGS (SDI JOB #15801)		INSTALLER:	FABRICATOR:
	1	04/16/15	IBA	Changes per State Review	SUPERVISOR: E. Barendse	PROJECT NAME: Walden BR# 030-3(5)	J.A. McDonald, Inc. PO Box 132 Lyndon Center, VT 05850	193 INDUSTRIAL AVE. WILLISTON, VT 05495 Ph: (802) 658-0201
					DETAILER: I. ADAMS	PROJECT #: 030-3(5)		
					CHECKER: E. Barendse	LOCATION: Walden, VT	04/08/2015	SLAB_BAR_1
					ENGINEER: VT AOT			7_OF_10

