

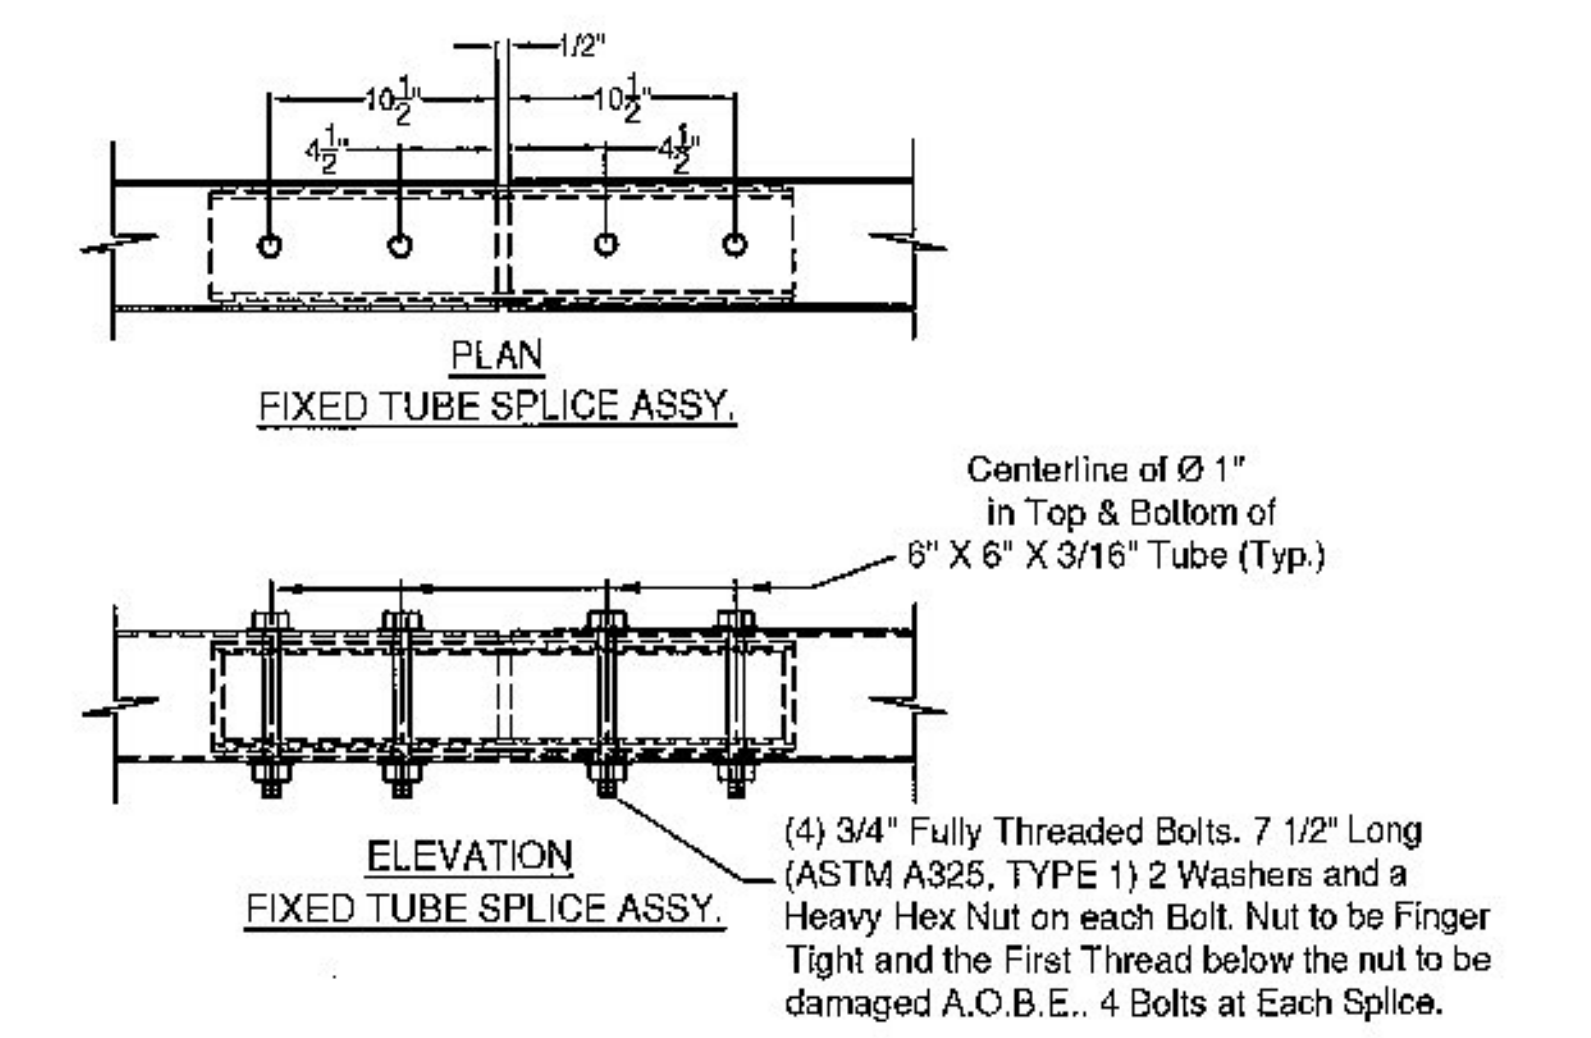
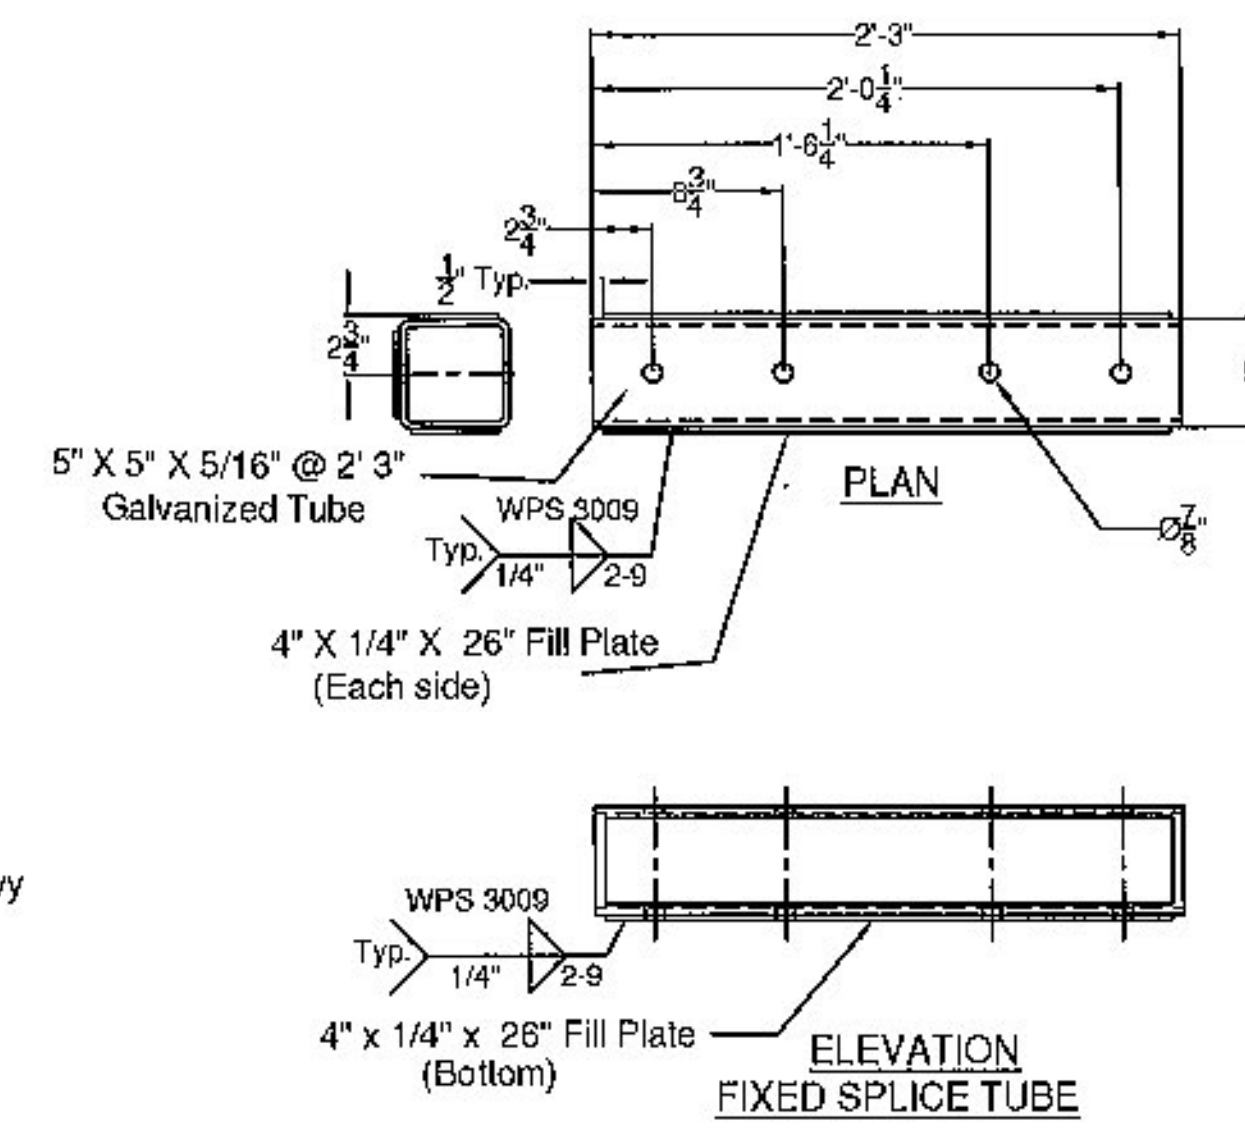
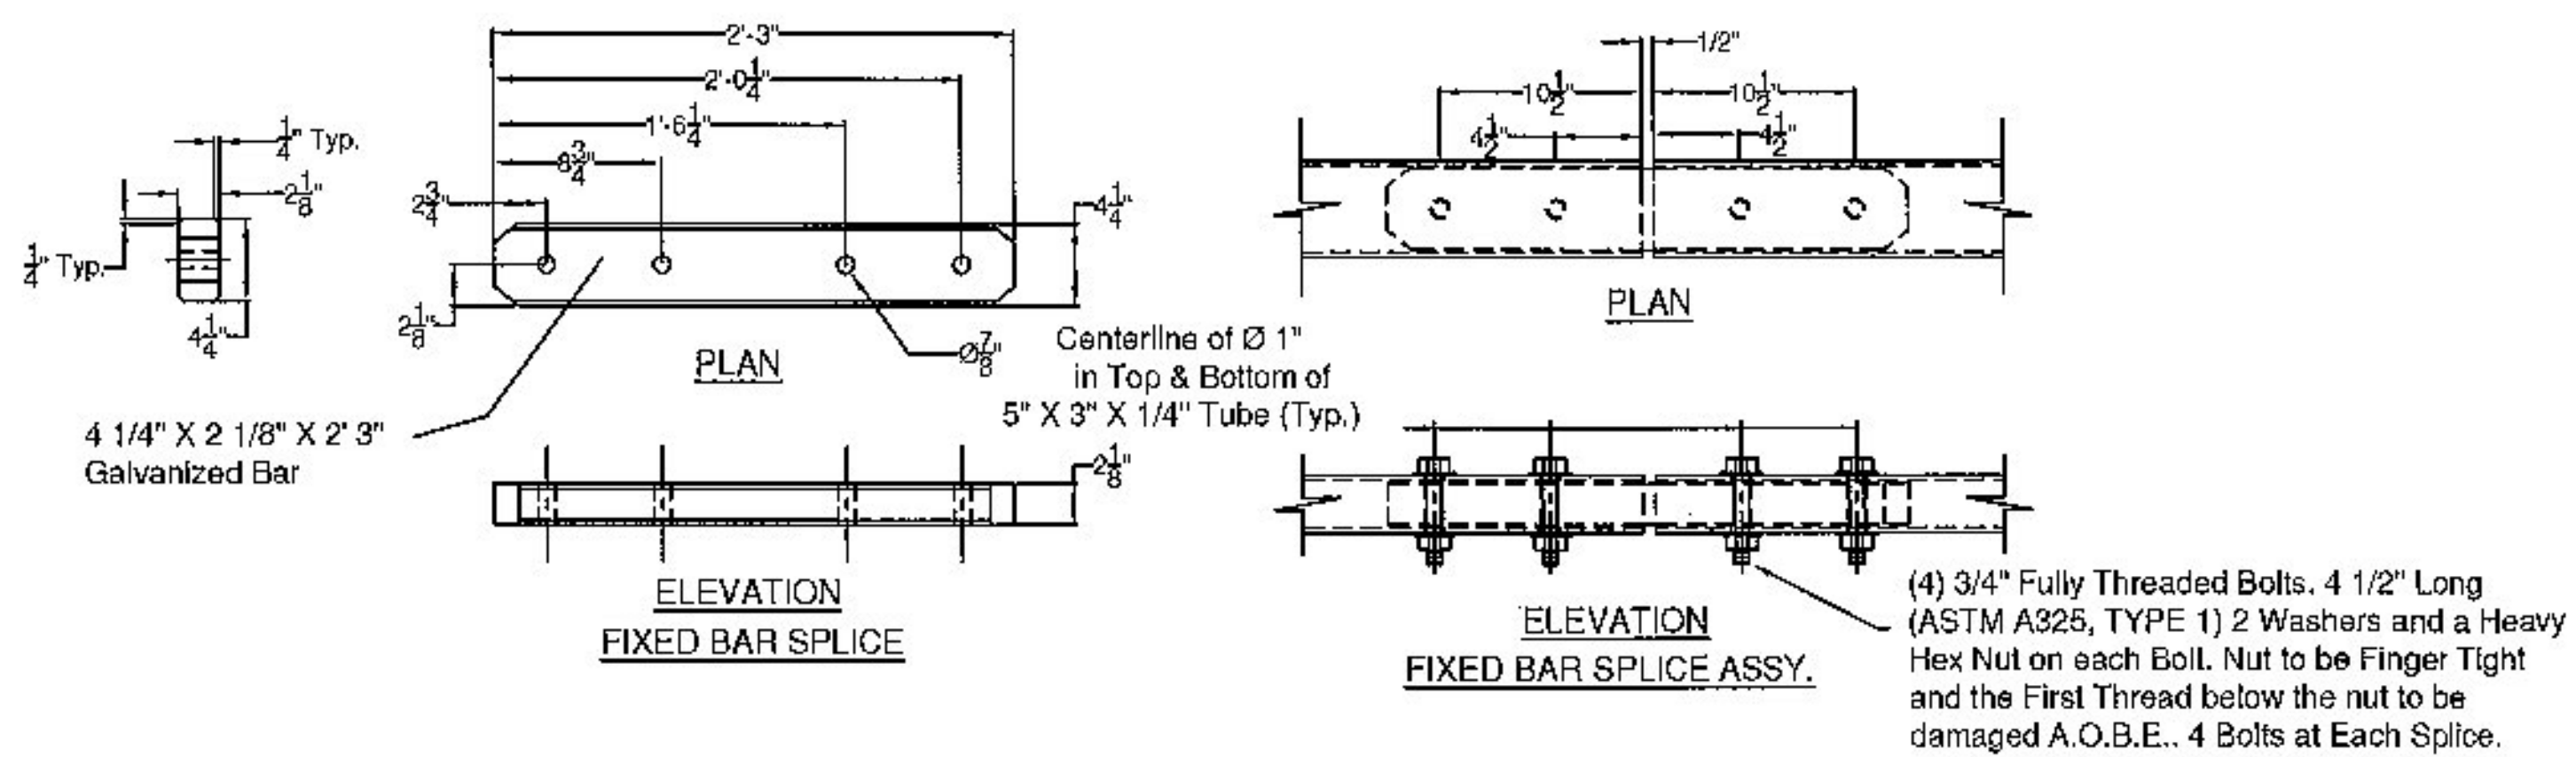
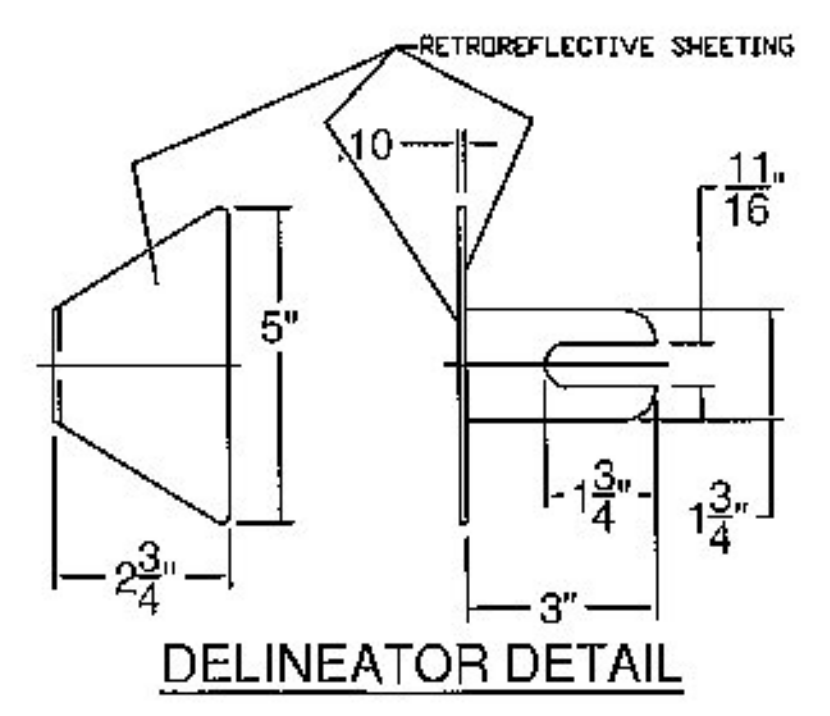
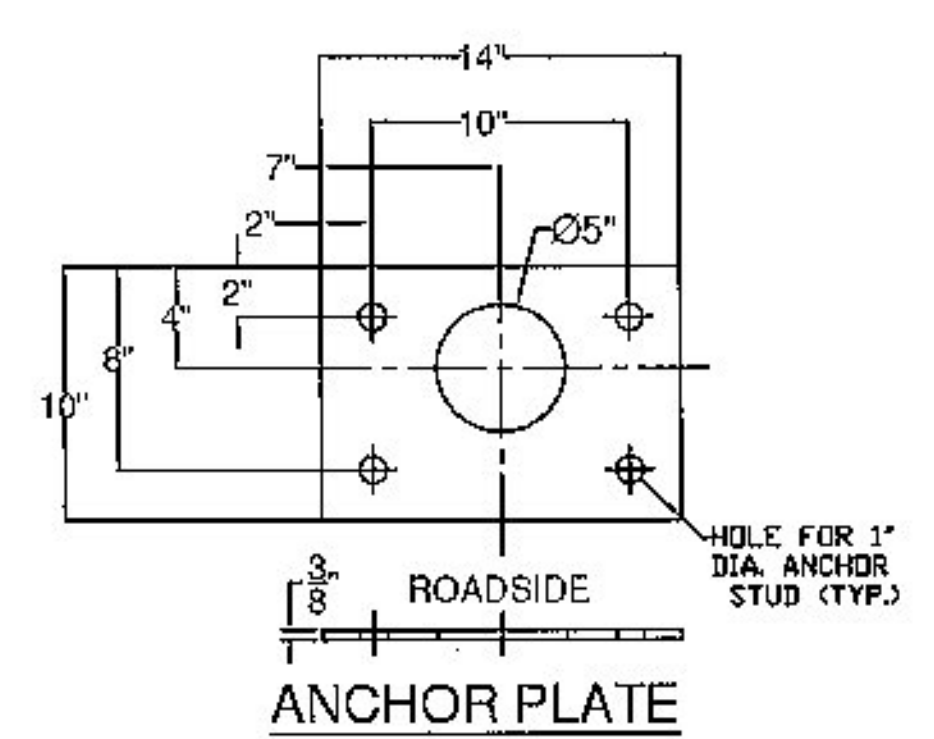


SPLICE BAR - FIXED




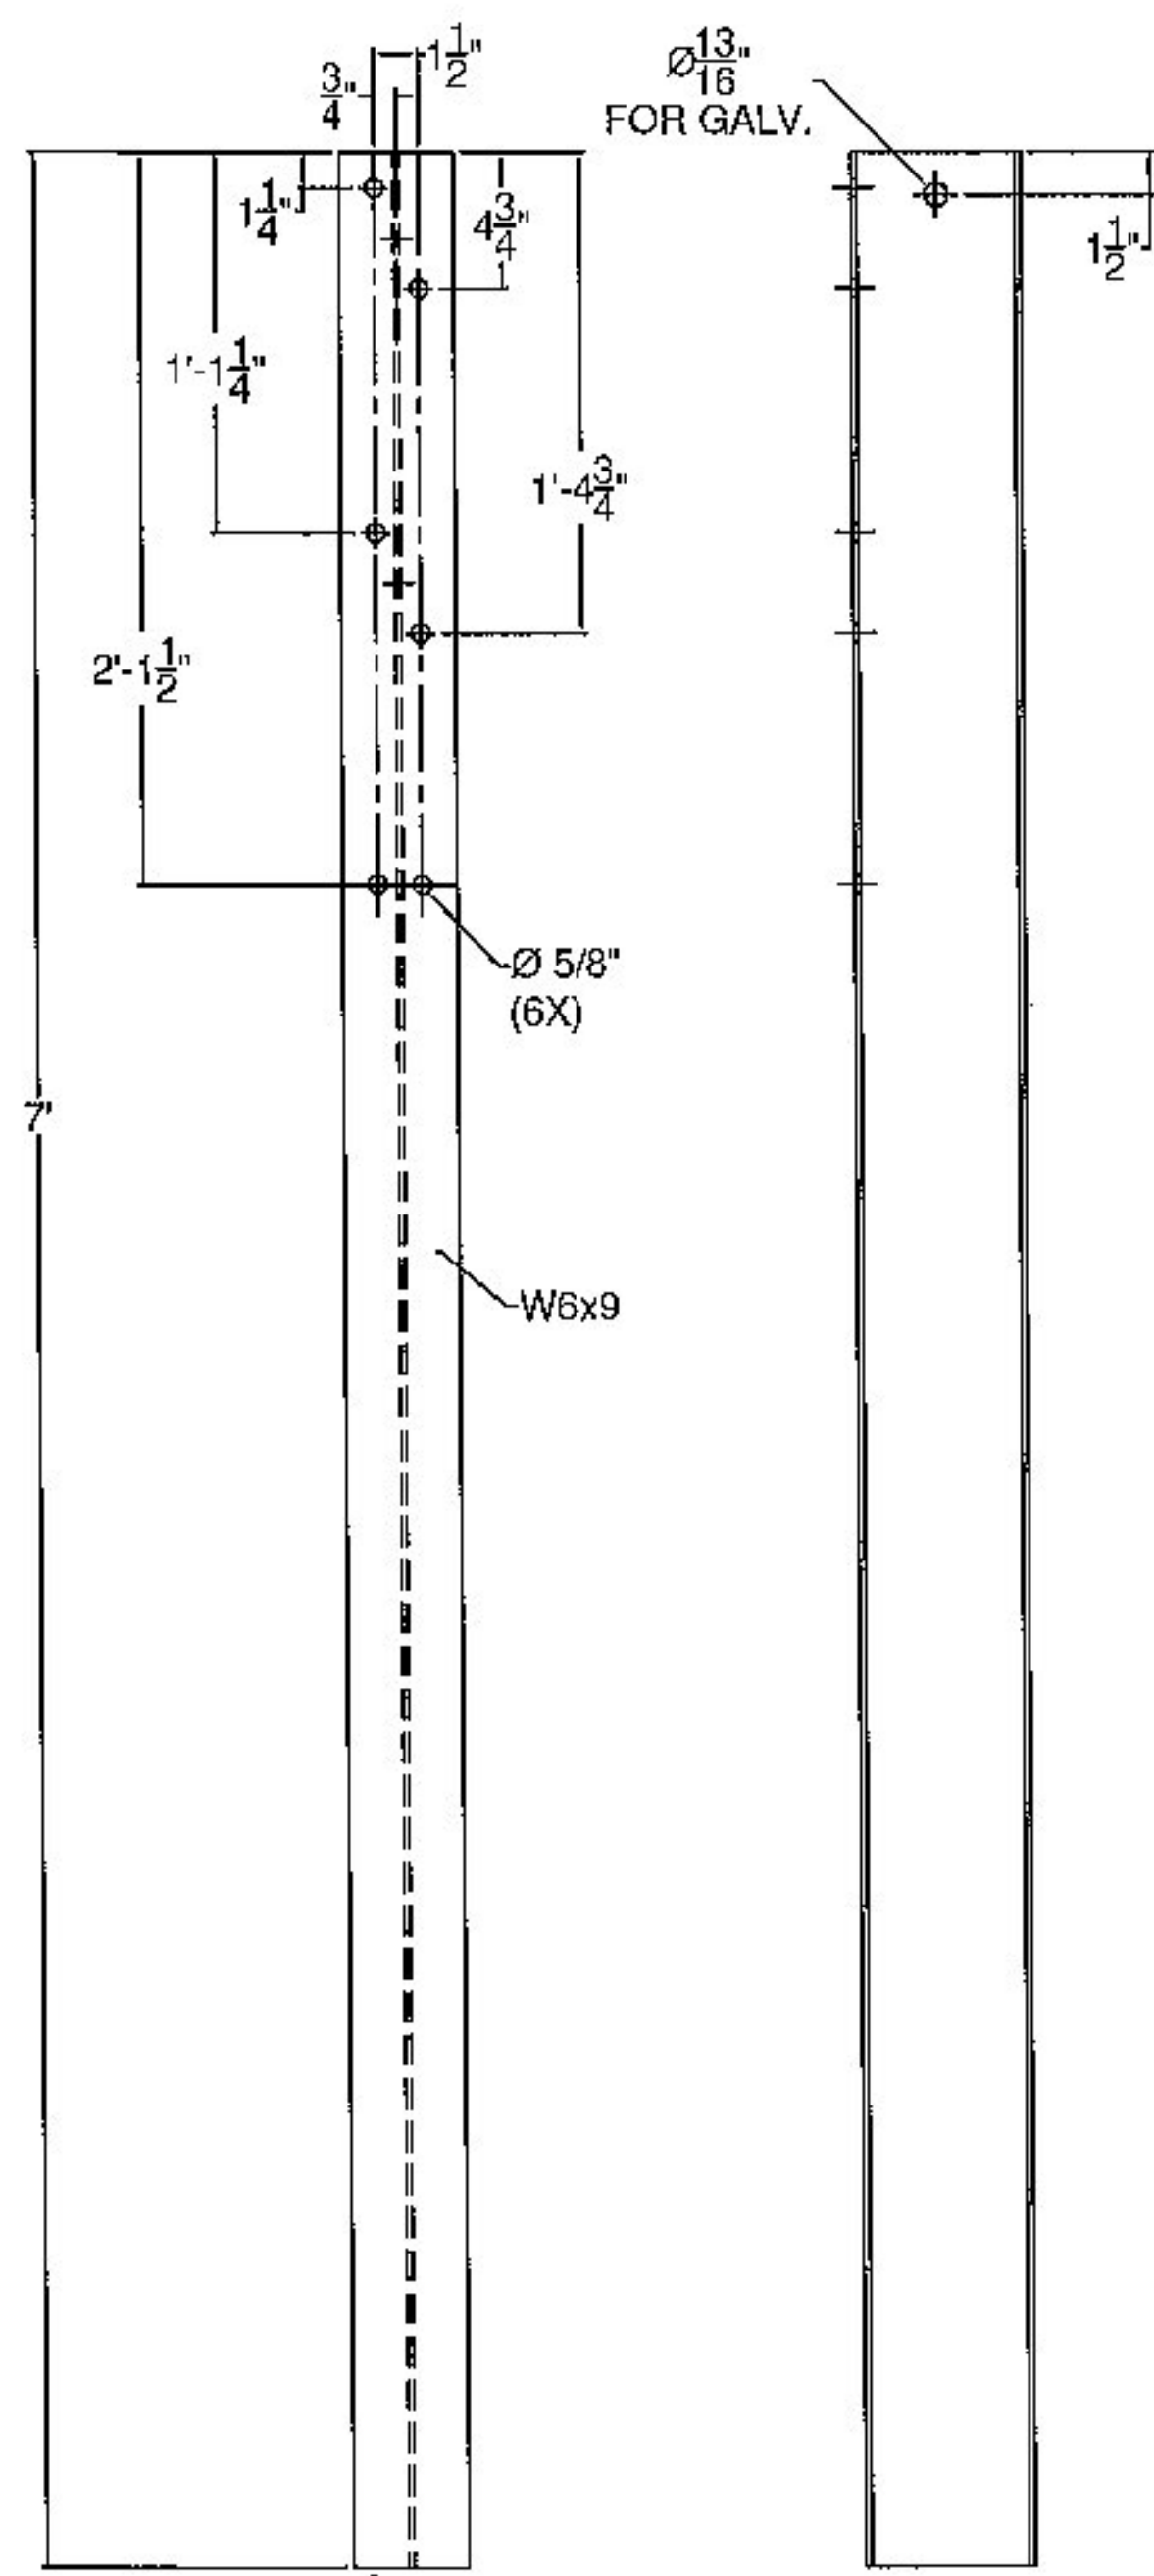


SPLICE TUBE - FIXED

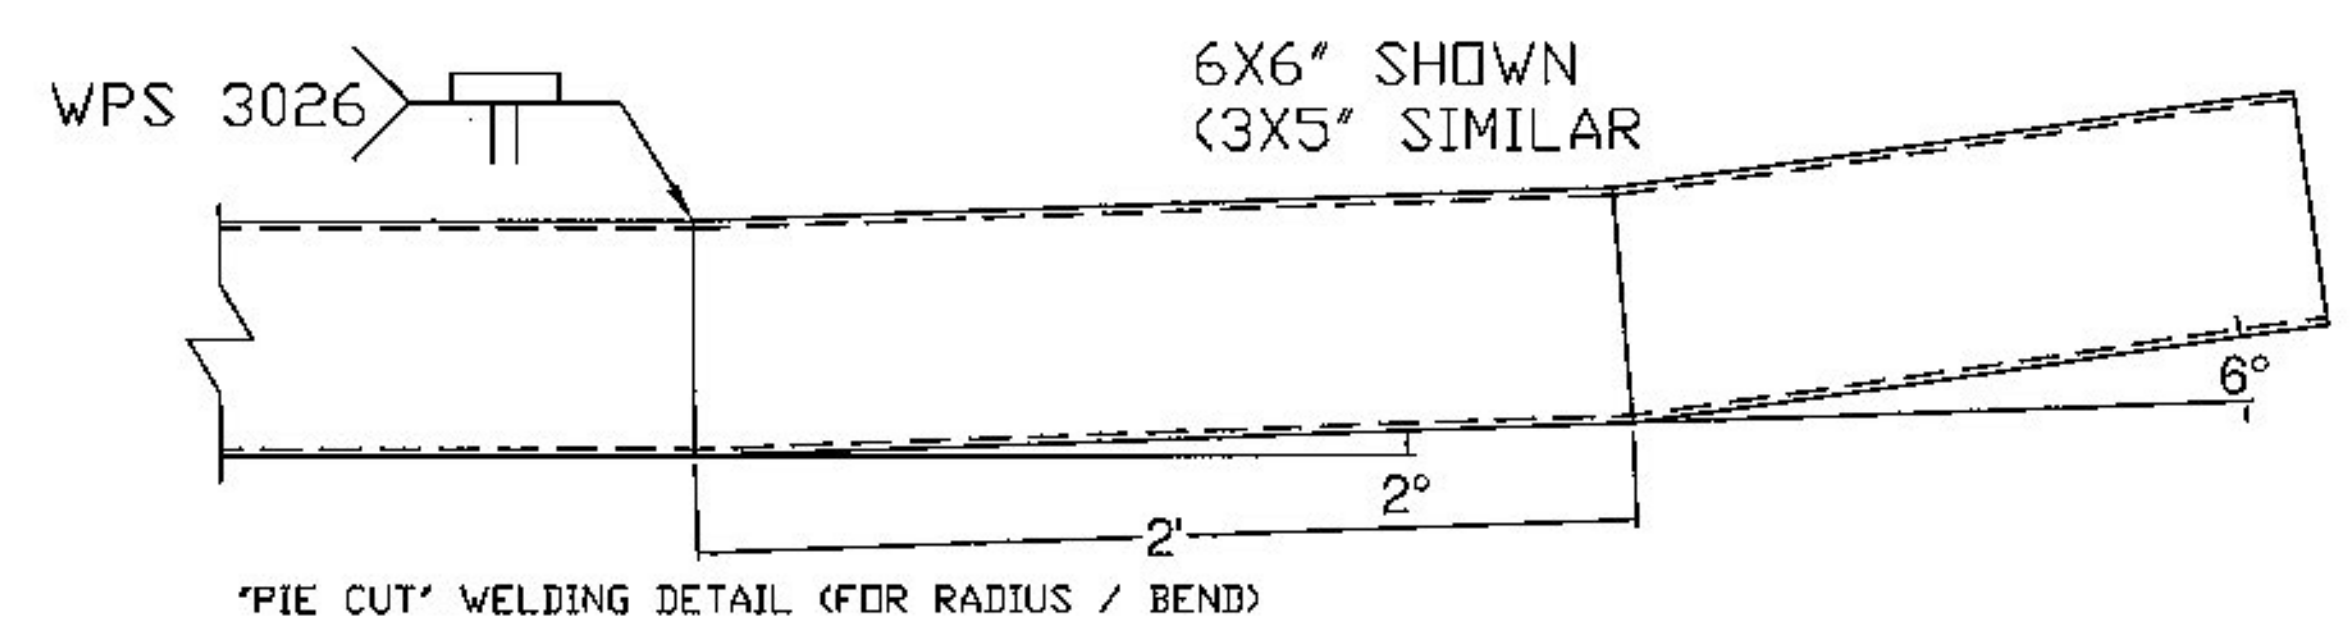

Vermont Agency of Transportation
RECEIVED

CK'D BY CLB OK'D BY HIS
 April 23, 2015
 RESUBMIT NO Approved
 BY Carolyn Carlson DATE 4/29/2015

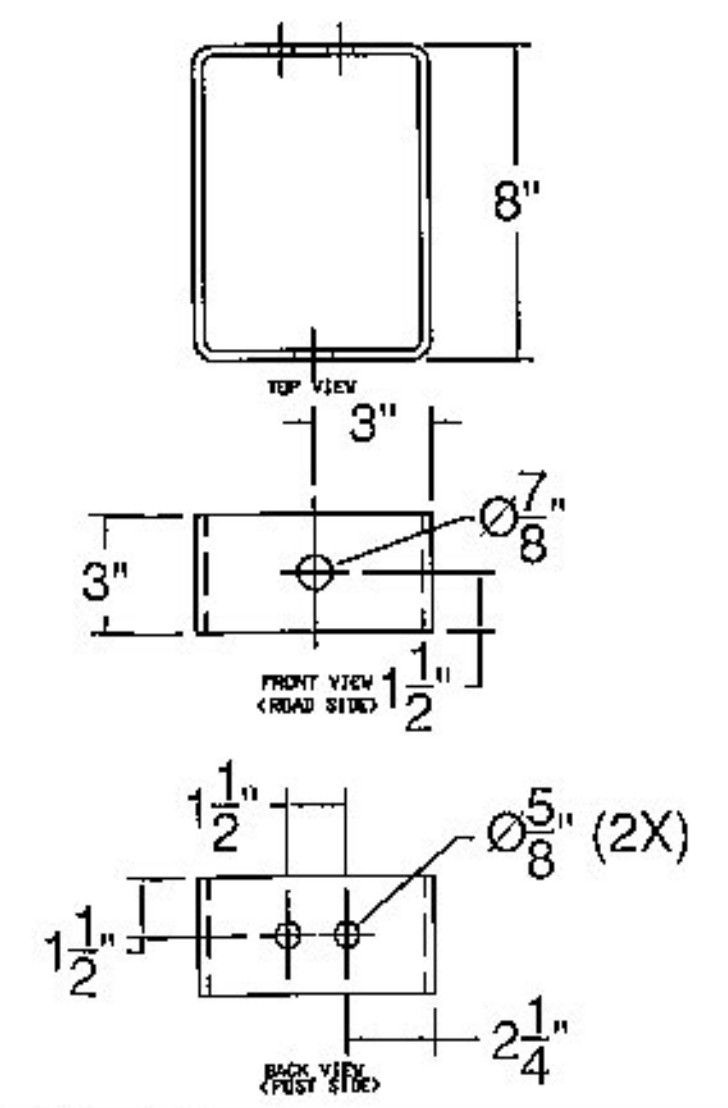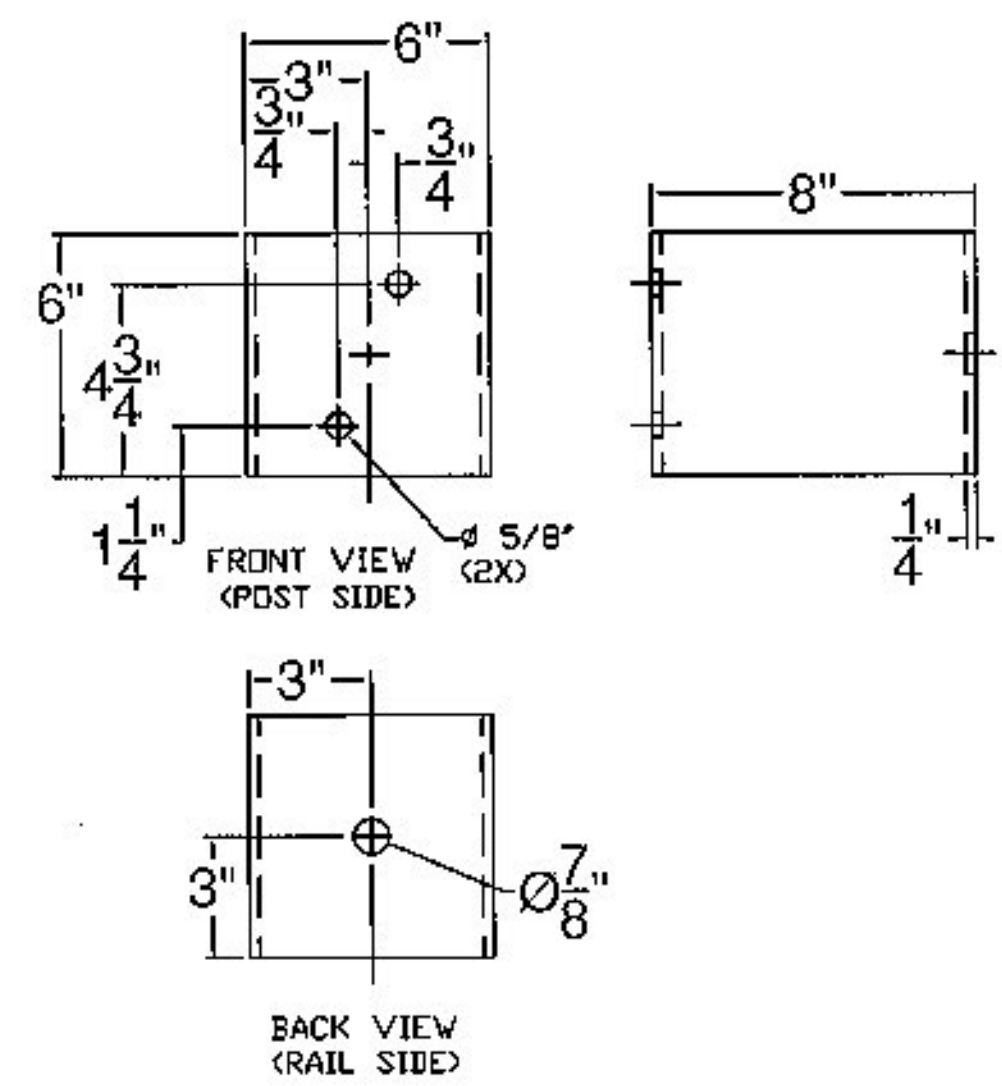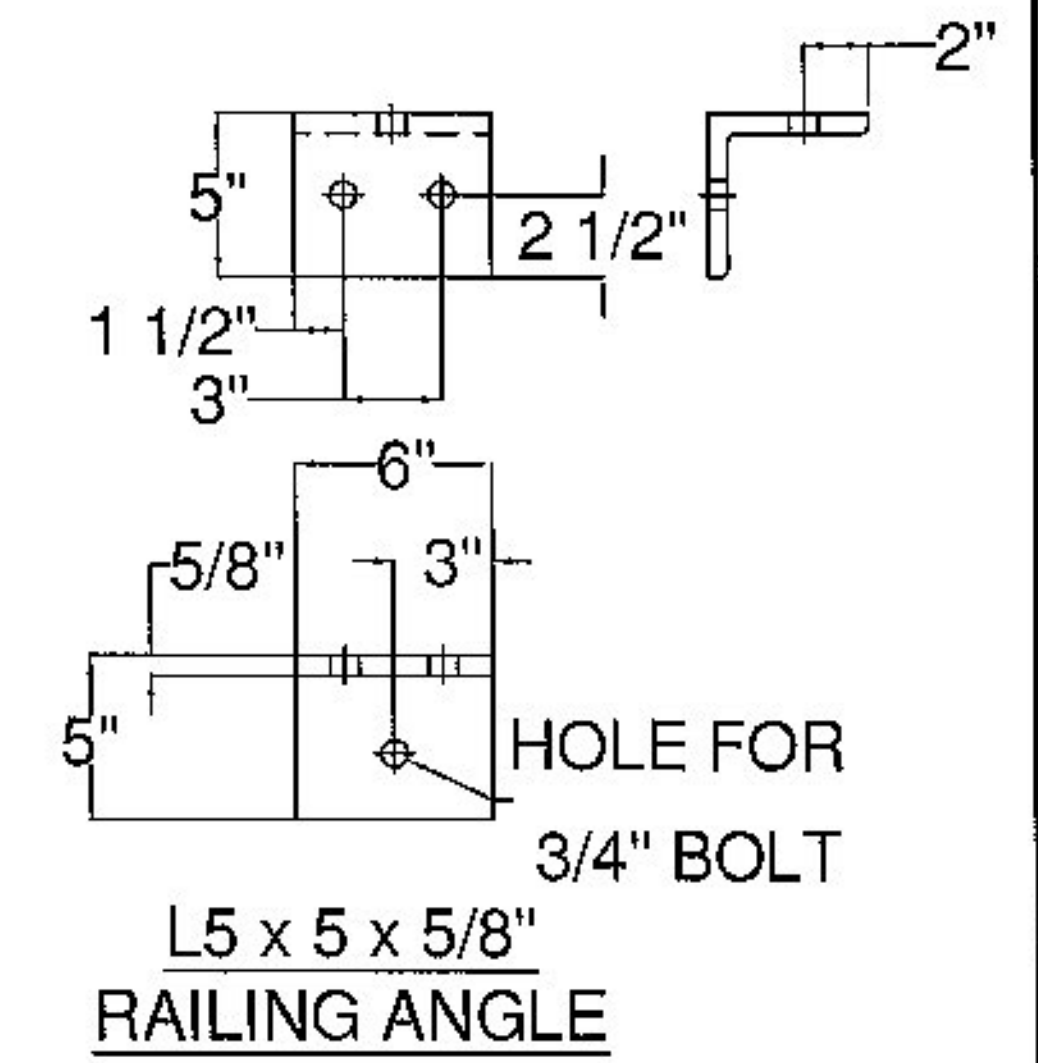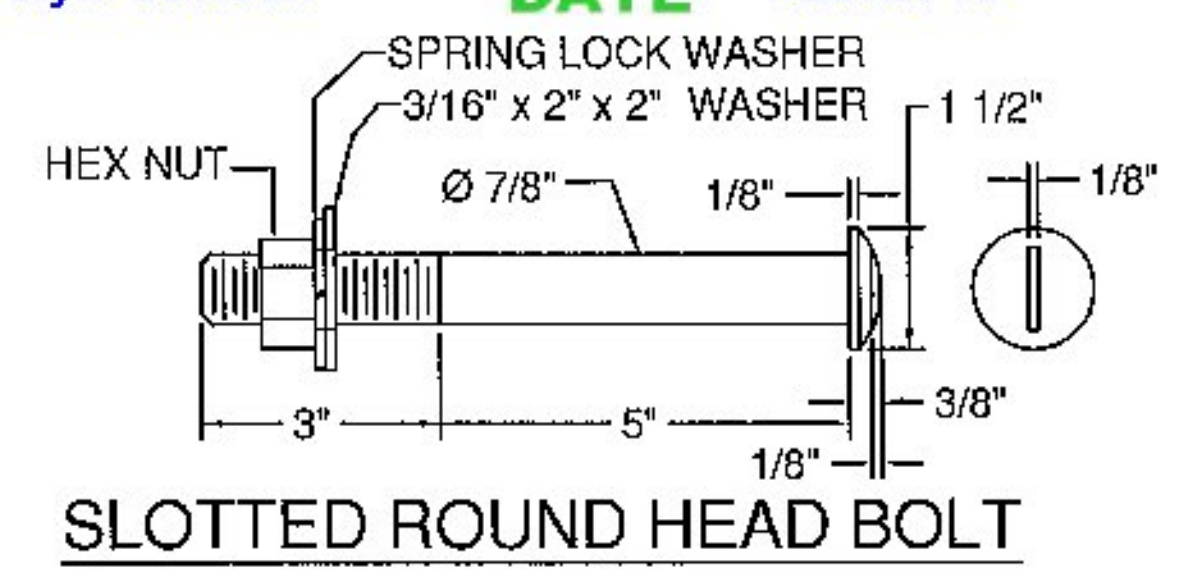

ITEM #: 525.335 SHEET 2 OF 2

STRUCTURAL STEEL TO COMPLY W/ ASTM A6

BRIDGE RAIL DETAILS SHEET
 ROUTE VT 15 (MINOR ARTERIAL), BRIDGE # 83
 TOWN OF WALDEN, COUNTY OF CALEDONIA, VT.

| R NO. | DATE | DESCRIPTION | BY | R NO. | DATE | DESCRIPTION | BY |
|-------|---------|---------------------------|------|-------|------|-------------|----|
| E 1 | 4/16/15 | Revised Per 4/1/15 Markup | E.P. | | | | |
| V | | | V | | | | |

TOLERANCE UNLESS OTHERWISE NOTED:
 FRACTIONS = $\pm 1/16"$
 ANGLES = $\pm 1/2^\circ$
 DIAMETERS = $\pm 1/32"$

ELDERLEE, INC.
 OAKS CORNERS, NEW YORK 14518
 E-Mail: dlong@elderlee.com, epesk@elderlee.com
 Tel: 315-789-6670 Fax: 315-789-6615

DRAWN E.P. 2/20/15
 CHECKED D.L. 2/23/15
 APPROVED
 SCALE SCHEMATIC
 DRAWING NO. F.R. LAFAYETTE-WALDEN