



Water repellent, silane to be applied to exposed surfaces. (By Others)

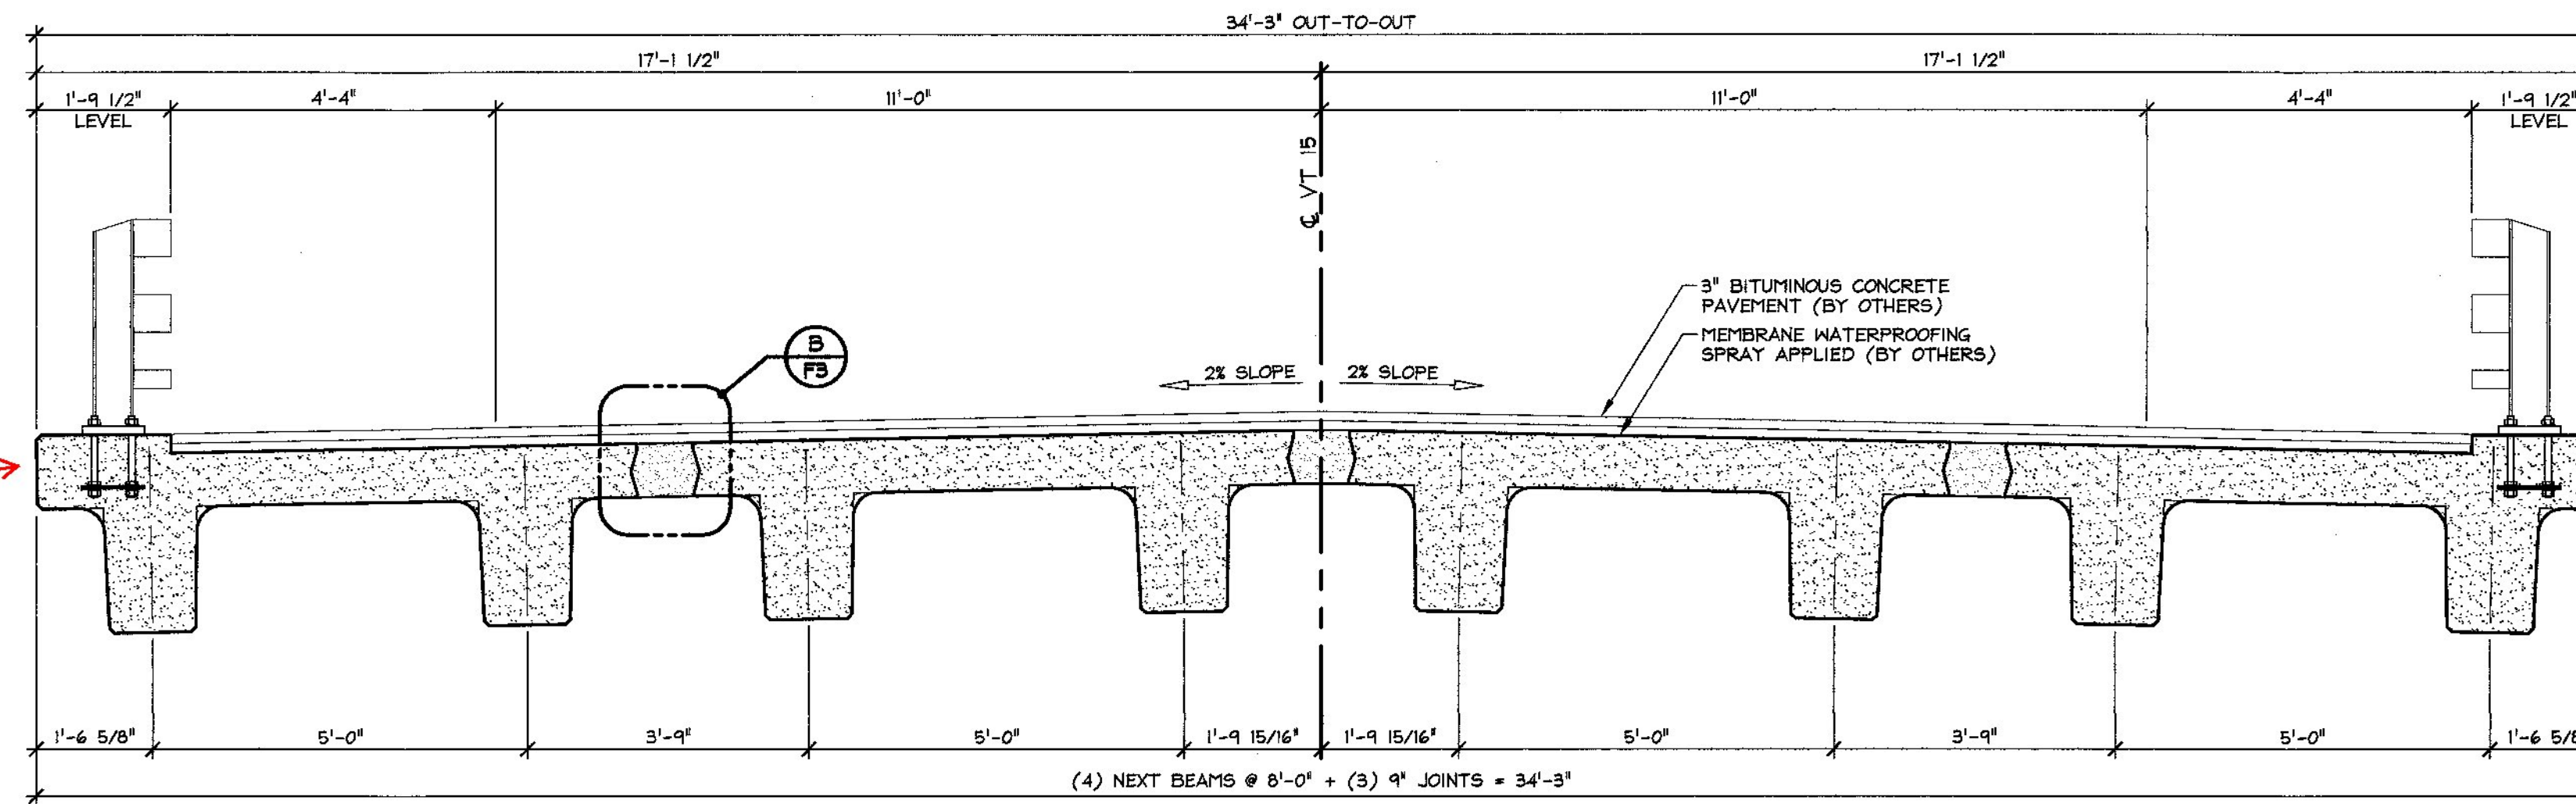

1 TRANSVERSE SECTION  
F2 1/2" = 1'-0"

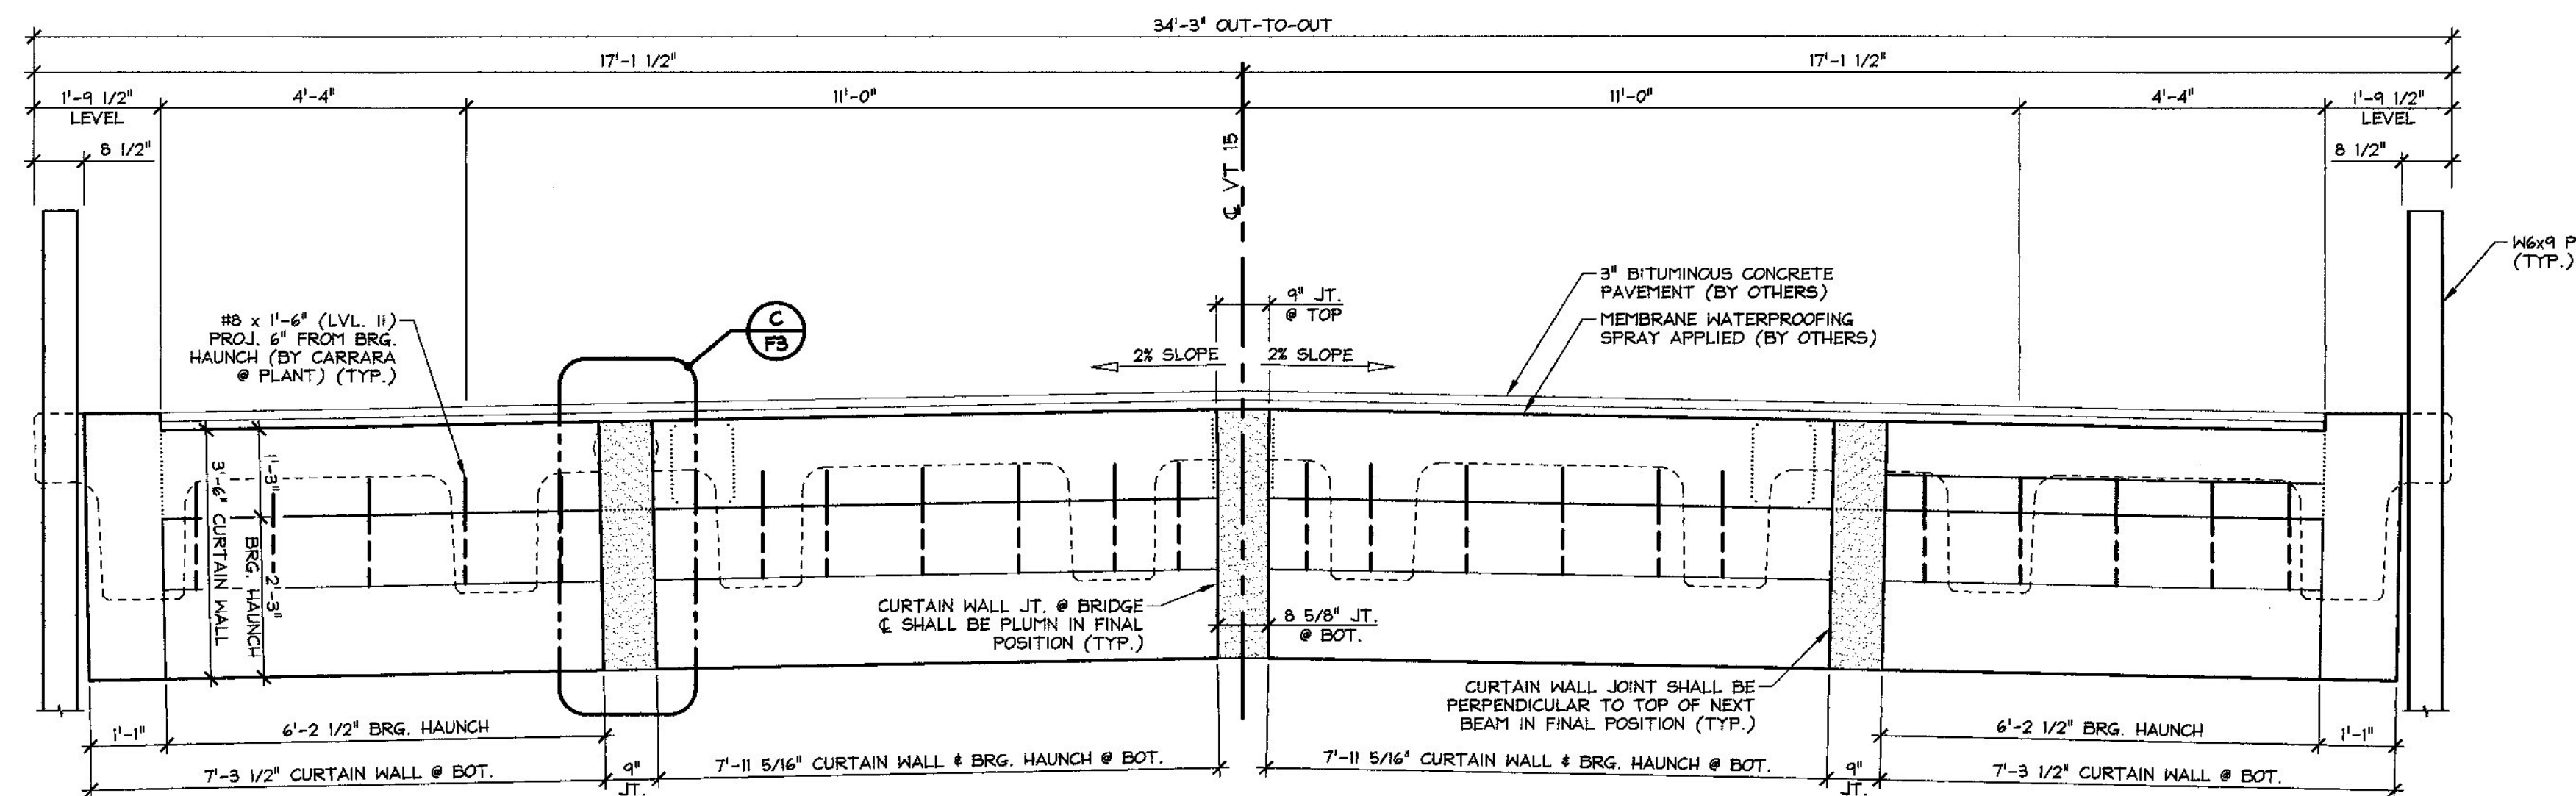

2 CURTAIN WALL ELEVATION  
F2 1/2" = 1'-0"

Vermont Agency of Transportation  
**RECEIVED**

CK'D BY CLB OK'D BY HIS  
April 13, 2015  
RESUBMIT NO Approved AsNoted  
BY C. CARLSON DATE 04/15/15

4-13-15 REVISED PER V.A.T. COMMENTS

|                 |   |  |  |                   |
|-----------------|---|--|--|-------------------|
| APPROVAL STAMP: | <b>J.P. CARRARA &amp; SONS INC.</b><br>Precast & Prestress Manufacturer<br>2464 OISE ST., MIDDLEBURY, VERMONT 05753 Phone: (802)388-8361 Fax: (802)388-8010 |  | <b>J.A. McDONALD, INC.</b><br>CONTRACTOR<br>LYNDON CENTER, VERMONT |                   |
|                 | STATE OF VERMONT AGENCY OF TRANSPORTATION<br>COUNTY OF CALEDONIA  |  | DATE: FEB. 26, 2015  | SCALE: NOTED      |
|                 | TOWN OF WALDEN<br>VT ROUTE NO. 15 (MINOR ARTERIAL) OVER JOE'S BROOK<br>BRIDGE NO.: 83 PROJECT NO.: BRP 030-3(5)   |  | CHKD: P.C. DFTM: B.L.  | JOB NO: 23460-015 |
|                 | TRANSVERSE SECTION<br>& CURTAIN WALL ELEVATION  |  | DWG. NO:   | <b>F2</b>         |