


1 DIMENSIONAL PLAN VIEW IN FORM
 NB3 1/4" = 1'-0"

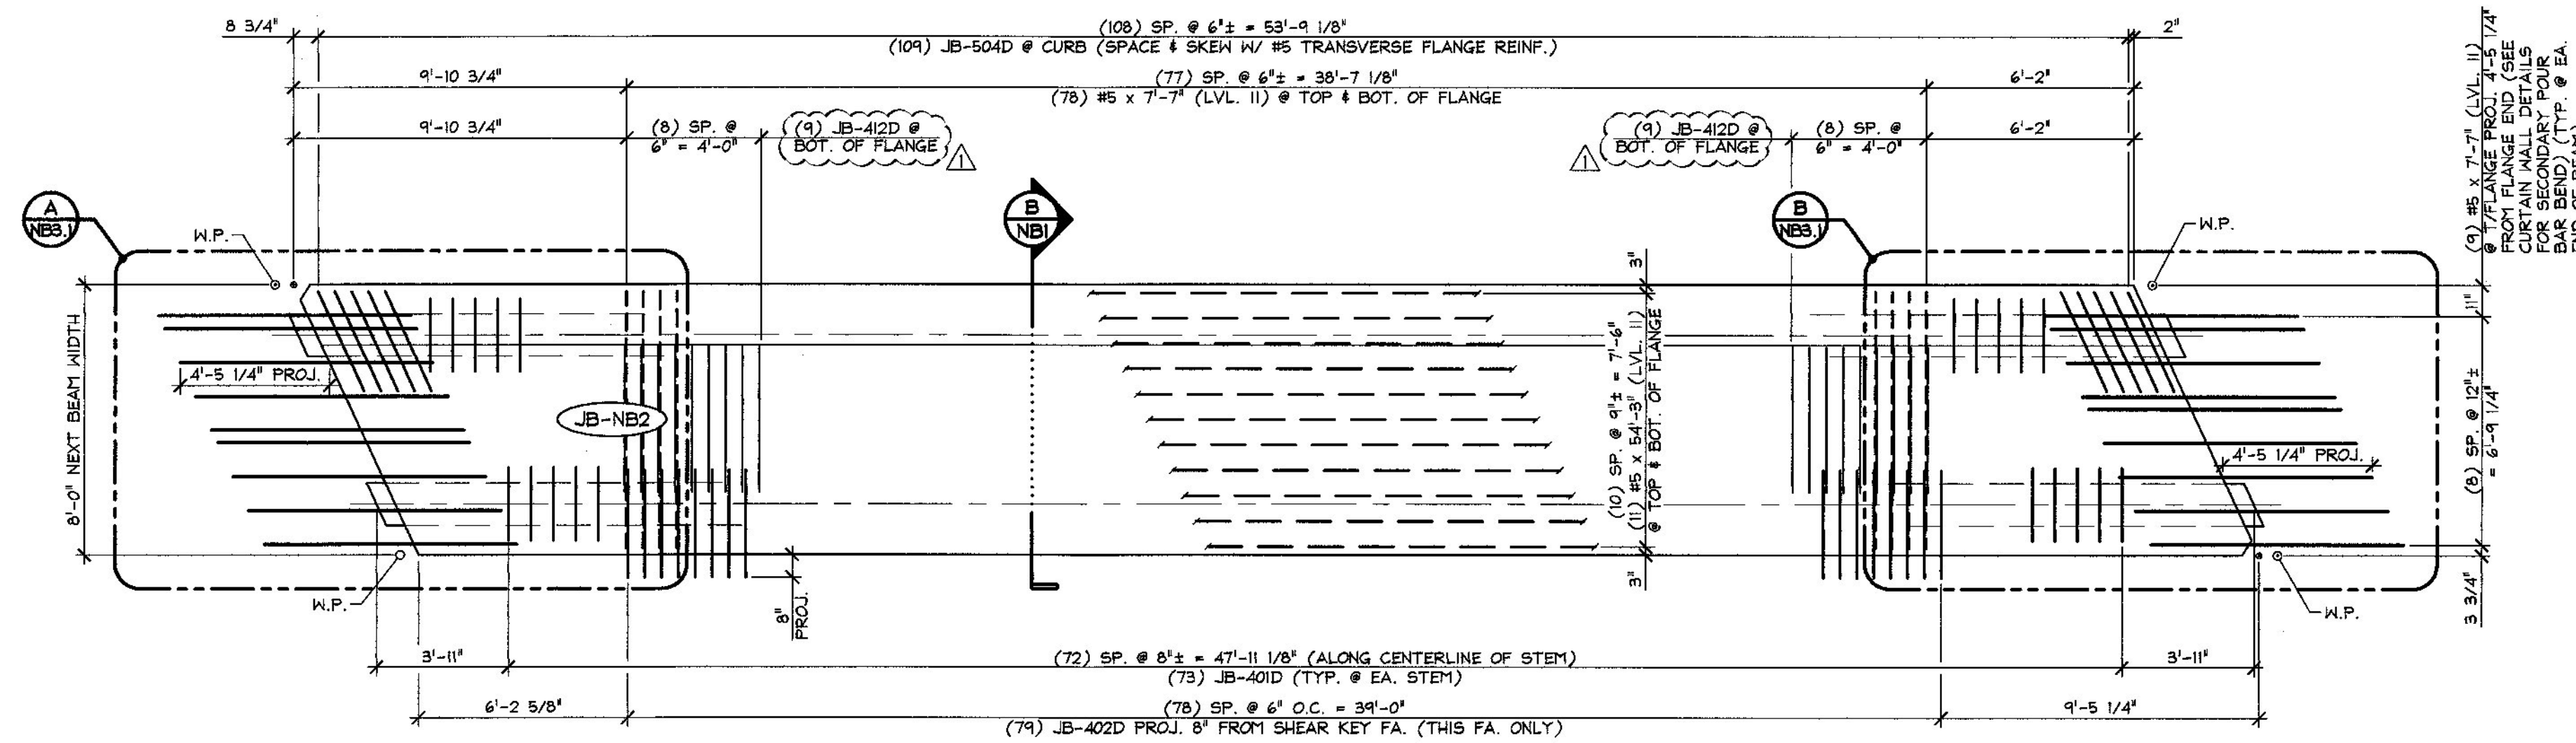

2 REINFORCING PLAN VIEW IN FORM
 NB3 1/4" = 1'-0"

MARK: JB-NB2 QTY.: 2 WT.: 41.82 T VOL.: 20.65 cy

MATERIAL LIST / NEXT BEAM								
ITEM	MARK	DESCRIPTION	QTY.		ITEM	MARK	DESCRIPTION	QTY.
1	JB-401D	#4 BENT BAR (LEVEL II, DUAL COATED)	146		16	JB-503D	#5 BENT BAR (LEVEL II, DUAL COATED)	16
2	JB-402D	#4 BENT BAR (LEVEL II, DUAL COATED)	79		17	JB-504D	#5 BENT BAR (LEVEL II, DUAL COATED)	109
3	JB-403D	#4 BENT BAR (LEVEL II, DUAL COATED)	44		18		#5 x 5'-3" (LEVEL II, DUAL COATED)	22
4	JB-404D	#4 BENT BAR (LEVEL II, DUAL COATED)	22		19		#5 x 7'-7" (LEVEL II, DUAL COATED)	178
5	JB-405D	#4 BENT BAR (LEVEL II, DUAL COATED)	6		20		#5 x 8'-4" (LEVEL II, DUAL COATED)	44
6	JB-406D	#4 BENT BAR (LEVEL II, DUAL COATED)	1		21		#5 x 8'-0 1/2" (LEVEL II, DUAL COATED)	4
7	JB-408D	#4 BENT BAR (LEVEL II, DUAL COATED)	22		22		#5 x 7'-9 3/4" (LEVEL II, DUAL COATED)	4
8	JB-409D	#4 BENT BAR (LEVEL II, DUAL COATED)	2		23		#5 x 7'-8" (LEVEL II, DUAL COATED)	4
9	JB-410D	#4 BENT BAR (LEVEL II, DUAL COATED)	2		24		#5 x 5'-0" (LEVEL II, DUAL COATED)	10
10	JB-411D	#4 BENT BAR (LEVEL II, DUAL COATED)	2		25			
11	JB-412D	#4 BENT BAR (LEVEL II, DUAL COATED)	20		26		GUARD RAIL ANCHOR PLATE (GALV.) (SUPPLIED BY OTHERS)	8
12		#4 x 8'-4" (LEVEL II, DUAL COATED)	22		27		SET OF (4) 0.60" Ø STRAND LIFTING LOOPS	4
13					28			
14					29			
15								

Vermont Agency of Transportation
RECEIVED

CK'D BY CLB OK'D BY HIS

April 13, 2015

RESUBMIT NO Approved
 BY C. CARLSON DATE 04/15/15

4-13-15 REVISED PER V.A.T. COMMENTS

APPROVAL STAMP:

J.P. CARRARA & SONS INC.
 Precast & Prestress Manufacturer
 2444 CASE ST., MIDDLEBURY, VERMONT 05753 Phone: (802)388-8361 Fax: (802)388-9010

J.A. McDONALD, INC.
 CONTRACTOR
 LYNDON CENTER, VERMONT

STATE OF VERMONT AGENCY OF TRANSPORTATION
 COUNTY OF CALEDONIA

TOWN OF WALDEN
 VT ROUTE NO. 15 (MINOR ARTERIAL) OVER JOE'S BROOK
 BRIDGE NO.: 83 PROJECT NO.: BRP 030-3(5)

DATE: FEB. 26, 2015
 SCALE: NOTED
 CHKD: P.C. DFTM: B.L.
 JOB NO: 23460-015

PRESTRESSED NEXT BEAM DETAILS
 DWG. NO: NB3