

604.412 OR 604.415 REHAB.
DIS. CBS OR MHS. CLASS I OR II
STA. 45+93, LT
STA. 47+94, LT

629.20 ADJUST ELEVATION OF VALVE BOX
STA. 50+70, LT
STA. 50+72, LT

621.205 STEEL BEAM GUARDRAIL,
GALVANIZED W/8 FEET POSTS
STA. 45+50.0 TO 51+50.0, RT

621.80 REMOVAL AND DISPOSAL OF GUARDRAIL
STA. 45+50 TO 51+50, RT

646.412 DURABLE 4 INCH YELLOW LINE, THERMOPLASTIC OR
646.413 DURABLE 4 INCH YELLOW LINE, EPOXY PAINT OR
646.414 DURABLE 4 INCH YELLOW LINE, POLYUREA
(ALL LINES WILL INCLUDE C BREAKS FOR SIDE ROADS)
STA. 45+50 TO 51+50, SOLID LT & RT

646.422 DURABLE 6 INCH WHITE LINE, THERMOPLASTIC OR
646.423 DURABLE 6 INCH WHITE LINE, EPOXY PAINT OR
646.424 DURABLE 6 INCH WHITE LINE, POLYUREA
(ALL LINES WILL INCLUDE EDGE LINE BREAKS AND
RADI FOR SIDE ROADS)
STA. 45+50 TO 51+50, SOLID LT & RT

646.442 DURABLE 8 INCH WHITE LINE, THERMOPLASTIC OR
646.443 DURABLE 8 INCH WHITE LINE, EPOXY PAINT OR
646.444 DURABLE 8 INCH WHITE LINE, POLYUREA
STA. 47+03 TO 47+15, LT (HYDRANT)

646.492 DURABLE LETTER OR SYMBOL OR
646.493 DURABLE LETTER OR SYMBOL, EPOXY PAINT OR
646.494 DURABLE LETTER OR SYMBOL, POLYUREA
STA. 46+19, LT - BIKE LANE ARROW
STA. 46+31, LT - BIKE LANE SYMBOL


646.612 TEMPORARY 4 INCH YELLOW LINE, PAINT
(ALL LINES WILL INCLUDE C BREAKS FOR SIDE ROADS)
STA. 45+50 TO 51+50, SOLID LT & RT

646.622 TEMPORARY 6 INCH WHITE LINE, PAINT
(ALL LINES WILL INCLUDE EDGE LINE BREAKS AND
RADI FOR SIDE ROADS)
STA. 45+50 TO 51+50, SOLID LT & RT

646.642 TEMPORARY 8 INCH WHITE LINE, PAINT
STA. 47+03 TO 47+15, LT (HYDRANT)

646.692 TEMPORARY LETTER OR SYMBOL, PAINT
STA. 46+19, LT - BIKE LANE ARROW
STA. 46+31, LT - BIKE LANE SYMBOL

675.50 REMOVING SIGNS
AS SHOWN - 5

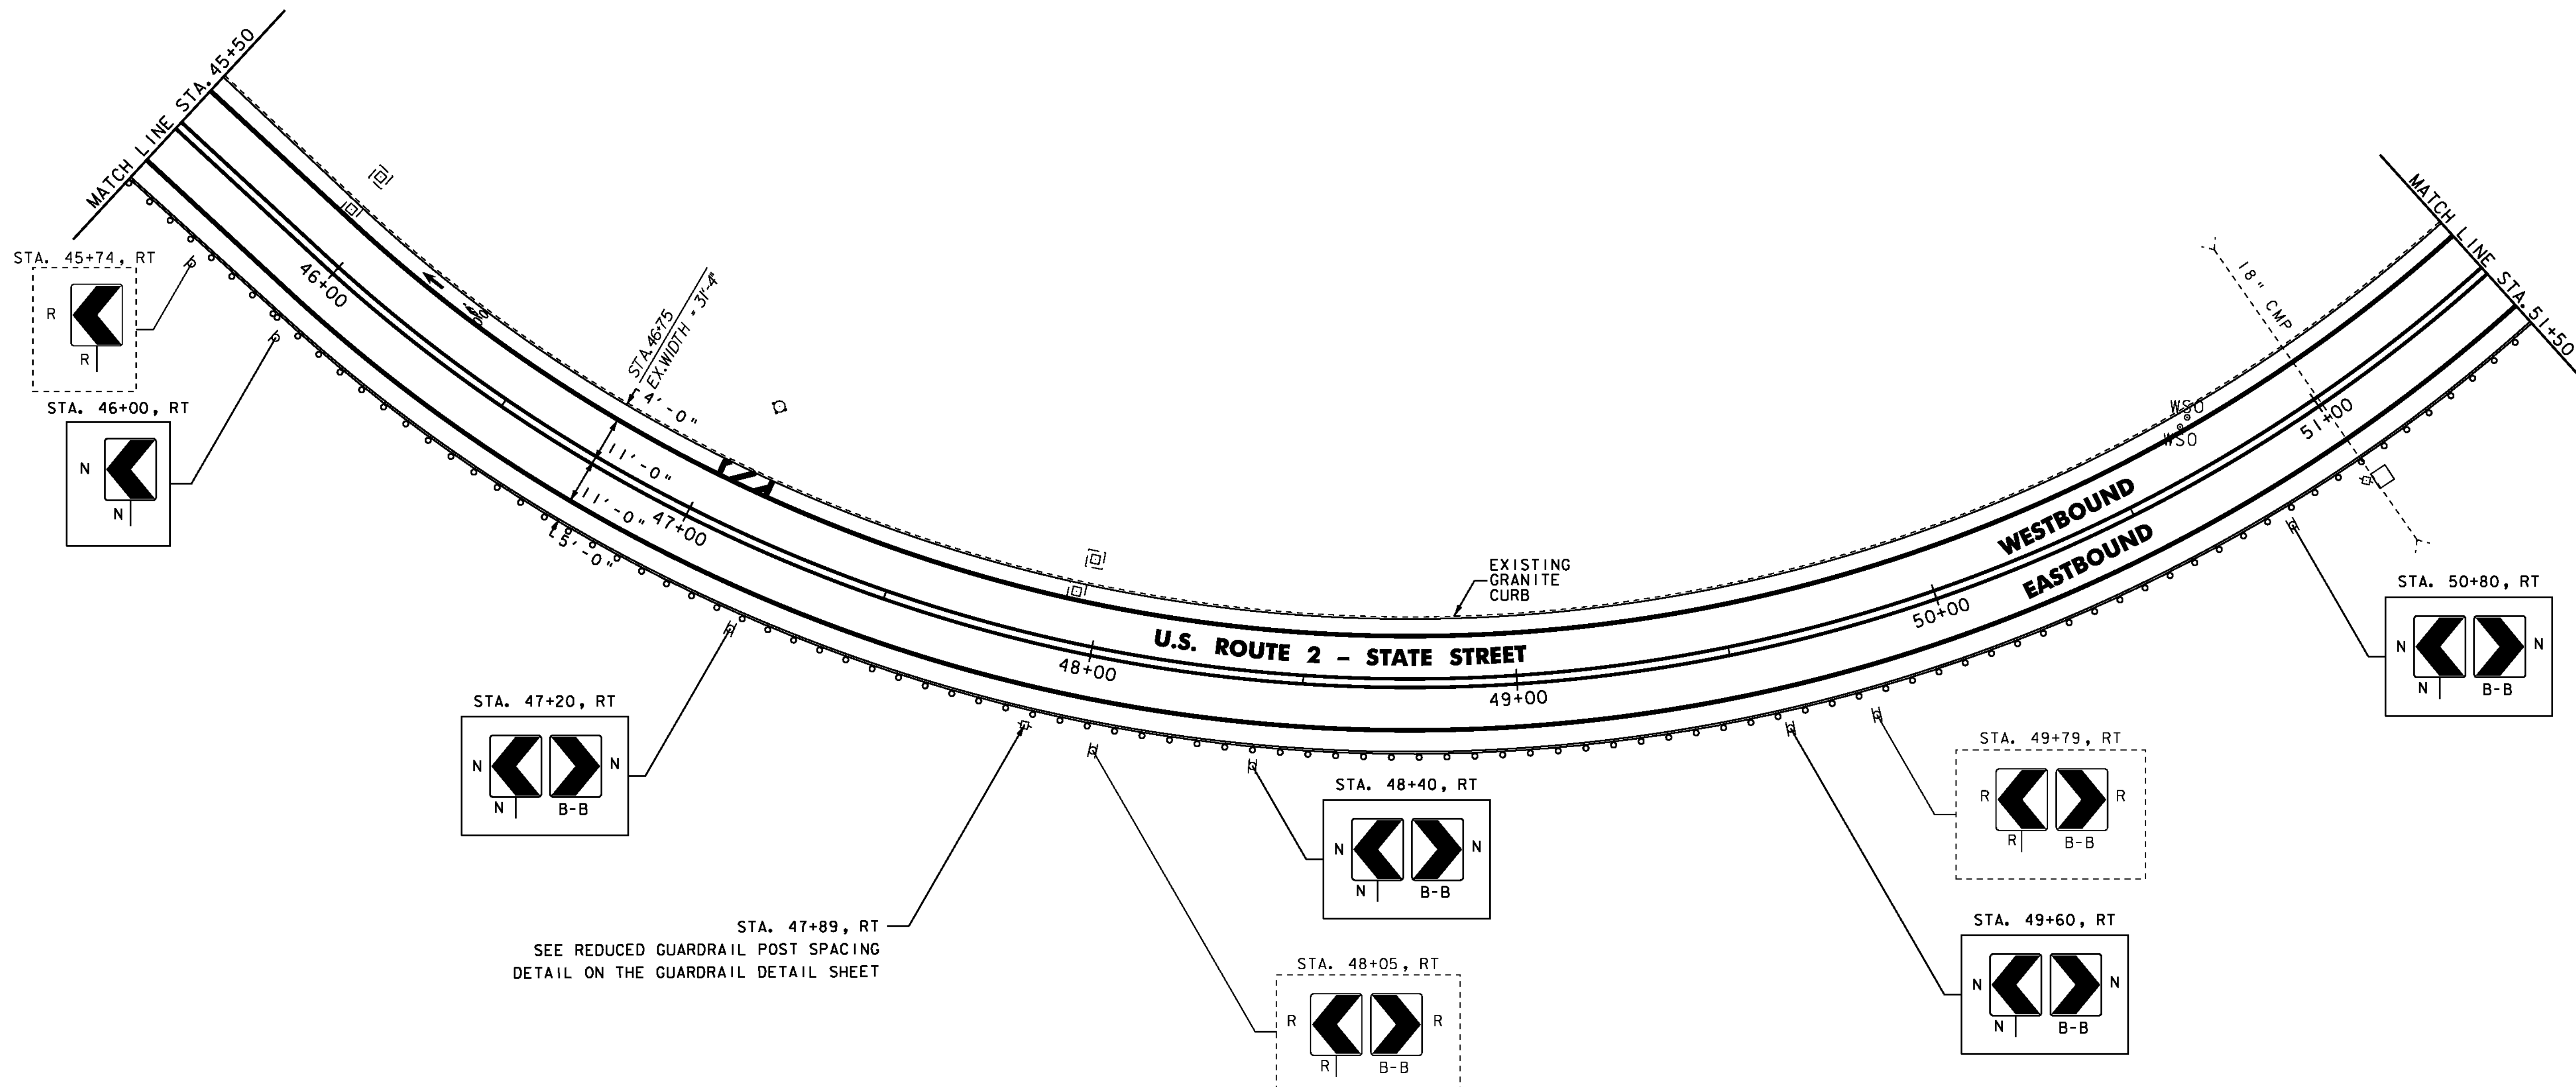

STA. 47+89, RT
SEE REDUCED GUARDRAIL POST SPACING
DETAIL ON THE GUARDRAIL DETAIL SHEET

NOTES: 1. FOR LEGENDS, SEE LAYOUT SHEET #1
2. ALL EXISTING SIGNS NOT SHOWN SHALL
BE RETAINED.

NOT TO SCALE

**PROJECT
LAYOUT
SHEET #6**

PROJECT NAME: MONTPELIER
PROJECT NUMBER: STP 2905(1)

FILE NAME: pl0dl16.dgn
PROJECT LEADER: JLL
DESIGNED BY: STANTEC
IPARM FILE: p10d116106.i

PLOT DATE: 26-MAY-2011
DRAWN BY: STANTEC
CHECKED BY: STANTEC
SHEET 21 OF 79

