

604.412 OR 604.415 REHAB.
DIS. CBS OR MHS, CLASS I OR II
STA. 77+03, LT
STA. 79+42, LT

629.20 ADJUST ELEVATION OF VALVE BOX
STA. 79+44, RT
STA. 80+15, RT
STA. 80+56, LT
STA. 80+56, LT

621.205 STEEL BEAM GUARDRAIL,
GALVANIZED W/8 FEET POSTS
STA. 75+50.0 TO 79+03.5, RT
STA. 79+28.5 TO 79+41.0, RT

621.207 STEEL BEAM GUARDRAIL,
GALVANIZED/NESTED W/8 FEET POSTS
STA. 79+03.5 TO 79+28.5, RT
(SEE DETAIL ON GUARDRAIL DETAIL SHEET)

621.60 ANCHOR FOR STEEL BEAM RAIL
STA. 79+41, RT

621.80 REMOVAL AND DISPOSAL OF GUARDRAIL
STA. 75+50 TO 79+41, RT

646.412 DURABLE 4 INCH YELLOW LINE, THERMOPLASTIC OR
646.413 DURABLE 4 INCH YELLOW LINE, EPOXY PAINT OR
646.414 DURABLE 4 INCH YELLOW LINE, POLYUREA
(ALL LINES WILL INCLUDE C BREAKS FOR SIDE ROADS)
STA. 75+50 TO 81+50, SOLID LT & RT

646.422 DURABLE 6 INCH WHITE LINE, THERMOPLASTIC OR
646.423 DURABLE 6 INCH WHITE LINE, EPOXY PAINT OR
646.424 DURABLE 6 INCH WHITE LINE, POLYUREA
(ALL LINES WILL INCLUDE EDGE LINE BREAKS AND
RADIi FOR SIDE ROADS)
STA. 75+50 TO 81+50, SOLID LT & RT

646.442 DURABLE 8 INCH WHITE LINE, THERMOPLASTIC OR
646.443 DURABLE 8 INCH WHITE LINE, EPOXY PAINT OR
646.444 DURABLE 8 INCH WHITE LINE, POLYUREA
STA. 80+50 TO 80+62, LT (HYDRANT)

646.492 DURABLE LETTER OR SYMBOL, THERMOPLASTIC OR
646.493 DURABLE LETTER OR SYMBOL, EPOXY PAINT OR
646.494 DURABLE LETTER OR SYMBOL, POLYUREA
STA. 80+88, RT "SIGNAL"
STA. 81+08, LT - BIKE LANE ARROW
STA. 81+20, LT - BIKE LANE SYMBOL
STA. 81+20, RT "AHEAD"

646.612 TEMPORARY 4 INCH YELLOW LINE, PAINT
(ALL LINES WILL INCLUDE C BREAKS FOR SIDE ROADS)
STA. 75+50 TO 81+50, SOLID LT & RT


646.622 TEMPORARY 6 INCH WHITE LINE, PAINT
(ALL LINES WILL INCLUDE EDGE LINE BREAKS AND
RADIi FOR SIDE ROADS)
STA. 75+50 TO 81+50, SOLID LT & RT

646.642 TEMPORARY 8 INCH WHITE LINE, PAINT
STA. 80+50 TO 80+62, LT (HYDRANT)

646.692 TEMPORARY LETTER OR
SYMBOL, PAINT
STA. 80+88, RT "SIGNAL"
STA. 81+08, LT - BIKE LANE ARROW
STA. 81+20, LT - BIKE LANE SYMBOL
STA. 81+20, RT "AHEAD"

675.50 REMOVING SIGNS
AS SHOWN - 12

675.60 ERECTING SALVAGED SIGNS
AS SHOWN - 2

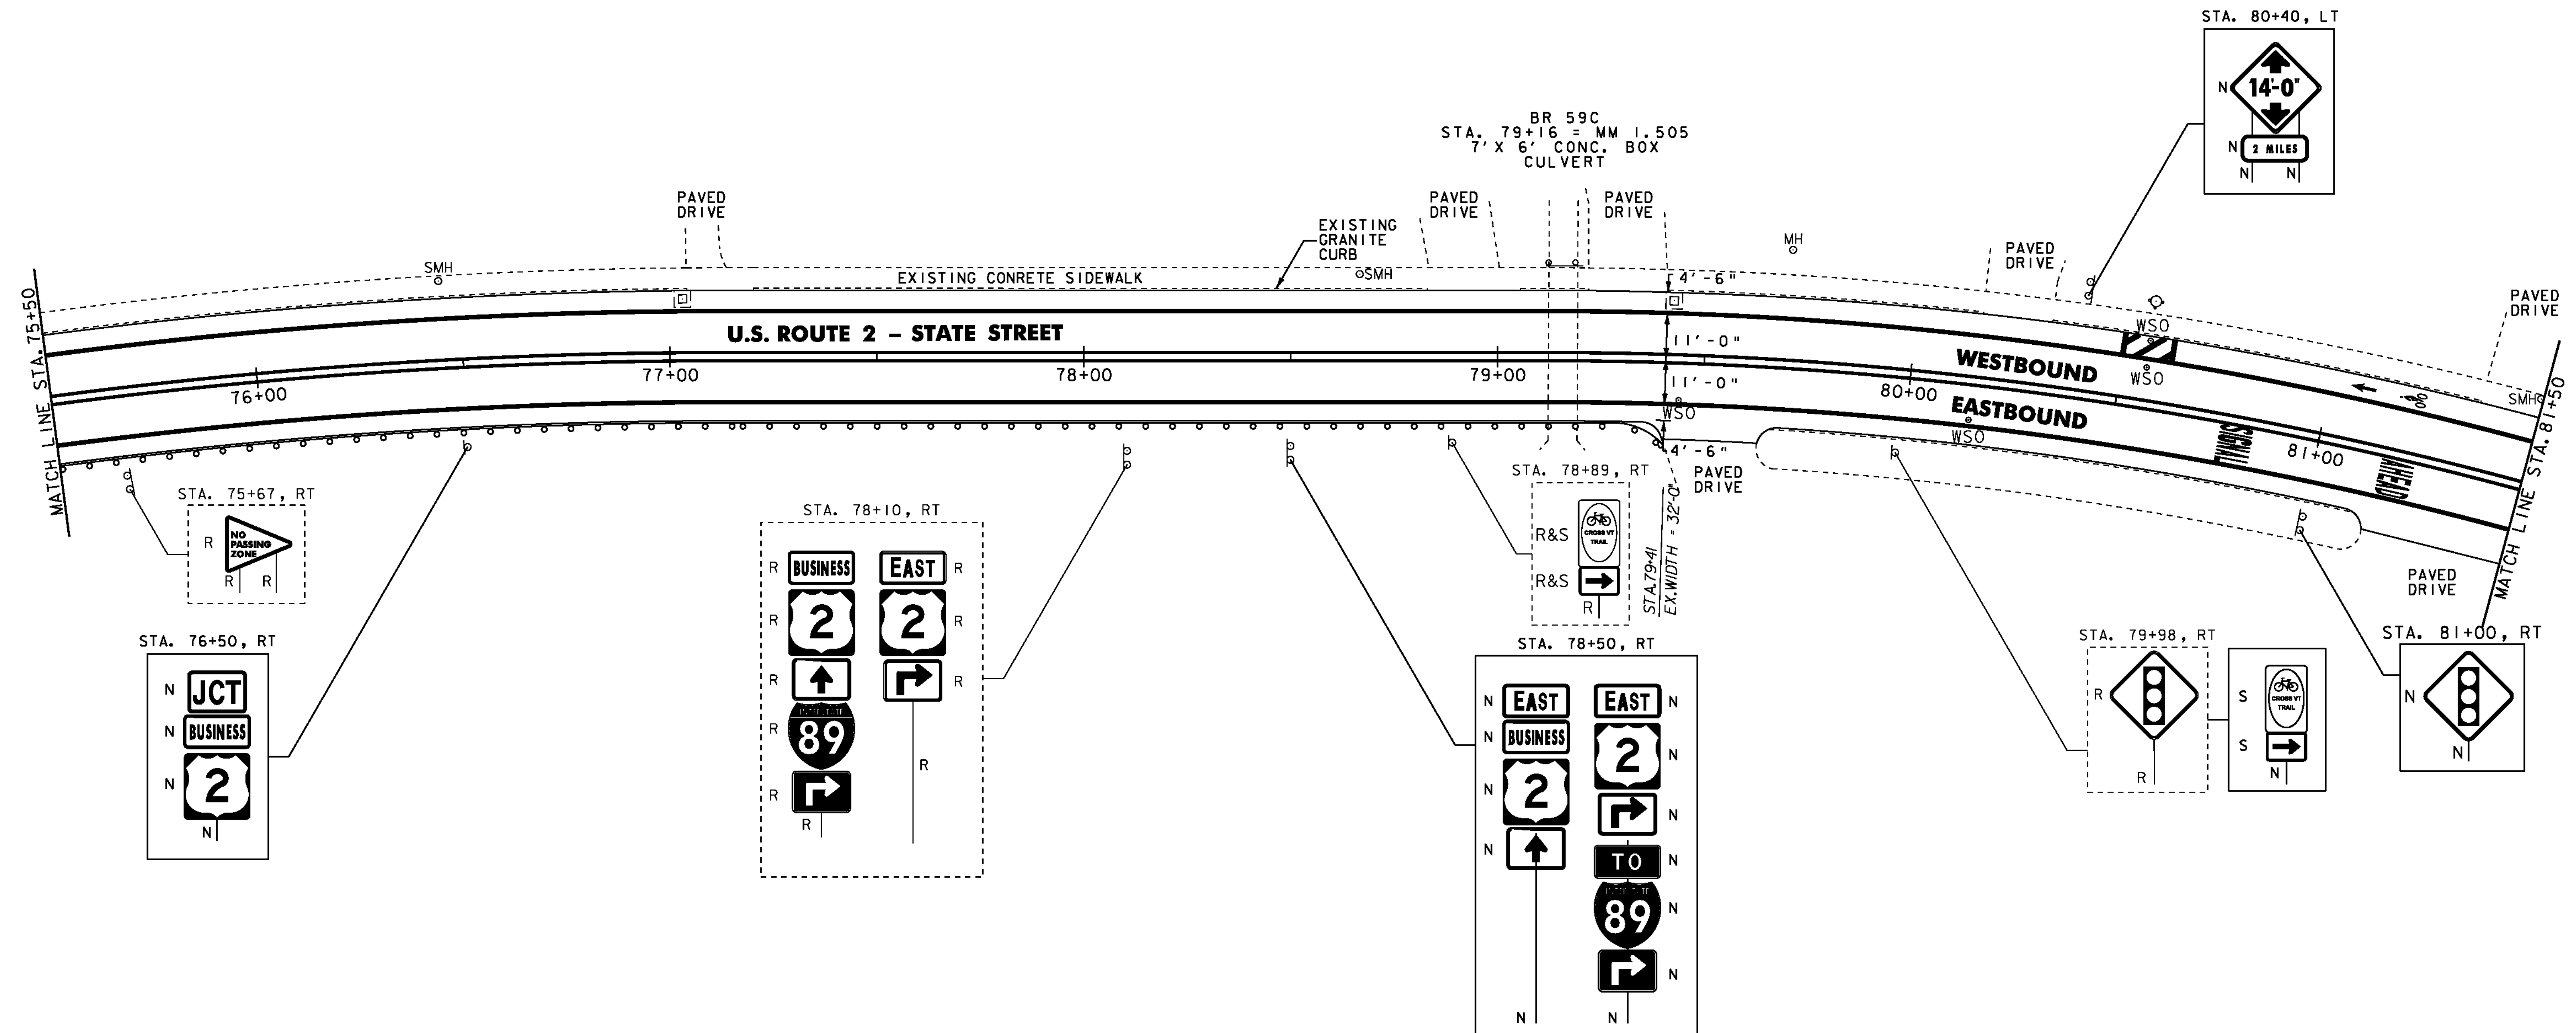

NOTES: 1. FOR LEGENDS, SEE LAYOUT SHEET #1
2. ALL EXISTING SIGNS NOT SHOWN SHALL
BE RETAINED.

NOT TO SCALE

**PROJECT
LAYOUT
SHEET #9**



PROJECT NAME: MONTPELIER
PROJECT NUMBER: STP 2905(1)

FILE NAME: p10dl16.dgn
PROJECT LEADER: JLL
DESIGNED BY: STANTEC
IPARM FILE: p10dl116109.i

PLOT DATE: 26-MAY-2011
DRAWN BY: STANTEC
CHECKED BY: STANTEC
SHEET 24 OF 79