


646.402 DURABLE 4 INCH WHITE LINE, THERMOPLASTIC OR  
 646.403 DURABLE 4 INCH WHITE LINE, EPOXY PAINT OR  
 646.404 DURABLE 4 INCH WHITE LINE, POLYUREA  
 (ALL LINES WILL INCLUDE EDGE LINE BREAKS AND  
 RADII FOR SIDE ROADS)  
 STA. 31+50 TO 36+59, SOLID LT & RT

646.412 DURABLE 4 INCH YELLOW LINE, THERMOPLASTIC OR  
 646.413 DURABLE 4 INCH YELLOW LINE, EPOXY PAINT OR  
 646.414 DURABLE 4 INCH YELLOW LINE, POLYUREA  
 (ALL LINES WILL INCLUDE C BREAKS FOR SIDE ROADS)  
 STA. 31+50 TO 36+59, SOLID LT & RT

646.602 TEMPORARY 4 INCH WHITE LINE, PAINT  
 (ALL LINES WILL INCLUDE EDGE LINE BREAKS AND  
 RADII FOR SIDE ROADS)  
 STA. 31+50 TO 36+59, SOLID LT & RT

646.612 TEMPORARY 4 INCH YELLOW LINE, PAINT  
 (ALL LINES WILL INCLUDE C BREAKS FOR SIDE ROADS)  
 STA. 31+50 TO 36+59, SOLID LT & RT

675.50 REMOVING SIGNS  
 AS SHOWN - 5

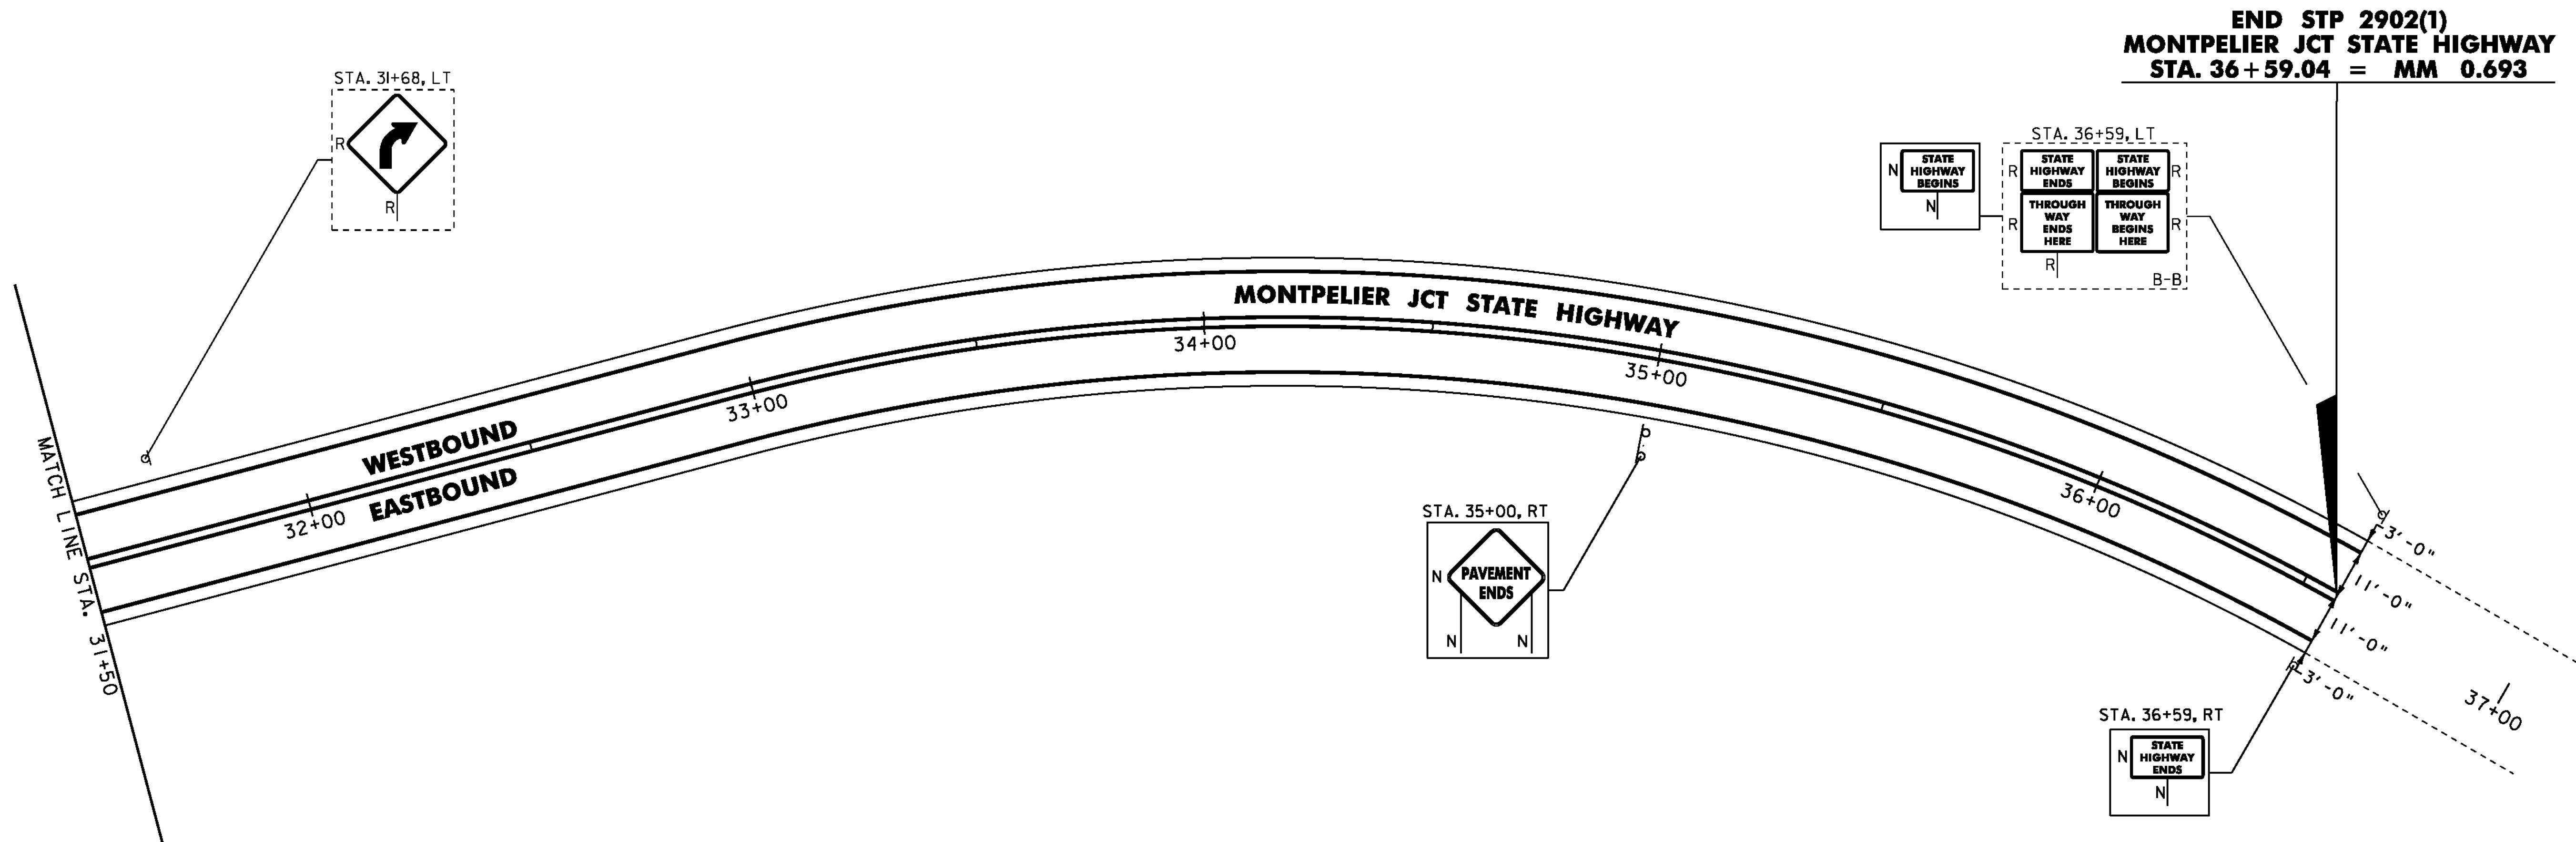

**END STP 2902(1)**  
**MONTPELIER JCT STATE HIGHWAY**  
**STA. 36+59.04 = MM 0.693**

NOTES: 1. FOR LEGENDS, SEE LAYOUT SHEET #1  
 2. ALL EXISTING SIGNS NOT SHOWN SHALL  
 BE RETAINED.

NOT TO SCALE

**PROJECT  
 LAYOUT  
 SHEET #7**

PROJECT NAME: MONTPELIER  
 PROJECT NUMBER: STP 2902(1)

FILE NAME: p09b318.dgn  
 PROJECT LEADER: JLL  
 DESIGNED BY: STANTEC  
 IPARM FILE: p09b318107.i

PLOT DATE: 26-MAY-2011  
 DRAWN BY: STANTEC  
 CHECKED BY: STANTEC  
 SHEET 75 OF 79

