

INDEX OF SHEETS

- 1. TITLE SHEET
- 2. QUANTITY SHEET
- 3-5. TRAFFIC SIGNAL SHEETS

STANDARDS

E-100	CONSTRUCTION APPROACH SIGNS	01/02/2004
E-100A	SIDE ROAD CONSTRUCTION APPROACH SIGNS	01/02/2004
E-101	CONSTRUCTION SIGN DETAILS	05/30/2003
E-102	CONSTRUCTION SIGN DETAILS	06/30/2003
E-110	MAJOR MAINTENANCE OPERATION LANE CLOSURE	08/08/1995
E-111	MINOR MAINTENANCE OPERATIONS	03/11/1997
E-171A	TRAFFIC CONTROL SIGNALS GENERAL NOTES AND DETAILS	08/09/1995
E-171B	TRAFFIC CONTROL SIGNALS MISC. DETAILS	08/09/1995
E-171C	TRAFFIC CONTROL SIGNALS CANTILEVER MOUNTING DETAILS	08/09/1995

STATE OF VERMONT AGENCY OF TRANSPORTATION







PROPOSED IMPROVEMENT TOWN OF BRATTLEBORO COUNTY OF WINDHAM US ROUTE 5 - PRINCIPAL ARTERIAL

TOWN OF BRATTLEBORO, US 5 AT THE INTERSECTIONS OF FAIRFIELD PLAZA (MM 3.90), SHOPPING CENTER (MM 4.16), AND BLACK MTN. ROAD (MM 4.35).

LENGTH OF ROADWAY - US 5 & FAIRFIELD PLAZA	500 FT	.09 MILES
LENGTH OF ROADWAY - US 5 & SHOPPING CENTER	500 FT	.09 MILES
LENGTH OF ROADWAY - US 5 & BLACK MTN. ROAD	500 FT	.09 MILES
TOTAL LENGTH OF ROADWAY	1500 FT	.28 MILES

THIS PROJECT SHALL CONSIST OF ALL WORK ASSOCIATED WITH THE INSTALLATION OF VIDEO DETECTION, NEW SIGNAL CONTROLLERS, AND COORDINATION AT THREE SIGNALIZED INTERSECTIONS.

PROJECT LOCATION
STPG SGNL (36)

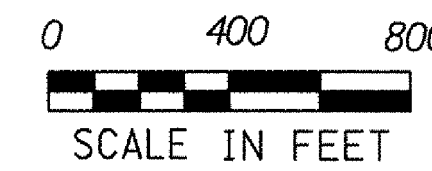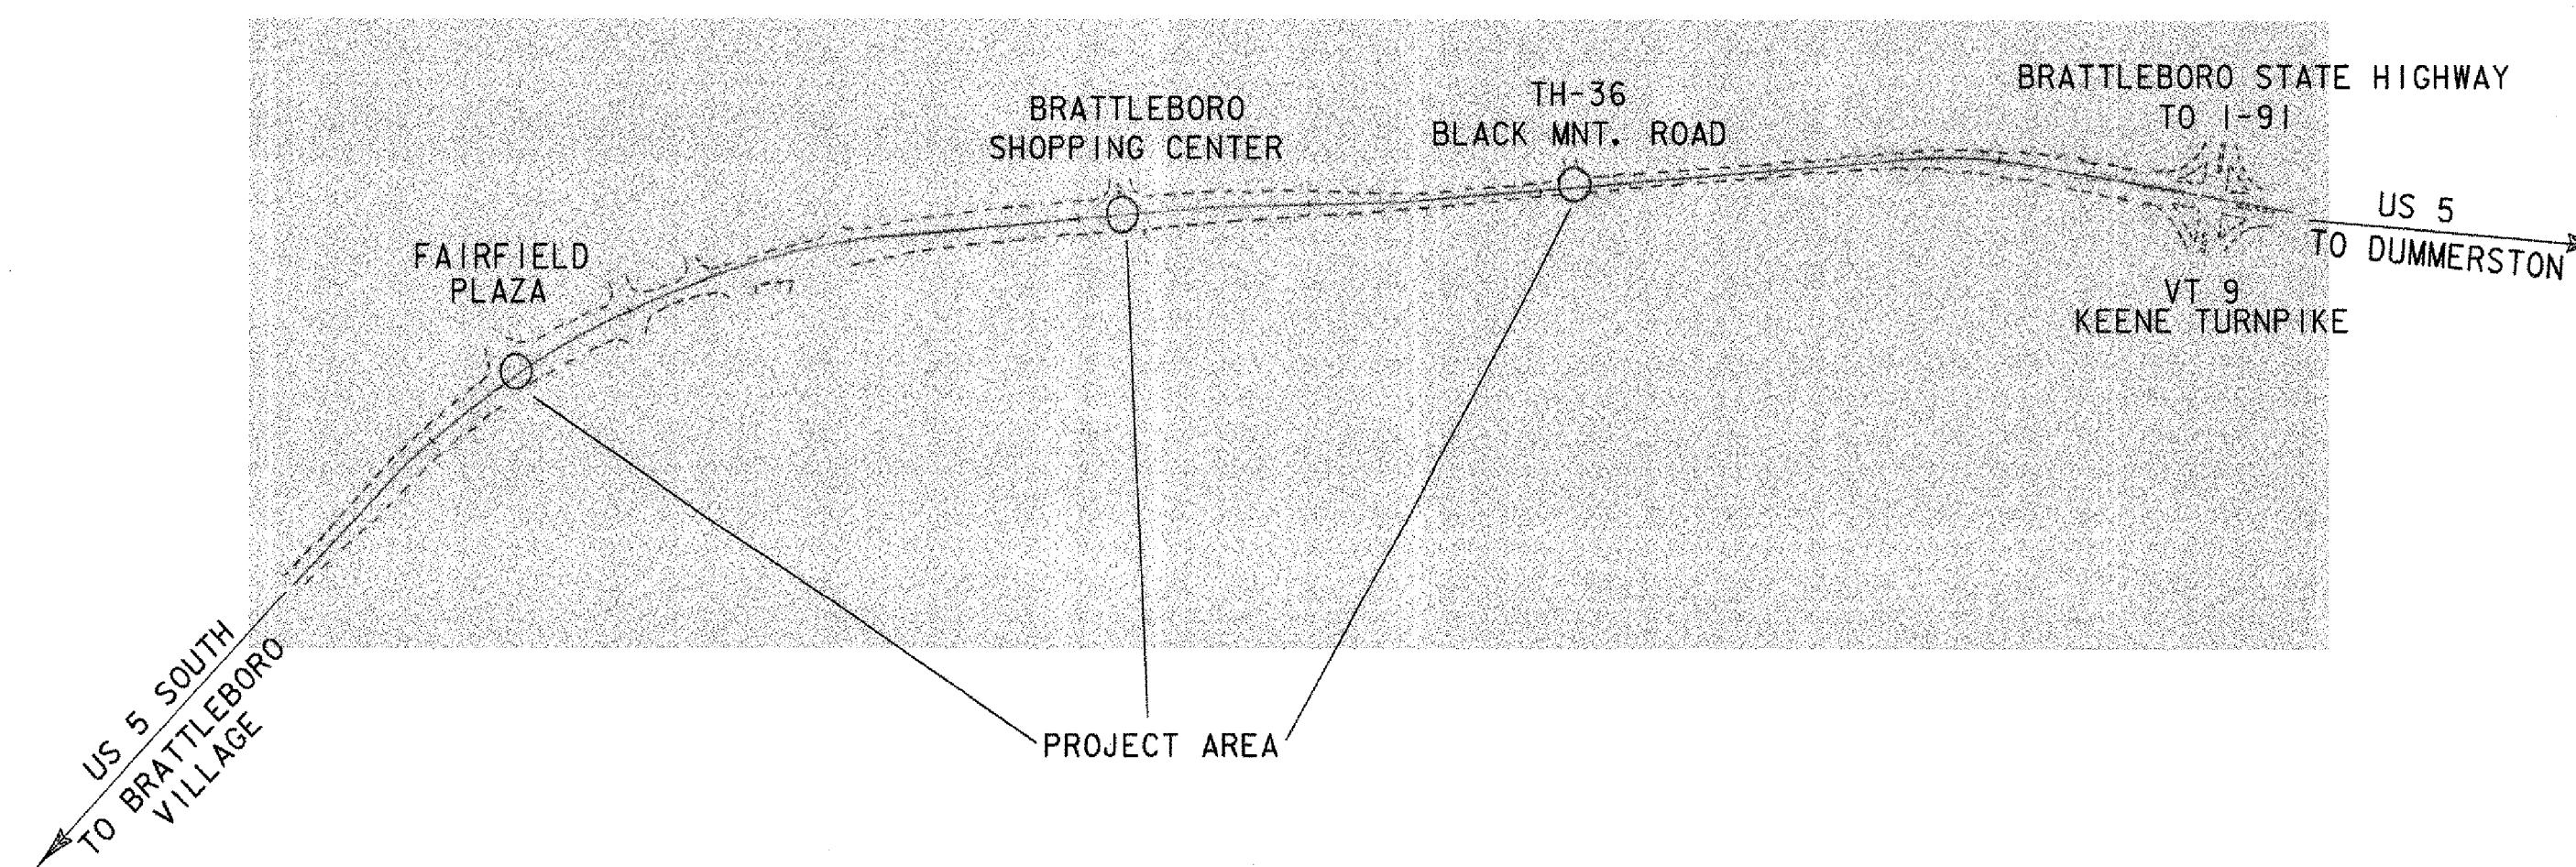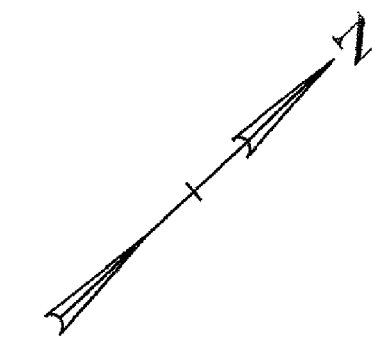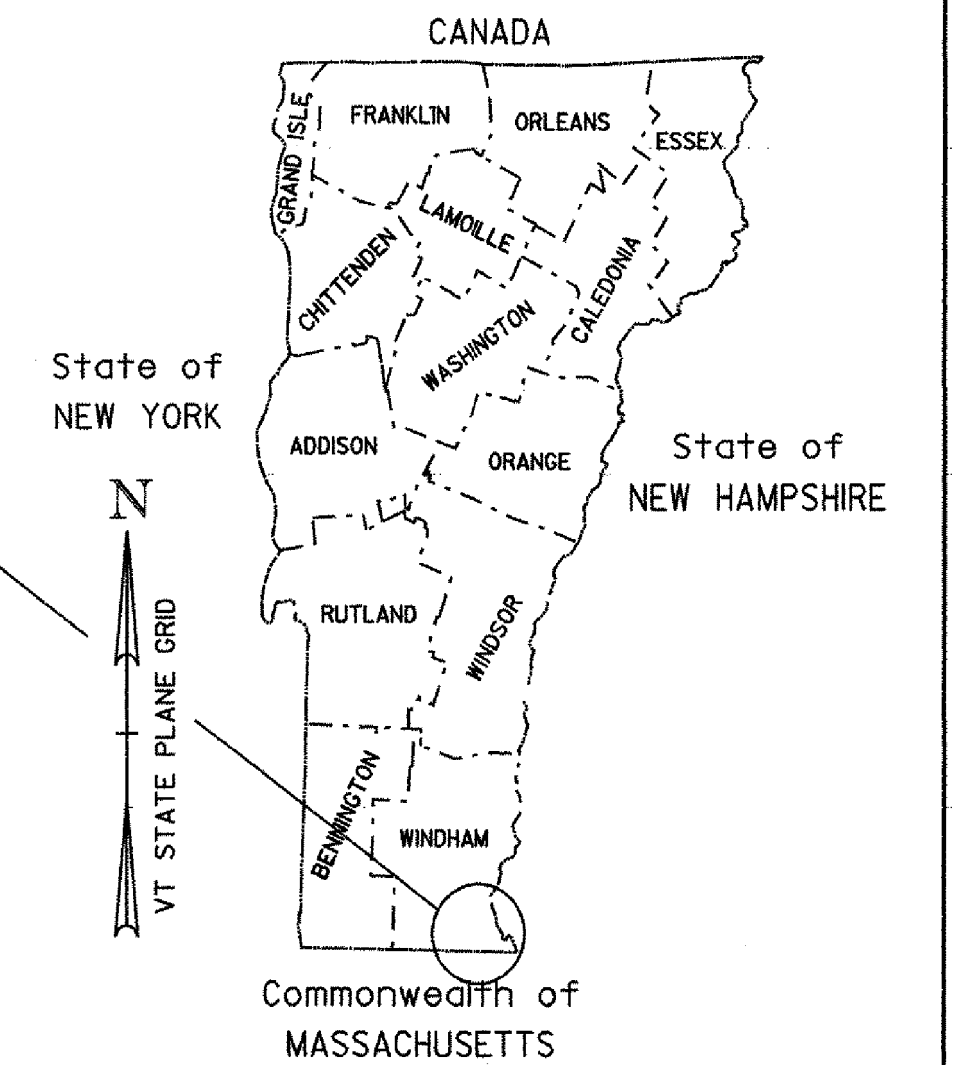

CONVENTIONAL SYMBOLS

COUNTY LINE	
TOWN LINE	
LIMITS OF ACCESS	
POINT OF ACCESS	
FENCE LINE	
STONE WALL	
TRAVELED WAY	
GUARD RAIL	
RAILROAD	
SURVEY LINE	
CULVERT	
POWER POLE	
TELEPHONE POLE	
TREES	
CONTROL OF ACCESS	
PROPERTY LINE	
R.O.W. TAKING LINE	
SLOPE RIGHTS	
TOP OF CUT	
TOE OF SLOPE	

SURVEYED BY : N/A
SURVEYED DATE : N/A
DATUM
VERTICAL N/A
HORIZONTAL N/A

THESE PLANS ARE SUBJECT TO SUCH ENGINEERING CHANGES AS MAY BE REQUIRED BY THE FEDERAL HIGHWAY ADMINISTRATION OR THE DIRECTOR OF PROGRAM DEVELOPMENT.
CONSTRUCTION IS TO BE CARRIED ON IN ACCORDANCE WITH THESE PLANS AND THE STANDARD SPECIFICATIONS FOR CONSTRUCTION DATED 2006, AS APPROVED BY THE FEDERAL HIGHWAY ADMINISTRATION ON JUNE 15, 2006 FOR USE ON THIS PROJECT, INCLUDING ALL SUBSEQUENT REVISIONS AND SUCH REVISED SPECIFICATIONS AND SPECIAL PROVISIONS AS ARE INCORPORATED IN THESE PLANS.

DIRECTOR OF PROGRAM DEVELOPMENT	
APPROVED	DATE 6-23-2009
PROJECT MANAGER : B. NYQUIST	
PROJECT NAME : BRATTLEBORO	
PROJECT NUMBER : STPG SGNL (36)	
SHEET 1 OF 5 SHEETS	