



# ROADWAY PROFILE

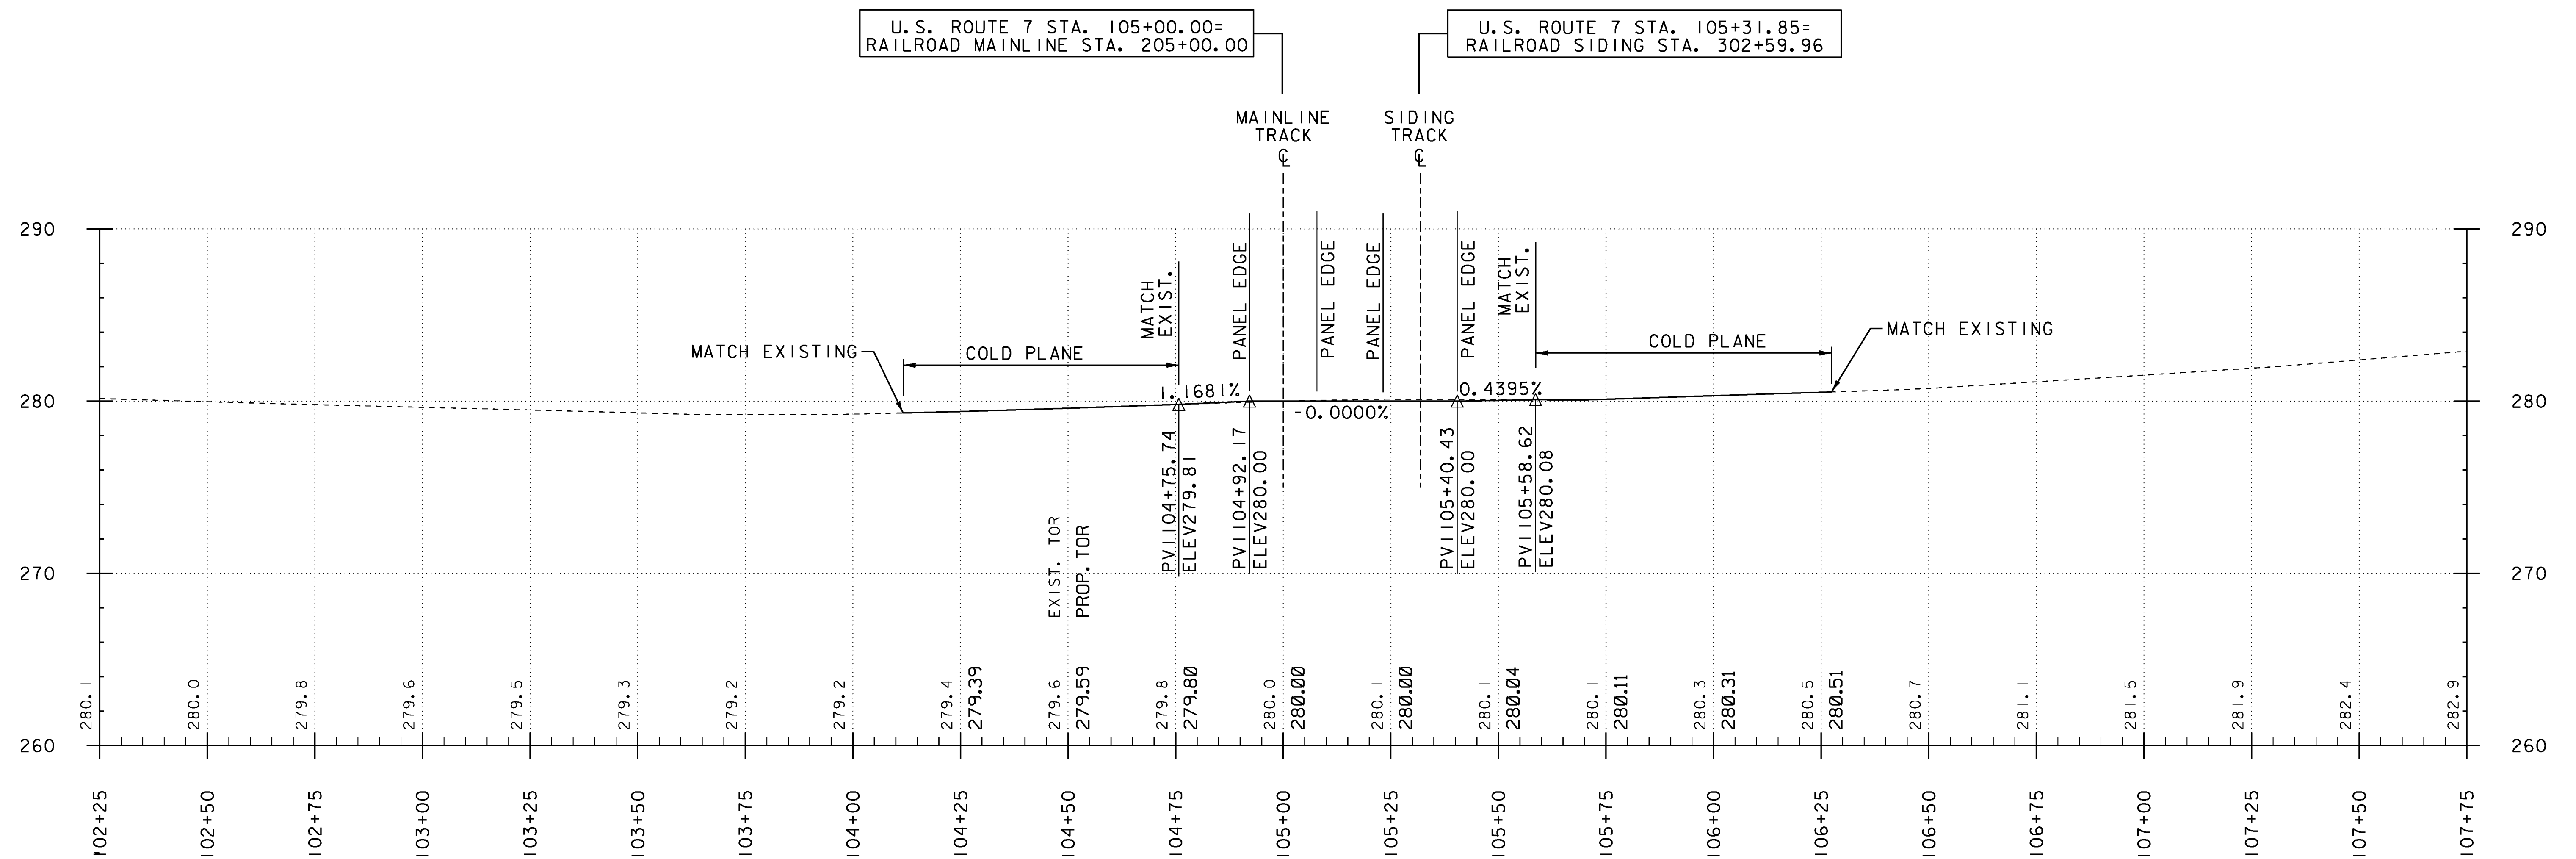

ROUTE 7 PROFILE

LINE	SURFACE	OFFSET
-----	x84e06log	0.00
-----	MAINLINE	0.00
Scaled	4.0000	Times Ver.
Scaled	1.0000	Times Hor.

NOTES:  
 GRADES SHOWN TO THE NEAREST TENTH ARE EXISTING GROUND ALONG  $\phi$ .  
 GRADES SHOWN TO THE NEAREST HUNDREDTH ARE FINISH GRADE ALONG  $\phi$ .

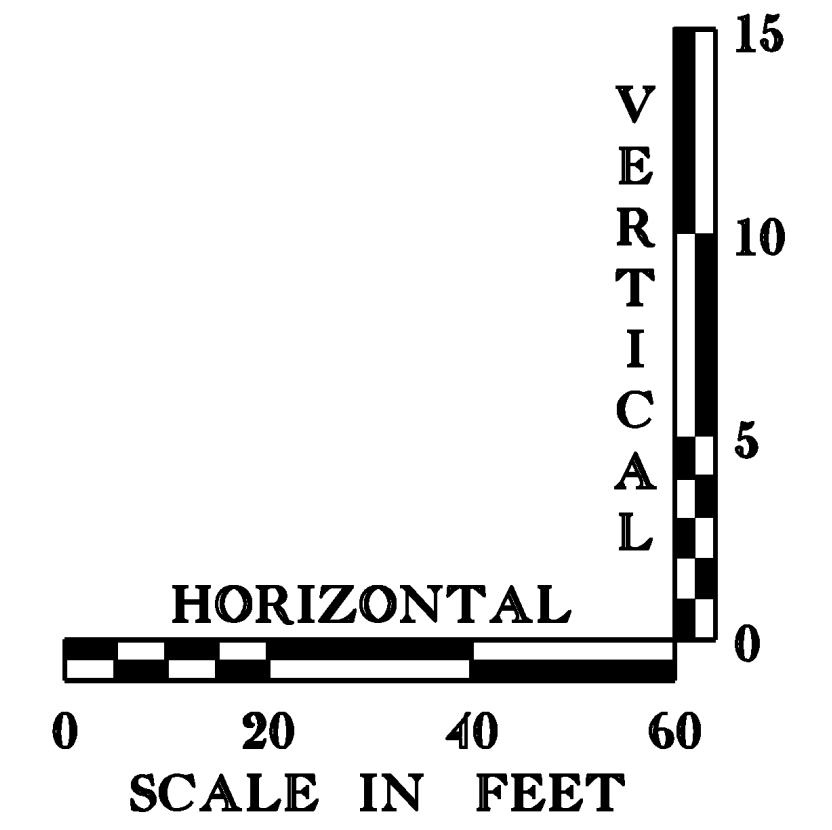

PROJECT NAME:	NEW HAVEN	PLOT DATE:	13-JUL-2010
PROJECT NUMBER:	RAIL 5307(16)	DRAWN BY:	LB
FILE NAME:	z09g070/RAIL/bdr_xsl.dgn	CHECKED BY:	J.READ
PROJECT LEADER:	J.B.McCARTHY	ROADWAY PROFILE	SHEET 11 OF 18
DESIGNED BY:	LB		