


NOTE:  
ELEVATIONS SHOWN TO THE NEAREST TENTH ARE EXISTING GROUND ALONG BASELINE.  
ELEVATIONS SHOWN TO THE NEAREST HUNDREDTH ARE FINISHED GRADE ALONG BASELINE.

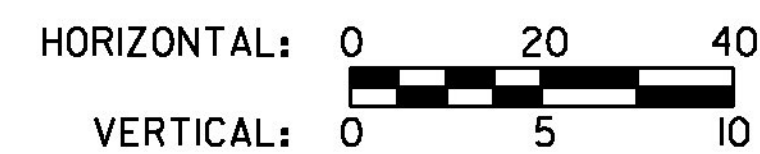

PROJECT NAME: SPRINGFIELD  
PROJECT NUMBER: CMG PARK (32)

FILE NAME: z09k250xs.dgn  
PROJECT LEADER: G. SANTY  
DESIGNED BY: I. MAYNARD  
PROFILE SHEET

PLOT DATE: 6/25/2014  
DRAWN BY: I. MAYNARD  
CHECKED BY: M. FOISY  
SHEET 13 OF 43