



- REMOVING SIGNS AS SHOWN - 11
- ERECTING SALVAGED SIGNS AS SHOWN - 1
- DURABLE 24" STOP BAR, EPOXY PAINT  
STA. 104+06, RT.
- DURABLE 4" WHITE LINE, EPOXY PAINT  
STA. 101+50 TO 103+69, LT & RT (PARKING SPACES AND DIAGONALS)  
STA. 204+67 TO 204+83, LT & RT (BOLLARD MARKING)
- DURABLE 4" YELLOW LINE, EPOXY PAINT  
STA. 101+74 TO STA. 103+45, (CENTER LINE)  
STA. 103+69 TO STA. 104+07, (CENTER LINE)
- DURABLE 12" WHITE LINE, EPOXY PAINT  
STA. 204+83, LT-RT (SHARED USE PATH STOP BAR)
- DURABLE LETTER OR SYMBOL, EPOXY PAINT
- |                      |                           |
|----------------------|---------------------------|
| STA. 101+57, LT. - † | STA. 103+15, LT. - †      |
| STA. 101+57, RT. - † | STA. 103+15, RT. - †      |
| STA. 101+65, LT. - † | STA. 103+31, LT. - †      |
| STA. 101+65, RT. - † | STA. 103+31, RT. - †      |
| STA. 102+58, LT. - † | STA. 103+53, LT. - †      |
| STA. 102+58, LT. - † | STA. 103+53, RT. - †      |
| STA. 102+58, RT. - † | STA. 103+62, LT. - †      |
| STA. 102+58, RT. - † | STA. 103+62, RT. - †      |
| STA. 102+58, RT. - † | STA. 103+78, LT. - †      |
| STA. 102+58, RT. - † | STA. 103+78, RT. - †      |
| STA. 102+58, RT. - † | STA. 103+78, RT. - †      |
| STA. 103+49, RT. - † | STA. 103+97, RT. - "STOP" |

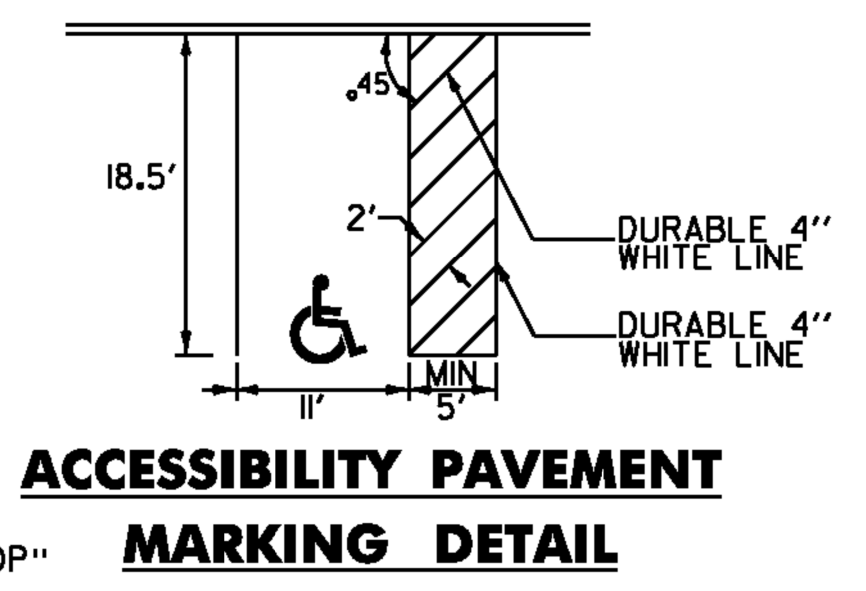

- NOTES
- 1) ALL EXISTING SIGNS NOT SHOWN SHALL BE RETAINED UNLESS OTHERWISE DIRECTED BY THE ENGINEER.
  - 2) FOR ANY TOWN HIGHWAY OR STREET DETAILS, SEE VTRANS STANDARD E-193.
  - 3) FOR ALL PAVEMENT MARKING DETAILS, SEE VTRANS STANDARDS E-191, E-192, & E-193.

- SIGN LEGEND
- N = NEW
  - R = REMOVE
  - R&S = REMOVE & SALVAGE
  - S = SALVAGE SIGN
  - RET = RETAIN
  - B-B = BACK TO BACK

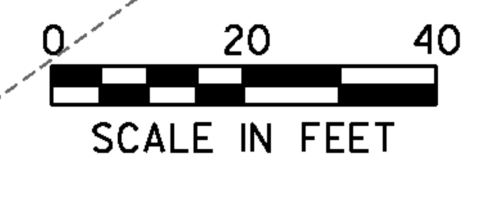

PROJECT NAME: SPRINGFIELD  
PROJECT NUMBER: CMG PARK (32)

FILE NAME: z09k250bdr.dgn  
PROJECT LEADER: G. SANTY  
DESIGNED BY: I. MAYNARD  
SIGNING AND PAVEMENT MARKING PLAN

PLOT DATE: 6/25/2014  
DRAWN BY: I. MAYNARD  
CHECKED BY: M. FOISY  
SHEET 15 OF 43

\*LETTER OR SYMBOL, WATERBORNE PAINT

\*ADDED 1 HANDICAP STALL, REF. COD \*01 FOR REVISED SHEET