


NOTE:
 1. UTILITIES TO BE RELOCATED BY UTILITY OWNER PRIOR TO THE PROJECT. SEE THE UTILITY SPECIAL PROVISIONS FOR ADDITIONAL INFORMATION AND REQUIREMENTS.

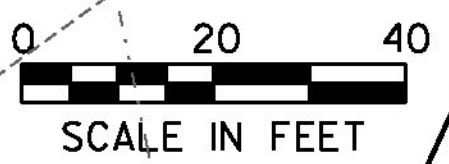

PROJECT NAME:	SPRINGFIELD	FILE NAME:	z09k250bdr.dgn	PLOT DATE:	6/25/2014
PROJECT NUMBER:	CMG PARK (32)	PROJECT LEADER:	G. SANTY	DRAWN BY:	I. MAYNARD
		DESIGNED BY:	I. MAYNARD	CHECKED BY:	M. FOISY
		UTILITY RELOCATION PLAN		SHEET	24 OF 43