


103+69 = 204+54.76, 109.81 RT.

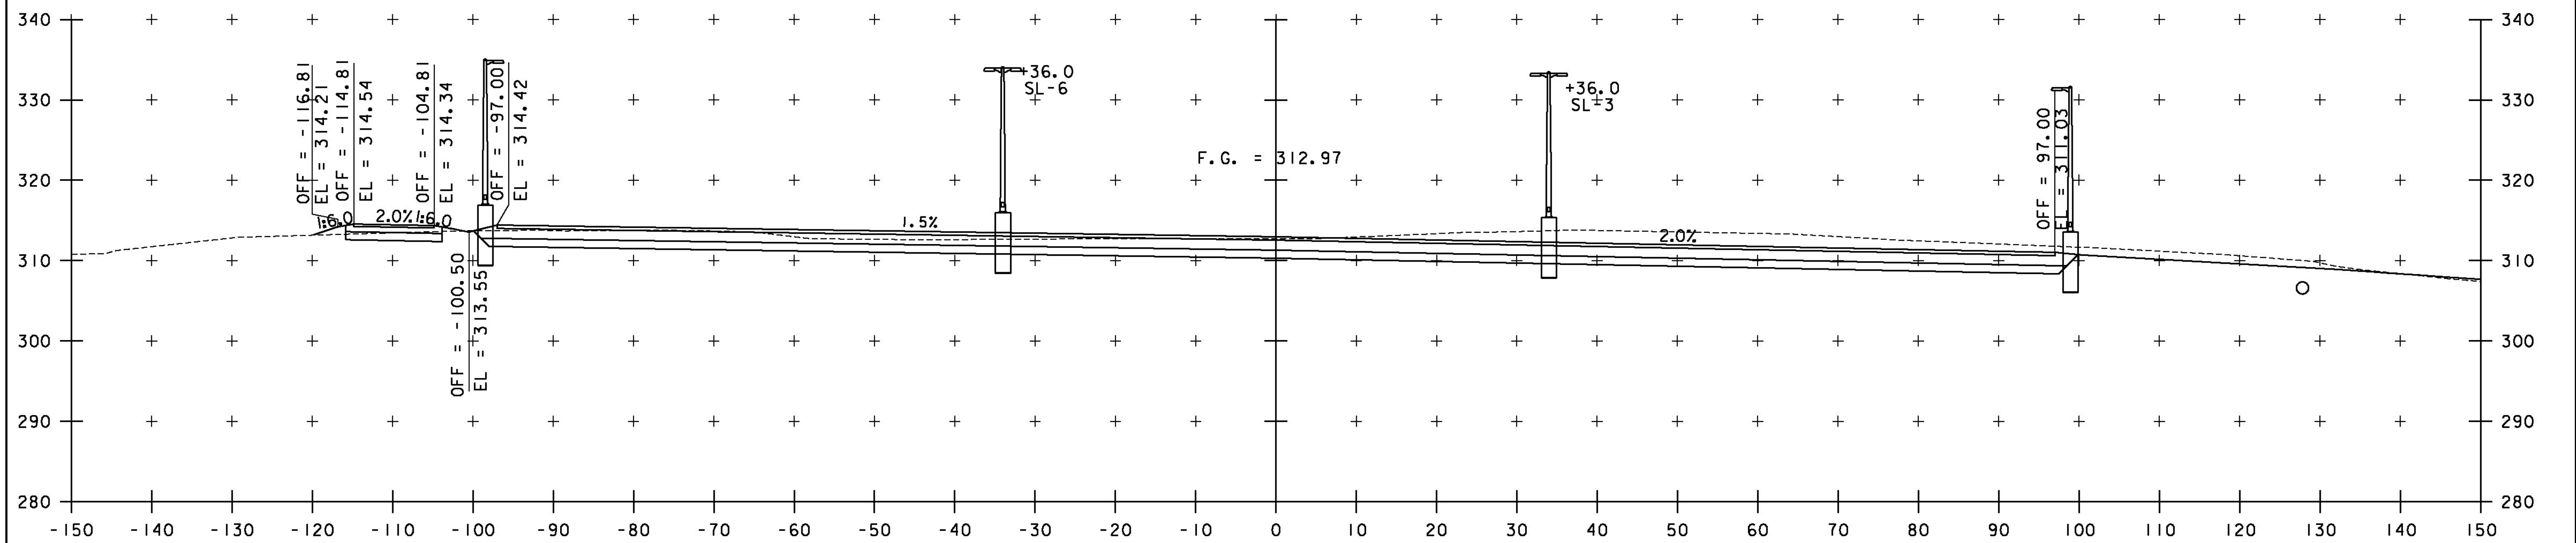

103+50 = 204+35.75, 109.81 RT.

PARK-AND-RIDE BASELINE
STA. 103+50 TO STA. 103+69

PROJECT NAME: SPRINGFIELD
PROJECT NUMBER: CMG PARK (32)

FILE NAME: z09k250xs.dgn
PROJECT LEADER: G. SANTY
DESIGNED BY: I. MAYNARD
CROSS SECTION SHEET 5

PLOT DATE: 6/25/2014
DRAWN BY: I. MAYNARD
CHECKED BY: M. FOISY
SHEET 35 OF 43

