




END ELEVATION (TYP.)
SCALE: 1/2" = 1'-0"

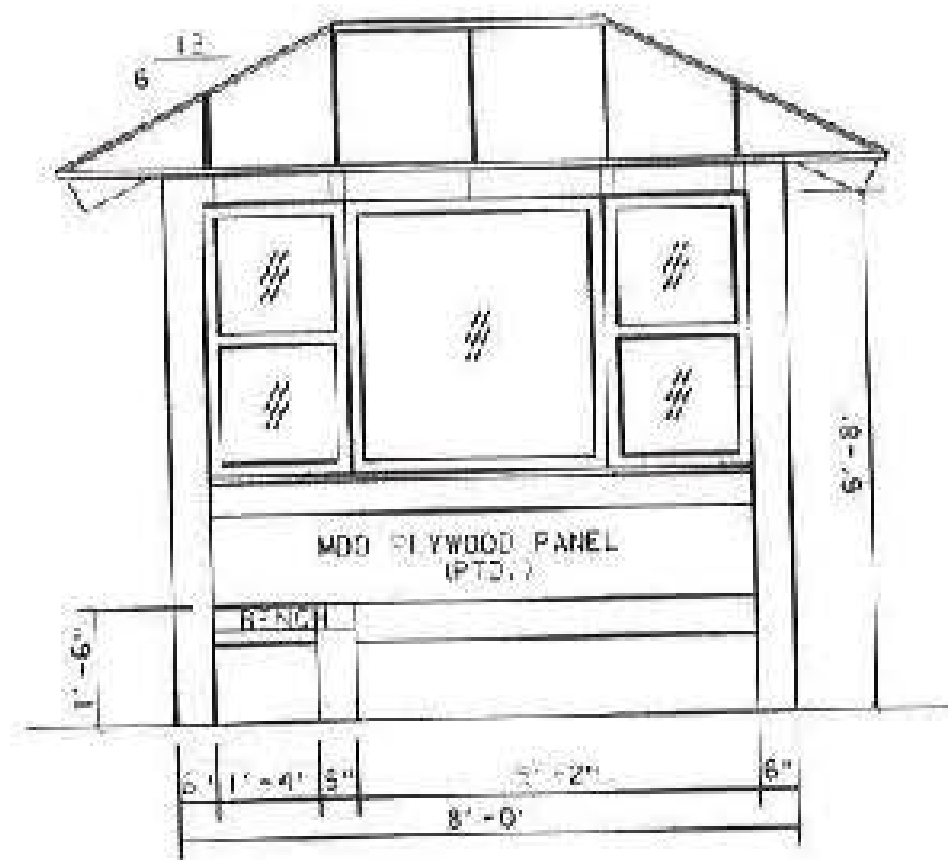

FRONT/INTERIOR ELEVATION
SCALE: 1/2" = 1'-0"

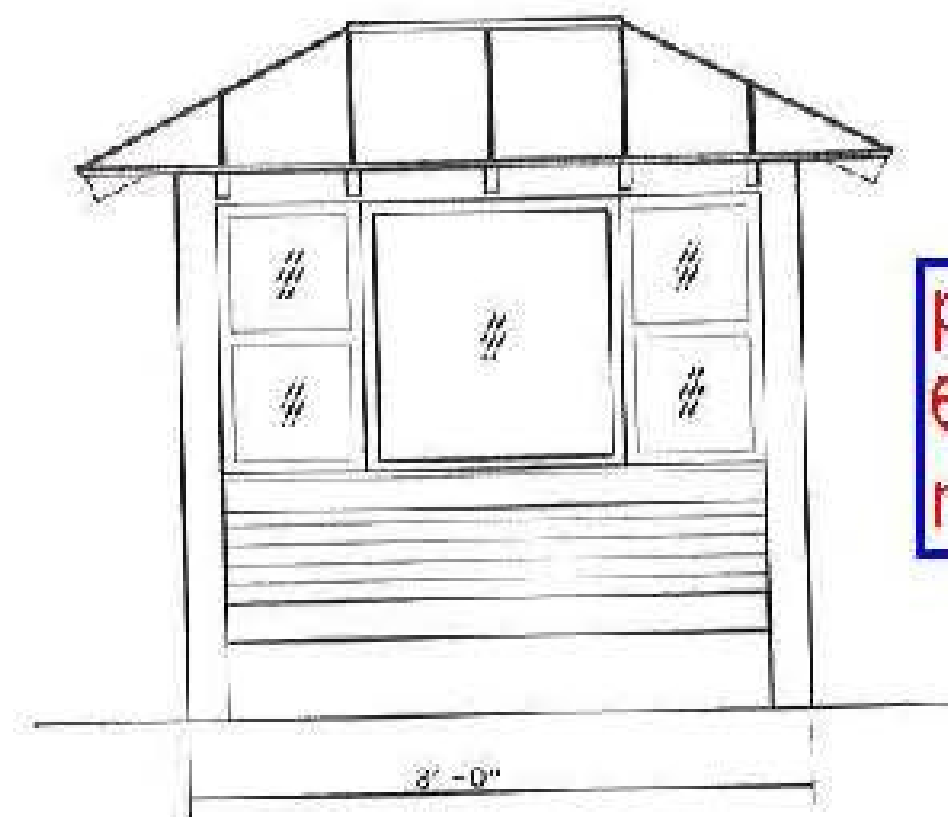


REAR ELEVATION
SCALE: 1/2" = 1'-0"

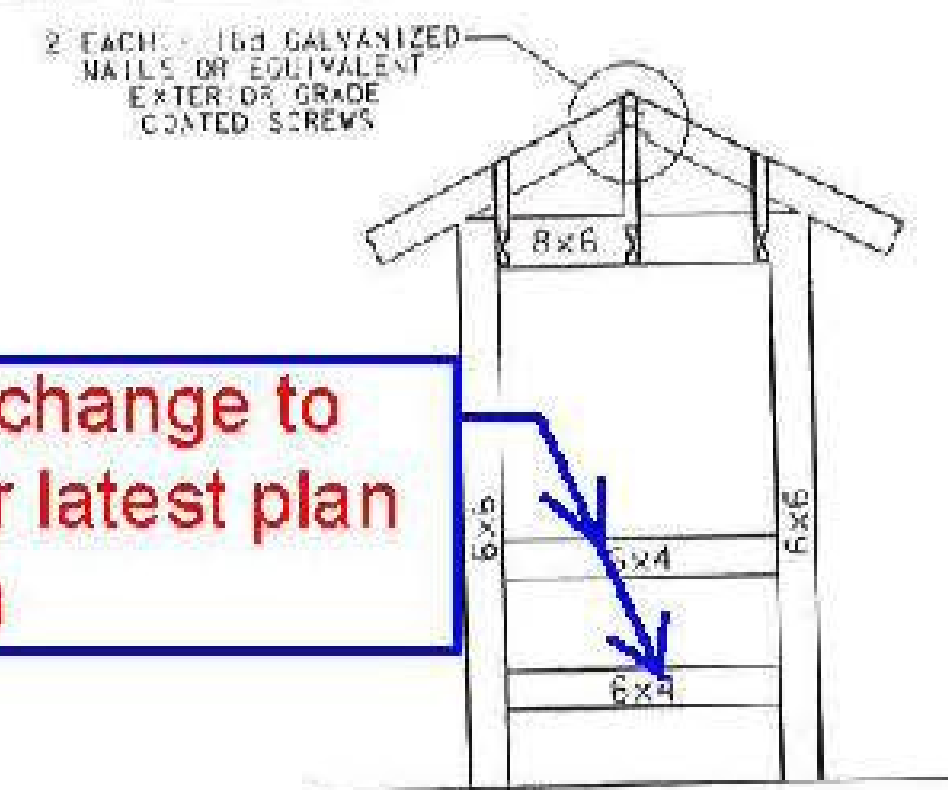


END FRAMING - ELEVATION
SCALE: 1/2" = 1'-0"


please change to 6X6 per latest plan revision

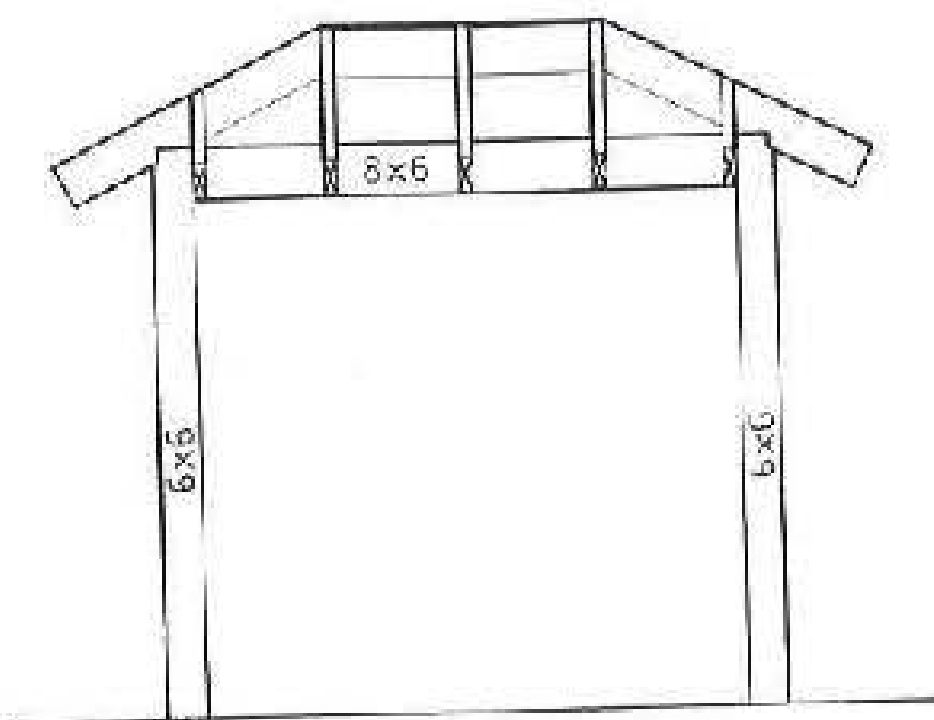


FRONT/REAR FRAMING - ELEVATION
SCALE: 1/2" = 1'-0"

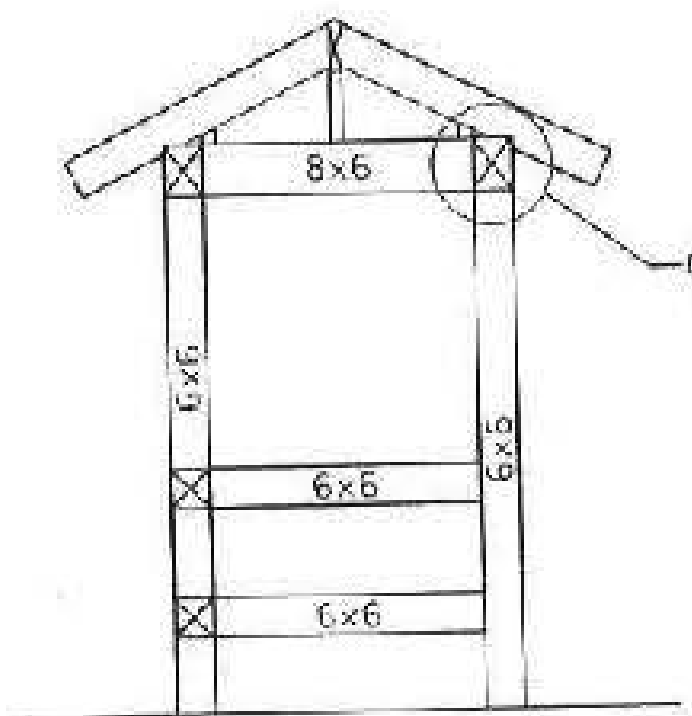

END FRAMING - SECTION
SCALE: 1/2" = 1'-0"

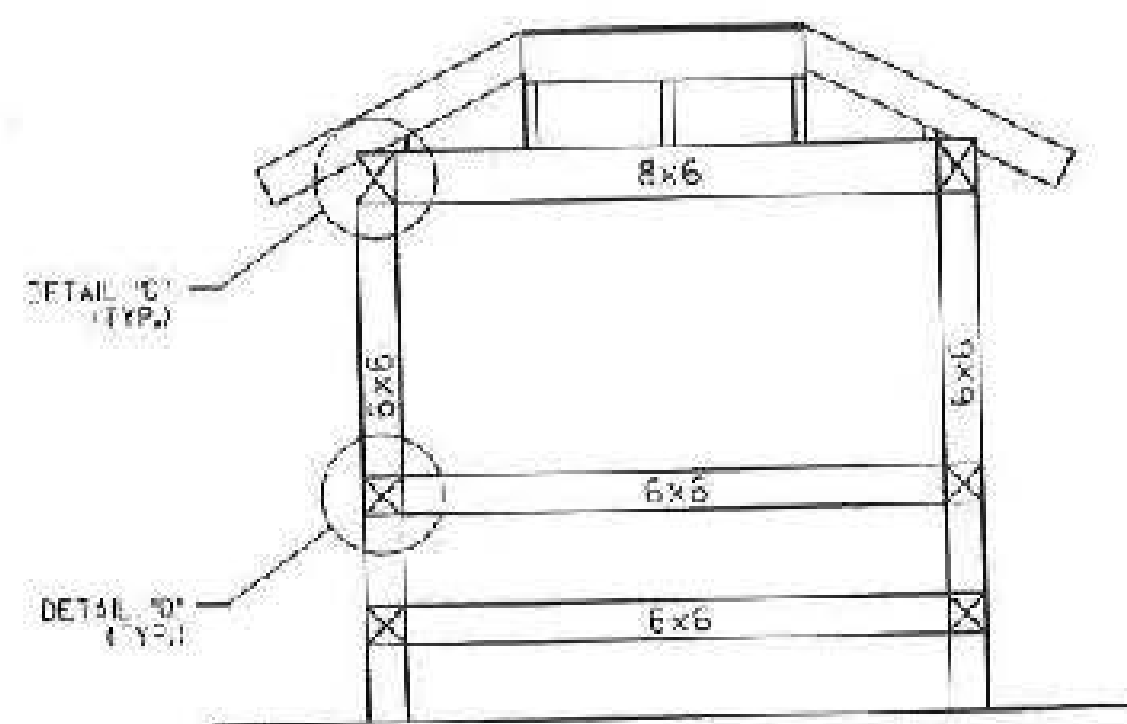


FRONT/REAR FRAMING - SECTION
SCALE: 1/2" = 1'-0"

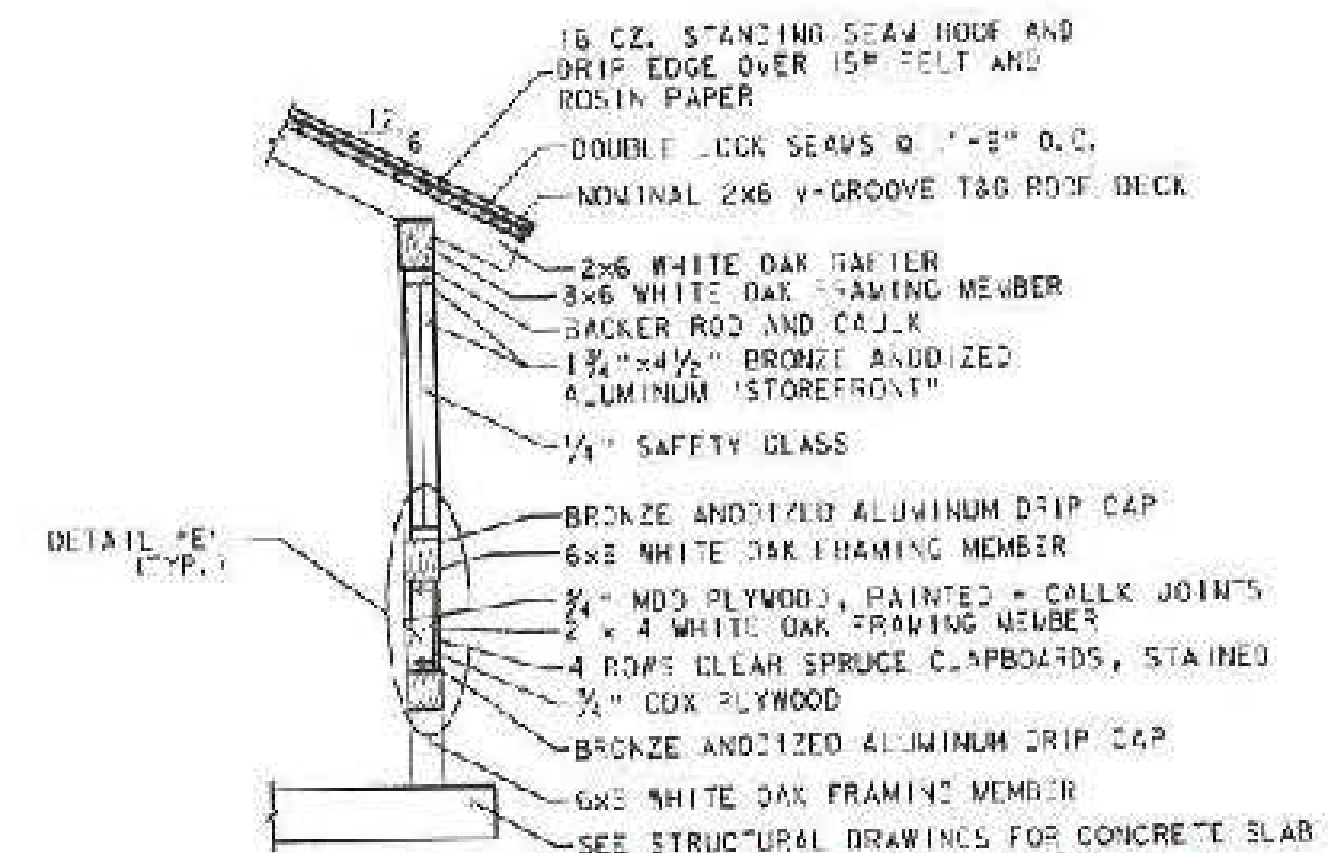

TYPICAL WALL SECTION
SCALE: 1/2" = 1'-0"

- NOTES:
1. JACK AND COMMON RAFTERS ARE 2X6.
 2. HIP RAFTERS ARE 2X8
 3. RIDGE BEAM IS 2X8

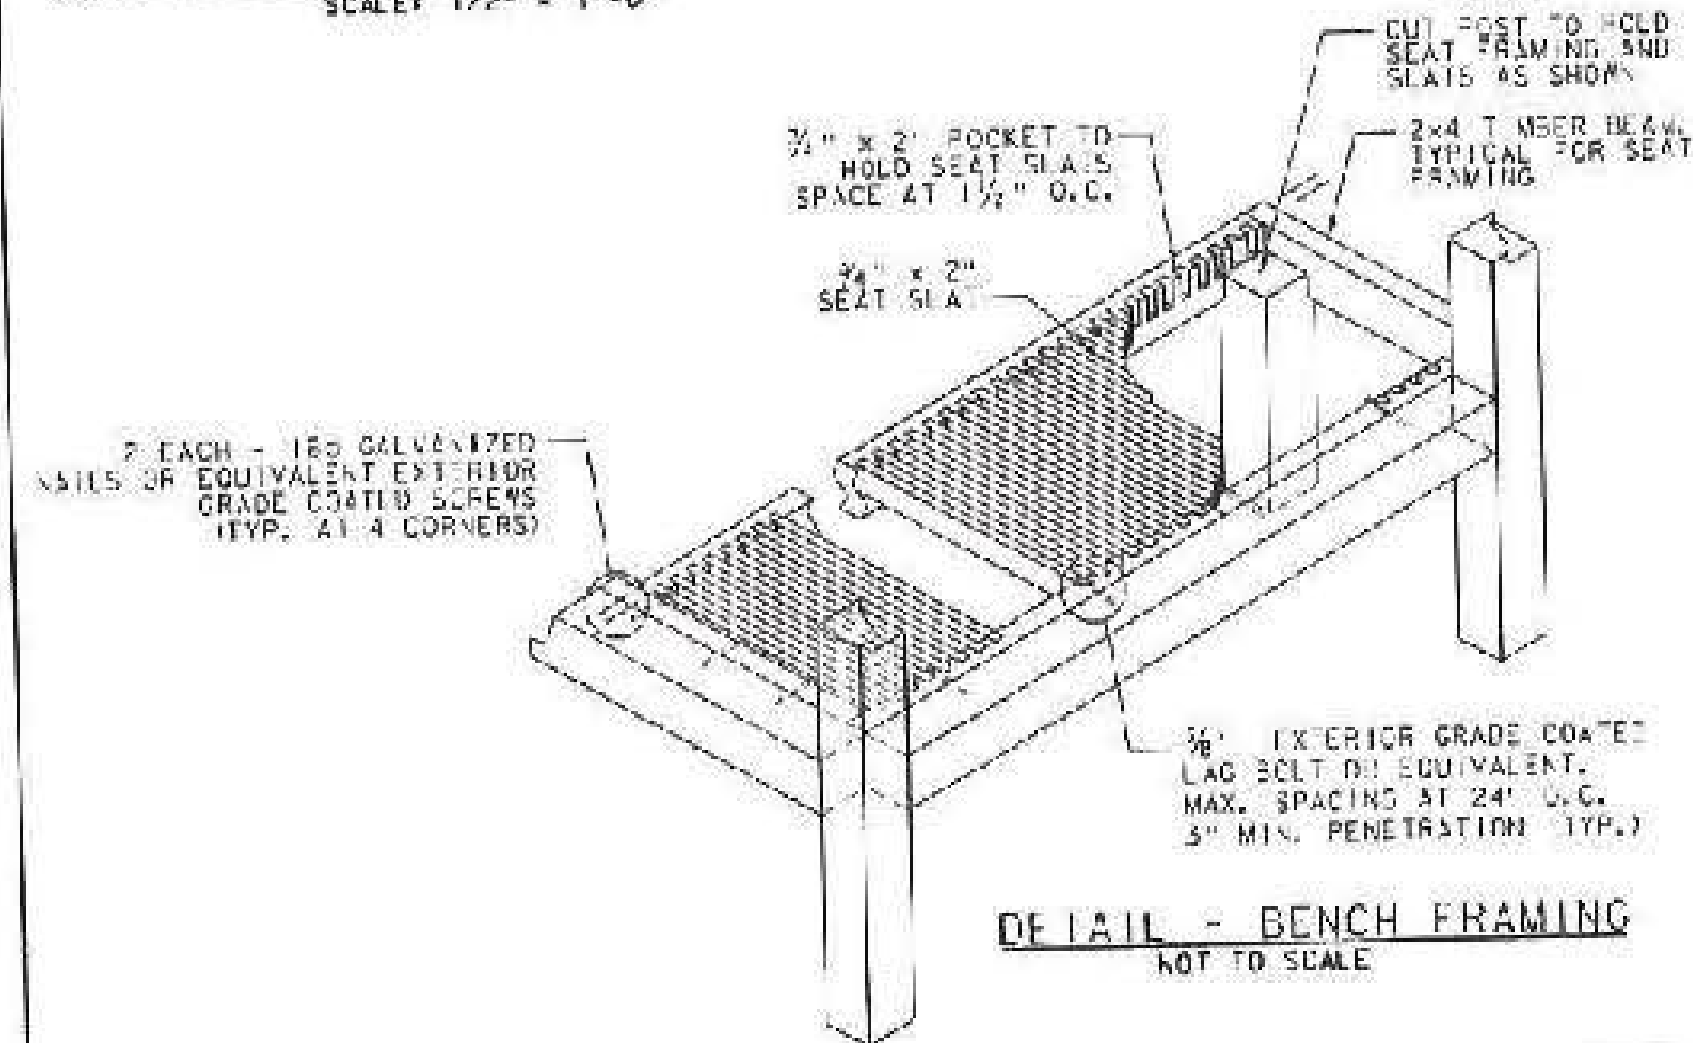

DETAIL - BENCH FRAMING
NOT TO SCALE

Ingram Construction Corp.
Approved for Submittal
Date 4/14/15 By SPC



NOTE:
FOR DETAILS B & C, SEE BUS SHELTER DETAILS 3.
FOR DETAILS D & E, SEE BUS SHELTER DETAILS 4.
ALL DIMENSIONS IN INCHES UNLESS OTHERWISE NOTED.

PROJECT NAME: SPRINGFIELD
PROJECT NUMBER: CMG PARK (32)
FILE NAME: 209K257.dwg
PROJECT LEADER: M. J. J.
DESIGNED BY: J. LANGFORD
BUS SHELTER DETAILS 2
PLOT DATE: 5/25/2014
DRAWN BY: C. BURTON
CHECKED BY: G. EGGLE
SHEET 26 OF 43