


NOTE:
 ELEVATIONS SHOWN TO THE NEAREST TENTH ARE EXISTING
 GROUND ALONG CONSTRUCTION BASELINE.
 ELEVATIONS SHOWN TO THE NEAREST HUNDREDTH ARE
 FINISHED GRADE ALONG CONSTRUCTION BASELINE.

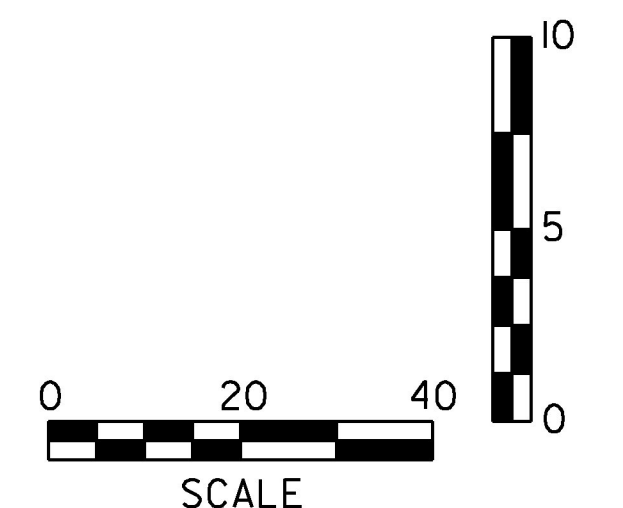

1"=20' HORIZONTAL @ FULL SIZE
 1"= 5' VERTICAL @ FULL SIZE

PROJECT NAME:	BRADFORD
PROJECT NUMBER:	CMG PARK (33)
FILE NAME:	z09k252xs.dgn
PROJECT LEADER:	M. FOISY
DESIGNED BY:	I. MAYNARD
PROFILE	
PLOT DATE:	5/22/2014
DRAWN BY:	P. ARMATA
CHECKED BY:	G. SANTY
SHEET	II OF 33

