



12+25

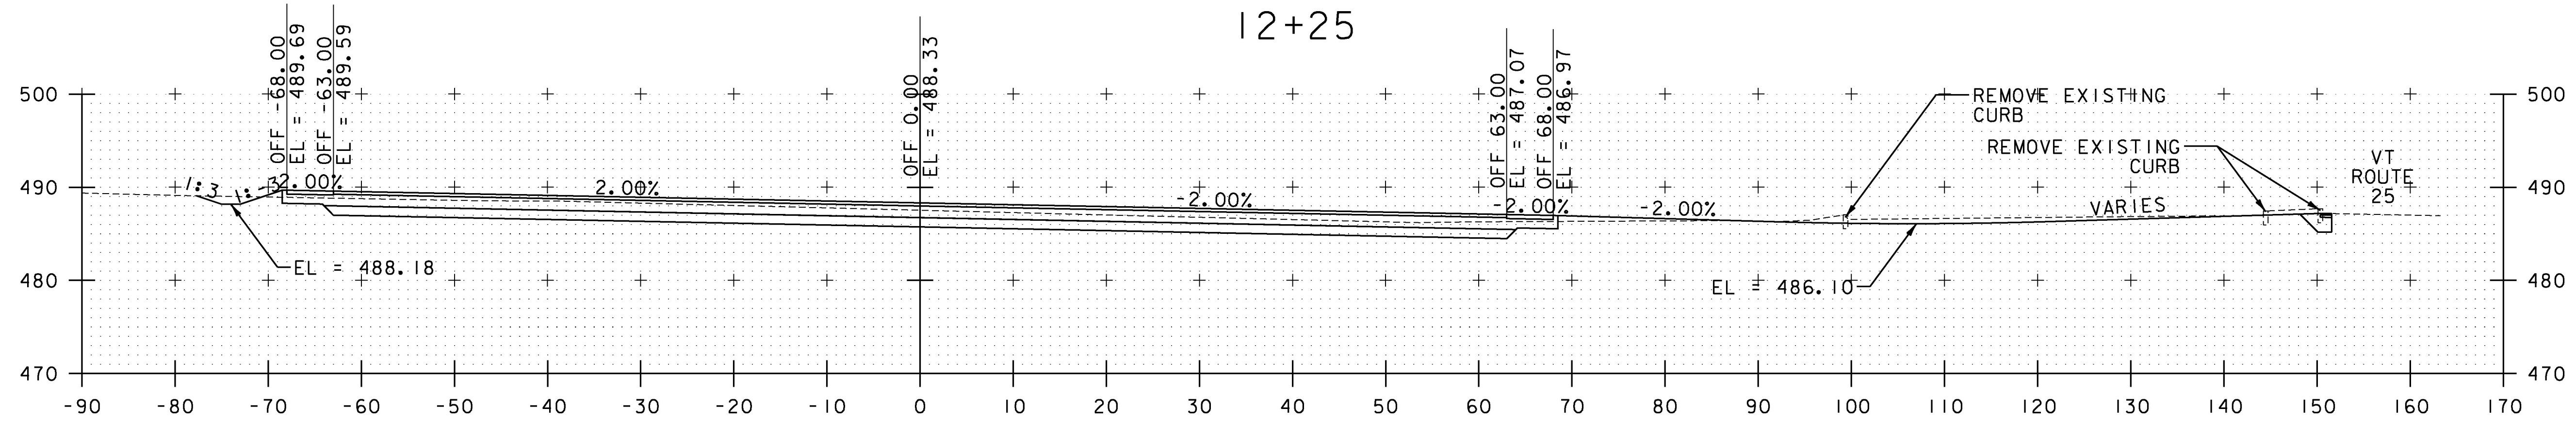

12+00

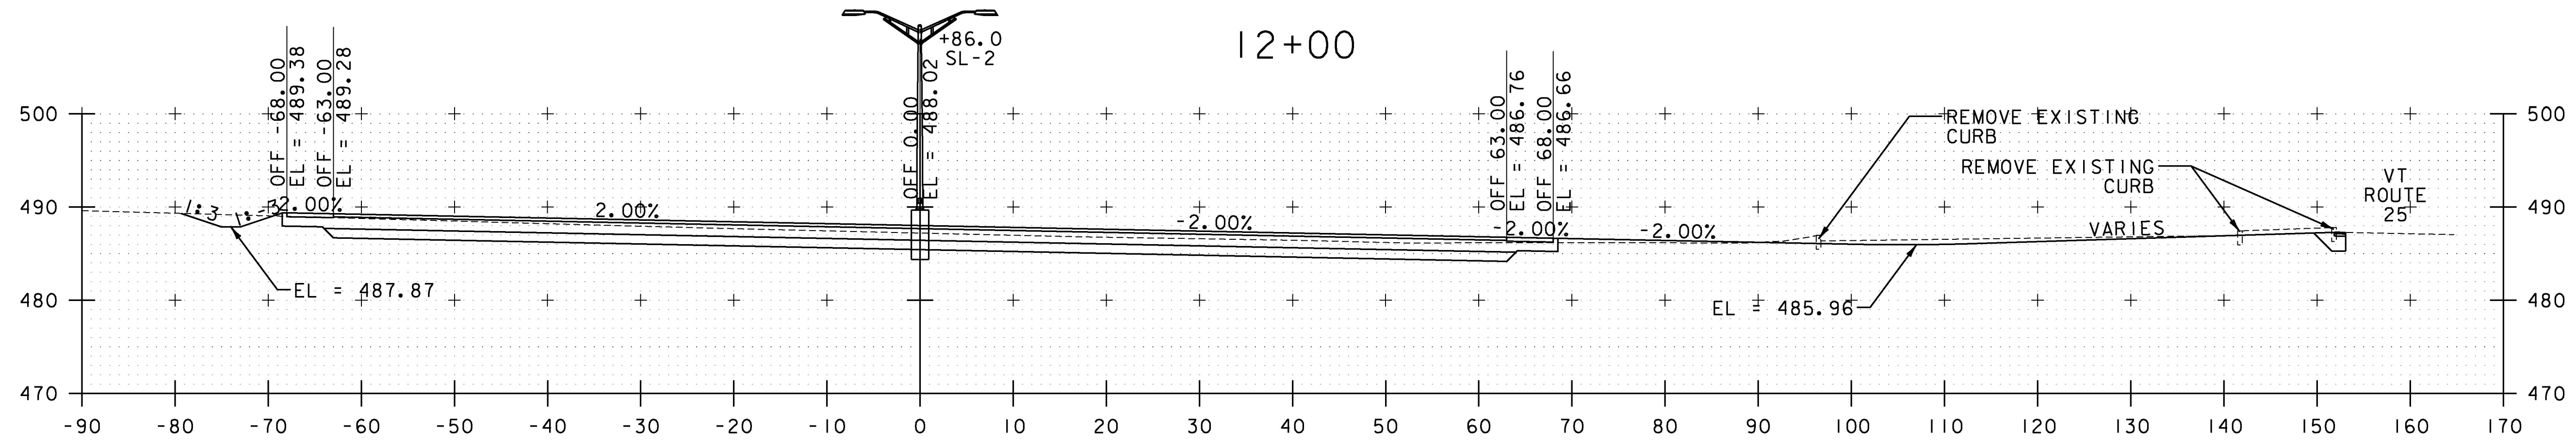

11+75

STA. 11+75 TO STA. 12+25

PROJECT NAME:	BRADFORD	PLOT DATE:	5/22/2014
PROJECT NUMBER:	CMG PARK (33)	DRAWN BY:	P. ARMATA
FILE NAME:	z09k252xs.dgn	DESIGNED BY:	I. MAYNARD
PROJECT LEADER:	M. FOISY	CHECKED BY:	G. SANTY
CROSS SECTIONS SHEET 3			SHEET 26 OF 33

