



13+00
END NEW PARK & RIDE LOT

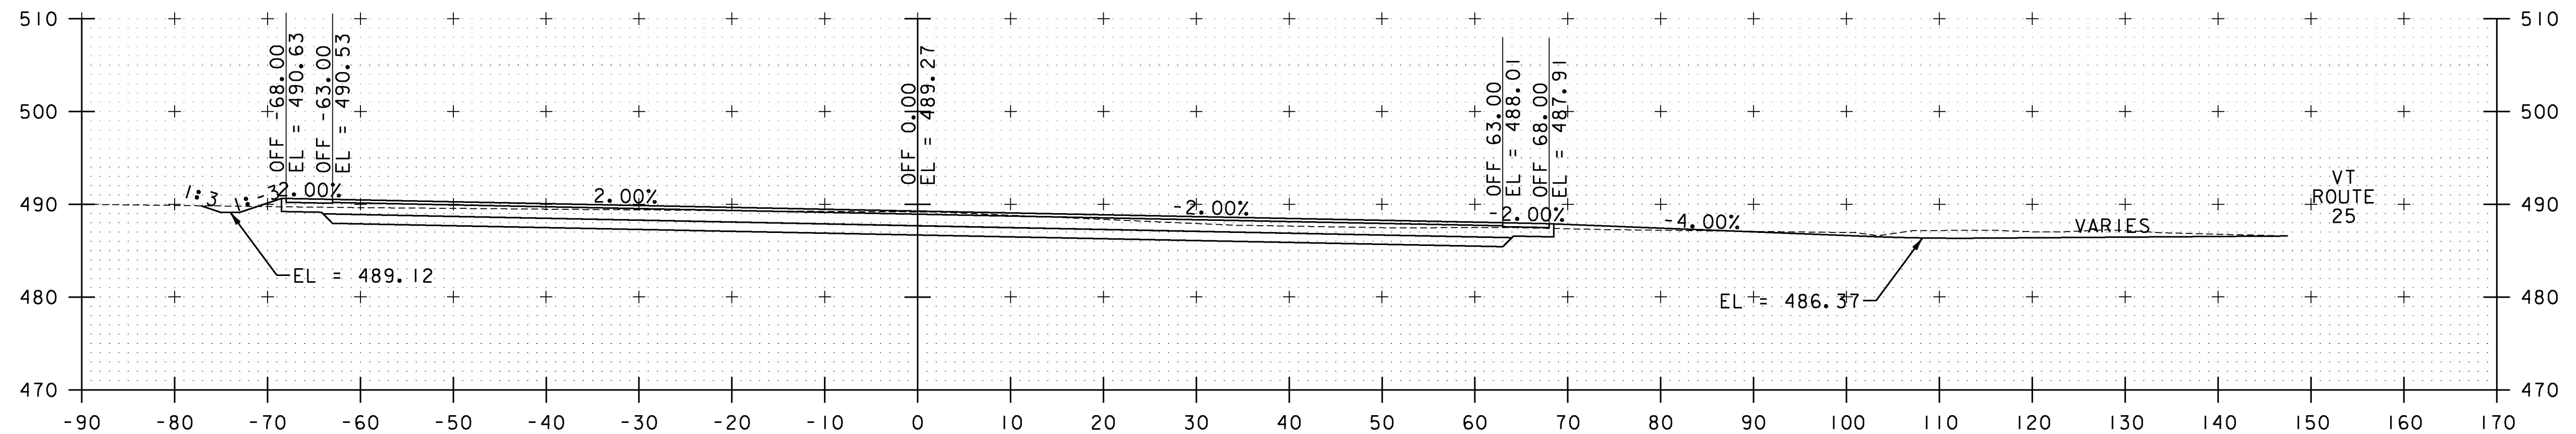

12+75

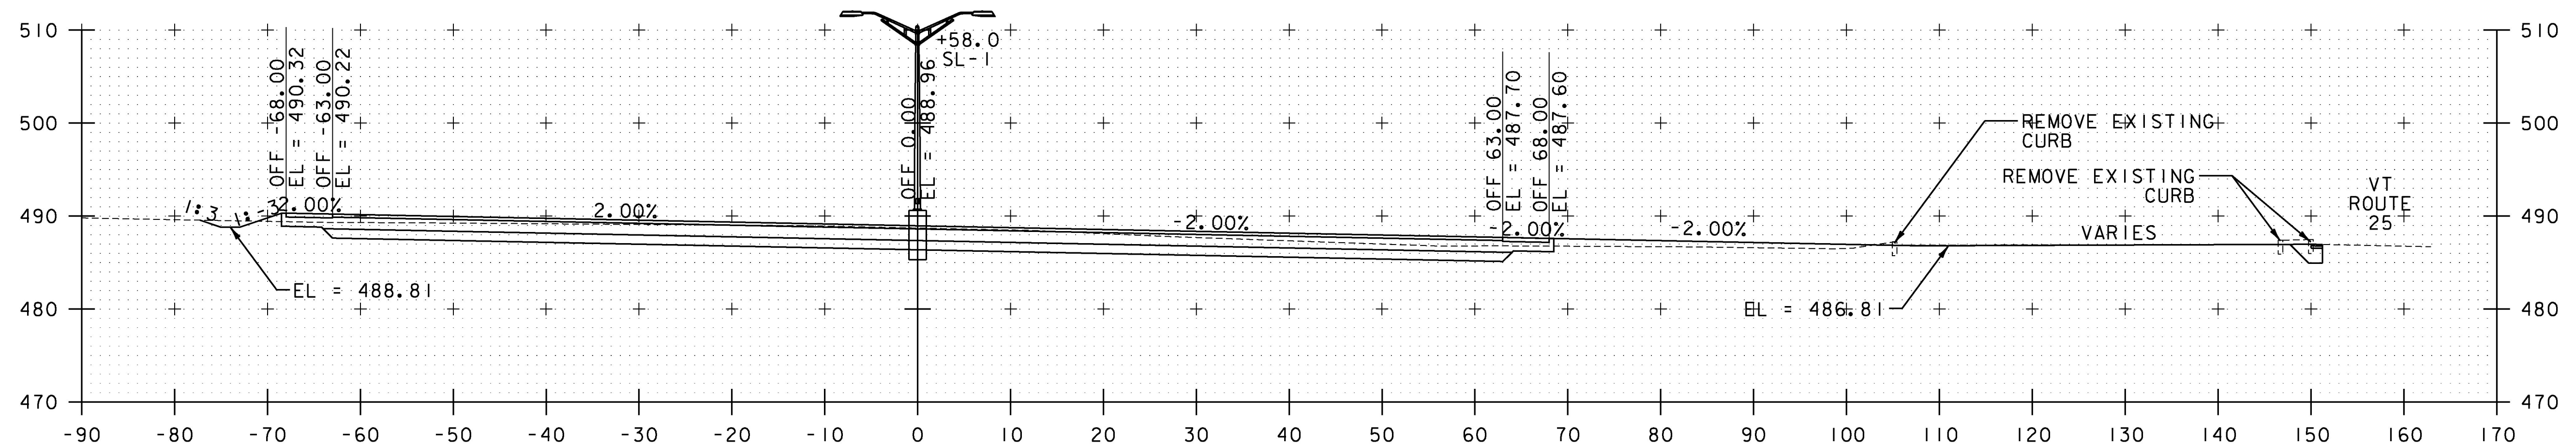

12+50

STA. 12+50 TO STA. 13+00

PROJECT NAME:	BRADFORD	FILE NAME:	z09k252xs.dgn	PLOT DATE:	5/22/2014
PROJECT NUMBER:	CMG PARK (33)	PROJECT LEADER:	M. FOISY	DRAWN BY:	P. ARMATA
		DESIGNED BY:	I. MAYNARD	CHECKED BY:	G. SANTY
		CROSS SECTIONS SHEET 4			SHEET 27 OF 33

